


NOTE 1: LOCATE TRANSITION POST AS CLOSE TO ABUTMENT WALL AS PRACTICAL.

RAILING ELEVATION

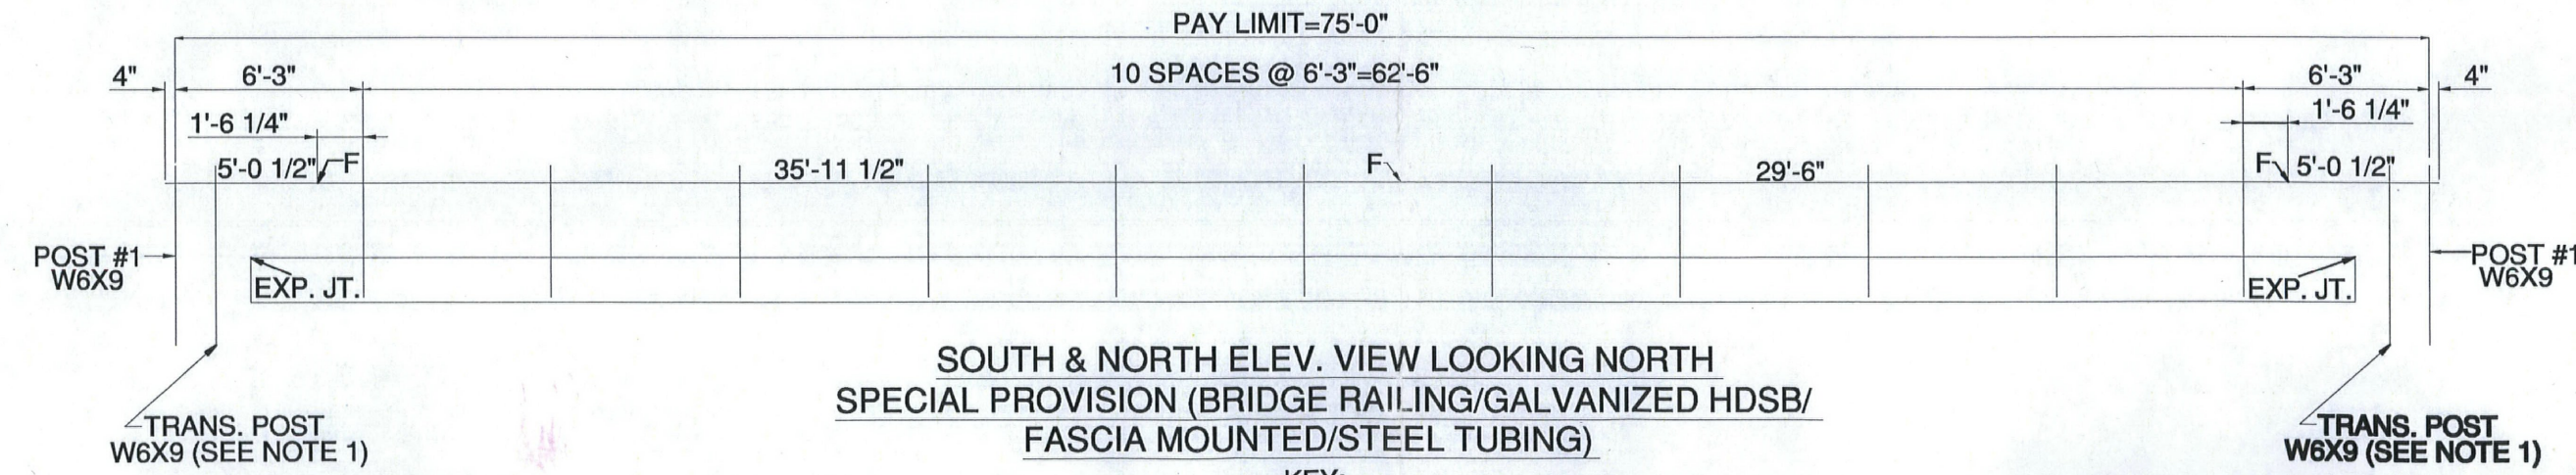

NOTES: FOR SECTION VIEWS B-B & D-D SEE SHEET 2 OF 3.

KEY:
F=1/2" SPL. JT.

Vermont Agency of Transportation
RECEIVED
CK'D BY **TCF** OK'D BY **JTS**
9:09 am, Apr 27, 2010
RESUBMIT APPROVED X
BY **KMH** DATE 4-27-10

ALL DIMENSIONS MUST BE FIELD VERIFIED BY CONTRACTOR PRIOR TO FABRICATION

DRAWN BY: JJP	DATE 4/9/10	CHECKED BY: DCK	SHEET NO. 1 OF 3
BRIDGE RAILING LAYOUT			
VERMONT AGENCY OF TRANSPORTATION HEWARD ROAD BRIDGE (STA. 11+85.00) OVER AYER'S BROOK IN THE TOWN OF BRANTREE IN THE COUNTY OF ORANGE			
CONT. NO. BRO 1444(26)	GEN. CONT. RENAUD BROTHERS, INC.		REGION NO. N/A
ERECTOR: VERMONT RECREATIONAL SURFACING & FENCING, INC.		JOB NO. V04-02	
FABRICATOR: DI HIGHWAY SIGN & STRUCTURE CORPORATION P.O. BOX 123(40 GREENMAN AVE.) NEW YORK MILLS, N.Y. 13417			

039 Bridge Rail