

### CONVENTIONAL SYMBOLS

COUNTY LINE	
TOWN LINE	
LIMITS OF ACCESS	
POINT OF ACCESS	
FENCE LINE	
STONE WALL	
TRAVELED WAY	
GUARD RAIL	
RAILROAD	
SURVEY LINE	
CULVERT	
POWER POLE	
TELEPHONE POLE	
TREES	
CONTROL OF ACCESS	
PROPERTY LINE	
R.O.W. TAKING LINE	
SLOPE RIGHTS	
TOP OF CUT	
TOE OF SLOPE	

SURVEYED BY : GILMAN/MOREAU


SURVEYED DATE : 10/03/1996

#### DATUM

VERTICAL NAVD 88

HORIZONTAL NAD 83 (92)

N

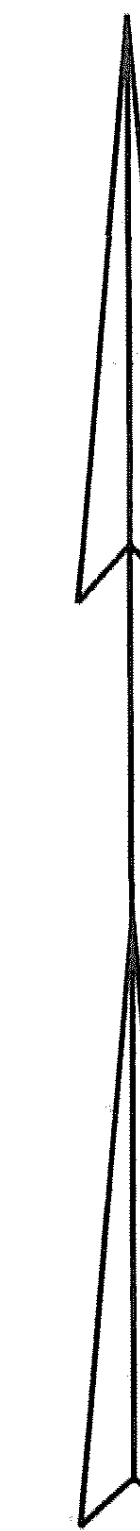

VT STATE PLANE GRID


LENGTH OF STRUCTURE :  
 LENGTH OF ROADWAY :  
 LENGTH OF PROJECT :

EN  
ST

END E  
STA  
P.O.S.

BEGIN BRIDGE  
 STA 11+20  
 P.O.S.T.

BEGIN PROJECT  
 STA 10+75

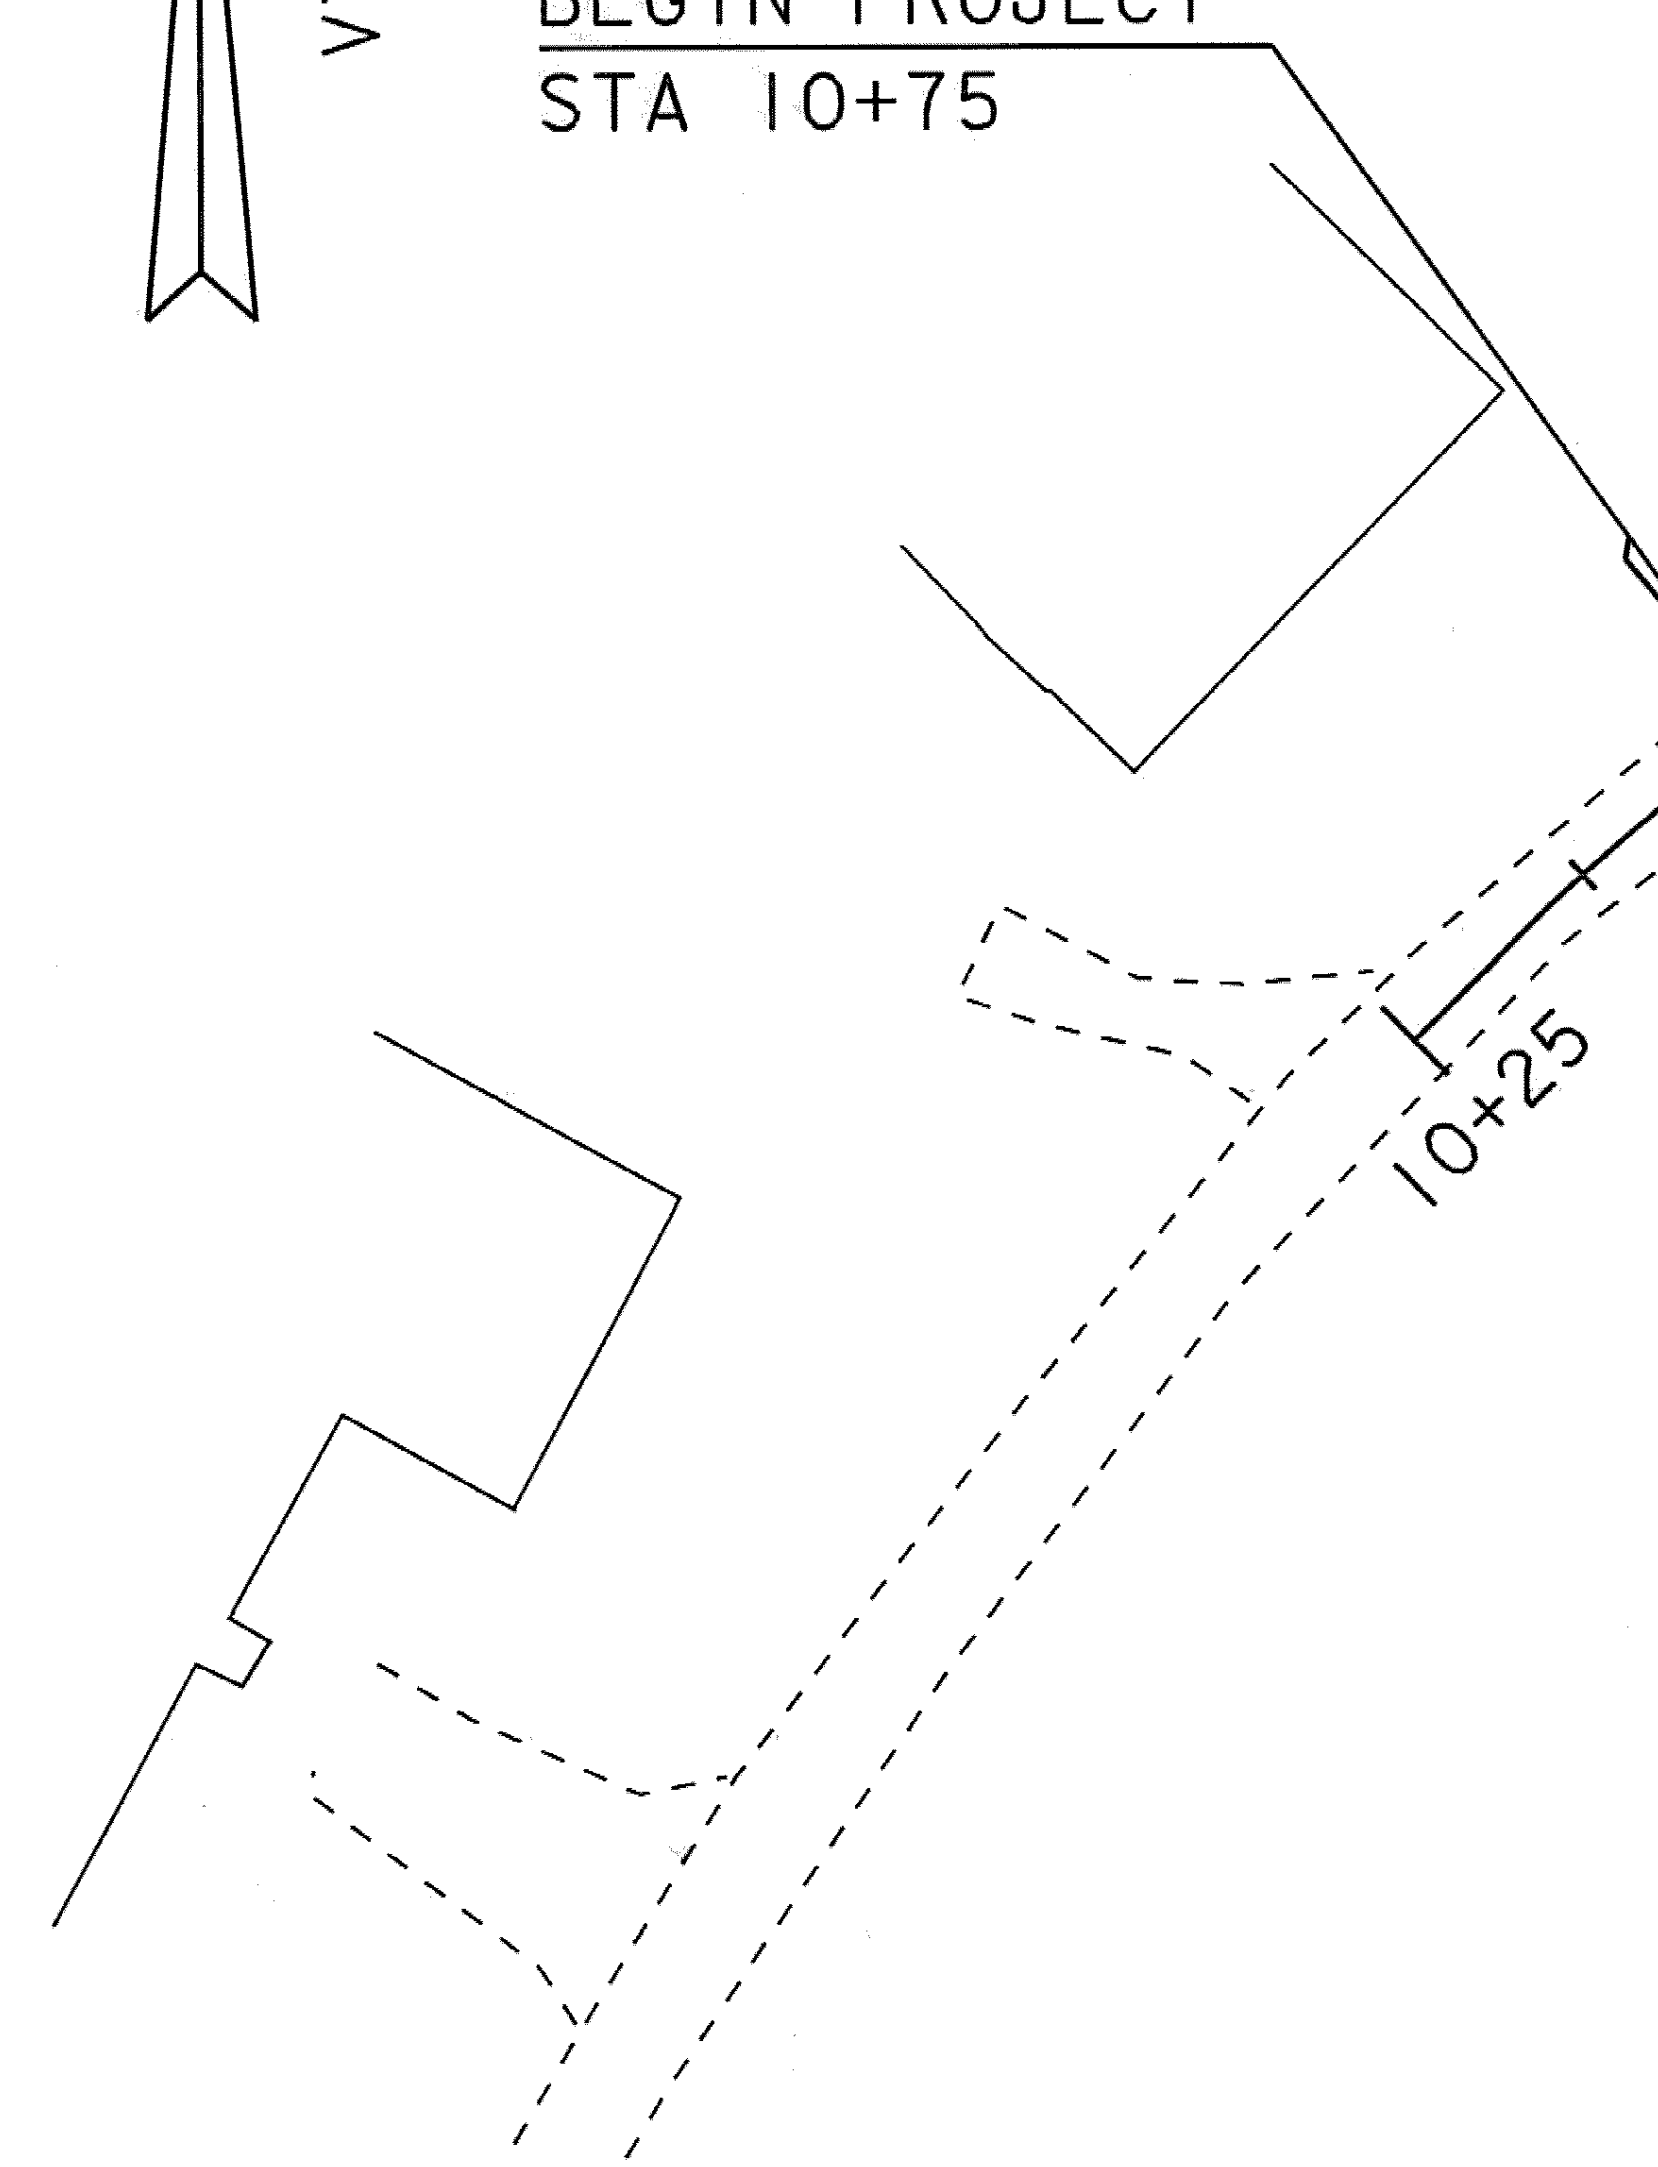

# PRELIMINARY INFORMATION SHEET (BRIDGE)

LRFD

INDEX OF SHEETS

FINAL HYDRAULIC REPORT

PLAN SHEETS

1	TITLE SHEET
2	PRELIMINARY INFORMATION (BRIDGE)
3	GENERAL NOTES
4 - 5	QUANTITY SHEETS
6	TYPICAL SECTIONS
7	TIE SHEET
8	LAYOUT SHEET
9	PROFILE SHEET
10	EPSC NARRATIVE
11	EPSC EXISTING CONDITIONS
12	BORING LAYOUT SHEET
13	BORING LOGS
14	PLAN AND ELEVATION
15	FRAMING PLAN
16 - 17	BOX BEAM DETAILS #1-#2
18	BEARING DETAILS
19	ABUTMENTS
20	RETAINING WALL
21	RAL LAYOUT SHEET
22	RAL DETAIL
23 - 25	MAINLINE SECTIONS
26	CHANNEL SECTIONS

STANDARDS LIST

E-100	CONSTRUCTION APPROACH SIGNS	2-Jan-04
E-100A	SIDE ROAD CONSTRUCTION - APPROACH SIGNS	2-Jan-04
E-101	CONSTRUCTION SIGN DETAILS	30-May-03
E-102	CONSTRUCTION SIGN DETAILS	30-Jun-03
E-102A	CONSTRUCTION SIGN DETAILS	1-May-04
E-106	TRAFFIC CONTROL- MISCELLANEOUS DETAILS	1-Mar-04
E-107	DELINEATION, BARRICADES AND DETOURS FOR CONSTRUCTION AREAS	30-Jun-03
E-107A	BREAKAWAY BARRICADE DETAILS	8-Jun-09
E-108	CONSTRUCTION ZONE   LONGITUDINAL DROP OFFS	8-Jun-09
E-120	STANDARD SIGN PLACEMENT - EXPRESSWAY & FREEWAY	8-Aug-95
E-121	STANDARD SIGN PLACEMENT - CONVENTIONAL ROAD	8-Aug-95
E-138	MILE MARKER DETAILS - STATE & TOWN HIGHWAYS	30-May-03
E-150	WARNING SIGN DETAILS	1-May-04
E-151	WARNING SIGN DETAILS	1-May-04
E-160	FLANGED CHANNEL STEEL SIGN POST	20-May-99
E-161	W-SHAPED STEEL SIGN POST	18-Aug-95
E-162	TUBULAR ALUMINUM SIGN POST	20-May-99
E-163	TUBULAR STEEL SIGN POST	20-May-99
E-164	SQUARE STEEL SIGN POST	8-Jun-09
E-197	DELINEATOR PLACEMENT TYPICAL	1-Apr-05
E-198	DELINEATOR SAND MILE POSTS	1-Apr-05
E-199	DELINEATOR AND MILE POST MOUNTING ON   BRIDGE RAIL	1-Apr-05
G-1	STEEL BEAM GUARDRAIL DETAILS (POST, DELINEATOR, TYPICALS)	3-Jan-00
G-1D	STEEL BEAM GUARDRAIL DETAILS (END TERMINAL, ANCHOR, MEDIAN)	3-Jan-00
SB-R6-82	BRIDGE RAILING - HEAVY DUTY STEEL BEAM	6-Jan-95

HYDROLOGIC DATA

Date: Sept 2009

DRAINAGE AREA : 18.8 sq. mi.  
 CHARACTER OF TERRAIN : Rural, mixed forest and open, moderate to steep slopes  
 STREAM CHARACTERISTICS : Incised, unstable stream banks  
 NATURE OF STREAMBED : Sand, gravel and cobbles

PEAK FLOW DATA

Q 2.33 =	700 cfs	Q 50 =	2275 cfs
Q 10 =	1400 cfs	Q 100 =	2700 cfs
Q 25 =	1850 cfs	Q 500 =	3500 cfs

DATE OF FLOOD OF RECORD: November 1927  
 ESTIMATED DISCHARGE: Unknown  
 WATER SURFACE ELEV.: Unknown  
 NATURAL STREAM VELOCITY: @ Q25 = 10.2 fps  
 ICE CONDITIONS: Moderate  
 DEBRIS: Moderate  
 DOES THE STREAM REACH MAXIMUM HIGHWATER ELEV. RAPIDLY? Yes  
 IS ORDINARY RISE RAPID? Yes  
 IS STAGE AFFECTED BY UPSTREAM OR DOWNSTREAM CONDITIONS? No  
 IF YES, DESCRIBE: N/A

WATERSHED STORAGE: < 1% HEADWATERS:  
 UNIFORM: X  
 IMMEDIATELY ABOVE SITE:

EXISTING STRUCTURE INFORMATION

STRUCTURE TYPE: Temporary Mabey bridge  
 YEAR BUILT: Original structure built in 1929  
 CLEAR SPAN(NORMAL TO STREAM): 21'  
 VERTICAL CLEARANCE ABOVE STREAMBED: ~11'  
 WATERWAY OF FULL OPENING: 220 sq. ft.  
 DISPOSITION OF STRUCTURE: Remove and replace superstructure  
 TYPE OF MATERIAL UNDER SUBSTRUCTURE: See borings

WATER SURFACE ELEVATIONS AT:

Q2.33 =	697.8'	VELOCITY =	7.2 fps
Q10 =	700.5'	"	11.8 fps
Q25 =	701.7'	"	14.2 fps
Q50 =	702.3'	"	14.6 fps
Q100 =	703.7'	"	11.2 fps

LONG TERM STREAMBED CHANGES: Channel has moved laterally within floodplain over time.

IS THE ROADWAY OVERTOPPED BELOW Q100: Yes  
 FREQUENCY: Q25  
 RELIEF ELEVATION: 701.1'  
 DISCHARGE OVER ROAD @Q100: 1290 cfs

UPSTREAM STRUCTURE

TOWN: Braintree DISTANCE: 5700'  
 HIGHWAY #: VT 12 STRUCTURE #: BR 47  
 CLEAR SPAN: 25' CLEAR HEIGHT: 11.5'  
 YEAR BUILT: 1928, reconstructed in 1969 FULL WATERWAY:  
 STRUCTURE TYPE: T beam bridge and multiplate arch

DOWNSTREAM STRUCTURE

TOWN: Randolph DISTANCE: 9500'  
 HIGHWAY #: TH 42 STRUCTURE #: BR 37  
 CLEAR SPAN: 37' CLEAR HEIGHT: 11'  
 YEAR BUILT: 1985 FULL WATERWAY:  
 STRUCTURE TYPE: Concrete Slab

LRFR LOAD RATING FACTORS

LOADING LEVELS	TRUCK						
	H-20	HL-93	3S2	6 AXLE	3A STR	4A STR	5A SEM
TONNAGE	20	36	36	66	30	34.5	38
INVENTORY	1.67	1.07					
POSTING							
OPERATING	2.17	1.38	1.83	1.10	1.54	1.38	1.53
COMMENTS:							

PILE DRIVING AND TESTING REQUIREMENTS  
 1. NOMINAL PILE DRIVING CAPACITY: Prop. 465.00 KIP  
 2. PILE TEST RESISTANCE FACTOR:  $\phi$  0.40  
 3. MAXIMUM PILE TIP ELEVATION: SEE BORING LOGS  
 4.  $\bar{v}$

PROPOSED STRUCTURE

STRUCTURE TYPE: Single span  
 CLEAR SPAN(NORMAL TO STREAM): 21'  
 VERTICAL CLEARANCE ABOVE STREAMBED: ~12'  
 WATERWAY OF FULL OPENING: 225 sq. ft.

WATER SURFACE ELEVATIONS AT:

Q2.33 =	697.8'	VELOCITY =	7.3 fps
Q10 =	700.5'	"	11.9 fps
Q25 =	701.7'	"	14.2 fps
Q50 =	702.3'	"	14.6 fps
Q100 =	703.7'	"	11.2 fps

IS THE ROADWAY OVERTOPPED BELOW Q100: Yes  
 FREQUENCY: Q25  
 RELIEF ELEVATION: 701.1'  
 DISCHARGE OVER ROAD @Q100: 1290 cfs

AVERAGE LOW ELEVATION OF SUPERSTRUCTURE: 702.7'  
 VERTICAL CLEARANCE: @ Q25 = 1.0'

SCOUR: Contraction scour of 6.0' at Q25

REQUIRED CHANNEL PROTECTION: None required.

PERMIT INFORMATION

AVERAGE DAILY FLOW:	40 cfs	DEPTH OR ELEVATION:	
ORDINARY LOW WATER:	20 cfs		0.5' *
ORDINARY HIGH WATER:	300 cfs		2.5' *

TEMPORARY BRIDGE REQUIREMENTS

STRUCTURE TYPE: None  
 CLEAR SPAN (NORMAL TO STREAM):  
 VERTICAL CLEARANCE ABOVE STREAMBED:  
 WATERWAY AREA OF FULL OPENING:

ADDITIONAL INFORMATION

Elevations based on NAVD88  
 Existing abutments will be retained with the new bridge constructed over and behind them.  
 \* Water depths given are those where no scour holes occur in river.

DESIGN VALUES

1. DESIGN LIVE LOAD	HL-93
2. FUTURE PAVEMENT	$d_p$ : 2.0 INCH
3. DESIGN SPAN	$L$ : 67.00 FT
4. MIN. MID-SPAN POS. CAMBER @ RELEASE (PRESTRESSED UNITS)	$\Delta$ : 1.56 INCH
5. PRESTRESSING STRAND (0.60 INCH DIAMETER - LOW RELAX)	$f_y$ : 270 KSI
6. PRESTRESSED CONCRETE STRENGTH	$f_c$ : 7.0 KSI
7. PRESTRESSED CONCRETE RELEASE STRENGTH	$f_{cr}$ : 5.5 KSI
8. CONCRETE, HIGH PERFORMANCE CLASS AA	$f_c$ : 4.0 KSI
9. CONCRETE, HIGH PERFORMANCE CLASS A	$f_c$ : 4.0 KSI
10. CONCRETE, HIGH PERFORMANCE CLASS B	$f_c$ : 3.5 KSI
11. CONCRETE, CLASS C	$f_c$ : 3.0 KSI
12. REINFORCING STEEL	$f_y$ : 60 KSI
13. STRUCTURAL STEEL AASHTO M270	$f_y$ : ---
14. SOIL UNIT WEIGHT	$\gamma$ : 0.140 KCF
15. NOMINAL BEARING RESISTANCE OF SOIL	$q_n$ : 9.0 KSF
16. SOIL BEARING RESISTANCE FACTOR (REFER TO AASHTO LRFD)	$\phi$ : 0.45
17. NOMINAL BEARING RESISTANCE OF ROCK	$q_n$ : ---
18. ROCK BEARING RESISTANCE FACTOR (REFER TO AASHTO LRFD)	$\phi$ : ---
19. NOMINAL AXIAL PILE RESISTANCE	$q_p$ : 465.0 KIPS
20. PILE YIELD STRENGTH ASTM A572	$f_y$ : 50 KSI
21. PILE SIZE	HP 12X53
22. EST. PILE LENGTH	SEE BORING LOGS
$L_p$ :	
23. PILE RESISTANCE FACTOR	$\phi$ : 0.40
24. LATERAL PILE DEFLECTION	$\Delta$ : 0.25 INCH
25. BASIC WIND SPEED	$V_{3s}$ : ---
26. MINIMUM GROUND SNOW LOAD	$p_g$ : ---
27. SEISMIC DATA	$PGA$ : ---
$S_s$ :	
$S_1$ :	

PROJECT NAME: BRAINTREE  
 PROJECT NUMBER: BRO 1444(36)

FILE NAME: s95j292pi.xls PLOT DATE: 12/29/2009  
 PROJECT LEADER: K. HIGGINS DRAWN BY: R. PELLETT  
 DESIGNED BY: T. FILLBACH CHECKED BY: T. FILLBACH  
 PRELIMINARY INFORMATION (BRIDGE) SHEET 2 OF 26

TRAFFIC DATA

YEAR	ADT	DHV	% D	% T	ADTT	
2009	20	5	52	4	6	20 year ESAL for flexible pavement from 2009 to 2029 : < 50000
2029	30	5	52	4	6	40 year ESAL for flexible pavement from 2009 to 2049 : <50000
						Design Speed : 30 mph

**GENERAL**

1. ALL MATERIALS AND CONSTRUCTION SHALL CONFORM TO THE STATE OF VERMONT, AGENCY OF TRANSPORTATION STANDARD SPECIFICATIONS FOR CONSTRUCTION, DATED 2006, AND ITS LATEST REVISIONS, THE AASHTO LRFD BRIDGE DESIGN SPECIFICATIONS FOURTH EDITION, AND ITS LATEST REVISIONS AND THE AASHTO LRFD BRIDGE CONSTRUCTION SPECIFICATIONS, SECOND EDITION, AND ITS LATEST REVISIONS.
2. THE BRIDGE IS DESIGNED FOR HL-93 LIVE LOAD WITH AN ALLOWANCE FOR 2 INCHES OF FUTURE PAVEMENT.
3. ALL DIMENSIONS SHOWN IN THE PLANS ARE HORIZONTAL OR VERTICAL AND ARE GIVEN AT 68 DEGREES FAHRENHEIT, UNLESS NOTED OTHERWISE.
4. ANY STRUCTURE SUCH AS STEEL PANELS OR WOOD PANELS USED TO BRIDGE EXCAVATIONS SHALL BE DESIGNED BY A PROFESSIONAL ENGINEER.
5. ITEM 529.15 "REMOVAL OF STRUCTURE" IS FOR THE REMOVAL OF THE EXISTING MABEY BRIDGE SUPERSTRUCTURE AND ANY EXISTING SUBSTRUCTURE COMPONENTS REQUIRED TO COMPLETE THE PROPOSED WORK. SEE SPECIAL PROVISIONS FOR REQUIREMENTS ON THE REMOVAL AND DELIVERY OF THE MABEY BRIDGE COMPONENTS.
6. THE BID PRICE FOR ITEM 620.55 REMOVAL OF EXISTING FENCE SHALL INCLUDE STOCKPILING THE FENCE IN A LOCATION ACCEPTABLE TO THE PROPERTY OWNER.
7. SEE THE UTILITY SPECIAL PROVISIONS FOR A DESCRIPTION OF WHEN AND WHERE ITEM 204.22 TRENCH EXCAVATION OF EARTH, EXPLORATORY (N.A.B.I.) MAY BE REQUIRED.

**CONCRETE**

8. ALL EXPOSED EDGES OF CONCRETE SHALL BE CHAMFERED 1 INCH X 1 INCH.
9. ITEM 514.10 "WATER REPELLENT, SILANE", SHALL BE APPLIED TO ALL EXPOSED CONCRETE SURFACES, EXCEPT THE UNDERSIDE OF THE DECK BETWEEN DRIP NOTCHES.
10. JOINTS AND SCORE MARKS IN CONCRETE SHALL BE CONSTRUCTED AS SHOWN IN THE PLANS OR AS DIRECTED BY THE RESIDENT ENGINEER.

**PRESTRESSED BOX BEAMS & PRECAST ABUTMENTS**

11. ITEM 510.21 "PRESTRESSED CONCRETE BOX BEAMS" SHALL:
  - A. CONFORM TO SECTION 510 "PRESTRESSED CONCRETE".
  - B. HAVE THE ENDS OF THE STRANDS RECESSED AND GROUTED ACCORDING TO STANDARD PRACTICE.
  - C. INCLUDE COLD POURED JOINT FILLER, AND TRANSVERSE TENDONS.
  - D. GALVANIZE TRANSVERSE TENDONS PLATES AND CHUCKS AFTER FABRICATION ACCORDING TO AASHTO M 232M/M 232.
12. ITEM 510.24 "GROUTING SHEAR KEYS": FILL THE JOINTS BETWEEN THE BEAMS WITH MORTAR, TYPE IV, AS DESCRIBED IN SUBSECTION 510.13.
13. DESIGN VALUES
  - A. CONCRETE:  $f_c = 7$  ksi AND  $f_c = 5.5$  ksi
  - B. LIVE LOAD: AASHTO HL-93
  - C. PRESTRESSING STRANDS: 0.6" DIAMETER, 270 ksi, LOW-RELAXATION 7-WIRE STRANDS PULLED TO 75% OF THEIR YIELD STRENGTH
  - D. POST-TENSIONING STRANDS: 0.5" DIAMETER, 270 ksi, LOW-RELAXATION 7-WIRE STRANDS.
  - E. THE ASSUMED MODULUS OF ELASTICITY FOR THE STRAND IS 28,500 KSI.
  - F. THERE SHALL BE TWO (2) STRANDS PER POST-TENSION DUCT.
  - G. TRANSVERSE TENDONS SHALL BE COVERED BY SEAMLESS POLYPROPYLENE SHEATH (WITH CORROSION INHIBITOR GREASE BETWEEN SHEATH AND STRAND) FOR THE LENGTH OF THE STRAND. TIES SHALL BE TENSIONED TO 33 KIPS FOR EACH 0.5" DIAMETER STRAND AND 47 KIPS FOR EACH 0.6" DIAMETER STRAND.
  - H. SERVICE LOADS

MEMBER MOMENT	523 & 635 K-FT
SUPERIMPOSED DEAD LOAD MOMENT	66 K-FT
LIVE LOAD & IMPACT MOMENT	860 K-FT
DEAD LOAD REACTION	35 & 42 K
LIVE LOAD & IMPACT REACTION	56 K
TOTAL REACTION	91 & 98 K
FINAL CAMBER	1.2 & 1.7 IN
14. THE FABRICATOR MAY, WITH THE APPROVAL OF THE PROJECT MANAGER, ALTER THE DESIGN AS DETAILED TO MEET THE PLANT'S PRESTRESSING OPERATION AND MATERIAL REQUIREMENTS. ALTERNATE STRAND, TRANSVERSE TIE AND CROSS-SLOPE CONFIGURATIONS MAY BE SUBMITTED TO THE ENGINEER FOR APPROVAL. ANY DESIGN CHANGES SHALL MEET ALL OF THE APPLICABLE DESIGN CRITERIA, LOADINGS AND CODES AND SHALL BE STAMPED AND SIGNED BY A PROFESSIONAL ENGINEER LICENSED IN THE STATE OF VERMONT.

15. THE PRECASTER SHALL SANDBLAST SHEAR KEY FACES PRIOR TO DELIVERY.
16. IF THE SUBSTRUCTURE UNITS ARE PROVIDED IN MULTIPLE PIECES, THE SHEAR KEYS SHALL BE PROVIDED AT THE JOINTS AND THE PIECES SHALL BE MATCH CAST BY THE FABRICATOR.
17. ALL TIES AND STIRRUPS IN THE BOX BEAMS SHALL BE EPOXY COATED.
18. 1/2" SACRIFICIAL WEARING SURFACE HAS BEEN ADDED TO THE TOP OF THE BOX BEAMS. SEE THE SPECIAL PROVISIONS FOR DETAILS ON PROVIDING TEXTURING.

**PROPOSED CONSTRUCTION SEQUENCE FOR PRECAST ABUTMENTS**

19. PREPARE AND GRADE FOUNDATION TO REQUIRED ELEVATION.
20. PLACE SUBSTRUCTURE UNIT(S) OVER PILES.
  - A. PLUG GROUT HOLES
  - B. CONSTRUCTION JOINTS (IF REQUIRED) SHALL BE KEYED AND MATCH CAST.
21. INSTALL TRANSVERSE TENDONS (IF USING MORE THAN ONE SUBSTRUCTURE UNIT)
  - A. FEED TWO TENDONS THROUGH EACH OF THE SIX DUCTS.
  - B. USING A CALIBRATED JACK, POST-TENSION TO 3 KIPS TO REMOVE SAG IN THE TENDON
22. GROUT SHEAR KEY
23. POST-TENSION TRANSVERSE TENDONS:
  - A. GROUT SHALL ATTAIN A MINIMUM COMPRESSIVE STRENGTH OF 1500 psi, BASED ON THE MANUFACTURER'S RECOMMENDATIONS, PRIOR TO STRESSING. THE GROUT NEED NOT BE CURED FOR THREE DAYS PRIOR TO THE COMMENCING OF POST-TENSIONING.
  - B. PROVIDE APPROPRIATE CUBE MOLDS AS DESCRIBED IN AASHTO T106 FOR 3 SETS OF 3 DAY CUBES, 3 SETS OF 28 DAY CUBES AND AT A MINIMUM OF 3 MORE CUBES TO TEST FOR THE 1500 psi MINIMUM COMPRESSIVE STRENGTH.
  - C. POST-TENSION TENDONS TO 33 KIPS USING A CALIBRATED JACK OPERATED BY QUALIFIED PERSONNEL.
24. GROUT PILE CAVITIES
  - A. UNCOVER DUCTS
  - B. PLACE THE CONCRETE THROUGH FILL DUCTS INTO PILE CAVITIES.
  - C. MONITOR THE QUALITY OF THE GROUT THROUGH THE VENT DUCT.
  - D. CONTINUE GROUTING UNTIL THE CONCRETE COMPLETELY FILLS THE CAVITY AND BOTH DUCTS.
  - E. THE GROUT FOR FILLING THE PILE CAVITIES SHALL MEET THE REQUIREMENTS OF SELF-CONSOLIDATING CONCRETE. SEE THE SPECIAL PROVISIONS FOR DETAILS. ALL COSTS ASSOCIATED WITH GROUTING THE PILE CAVITIES SHALL BE INCLUDED IN THE BID PRICE FOR ITEMS 540.10 PRECAST CONCRETE STRUCTURE (ABUTMENT #1) AND 540.10 PRECAST CONCRETE STRUCTURE (ABUTMENT #2).

**BACKFILL ABUTMENT**

**PROPOSED CONSTRUCTION SEQUENCE FOR PRESTRESSED BOX BEAMS**

25. BACKFILL ABUTMENT
26. LAY OUT WORKING LINES:
  - A. LAY OUT WORKING LINES FOR THE ENTIRE BRIDGE WIDTH ON THE BEAM SEAT.
  - B. MEASURE ALL WORKING LINES FROM A COMMON WORKING POINT.
  - C. BASE THE WORKING LINES ON THE NOMINAL BEAM WIDTHS.
27. VERIFY BEAM SEAT ELEVATIONS:
  - A. MEASURE ELEVATIONS AT BEAM SEATS.
  - B. IF SEATS ARE HIGH OR LOW, TAKE CORRECTIVE ACTION.
  - C. INSTALL BEARINGS.
28. ERECT BEAMS:
  - A. PLACE BEAMS TO FIT WITHIN THE WORKING LINES.
  - B. AS WORK PROGRESSES, INSTALL HARDWOOD WEDGES BETWEEN ADJACENT BEAMS TO MAINTAIN PROPER JOINT OPENING (A MINIMUM OF ONE WEDGE AT EACH TRANSVERSE TENDON).
  - C. DRILL ANCHOR BOLT HOLES.
  - D. PLACE ANCHOR BOLTS.
29. INSTALL BACKER ROD: PLACE FILLER BELOW THE KEYWAY BOTTOM, AS SHOWN ON THE PLANS.
30. INSTALL TRANSVERSE TENDONS:
  - A. FEED TENDONS THROUGH DUCTS.
  - B. VERIFY THAT HARDWOOD WEDGES ARE IN PLACE AS REQUIRED TO PREVENT SLIPPAGE OF BEAMS.
  - C. USING A CALIBRATED JACK, POST-TENSION TENDONS TO APPROXIMATELY 3 KIPS TO REMOVE SAG IN THE TENDON AND TO SEAT THE CHUCK.

31. GROUT SHEAR KEYS:
  - A. CLEAN JOINTS WITH AN OIL FREE AIR-BLAST IMMEDIATELY BEFORE GROUT PLACEMENT. VERIFY THAT THE BACKER ROD IS STILL IN PLACE.
  - B. FOLLOW MANUFACTURER'S RECOMMENDATIONS FOR ADDITIONAL JOINT PREPARATION AND GROUT PLACEMENT.
  - C. CAREFULLY ROD JOINTS TO ELIMINATE ANY POSSIBILITY OF VOIDS.
32. POST-TENSION TRANSVERSE TENDONS:
  - A. GROUT SHALL ATTAIN A MINIMUM COMPRESSIVE STRENGTH OF 1500 psi, BASED ON THE MANUFACTURER'S RECOMMENDATIONS, PRIOR TO STRESSING. THE GROUT NEED NOT BE CURED FOR THREE DAYS PRIOR TO THE COMMENCING OF POST-TENSIONING.
  - B. PROVIDE APPROPRIATE CUBE MOLDS AS DESCRIBED IN AASHTO T106 FOR 3 SETS OF 3 DAY CUBES, 3 SETS OF 28 DAY CUBES AND AT A MINIMUM OF 3 MORE CUBES TO TEST FOR THE 1500 psi MINIMUM COMPRESSIVE STRENGTH.
  - C. POST-TENSION TENDONS TO 30 KIPS USING A CALIBRATED JACK OPERATED BY QUALIFIED PERSONNEL.
33. END DETAILS:
  - A. GROUT ANCHOR BOLTS INTO THE SLEEVES IN THE PRESTRESSED UNITS AT THE FIXED ENDS. BEFORE THE GROUT CURES, PLACE THE WASHER PLATE, AND INSTALL THE NUT ON TOP AND TIGHTEN.
  - B. PLACE THE COLD POURED JOINT SEALER IN THE SLEEVES IN THE PRESTRESSED UNITS AT THE EXPANSION ENDS. PLACE THE WASHER PLATE AND INSTALL THE NUT ON TOP. HAND TIGHTEN AND THEN LOOSEN 1/2 TURN.
  - C. GROUT OVER THE NUT AND BOLT IN THE ANCHOR BOLT BLOCK OUTS ON THE FIXED ENDS. FILL THE ANCHOR BOLT BLOCK OUTS ON THE EXPANSION ENDS WITH COLD POURED JOINT SEALER.
34. FINISH WORK: REMOVE WEDGES, AND PATCH SURFACE AND FASCIA BEAMS AT TRANSVERSE TENDONS.

**PILES**

35. THE PILES SHALL BE HP 12 X 53.
36. PILES SHALL BE DRIVEN TO A NOMINAL RESISTANCE OF 465 KIP. TO PREVENT DAMAGE TO THE PILES, PILE SHOES SHALL BE REQUIRED AND SHALL CONFORM TO SECTION 505.
37. FOR ESTIMATING PURPOSES, THE PILE TIP ELEVATIONS WERE ASSUMED AS SHOWN ON THE BORING LOGS. THE ACTUAL IN PLACE LENGTHS MAY VARY.
38. NO DYNAMIC LOAD TESTING IS REQUIRED FOR THIS PROJECT. THUS, PER SUBSECTION 505.04(C)(3) "THE ENGINEER WILL DETERMINE THE ULTIMATE CAPACITY BASED ON THE AGENCY'S WAVE EQUATION ANALYSIS". PER SUBSECTION 504.02(A) THE CONTRACTOR WILL STILL HAVE TO SUBMIT THE PILE AND DRIVING EQUIPMENT DATA FORM 14 DAYS PRIOR TO DRIVING.

**TRAFFIC CONTROL**

39. FOR ADDITIONAL SIGNING INSTRUCTIONS SEE STANDARDS E-100, E-100A, E-107, & E-107A.
40. THE CONTRACTOR WILL BE PERMITTED TO CLOSE THE BRIDGE TO TRAFFIC FOR THE FIRST 20 CALENDAR DAYS THAT THE PROJECT IS UNDER CONSTRUCTION. DURING THIS TIME, MENARD ROAD SHALL REMAIN OPEN TO VEHICULAR TRAFFIC WHEN THE CONTRACTOR IS NOT ON-SITE.
41. THE TRAFFIC CONTROL PLAN SHALL INCLUDE PROVISIONS TO ALLOW EMERGENCY VEHICLE ACCESS TO THE PROPERTIES ON MENARD ROAD WITHIN 15 MINUTES OF RECEIVING NOTICE THAT EMERGENCY VEHICLES ARE ON ROUTE OR FROM WHEN THE EMERGENCY VEHICLE ARRIVES ON SITE WITHOUT PRIOR NOTICE, EVEN DURING ANY BRIDGE CLOSURES. AN EXCEPTION, TO THE EMERGENCY VEHICLE PROVISION, SHALL BE ALLOWED FOR THE TIME WHEN THE EXISTING BRIDGE IS BEING REMOVED AND THE NEW SUPERSTRUCTURE IS BEING PLACED.
42. A SCHEDULE OF CLOSURE TIMES AND EXPECTED DURATIONS SHALL BE SUBMITTED TO THE RESIDENT ENGINEER, PROPERTY OWNERS AND EMERGENCY PERSONNEL 14 DAYS PRIOR TO ANY CLOSURES. THE RESIDENT ENGINEER SHALL HAVE 7 DAYS TO APPROVE THOSE TIMES.
43. ALL WORK ASSOCIATED WITH PROVIDING VEHICULAR ACCESS WHEN THE CONTRACTOR IS NOT ON-SITE AND PROVIDING EMERGENCY VEHICLE ACCESS SHALL BE INCIDENTAL TO ITEM 900.645 (TRAFFIC CONTROL, ALL-INCLUSIVE).
44. WORK OUTSIDE THE RIGHT OF WAY AND INSIDE THE TEMPORARY EASEMENT SHALL BE CONDITIONED UPON RESTORING THE PROPERTY TO ITS ORIGINAL CONDITION. THE COST FOR ANY RESTORATION SHALL BE INCLUDED IN THE BID PRICE FOR ITEM 900.645 (TRAFFIC CONTROL, ALL-INCLUSIVE).
45. THE CONTRACTOR SHALL REFER TO SECTION 900 - TRAFFIC CONTROL (ALL-INCLUSIVE) OF THE SPECIAL PROVISIONS FOR ADDITIONAL TRAFFIC CONTROL REQUIREMENTS.

PROJECT NAME:	BRAINTREE
PROJECT NUMBER:	BRO 1444(36)
FILE NAME:	s95J292gennot.e.dgn
PROJECT LEADER:	K. HIGGINS
DESIGNED BY:	T. FILLBACH
GENERAL NOTES	
PLOT DATE:	31-DEC-2009
DRAWN BY:	T. FILLBACH
CHECKED BY:	J. LACROIX
SHEET	3 OF 26


# QUANTITY SHEET 1

SUMMARY OF ESTIMATED QUANTITIES										TOTALS		DESCRIPTIONS				DETAILED SUMMARY OF QUANTITIES		
						ROADWAY	EROSION CONTROL	BRIDGE	FULL C.E. ITEMS	GRAND TOTAL	FINAL	UNIT	ITEMS	ITEM NUMBER	ROUND	QUANTITIES	UNIT	ITEMS
						1				1		LS	CLEARING AND GRUBBING, INCLUDING INDIVIDUAL TREES AND STUMPS	201.10				
						220				220		CY	COMMON EXCAVATION	203.15				
						1				1		CY	TRENCH EXCAVATION OF EARTH, EXPLORATORY (N.A.B.I.)	204.22				
								90		90		CY	STRUCTURE EXCAVATION	204.25				
								50		50		CY	GRANULAR BACKFILL FOR STRUCTURES	204.30				
						150				150		CY	SUBBASE OF CRUSHED GRAVEL, COARSE GRADED	301.25				
						40				40		CY	AGGREGATE SURFACE COURSE	401.10				
								1		1		LS	FURNISHING EQUIPMENT FOR DRIVING PILING	504.10				
								368		368		LF	STEEL PILING FOR INTEGRAL ABUTMENTS, HP 12 X 53	505.25				
								140		140		LF	PRESTRESSED CONCRETE BOX BEAMS (27 1/2" - 28 1/2" X 48")	510.21				
								140		140		LF	PRESTRESSED CONCRETE BOX BEAMS (28 1/2" - 29 1/2" X 48")	510.21				
								210		210		LF	GROUTING SHEAR KEYS	510.24				
								27		27		GAL	WATER REPELLENT, SILANE	514.10				
						1				1		LS	MAINTENANCE OF STRUCTURES AND APPROACHES	527.10				
						1				1		EACH	REMOVAL OF STRUCTURE (675 SF - EST.)	529.15				
								16		16		EACH	BEARING DEVICE ASSEMBLY, ELASTOMERIC PAD	531.11				
								1		1		LS	PRECAST CONCRETE STRUCTURE (ABUTMENT #1)	540.10				
								1		1		LS	PRECAST CONCRETE STRUCTURE (ABUTMENT #2)	540.10				
						1				1		MGAL	DUST CONTROL WITH WATER	609.10				
						70				70		CY	STONE FILL, TYPE II	613.11				
						162				162		LF	REMOVAL OF EXISTING FENCE	620.55				
						180				180		LF	HD STEEL BEAM GUARDRAIL, GALVANIZED W/8 FEET POSTS	621.215				
						4				4		EACH	ANCHOR FOR STEEL BEAM RAIL	621.60				
						143				143		LF	REMOVAL AND DISPOSAL OF GUARDRAIL	621.80				
									1	1		LS	FIELD OFFICE, ENGINEERS	631.10				
						1				1		LS	MOBILIZATION/DEMobilIZATION	635.11				
						60	70			130		SY	GEOTEXTILE UNDER STONE FILL	649.31				
							5			5		LB	SEED	651.15				
							5			5		LB	SEED, WINTER RYE	651.17				
							20			20		LB	FERTILIZER	651.18				
							0.1			0.1		TON	AGRICULTURAL LIMESTONE	651.20				
							0.25			0.25		TON	HAY MULCH	651.25				
							10			10		CY	TOPSOIL	651.35				
							70			70		SY	GRUBBING MATERIAL	651.40				
									1000	1000		DL	SPECIAL PROVISION (FIELD OFFICE TELEPHONE) (N.A.B.I.)	900.615				
							50			50		HR	SPECIAL PROVISION (MONITORING EPSC PLAN)	900.630				
								150		150		LF	SPECIAL PROVISION (BRIDGE RAILING, GALVANIZED HDSB/FASCIA MOUNTED/STEEL TUBING)	900.640				
							1			1		LS	SPECIAL PROVISION (EPSC PLAN)	900.645				
						1				1		LS	SPECIAL PROVISION (TRAFFIC CONTROL, ALL-INCLUSIVE)	900.645				

PROJECT NAME: BRAINTREE  
PROJECT NUMBER: BRO 1444(36)  
FILE NAME: s95j292exqfy.dgn  
PROJECT LEADER: K. HIGGINS  
DESIGNED BY: T. FILLBACH  
QUANTITY SHEET

PLOT DATE: 14-JAN-2010  
DRAWN BY: K. PATTERSON  
CHECKED BY: T. FILLBACH  
SHEET 4 OF 26



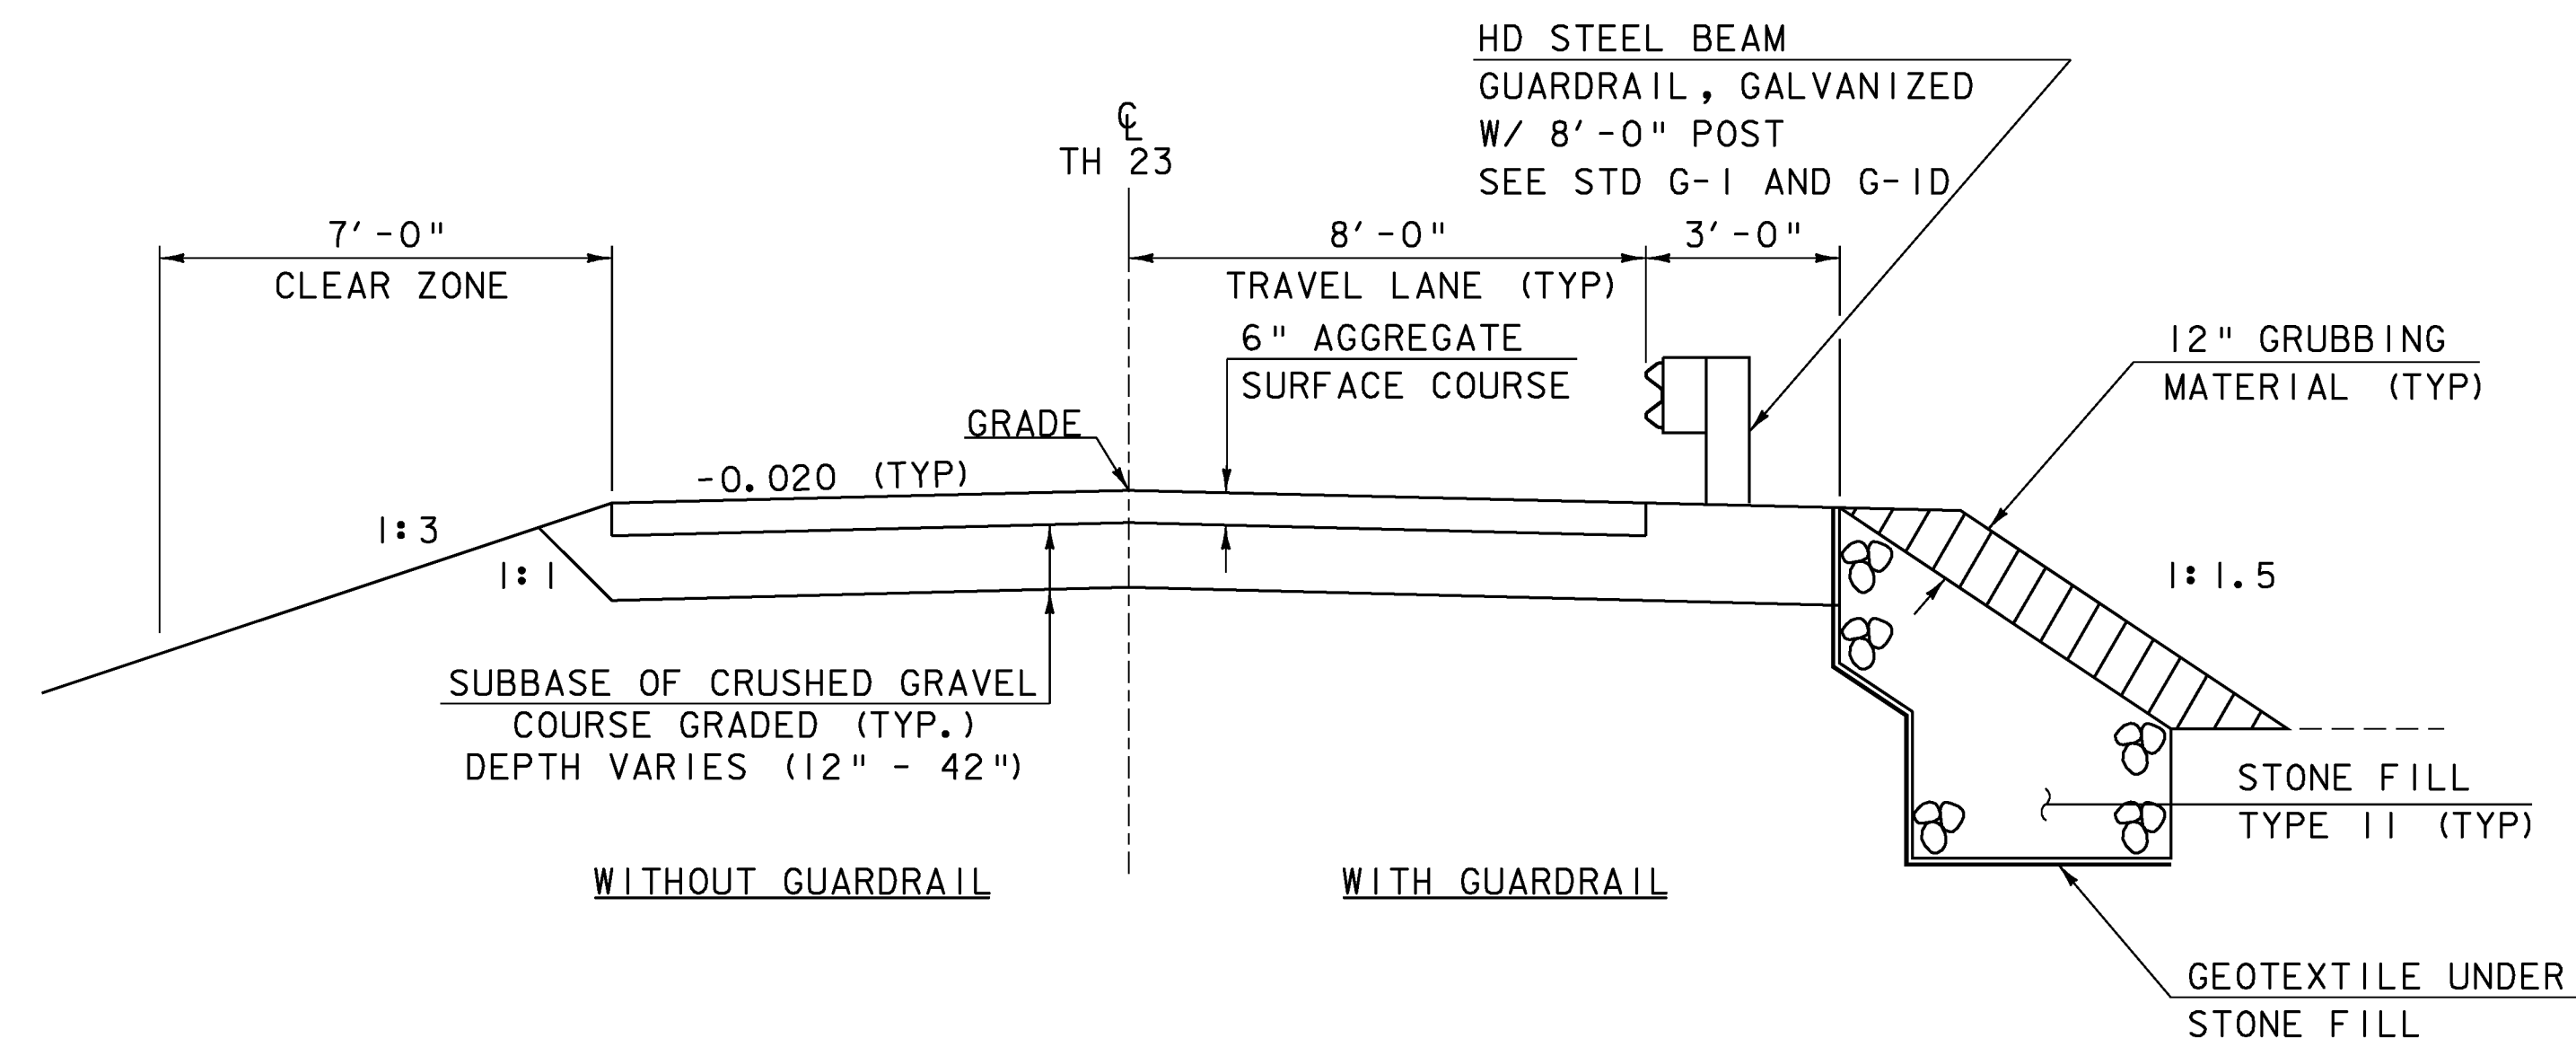


TH 23 TYPICAL SECTION

SCALE 3/8" = 1'-0"  
 1 0 1 2 3 4


MATERIAL TOLERANCES  
 (IF USED ON PROJECT)

SURFACE	
- PAVEMENT	+/- 1/4"
- AGGREGATE SURFACE COURSE	+/- 1/2"
BASE COURSE	+/- 1/2"
SUBBASE	+/- 1"
SAND BORROW	+/- 1"
GRANULAR BORROW	+/- 1"

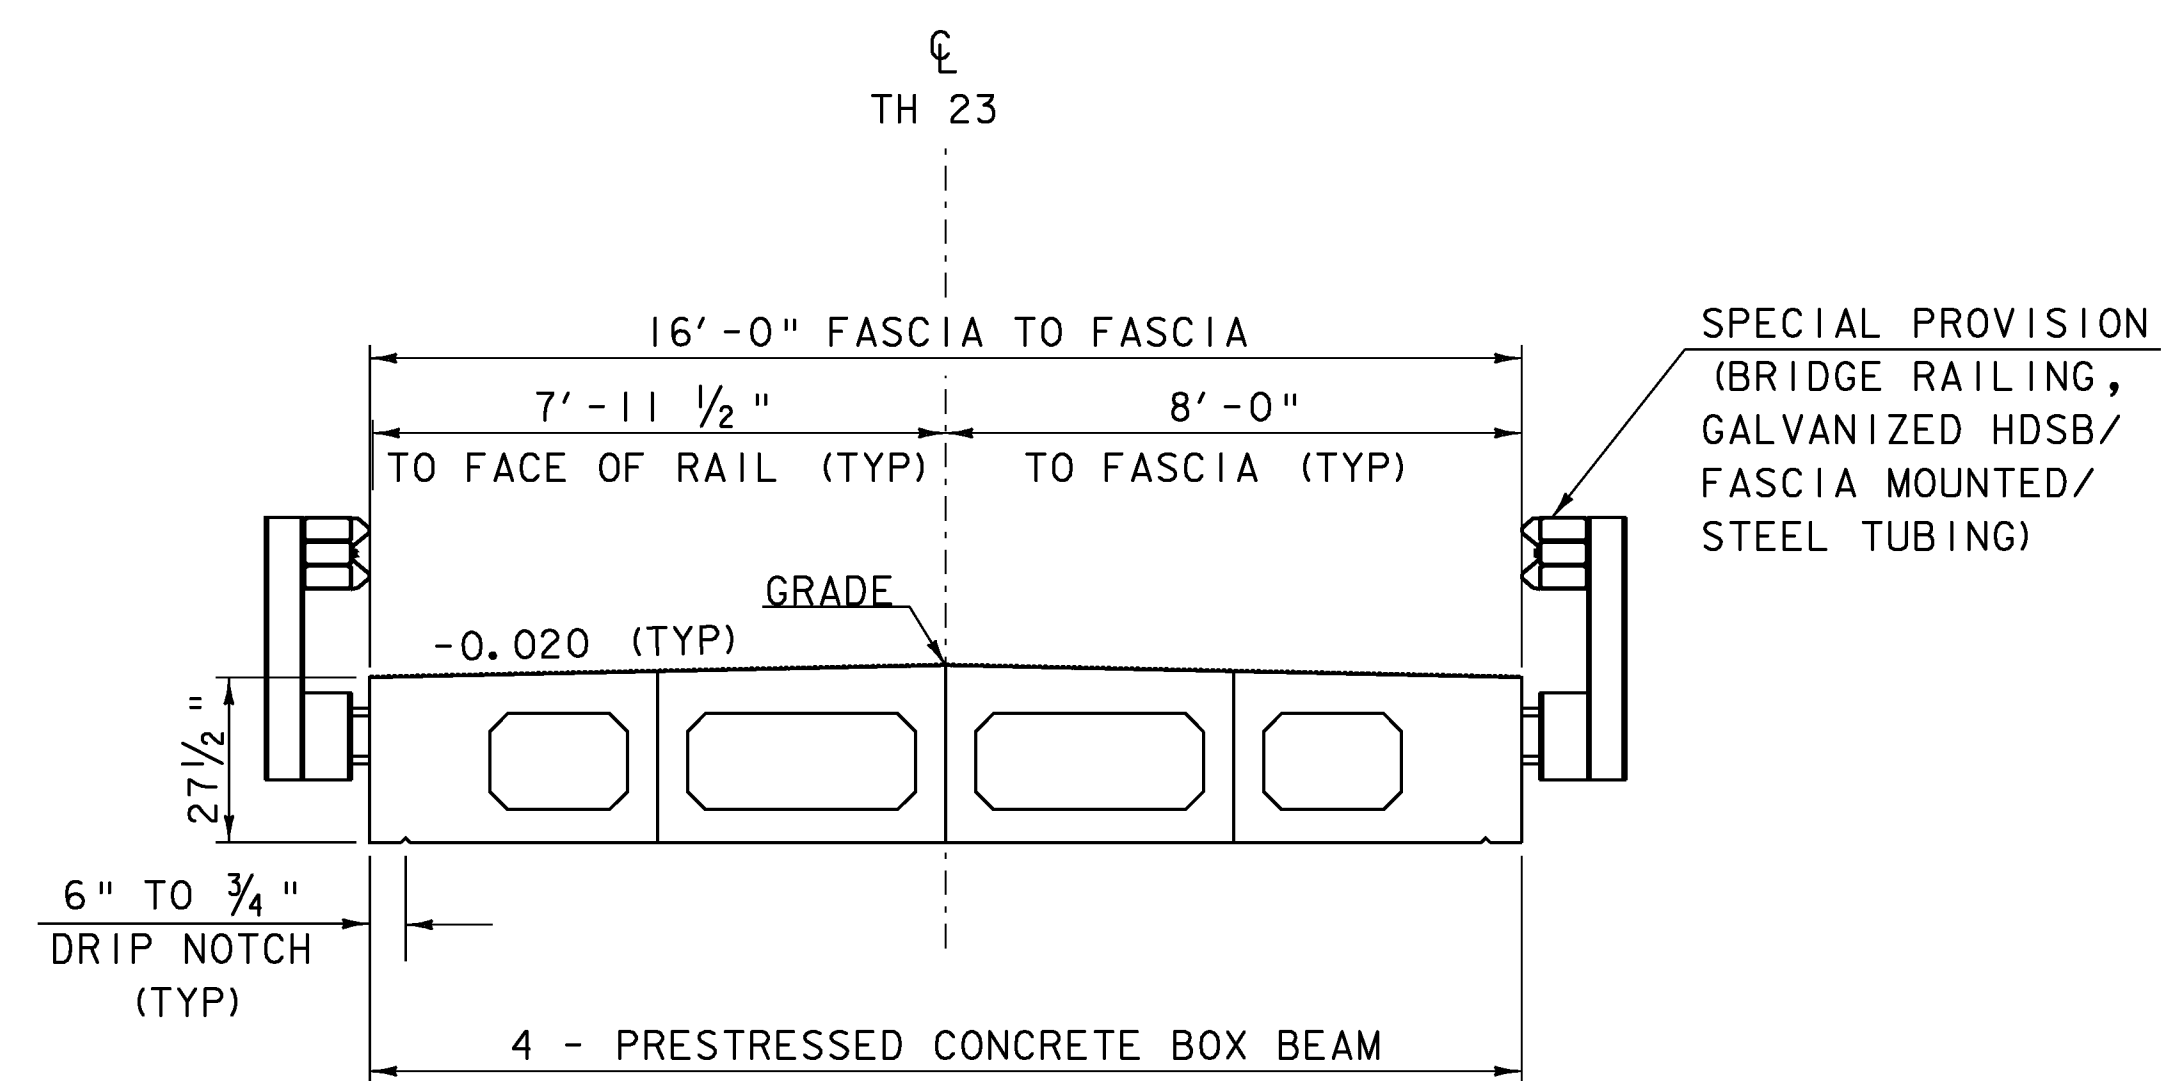

BRIDGE TYPICAL SECTION

SCALE 3/8" = 1'-0"  
 1 0 1 2 3 4

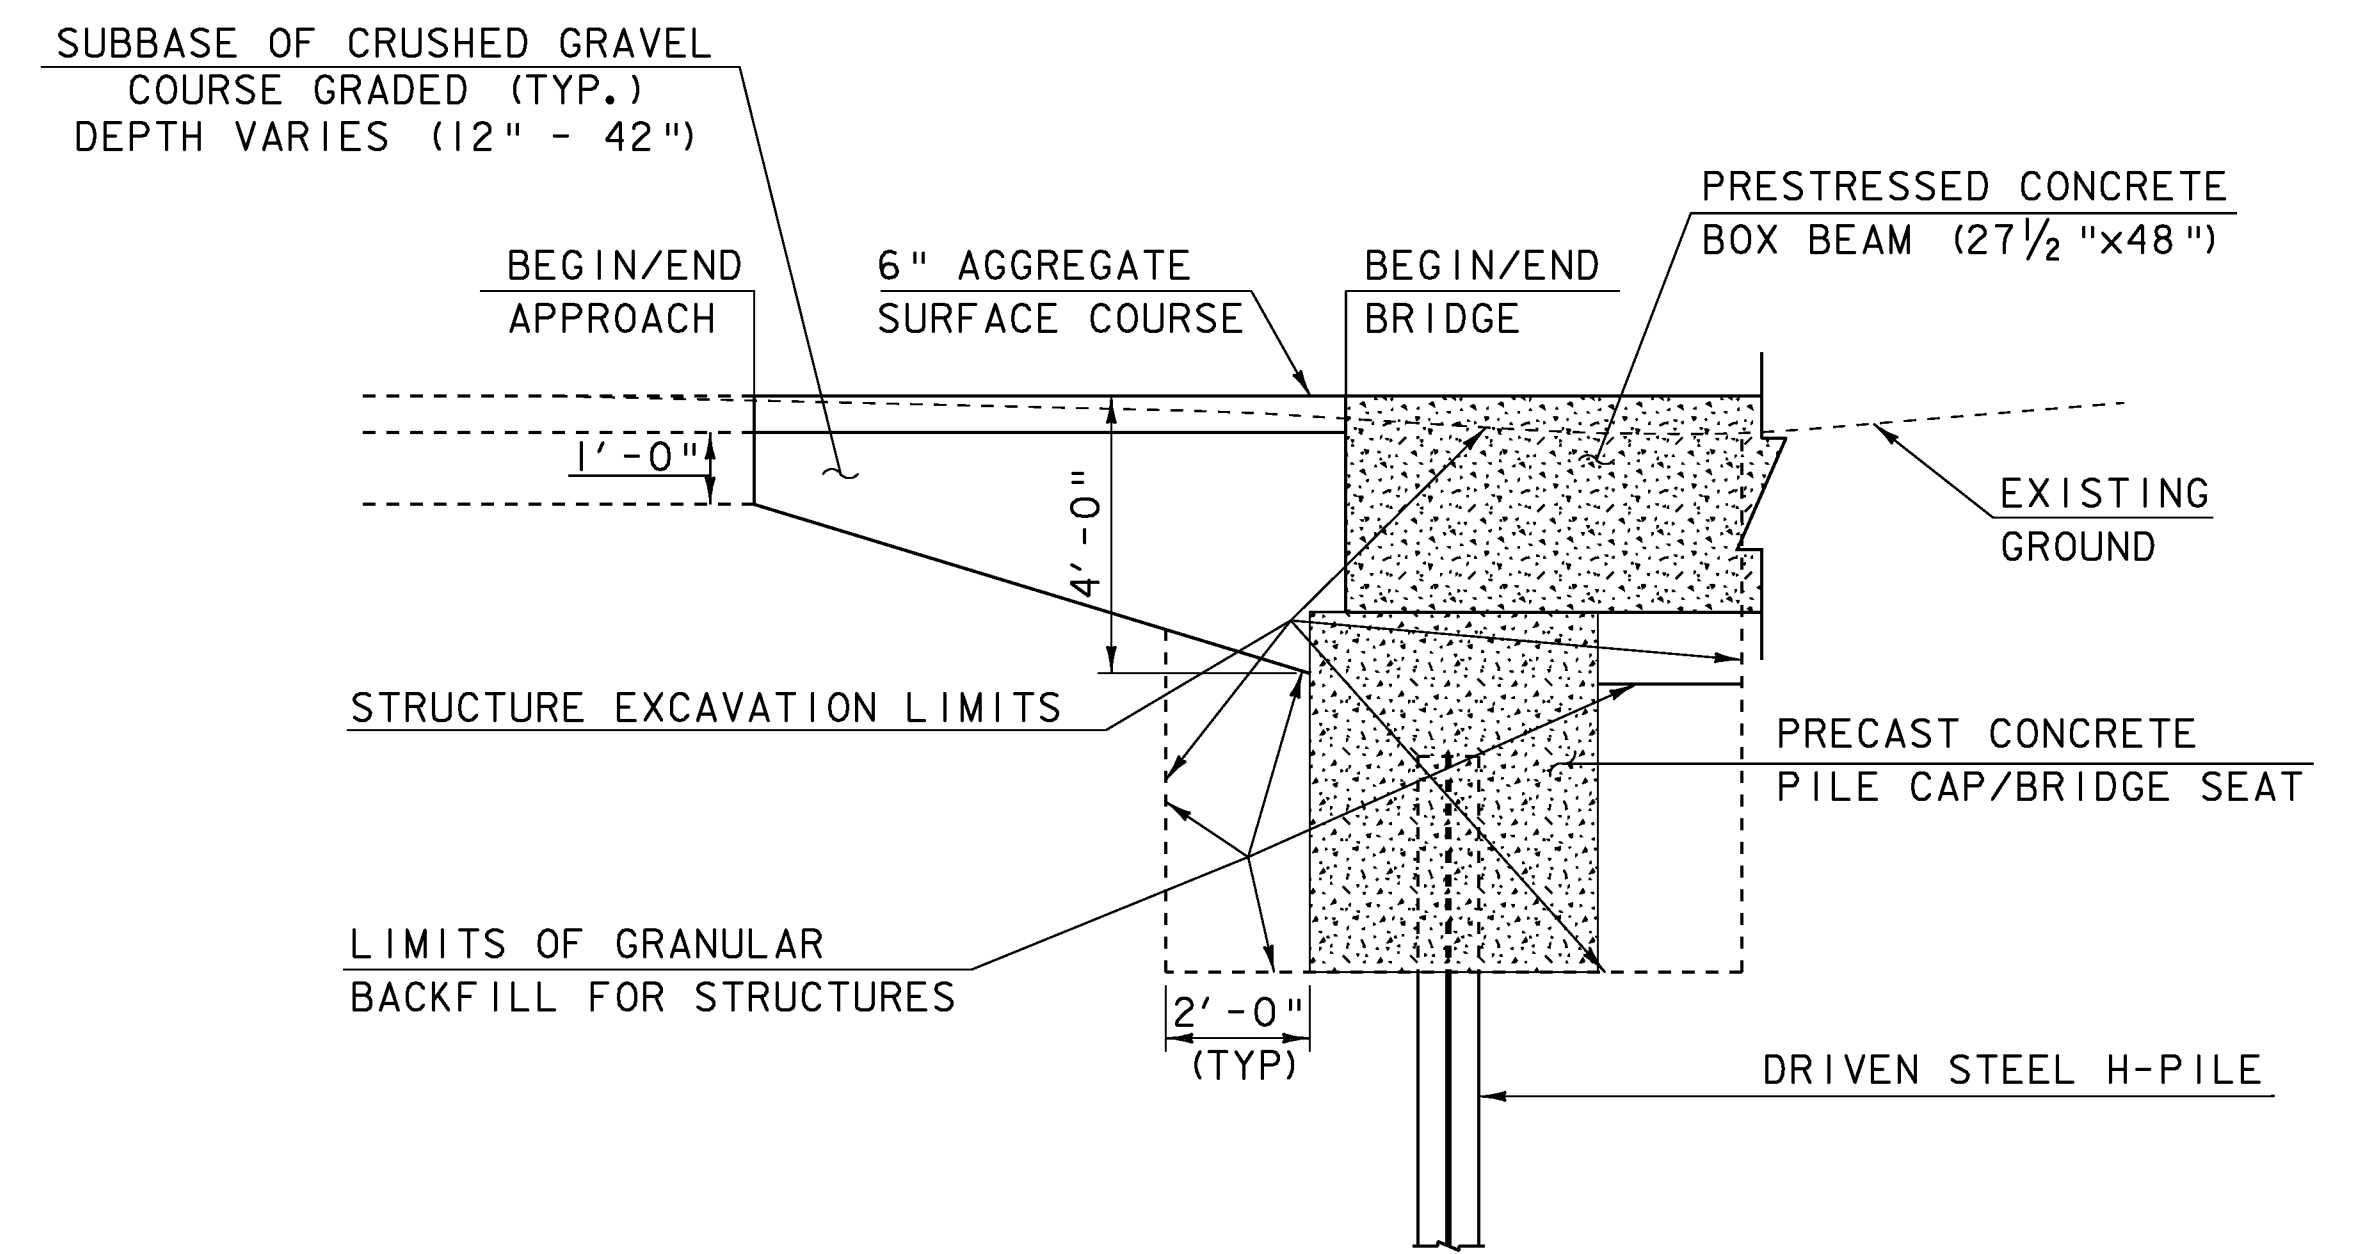

END BRIDGE TYPICAL SECTION

SCALE 3/8" = 1'-0"  
 1 0 1 2 3 4

PROJECT NAME:	BRAINTREE
PROJECT NUMBER:	BRO 1444(36)
FILE NAME:	s95J292typ.dgn
PROJECT LEADER:	K. HIGGINS
DESIGNED BY:	T. FILLBACH
TYPICAL SECTIONS	
PLOT DATE:	14-JAN-2010
DRAWN BY:	T. FILLBACH
CHECKED BY:	R. PELLETT
SHEET	6 OF 26

GPS CONTROL POINTS

HVCTRL #1

SNOWSVILLE AZ MK  
 NORTH = 548570.766  
 EAST = 1599864.917  
 ELEV. = 781.69



DESCRIBED BY VERMONT AGENCY OF TRANSPORTATION 1996 (DJM) GENERAL LOCATION - THE STATION IS LOCATED IN THE TOWN OF EAST BRAINTREE, 0.6 MI (1.0 KM) NORTH OF EAST BRAINTREE VILLAGE, 5.8 MI (9.3 KM) NORTH NORTHEAST OF RANDOLPH, AND 11.3 MI (18.2 KM) SOUTH OF NORTHFIELD. TO REACH FROM THE JUNCTION OF VERMONT ROUTE 12 AND VERMONT ROUTE 66 IN RANDOLPH, PROCEED NORTHERLY ALONG ROUTE 12 FOR 5.7 MI (9.2 KM) TO THE MARK ON THE RIGHT. TO REACH FROM THE JUNCTION OF VERMONT ROUTE 12 AND THE ROAD TO WEST BROOKFIELD, PROCEED SOUTH ALONG ROUTE 12 FOR 0.75 MI (1.21 KM) TO THE MARK ON THE LEFT. THE MARK IS A STATE OF VERMONT SURVEY DISK SET IN THE TOP OF A CONCRETE MONUMENT 30 CM IN DIAMETER, FLUSH WITH THE GROUND SURFACE. IT IS LOCATED 141 FT (43.0 M) NORTH NORTHEAST OF UTILITY POLE 136/19, 129 FT (39.3 M) SOUTH OF A SIGN (BRAINTREE / BROOKFIELD), 60.5 FT (18.4 M) SOUTH OF A MAILBOX, 22 FT (6.7 M) SOUTHEAST OF THE CENTERLINE OF VERMONT ROUTE 12, AND 3 FT (0.9 M) NORTHWEST OF A FIBERGLASS WITNESS POST. OWNERSHIP IS THE STATE OF VERMONT.

HVCTRL #2

SNOWSVILLE  
 NORTH = 546460.357  
 EAST = 1600026.324  
 ELEV. = 753.84

EAST BRAINTREE VILLAGE, 5.3 MI (8.5 KM) NORTH NORTHEAST OF RANDOLPH, AND 11.8 MI (19.0 KM) SOUTH OF NORTHFIELD. TO REACH FROM THE JUNCTION OF VERMONT ROUTE 66 AND VERMONT ROUTE 12 IN RANDOLPH, PROCEED NORTHERLY ALONG ROUTE 12 FOR 5.3 MI (8.5 KM) TO THE MARK ON THE RIGHT. TO REACH FROM THE JUNCTION OF VERMONT ROUTE 12 AND THE ROAD TO WEST BROOKFIELD, PROCEED 1.15 MI (1.85 KM) SOUTH ALONG ROUTE 12 TO THE MARK ON THE LEFT. THE MARK IS A STATE OF VERMONT SURVEY DISK SET IN THE TOP OF A CONCRETE MONUMENT 30 CM IN DIAMETER, FLUSH WITH THE GROUND SURFACE. IT IS LOCATED 130 FT (39.6 M) NORTH OF A HIGHWAY SIGN (EAST BRAINTREE), 68.5 FT (20.9 M) SOUTH SOUTHEAST OF UTILITY POLE 13 1/2 / 130X, 36.5 FT (11.1 M) SOUTHWEST OF HIGHWAY SIGN (REDUCED SPEED AHEAD), 17.5 FT (5.3 M) EAST OF THE CENTERLINE OF VERMONT ROUTE 12, 5 FT (1.5 M) WEST OF A WOODEN FENCE, AND 3 FT (0.9 M) WEST OF A FIBERGLASS WITNESS POST. OWNERSHIP IS THE STATE OF VERMONT

TRAVERSE TIES

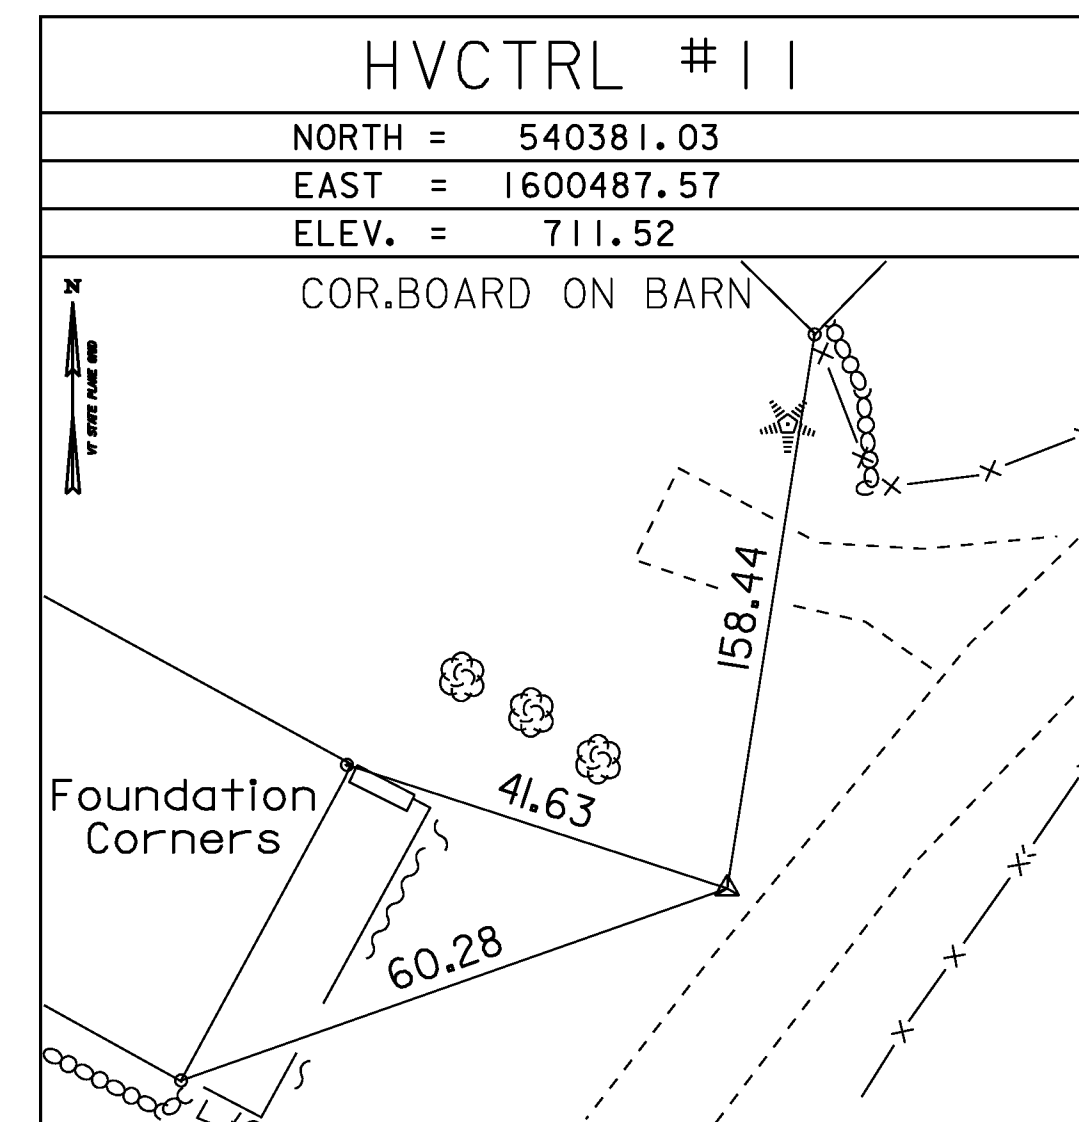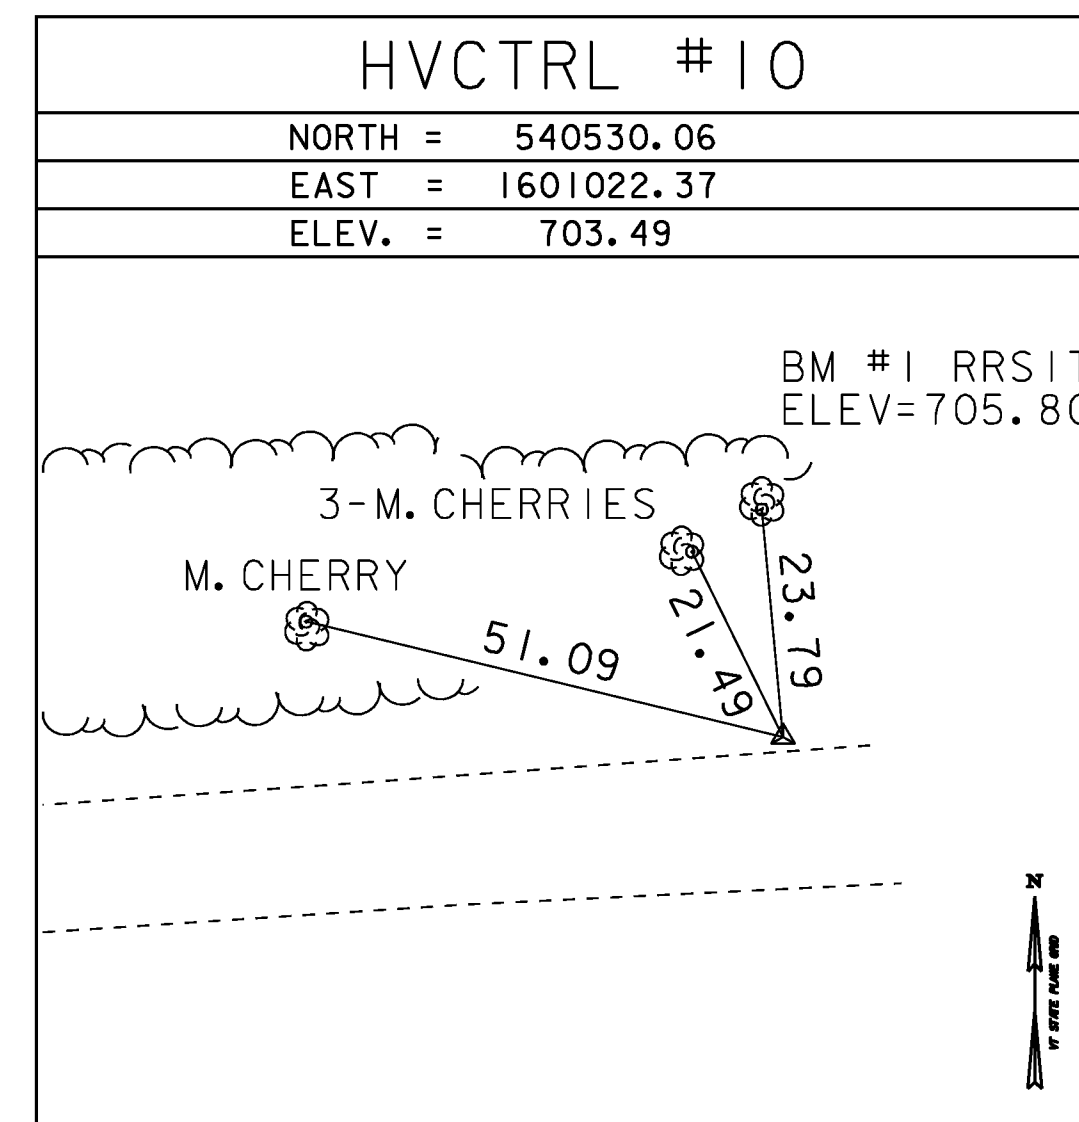

NORTH =
EAST =
ELEV. =

NORTH =
EAST =
ELEV. =

NORTH =
EAST =
ELEV. =

\* Main Traverse Completed 10/03/06 by R.Gilman P.C. & R.Moreau

ALIGNMENT TIES

NORTH =
EAST =
ELEV. =

NORTH =
EAST =
ELEV. =

DATUM  
 VERTICAL NAVD 88  
 HORIZONTAL NAD 83 (92)  
 ADJUSTMENT Compass

PROJECT NAME: Braintree  
 PROJECT NUMBER: BRO 1444 (36)  
 FILE NAME: survey\x95j292+1.dgn PLOT DATE: 31-DEC-2009  
 PROJECT LEADER: K. HIGGINS DRAWN BY: R. Bullock  
 DESIGNED BY: SURVEY CHECKED BY: SURVEY  
 TIE SHEET SHEET 7 OF 26

**CURVE #1**

DELTA = 24°55'00"  
 D = 28°38'52"  
 R = 200.00'  
 T = 44.19'  
 L = 86.98'  
 E = 4.82'

**CURVE #2**

DELTA = 14°02'00"  
 D = 19°05'55"  
 R = 300.00'  
 T = 36.92'  
 L = 73.48'  
 E = 2.26'

**REMOVAL AND DISPOSAL OF GUARDRAIL**

STA 11+04.3 - 11+38.8 LT  
 STA 11+07.0 - 11+37.4 RT  
 STA 11+80.1 - 12+17.8 LT  
 STA 11+80.3 - 12+18.9 RT

**REMOVAL OF EXISTING FENCE**

STA 10+50.0 - 11+25.0 RT  
 STA 10+75.0 - 11+00.0 LT

**SPECIAL PROVISION (BRIDGE RAILING/ GALVANIZED HDSB/ FASCIA MOUNTED/STEEL TUBING)**

STA 11+17.5 - 11+92.5 LT  
 STA 11+17.5 - 11+92.5 RT

**HD STEEL BEAM GUARDRAIL, GALVANIZED W/8 FEET POSTS**

STA 10+82.3 - 11+17.5 LT  
 STA 10+77.3 - 11+17.5 RT  
 STA 11+92.5 - 12+28.0 LT  
 STA 11+92.5 - 12+31.4 RT

**ANCHOR FOR STEEL BEAM RAIL**


STA 10+88.0 RT  
 STA 10+84.7 LT  
 STA 12+22.3 RT  
 STA 12+24.9 LT

**SPECIAL PROVISION (RETAINING WALL)**

STA 11+88.7 - 12+00.2 LT

**STONE FILL TYPE II**

STA 10+81.0 - 11+20.0 RT  
 STA 11+90.0 - 12+30.0 RT

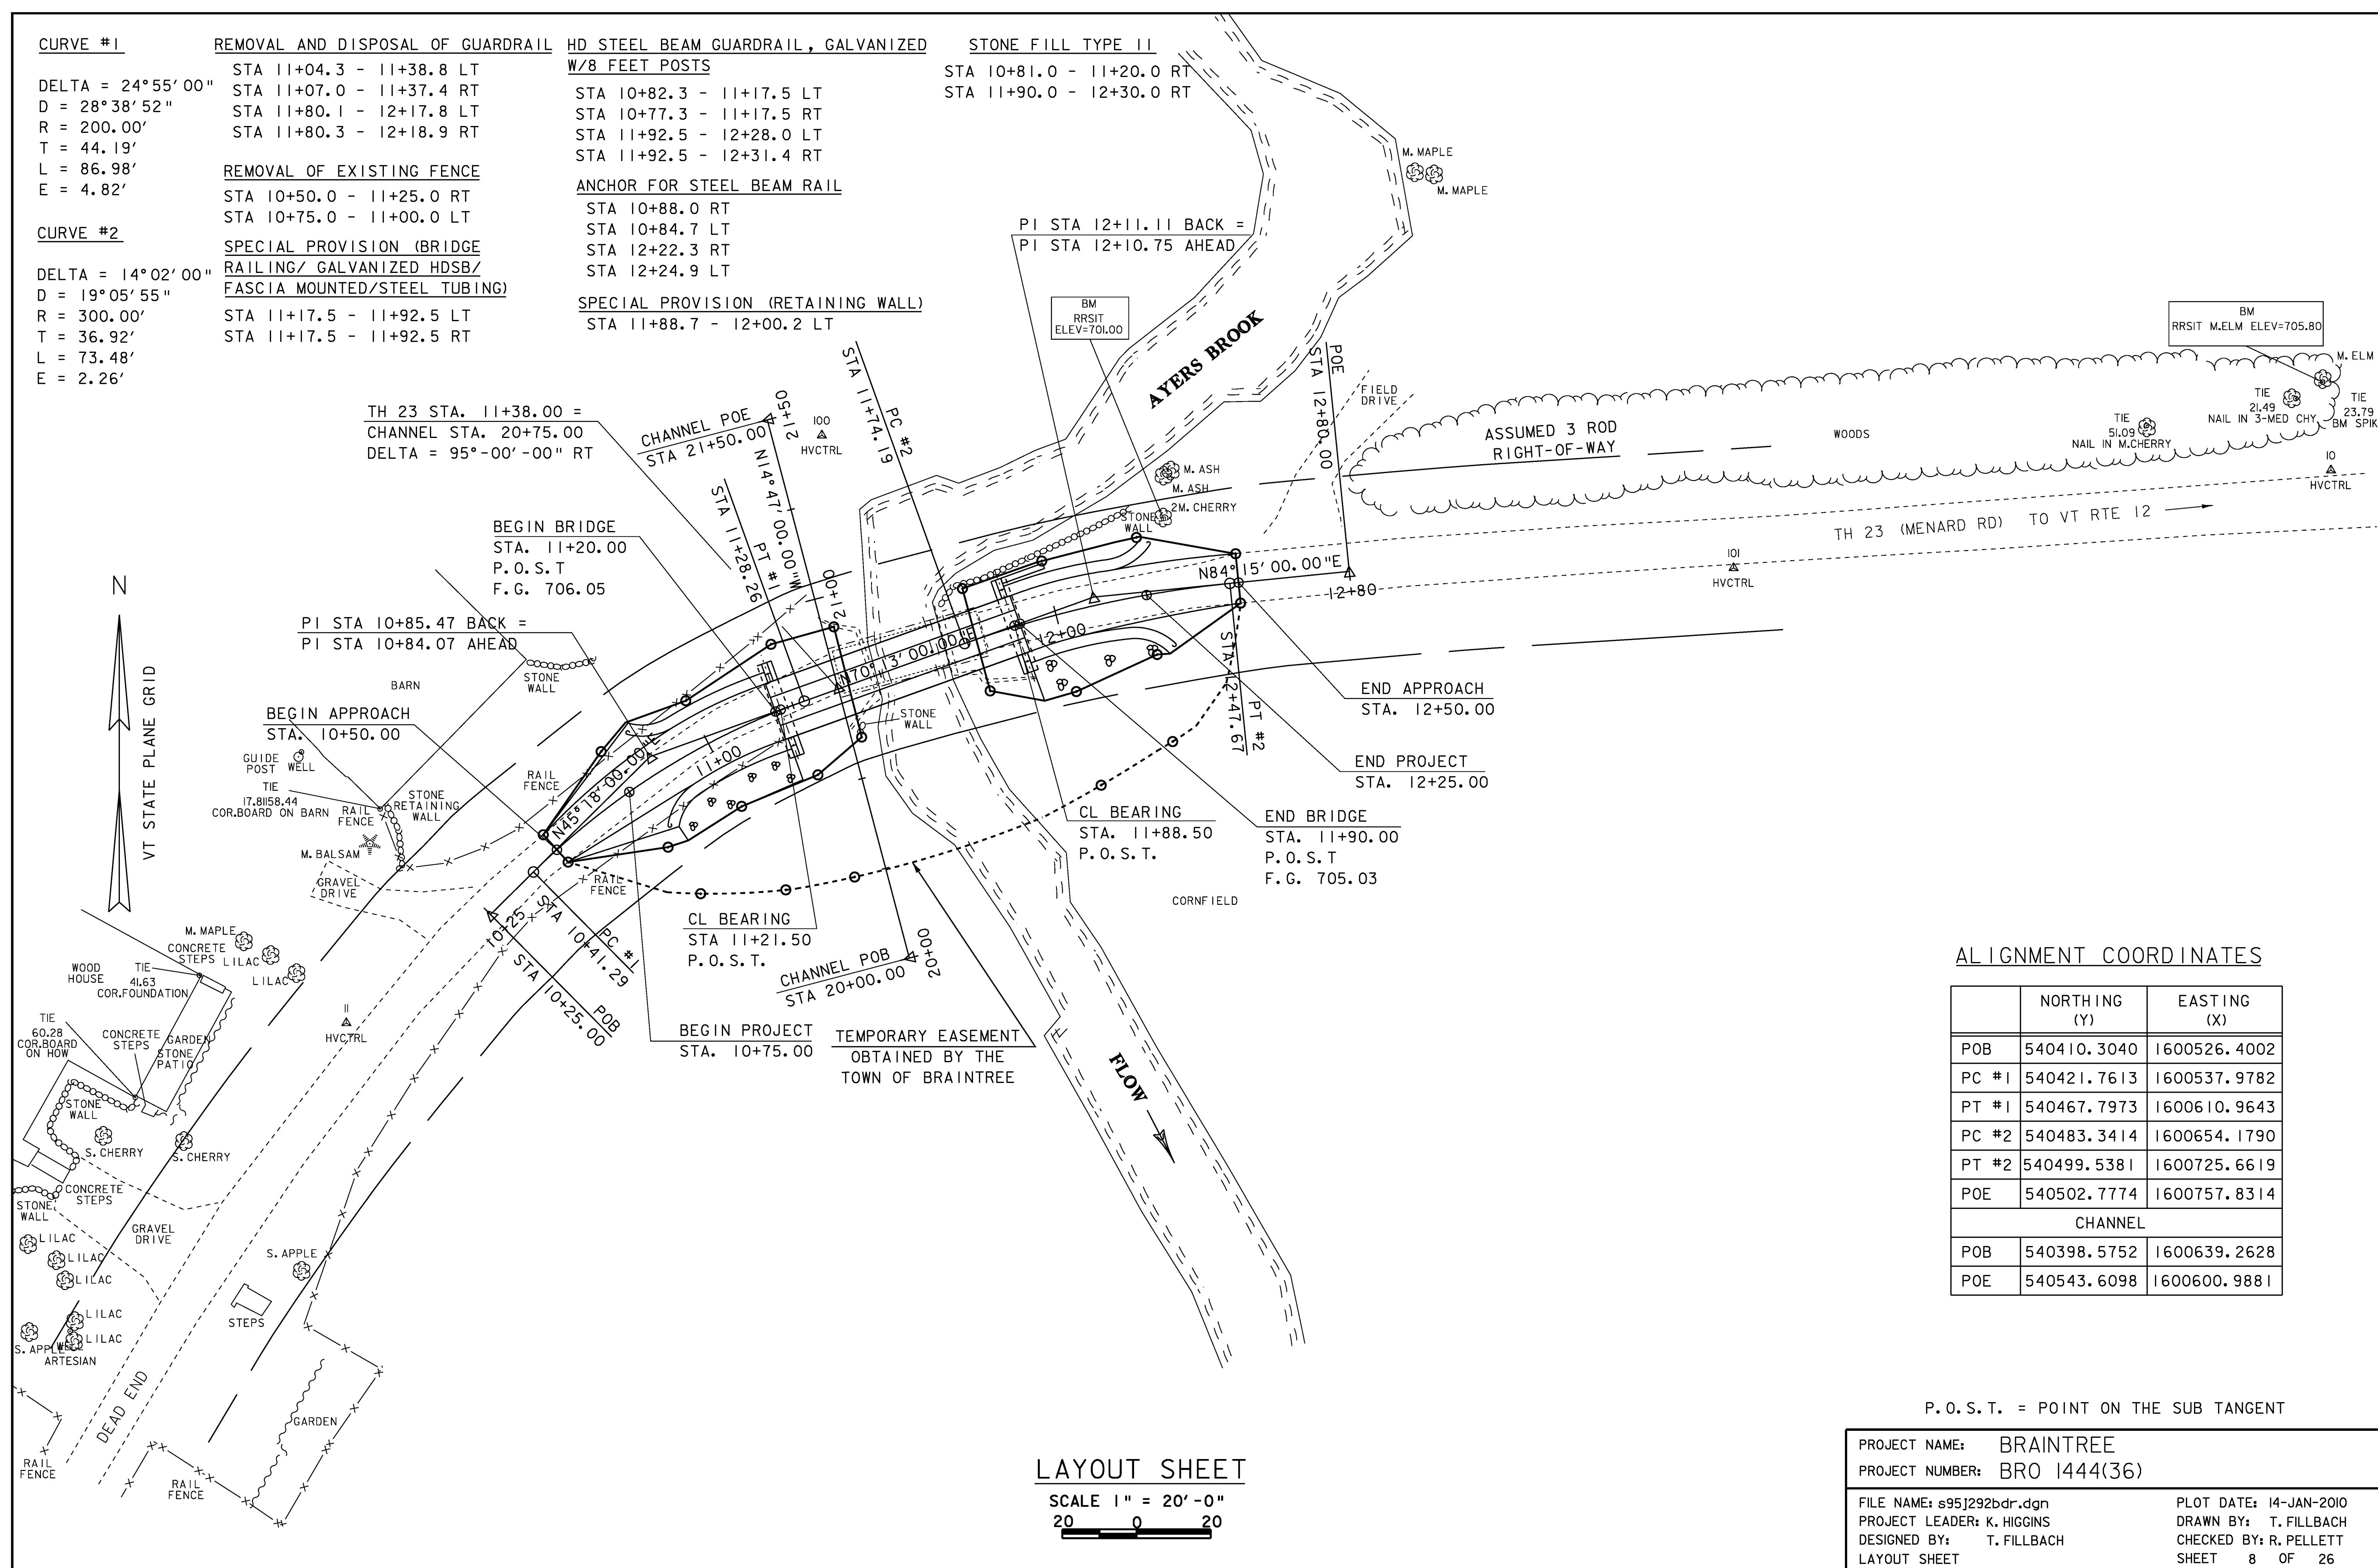

TH 23 STA. 11+38.00 =  
 CHANNEL STA. 20+75.00  
 DELTA = 95°-00'-00" RT

BEGIN BRIDGE  
 STA. 11+20.00  
 P. O. S. T  
 F. G. 706.05

BEGIN APPROACH  
 STA. 10+50.00

PI STA 10+85.47 BACK =  
 PI STA 10+84.07 AHEAD

END APPROACH  
 STA. 12+50.00

END PROJECT  
 STA. 12+25.00

CL BEARING  
 STA. 11+88.50  
 P. O. S. T.

END BRIDGE  
 STA. 11+90.00  
 P. O. S. T  
 F. G. 705.03

CL BEARING  
 STA 11+21.50  
 P. O. S. T.

BEGIN PROJECT  
 STA. 10+75.00

CHANNEL POB  
 STA 20+00.00

**ALIGNMENT COORDINATES**

	NORTHING (Y)	EASTING (X)
POB	540410.3040	1600526.4002
PC #1	540421.7613	1600537.9782
PT #1	540467.7973	1600610.9643
PC #2	540483.3414	1600654.1790
PT #2	540499.5381	1600725.6619
POE	540502.7774	1600757.8314
CHANNEL		
POB	540398.5752	1600639.2628
POE	540543.6098	1600600.9881



P. O. S. T. = POINT ON THE SUB TANGENT

**LAYOUT SHEET**

SCALE 1" = 20'-0"  
 20 0 20

PROJECT NAME:	BRAINTREE	PLOT DATE:	14-JAN-2010
PROJECT NUMBER:	BRO 1444(36)	DRAWN BY:	T. FILLBACH
FILE NAME:	s95j292bdr.dgn	CHECKED BY:	R. PELLETT
PROJECT LEADER:	K. HIGGINS	LAYOUT SHEET	SHEET 8 OF 26

# TH 23 (MENARD ROAD)

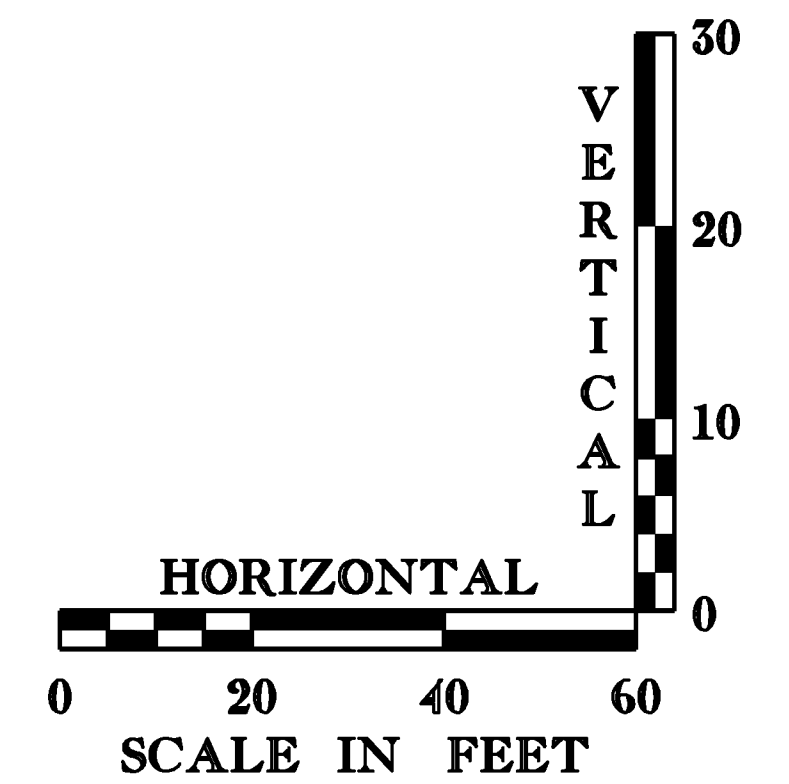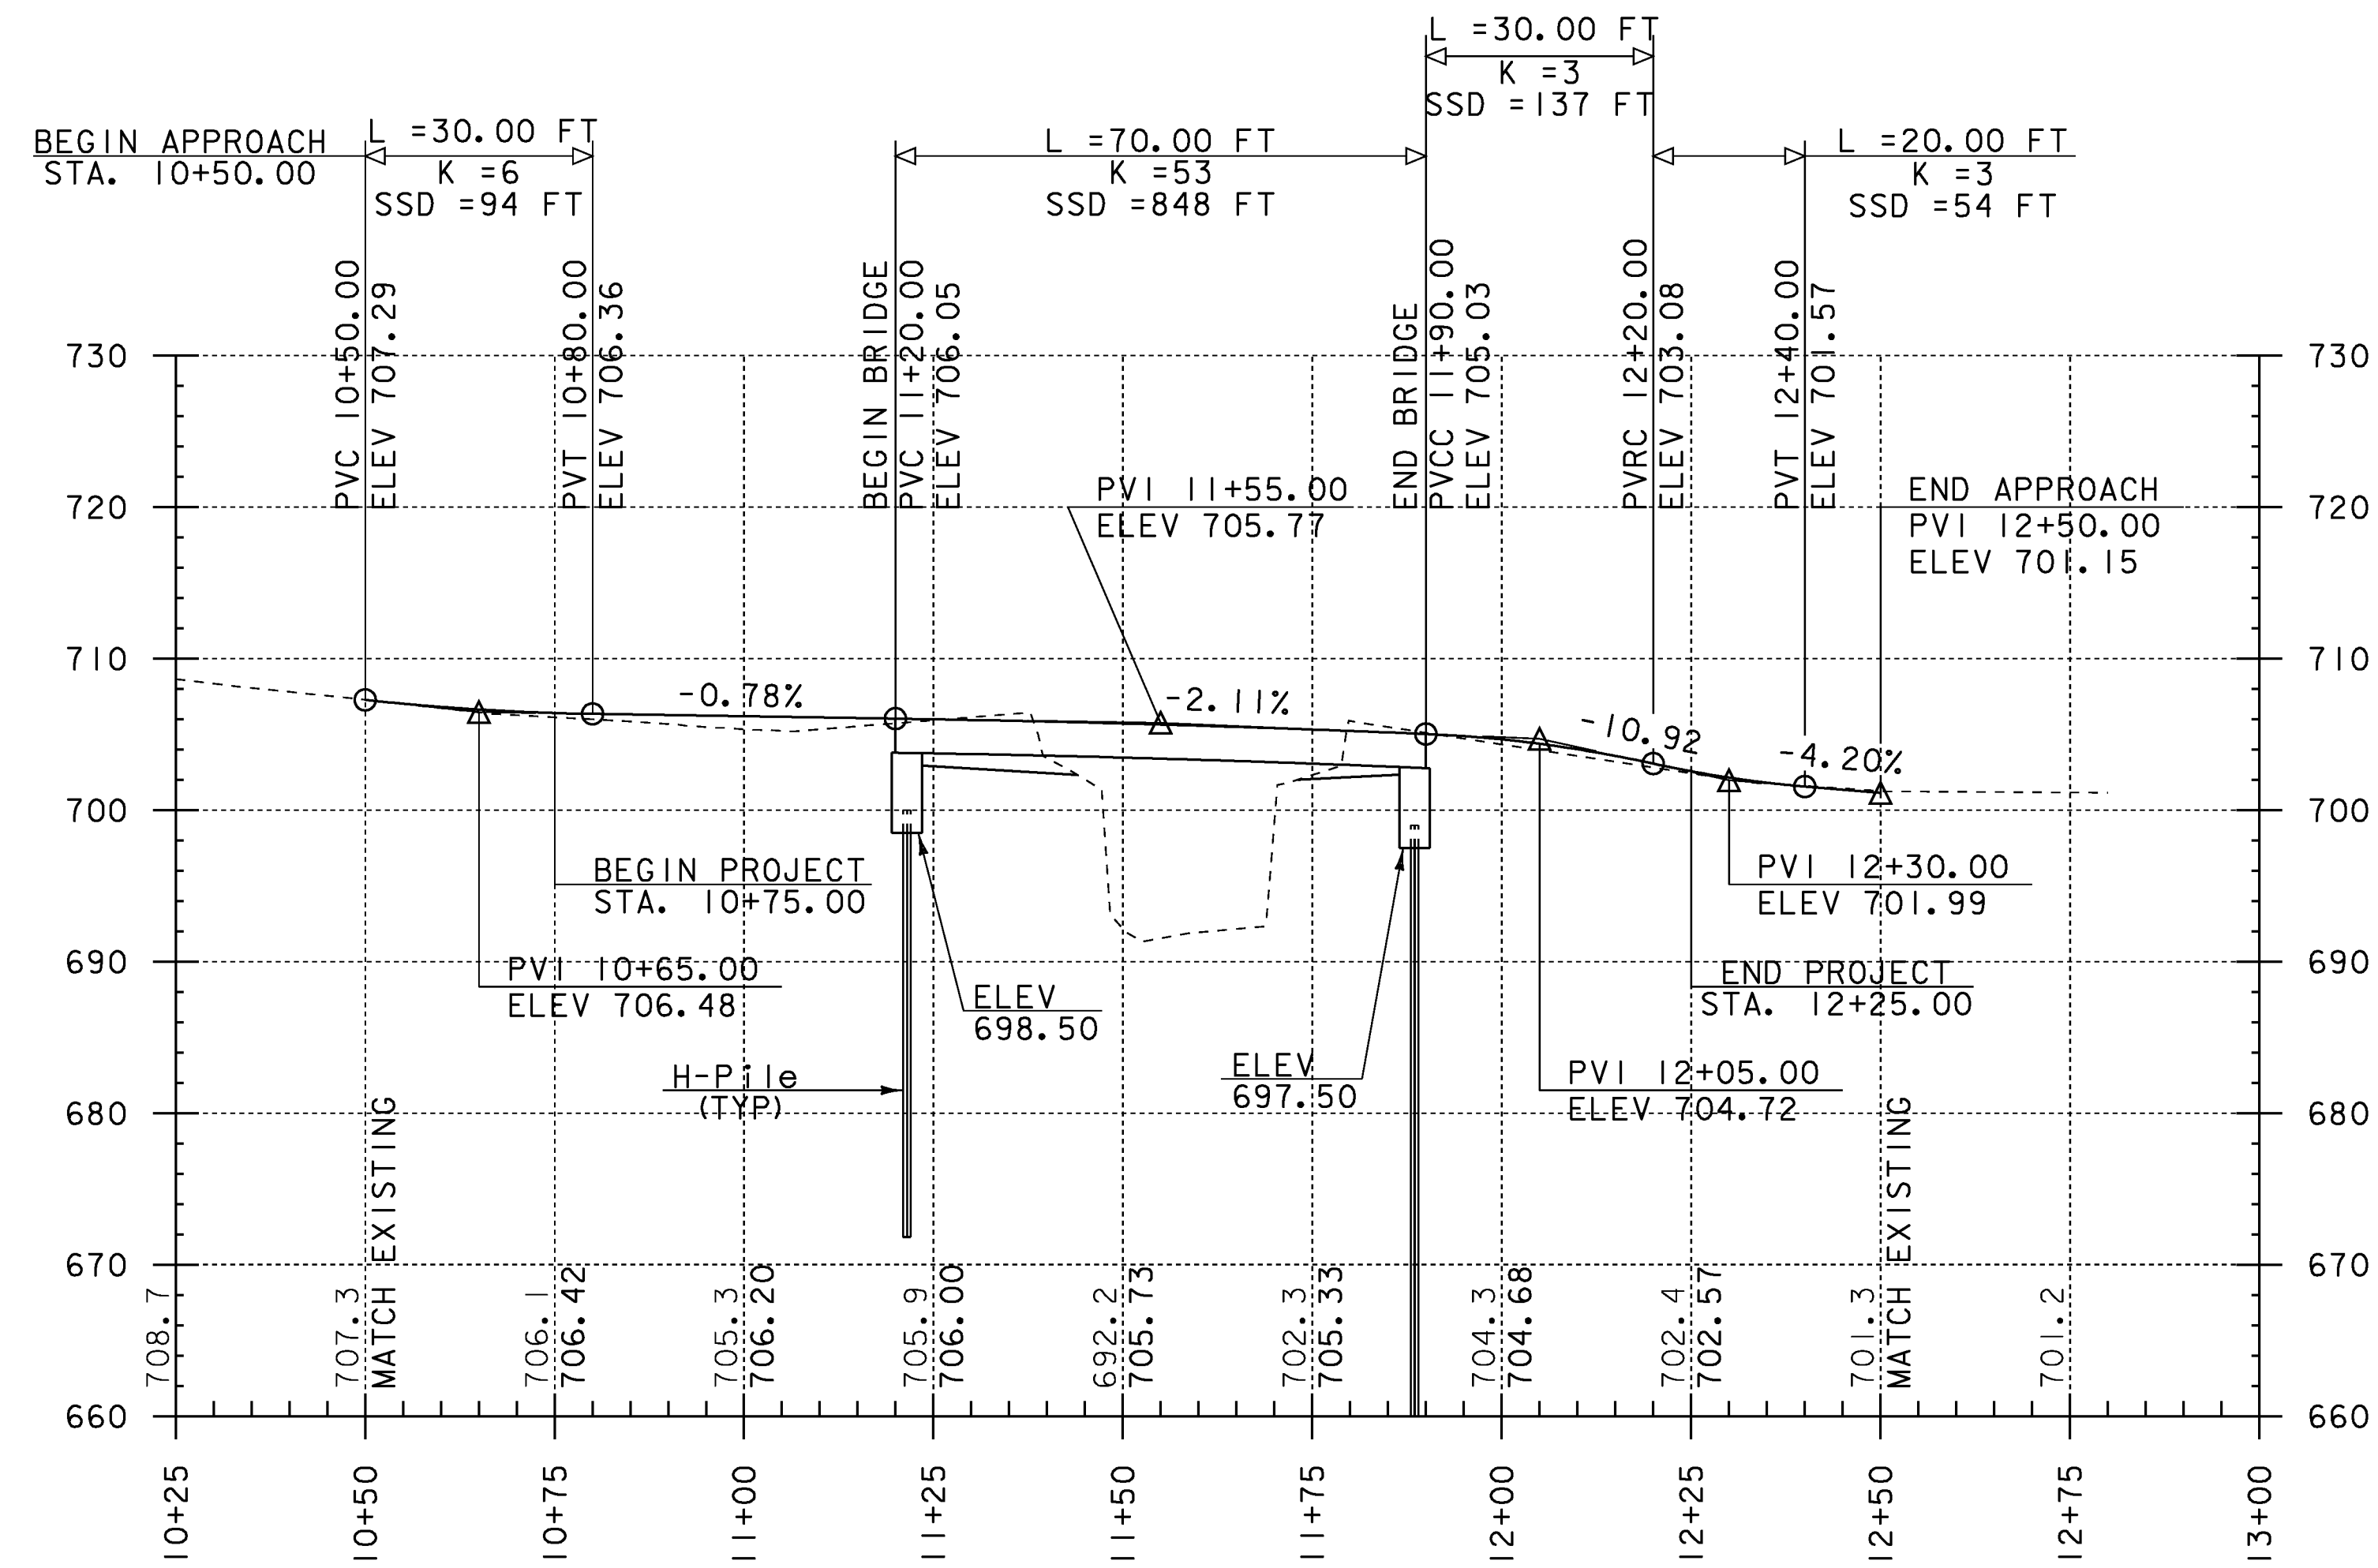

THE GRADES SHOWN TO THE NEAREST TENTH ARE THE ORIGINAL GROUND ELEVATIONS ALONG THE PROPOSED ALIGNMENT.

THE GRADES SHOWN TO THE NEAREST HUNDREDTH ARE THE FINISH GRADES ALONG THE PROPOSED ALIGNMENT.

SEE CROSS SECTIONS FOR MATERIAL TRANSITION INFORMATION.

PROJECT NAME:	BRAINTREE	PLOT DATE:	31-DEC-2009
PROJECT NUMBER:	BRO 1444(36)	DRAWN BY:	K. PATTERSON
FILE NAME:	s95j292pro.dgn	DESIGNED BY:	T. FILLBACH
PROFILE SHEET		CHECKED BY:	T. FILLBACH
		SHEET	9 OF 26

## **EPSC PLAN NARRATIVE**

### **1.1 PROJECT DESCRIPTION**

THIS PROJECT INVOLVES THE REPLACEMENT OF BRIDGE 12 ON TH 23. THE NEW STRUCTURE WILL BE 70 FEET IN LENGTH AND BE SET ON PILES AND PRECAST CONCRETE PILE CAPS OVER AYERS BROOK. THIS PROJECT IS LOCATED IN THE TOWN OF BRAINTREE.

NOTE: AREA OF DISTURBANCE INCLUDES LIMITS OF EARTH DISTURBANCE WITHIN THE PROJECT AREA, AS WELL AS WASTE, BORROW AND STAGING AREAS, AND OTHER EARTH DISTURBING ACTIVITIES WITHIN OR DIRECTLY ADJACENT TO THE PROJECT LIMITS AS SHOWN ON THE ATTACHED EPSC PLAN.

TOTAL AREA OF DISTURBANCE AS SHOWN ON THE ATTACHED EPSC PLAN IS APPROXIMATELY 0.15 ACRES.

IT IS ANTICIPATED THAT THIS PROJECT WILL LAST ONE CONSTRUCTION SEASON.

### **1.2 SITE INVENTORY**

#### **1.2.1 TOPOGRAPHY**

THE TOPOGRAPHY OF THE AREA IS A SADDLE THAT IS MOSTLY OPEN FIELDS AND PASTURES WITH SOME FORESTED AREA. MENARD RD IS IN THE PROJECT SITE. THERE IS A RESIDENCE ON THE WEST SIDE OF THE PROJECT WITH A SMALL FARM.

#### **1.2.2 DRAINAGE, WATERWAYS, BODIES OF WATER, AND PROXIMITY TO NATURAL OR MAN-MADE WATER FEATURES**

THE AYERS BROOK IS THE ONLY WATER SOURCE ON THE PROJECT SITE. THE BROOK IS CLASSIFIED AS INCISED WITH UNSTABLE STREAM BANKS. THE STREAM BEDS ARE SAND, GRAVEL AND COBBLES.

#### **1.2.3 VEGETATION**

THE VEGETATION IN THE PROJECT AREA CONSISTS OF HARDWOOD TREES AND UNDERGROWTH TO THE NORTHWEST AND OPEN FIELDS TO THE SOUTH AND EAST. THE IMPACT TO VEGETATION WILL BE LIMITED TO THAT WHICH IS DIRECTLY AFFECTED BY REPLACEMENT OF THE BRIDGE. DISTURBED VEGETATION WILL BE RE-ESTABLISHED WITH STANDARD SEED AND MULCH PRACTICES.

#### **1.2.4 SOILS**

ALL SOIL DATA CAME FROM THE U.S. DEPARTMENT OF AGRICULTURE SOIL CONSERVATION SERVICE FOR THE COUNTY OF ORANGE, VERMONT. SOILS ON THE PROJECT SITE ARE HADLEY VERY FINE SANDY LOAM, MERRIMAC FINE SANDY LOAM WITH 0% TO 3% SLOPES AND VERSHIRE-GLOVER-ROCK OUTCROP COMPLEX WITH 8% TO 25% SLOPES. THE "K FACTOR" FOR HADLEY IS 0.49, MERRIMAC IS 0.24 AND VERSHIRE-GLOVER-ROCK IS 0.24. THE SOIL IS CONSIDERED HIGHLY ERODIBLE DUE TO SIGNIFICANT SLOPES.

NOTE: K-VALUES GENERALLY INDICATE THE FOLLOWING:

0.0-0.23 = LOW EROSION POTENTIAL

0.24-0.36 = MODERATE EROSION POTENTIAL

0.37 AND HIGHER = HIGH EROSION POTENTIAL

#### **1.2.5 SENSITIVE RESOURCE AREAS**

CRITICAL HABITATS: NO

HISTORICAL OR ARCHEOLOGICAL AREAS: NO

PRIME AGRICULTURAL LAND: NO (AG LAND SURROUNDS THE PROJECT)

THREATENED AND ENDANGERED SPECIES: NO

WATER RESOURCE: AYERS BROOK

WETLANDS: NO

### **1.3 RISK EVALUATION**

THIS PROJECT DOES NOT FALL UNDER THE JURISDICTION OF GENERAL PERMIT 3-9020 FOR STORMWATER RUNOFF FROM CONSTRUCTION SITES. SHOULD CHANGES PRIOR TO OR DURING CONSTRUCTION RESULT IN ONE OR MORE ACRES OF EARTH DISTURBANCE OR SHOULD THE PROJECT BECOME PART OF A LARGER PLAN OF DEVELOPMENT, THE CONTRACTOR WILL BE RESPONSIBLE FOR ANY ADDITIONAL PERMITTING.

### **1.4 EROSION PREVENTION AND SEDIMENT CONTROL**

THE EROSION CONTROL PLANS ARE MEANT AS A GUIDELINE FOR PREVENTING EROSION AND CONTROLLING SEDIMENT TRANSPORT. THE PRINCIPLES OUTLINED IN THIS NARRATIVE CONSIST OF APPLYING MEASURES THROUGHOUT CONSTRUCTION OF THE PROJECT IN ORDER TO MINIMIZE SEDIMENT TRANSPORT TO THE RECEIVING WATERS. THE MEASURES INCLUDE STABILIZATION AND STRUCTURAL PRACTICES, STORM WATER CONTROLS AND OTHER POLLUTION PREVENTION PRACTICES. REFER TO THE LOW RISK SITE HANDBOOK AND APPROPRIATE DETAIL SHEETS FOR SPECIFIC GUIDANCE AND CONSTRUCTION DETAILING.

ALL MEASURES SHALL BE REGULARLY MAINTAINED AND SHALL BE CHECKED FOR SEDIMENT BUILD-UP. SEDIMENT SHALL BE DISPOSED OF AT AN APPROVED SITE WHERE IT WILL NOT BE SUBJECT TO EROSION.

#### **1.4.1 MARK SITE BOUNDARIES**

SITE BOUNDARIES AND AREAS CONSTRUCTION EQUIPMENT CAN ACCESS SHALL BE DELINEATED.

PROJECT DEMARCATION FENCING (PDF) SHALL BE USED TO PHYSICALLY MARK SITE BOUNDARIES.

#### **1.4.2 LIMIT DISTURBANCE AREA**

PREVENTING INITIAL SOIL EROSION BY MINIMIZING THE EXPOSED AREA IS MUCH MORE EFFECTIVE THAN TREATING ERODED SEDIMENT. EARTH DISTURBANCE CAN BE MINIMIZED THROUGH CONSTRUCTION PHASING BY ONLY OPENING UP EARTH AS NECESSARY. THIS CAN LIMIT THE AREA THAT WILL BE DISTURBED AND EXPOSED TO EROSION. EMPLOY TEMPORARY CONSTRUCTION STABILIZATION PRACTICES IN INCREMENTAL STAGES AS PHASES CHANGE. FOR PROJECTS WHICH FALL UNDER THE CONSTRUCTION GENERAL PERMIT, ONLY THE ACREAGE LISTED ON THE PERMIT AUTHORIZATION MAY BE EXPOSED AT ANY GIVEN TIME.

MAINTAINING VEGETATED BUFFERS ALONG STREAM BANKS, WETLANDS OR OTHER SENSITIVE AREAS IS A CRUCIAL EROSION AND SEDIMENT CONTROL MEASURE THAT SHOULD BE ESTABLISHED WHEREVER POSSIBLE.

#### **1.4.3 SITE ENTRANCE/EXIT STABILIZATION**

TRACKING OF SEDIMENT ONTO PUBLIC HIGHWAYS SHALL BE MINIMIZED TO REDUCE THE POTENTIAL FOR RUNOFF ENTERING RECEIVING WATERS. INSTALLATION SHALL COINCIDE WITH THE CONTRACTORS PROGRESS SCHEDULE.

STABILIZED CONSTRUCTION ENTRANCES SHALL BE INSTALLED ANYWHERE EQUIPMENT WILL BE GOING FROM AREAS OF EXPOSED SOILS TO PAVED SURFACES.

#### **1.4.4 INSTALL SEDIMENT BARRIERS**

SEDIMENT BARRIERS SHALL BE UTILIZED TO INTERCEPT RUNOFF AND ALLOW SUSPENDED SEDIMENT TO SETTLE OUT. THEY SHALL BE INSTALLED PRIOR TO ANY UP SLOPE WORK.

#### **1.4.5 DIVERT UPLAND RUNOFF**

DIVERSIONARY MEASURES SHALL BE USED TO INTERCEPT RUNOFF FROM ABOVE THE CONSTRUCTION AND DIRECT IT AROUND THE DISTURBED AREA SO THAT CLEAN WATER DOES NOT BECOME MUDDIED WHILE TRAVELING OVER EXPOSED SOILS ON THE CONSTRUCTION SITE.

#### **1.4.6 SLOW DOWN CHANNELIZED RUNOFF**

CHECK STRUCTURES SHALL BE UTILIZED TO REDUCE THE VELOCITY, AND THUS THE EROSION POTENTIAL, OF CONCENTRATED FLOW IN CHANNELS.

#### **1.4.7 CONSTRUCT PERMANENT CONTROLS**

PERMANENT STORMWATER TREATMENT DEVICES SHALL BE INSTALLED IN ACCORDANCE WITH PERMIT CONDITIONS.

#### **1.4.8 STABILIZE EXPOSED SOILS DURING CONSTRUCTION**

ALL AREAS OF DISTURBANCE MUST HAVE TEMPORARY STABILIZATION IN PLACE WITHIN 48 HOURS OF DISTURBANCE OR IN ACCORDANCE WITH THE CONSTRUCTION GENERAL PERMIT 3-9020 AUTHORIZATION.

SURFACE ROUGHENING OF ALL EXPOSED SLOPES, COMBINED WITH TEMPORARY MULCHING, SHALL BE UTILIZED ON A REGULAR BASIS. BIODEGRADABLE EROSION CONTROL MATTING OR AN EQUIVALENT SHALL BE USED TO STABILIZE ALL SLOPES STEEPER THAN 1:3.

THE FORECAST OF RAINFALL EVENTS SHALL TRIGGER IMMEDIATE PROTECTION OF EXPOSED SOILS.

#### **1.4.9 WINTER STABILIZATION**

VARIOUS MEASURES SPECIFIC TO WINTER MAY BE NECESSARY SHOULD THE PROJECT EXTEND INTO WINTER (OCTOBER 15 THROUGH APRIL 15). REFER TO THE LOW RISK SITE HANDBOOK FOR GUIDANCE.

#### **1.4.10 STABILIZE SOIL AT FINAL GRADE**

EXPOSED SOIL MUST BE STABILIZED WITHIN 48 HOURS OF REACHING FINAL GRADE.

SEED, MULCH, FERTILIZER AND LIME SHALL BE USED TO ESTABLISH PERMANENT VEGETATION. FOR SLOPES STEEPER THAN 1:3, BIODEGRADABLE EROSION CONTROL MATTING OR AN EQUIVALENT SHALL BE USED INSTEAD OF MULCH.

#### **1.4.11 DE-WATERING ACTIVITIES**

DISCHARGE FROM DEWATERING ACTIVITIES THAT FLOWS OFF OF THE CONSTRUCTION SITE MUST NOT CAUSE OR CONTRIBUTE TO A VIOLATION OF THE VERMONT WATER QUALITY STANDARDS.

#### **1.4.12 INSPECT YOUR SITE**

INSPECT THE PROJECT SITE BASED ON SPECIAL PROVISION REQUIREMENTS OR CONSTRUCTION GENERAL PERMIT AUTHORIZATION STIPULATIONS.

### **1.5 SEQUENCE AND STAGING**



THIS SECTION WILL BE DEVELOPED BY THE CONTRACTOR USING THE GUIDANCE OUTLINED IN THE VTRANS EPSC PLAN CONTRACTOR CHECKLIST.

#### **1.5.1 CONSTRUCTION SEQUENCE**

#### **1.5.2 OFF-SITE ACTIVITIES**

IN ADDITION TO THE CONTRACTOR CHECKLIST ANY ACTIVITIES OUTSIDE THE CONSTRUCTION LIMITS SHALL FOLLOW SUBSECTIONS 105.25- 105.29 OF THE STANDARD SPECIFICATIONS FOR CONSTRUCTION.

PROJECT NAME:	BRAINTREE
PROJECT NUMBER:	BRO 1444(36)
FILE NAME: s95j292epsc_narrative.dgn	PLOT DATE: 31-DEC-2009
PROJECT LEADER: K. HIGGINS	DRAWN BY: R. PELLETT
DESIGNED BY: T. FILLBACH	CHECKED BY: T. FILLBACH
EPSC NARRATIVE	SHEET 10 OF 26

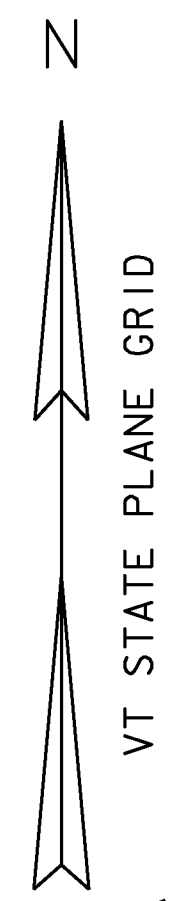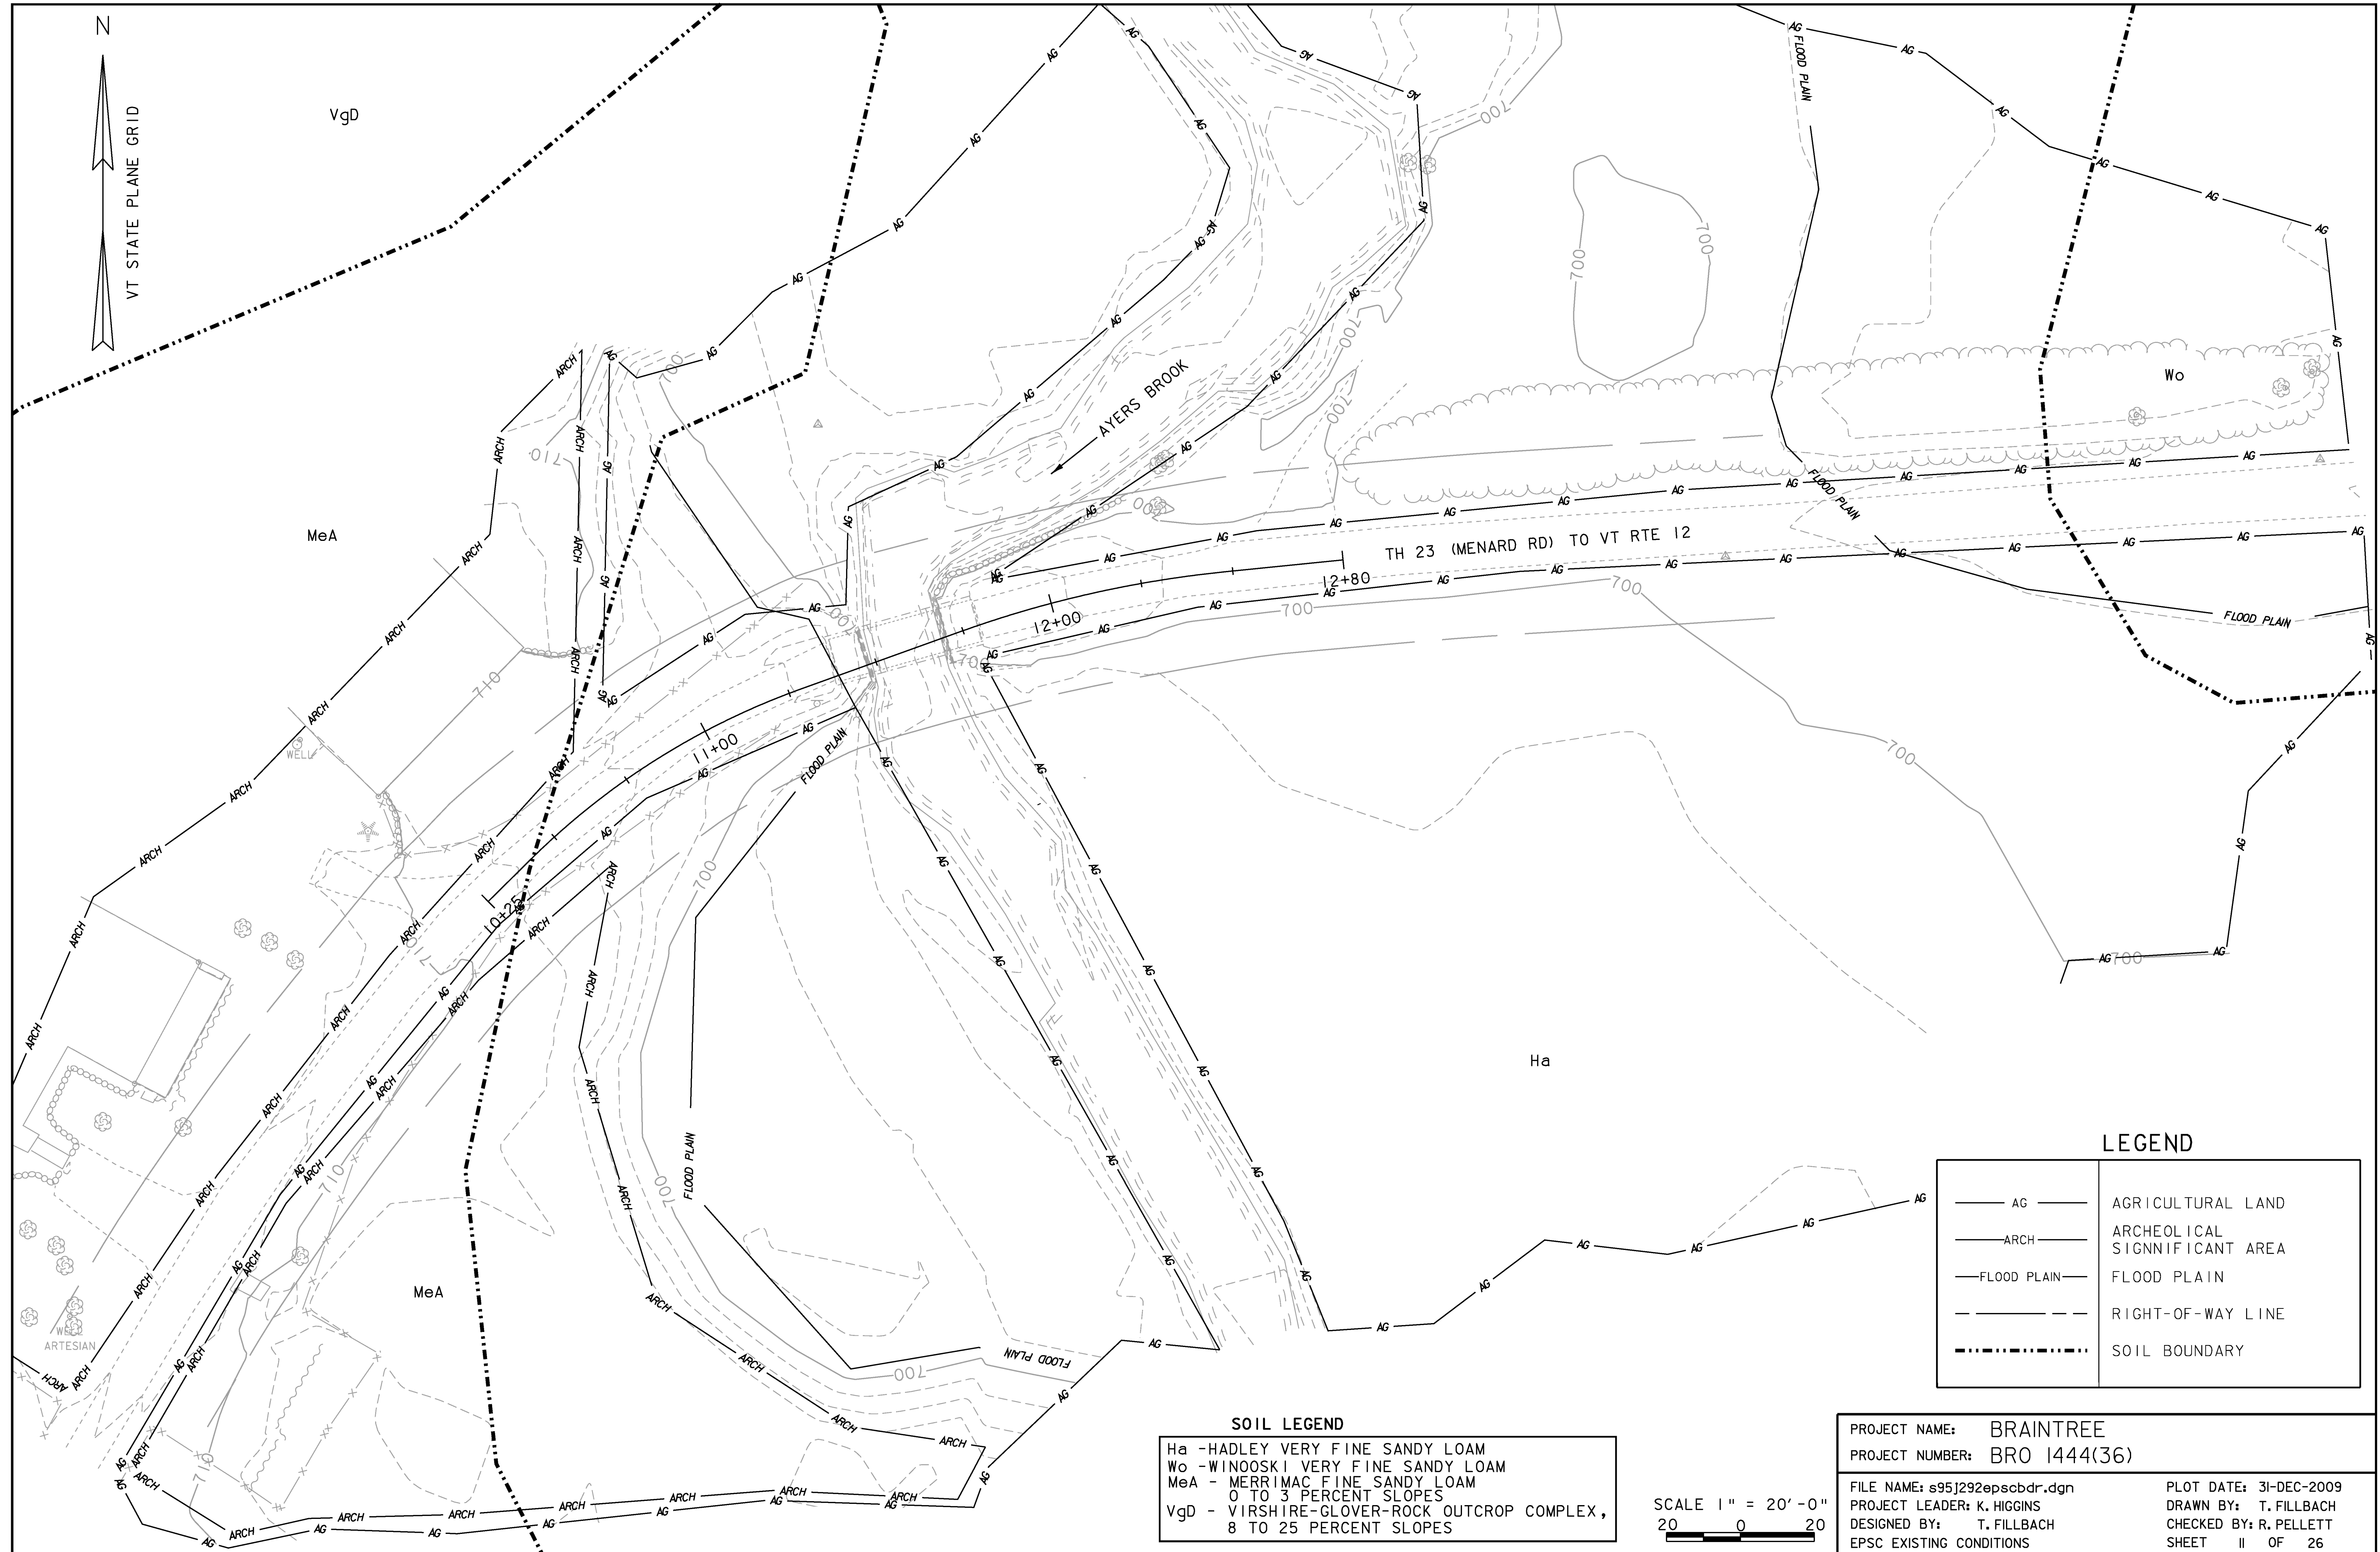

**LEGEND**

— AG —	AGRICULTURAL LAND
— ARCH —	ARCHEOLOGICAL SIGNIFICANT AREA
— FLOOD PLAIN —	FLOOD PLAIN
— — — — —	RIGHT-OF-WAY LINE
- - - - -	SOIL BOUNDARY

**SOIL LEGEND**

Ha	-HADLEY VERY FINE SANDY LOAM
Wo	-WINOOSKI VERY FINE SANDY LOAM
MeA	-MERRIMAC FINE SANDY LOAM 0 TO 3 PERCENT SLOPES
VgD	-VIRSHIRE-GLOVER-ROCK OUTCROP COMPLEX, 8 TO 25 PERCENT SLOPES

SCALE 1" = 20'-0"  
20 0 20

PROJECT NAME:	BRAINTREE	PLOT DATE:	31-DEC-2009
PROJECT NUMBER:	BRO 1444(36)	DRAWN BY:	T. FILLBACH
FILE NAME:	s95j292epsbdr.dgn	CHECKED BY:	R. PELLETT
PROJECT LEADER:	K. HIGGINS	SHEET	II OF 26
DESIGNED BY:	T. FILLBACH		
EPSC EXISTING CONDITIONS			

**SOIL CLASSIFICATION**

AASHTO

A1	Gravel and Sand
A3	Fine Sand
A2	Silty or Clayey Gravel and Sand
A4	Silty Soil - Low Compressibility
A5	Silty Soil - Highly Compressible
A6	Clayey Soil - Low Compressibility
A7	Clayey Soil - Highly Compressible

**ROCK QUALITY DESIGNATION**

R.Q.D. (%)	ROCK DESCRIPTION
<25	Very Poor
25 to 50	Poor
51 to 75	Fair
76 to 90	Good
>90	Excellent

**SHEAR STRENGTH**

UNDRAINED SHEAR STRENGTH IN P.S.F.	CONSISTENCY
<250	Very Soft
250-500	Soft
500-1000	Med. Stiff
1000-2000	Stiff
2000-4000	Very Stiff
>4000	Hard

**CORRELATION GUIDE OF "N" TO DENSITY/CONSISTENCY**

DENSITY (GRANULAR SOILS)		CONSISTENCY (COHESIVE SOILS)	
N	DESCRIPTIVE TERM	N	DESCRIPTIVE TERM
<5	Very Loose	<2	Very Soft
5-10	Loose	2-4	Soft
11-24	Med. Dense	5-8	Med. Stiff
25-50	Dense	9-15	Stiff
>50	Very Dense	16-30	Very Stiff
		31-60	Hard
		>60	Very Hard


**COMMONLY USED SYMBOLS**

- ▼ Water Elevation
- ⊕ Standard Penetration Boring
- ⊗ Auger Boring
- ⊙ Rod Sounding
- S Sample
- N Standard Penetration Test
- Blow Count Per Foot For:
- 2" O.D. Sampler
- 1 3/8" I.D. Sampler
- Hammer Weight Of 140 Lbs.
- Hammer Fall Of 30"
- VS Field Vane Shear Test
- US Undisturbed Soil Sample
- B Blast
- DC Diamond Core
- MD Mud Drill
- WA Wash Ahead
- HSA Hollow Stem Auger
- AX Core Size 1 1/8"
- BX Core Size 1 3/8"
- NX Core Size 2 1/8"
- M Double Tube Core Barrel Used
- LL Liquid Limit
- PL Plastic Limit
- PI Plasticity Index
- NP Non Plastic
- w Moisture Content (Dry Wgt. Basis)
- D Dry
- M Moist
- MTW Moist To Wet
- W Wet
- Sat Saturated
- Bo Boulder
- Gr Gravel
- Sa Sand
- Sl Silt
- Cl Clay
- HP Hardpan
- Le Ledge
- NLTD No Ledge To Depth
- CNPF Can Not Penetrate Further
- TLOB To Ledge Or Boulder
- NR No Recovery
- Rec. Recovery
- %Rec. Percent Recovery
- ROD Rock Quality Designation
- CBR California Bearing Ratio
- < Less Than
- > Greater Than
- R Refusal (N > 100)

COLOR			
blk	Black	pnk	Pink
bl	Blue	pu	Purple
brn	Brown	rd	Red
dk	Dark	tn	Tan
gry	Gray	wh	White
gn	Green	yel	Yellow
lt	Light	mltc	Multicolored
or	Orange		

**BORING CHART**

HOLE NO.	SURV. STATION	OFFSET	NORTHING (Y)	EASTING (X)	TOP OF BEDROCK
B-101	11+86.6	3.5	540483.97	1600666.96	638.06
B-102	11+31.6	-7.5	540475.96	1600611.57	671.82

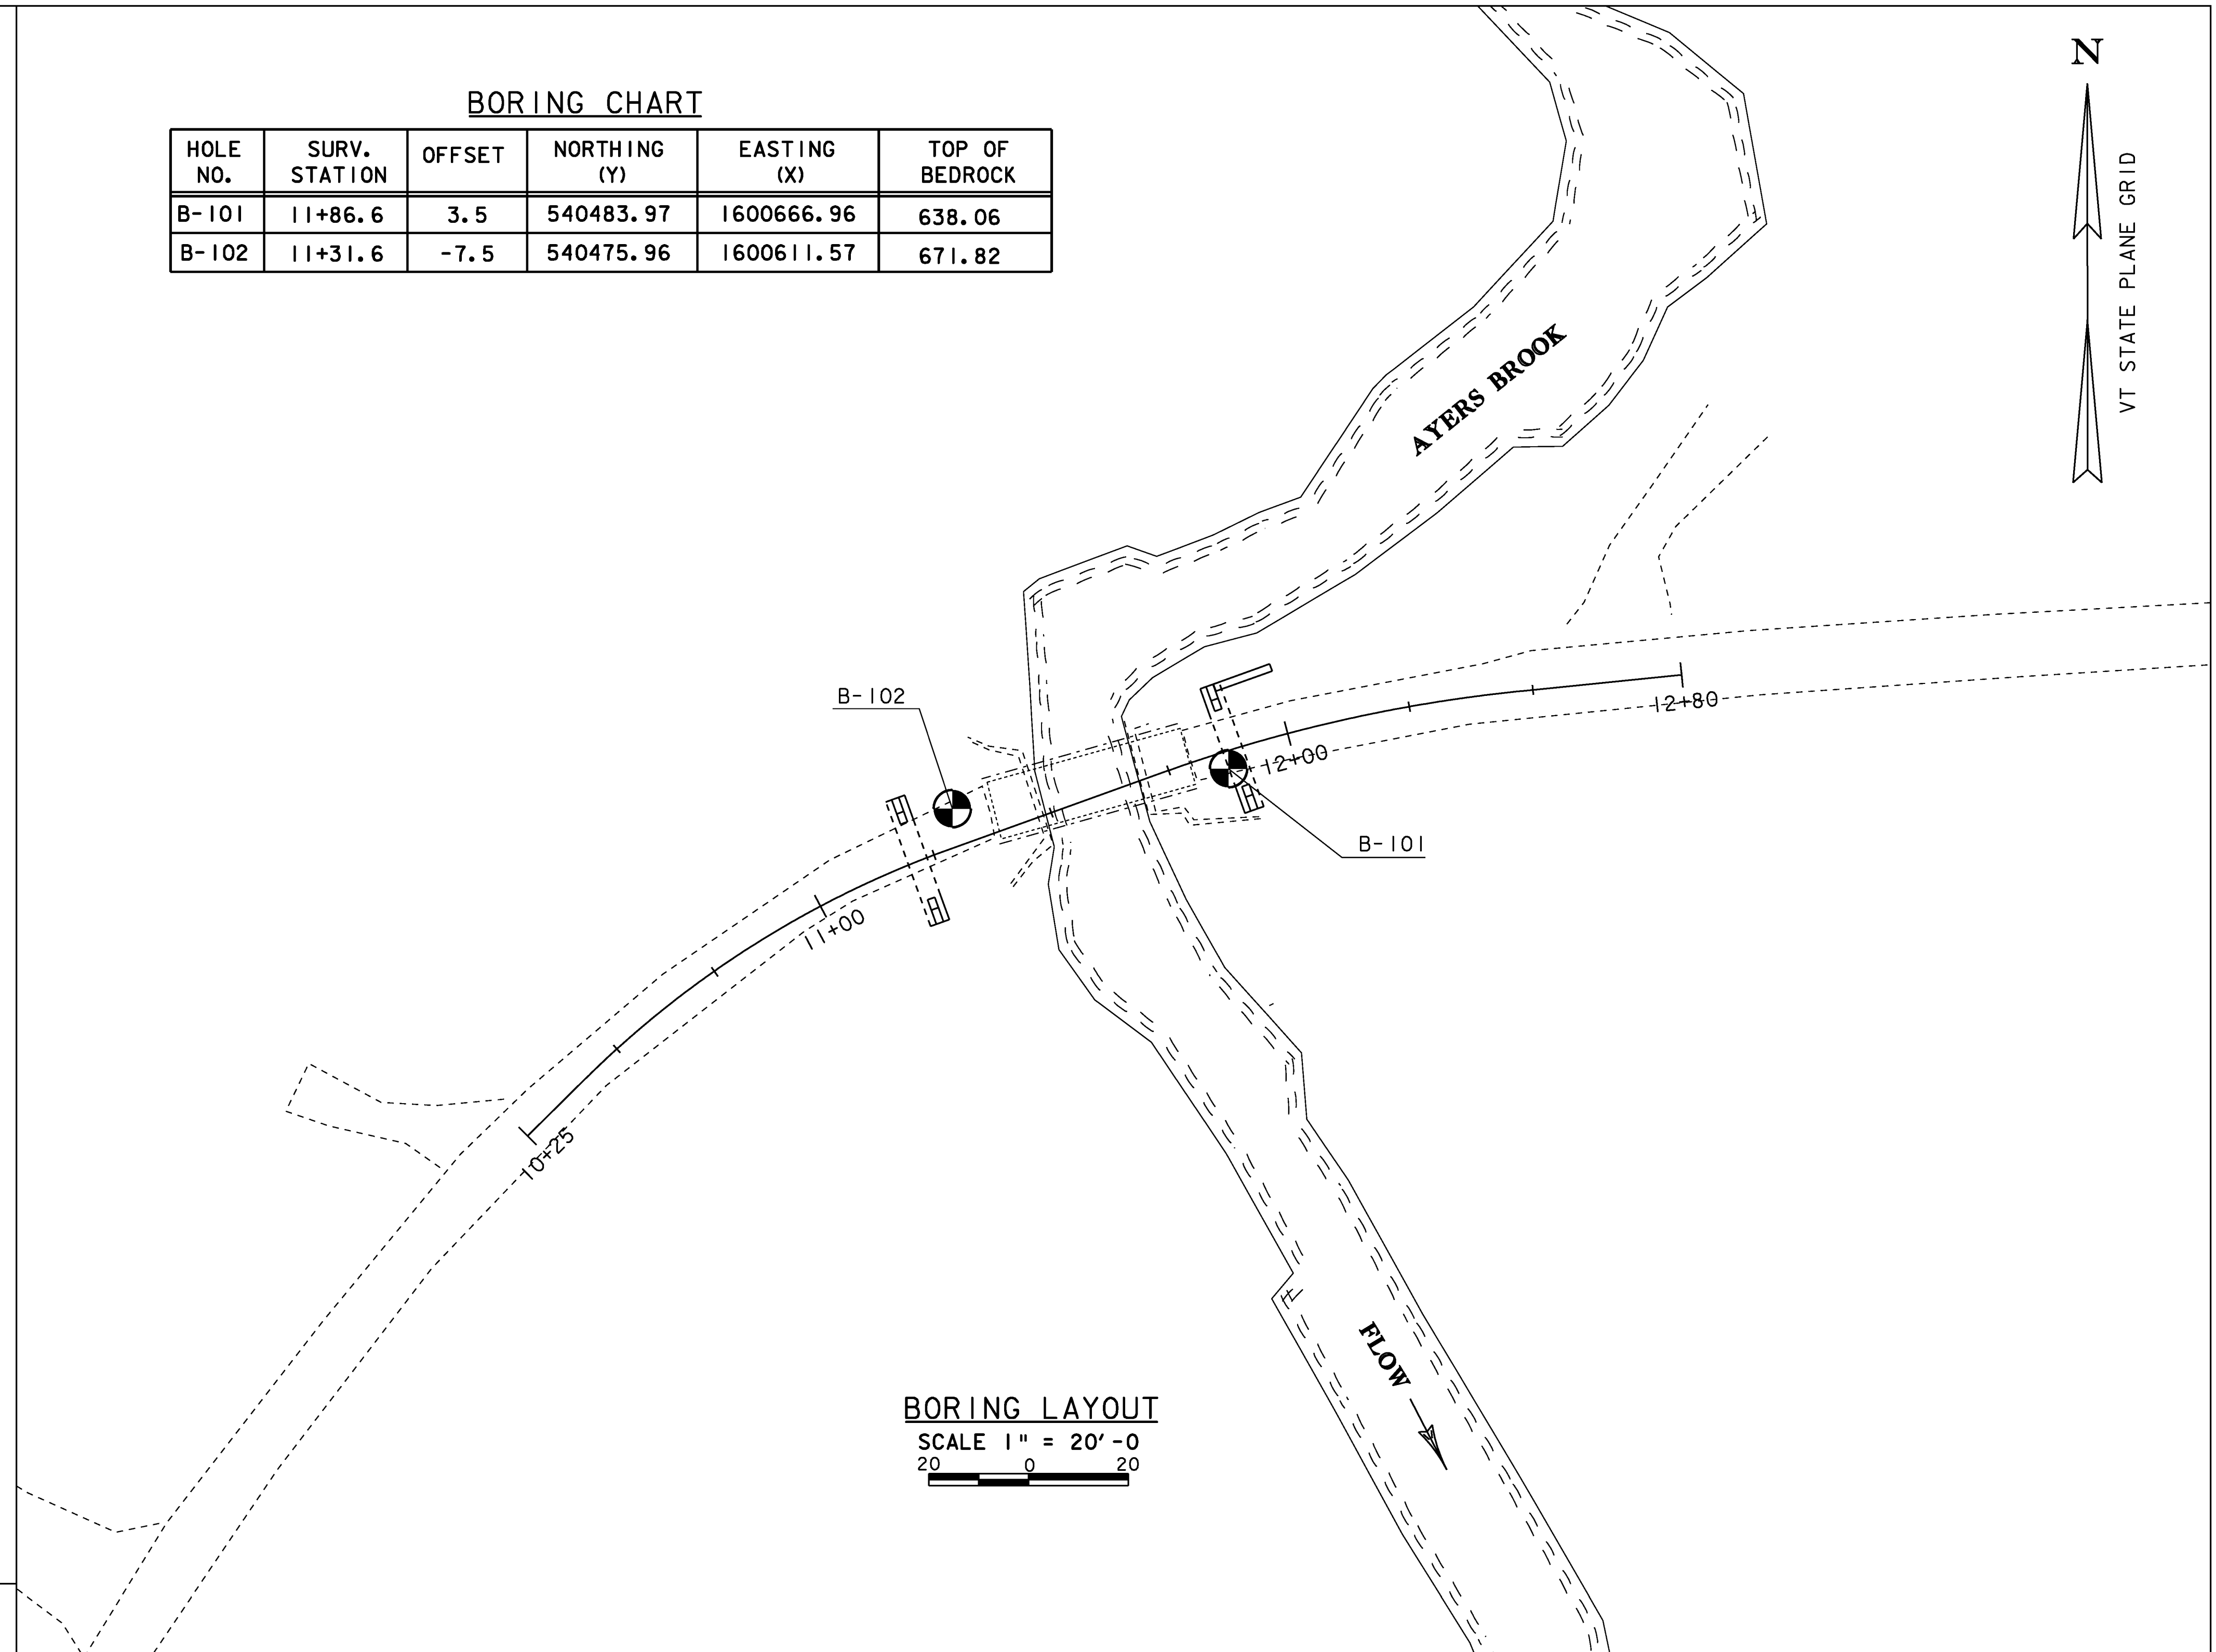

**BORING LAYOUT**

SCALE 1" = 20'-0"  
20 0 20

**DEFINITIONS (AASHTO)**

- BEDROCK (LEDGE)** - Rock in its native location of indefinite thickness.
- BOULDER** - A rock fragment with an average dimension > 12 inches.
- COBBLE** - Rock fragments with an average dimension between 3 and 12 inches.
- GRAVEL** - Rounded particles of rock < 3" and > 0.075" (#10 sieve).
- SAND** - Particles of rock < 0.075" (#10 sieve) and > 0.0029" (#200 sieve).
- SILT** - Soil < 0.0029" (#200 sieve), non or slightly plastic and exhibits no strength when air-dried.
- CLAY** - Fine grained soil, exhibits plasticity when moist and considerable strength when air-dried.
- VARVED** - Alternate layers of silt and clay.
- HARDPAN** - Extremely dense soil, cemented layer, not softened when wet.
- MUCK** - Soft organic soil (containing > 10% organic material).
- MOISTURE CONTENT** - Weight of water divided by dry weight of soil.
- FLOWING SAND** - Granular soil so saturated (loose) that it flows into drill casing during extraction of wash rod.
- STRIKE** - Angle from magnetic north to line of intersection of bed with a horizontal plane.
- DIP** - Inclination of bed with a horizontal plane.

**GENERAL NOTES**

1. The subsurface explorations shown herein were made between 6/17/09 and 6/25/09 by the Agency.
2. Soil and rock classifications, properties and descriptions are based on engineering interpretation from available subsurface information by the Agency and may not necessarily reflect actual variations in subsurface conditions that may be encountered between individual boring or sample locations.
3. Observed water levels and/or conditions indicated are as recorded at the time of exploration and may vary according to the prevailing rainfall, methods of exploration and other factors.
4. Engineering Judgment was exercised in preparing the subsurface information presented herein. Analysis and interpretation of subsurface data was performed and interpreted for Agency design and estimating purposes. Presentation of the information in the Contract is intended to provide the Contractor access to the same data available to the Agency. The subsurface information is presented in good faith and is not intended as a substitute for personal investigation, independent interpretation, independent analysis or judgment by the Contractor.
5. Pictorial structure details shown on the boring plan layout or soils profile are for illustrative purposes only and may not accurately portray final contract details.
6. Terminology used on boring logs to describe the hardness, degree of weathering, and spacing of fractures, joints and other discontinuities in the bedrock is defined in the AASHTO Manual on Subsurface Investigations, 1988.

PROJECT NAME:	BRAINTREE	PLOT DATE:	31-DEC-2009
PROJECT NUMBER:	BRO 1444(36)	DRAWN BY:	R. PELLETT
FILE NAME:	s95J292bor.dgn	CHECKED BY:	T. FILLBACH
PROJECT LEADER:	K. HIGGINS	BORING LAYOUT SHEET	SHEET 12 OF 26

VT Trans		STATE OF VERMONT AGENCY OF TRANSPORTATION MATERIALS & RESEARCH SECTION SUBSURFACE INFORMATION		BORING NUMBER: B-101 SHEET 1 of 1 DATE STARTED: 6/17/09 DATE COMPLETED: 6/19/09					
PROJECT NAME: BRAINTREE SITE NAME: TH-23 STATION: 11+86.6 OFFSET: 3.50 VTSPG NAD83: N 540483.97 ft E 1600666.96 ft		PROJECT NUMBER: BRO 1444(36) SITE NUMBER: BR-12 GROUND ELEVATION: 705.06 ft GROUNDWATER DEPTH: NONE TAKEN PROJECT PIN NUMBER: 95J292							
BORING CREW CREW CHIEF: PORTER DRILLER: PORTER LOGGER: WERNER		BORING RIG: LAG TRACK RIG #09 w/AUTO HAMMER BORING TYPE: WASH BORE SAMPLE TYPE: SPLIT BARREL CHECKED BY: NSM							
DEPTH (ft)	SYMBOL	CLASSIFICATION OF MATERIALS (Description)	BLOWS PER FOOT	M.C. (%)	GRAVEL (%)	SAND (%)	FINES (%)	LL (%)	PI (%)
			RUN	REC (%)	ROD (%)	Dip (deg)	Drill Rate (min/ft)		
		A-1-a, SaGr, brn, Moist, Rec. = 1.4 ft	14	4.4	52.6	35.2	12.2		
		A-1-b, SiGrSa, brn, Moist, Rec. = 1.6 ft	17	7.0	36.7	43.2	20.1		
		A-1-b, SiGrSa, brn, Moist, Rec. = 1.3 ft	10	8.6	33.7	43.6	22.7		
		A-1-a, SaGr, brn-gry, Moist, Rec. = 1.3 ft	35	8.9	60.4	24.2	15.4		
		A-1-a, SaGr, gry, Wet, Rec. = 1.1 ft	11	12.7	51.1	34.2	14.7		
		A-1-a, SaGr, gry, Wet, Rec. = 1.3 ft	11	11.3	54.8	33.1	12.1		
		A-4, Si, gry, Wet, Rec. = 1.0 ft	5	29.6	8.5	6.6	84.9		
		A-4, Si, gry, Wet	2	30.3	0.0	2.7	97.3		
		Visual Classification, Si, gry, Wet, Rec. = 1.3 ft	2	33.8					
		Visual Classification, Si, gry, Wet, Rec. = 1.4 ft	3	34.0					
		A-4, Si, gry, Wet, Rec. = 2.0 ft	3	35.4	0.0	0.3	99.7		
		Visual Classification, Si, gry, Wet, Rec. = 2.0 ft	2	36.0					
		A-4, Si, gry, Wet, Rec. = 2.0 ft	4	36.9	0.0	1.1	98.9		
		Visual Classification, Si, gry, Wet, Rec. = 2.0 ft	WH	37.3					
		A-4, Si, gry, Wet, Rec. = 0.9 ft	WH	40.8	0.0	0.6	99.4	35	2
		Visual Classification, Si, gry, Wet, Rec. = 2.0 ft	1	38.2					
		Visual Classification, Si, gry, Wet, Rec. = 2.0 ft	1	41.3					
		A-4, Si, gry, Wet, Rec. = 1.1 ft	WH	40.1	0.0	0.8	99.2		
		A-1-a, SaGr, gry, Wet, Rec. = 0.7 ft, Broken Rock was within sample.	35	11.8	61.8	26.0	12.2		
		Dark gray, Phyllite, with occasional pyrite rich zones. Competent. Low RQD possibly due to mechanical breakage during drilling. Moderately soft, Unweathered, BXMDC, 67.0 ft - 72.0 ft, Rec. = 4.6 ft	1	92	18	50	8		
		Dark gray, Phyllite, with occasional pyrite rich zones. Competent. Low RQD possibly due to mechanical breakage during drilling. Moderately soft, Unweathered, BXMDC, 72.0 ft - 77.0 ft, Rec. = 4.95 ft	2	99	60	50	10		
		Hole stopped @ 77.0 ft					10		
							11		
							11		

BOTTOM OF ABUT. 2  
ELEV. 697.50

PILE DEPTH (ESTIMATED)  
ELEV. 638.00  
@ ABUT. 2

LOG OF BORING - BRAINTREE - BRO 1444(36) - VP - ADT.GBT - 12/4/09



VT Trans		STATE OF VERMONT AGENCY OF TRANSPORTATION MATERIALS & RESEARCH SECTION SUBSURFACE INFORMATION		BORING NUMBER: B-102 SHEET 1 of 1 DATE STARTED: 6/23/09 DATE COMPLETED: 6/25/09					
PROJECT NAME: BRAINTREE SITE NAME: TH-23 STATION: 11+31.6 OFFSET: -7.50 VTSPG NAD83: N 540475.96 ft E 1600611.57 ft		PROJECT NUMBER: BRO 1444(36) SITE NUMBER: BR-12 GROUND ELEVATION: 706.32 ft GROUNDWATER DEPTH: 9.5 ft PROJECT PIN NUMBER: 95J292							
BORING CREW CREW CHIEF: PORTER DRILLER: PORTER LOGGER: WERNER		BORING RIG: LAG TRACK RIG #09 w/AUTO HAMMER BORING TYPE: WASH BORE SAMPLE TYPE: SPLIT BARREL CHECKED BY: NSM							
DEPTH (ft)	SYMBOL	CLASSIFICATION OF MATERIALS (Description)	BLOWS PER FOOT	M.C. (%)	GRAVEL (%)	SAND (%)	FINES (%)	LL (%)	PI (%)
			RUN	REC (%)	ROD (%)	Dip (deg)	Drill Rate (min/ft)		
		A-1-a, SaGr, brn, Moist, Rec. = 1.4 ft	19	3.2	54.3	32.4	13.3		
		A-2-4, SiGrSa, brn, Moist, Rec. = 1.6 ft	20	7.9	33.3	40.7	26.0		
		A-2-4, SiGrSa, brn, Moist, Rec. = 1.4 ft	10	9.1	30.9	44.6	24.5		
		A-1-b, SiGrSa, brn, Moist, Rec. = 1.2 ft	4	9.2	35.3	43.9	20.8		
		A-1-b, SaGr, brn, Wet, Rec. = 0.9 ft	3	14.6	42.5	39.9	17.6		
		A-4, SaSi, brn, Wet, Rec. = 1.3 ft	7	24.1	18.5	30.6	50.9		
		Field Note: No Recovery, Appears to be silt	3						
		Visual Classification, Si, gry, Wet, Rec. = 0.8 ft	3	31.7					
		A-4, Si, gry, Wet, Rec. = 1.5 ft	3	34.1	0.0	1.1	98.9		
		A-4, Si, gry, Wet, Rec. = 1.6 ft	3	35.1	0.0	0.5	99.5		
		Visual Classification, Si, gry, Wet, Rec. = 2.0 ft	3	35.8					
		A-2-4, SiSaGr, gry, Wet, Rec. = 1.4 ft	11	11.2	38.8	34.0	27.2		
		Field Class: Cobbles, BXDC, Cleaned out casing							
		A-1-b, SaGr, gry, Wet, Rec. = 0.8 ft	68	9.4	55.1	29.2	15.7		
		Dark gray, Meta-Limestone, grading to phyllite. Competent. Low RQD possibly due to mechanical breakage during drilling. Moderately soft to moderately hard, Unweathered, BXMDC, 34.5 ft - 38.5 ft, Rec. = 3.4 ft	1	85	29	50	7		
		Dark gray, Phyllite, Competent. Low RQD possibly due to mechanical breakage during drilling. Moderately soft, Unweathered, BXMDC, 38.5 ft - 41.5 ft, Rec. = 2.7 ft	2	90	11	50	6		
		Dark gray, Phyllite, Competent. Low RQD possibly due to mechanical breakage during drilling. Moderately soft, Unweathered, BXMDC, 41.5 ft - 42.5 ft, Rec. = 1.0 ft	3	100	0	50	9		
		Hole stopped @ 42.5 ft					16		
							7		
							7		
							15		
							12		

BOTTOM OF ABUT. 1  
ELEV. 698.50

PILE DEPTH (ESTIMATED)  
ELEV. 671.50  
@ ABUT. 1


LOG OF BORING - BRAINTREE - BRO 1444(36) - VP - ADT.GBT - 12/4/09

PROJECT NAME: BRAINTREE  
PROJECT NUMBER: BRO 1444(36)  
FILE NAME: s95J292borlogs.dgn  
PROJECT LEADER: K. HIGGINS  
DESIGNED BY: MATERIALS & RESEARCH  
BORING LOGS  
PLOT DATE: 31-DEC-2009  
DRAWN BY: K. PATTERSON  
CHECKED BY: T. FILLBACH  
SHEET 13 OF 26

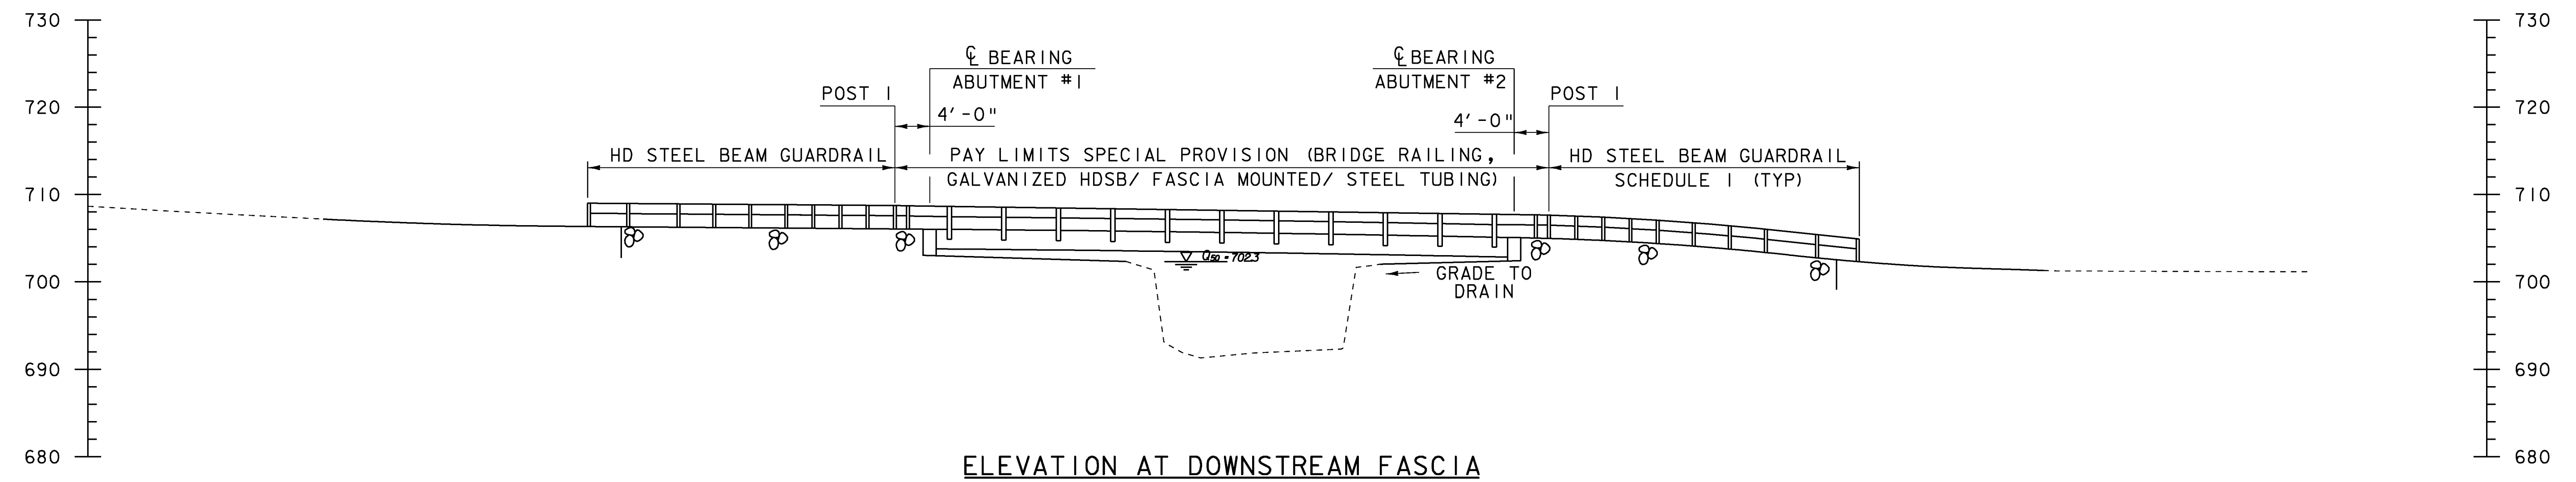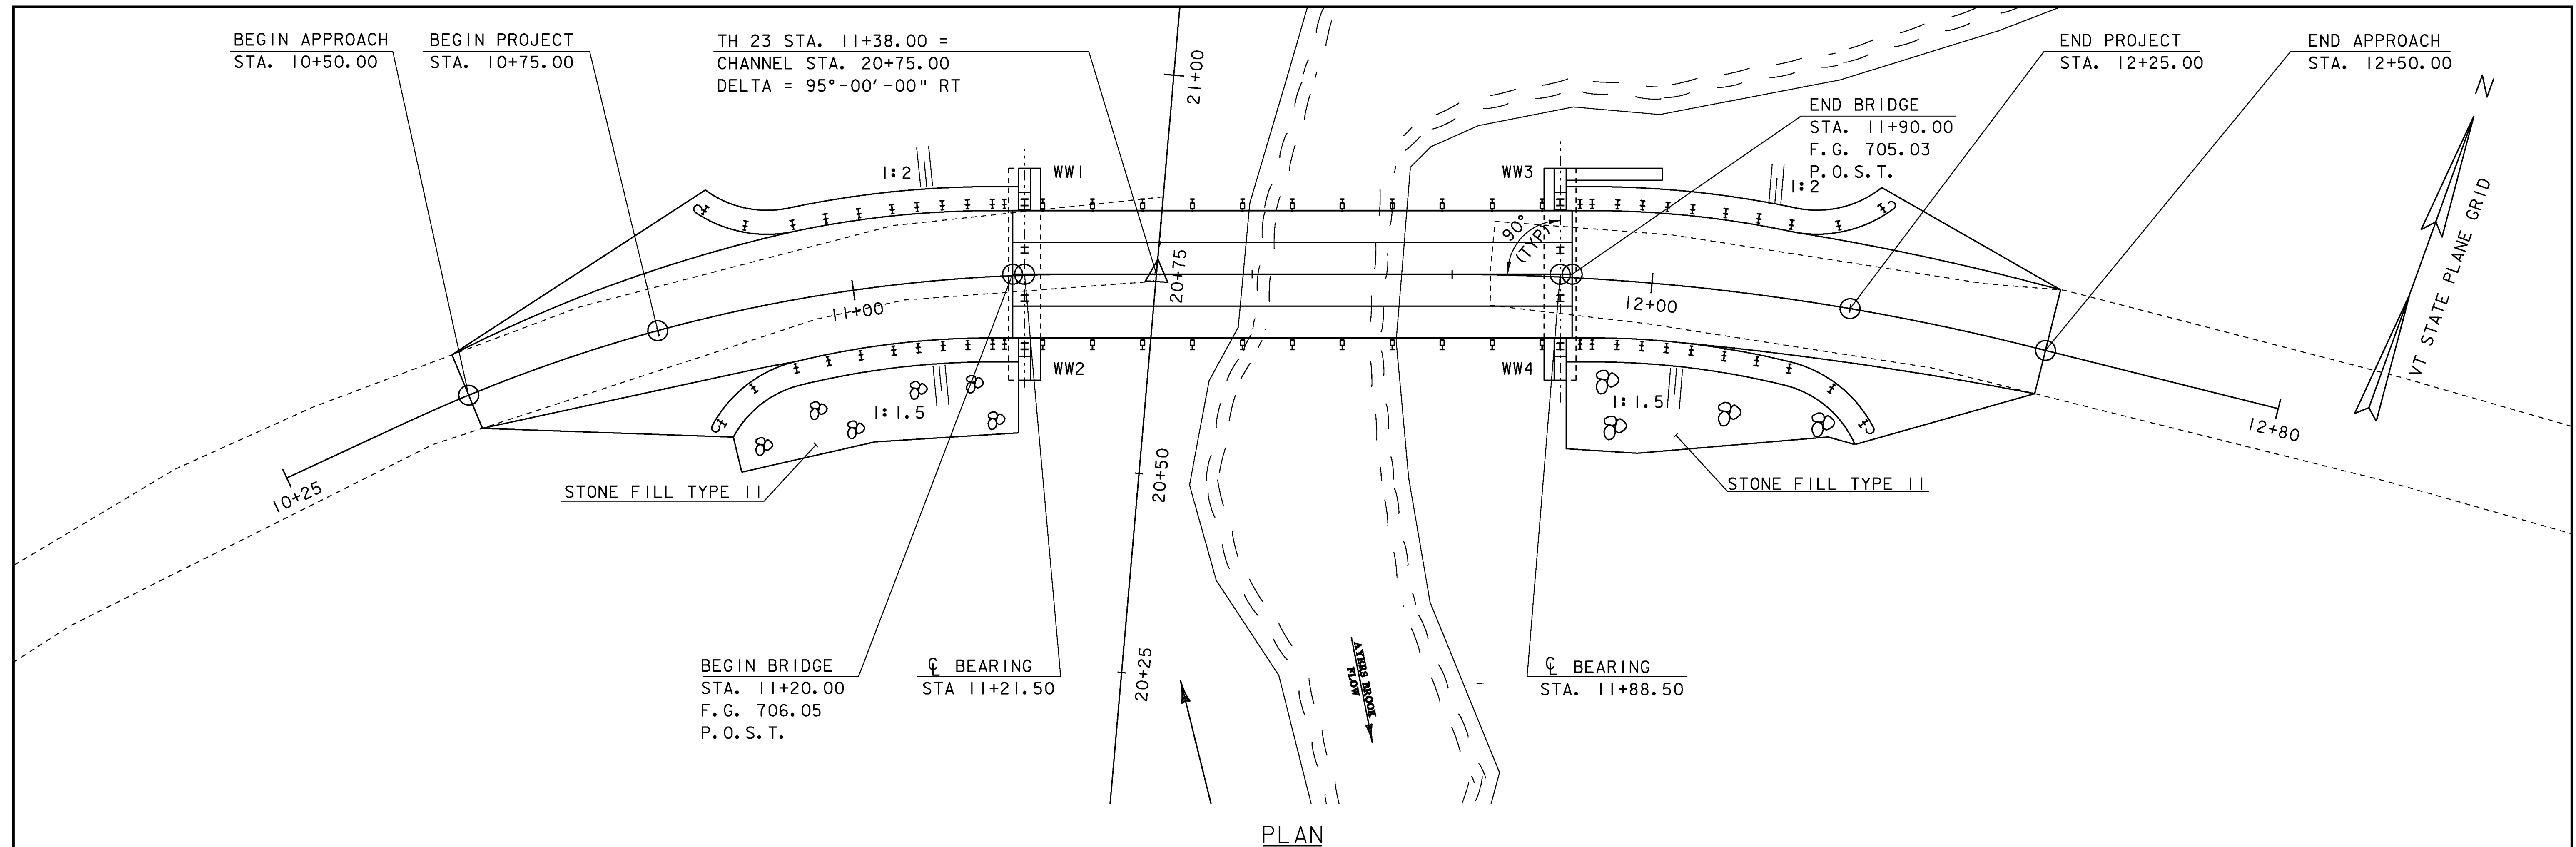


SCALE 1" = 10'-0"  
 10 0 10

PROJECT NAME: BRAINTREE	PLOT DATE: 31-DEC-2009
PROJECT NUMBER: BRO 1444(36)	DRAWN BY: R. PELLETT
FILE NAME: s95j292pe.dgn	CHECKED BY: T. FILLBACH
PROJECT LEADER: K. HIGGINS	SHEET 14 OF 26
DESIGNED BY: T. FILLBACH	
PLAN AND ELEVATION	

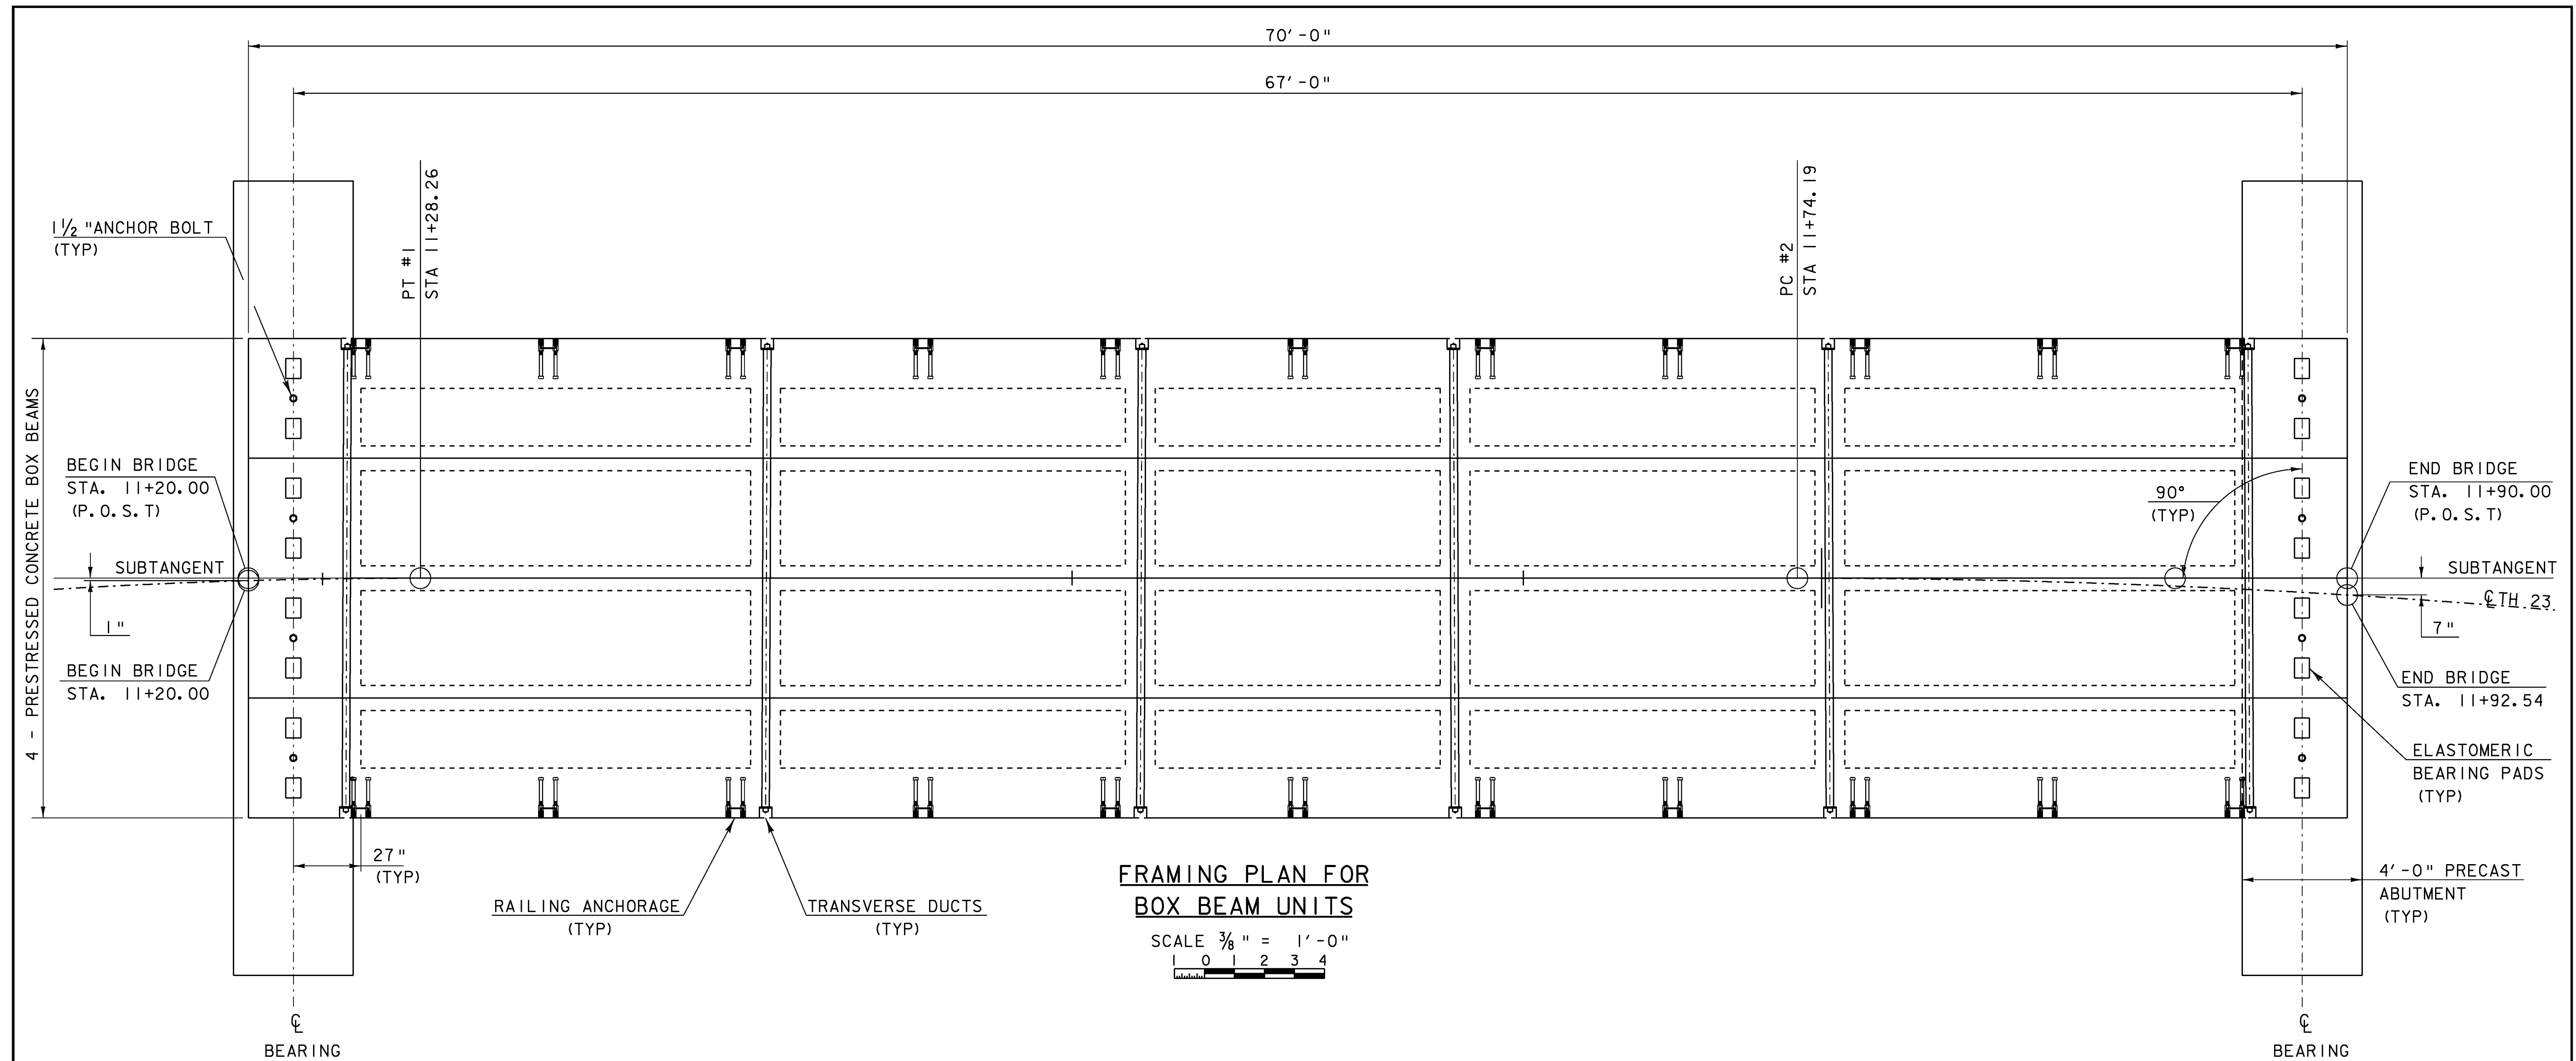

**FRAMING PLAN FOR  
BOX BEAM UNITS**


SCALE  $\frac{3}{8}$ " = 1'-0"  
1 0 1 2 3 4

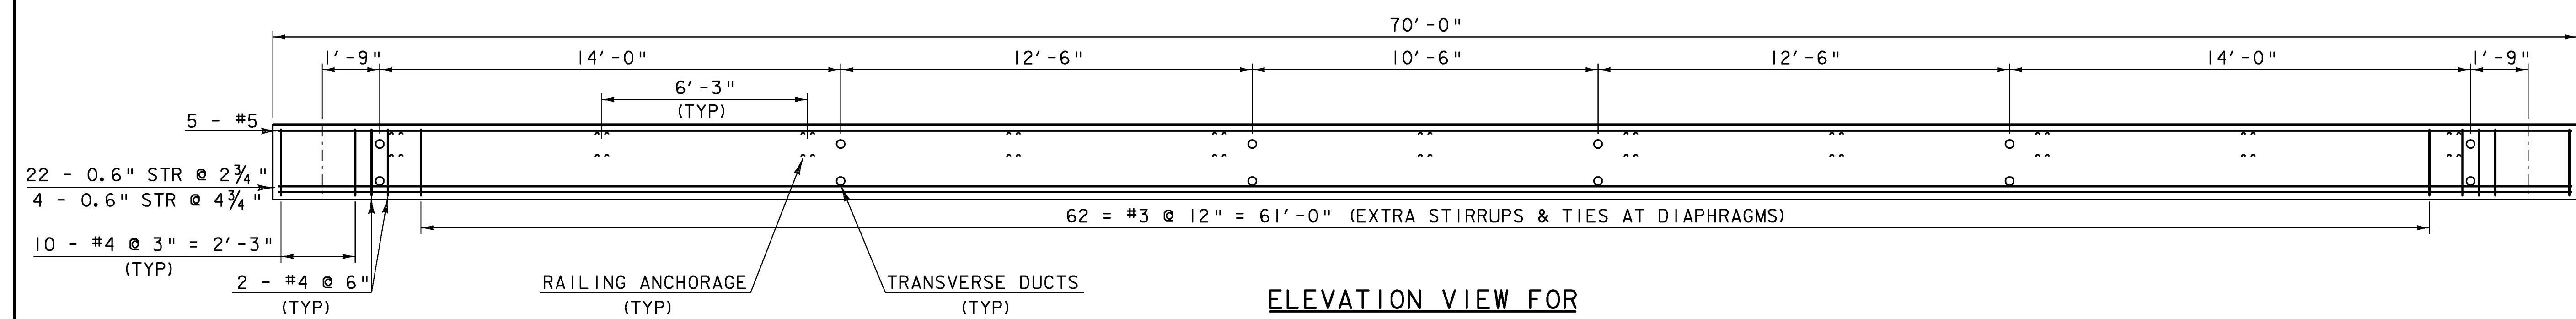


**ELEVATION VIEW FOR  
BOX BEAM UNITS**

SCALE  $\frac{3}{8}$ " = 1'-0"  
1 0 1 2 3 4


PROJECT NAME:	BRAINTREE	PLOT DATE:	14-JAN-2010
PROJECT NUMBER:	BRO 1444(36)	DRAWN BY:	K. PATTERSON
FILE NAME:	s95J292sup.dgn	DESIGNED BY:	T. FILLBACH
PROJECT LEADER:	K. HIGGINS	CHECKED BY:	T. FILLBACH
FRAMING PLAN		SHEET	15 OF 26

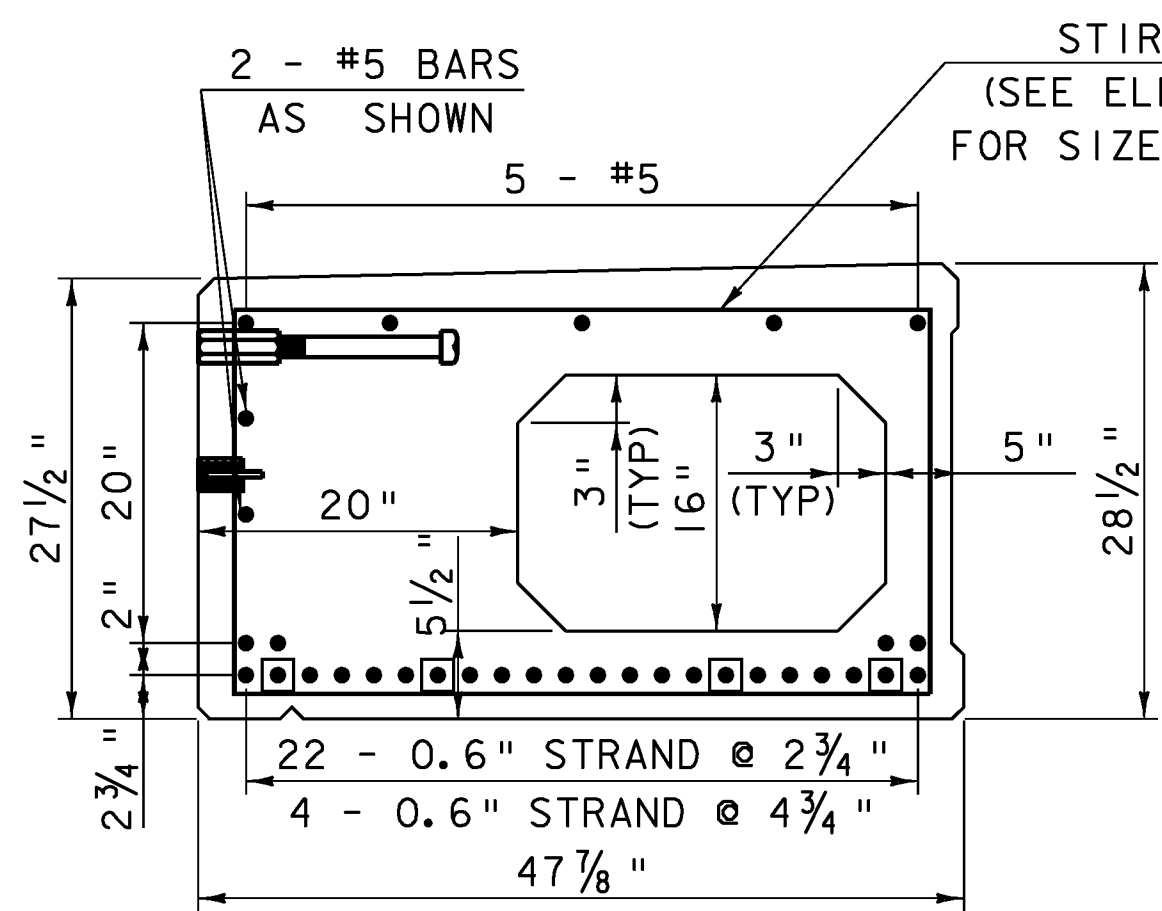

PRESTRESSED CONCRETE BOX BEAM  
(27 1/2" - 28 1/2" x 48")  
EXTERIOR

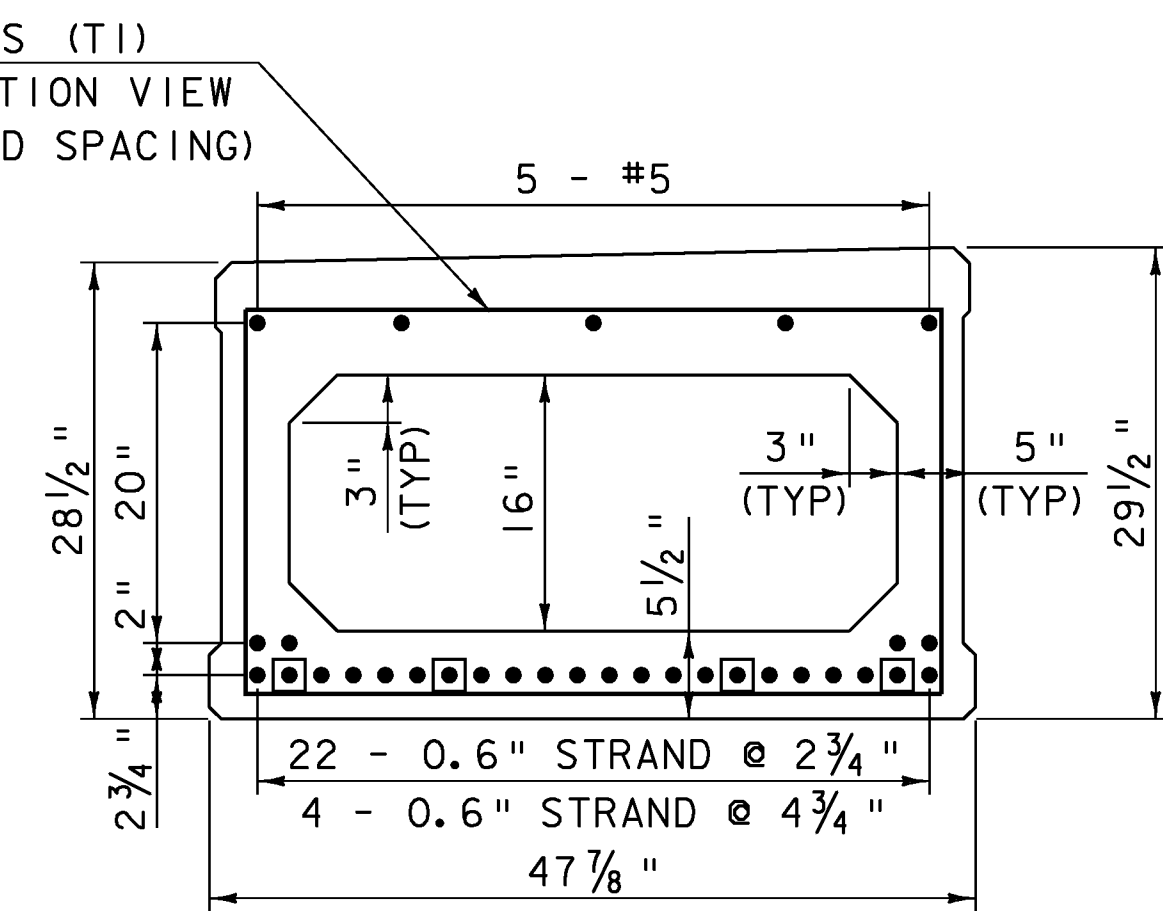


PRESTRESSED CONCRETE BOX BEAM  
(28 1/2" - 29 1/2" x 48")  
INTERIOR

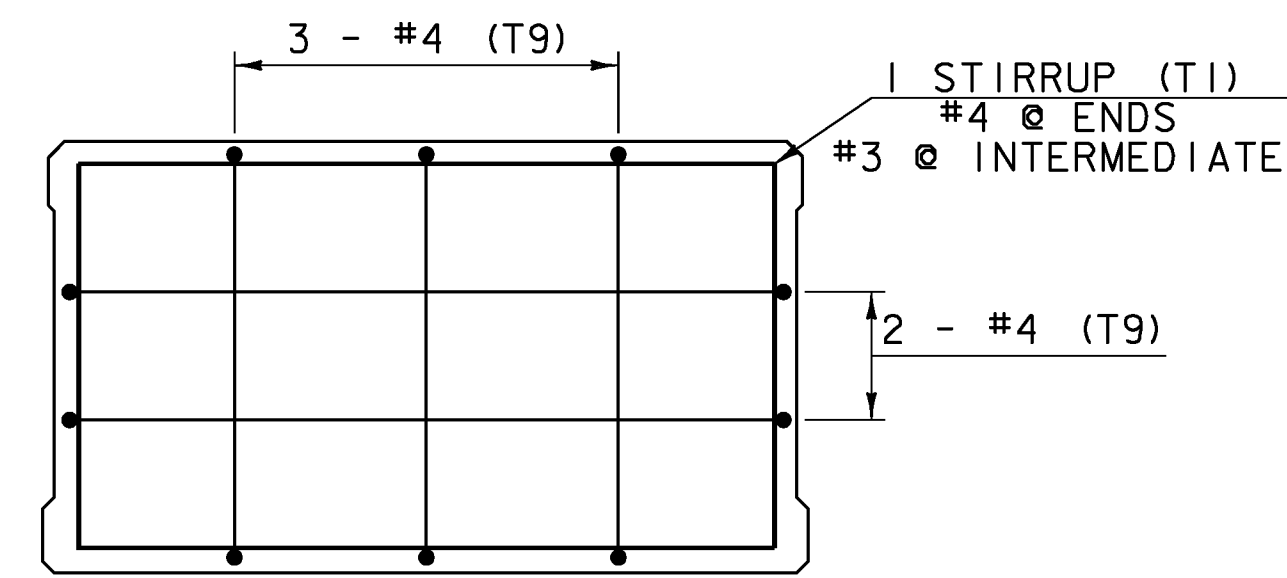


DIAPHRAGM REINFORCING  
(INTERIOR & EXTERIOR)

■ - SHIELDED AT ENDS FOR 6'


□ MAT EACH SIDE OF TRANVERSE DUCTS

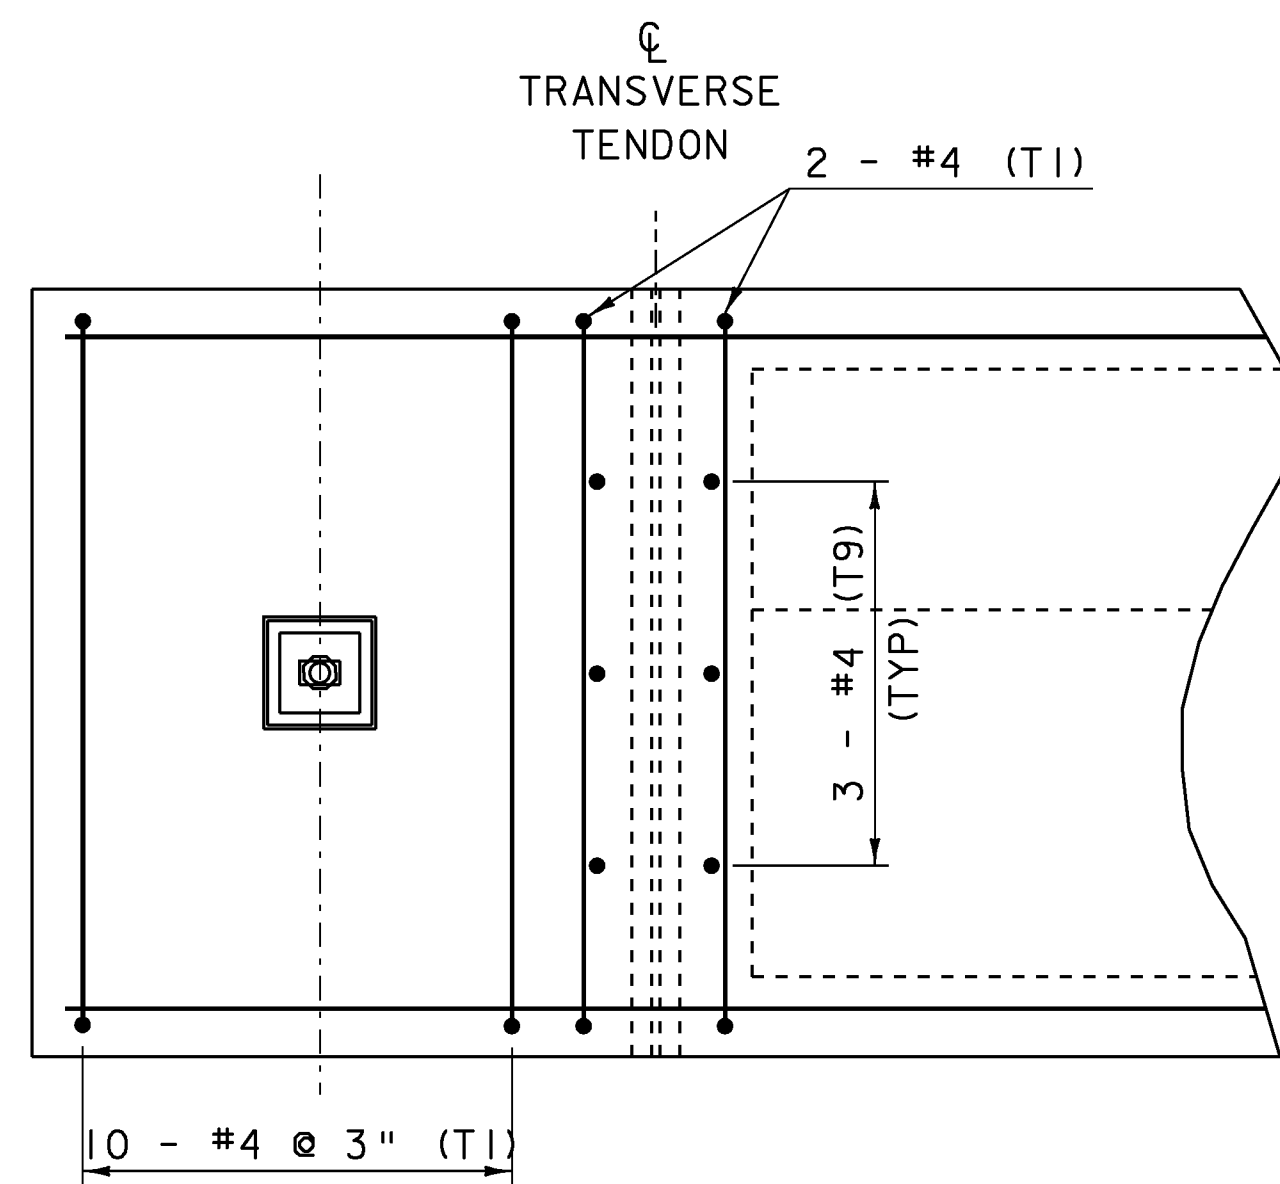

END DIAPHRAGM REINFORCING  
(INTERIOR & EXTERIOR)

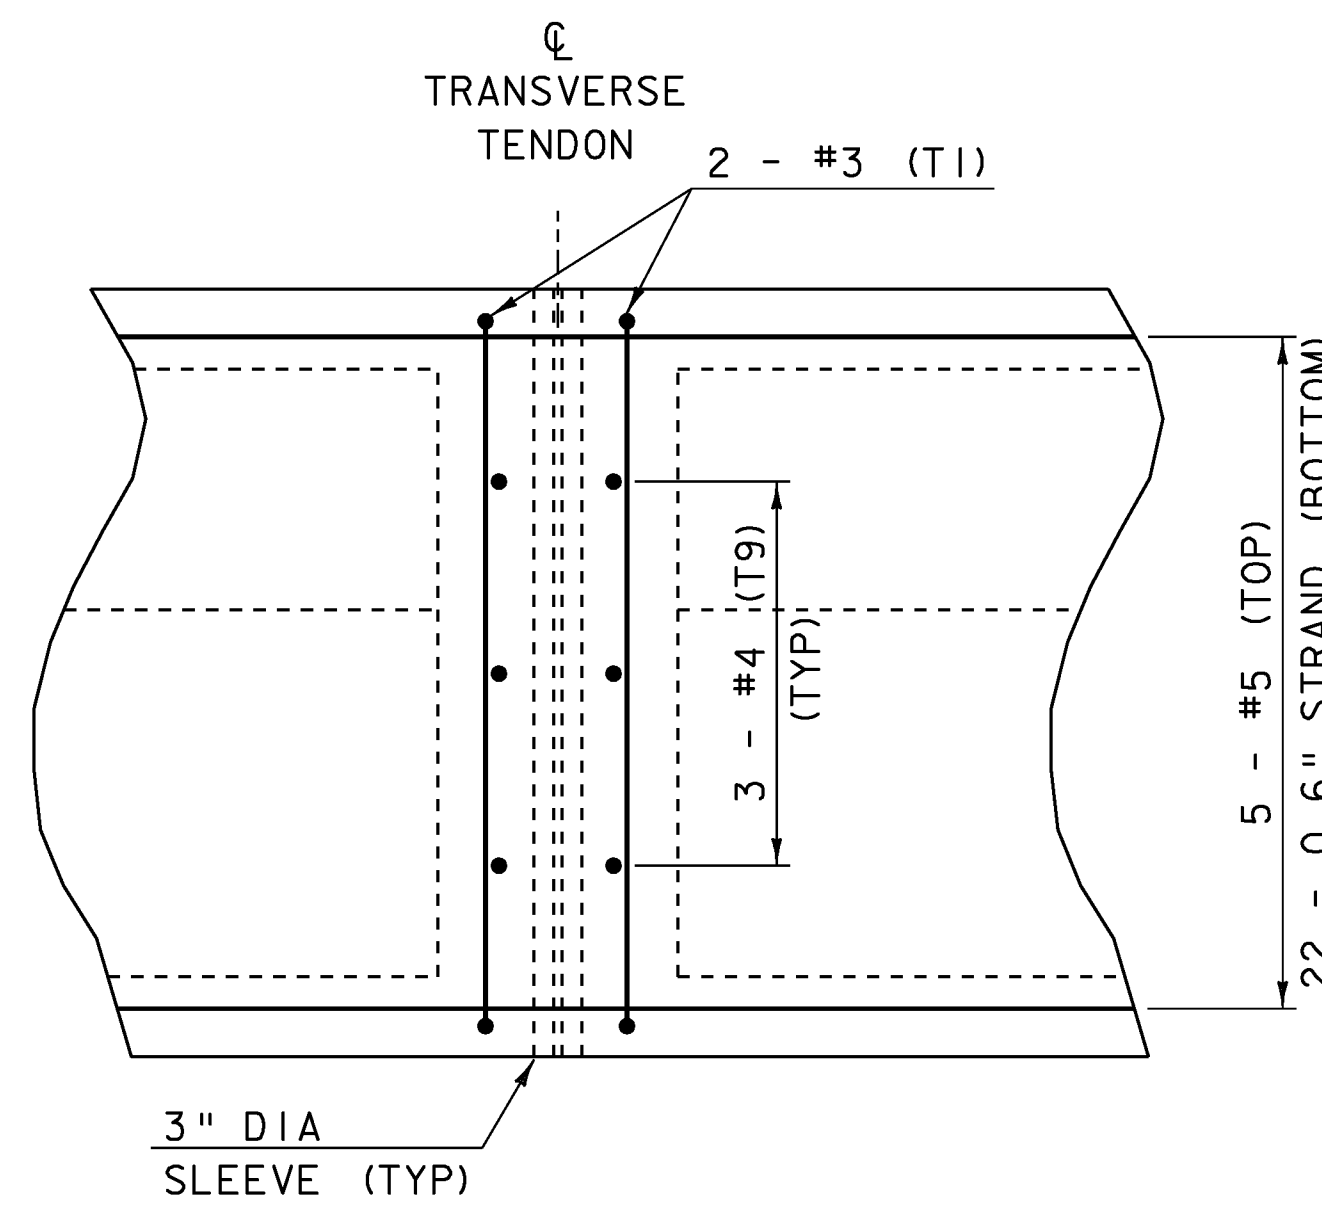


INTERMEDIATE DIAPHRAGM  
REINFORCING  
(INTERIOR & EXTERIOR)

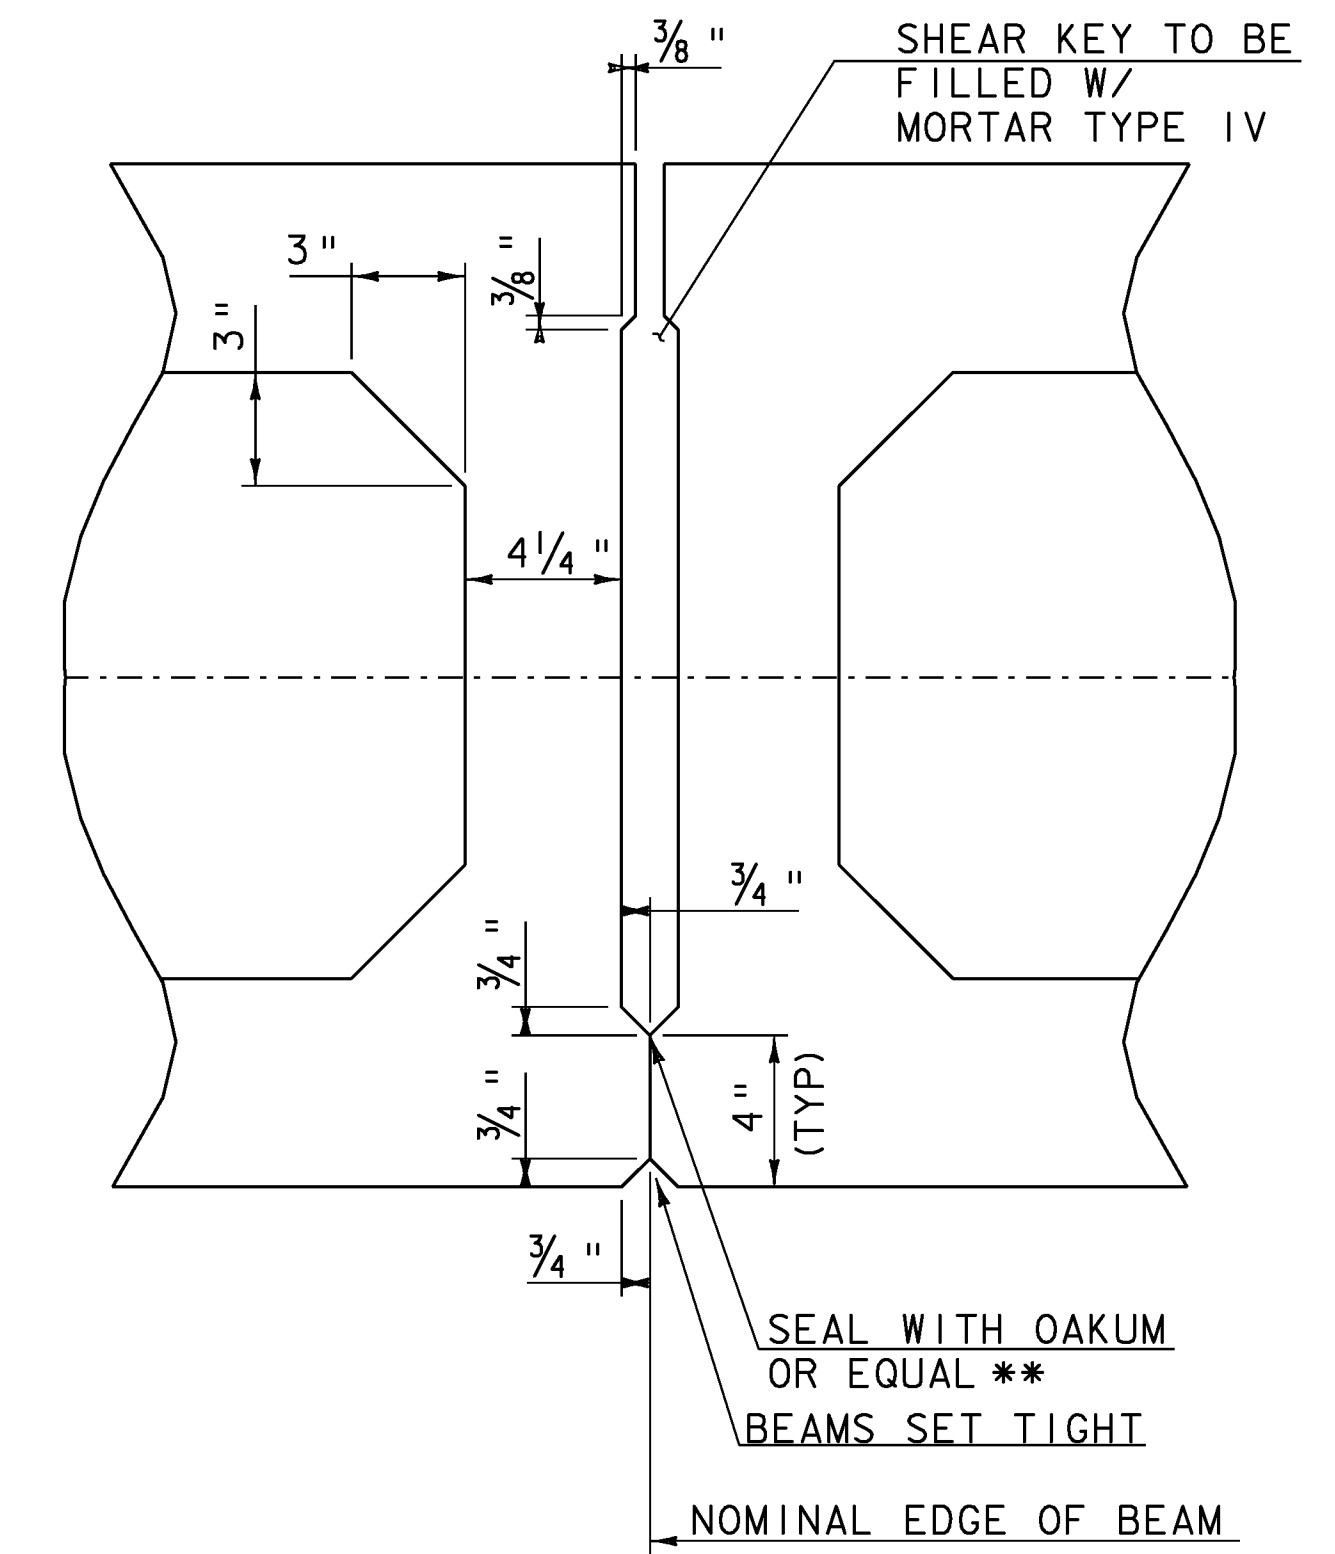


SHEAR KEY DETAIL  
FOR BOX BEAM

NTS

\*\* NOTE: INSTALL OAKUM AFTER UNITS HAVE BEEN PLACED

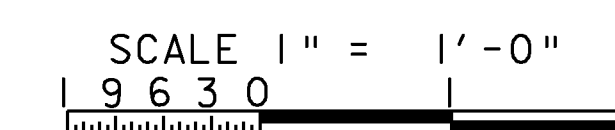


PROJECT NAME:	BRAINTREE	FILE NAME:	s95J292sup.dgn	PLOT DATE:	14-JAN-2010
PROJECT NUMBER:	BRO 1444(36)	PROJECT LEADER:	K. HIGGINS	DRAWN BY:	K. PATTERSON
		DESIGNED BY:	T. FILLBACH	CHECKED BY:	T. FILLBACH
		BOX BEAM DETAILS #1		SHEET	16 OF 26

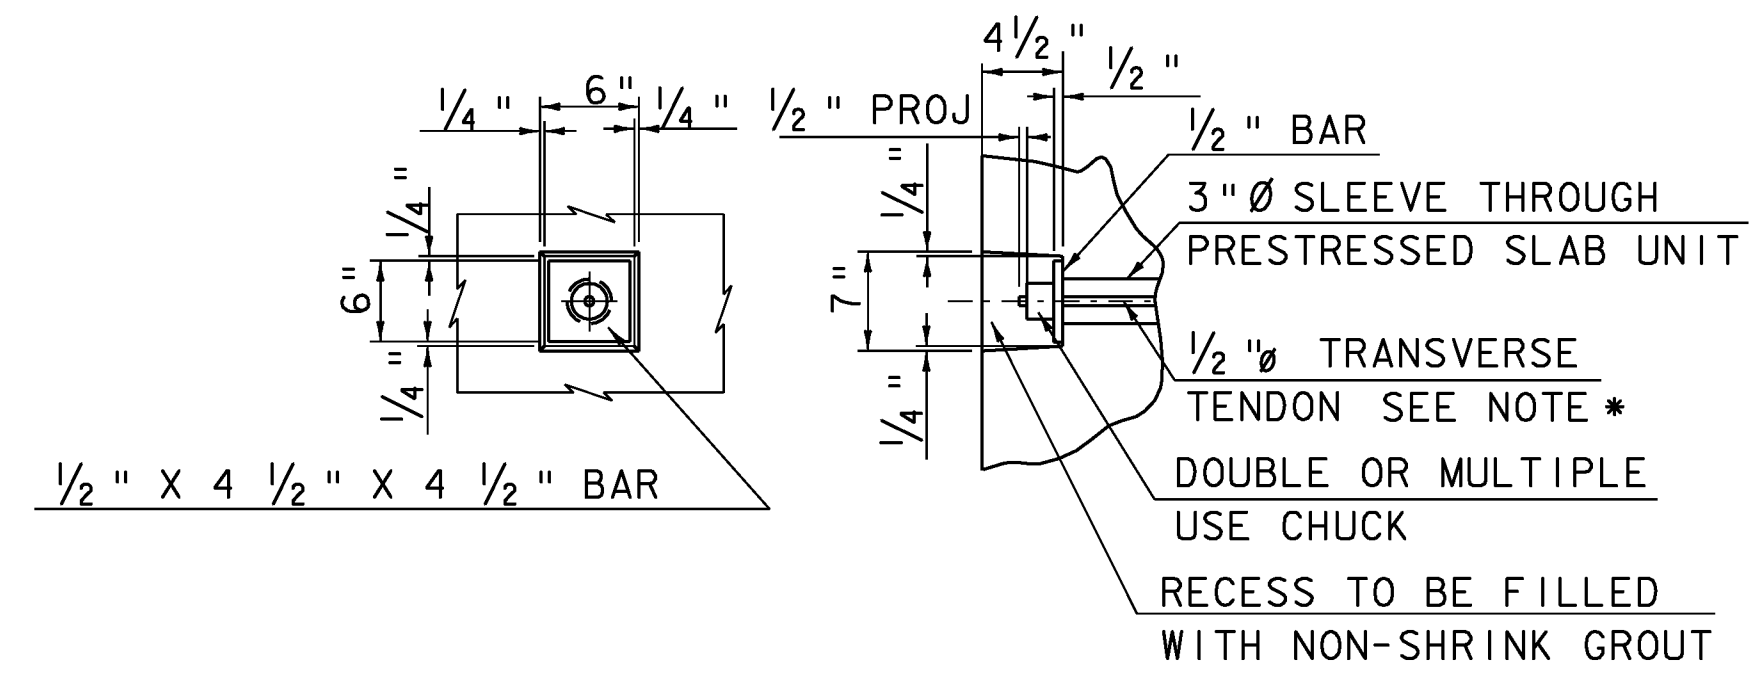


**1/2" Ø TRANSVERSE TENDON DETAIL**  
(NOT TO SCALE)


\* TRANSVERSE TIES SHALL BE COVERED BY SEAMLESS POLYPROPYLENE SHEATH (WITH CORROSION INHIBITER GREASE BETWEEN SHEATH AND STRAND) FOR THE LENGTH OF STRAND, EXCEPT AT ANCHORAGE LOCATIONS, EACH STRAND SHALL BE TENSIONED TO 33 KIPS

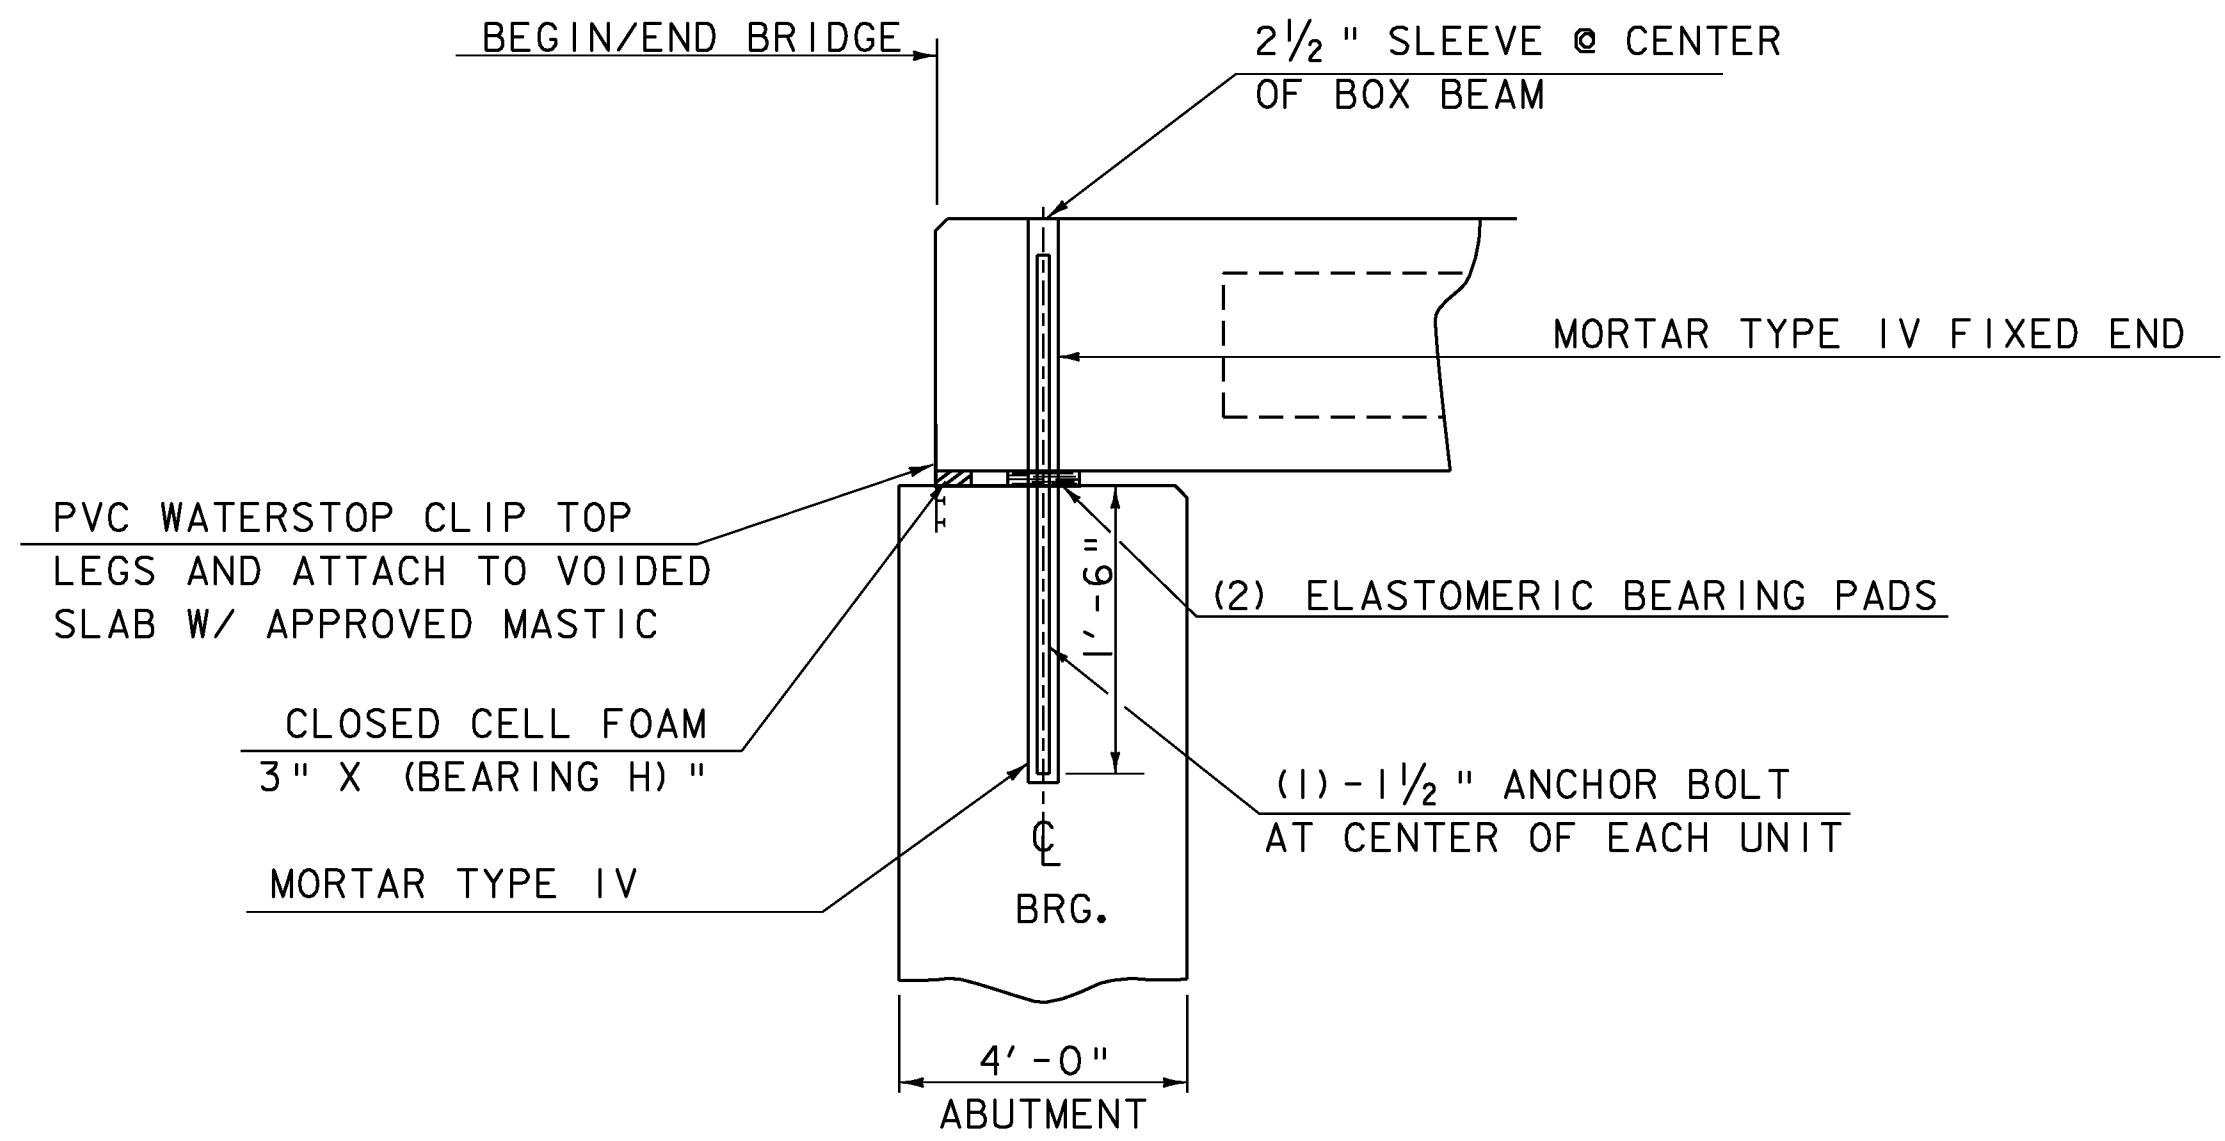

**VOIDED SLAB/BOX BEAM**  
**NO PAVEMENT/NO APPROACH SLAB**  
(NOT TO SCALE)


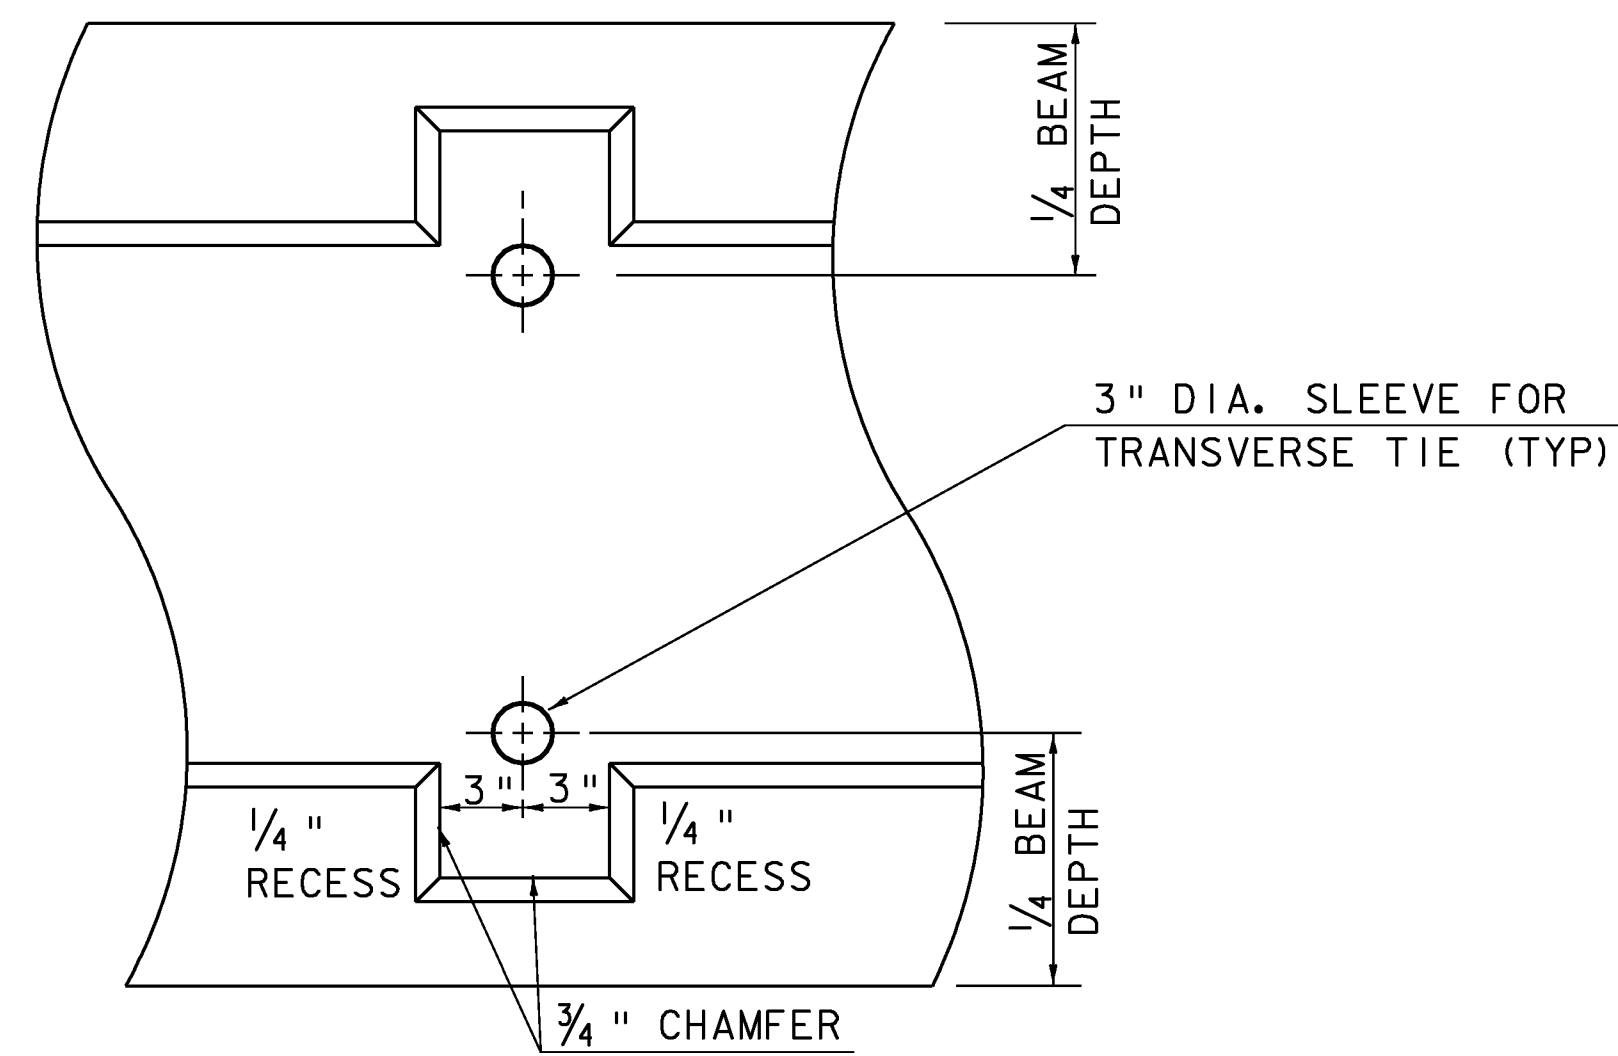


**TYPICAL BEAM ELEVATION AT TRANSVERSE TIE LOCATIONS**  
(NOT TO SCALE)

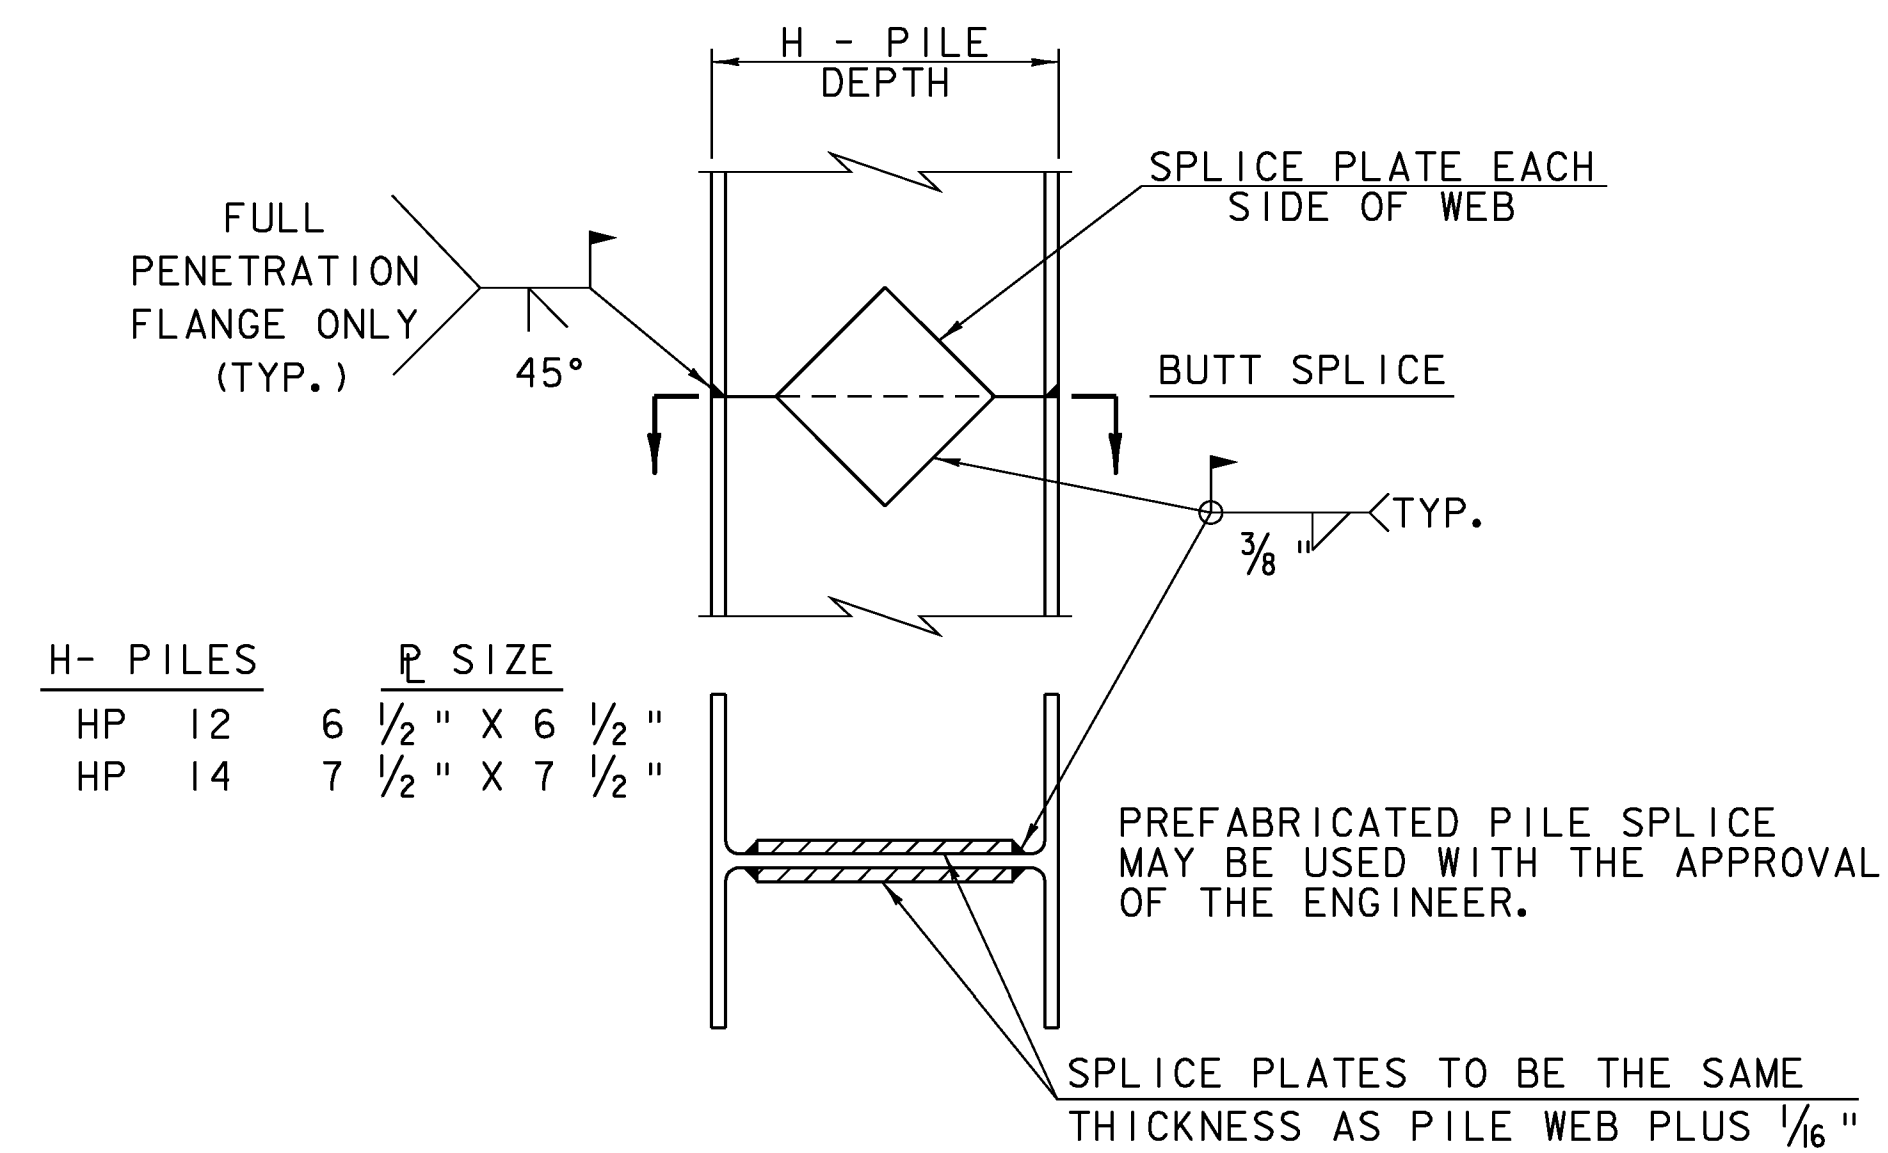

**DETAIL OF PILE SPLICE**  
(NOT TO SCALE)


PROJECT NAME:	BRAINTREE
PROJECT NUMBER:	BRO 1444(36)
FILE NAME:	s95J292sup.dgn
PROJECT LEADER:	K. HIGGINS
DESIGNED BY:	T. FILLBACH
BOX BEAM DETAILS #2	
PLOT DATE:	31-DEC-2009
DRAWN BY:	K. PATTERSON
CHECKED BY:	T. FILLBACH
SHEET	17 OF 26

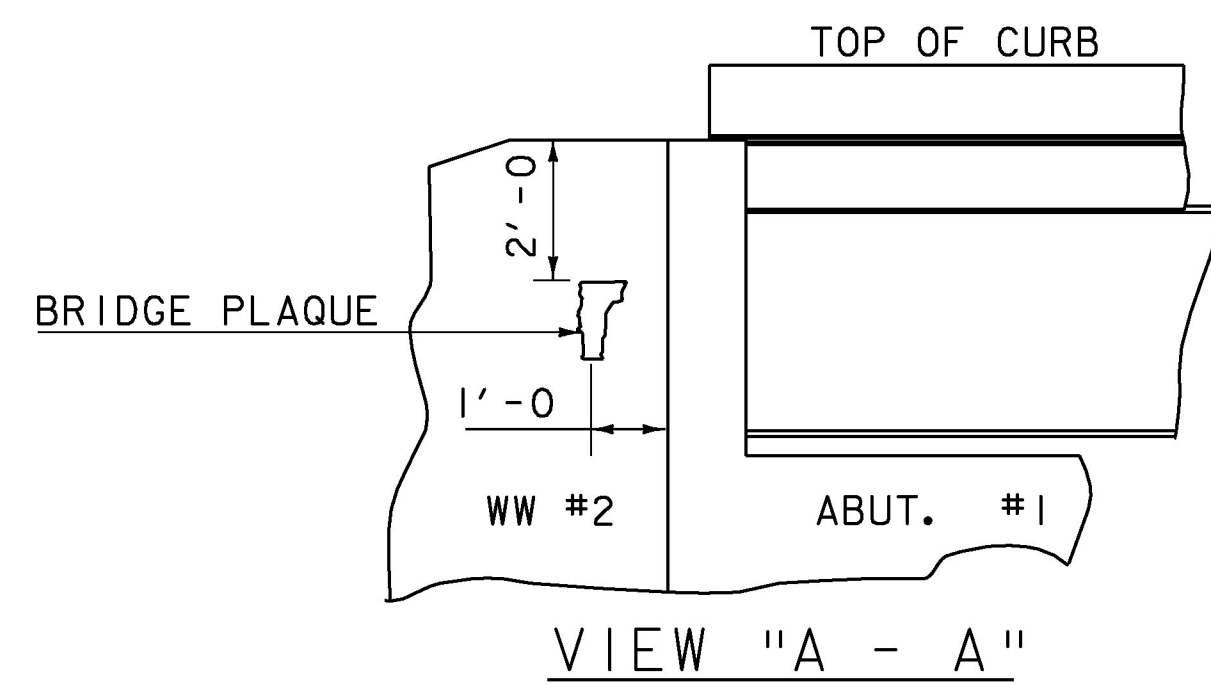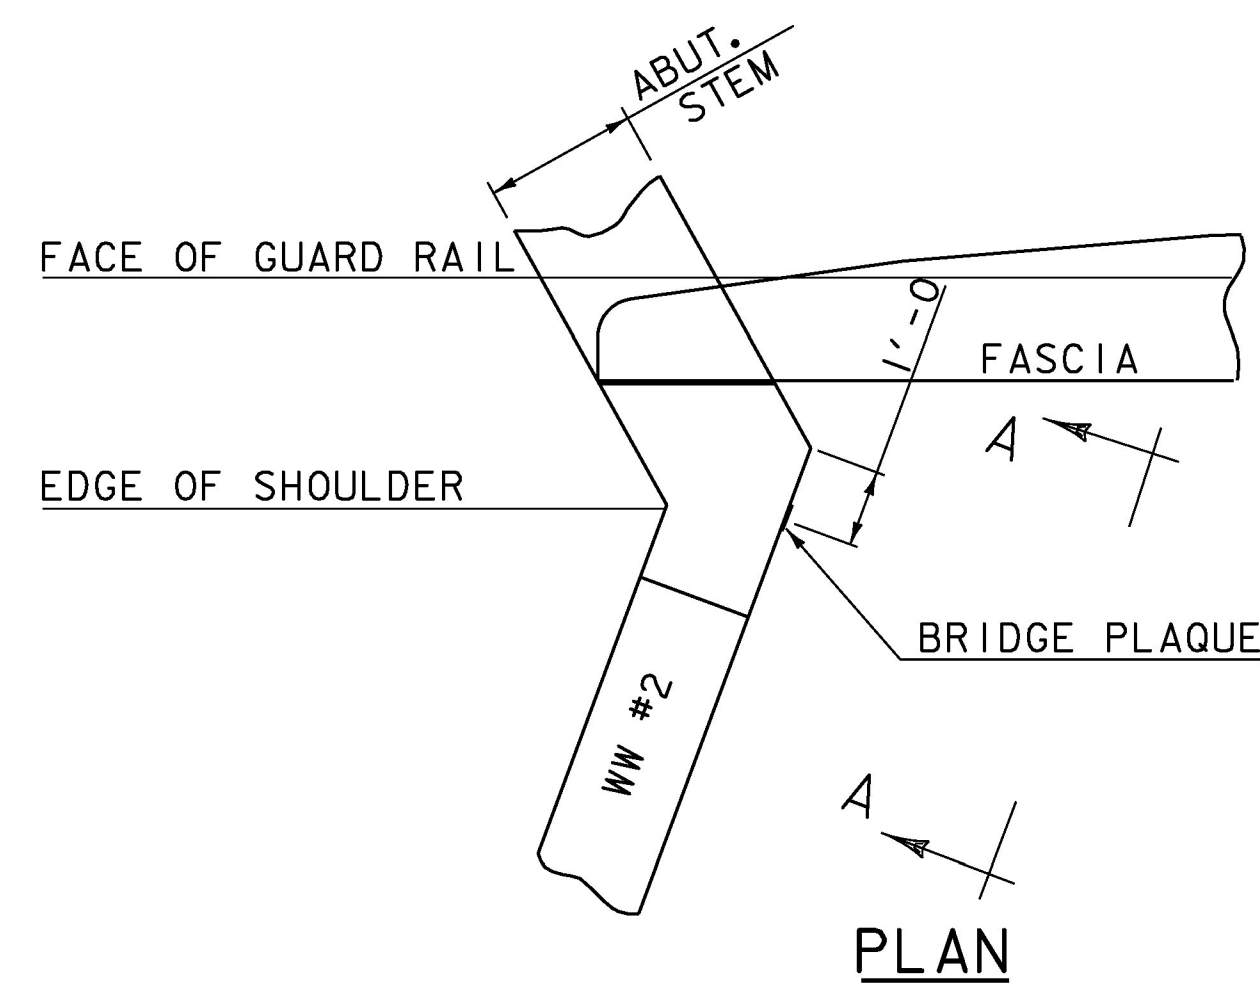

**BRIDGE PLAQUE**  
(NOT TO SCALE)

THE BRIDGE PLAQUE WILL BE SUPPLIED BY THE AGENCY OF TRANSPORTATION AND SHALL BE INSTALLED BY THE CONTRACTOR AT ABUTMENT #1 ON THE RIGHT SIDE AS SHOWN OR AS DIRECTED BY THE ENGINEER.


PAYMENT FOR INSTALLATION OF THE BRIDGE PLAQUE SHALL BE INCIDENTAL TO THE ADJACENT CONCRETE.

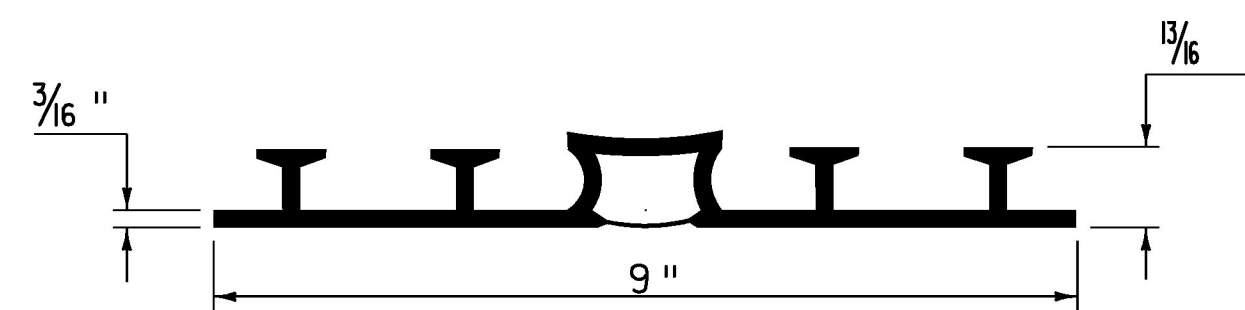


**P.V.C. WATERSTOP FOR EXPANSION JOINTS**  
(NOT TO SCALE)

PAYMENT FOR THE P.V.C. WATERSTOP SHALL BE INCIDENTAL TO THE UNIT BID PRICE FOR THE ADJACENT CONCRETE.

OTHER CONFIGURATIONS OF WATERSTOP MAY BE USED UPON APPROVAL OF THE ENGINEER.

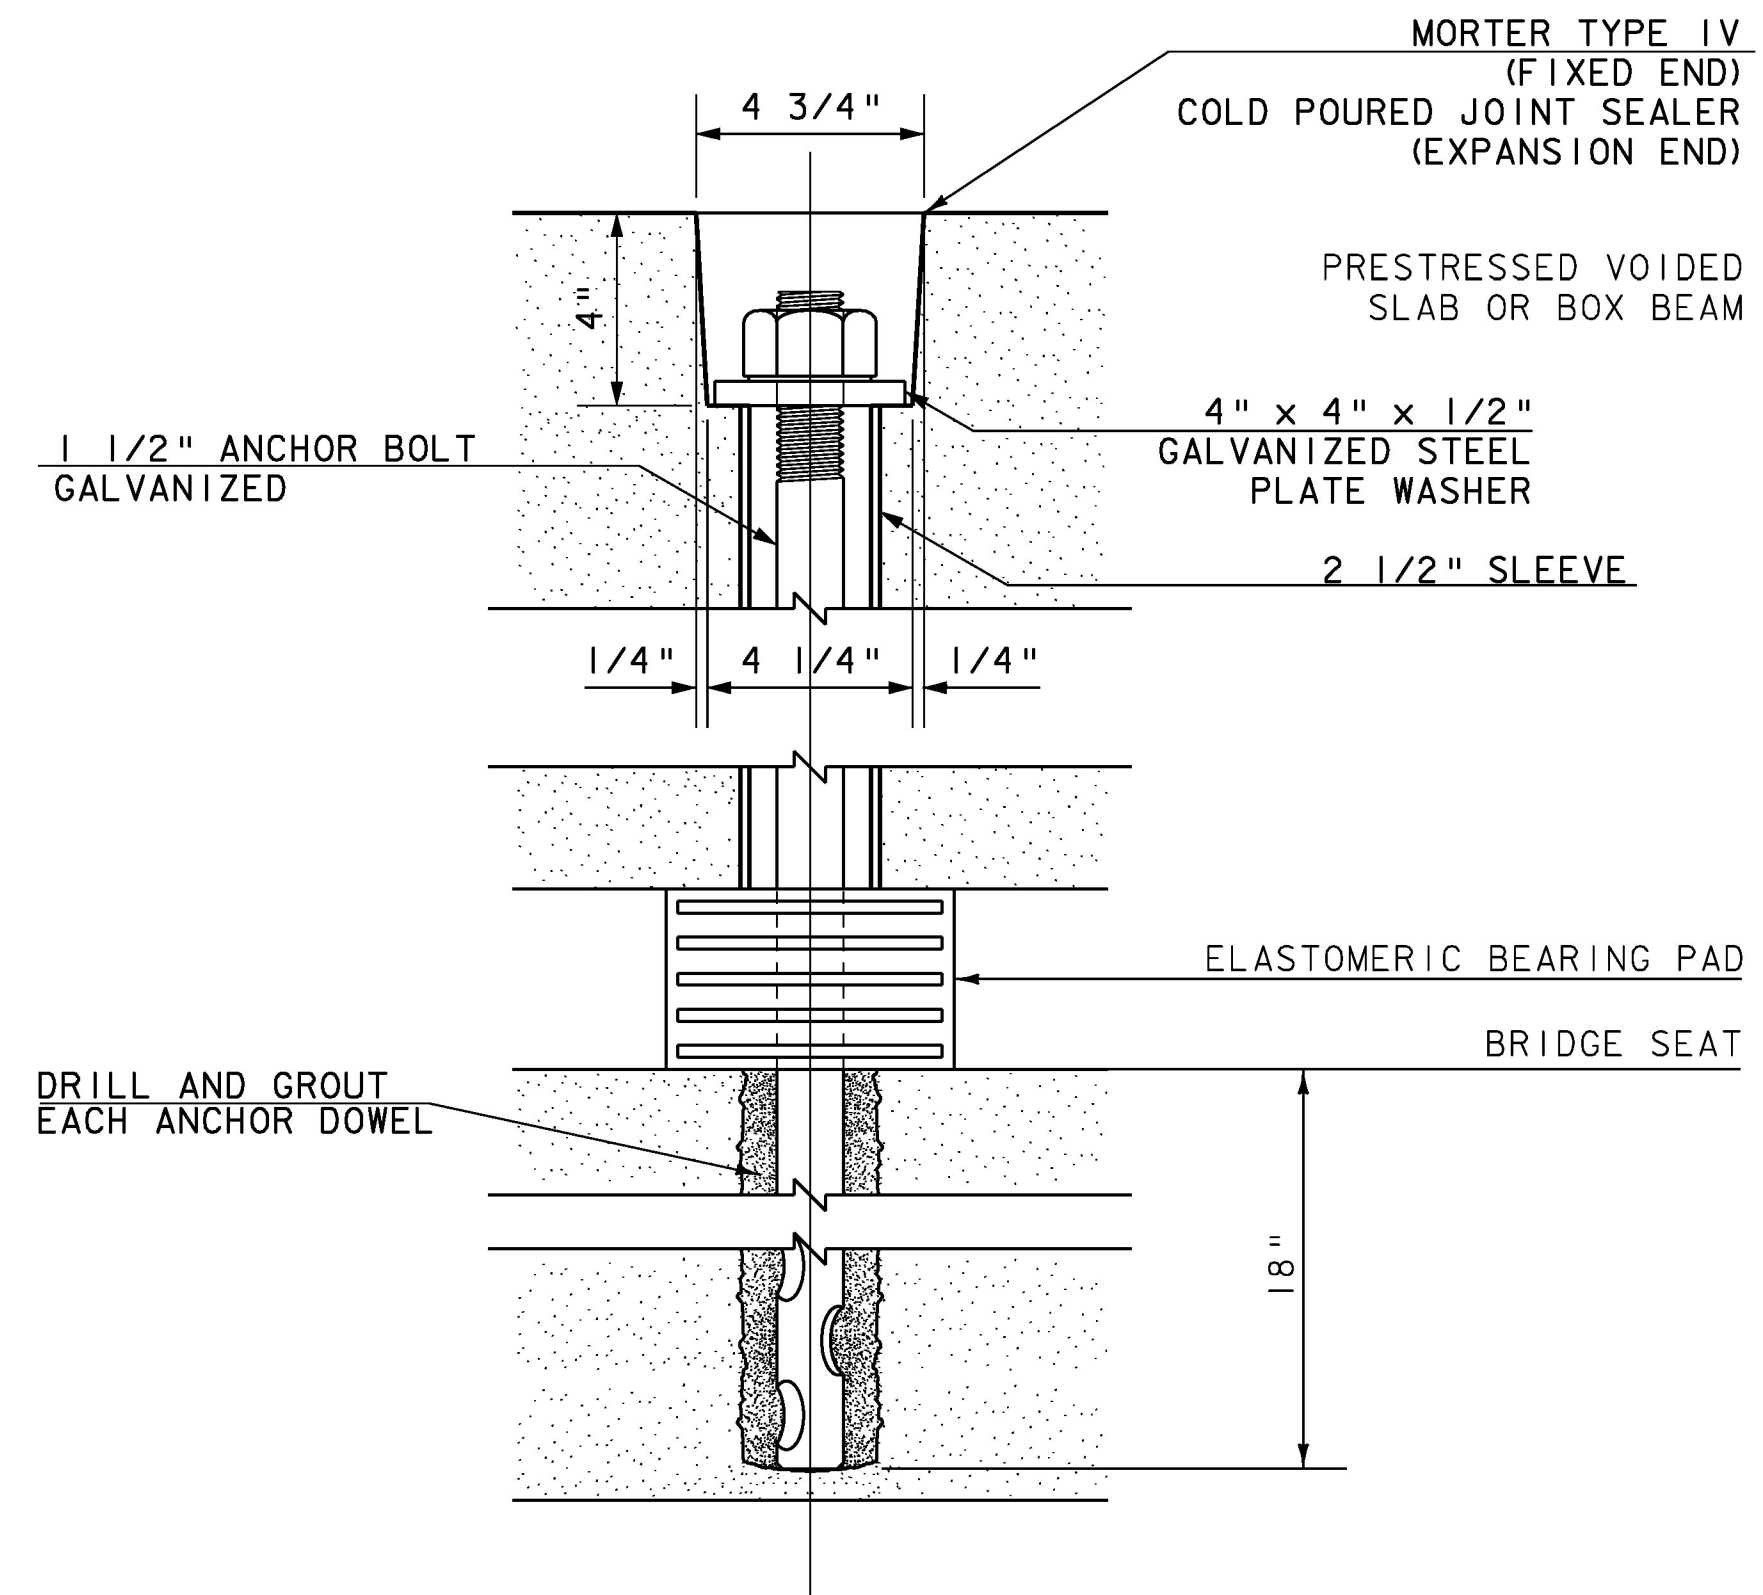


**ANCHOR BOLT DETAIL**  
(NOT TO SCALE)

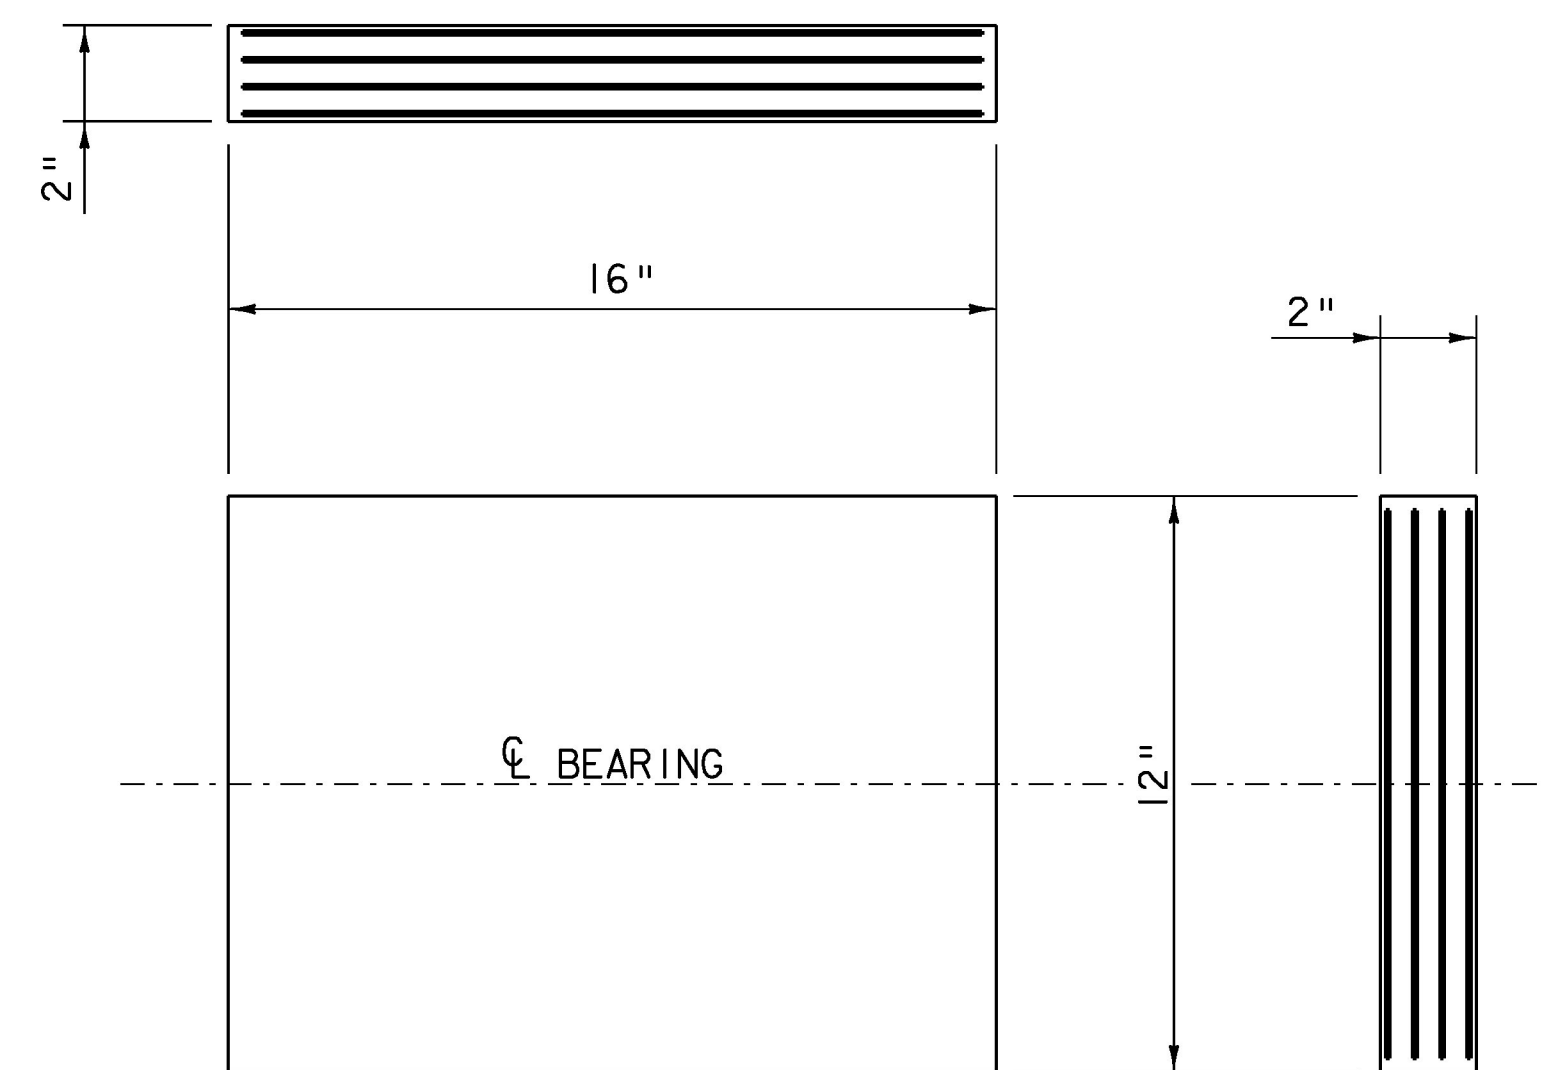

**ELASTOMERIC BEARING DETAIL**

- 2 - 1/8" EXTERIOR LAYERS OF ELASTOMER
- 3 - 1/2" INTERIOR LAYERS OF ELASTOMER
- 4 - 1/16" STEEL REINFORCING PLATES

SCALE 3" = 1'-0"

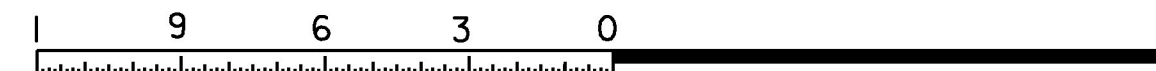


**Bearing Notes**

1. Bearings shall conform to the applicable subsections of Standard Specifications sections 531 and 731.
2. The bearings, including anchor bolts, drilling and grouting, washers and nuts shall be paid for under the item 531.11 "Bearing Device Assembly, Elastomeric Pad."
3. All washers shall be 1/2" plate (minimum).
4. All plates, nuts, washers and anchor bolts, unless noted otherwise, shall be galvanized or metalized as per subsections 531.04 (b) and 506.15 of the Standard Specifications. If the bearings are metalized, they shall be sealed with an approved sealer as specified in subsection 506.15 (b) of the standard specifications. Areas of galvanizing or metalizing damaged by field welding or handling shall be repaired in conformance with standard specification 513.
5. All steel in the bearing devices shall be AASHTO M270M/M270 Grade 50, unless noted otherwise.
6. Anchor bolts shall be ASTM A-449, type I with a yield strength of 58 ksi and have a minimum embedment of 18" into the concrete and shall conform to subsection 714.08.
7. All reinforcement between layers of elastomer shall be steel AASHTO M270M/M270 Grade 36. All internal steel plates shall be sand blasted and free of coatings, rust and mill scale. The plates shall be free of sharp edges and burrs.
8. Steel reinforced elastomeric bearings shall have a minimum 1/8" edge seal of elastomer integral with bearing over all internal plates.
9. The elastomer was designed with a shear modulus of 100 psi +/- 15%.
10. The elastomer shall meet the requirements of Low Temperature Zone D, Grade 4.
11. The concrete under the bearing device shall be level.
12. All designs done for the bearings shall be per the AASHTO LRFD Bridge Design Specifications 4th edition and its latest revisions.
13. Alternate configurations for bearings may be submitted for approval. Any alternate submitted shall be designed and certified to meet the design loads and criteria shown on the plans.
14. Bridge seat elevations may be revised to accommodate an alternative configuration.


Design Load (kip)	Service Limit State	Vertical	Max	74.4
			Min	28.4
Strength Limit State		Permanent	30.6	
		Transverse	6.7	
		Longitudinal	2.5	
Service Limit State		Vertical	113.1	
		Transverse	22.9	
		Longitudinal	16.5	
Translation (in)	Service Limit State	Irreversible	Transverse	0
			Longitudinal	1/16
		Reversible	Transverse	1/8
			Longitudinal	1/2
Rotation (rad)	Service Limit State	Irreversible	Transverse	0.000
			Longitudinal	0.018
			Reversible	Transverse
		Longitudinal	0.009	

PROJECT NAME:	BRAINTREE
PROJECT NUMBER:	BRO 1444(36)
FILE NAME:	s95J292sup.dgn
PROJECT LEADER:	K. HIGGINS
DESIGNED BY:	T. FILLBACH
BEARING DETAILS	
PLOT DATE:	31-DEC-2009
DRAWN BY:	T. FILLBACH
CHECKED BY:	J. LACROIX
SHEET	18 OF 26

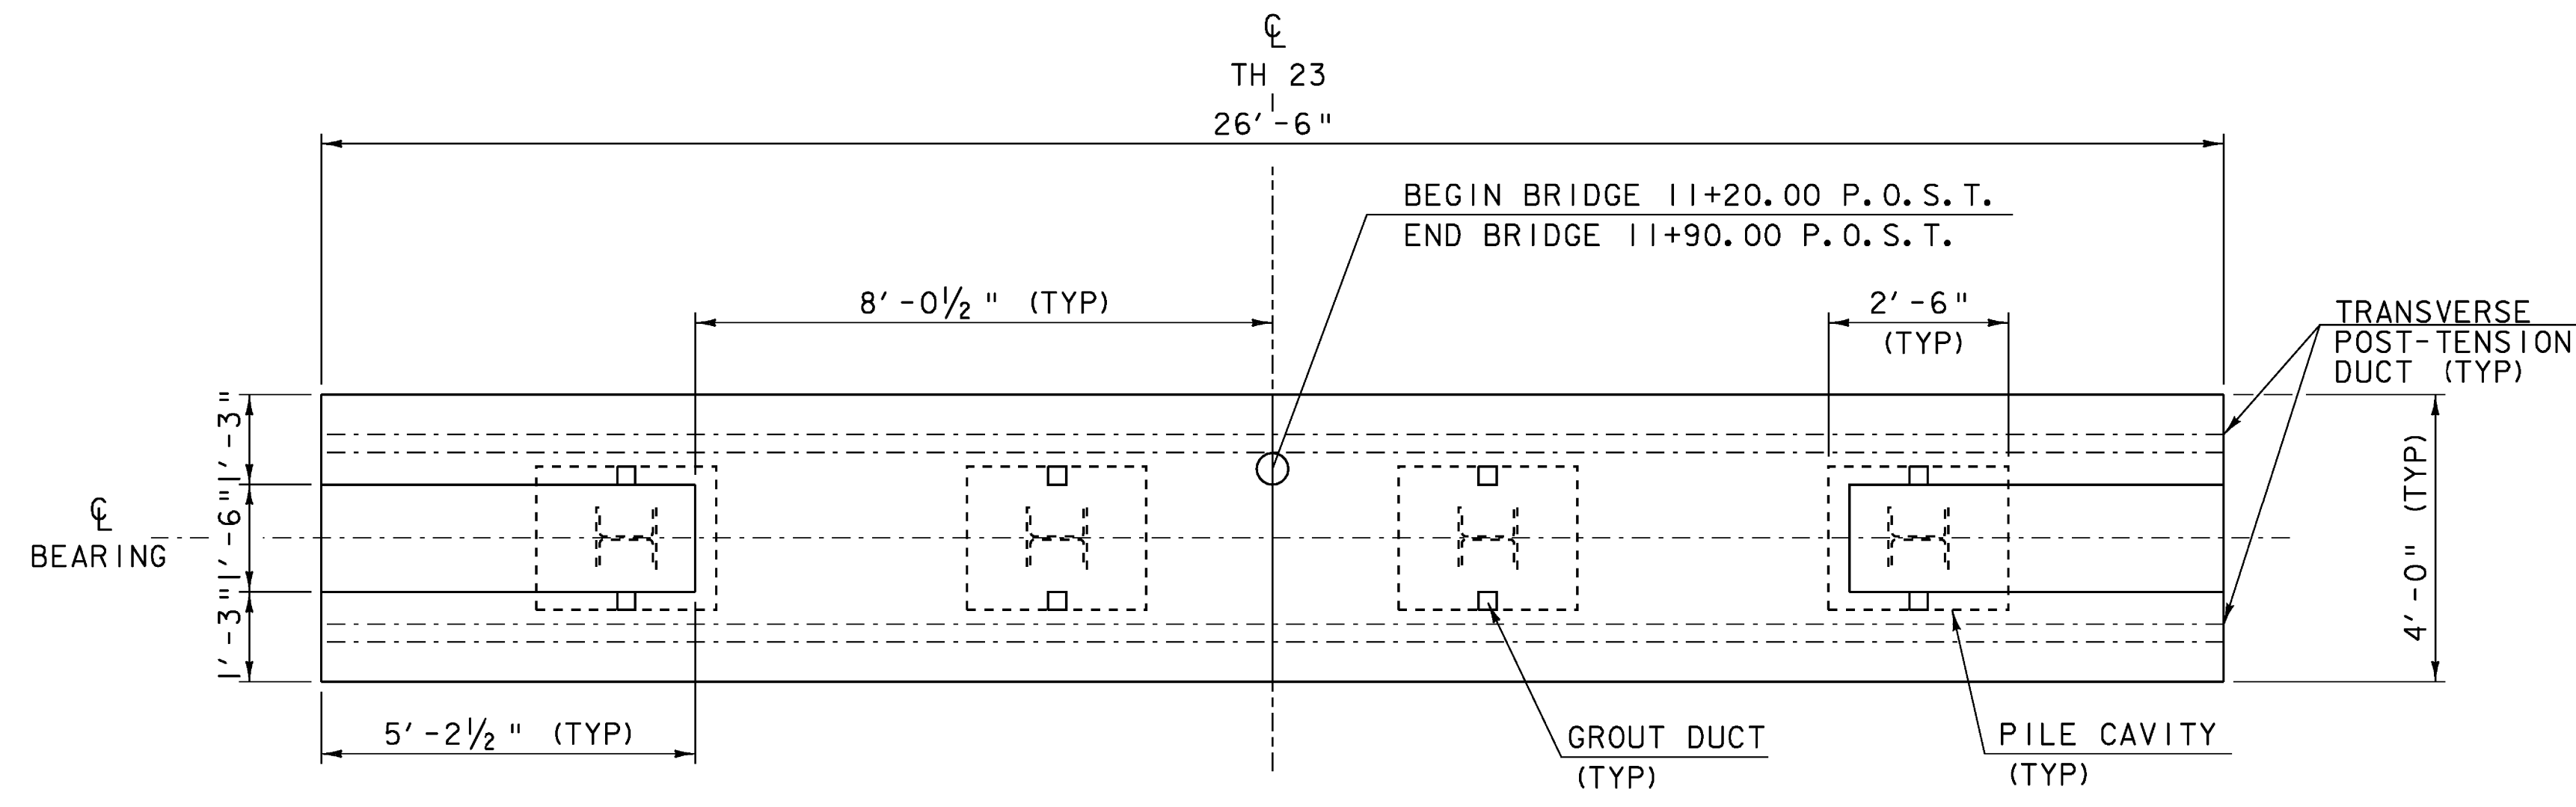

TYPICAL ABUTMENT PLAN


SCALE 1/2" = 1'-0"

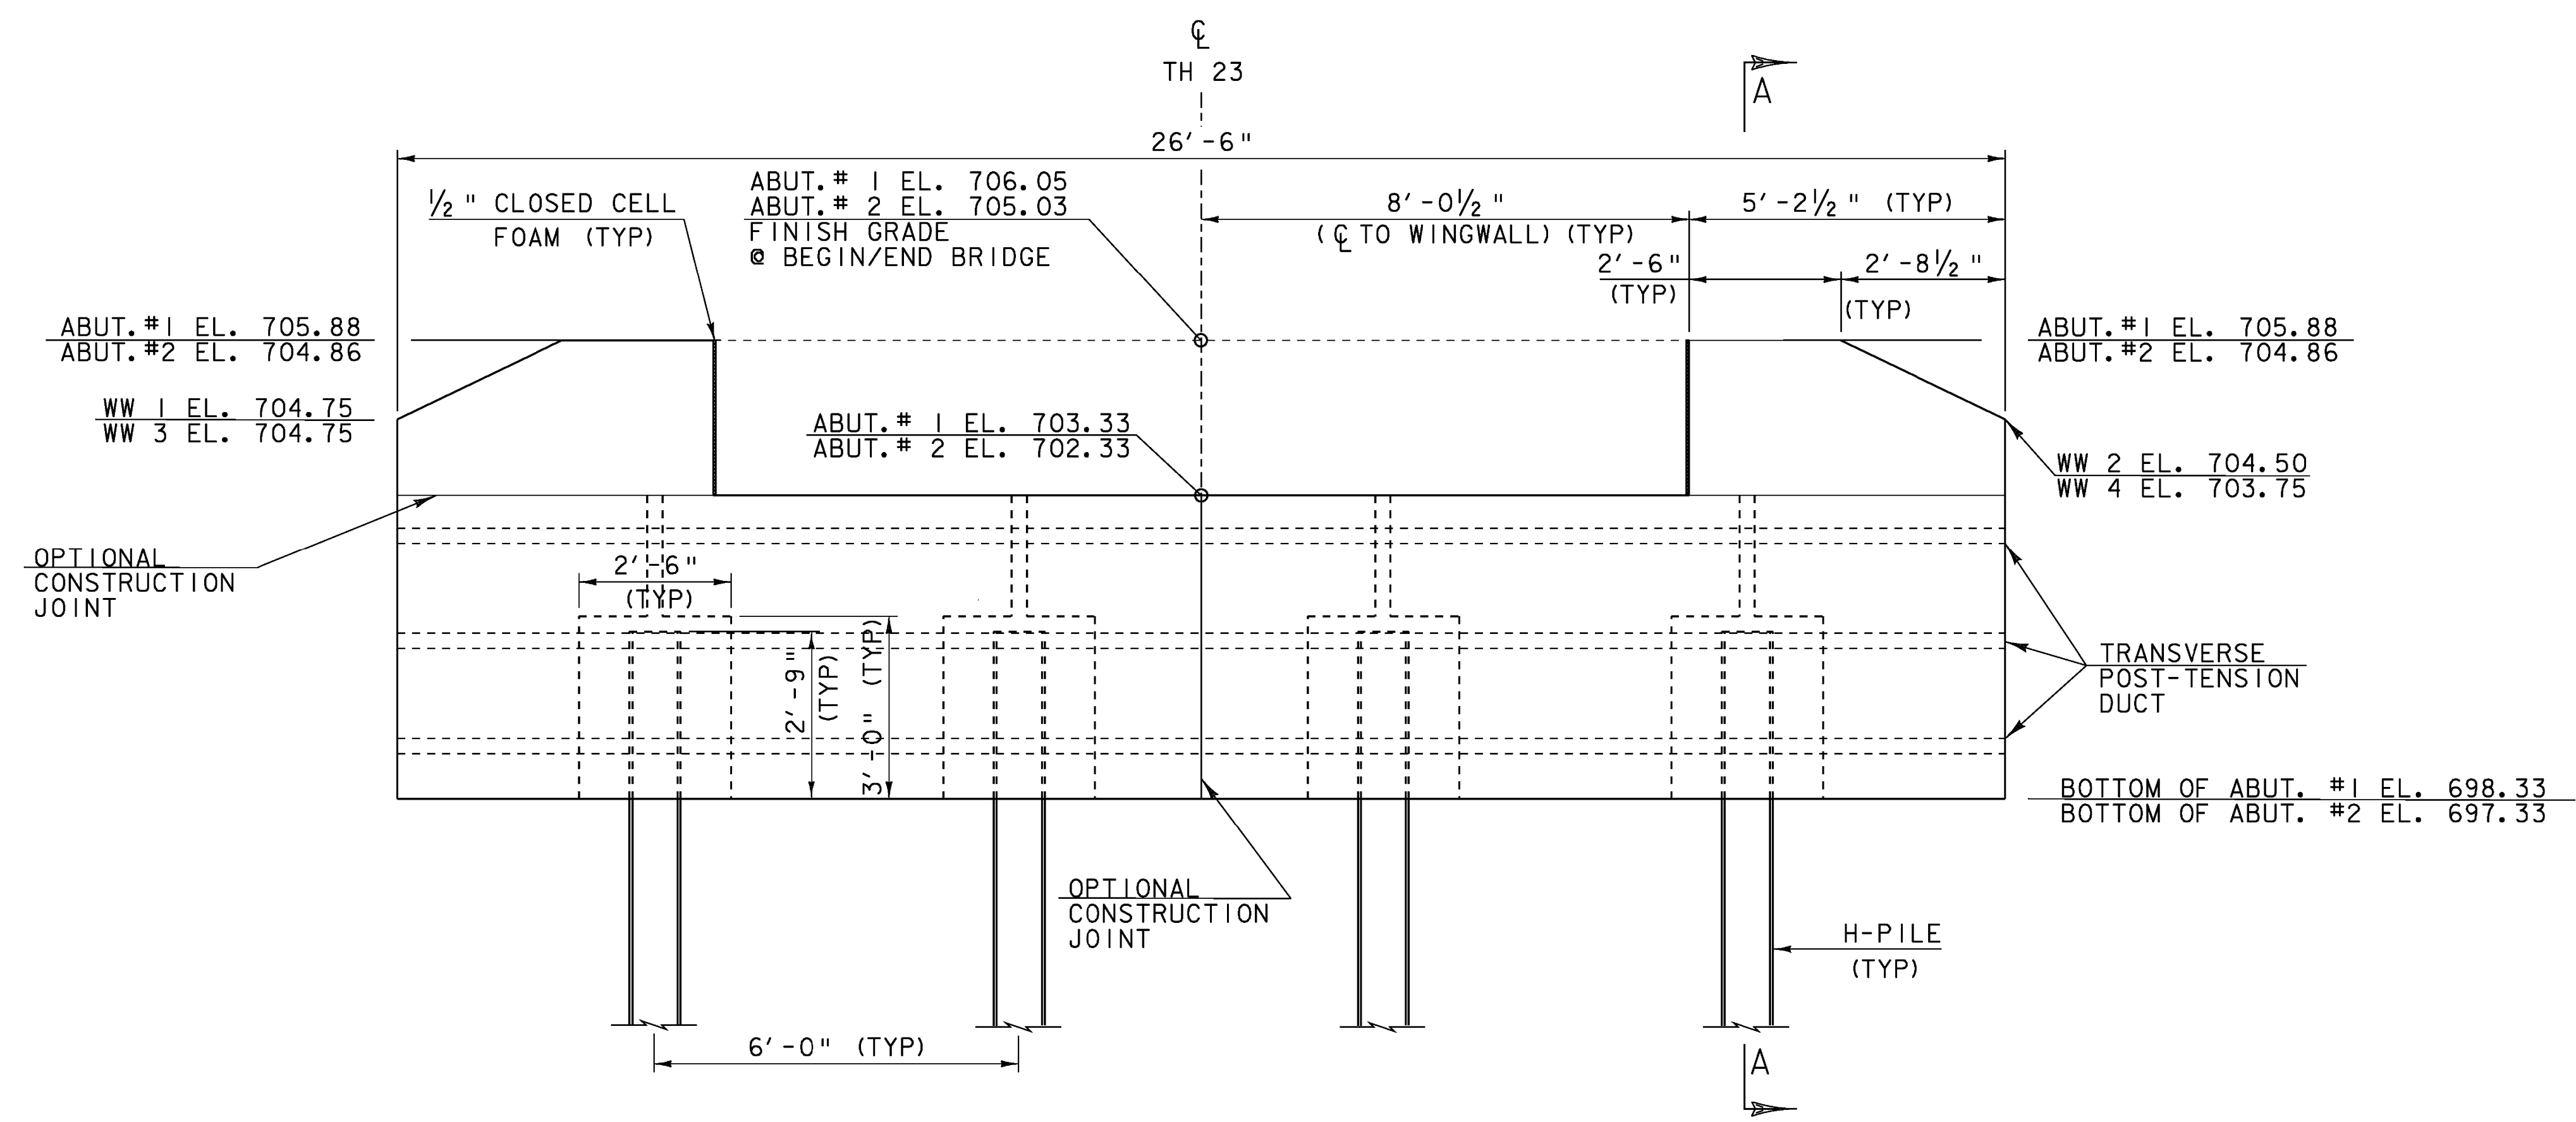

TYPICAL ABUTMENT ELEVATION

SCALE 1/2" = 1'-0"

NOT BUILT, USED CAST-IN-PLACE  
 SEE SHOP DRAWINGS FOR DETAILS

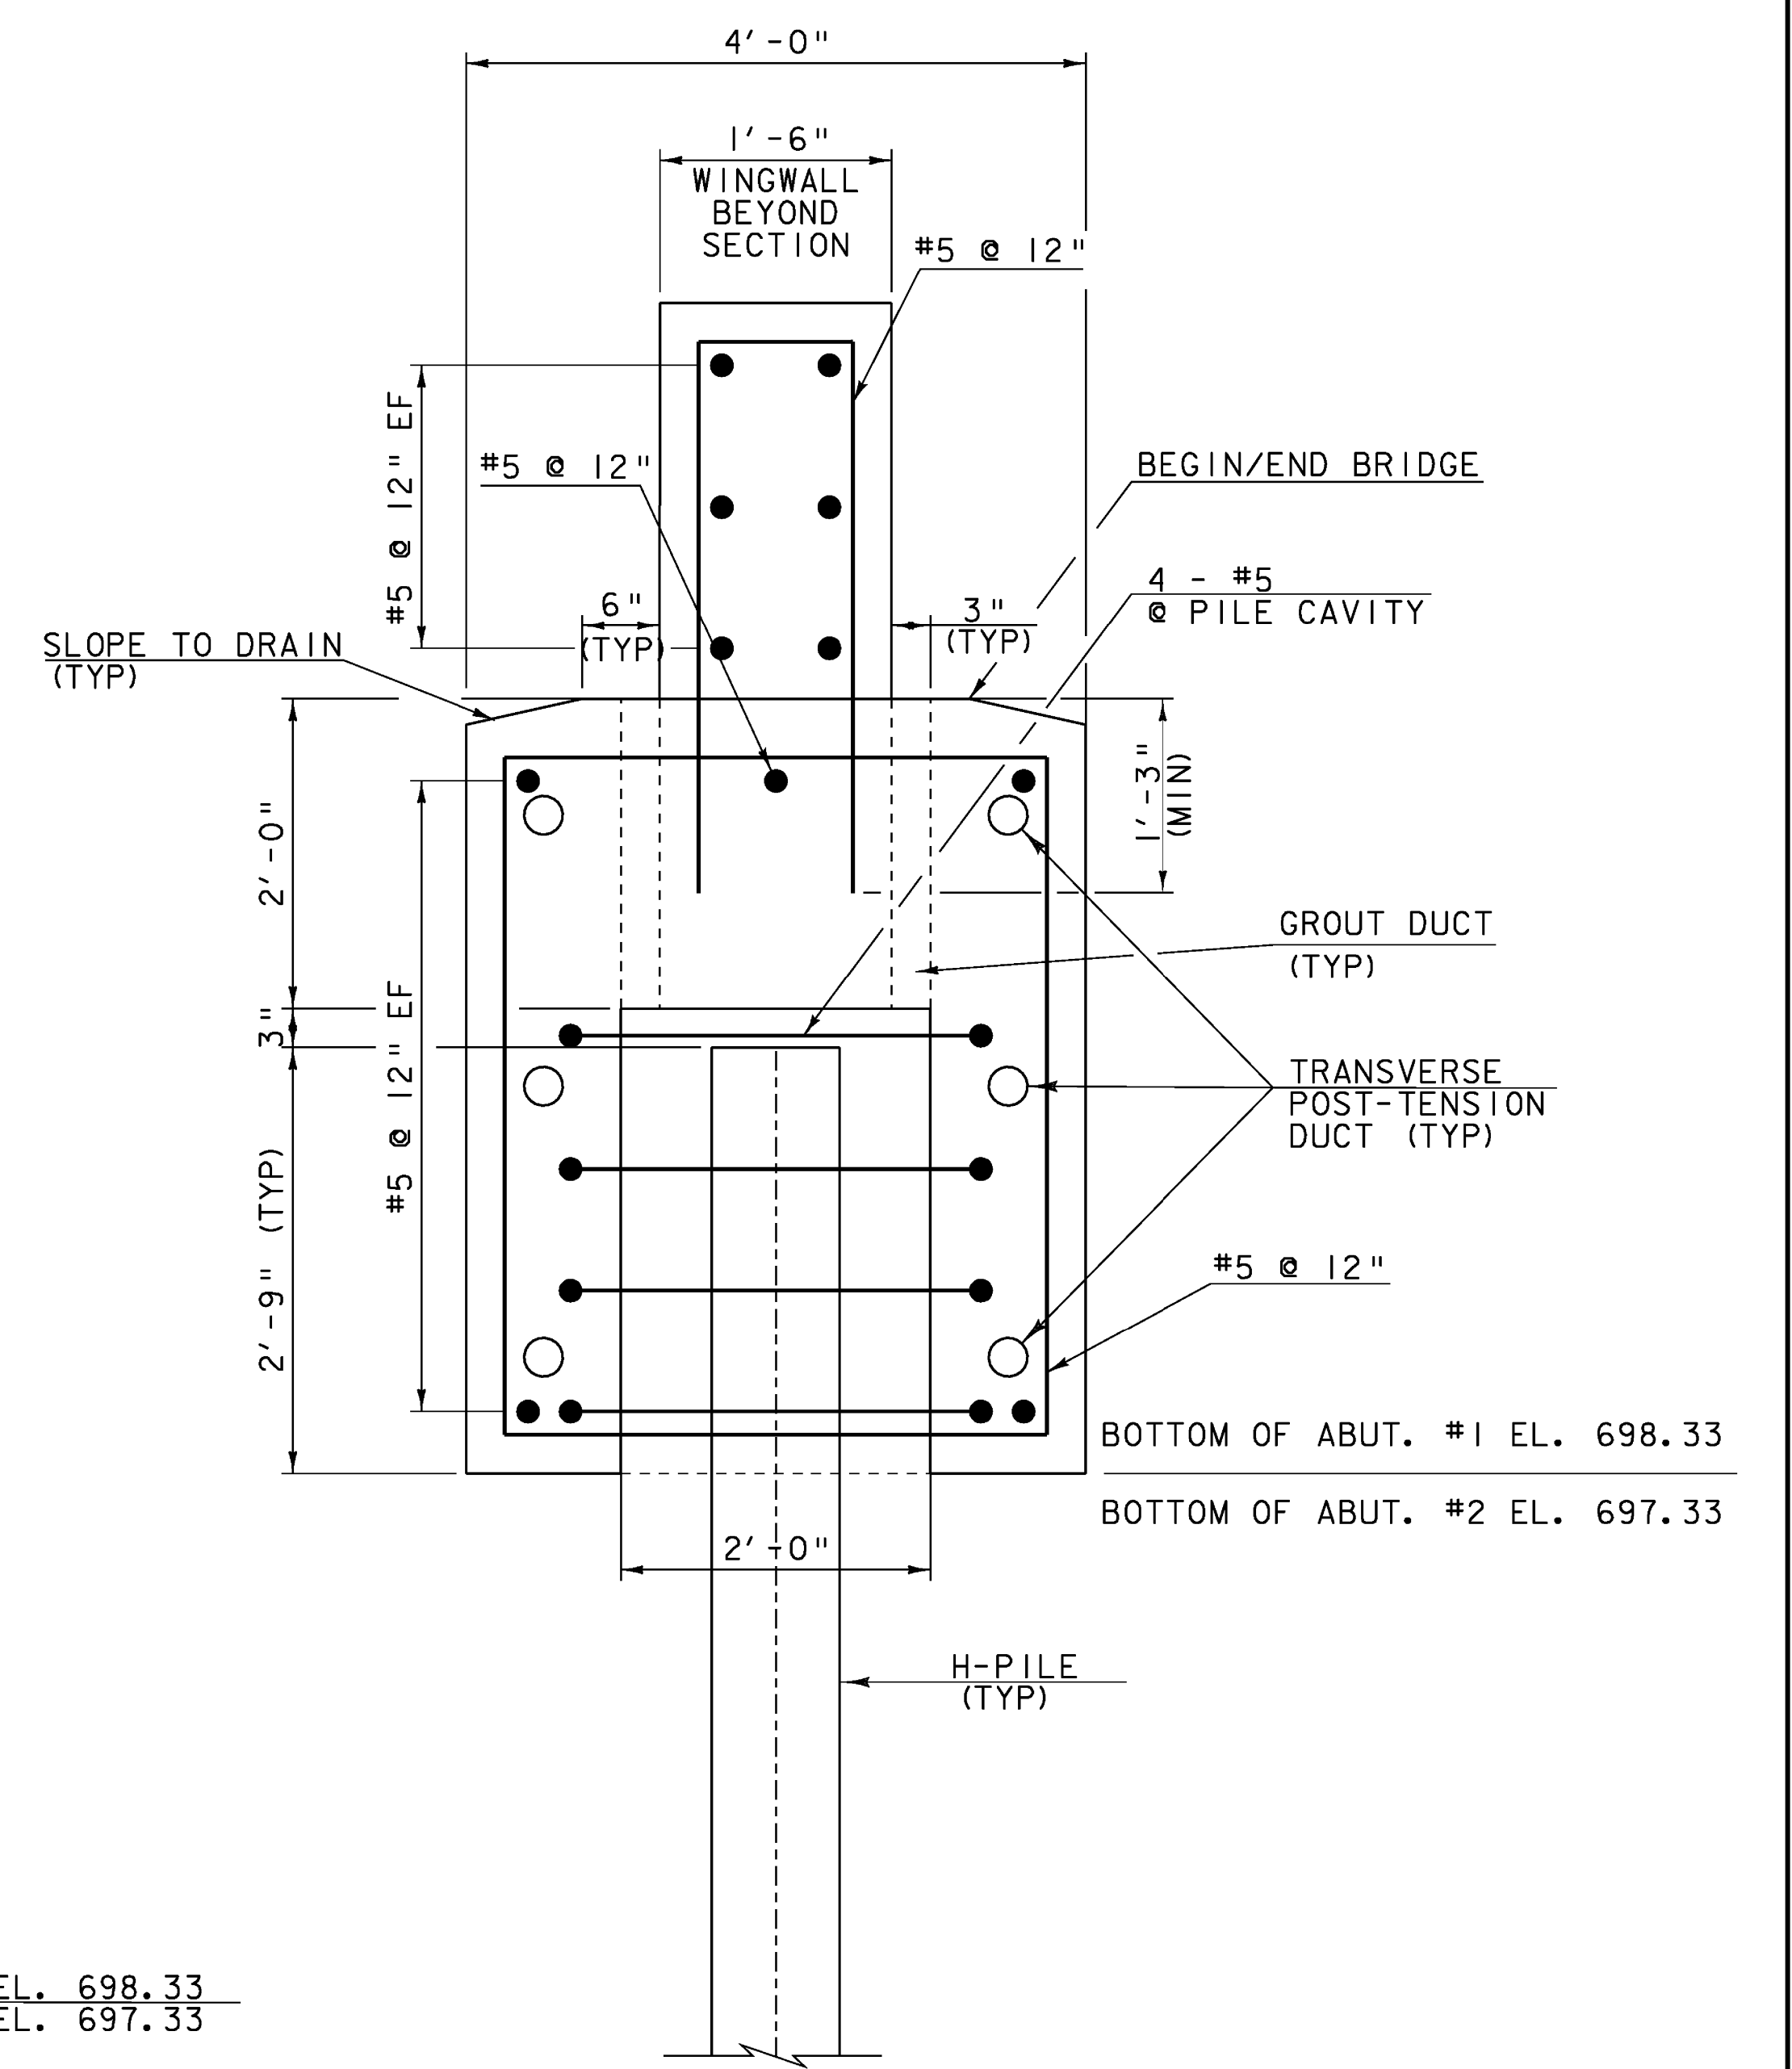

SECTION A-A

SCALE 1" = 1'-0"


NOTE:  
 NF = NEAR FACE  
 FF = FAR FACE  
 EF = EACH FACE  
 ▲ = CUT TO FIT IN FIELD  
 3" CLEAR, UNLESS OTHERWISE SPECIFIED ON THE PLANS.  
 2'-2" BAR LAP UNLESS OTHERWISE SPECIFIED ON THE PLANS.

NOTES:  
 ONCE PILES HAVE BEEN CUT TO THEIR FINAL ELEVATIONS, 1" x 12" x 12" STEEL PLATES SHALL BE WELDED TO THE TOP OF THE PILES.

PILE CAVITY GROUT (FILL AND VENT) DUCTS SHALL BE CORRUGATED.

SEE GENERAL NOTES FOR ADDITIONAL FABRICATION, CONSTRUCTION AND SEQUENCE NOTES.

PROJECT NAME:	BRAINTREE	PLOT DATE:	14-JAN-2010
PROJECT NUMBER:	BRO 1444(36)	DRAWN BY:	K. PATTERSON
FILE NAME:	s95J292sub.dgn	CHECKED BY:	T. FILLBACH
PROJECT LEADER:	K. HIGGINS	SHEET	19 OF 26
DESIGNED BY:	T. FILLBACH		
ABUTMENTS			


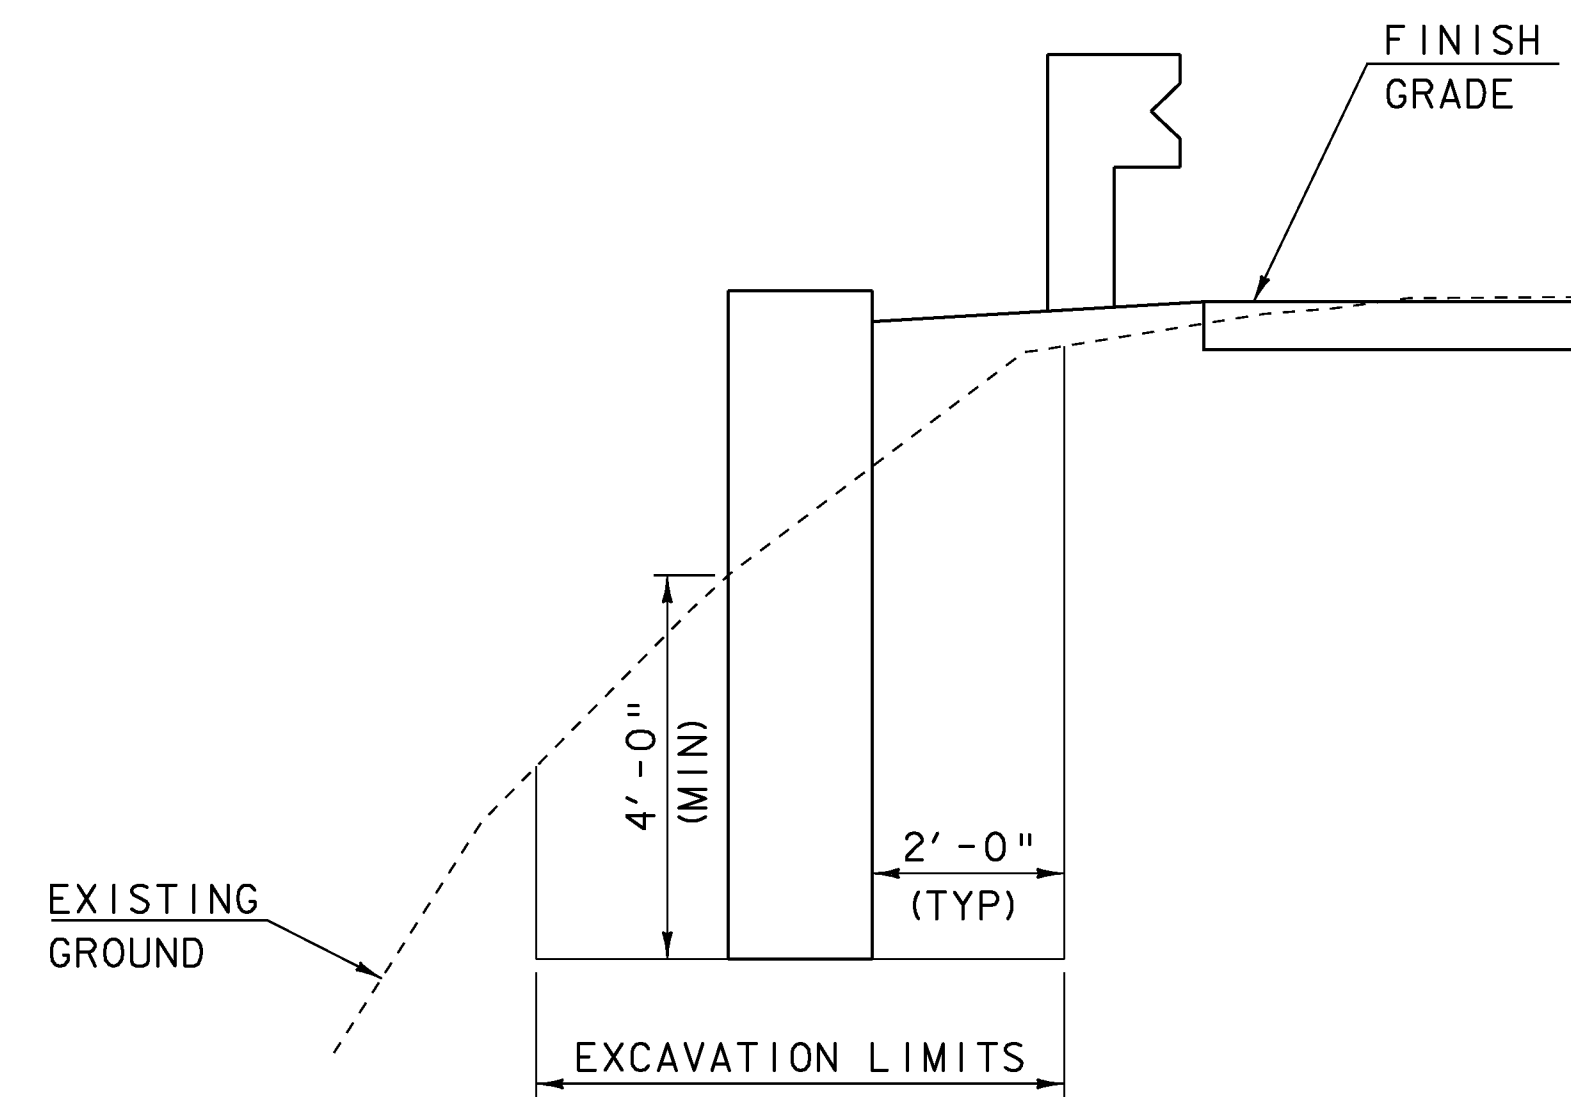


**TYPICAL RETAINING WALL EARTHWORKS DETAIL**

SCALE 1/2" = 1'-0"


**RETAINING WALL NOTES:**

1. THE DETAILS SHOWN ARE CONCEPTUAL IN NATURE AND ARE INTENDED TO PROVIDE OVERALL INFORMATION SUCH AS BEGINNING AND END OF WALL AND APPROXIMATE TOP AND BOTTOM PROFILE OF THE WALL.
2. THE WALL SHALL BE SELECTED FROM THE LIST OF WALLS IN THE APPROVED RETAINING WALL DOCUMENT AVAILABLE FROM VAOT MATERIALS & RESEARCH WEB SITE.
3. THE BOTTOM OF WALL SHALL BE A MINIMUM OF 4 FEET BELOW THE FINISH GRADE IN THE FRONT OF WALL.
4. THE WALL SHALL BE DESIGNED IN ACCORDANCE WITH THE 2009 AASHTO LRFD BRIDGE DESIGN SPECIFICATIONS AND ITS LATEST REVISIONS.
5. THE DESIGN SHALL CONSIDER THE EFFECTS OF ALL LOADS INCLUDING BUT NOT LIMITED TO LOADS FROM THE GUARDRAIL, EARTH SURCHARGE, LIVE LOAD SURCHARGE, AND HYDROSTATIC PRESSURE.
6. THE TYPE OF WALL SELECTED SHALL BE COMPATIBLE WITH THE GUARD RAIL SYSTEM SHOWN ON THE PLANS AND SHALL CONSIDER THE EFFECT OF 8 FOOT GUARD RAIL POSTS ON ANY REINFORCING OR ANCHORING SYSTEM.
7. THE FOLLOWING SOIL PROPERTIES SHALL BE USED IN THE DESIGN:
  - a. SELECT BACKFILL (GRANULAR BACKFILL FOR STRUCTURES)
    - i. UNIT WEIGHT: 140 PCF
    - ii. FRICTION ANGLE: 34 DEGREES
    - iii. COHESION, c: 0
  - b. RETAINED SOIL
    - i. UNIT WEIGHT: 130 PCF
    - ii. FRICTION ANGLE: 32 DEGREES
    - iii. COHESION, c: 0
  - c. FOUNDATION SOIL
    - i. UNIT WEIGHT: 115 PCF
    - ii. FRICTION ANGLE: 30 DEGREES
    - iii. COHESION, c: 0
    - iv. NOMINAL BEARING RESISTANCE: 9 KSF
8. THE INTERFACE BETWEEN THE RETAINING WALL AND THE ABUTMENT STEM SHALL BE DESIGNED AND SUBMITTED TO THE PROJECT MANAGER FOR REVIEW AND APPROVAL.
9. THE WALL, INCLUDING ALL COMPONENTS, EXCAVATION AND BACKFILL, NECESSARY TO CONSTRUCT THE WALL, SHALL BE INCLUDED IN THE UNIT PRICE BID FOR ITEM 900.670 "SPECIAL PROVISION (RETAINING WALL)".

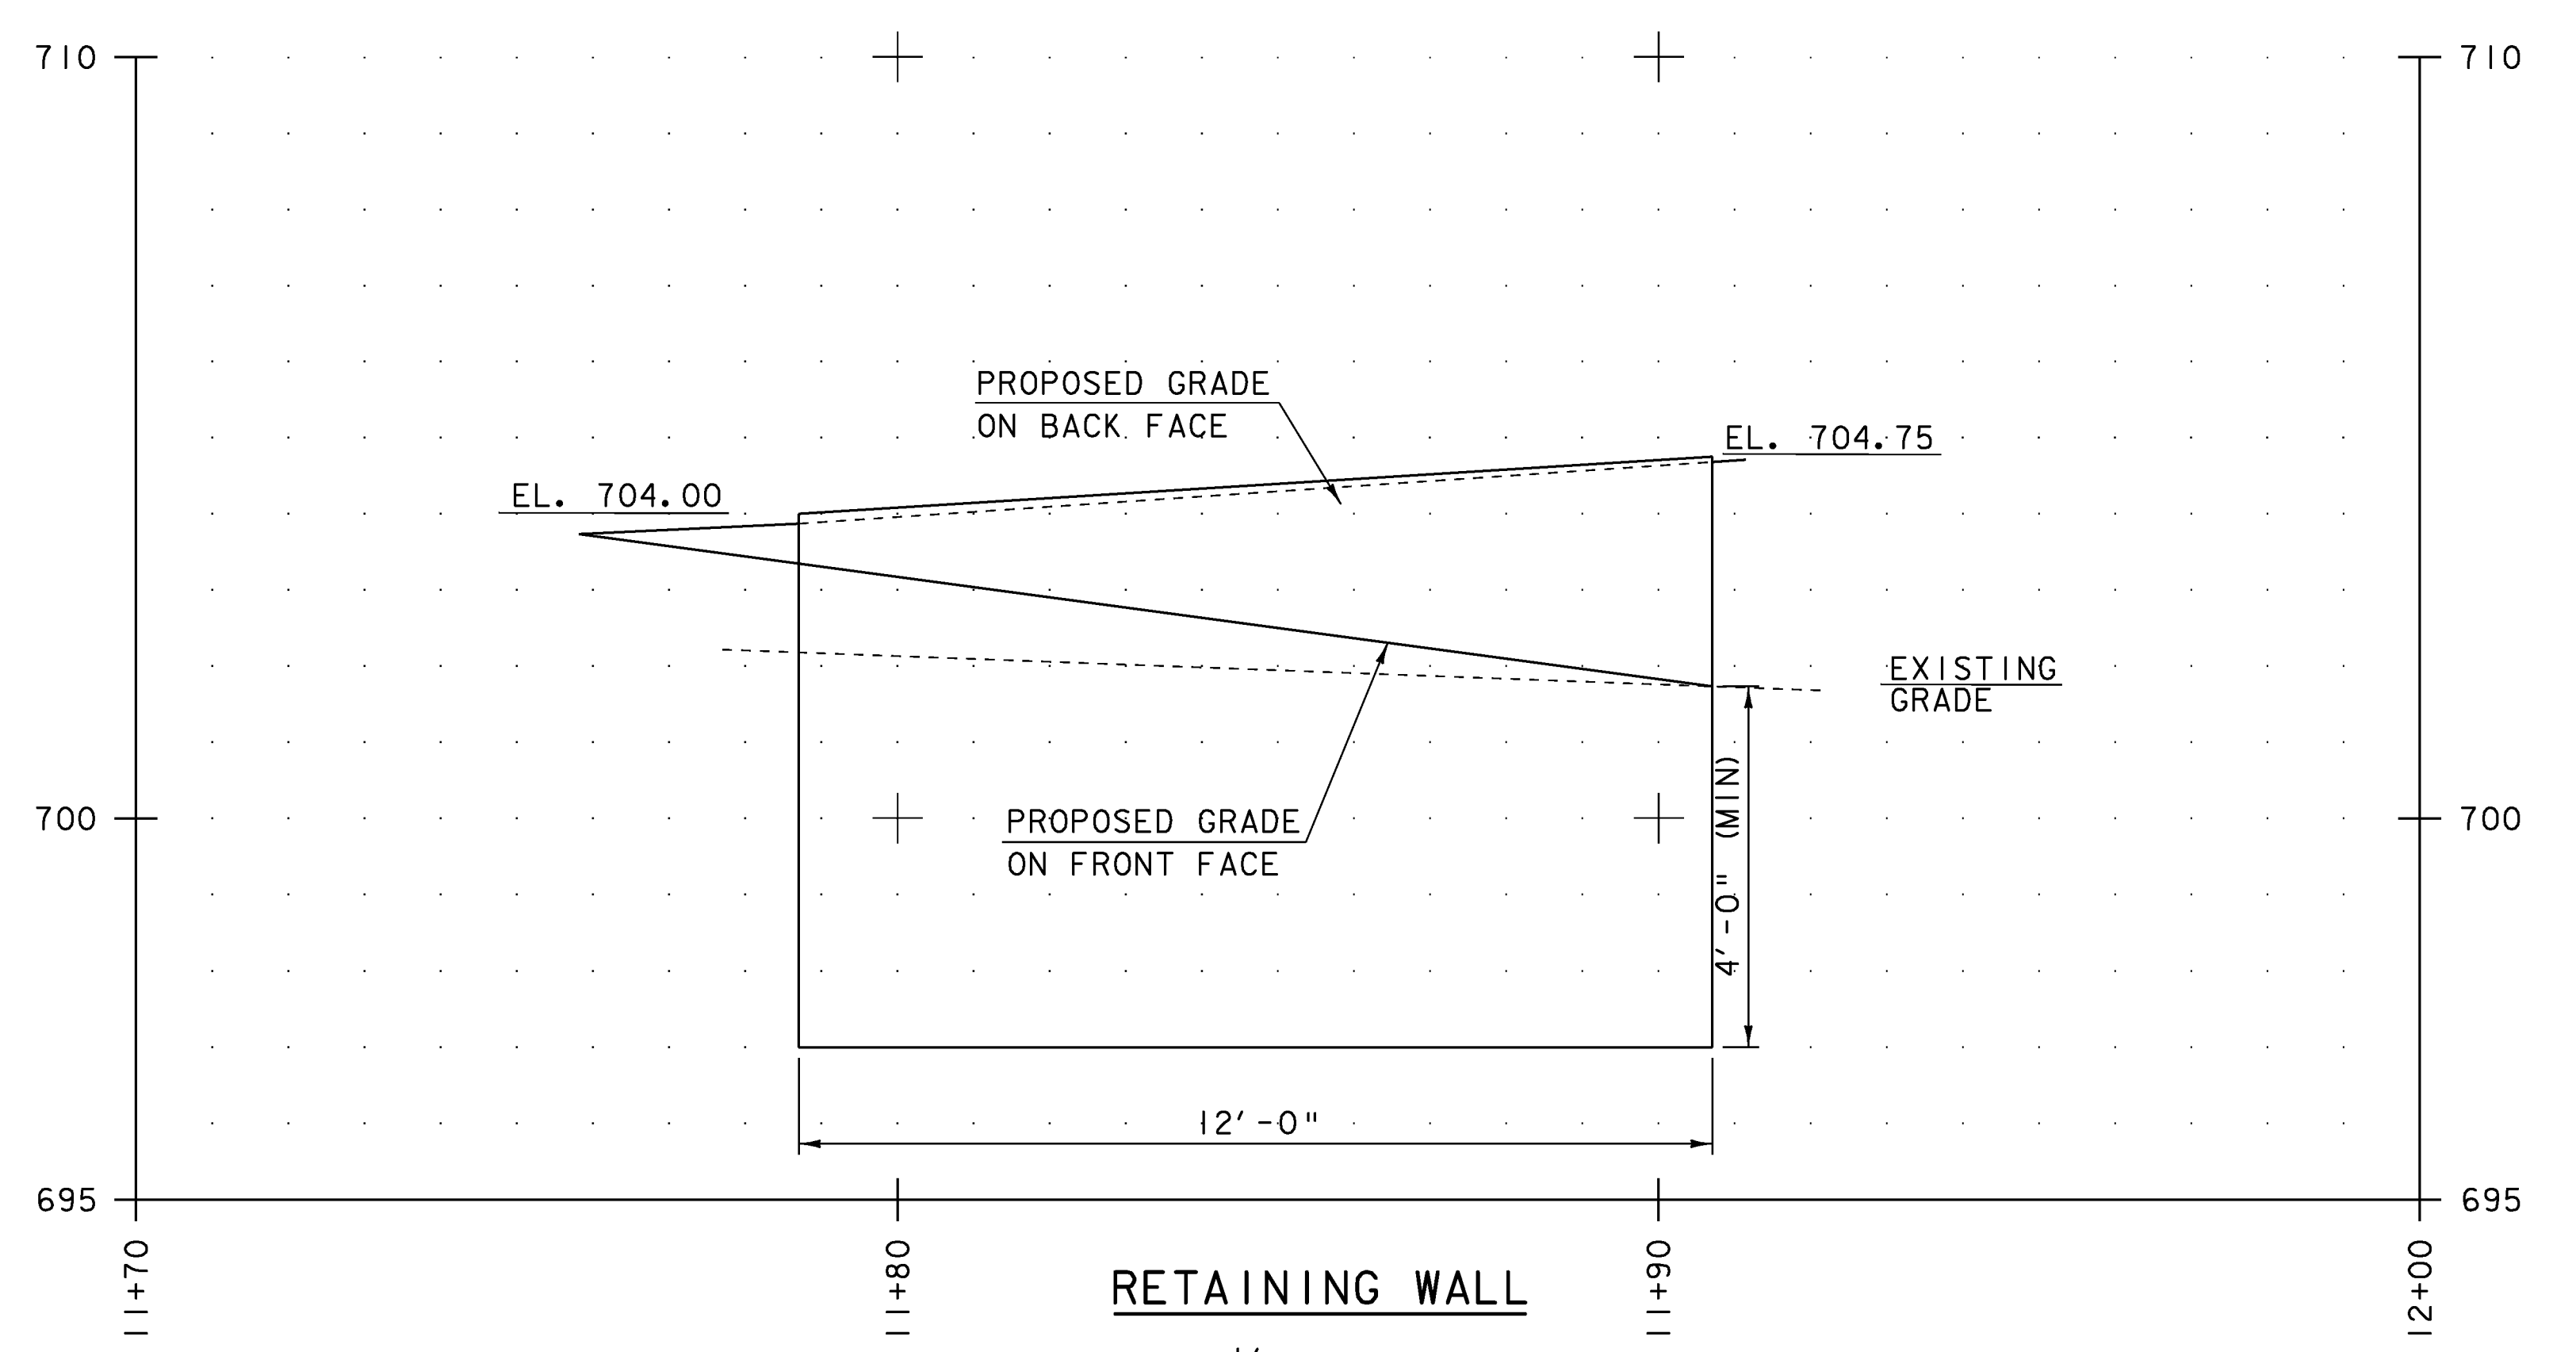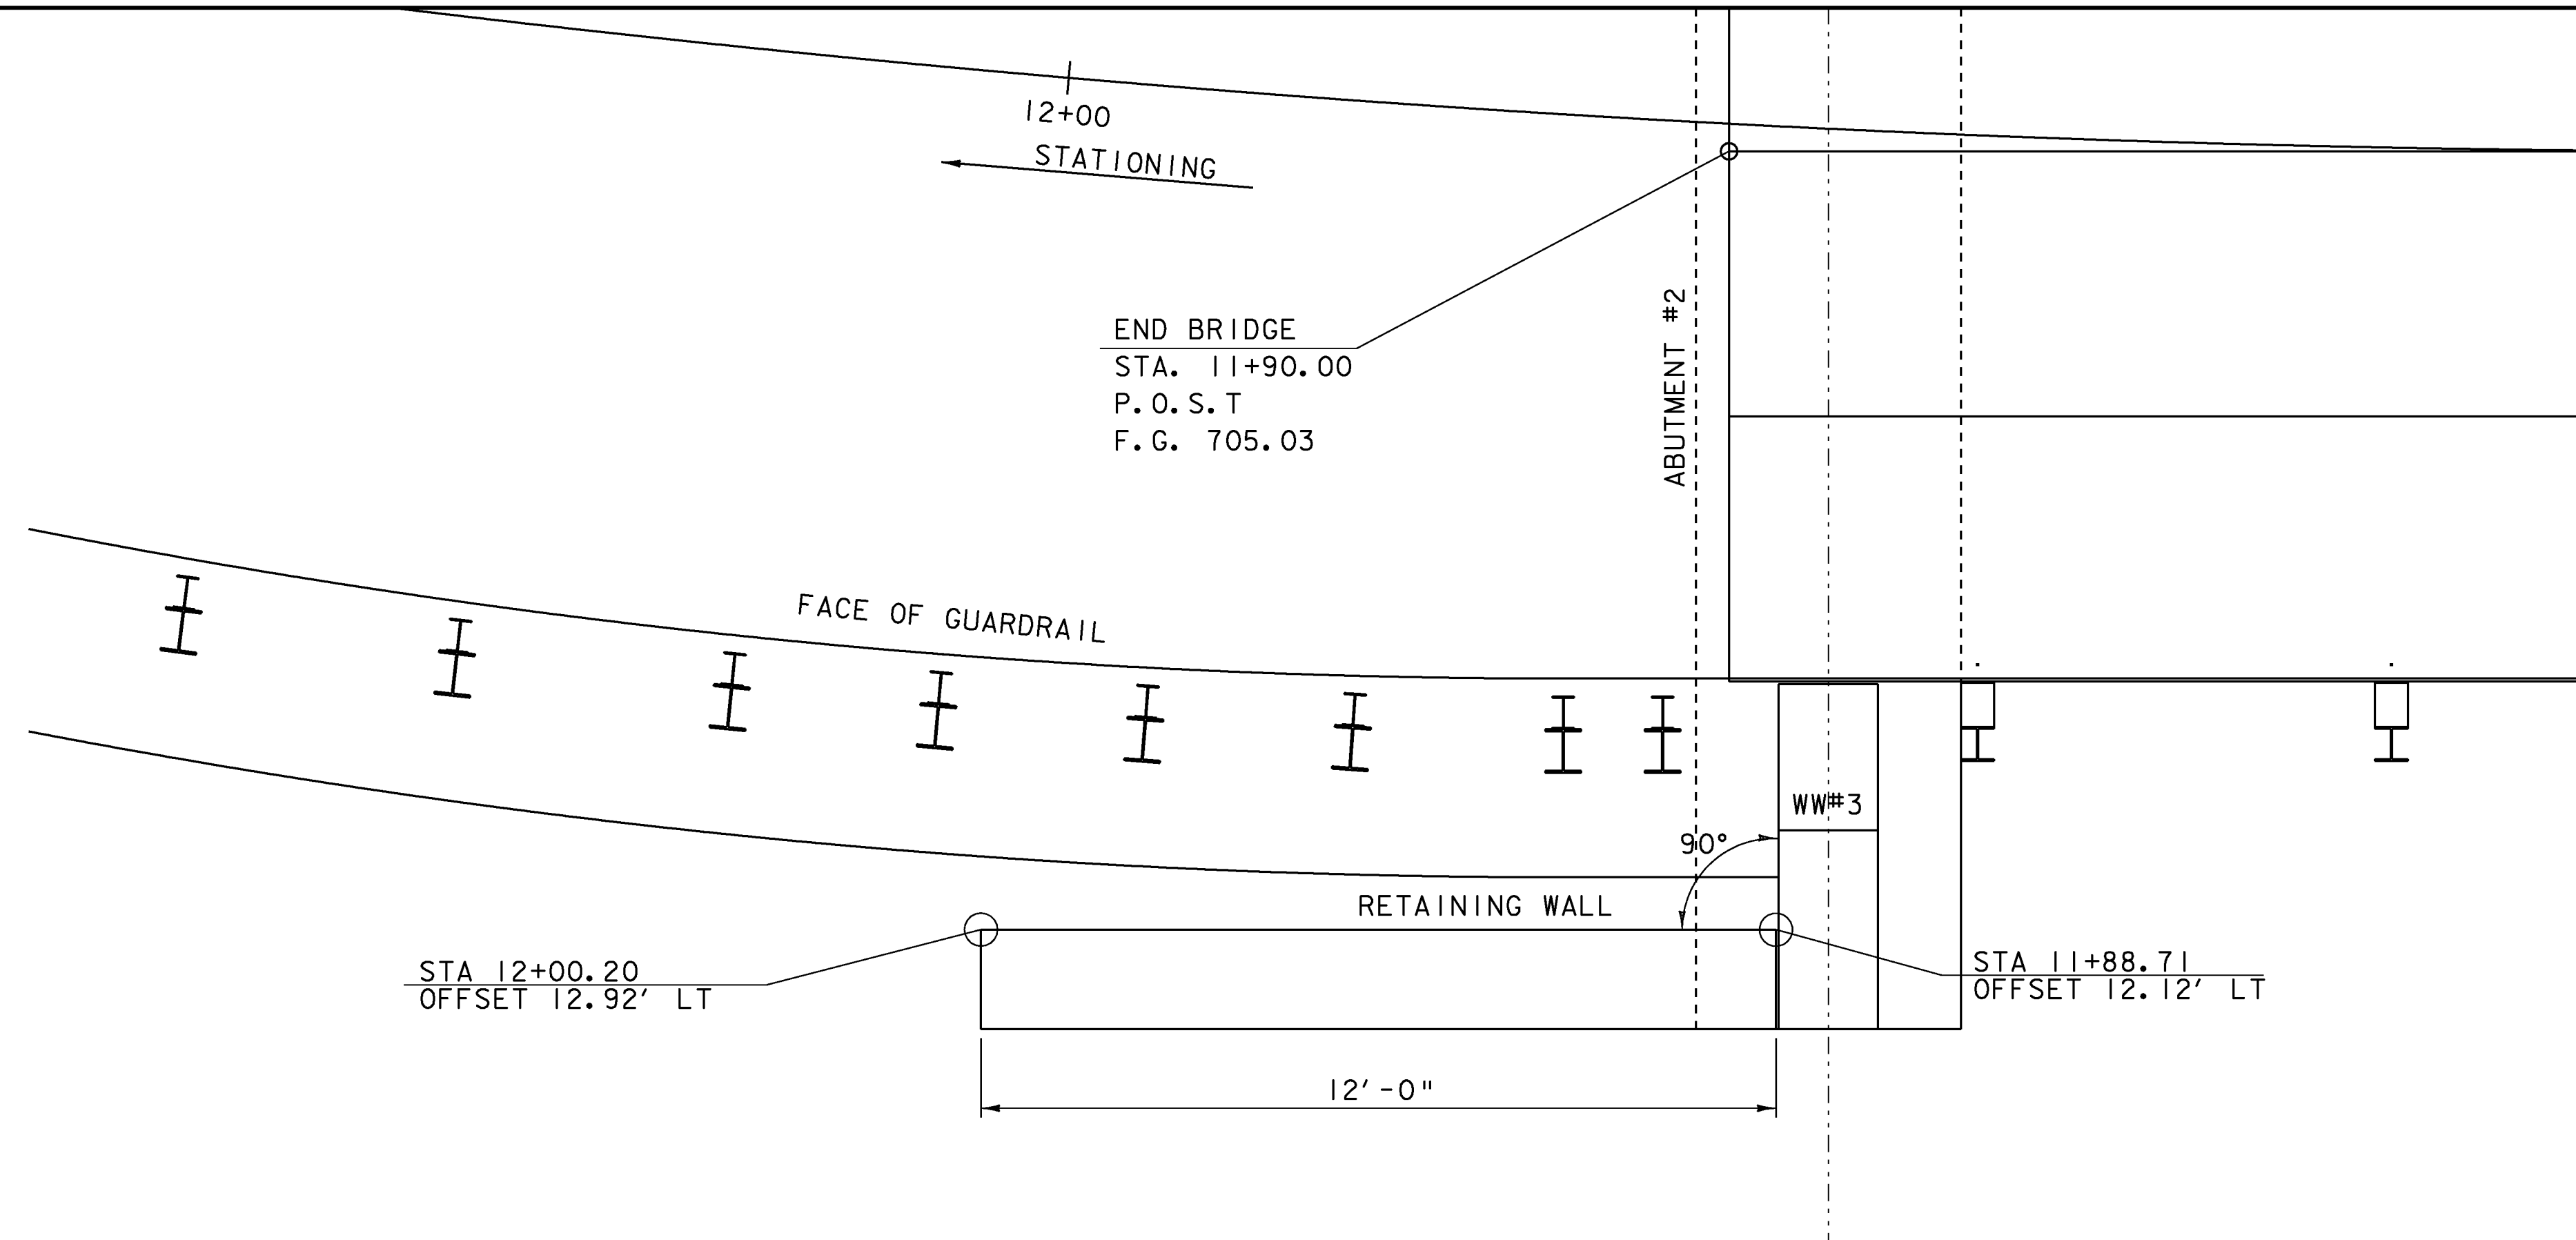


**RETAINING WALL**

SCALE 1/2" = 1'-0"

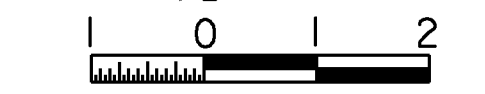

PROJECT NAME: BRAINTREE	PLOT DATE: 31-DEC-2009
PROJECT NUMBER: BRO 1444(36)	DRAWN BY: K. PATTERSON
FILE NAME: s95j292sub.dgn	DESIGNED BY: T. FILLBACH
PROJECT LEADER: K. HIGGINS	CHECKED BY: T. FILLBACH
RETAINING WALL	SHEET 20 OF 26

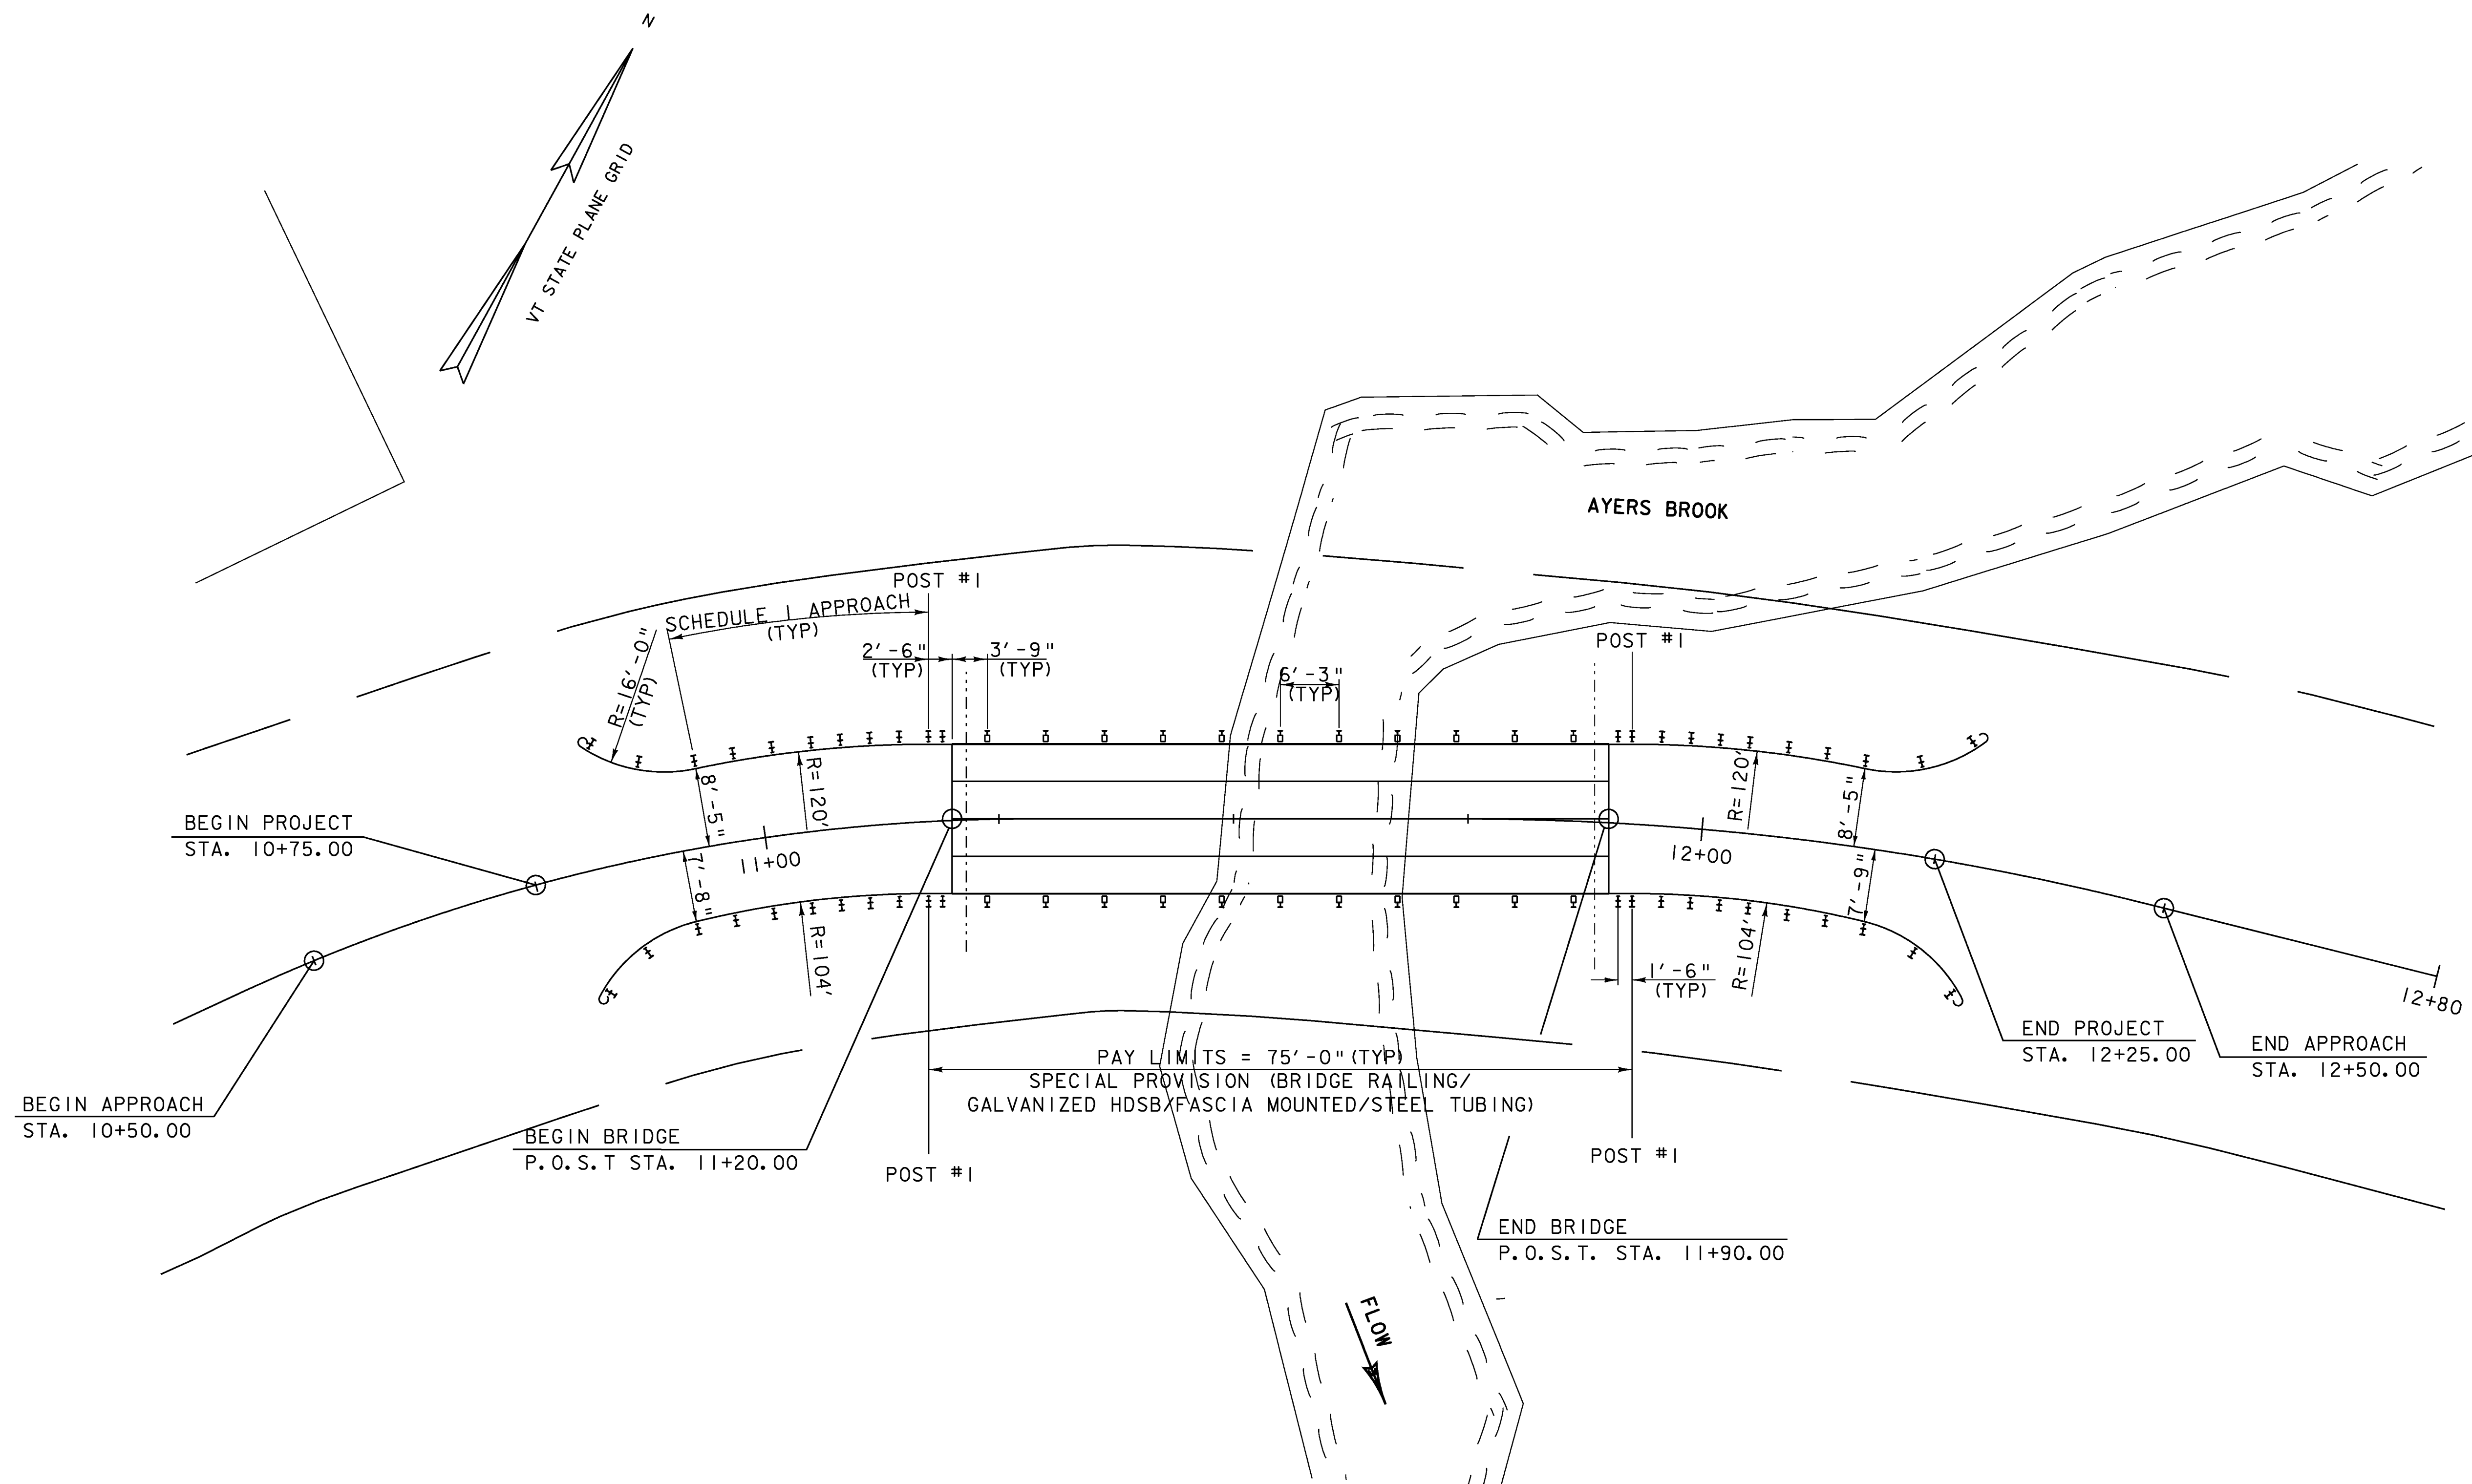


**RAIL LAYOUT**  
 SCALE 1" = 10'-0"  
 10 0 10


PROJECT NAME: BRAINTREE	PLOT DATE: 14-JAN-2010
PROJECT NUMBER: BRO 1444(36)	DRAWN BY: K. PATTERSON
FILE NAME: s95j292rail.dgn	CHECKED BY: T. FILLBACH
PROJECT LEADER: K. HIGGINS	SHEET 21 OF 26
DESIGNED BY: T. FILLBACH	
RAIL LAYOUT SHEET	

**FASCIA MOUNTED WITHOUT CURB NOTES**


BOLTS IN SLOTTED HOLES SHALL NOT BE DRAWN UP SO TIGHT AS TO PREVENT SLIDING BETWEEN THE TUBE AND CHANNEL.

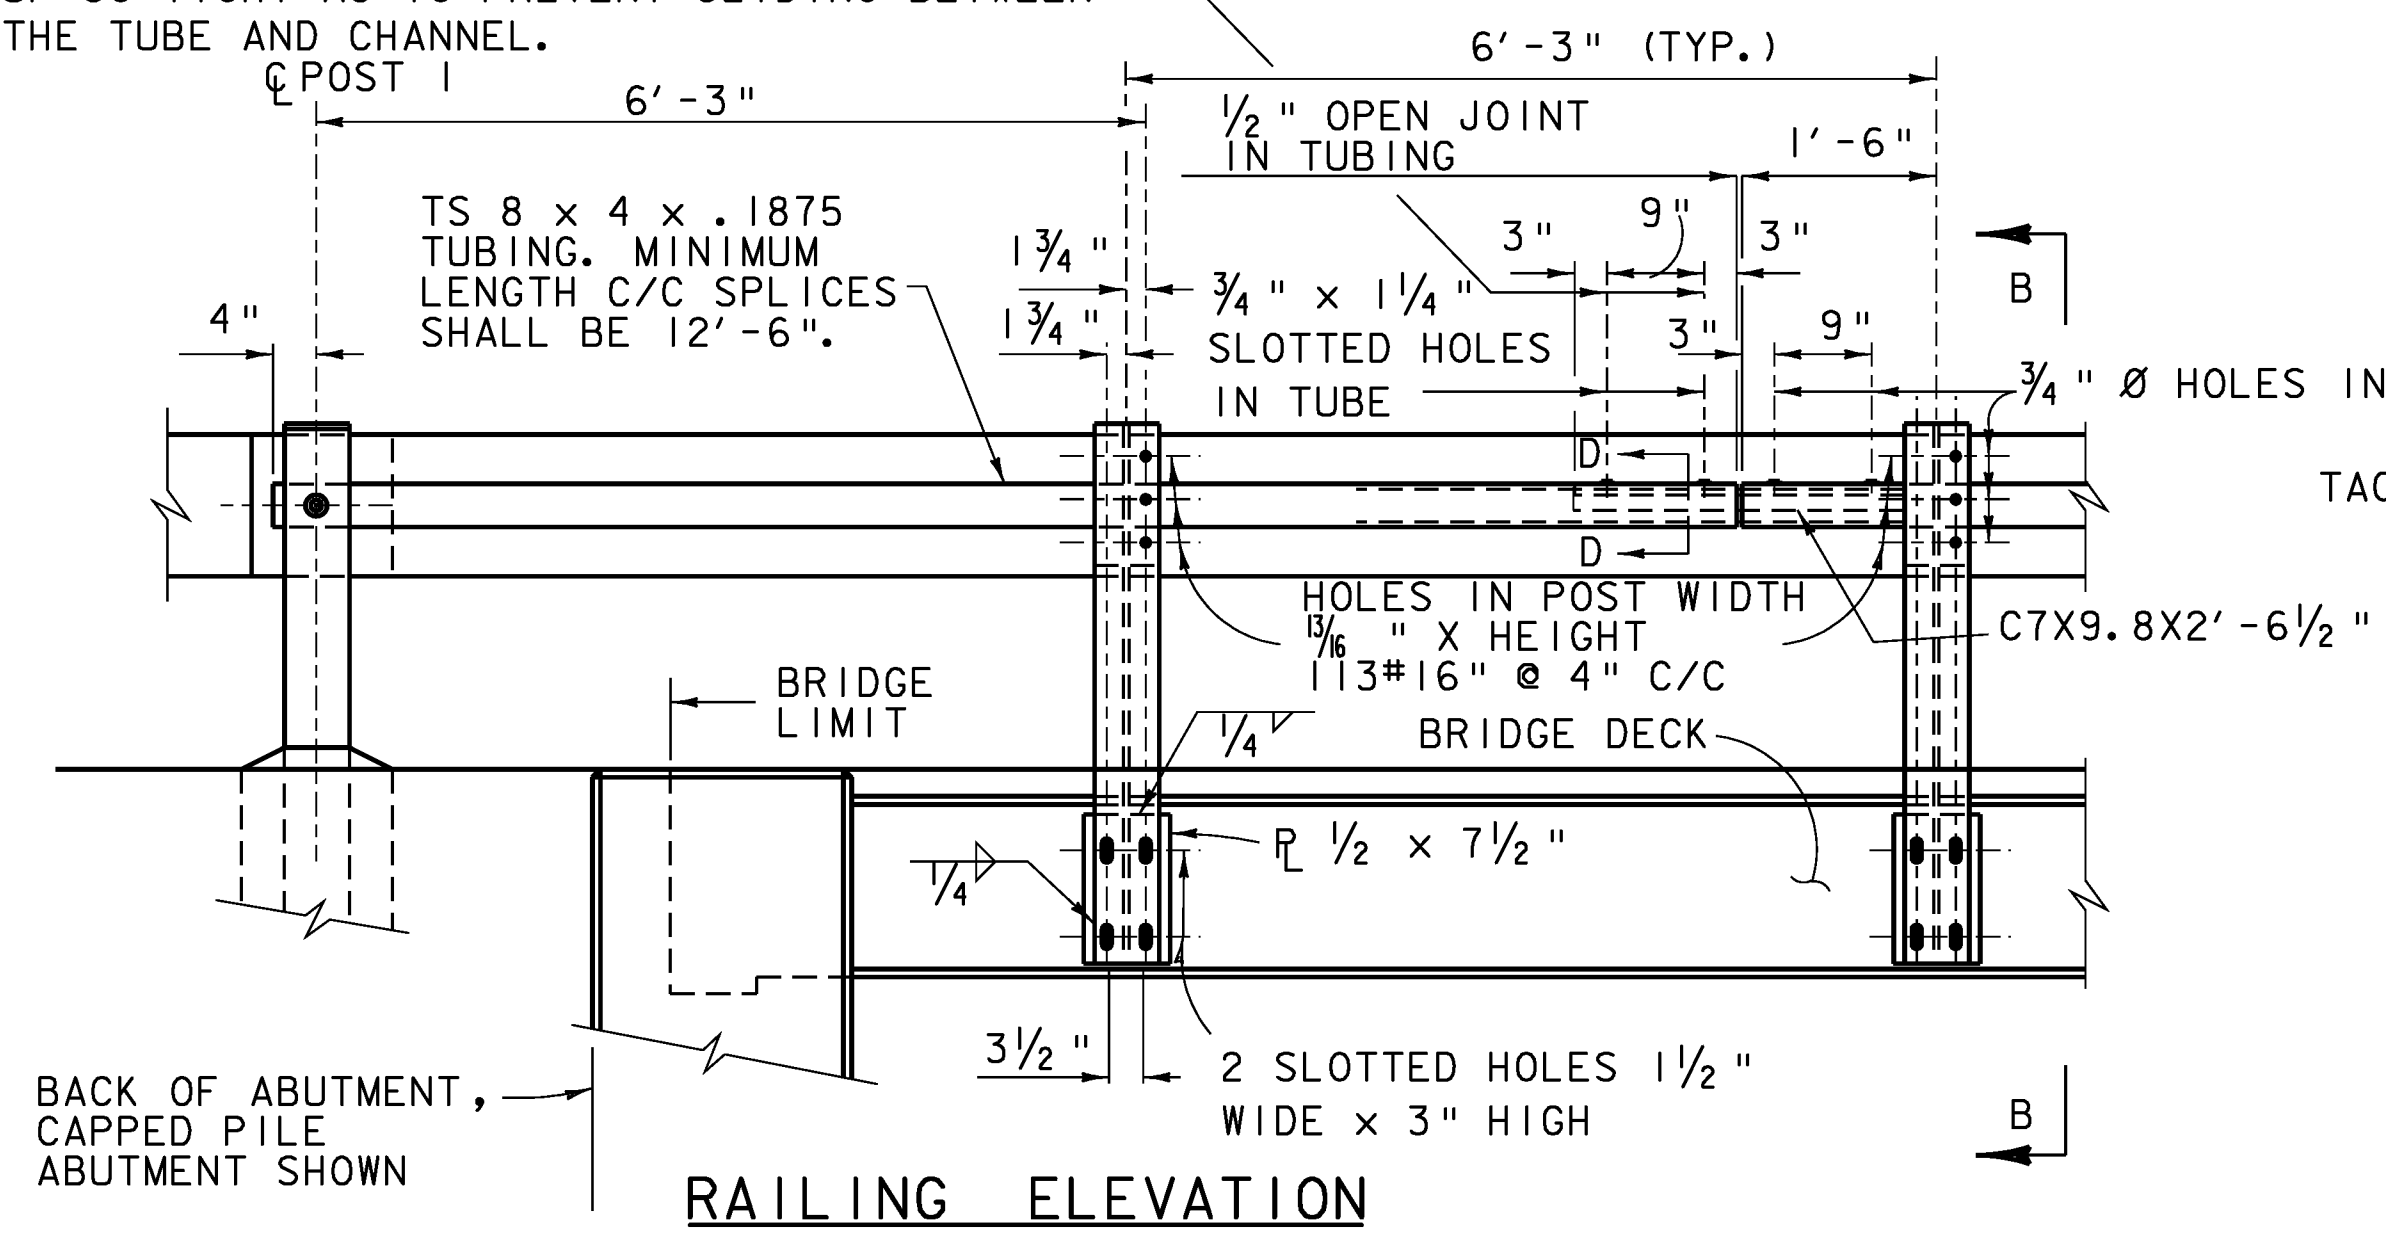

**RAILING ELEVATION**

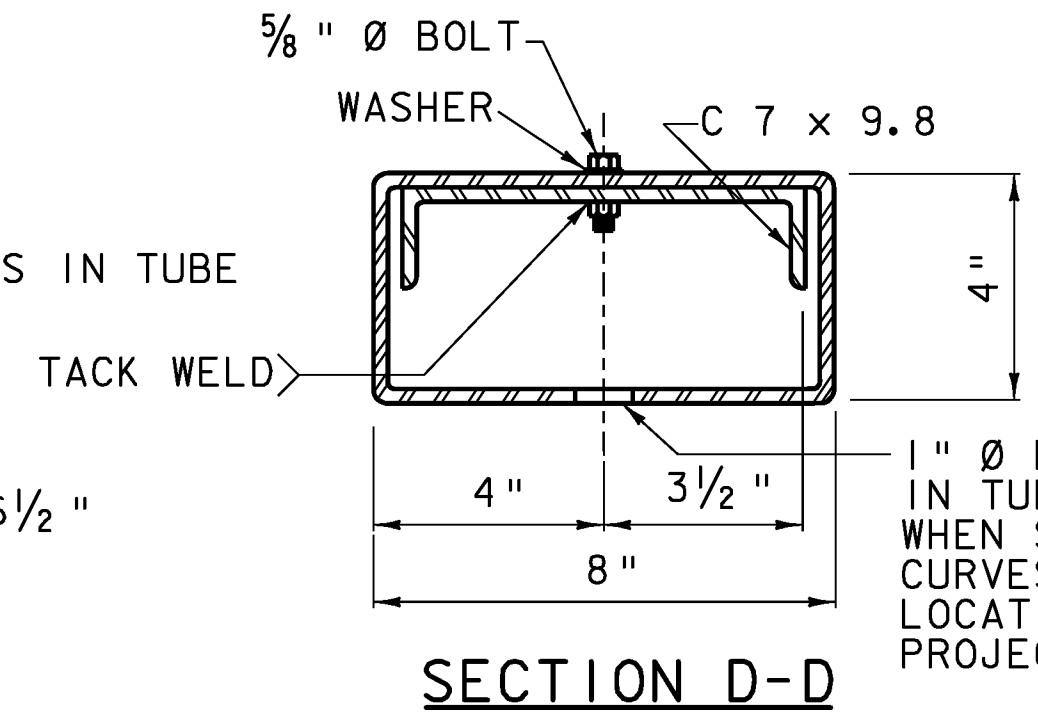


**SECTION D-D**

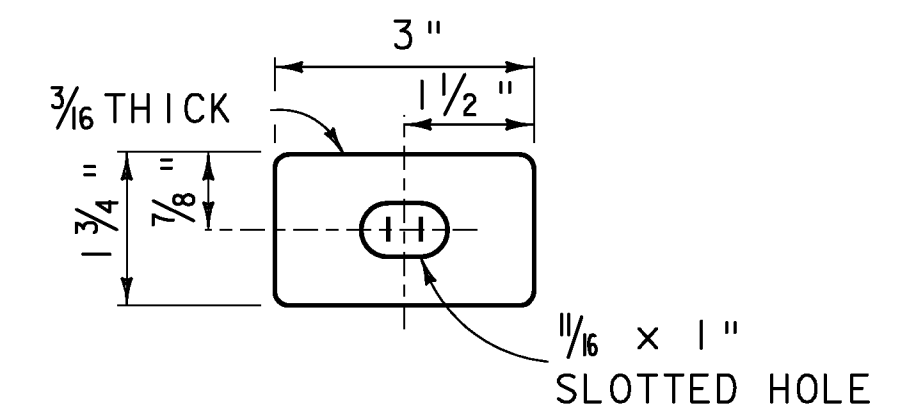

**SPECIAL WASHER**


PLACE WASHER BETWEEN BOLT HEAD AND FACE OF RAIL.

1. HEAVY DUTY STEEL BEAM GUARD RAIL SHALL CONFORM TO VT. SPECIFICATION SECTION 732.
2. STRUCTURAL STEEL TUBING SHALL CONFORM TO VT. SPECIFICATION SECTION 732 GALVANIZED AFTER FABRICATION IN ACCORDANCE WITH AASHTO M111M/M111.
3. ANCHOR BOLTS, NUTS AND WASHERS SHALL BE GALVANIZED IN ACCORDANCE WITH AASHTO M232M/M232 GALVANIZED AFTER FABRICATION IN ACCORDANCE WITH AASHTO M111M/M111.
4. BRIDGE RAIL POSTS, SPECIAL WASHERS, PLATE WASHERS AND SPLICE BARS SHALL CONFORM TO AASHTO M223M/M223 GALVANIZED AFTER FABRICATION IN ACCORDANCE WITH AASHTO M111M/M111.
5. ALL BOLTS AND RELATED HARDWARE SHALL CONFORM TO AASHTO M164 TYPE 1 BOLTS, HOT DIPPED OR MECHANICALLY GALVANIZED PER SPECIFICATION.
6. SEE STANDARD DRAWING G-1 AND G-1d FOR ADDITIONAL DETAILS CONCERNING GUARD RAIL.
7. SEE STANDARD DRAWING SB-R6-82 FOR APPROACH RAIL DETAILS AND FOR INFORMATION RELATIVE TO SCHEDULE I AND SCHEDULE II. ALL APPROACH RAIL SHALL BE HEAVY DUTY STEEL BEAM GUARD RAIL. ALSO SEE STD. DRWG. SB-R6-82 FOR HANDRAIL DETAILS (EXCEPT END DETAILS) IF HAND RAIL IS REQUIRED.
8. ALL POSTS SHALL BE SET NORMAL TO GRADE.
9. SPLICES FOR THE STEEL BEAM GUARD RAIL SHALL LAP IN THE DIRECTION OF TRAFFIC.
10. SEE STANDARD DRAWING G-1 FOR DETAILS OF DELINEATORS. A DELINEATOR SHALL BE LOCATED AT EVERY FIFTH POST. PAYMENT SHALL BE INCIDENTAL TO OTHER ITEMS.
11. A RAILING JOINT SPLICE SHALL BE PROVIDED AT EACH SUPERSTRUCTURE EXPANSION JOINT.
12. ALL FIELD CUT OR DRILLED AREAS SHALL BE REPAIRED PER SECTION 513.
13. FOR RADIUS LESS THAN 950 FEET, THE STEEL TUBING SHALL BE SHOP BENT TO FIT THE APPLICABLE CURVE.
14. THE DROP-WEIGHT TEAR TEST IN SECTION 732 SHALL NOT APPLY TO THE STRUCTURAL TUBING.

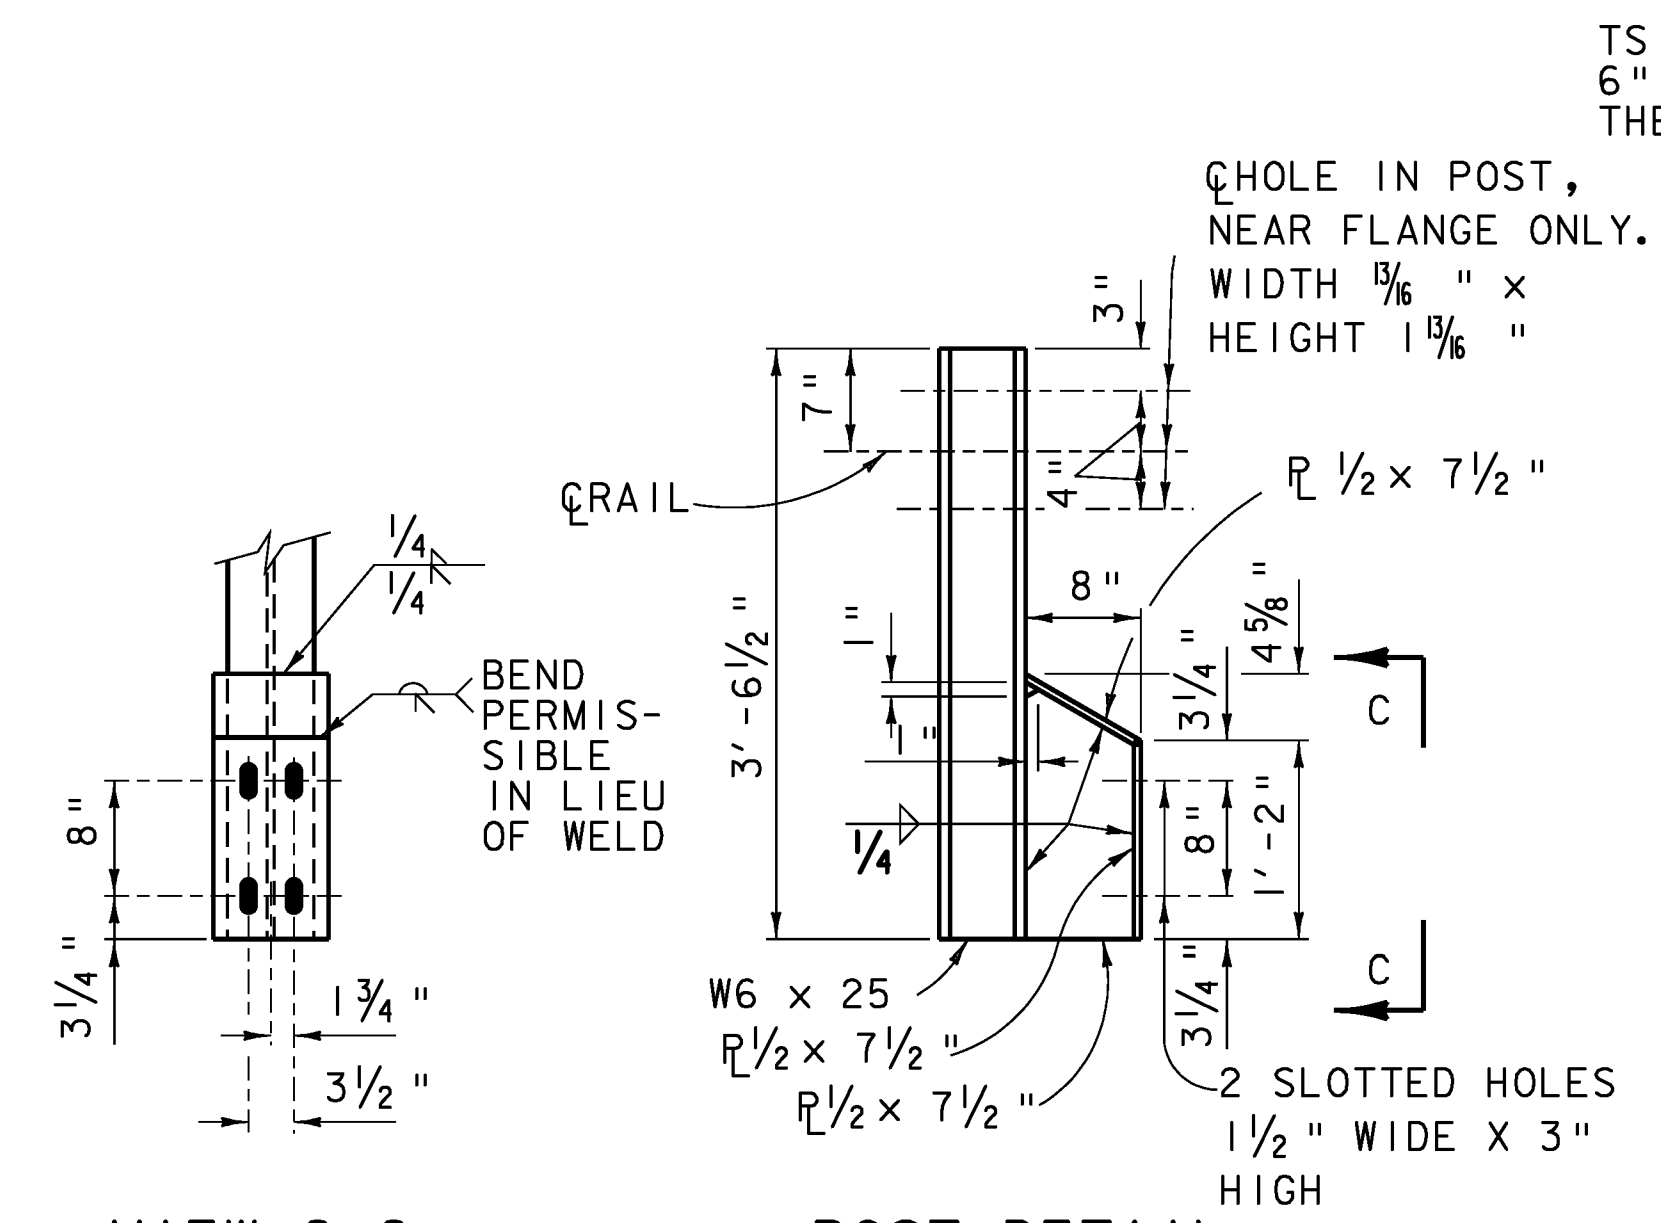


**VIEW C-C**

**POST DETAIL**

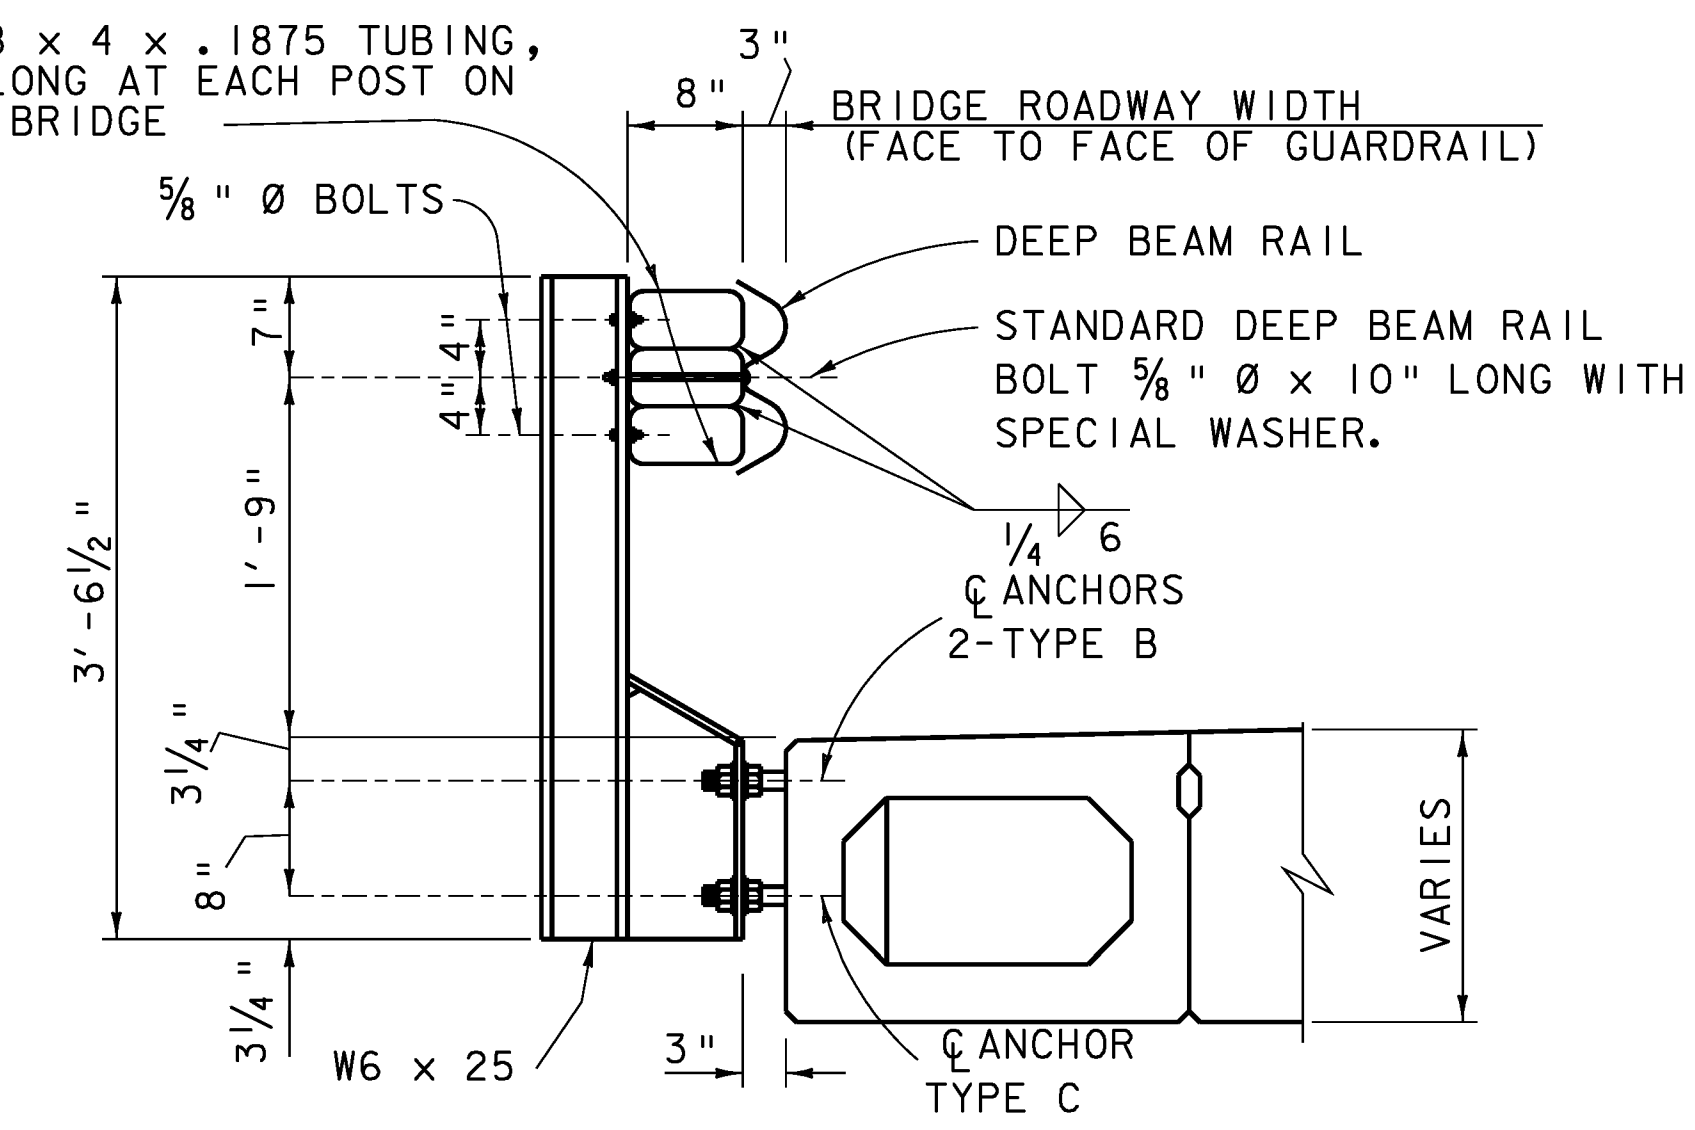


**SECTION B-B**

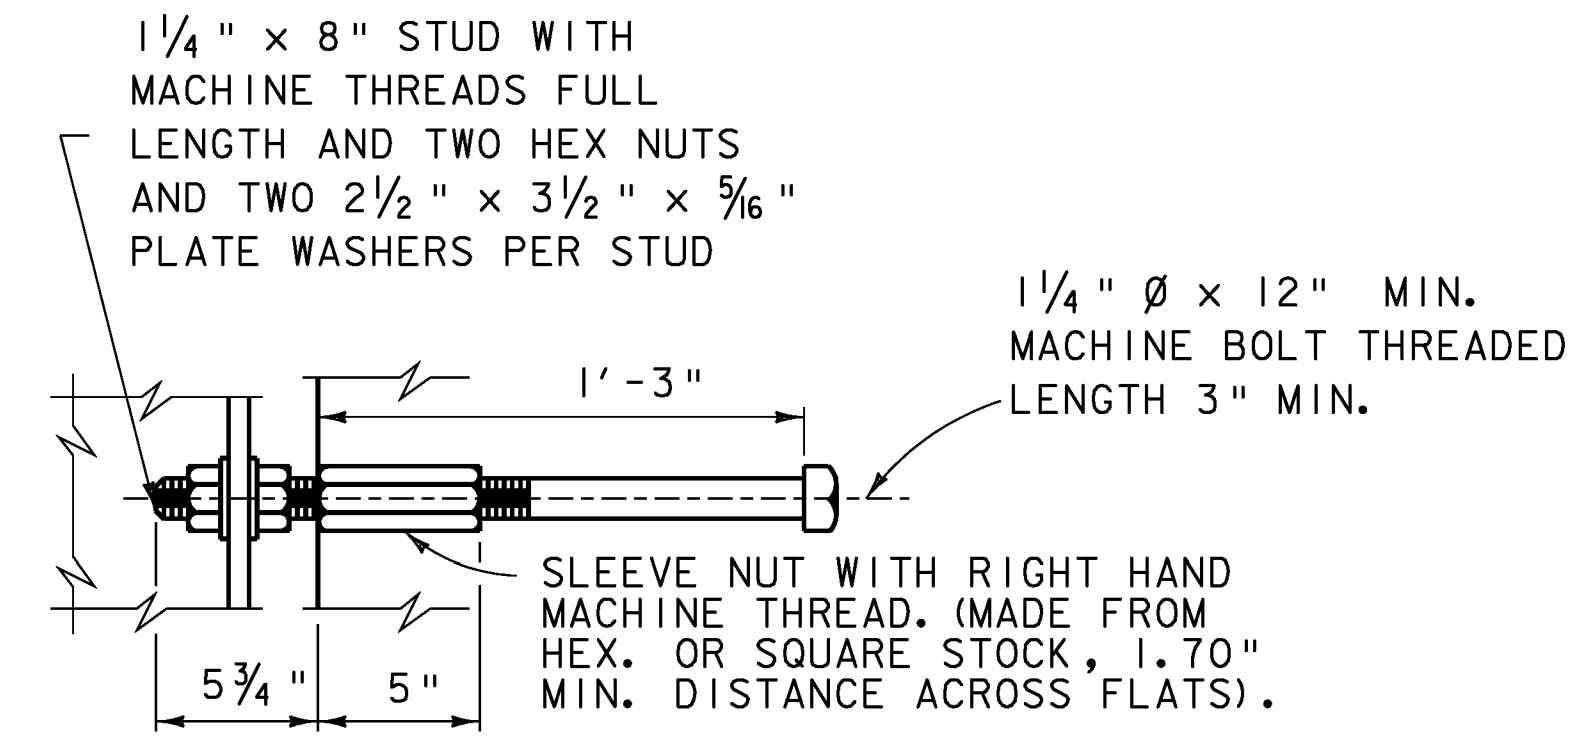

**TYPE B ANCHOR DETAIL**

TWO 1 1/4" x 8" STUDS WITH MACHINE THREADS FULL LENGTH AND TWO HEX NUTS AND TWO 2 1/2" x 3 1/2" x 5/16" PLATE WASHERS PER STUD.

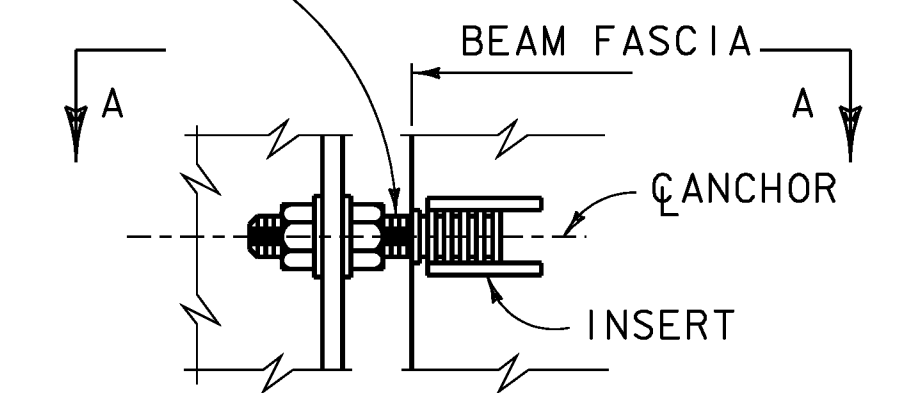


**SECTION A-A  
TYPE C ANCHOR DETAIL**


NOTE:  
ALTERNATE TYPE C ANCHOR MAY BE SUBMITTED FOR ACCEPTANCE. FERRULE SHALL BE DAYTON SUPERIOR F-43 PLAIN OR EQUIVALENT.

PROJECT NAME: BRAINTREE	PLOT DATE: 31-DEC-2009
PROJECT NUMBER: BRO 1444(36)	DRAWN BY: G. LAROCHE
FILE NAME: s95J292Raildet.dgn	DESIGNED BY: T. FILLBACH
PROJECT LEADER: K. HIGGINS	CHECKED BY: T. FILLBACH
RAIL DETAIL	SHEET 22 OF 26


N. T. S.

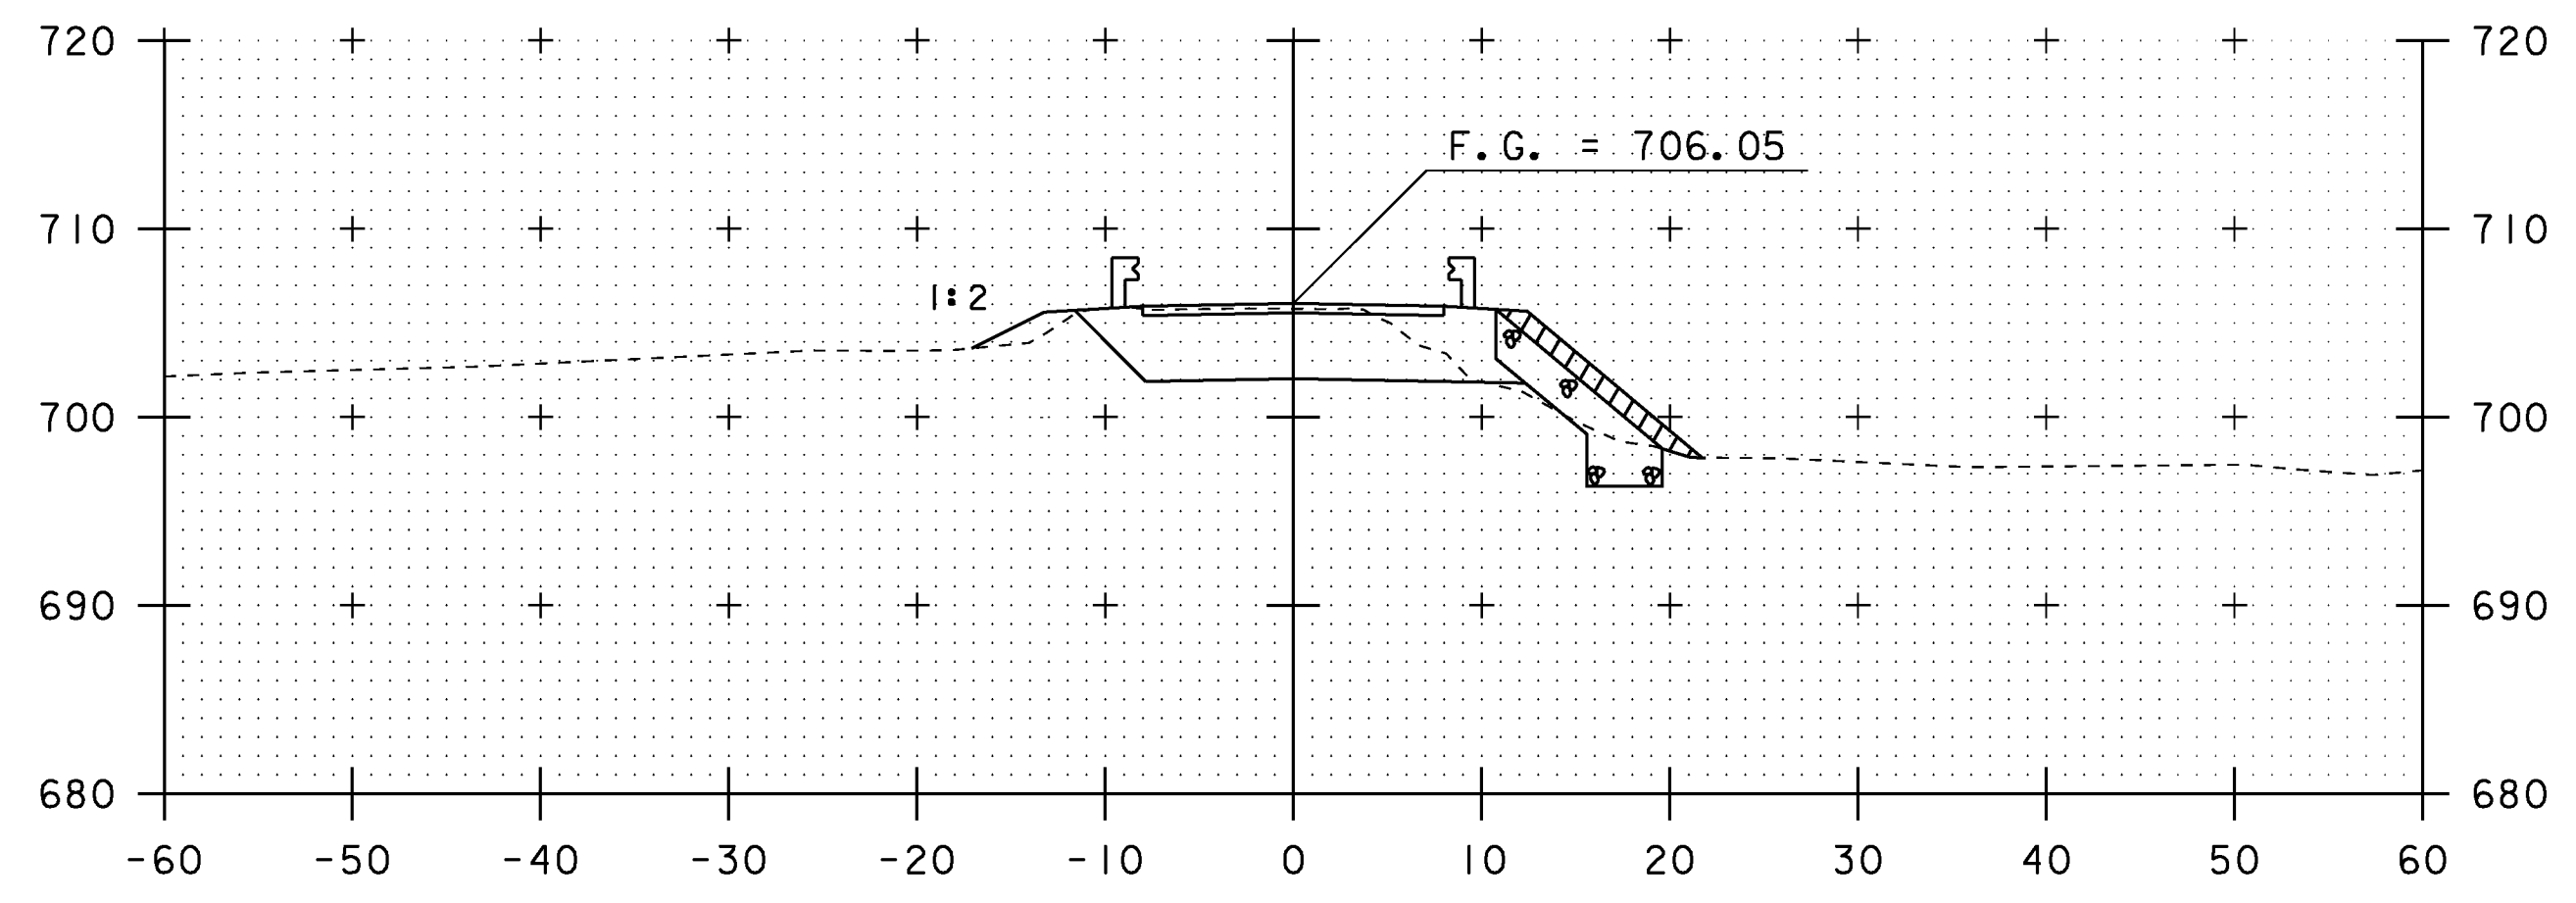


BEGIN BRIDGE  
11+20

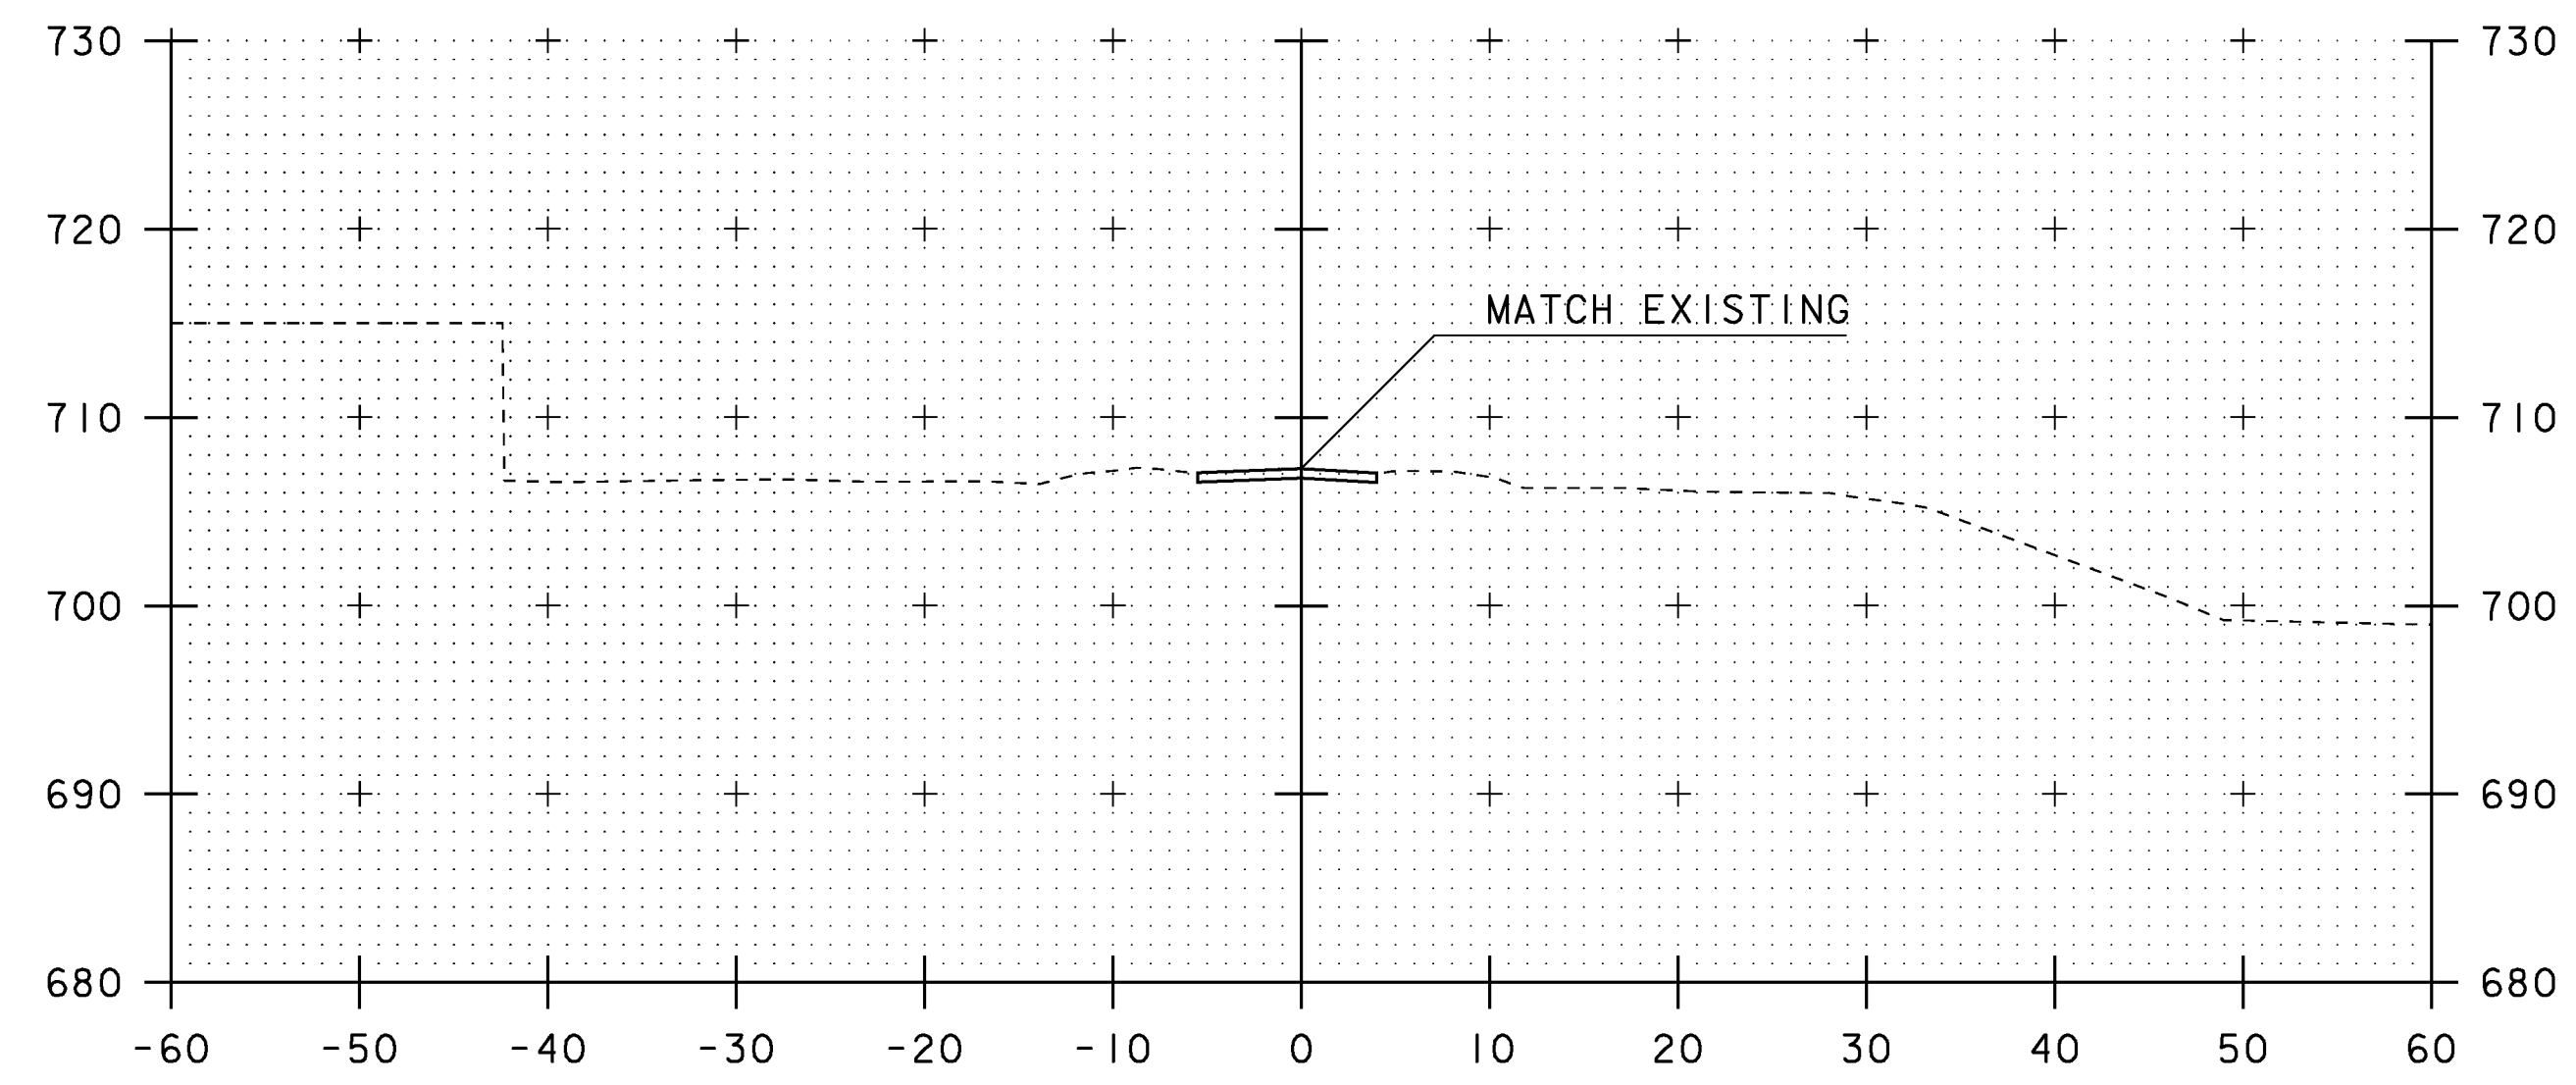


BEGIN APPROACH  
10+50

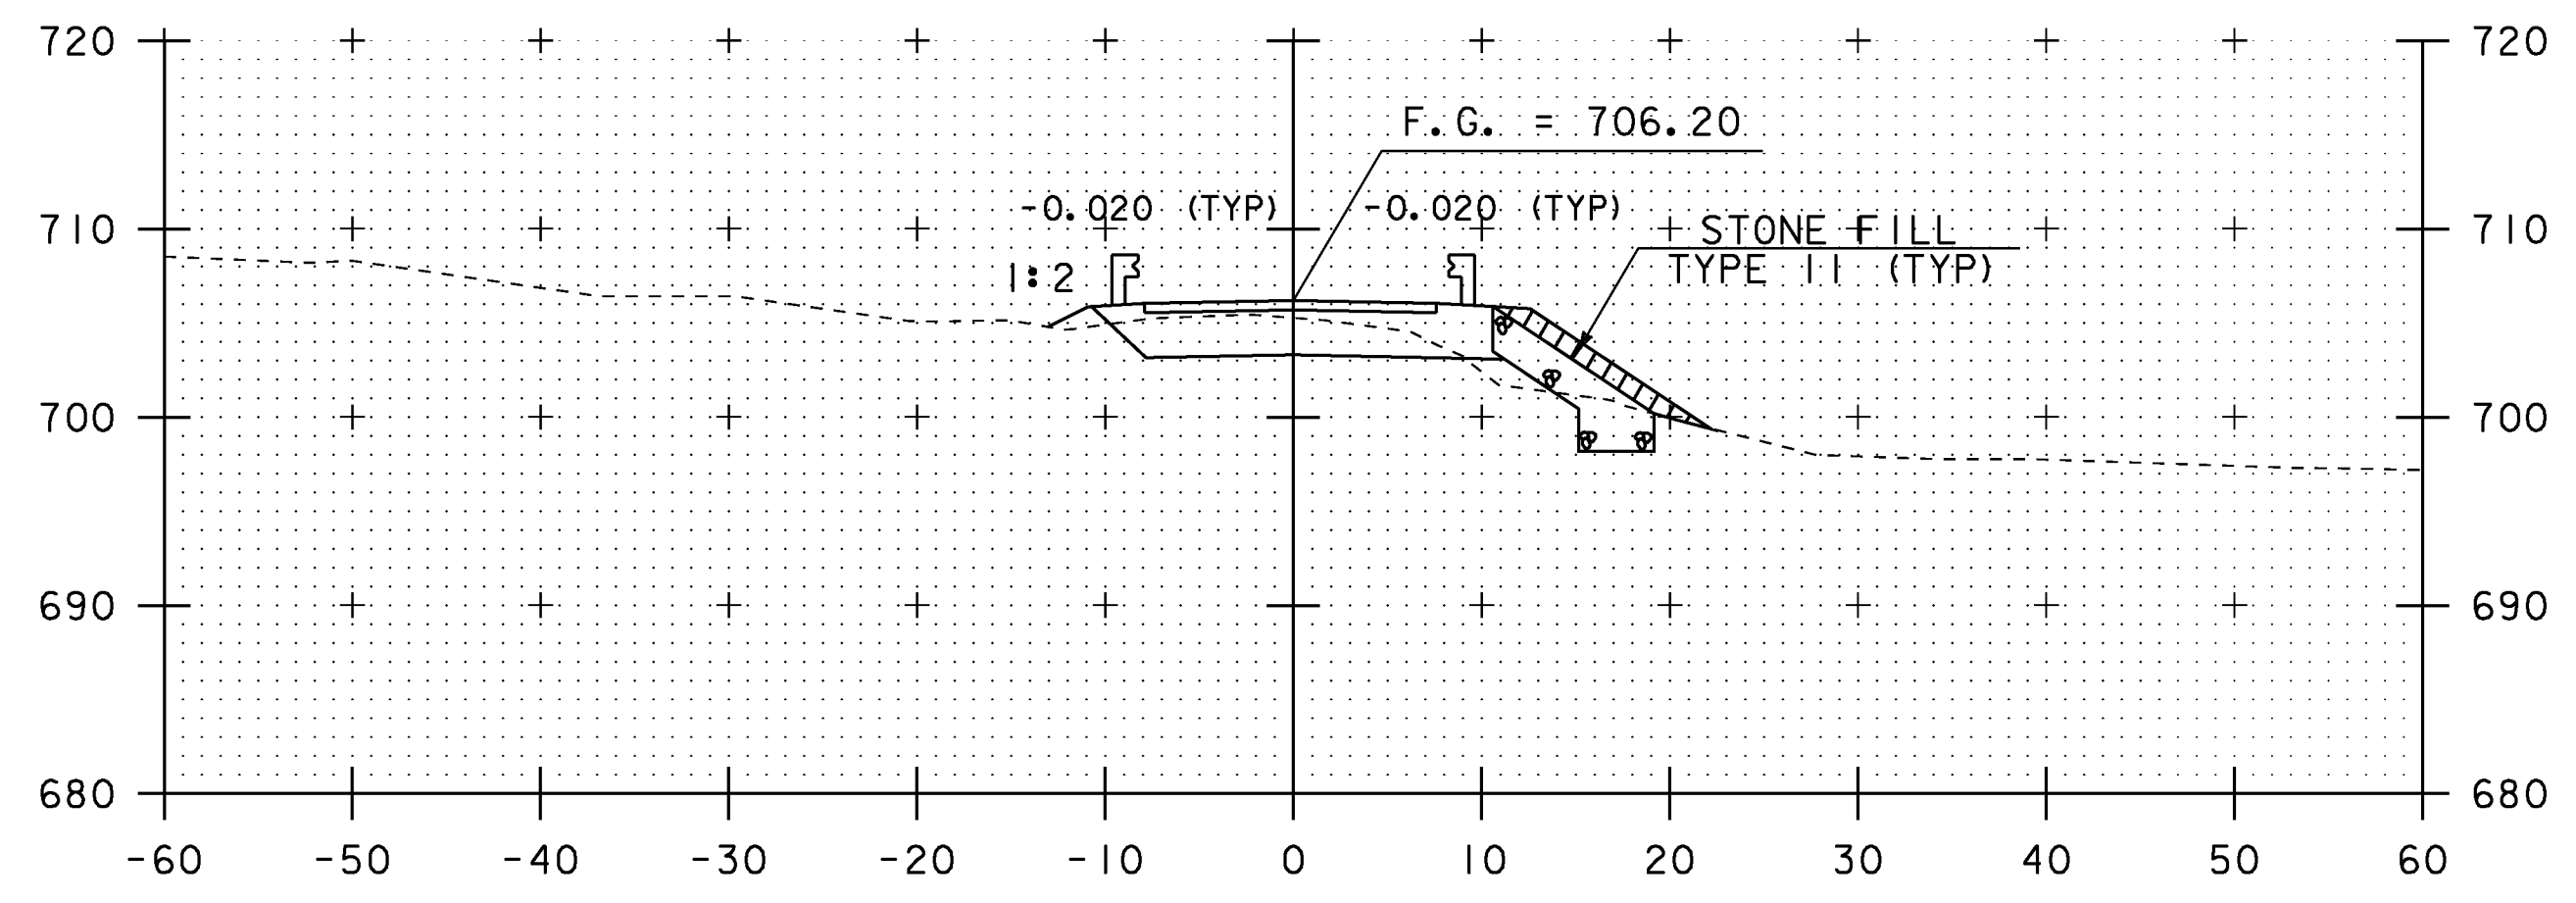

11+00

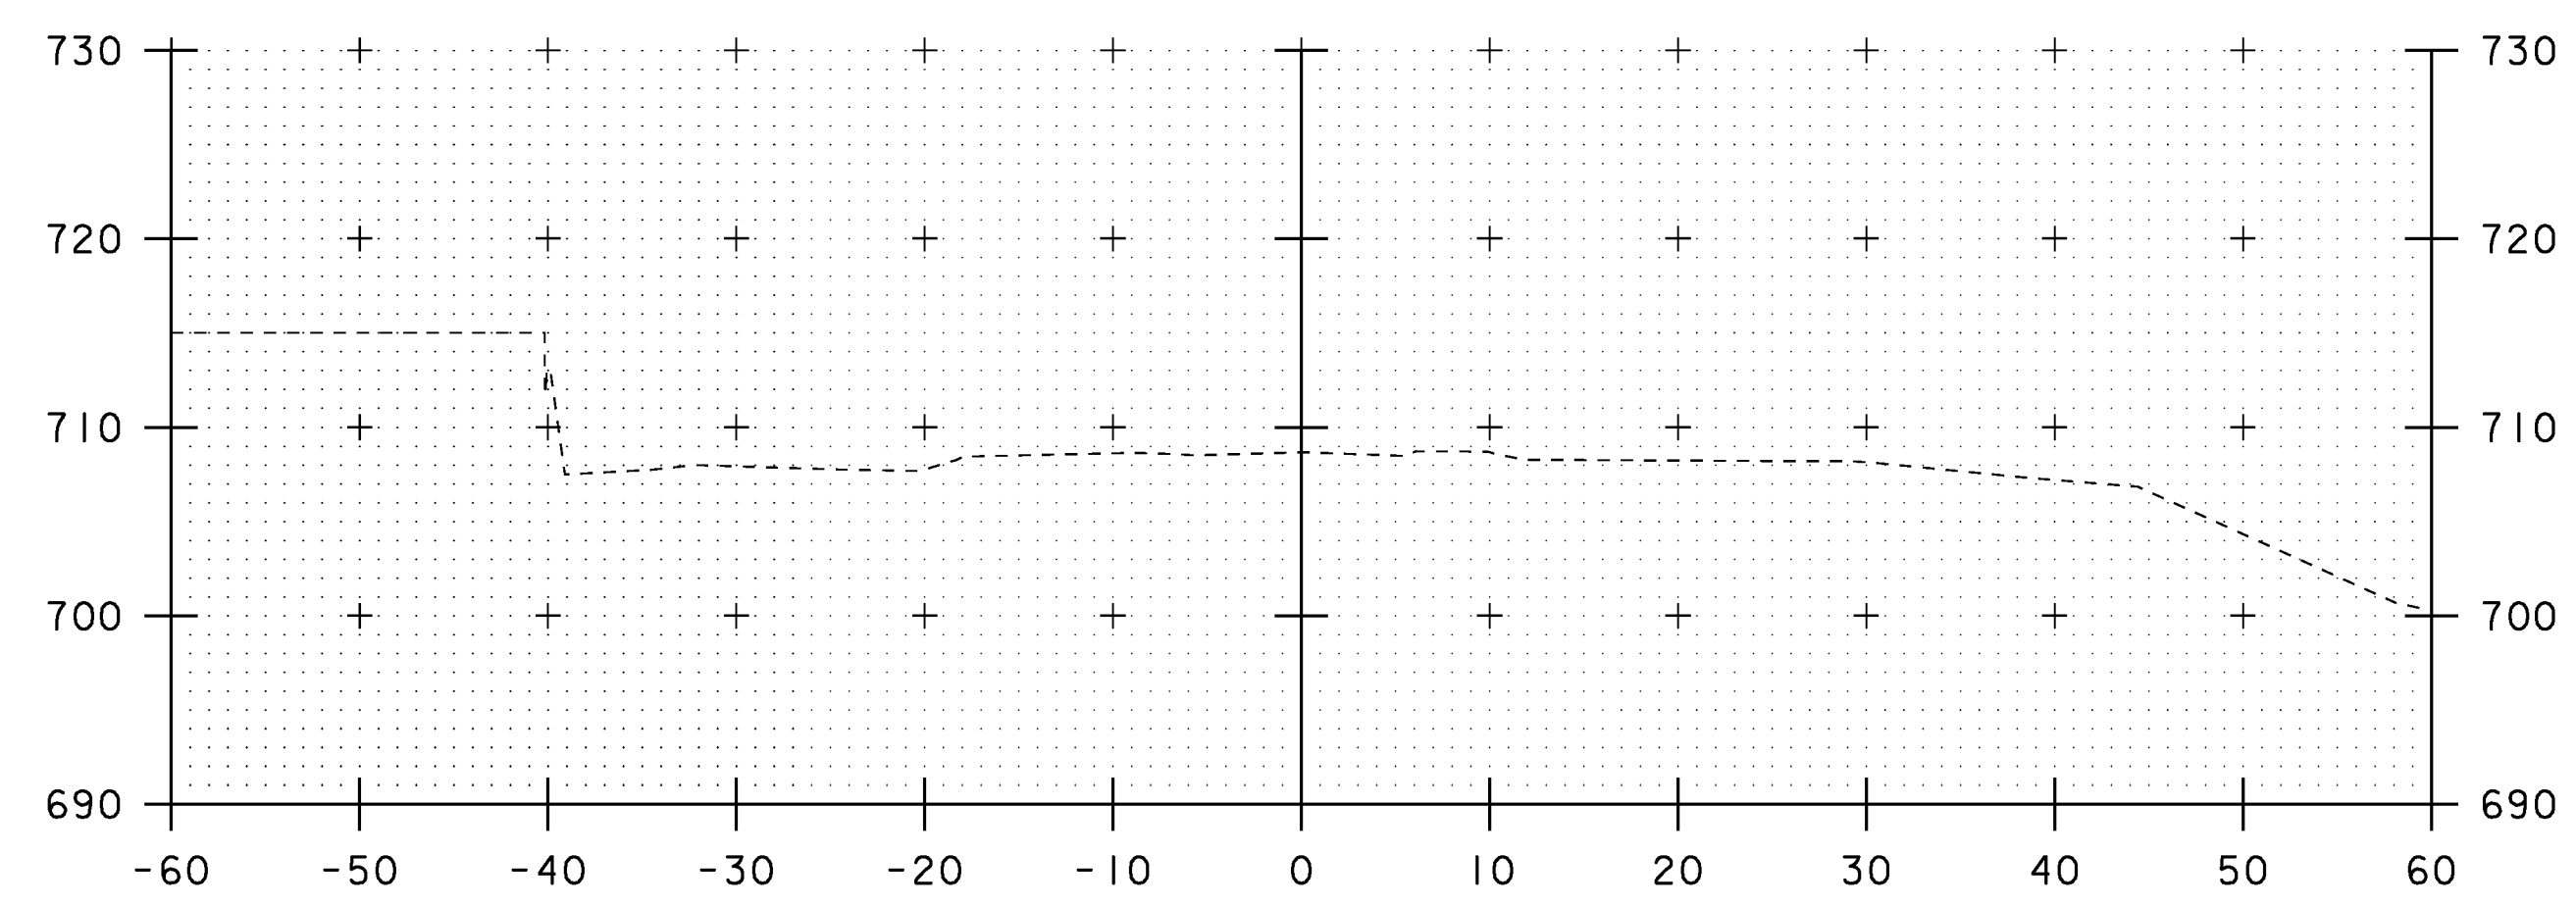

10+25

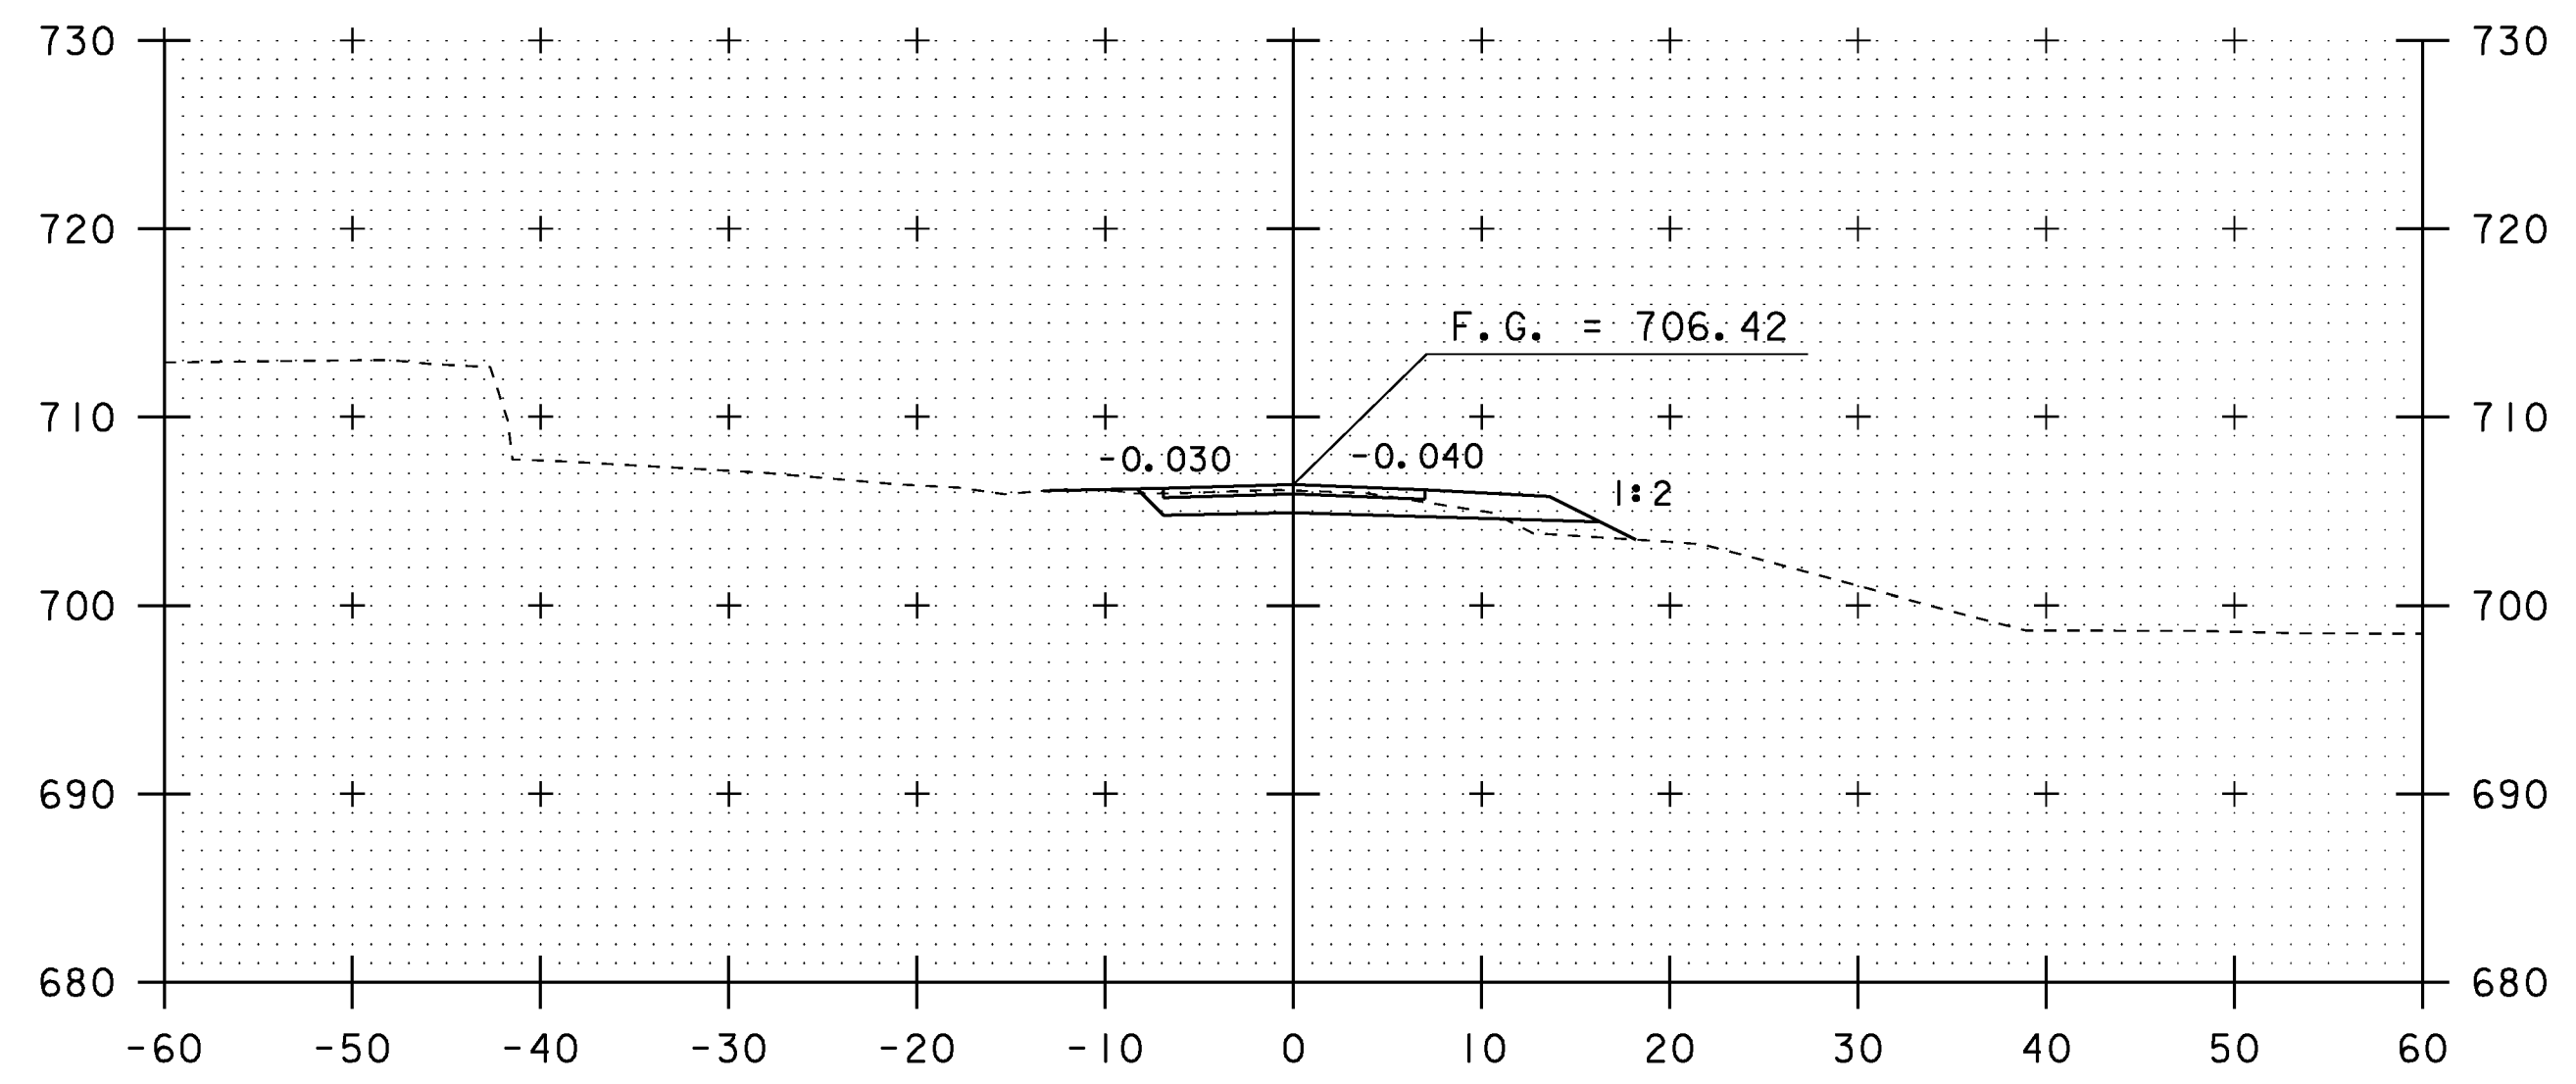


BEGIN PROJECT  
10+75


SCALE 1" = 10'-0"  
10 0 10

STA. 10+25 TO STA. 11+20


PROJECT NAME: BRAINTREE	PLOT DATE: 31-DEC-2009
PROJECT NUMBER: BRO 1444(36)	DRAWN BY: T. FILLBACH
FILE NAME: s95j292xsl.dgn	CHECKED BY: R. PELLETT
PROJECT LEADER: K. HIGGINS	SHEET 23 OF 26
DESIGNED BY: T. FILLBACH	
MAINLINE SECTIONS	

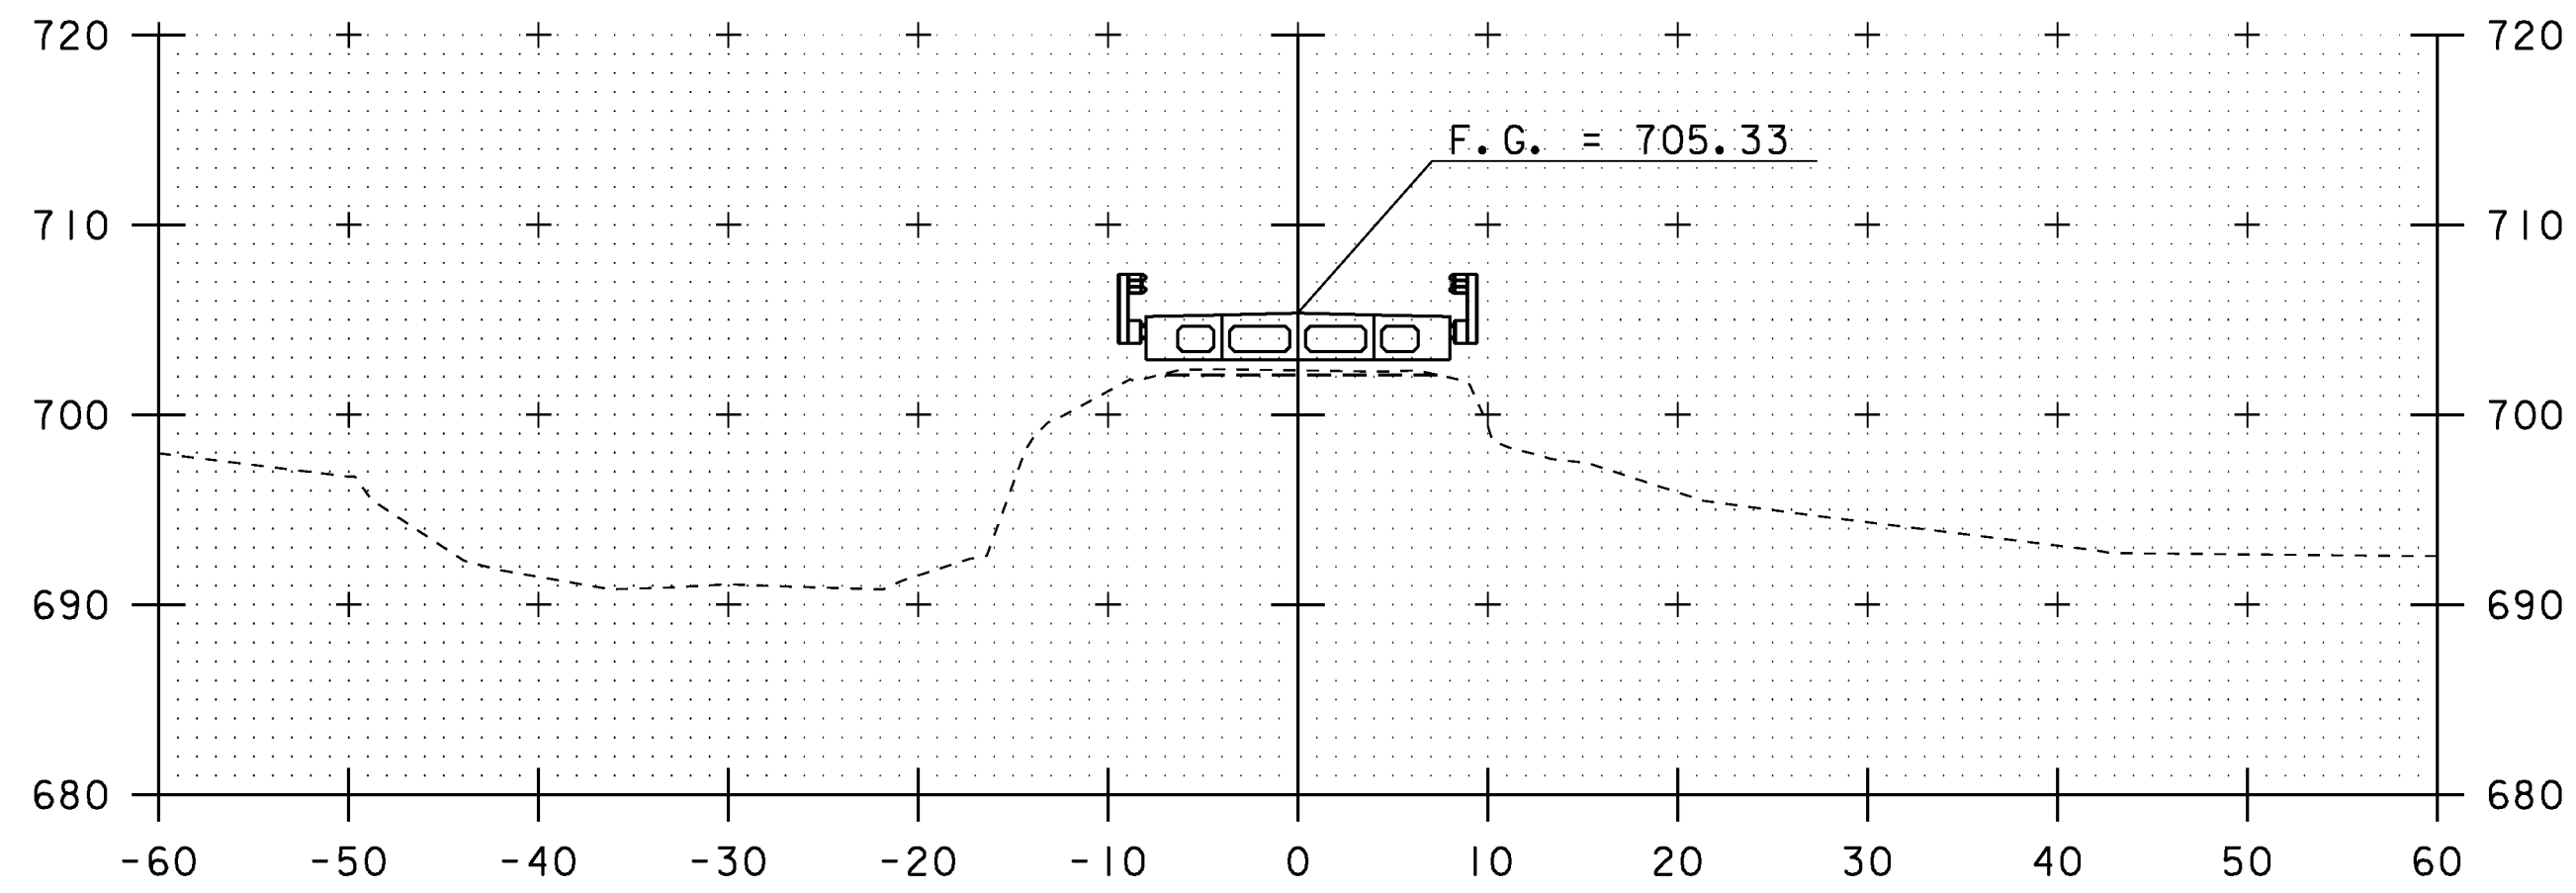


11+75

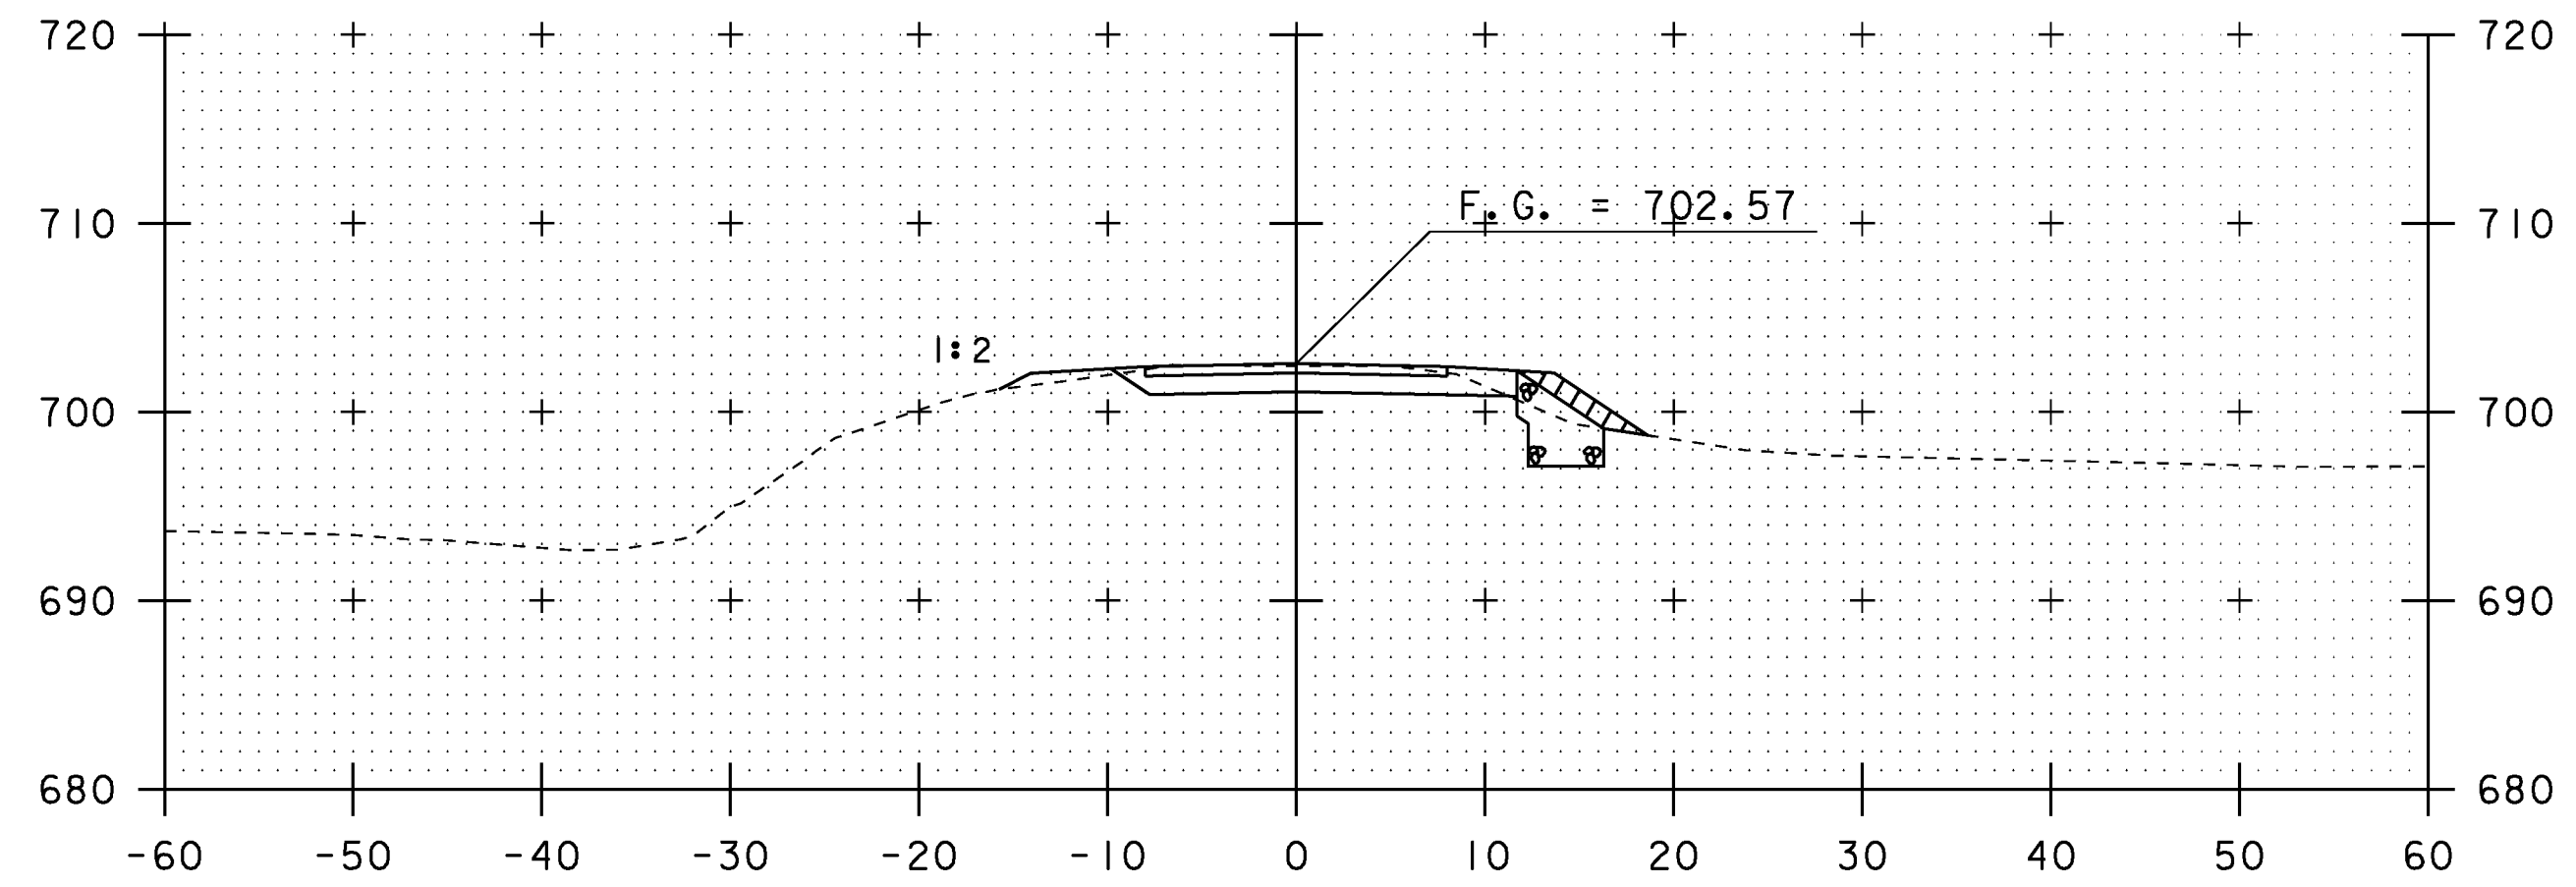


END PROJECT  
12+25

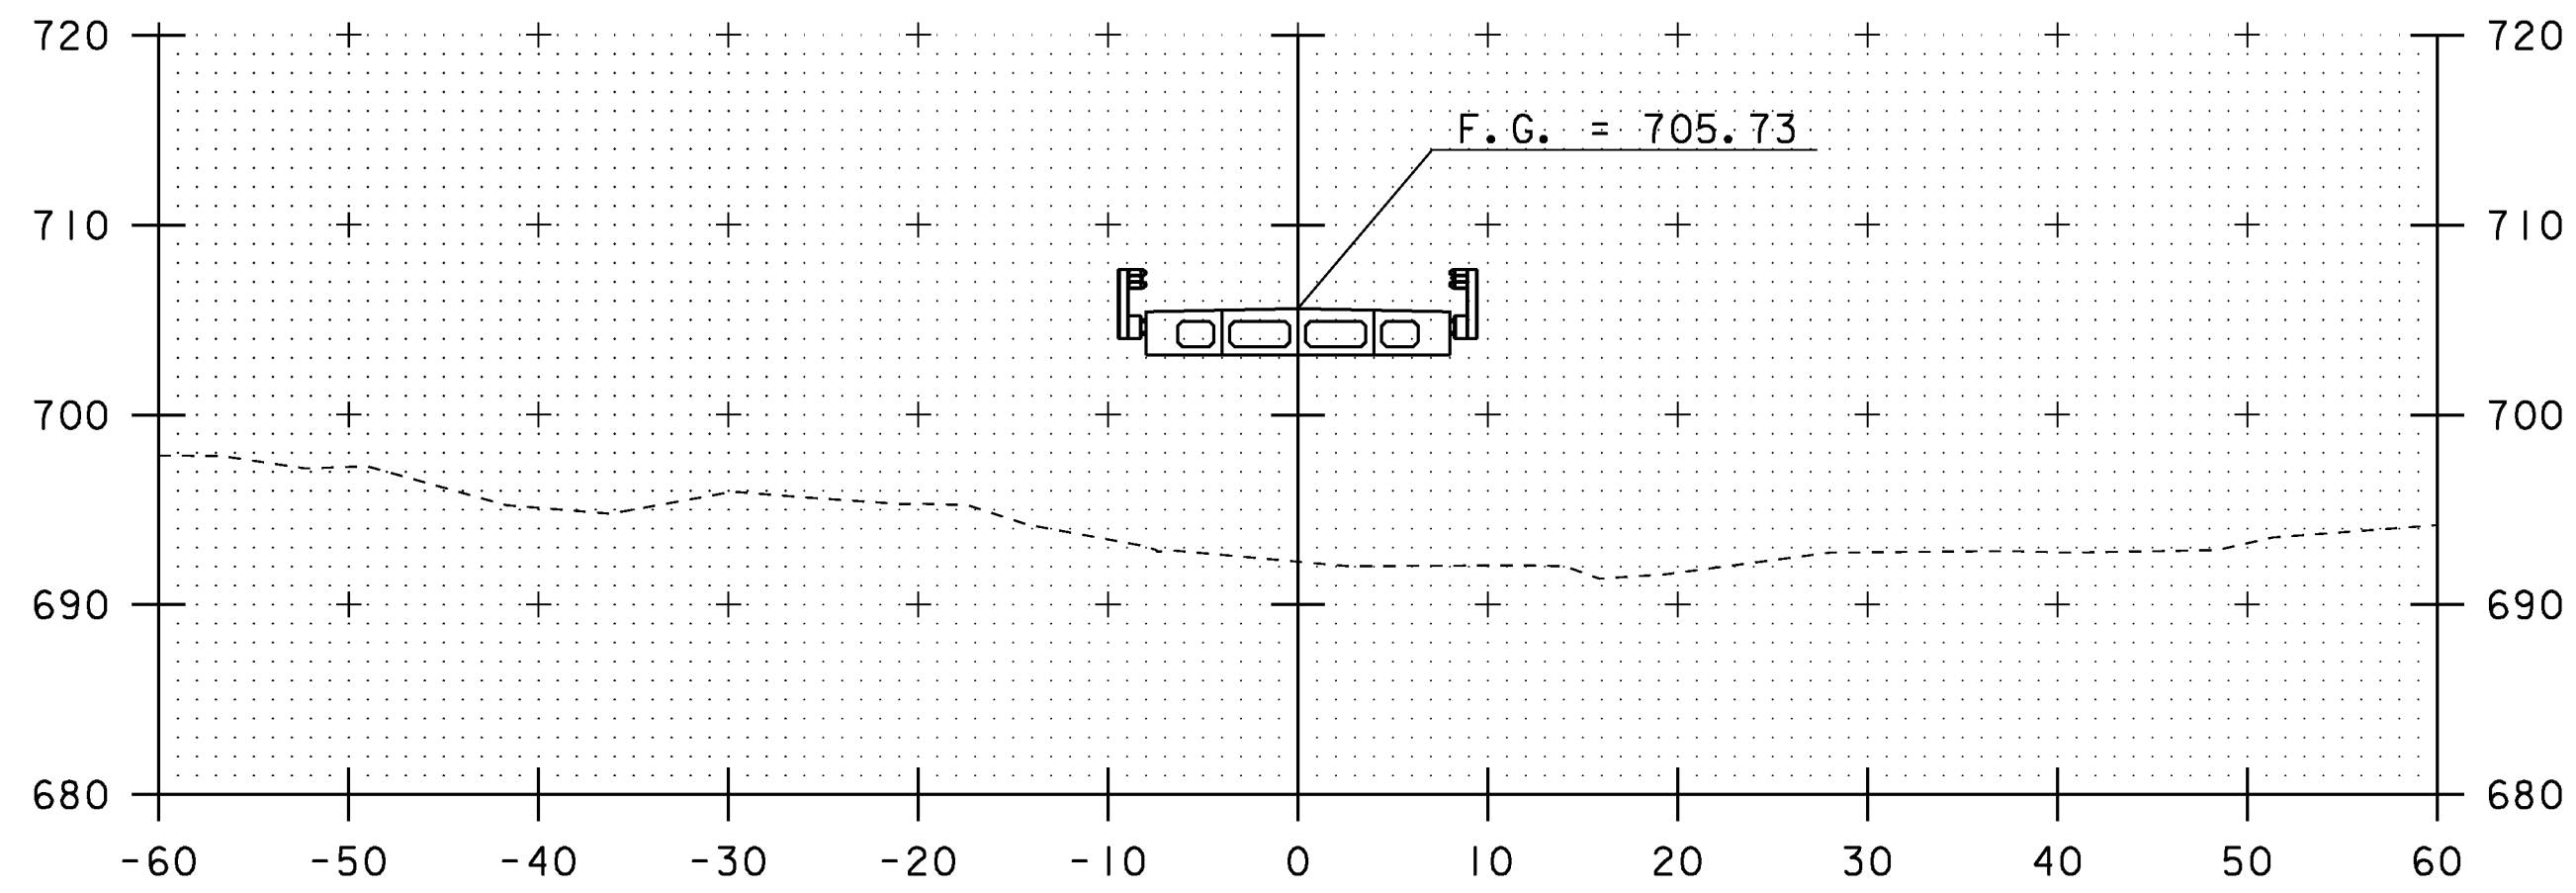


11+50

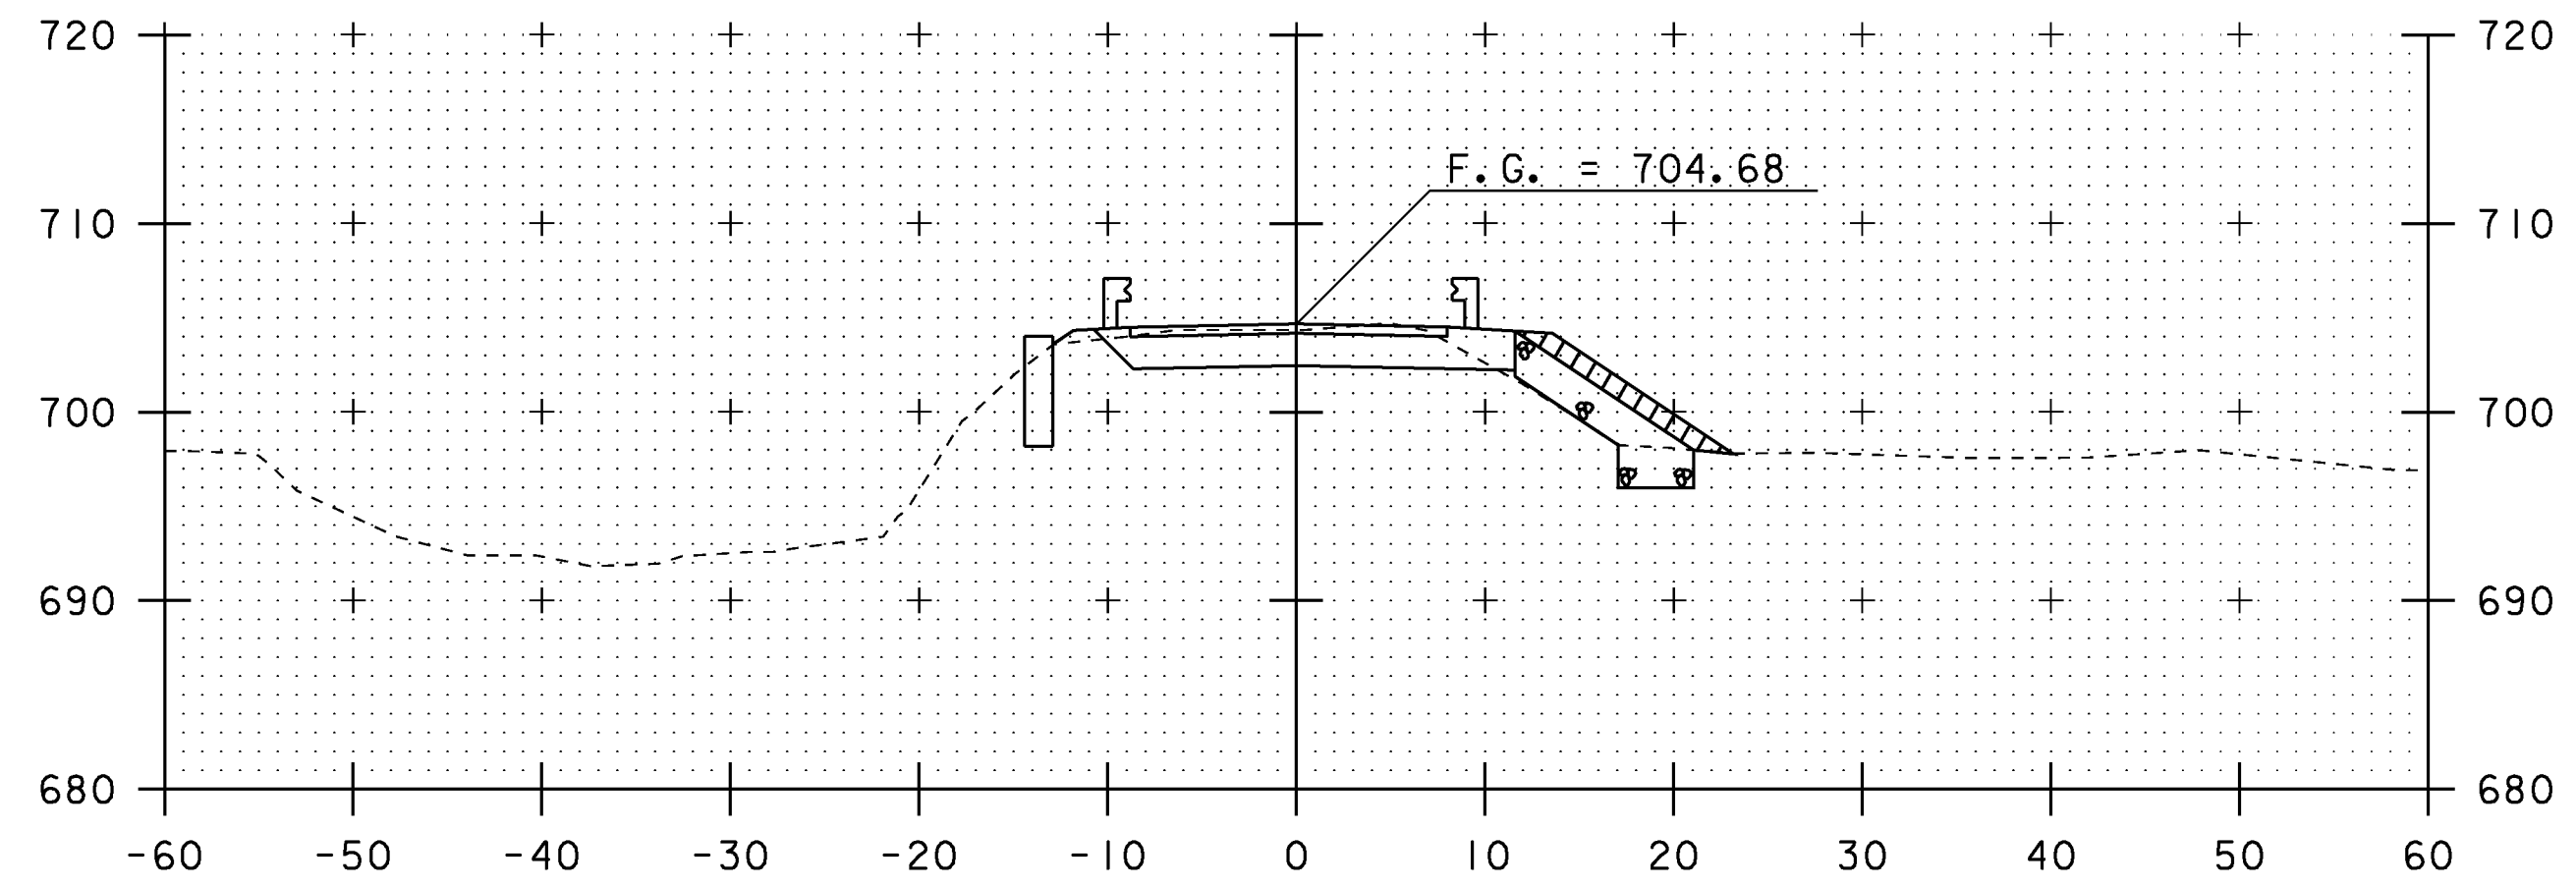

12+00

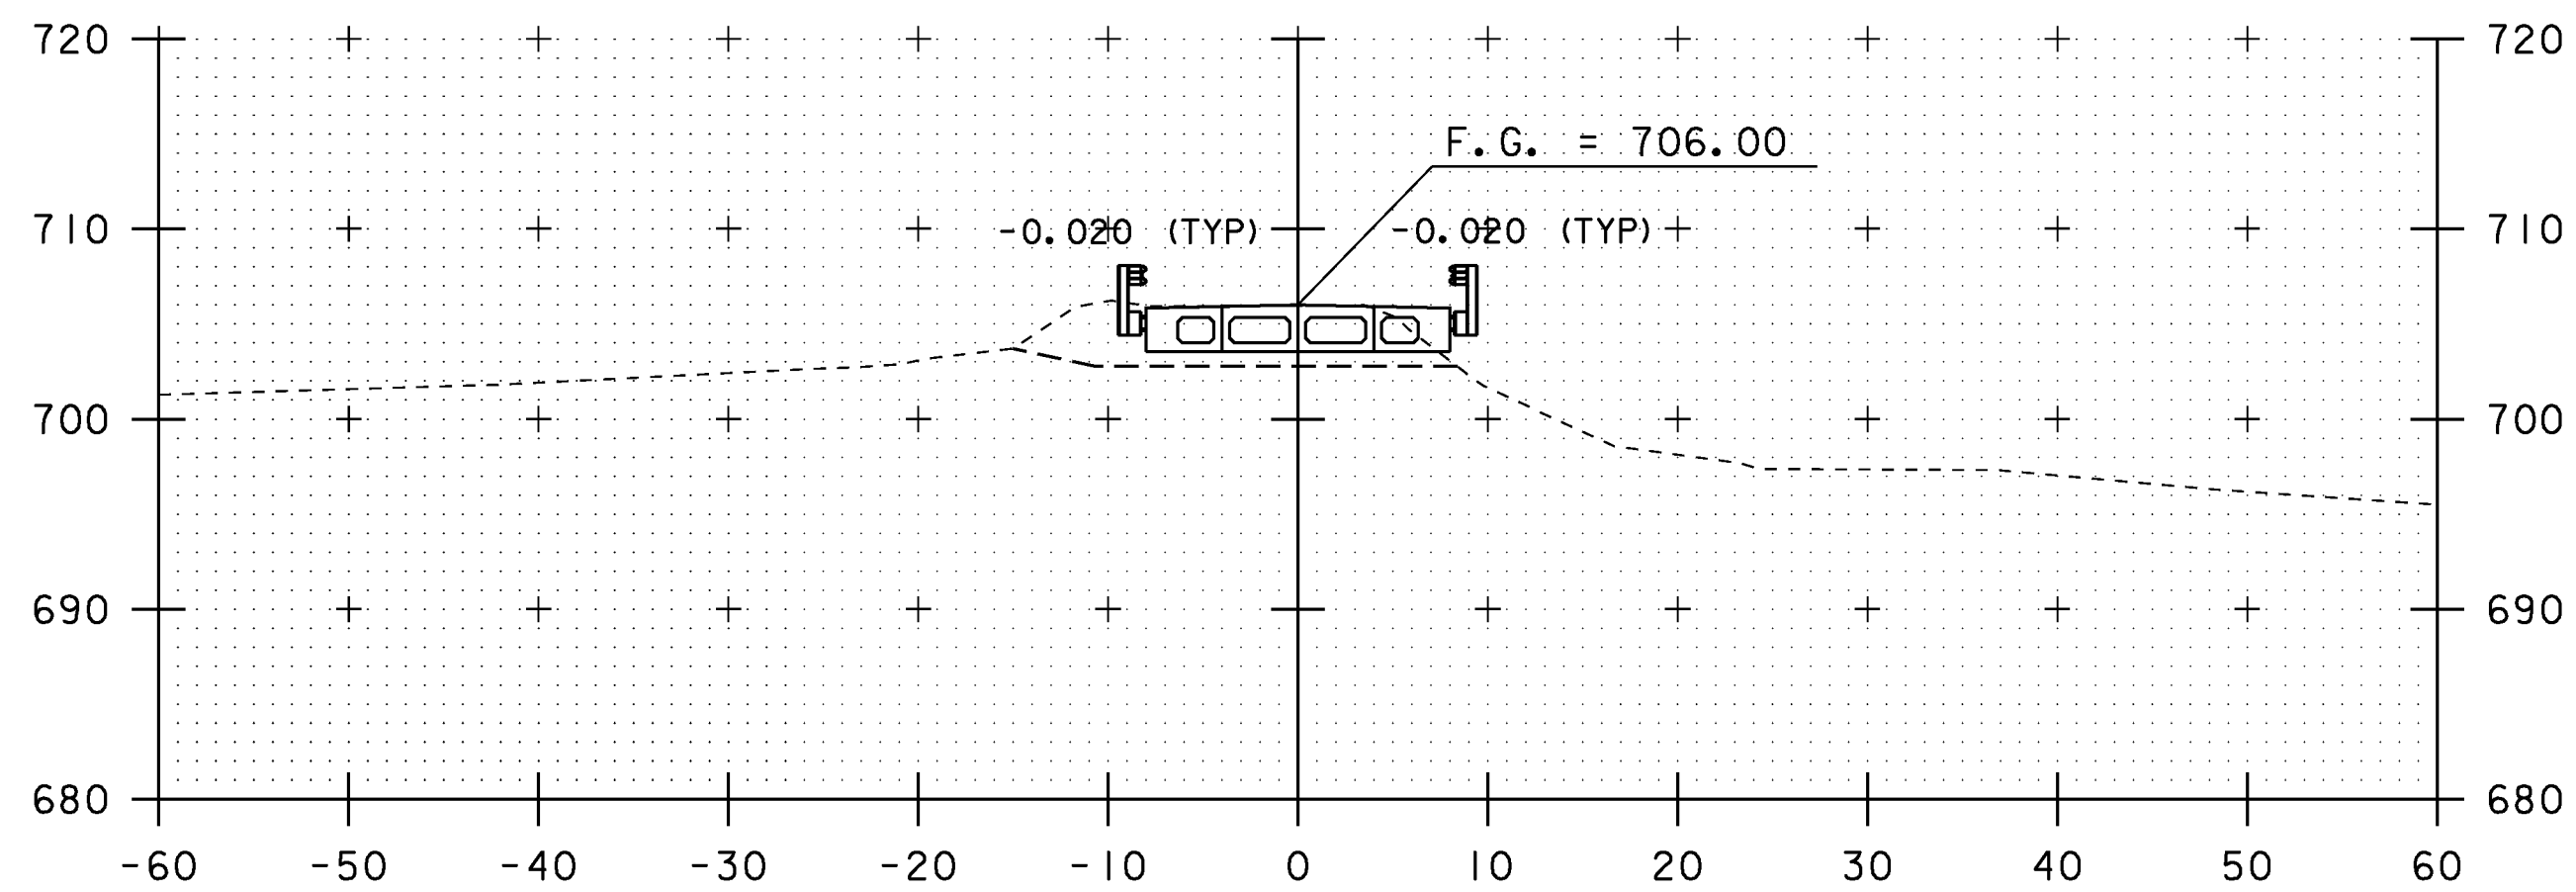

11+25

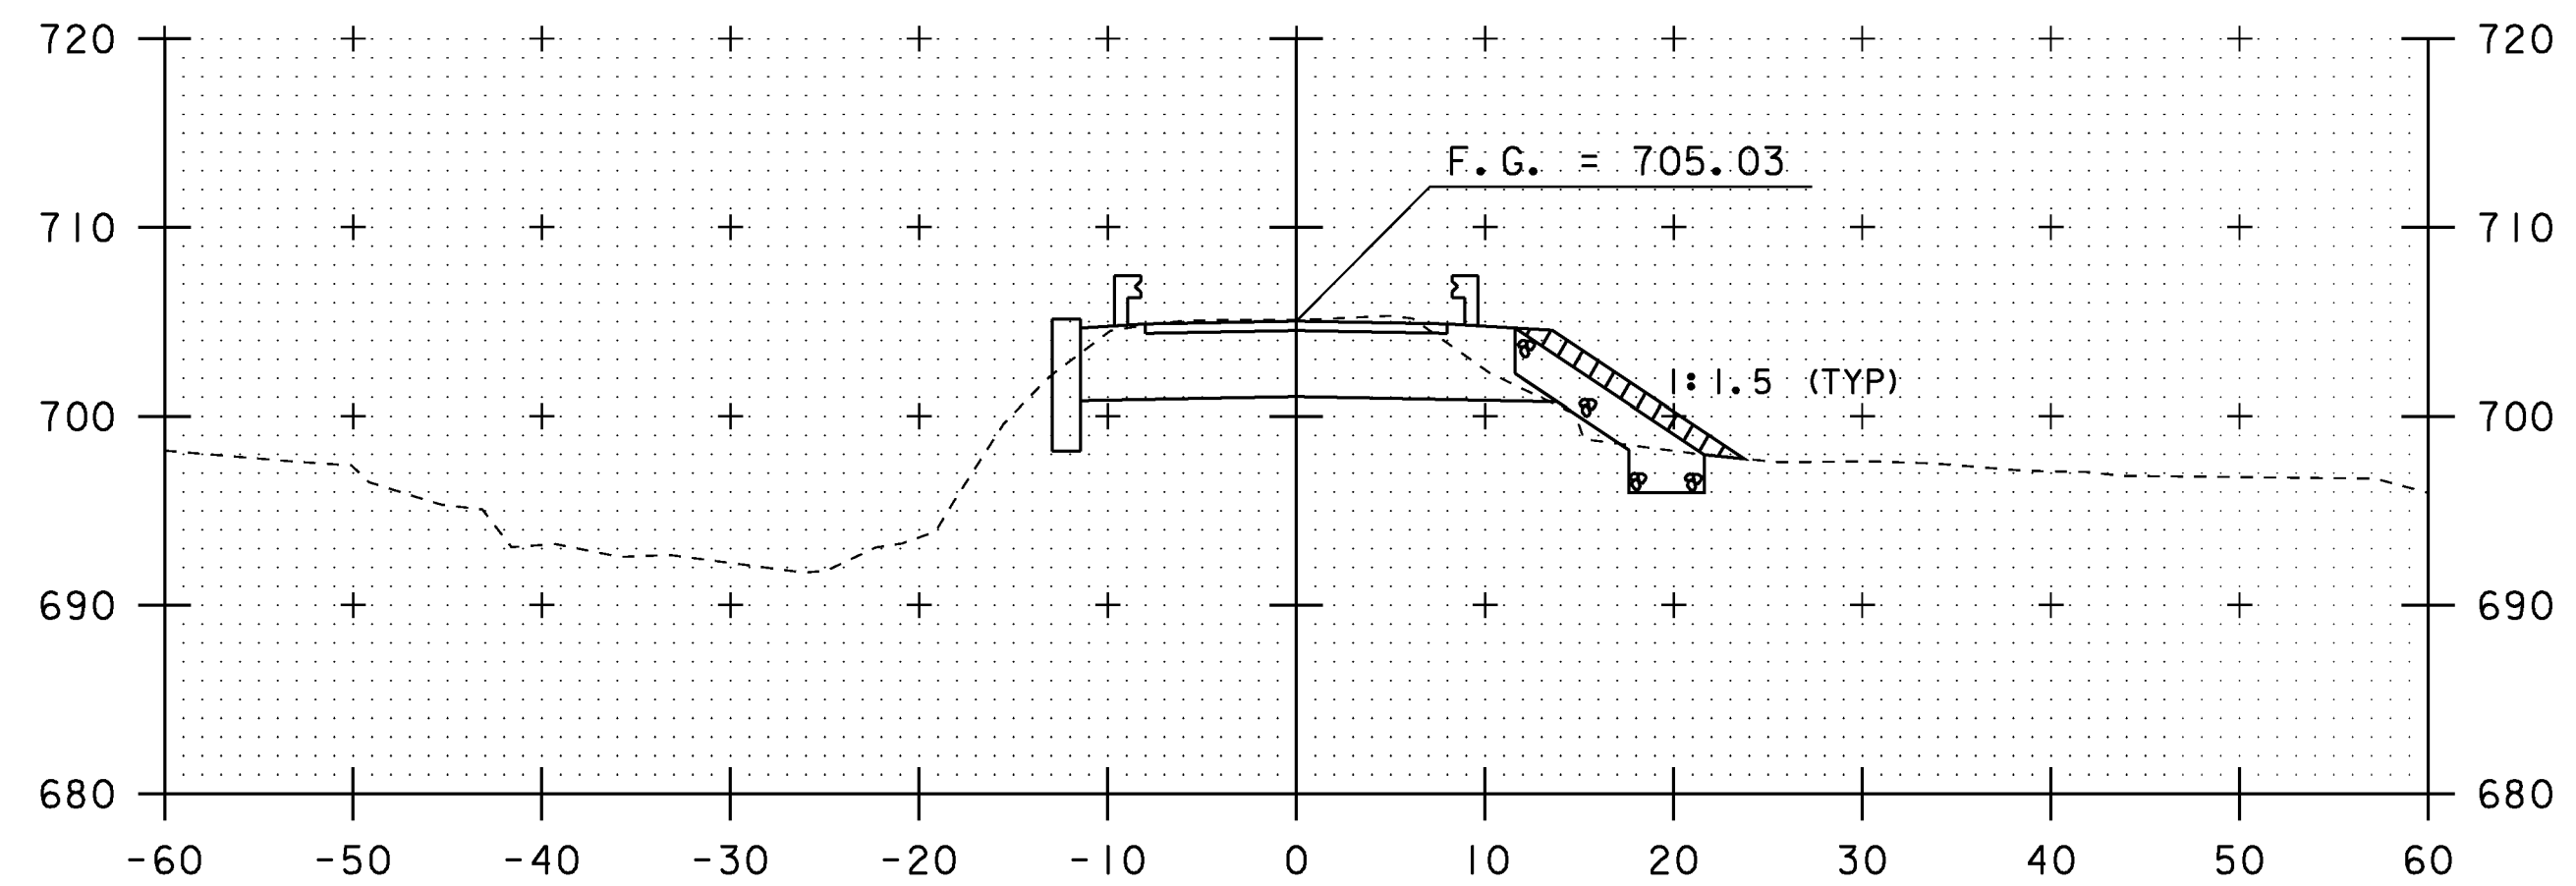

END BRIDGE  
11+90


SCALE 1" = 10'-0"  
10 0 10

STA. 11+25 TO STA. 12+25


PROJECT NAME: BRAINTREE  
PROJECT NUMBER: BRO 1444(36)

FILE NAME: s95j292xsl.dgn  
PROJECT LEADER: K. HIGGINS  
DESIGNED BY: T. FILLBACH  
MAINLINE SECTIONS


PLOT DATE: 31-DEC-2009  
DRAWN BY: T. FILLBACH  
CHECKED BY: R. PELLETT  
SHEET 24 OF 26

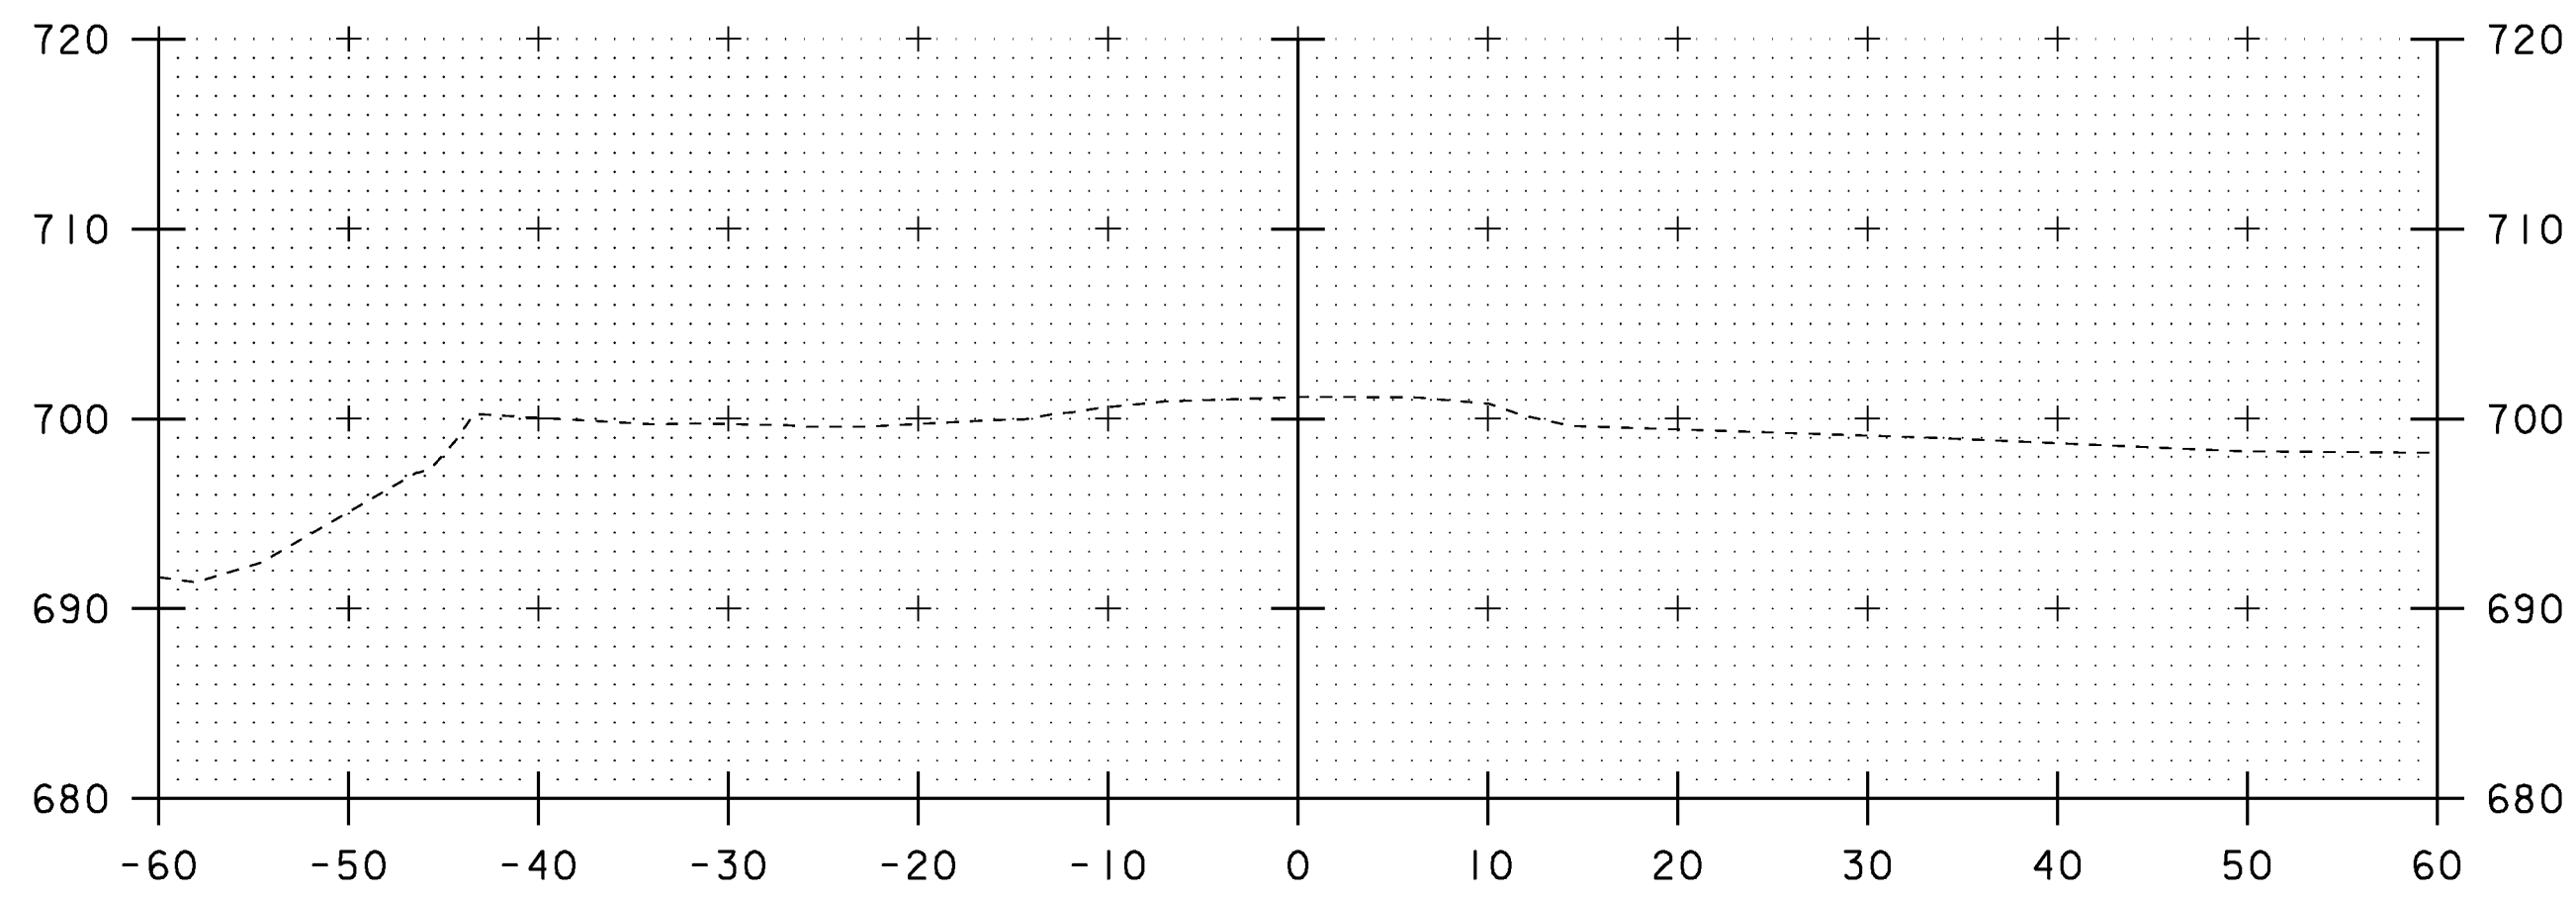

12+75

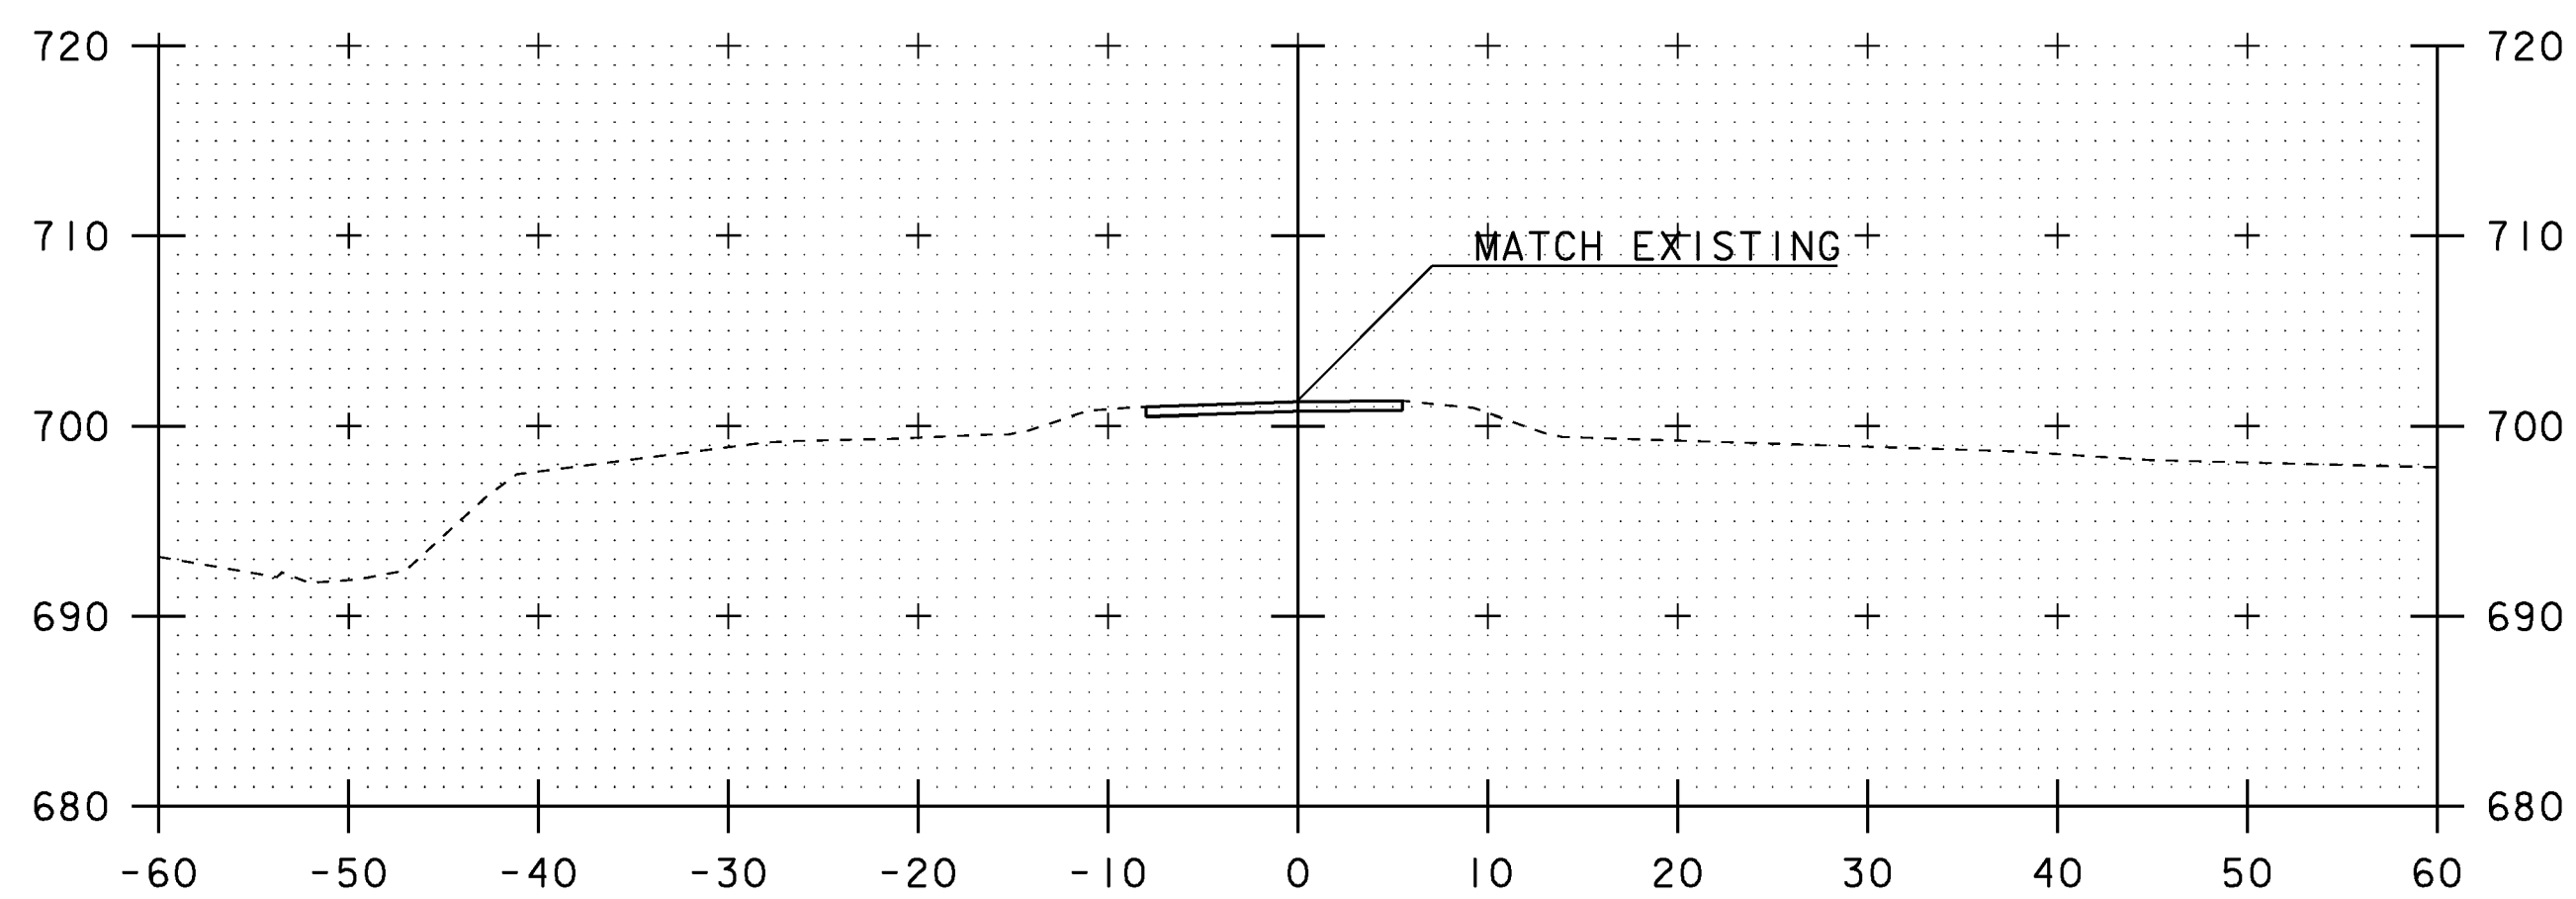

END APPROACH  
12+50

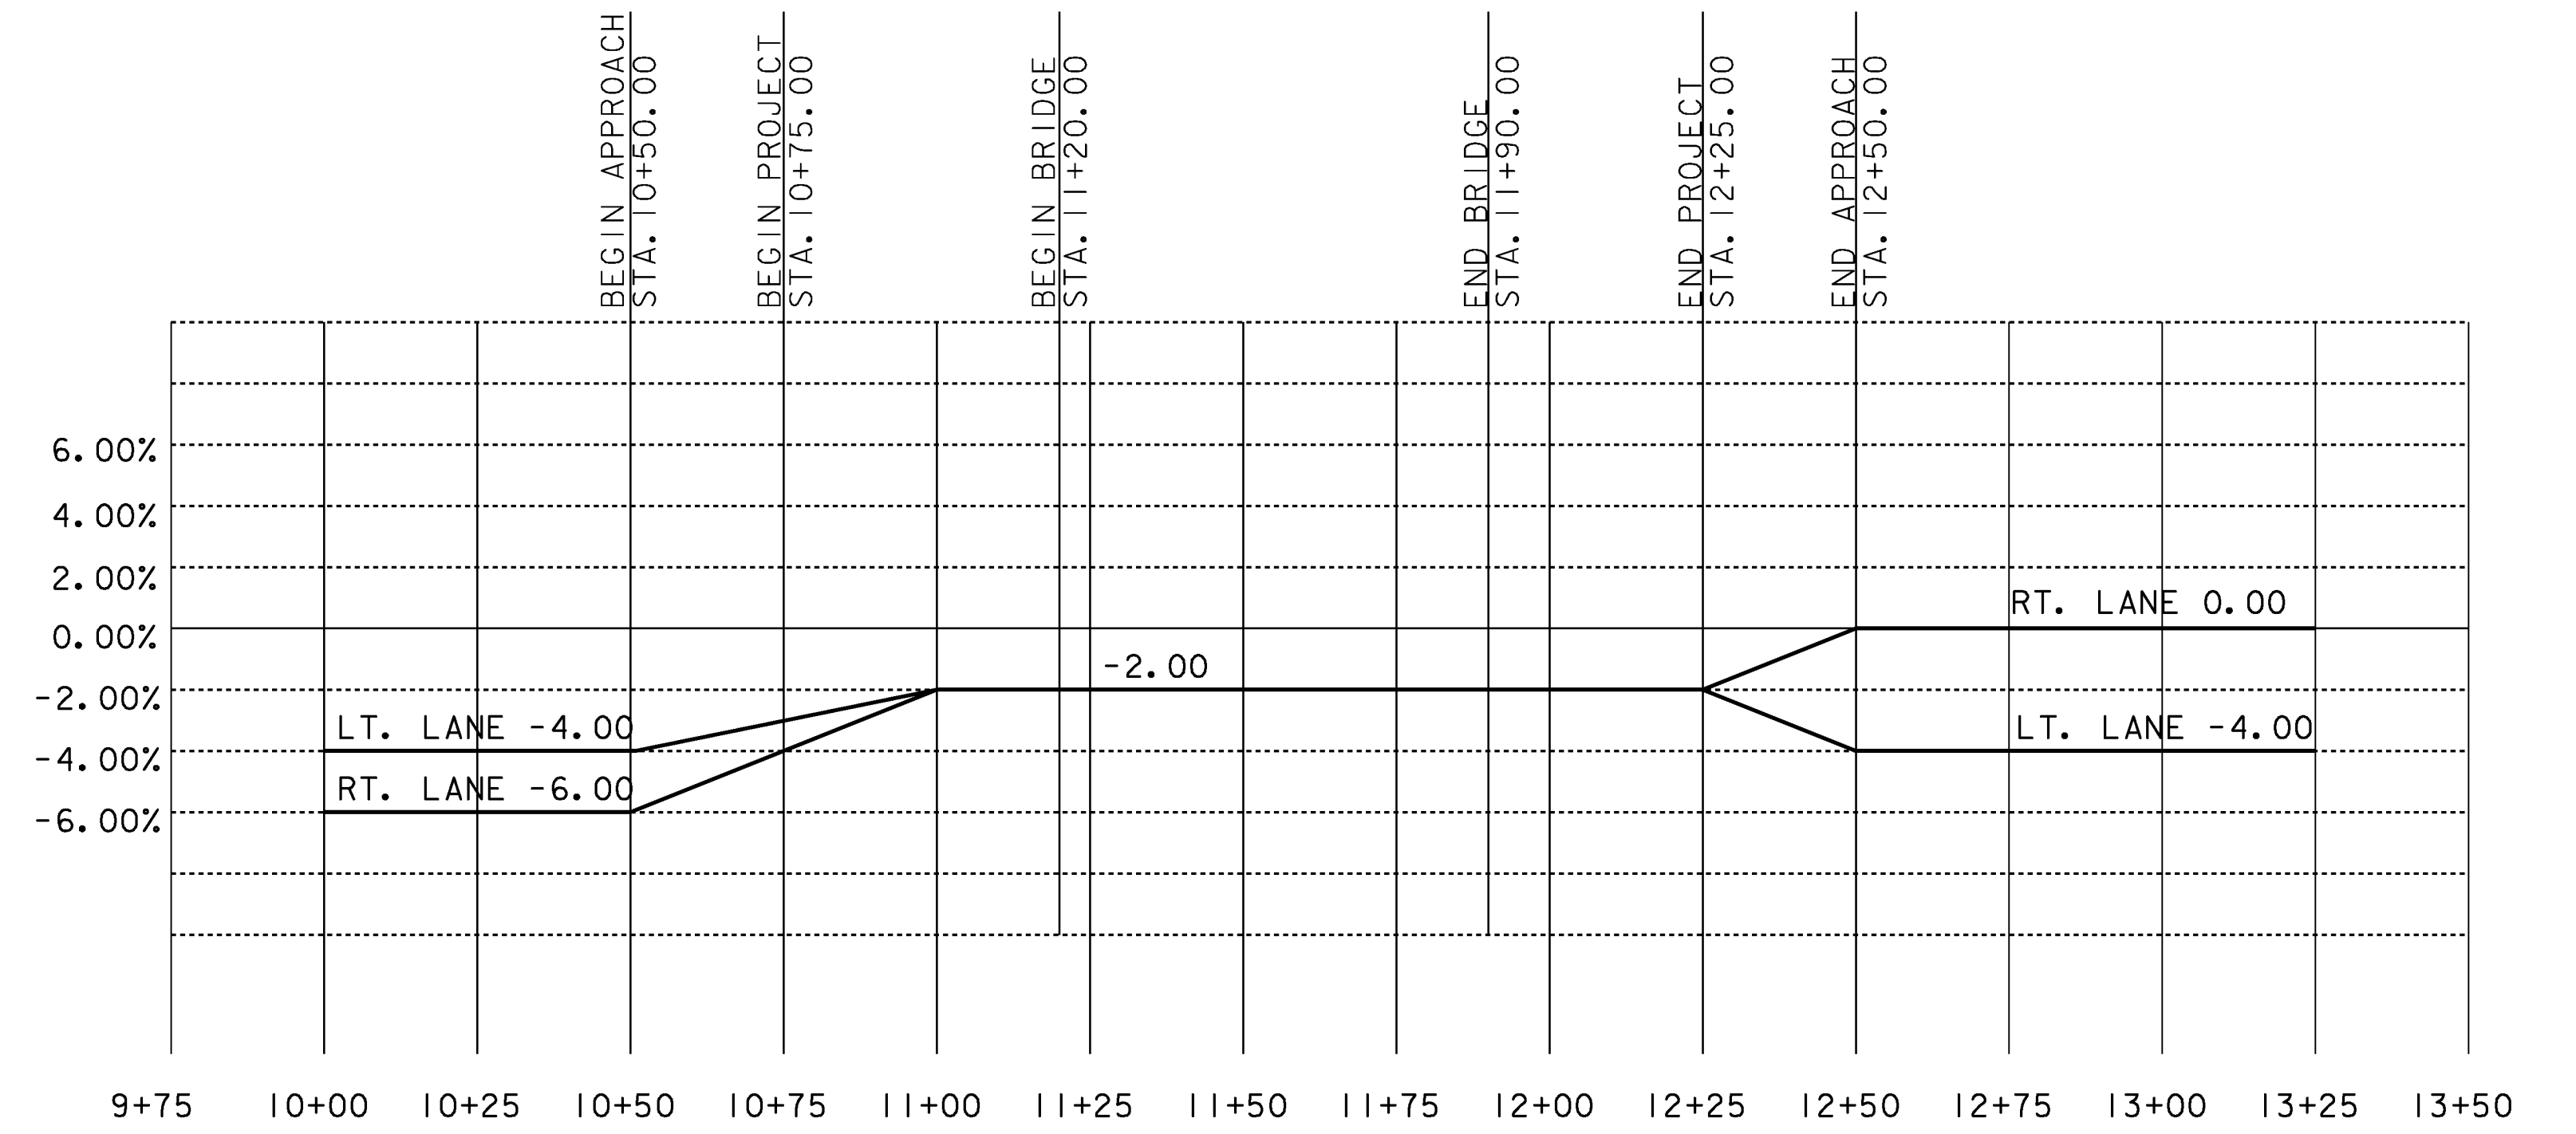


SUPERELEVATION DIAGRAM  
NOT TO SCALE


SCALE 1" = 10'-0"  
10 0 10

PROJECT NAME: BRAINTREE	PLOT DATE: 31-DEC-2009
PROJECT NUMBER: BRO 1444(36)	DRAWN BY: T. FILLBACH
FILE NAME: s95J292xsl.dgn	CHECKED BY: R. PELLETT
PROJECT LEADER: K. HIGGINS	SHEET 25 OF 26
DESIGNED BY: T. FILLBACH	
MAINLINE SECTIONS	


STA. 12+50 TO STA. 12+75

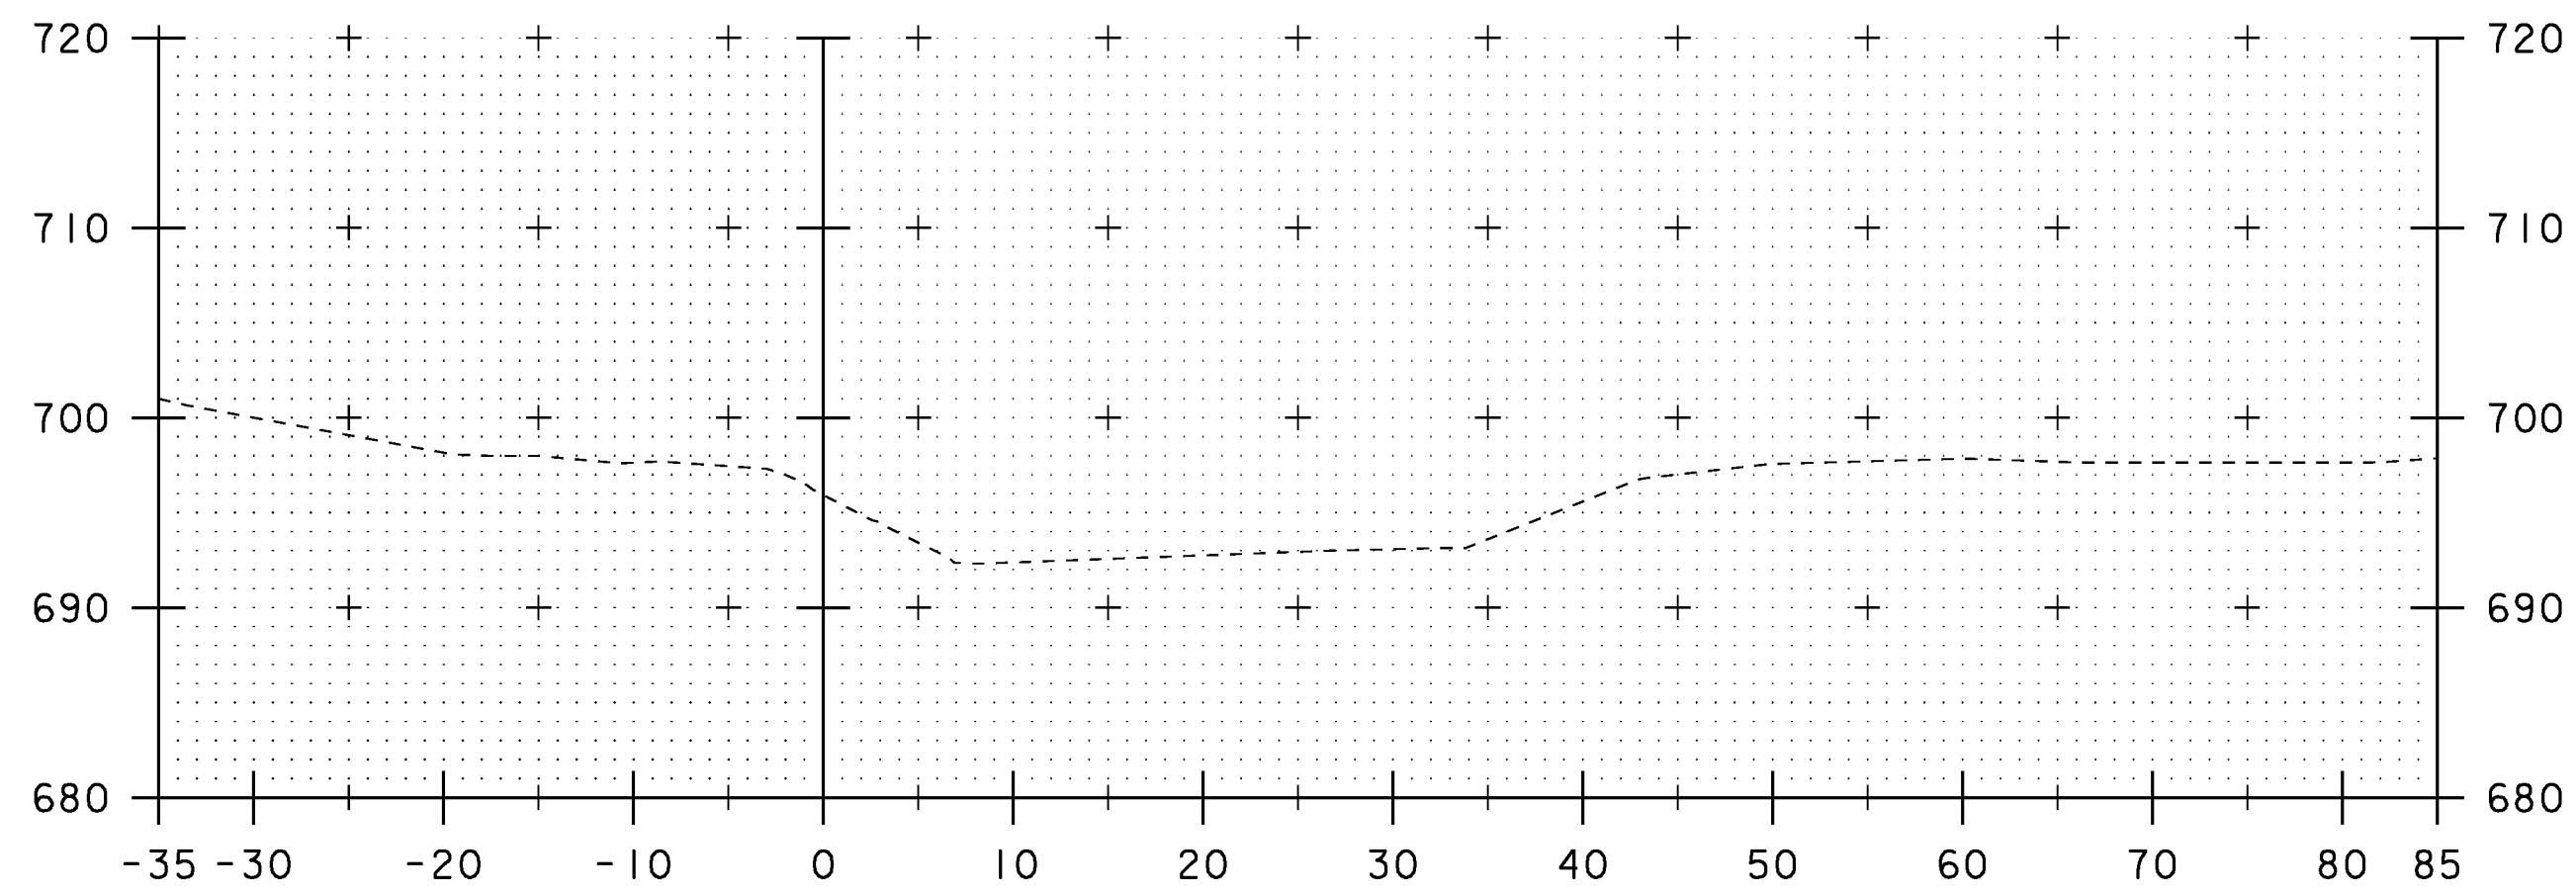


20+50

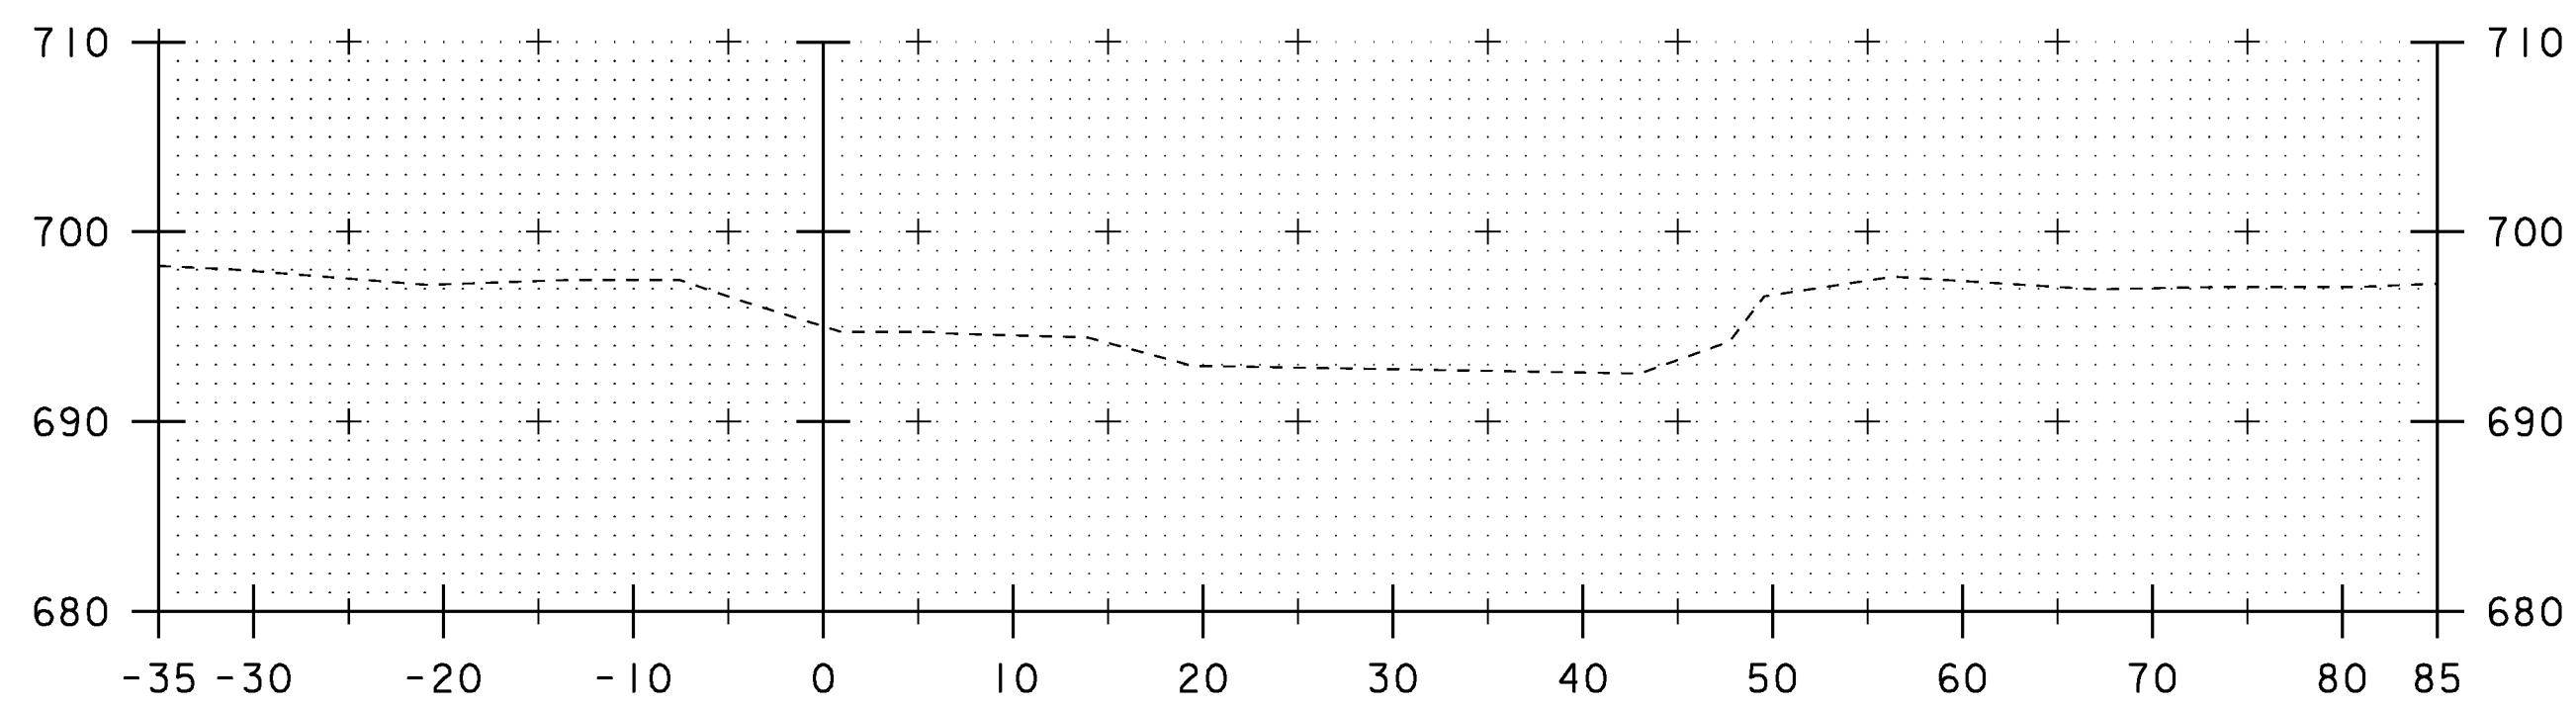


20+25

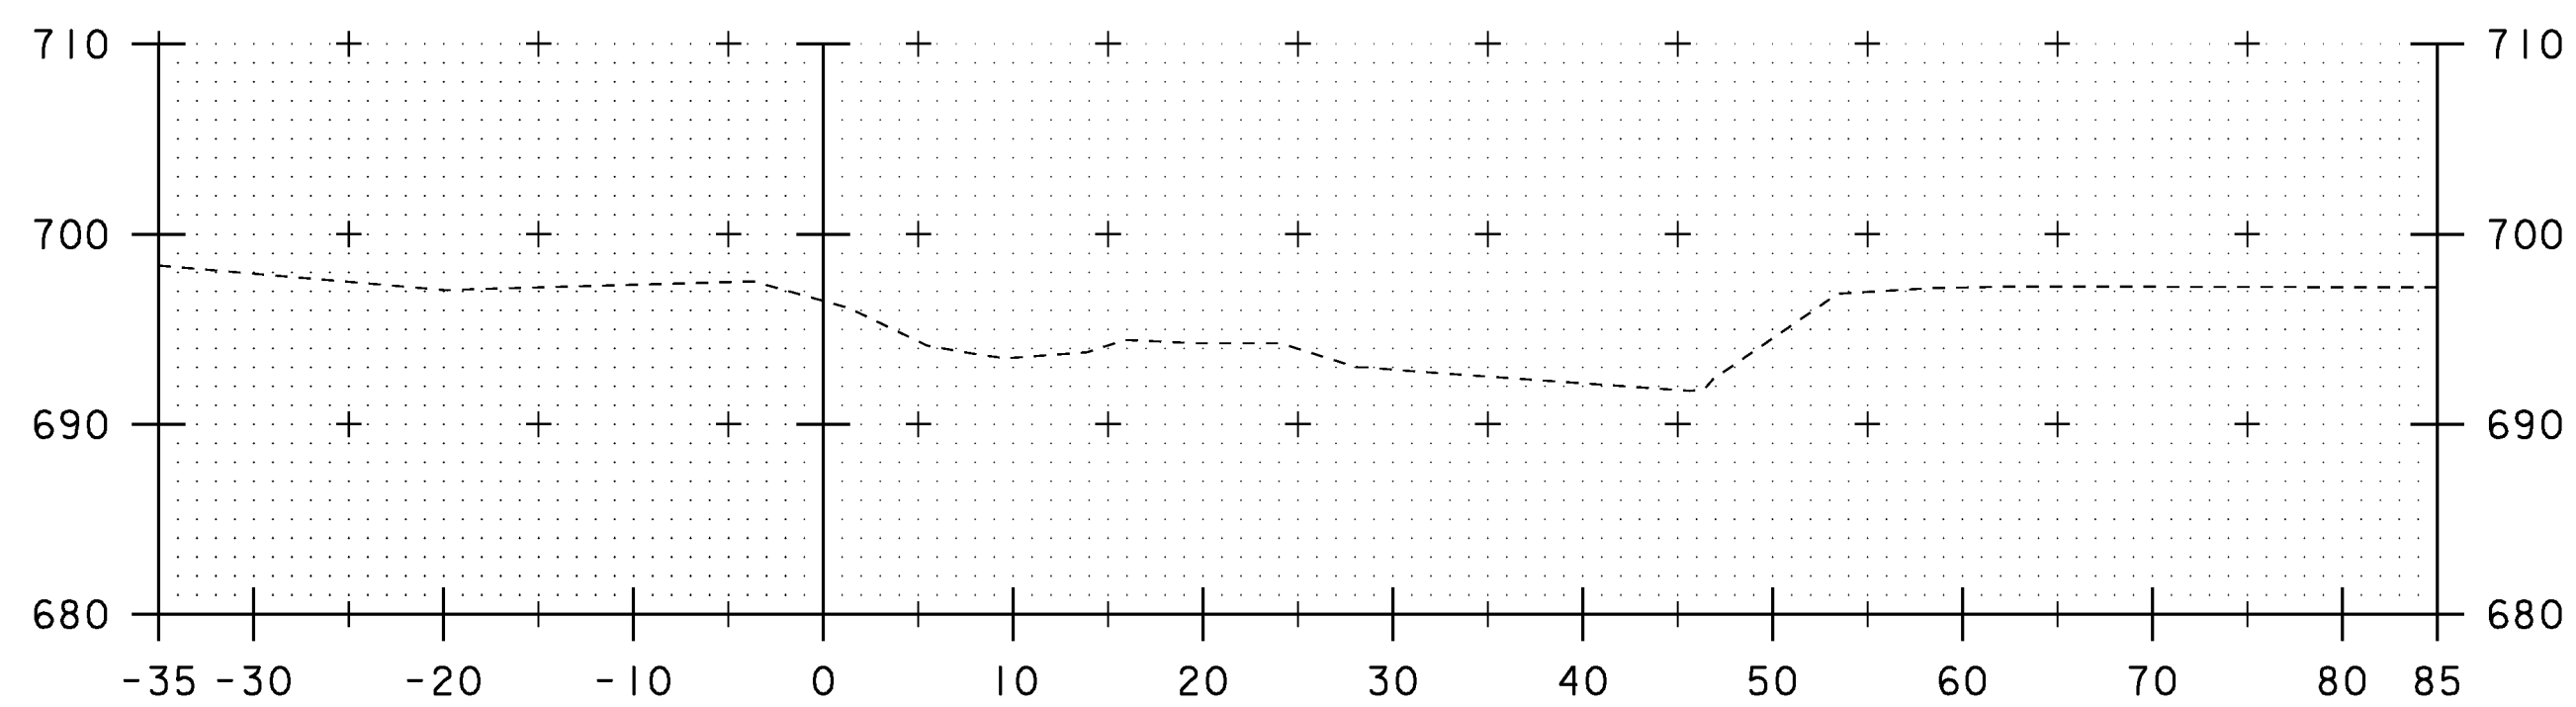


20+00

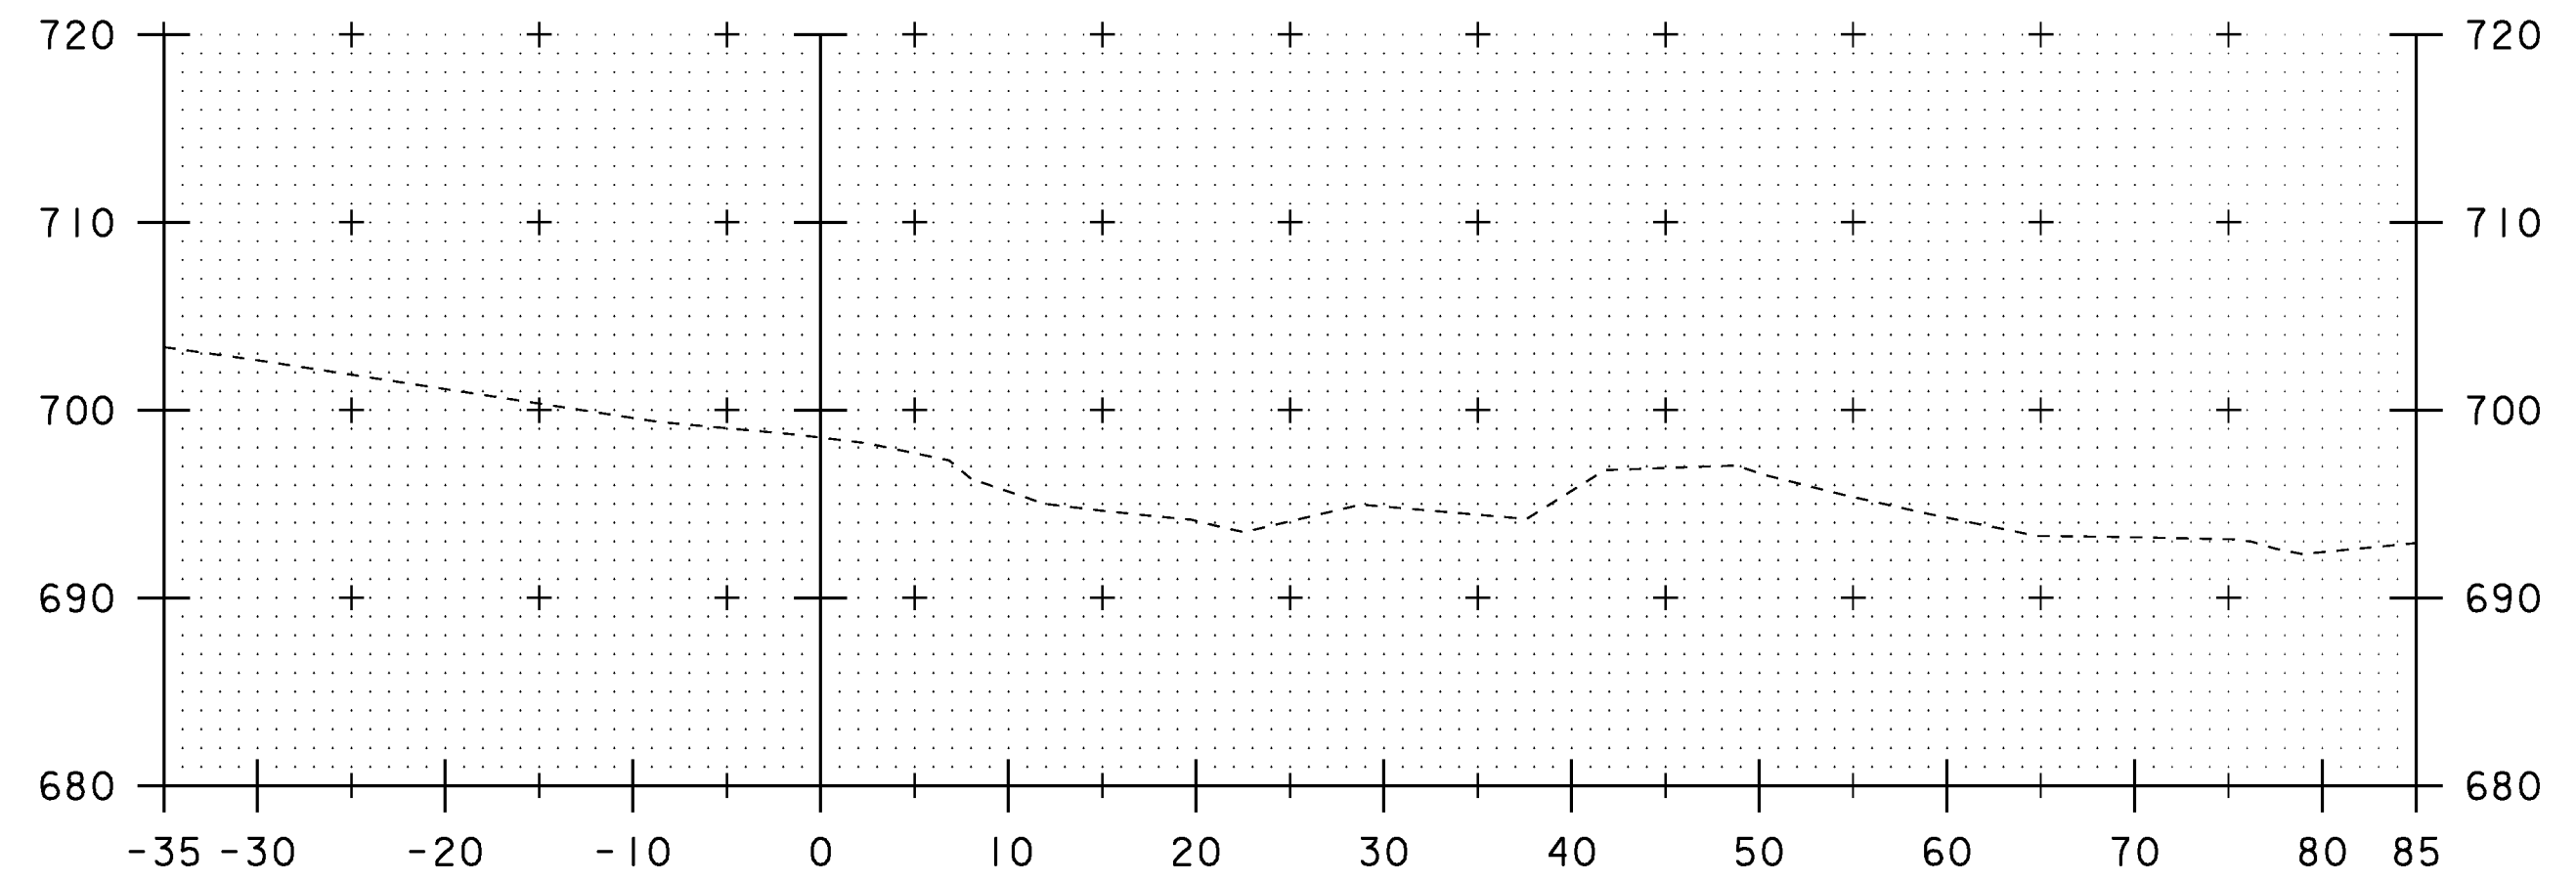

21+25

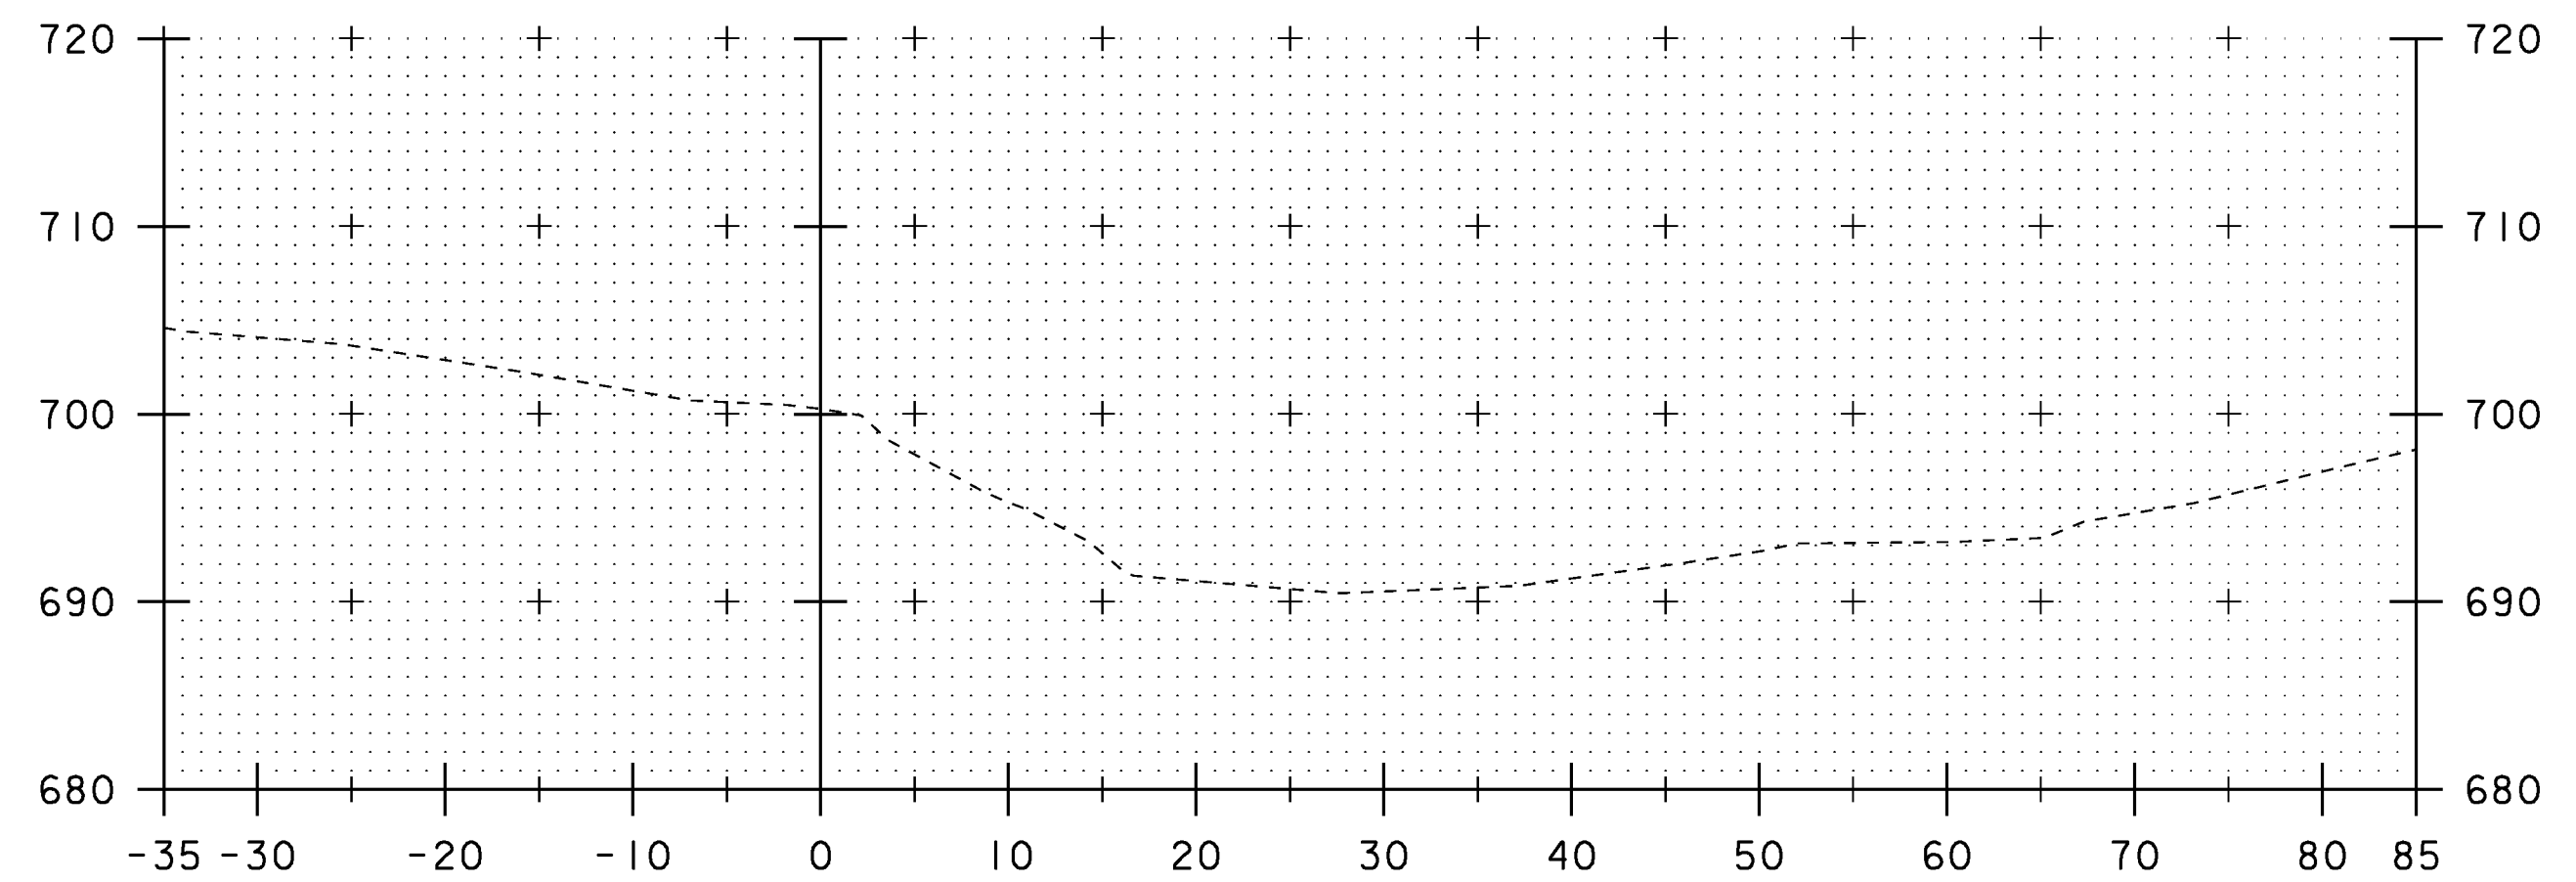

21+00

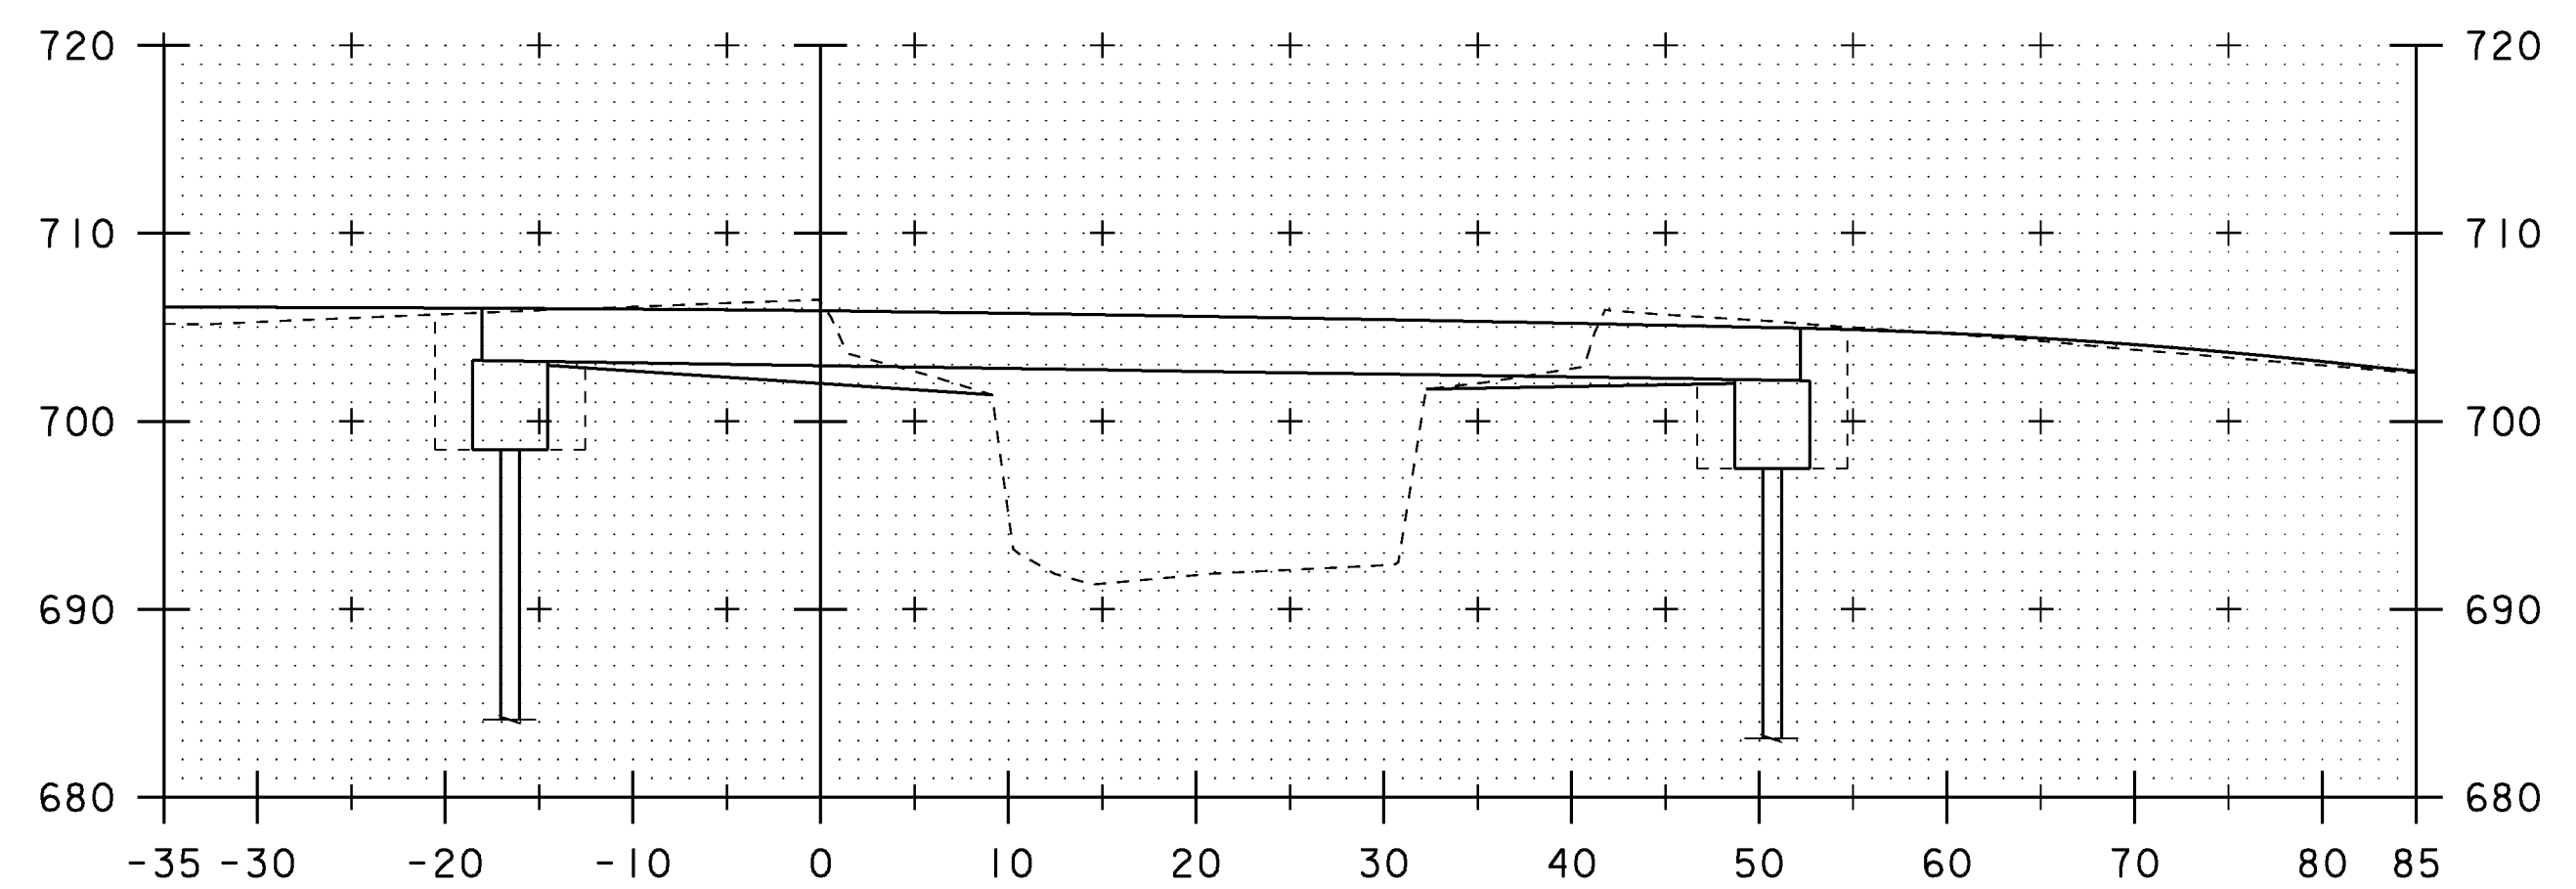

20+75

SCALE 1" = 10'-0"

STA. 20+00 TO STA. 21+25

PROJECT NAME: BRAINTREE	PLOT DATE: 31-DEC-2009
PROJECT NUMBER: BRO 1444(36)	DRAWN BY: T. FILLBACH
FILE NAME: s95j292xsl.dgn	CHECKED BY: R. PELLETT
PROJECT LEADER: K. HIGGINS	SHEET 26 OF 26
DESIGNED BY: T. FILLBACH	
CHANNEL SECTIONS	



State of Vermont  
PDD/Structures Design Section  
One National Life Drive  
Montpelier, VT 05633-5001  
www.aot.state.vt.us

(phone) 802-888-2621  
(fax) 802-888-3566  
(tdd) 800-253-0191

Agency of Transportation

July 12, 2010

Renaud Bros. Construction  
283 Fort Bridgeman Rd #2  
Vernon, VT 05354


Project Name: Braintree BRO 1444(36)

Structure Identification: Bridge 12 over Ayers Brook

The following Bridge Abutment Plans (Incidental to Items 540.10 Precast Concrete Structure (Abutment #1) and 540.10 Precast Concrete Structure (Abutment #2) for the above project received in this office on June 29, 2010 has been reviewed and is being returned herewith.

All details are approved as noted. The details for the retaining wall have not been received as of this time.


Sincerely,

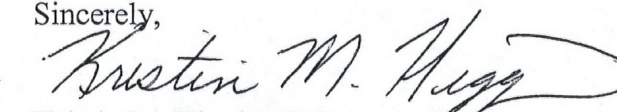  
Kristin M. Higgins, P.E.  
Structures Project Manager


Attachments

- cc:  Jeremy Reed - Resident Engineer - letter and plans  
 Renaud Bros Construction - Contractor - letter and Plans  
 Construction Division - letter only  
 Files (KMH)


Abutment Details\_Approval\_0712.doc

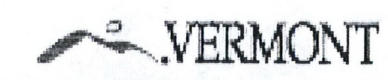


027-ABUT

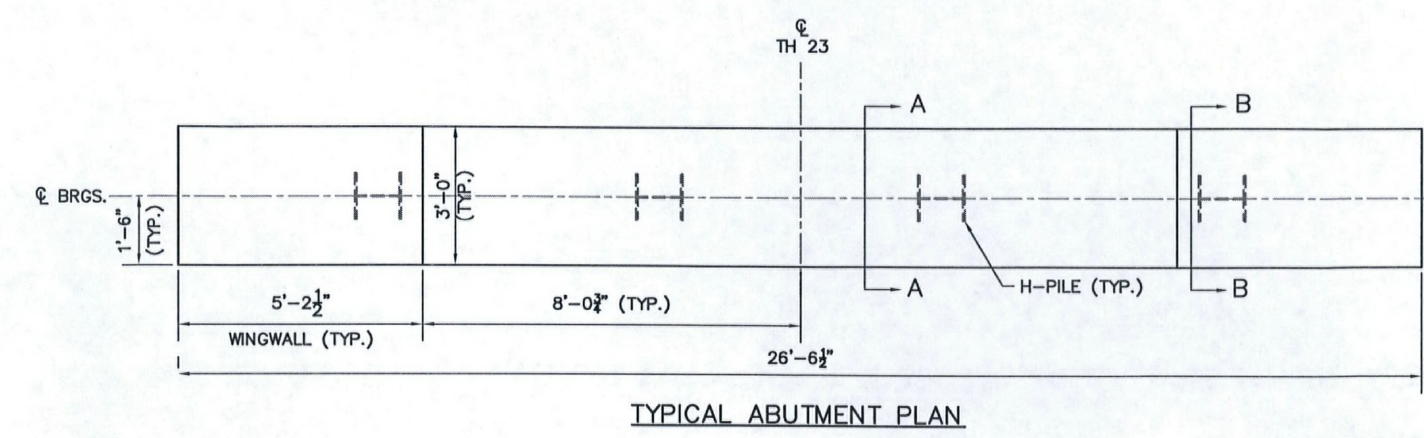


TYPICAL ABUTMENT PLAN

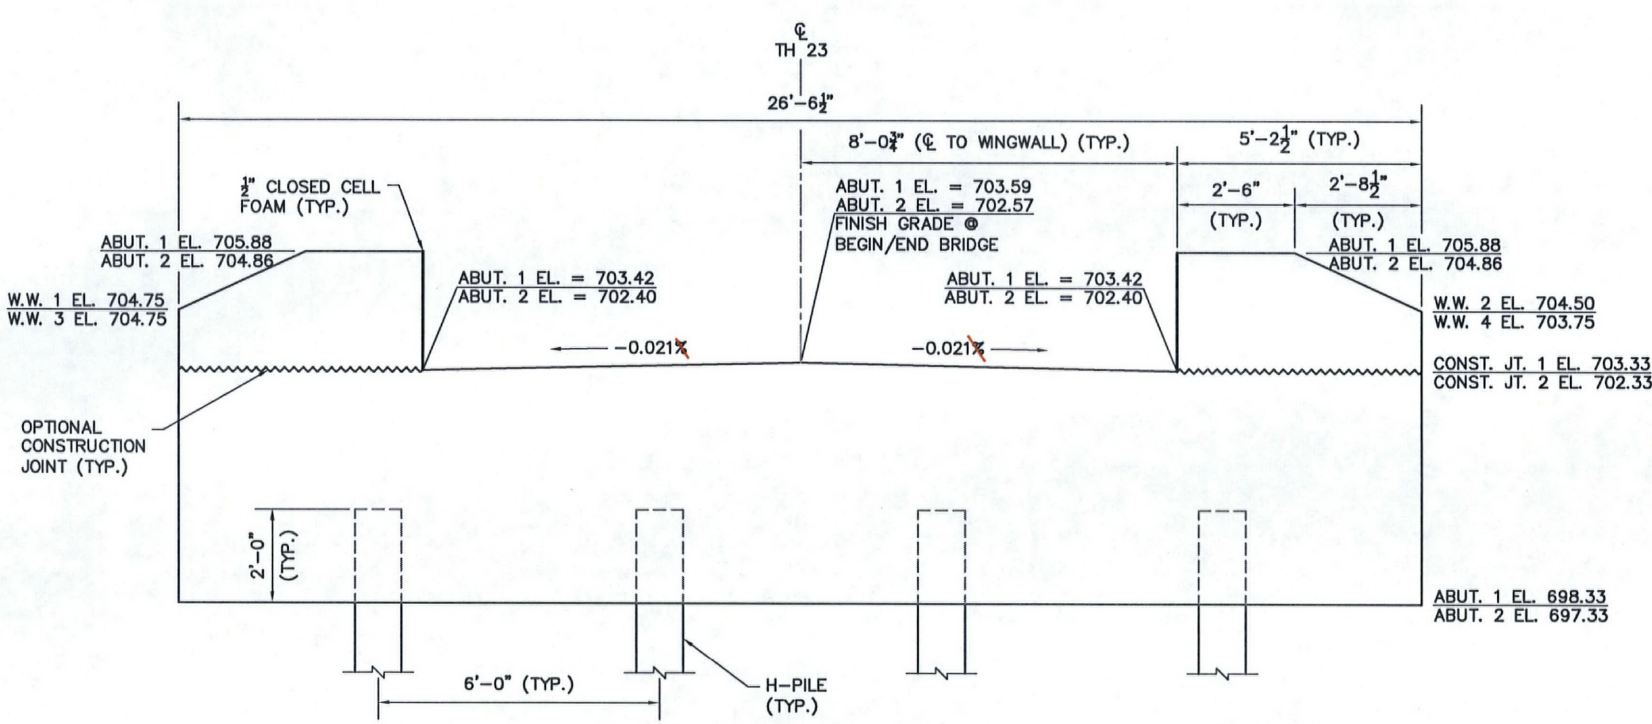


TYPICAL ABUTMENT ELEVATION

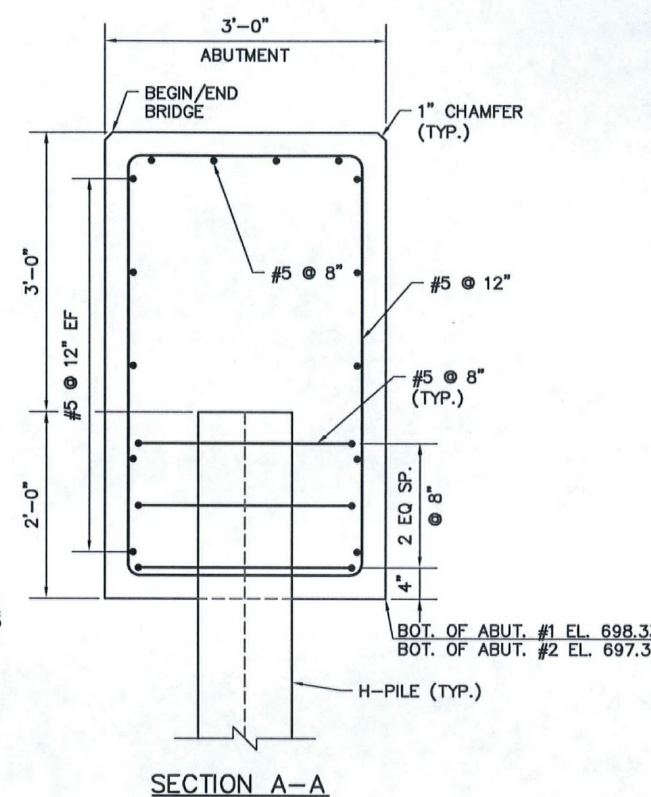

SECTION A-A

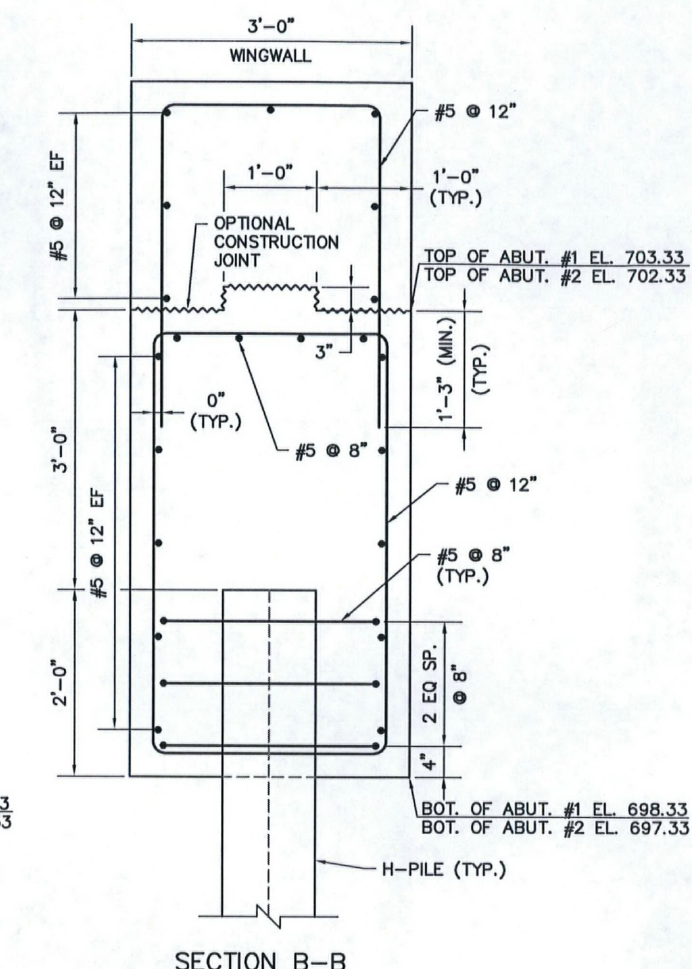

SECTION B-B

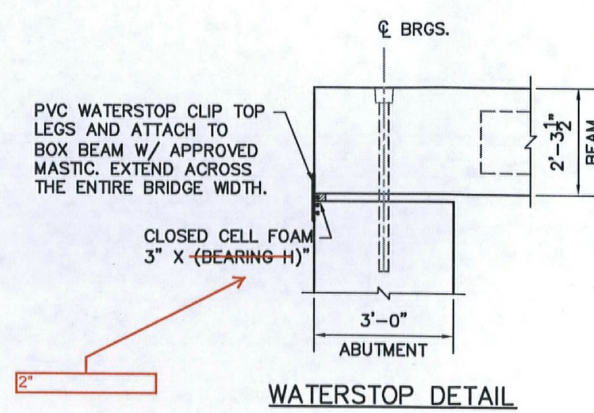

WATERSTOP DETAIL

Vermont Agency of Transportation  
**RECEIVED**  
 CK'D BY TCF OK'D BY KMH  
 10:04 am, Jul 8, 2010  
 RESUBMIT APPROVED AS NOTED  
 BY KMH DATE 7-12-10

NOTE:  
 1. LAP LENGTH FOR ALL #5 BARS SHALL BE 2'-2"  
 2. ALL CONCRETE SHALL BE HIGH PERFORMANCE CLASS B MEETING SECTION 501 OF THE STANDARD SPECIFICATIONS FOR CONSTRUCTION



State of Vermont  
PDD/Structures Design Section  
National Life Building – Drawer 33  
Montpelier, VT 05633-5001  
[www.aot.state.vt.us](http://www.aot.state.vt.us)

Agency of Transportation

[phone] 802-828-2621  
[fax] 802-828-3566  
[toll] 800-253-0191

Cosmec, Inc.  
1501 Rocky Ridge Road  
P.O. Box 2159  
Athens, Texas 75751

April 23, 2010

**Project Name: Braintree Project #: BRO 1444 (36)**


**Structure Identification: Bridge 12 over Ayers Brook**

The following Bridge Bearing fabrication drawings, for the above project (General Contractor – Renaud Bros., Inc.), have been reviewed and are being returned herewith.

**Bearing fabrication drawings are approved.**

You must provide notice to our fabrication inspector, Jeff Clark, as to the date fabrication represented by these drawings will begin. That notice must be received and acknowledged at least seven days prior to that date, as per Specification 506.03. Jeff may be contacted by phone at (802)828-0044 or email at [jeff.clark@state.vt.us](mailto:jeff.clark@state.vt.us). Any material fabricated prior to the notification date is subject to rejection without further cause.

Sincerely,

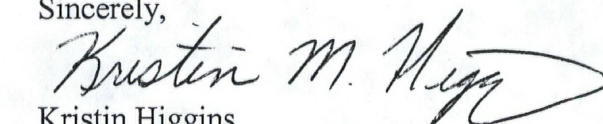
  
Kristin Higgins  
Structures Project Manager

Attachments


cc:  Resident Engineer w/prints – Jeremy Reed  
 Shop Inspector w/prints – Jeff Clark  
 Contractor w/prints – Renaud Bros., Inc.  
 Construction Division – letter only  
 Materials & Research Section (C&IA Unit) – letter only  
 Files




029 Bearings

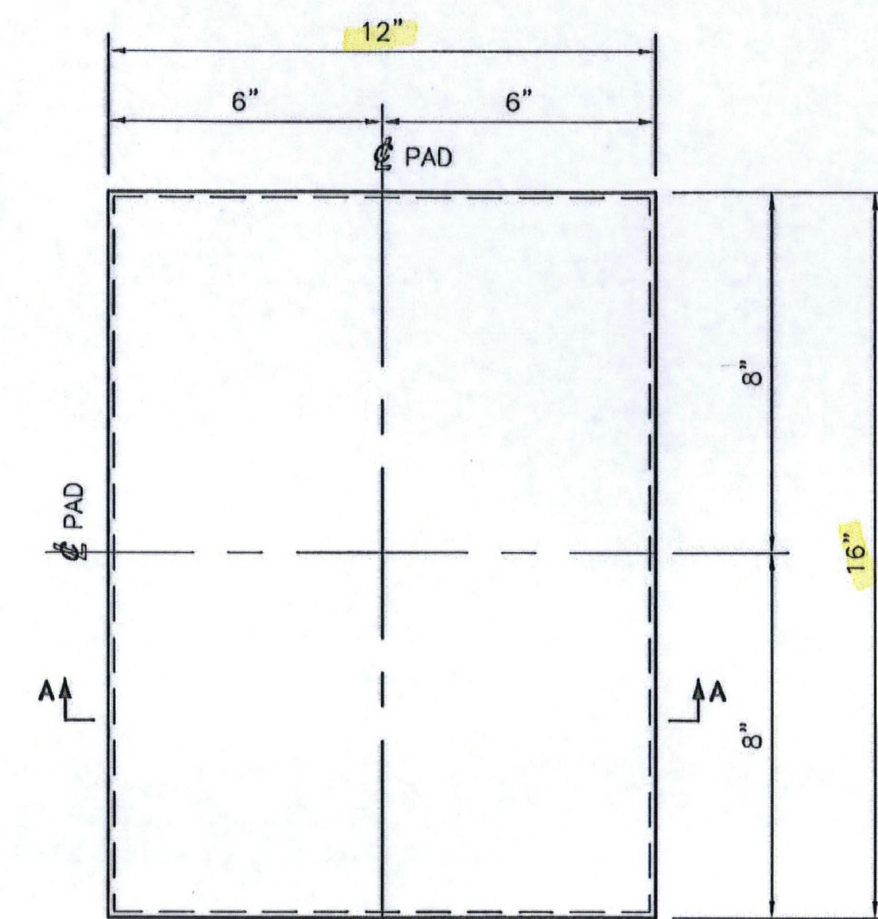

PLAN VIEW

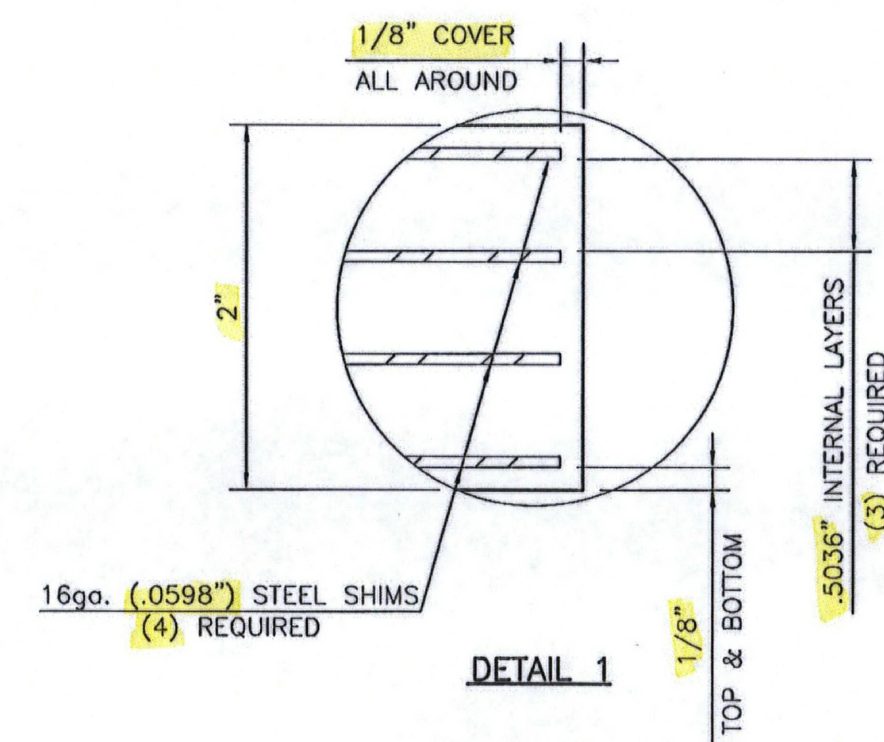

DETAIL 1

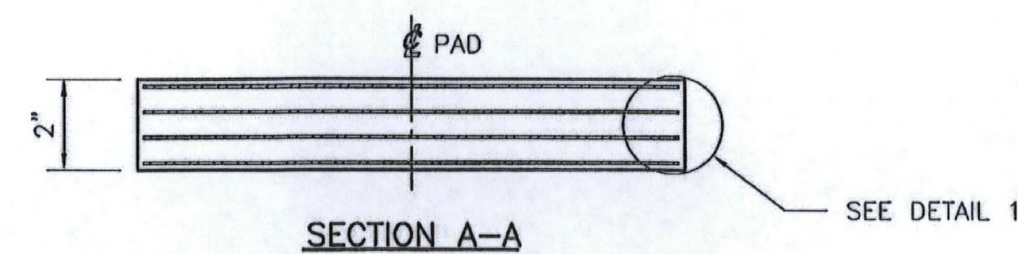

SECTION A-A

(16) LAMINATED ELASTOMERIC BEARING PADS  
LOCATE @ ABUTMENTS

SHOP NOTES:

1. BEARINGS SHALL CONFORM TO THE APPLICABLE SUBSECTIONS OF STANDARD SPECIFICATIONS SECTIONS 531 & 731.
2. ELASTOMER - 50 DUROMETER NATURAL RUBBER.
3. INTERNAL STEEL LAMINATES (SHIMS) SHALL BE AASHTO M270M/M270 GRADE 36.
4. ELASTOMER SHALL HAVE A SHEAR MODULUS OF 100 psi ± 15% AND MEET THE REQUIREMENTS OF LOW TEMPERATURE ZONE D, GRADE 4.

RECEIVED  
 CONTROL 7.7 CHECKED KMH  
 APR 16 2010  
 RESUBMIT  APPROVED   
 BY KMH DATE 4/23/10

LAMINATED ELASTOMERIC BEARING PADS		
STATE OF VERMONT		
AGENCY OF TRANSPORTATION		
TOWN OF BRAINTREE		
REPLACEMENT OF BRIDGE NO: 12		
STATE	COUNTY	CONTROL NO.
VT	CRANE	N/A
PROJECT NO.: BRO-1444 (36)		
DYNAMIC RUBBER; LAMINATED BEARING ASSEMBLIES		
<b>Cosma</b>		
1501 ROCKY RIDGE ROAD P.O. BOX 2159 ATHENS, TEXAS 75751		
SCALE: NONE	DRAWN BY: [blank]	CHECKED BY: [blank]
	DATE: 4/2/10	DATE: 4/12/10
SHEET 1 OF 1		JOB NO.: 10631

REV.	DESCRIPTION	BY	DATE	CHKD	DATE

D30 Bearing



State of Vermont  
PDD/Structures Design Section  
National Life Building - Drawer 33  
Montpelier, VT 05633-5001  
www.aot.state.vt.us

(phone) 802-828-2521  
(fax) 802-828-2566  
(toll) 800-253-0191

Agency of Transportation

July 22, 2010

Wm. E. Dailey Inc.  
Airport Rd  
Shaftsbury, VT 05262

Project Name: Braintree

Project #: BRO 1444 (36)

Structure Identification: Bridge #12 over Ayers Brook

The Prestressed Concrete Box Beam fabrication drawings [Item 510.21 Prestressed Concrete Box Beams] for the above project (General Contractor - Renaud Bros., Inc.) have been reviewed and are being returned herewith.

All sheets are approved or approved as noted.

You must provide notice to our fabrication inspector, Jim Wild, as to the date fabrication represented by these drawings will begin. Jim must receive and acknowledge your notice at least seven days prior to that date. You may contact Jim by phone at (802)828-6931 or email at [jim.wild@state.vt.us](mailto:jim.wild@state.vt.us). Any material fabricated prior to the notification date is subject to rejection without further cause.

Sincerely,




Kristin M. Higgins P.E.  
Project Manager

Attachments


cc:  Resident Engineer - Jeremy Reed w/prints  
 Shop Inspector - Jim Wild w/prints  
 Contractor - Renaud Bros., Inc. w/prints  
 Construction Division - letter only  
 Materials & Research Section (C&IA Unit) - letter only  
 Files (Structures & Central)



031 Bar Beam

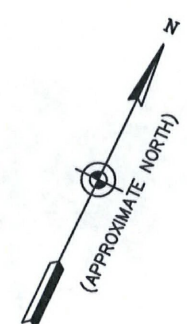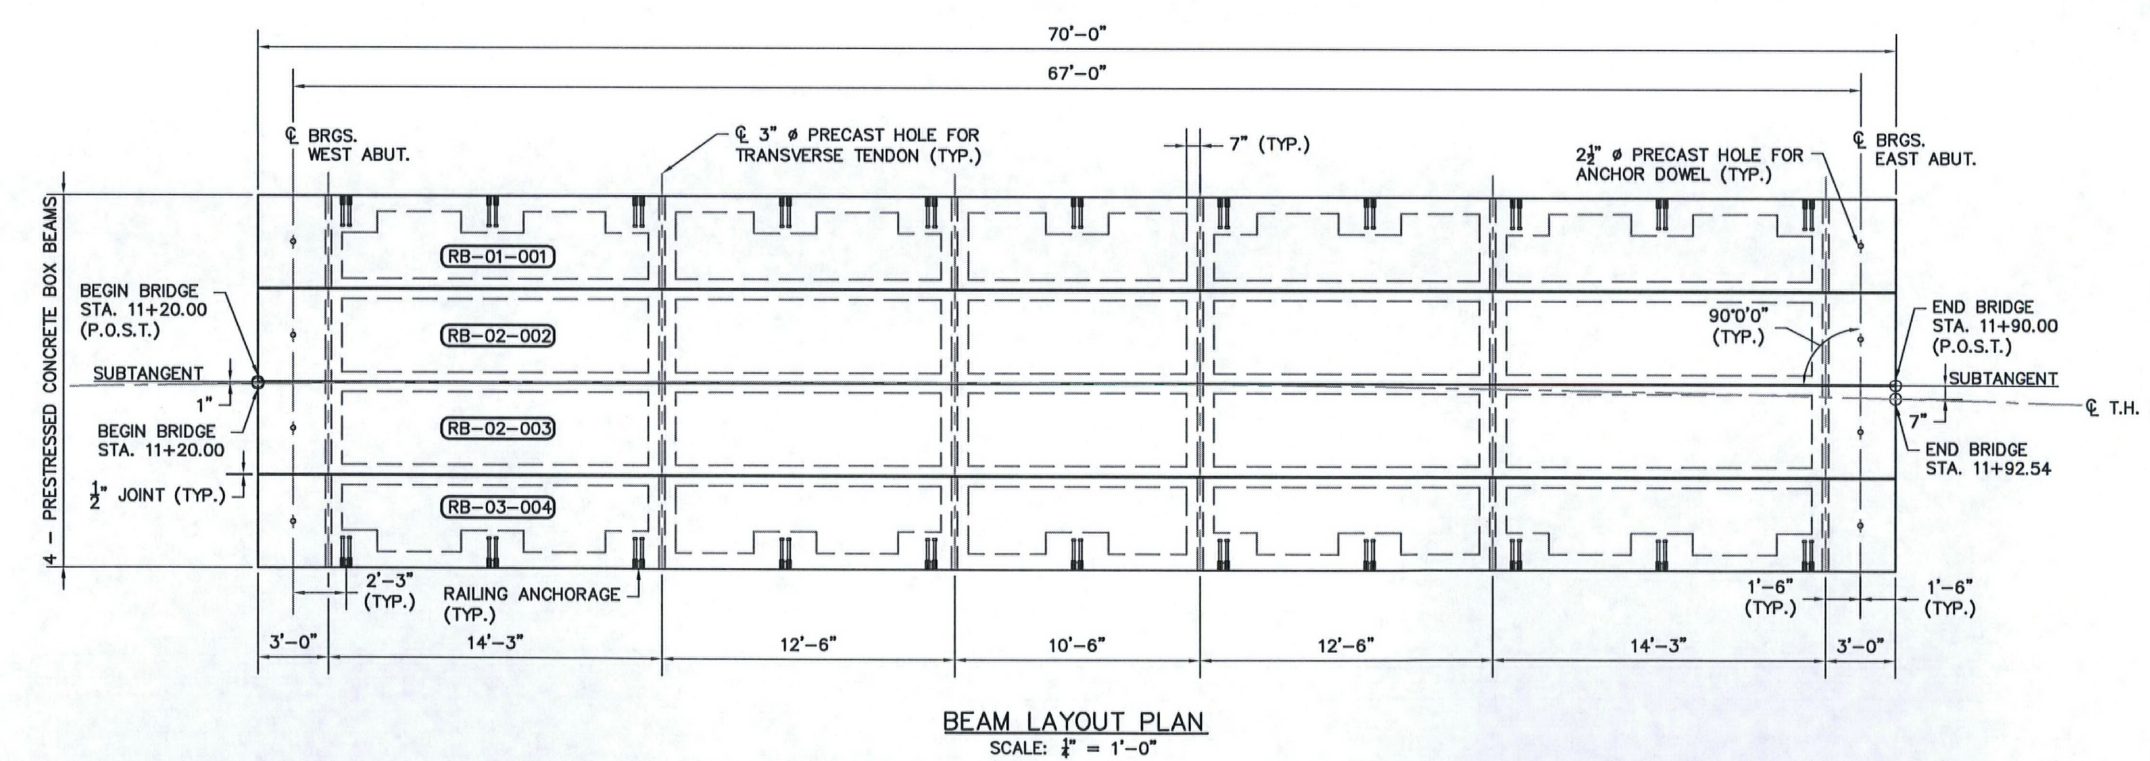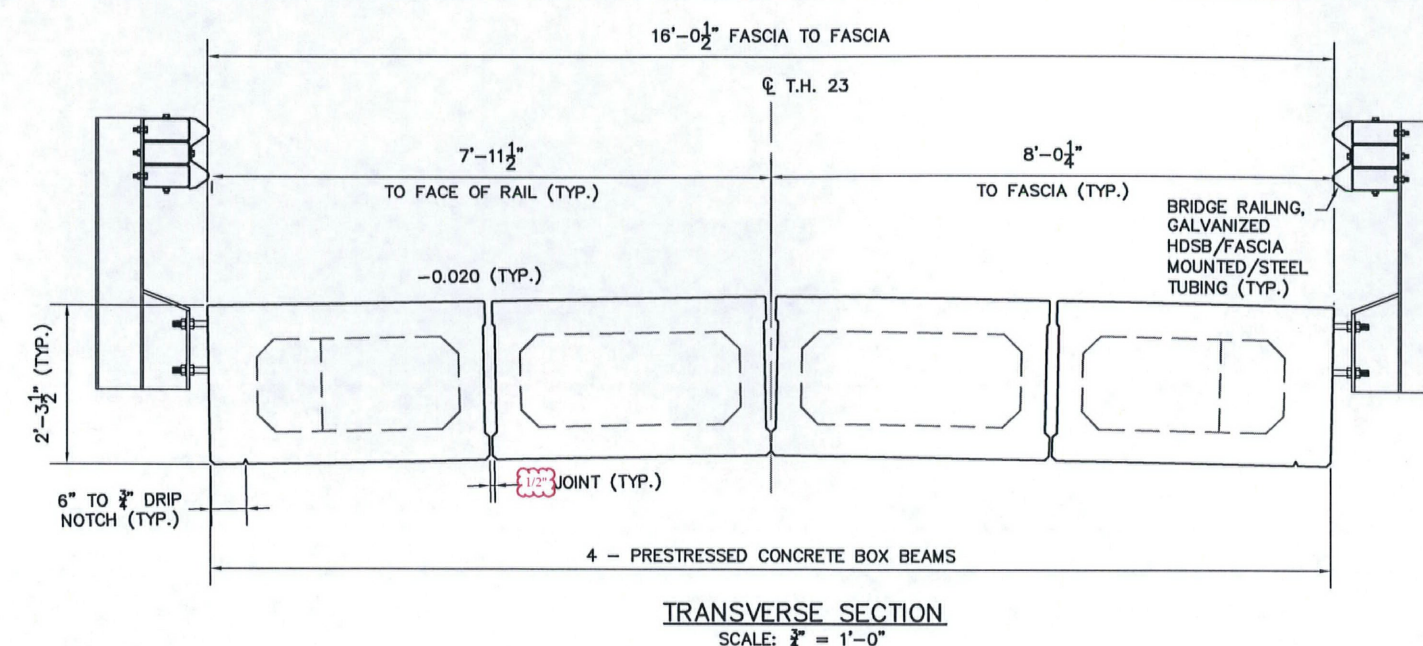


**Hoyle, Tanner & Associates, Inc.**  
125 College Street, 4th Floor, Burlington, VT 05401  
Tel: (802) 260-1331 Fax: (802) 260-4444 www.hoyletanner.com  
© Copyright 2010 Hoyle, Tanner & Associates, Inc.

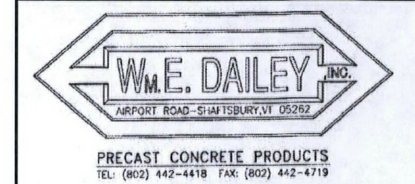


**BRAINTREE, VT**  
T.H. 23 CLASS III  
BRIDGE #12  
PROJECT NO: BRO 1444 (36)  
**SHEET 1 OF 5**

Vermont Agency of Transportation  
**RECEIVED**  
CHK'D BY: Timothy F. Baskin OK'D BY: [Signature]  
3:26 pm, Jul 21, 2010  
RESUBMIT BY: [Signature] APPROVED DATE: [Signature]

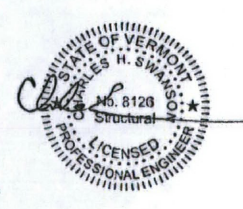

032 Pot Bean

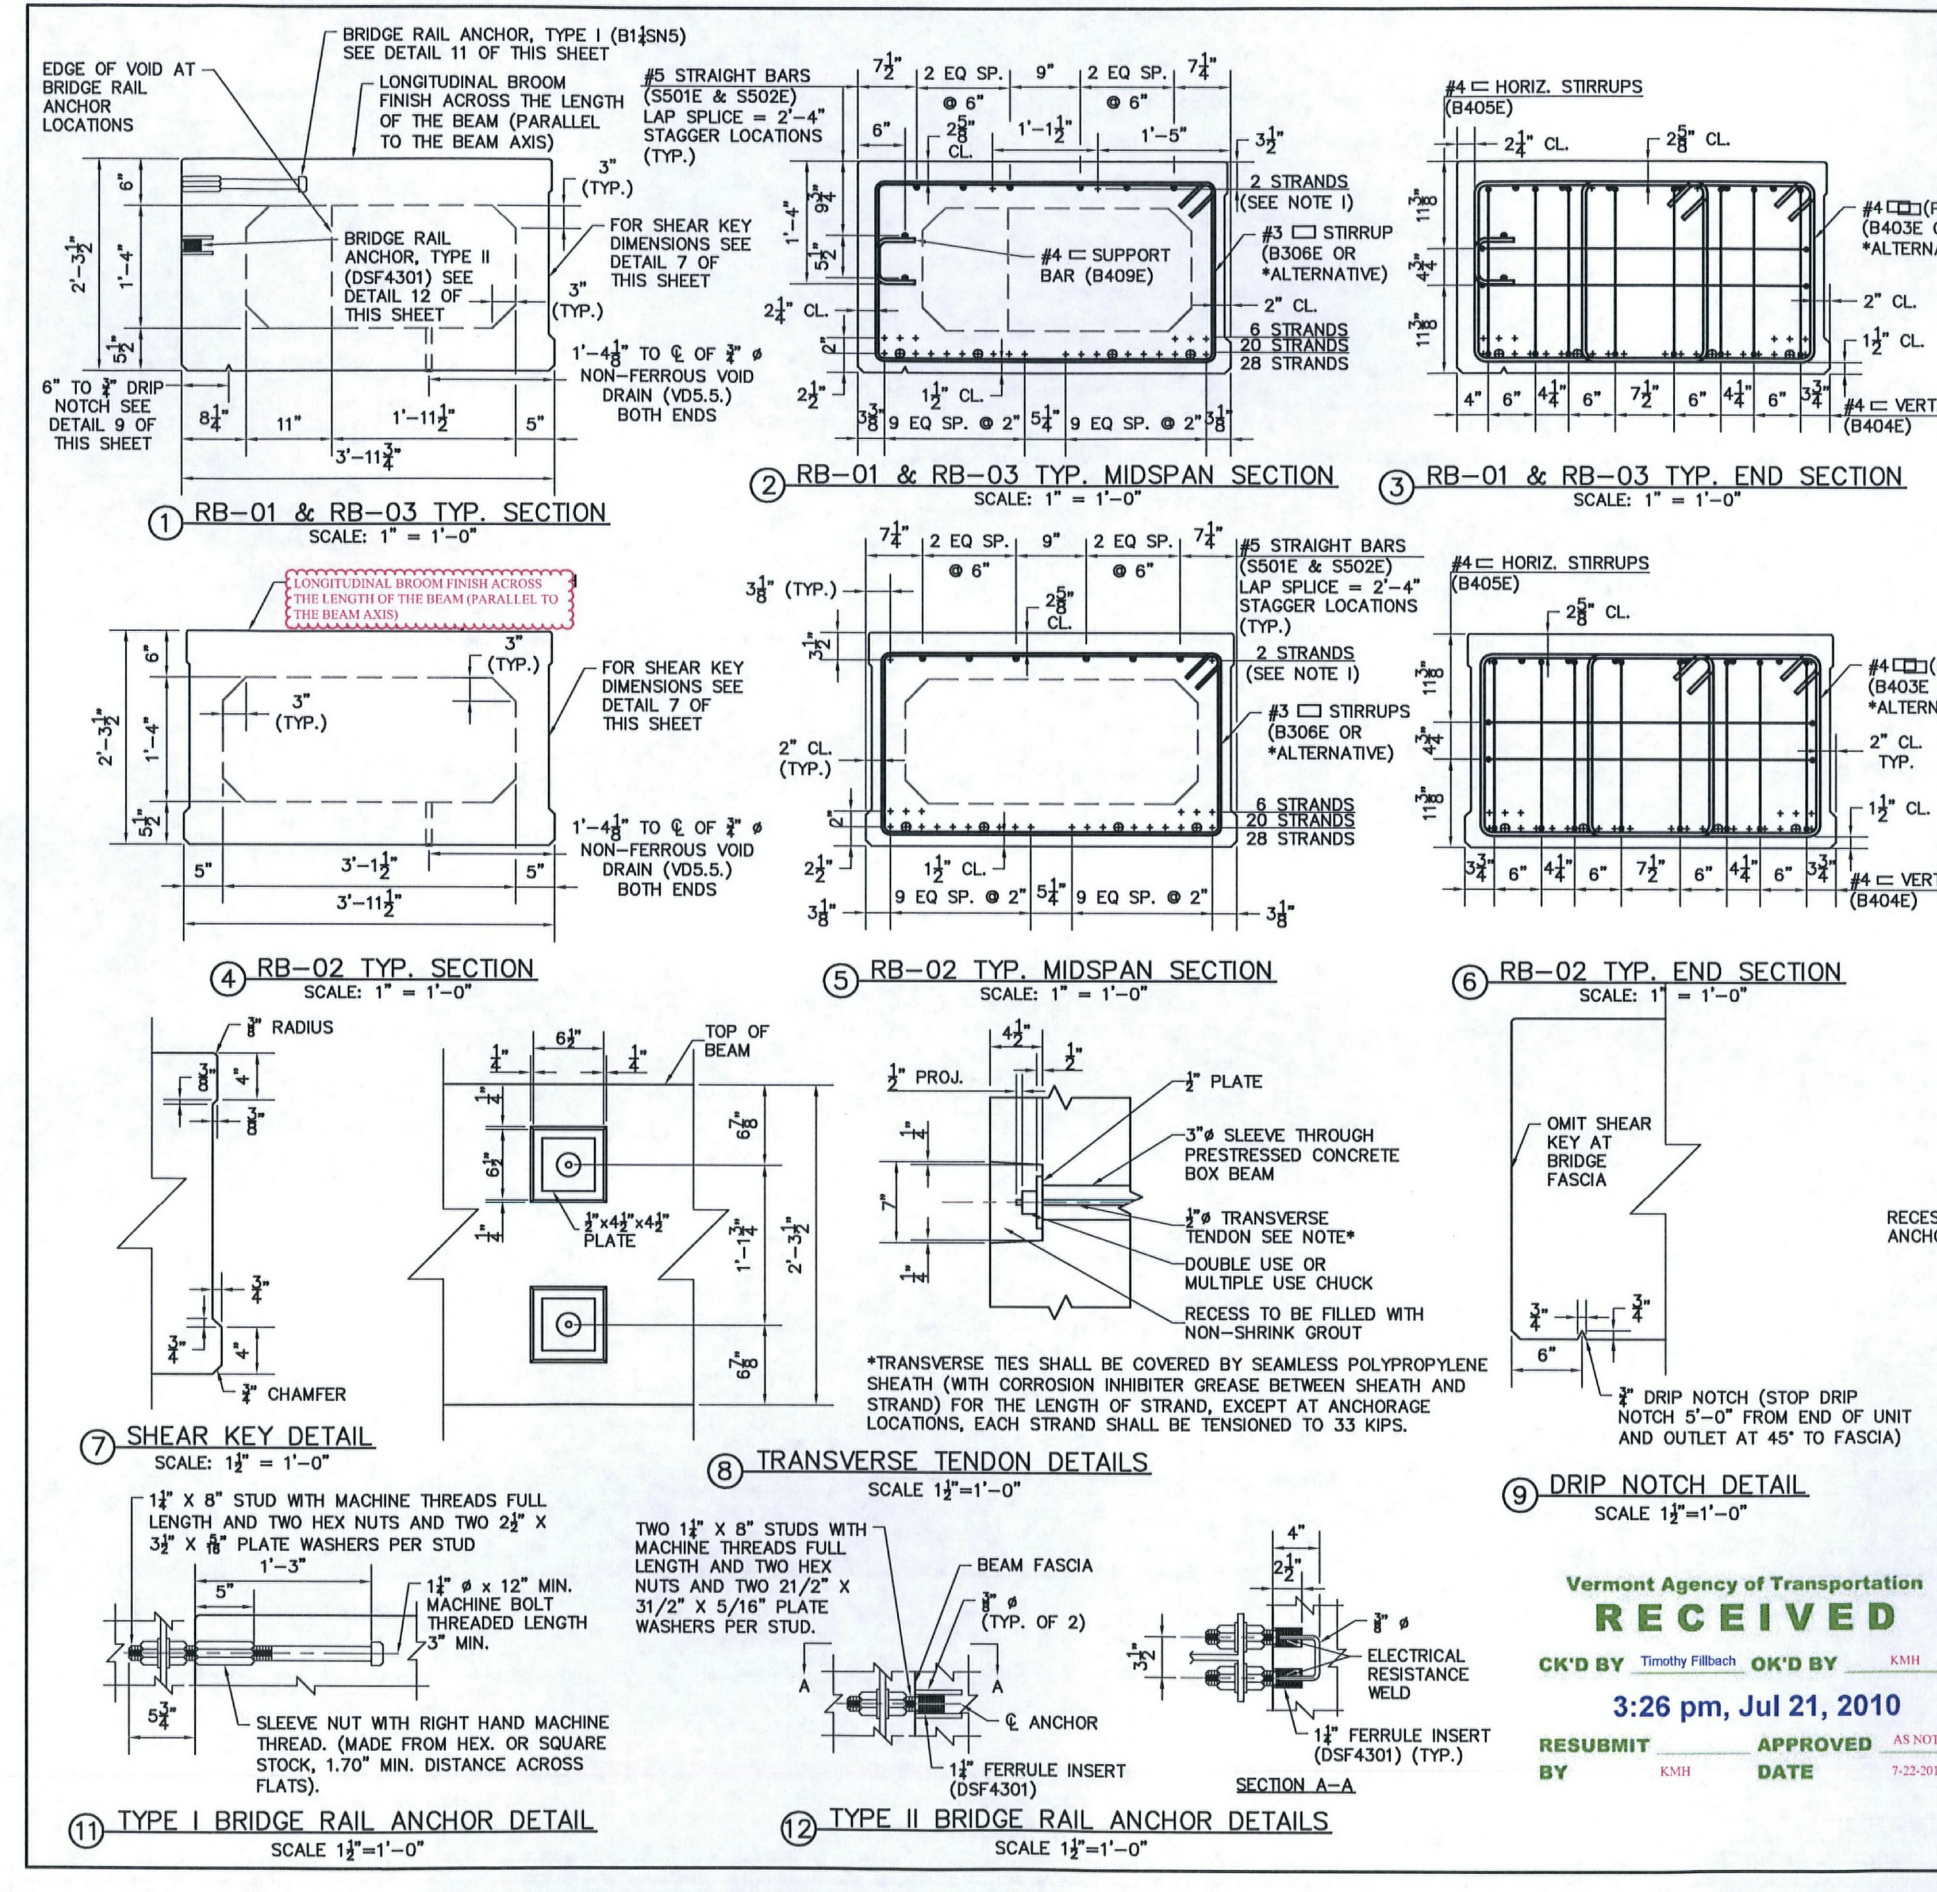

**NOTES:**

- (+) INDICATES 0.6" # LOW RELAXATION STRAIGHT STRAND. AASHTO M203. BOTTOM ROWS OF STRANDS INITIAL TENSION 44 KIPS. TOP ROWS OF STRANDS INITIAL TENSION 2 KIPS. 270 KSI MINIMUM ULTIMATE TENSILE STRENGTH.
- (@) INDICATES 0.6" # LOW RELAXATION DEBONDED STRAND AASHTO M203. DEBOND 6"-0" FROM END OF BEAM. INITIAL TENSION 44 KIPS. 270 KSI MINIMUM ULTIMATE TENSILE STRENGTH.
- CONCRETE COMPRESSIVE STRENGTH TESTED BY CYLINDER BREAK TEST.
- EACH STRAND SHALL BE FINALLY BURNED OR CUT OFF AT A DEPTH OF 3" INTO THE END OF THE BEAM AND THE RECESSED AREA AROUND THE STRAND SHALL BE FILLED WITH CONSPEC 100 NON-SHRINK, NON-METALLIC GROUT MANUFACTURED BY DAYTON SUPERIOR (THIS PRODUCT CAN BE FOUND ON THE PRE-APPROVED PRODUCTS LIST).
- OMIT SHEAR KEY ON EXPOSED EDGES.
- THE PRECASTER SHALL SANDBLAST SHEAR KEY FACES PRIOR TO DELIVERY.

**MATERIAL SPECIFICATION:**

CONCRETE MIX:  
28 DAY STRENGTH: 7000 PSI  
RELEASE STRENGTH: 5000 PSI  
STRAND: AASHTO M203  
MILD REINFORCING: ASTM A618M, GR 60  
EPOXY COATED

**FINISHES:**  
TOP: LONGITUDINAL BROOM FINISH  
SIDES: STEEL FORM  
BOTTOM: STEEL FORM  
ENDS: FORM (SEE NOTE 4)


**DUNNAGE:**  
STORAGE: BELOW LIFTING LOOPS  
SHIPPING: BELOW LIFTING LOOPS

**EXTERIOR BEAM:**  
TOTAL HEIGHT: 70.149 LBS  
CONC. YARDAGE: 17.32 CY

**INTERIOR BEAM:**  
TOTAL HEIGHT: 63.215 LBS  
CONC. YARDAGE: 15.61 CY

**PARTS & PART NUMBERS**

	B402E		B402L
	S502E		S402E
	B403E		B403L
	B404E		B404L
	B405E		B405L
	B406E		B406L
	B407E		B407L
	B408E		B408L
	B409E		B409L
	B410E		B410L
	B411E		B411L
	B412E		B412L
	B413E		B413L
	B414E		B414L
	B415E		B415L
	B416E		B416L
	B417E		B417L
	B418E		B418L
	B419E		B419L
	B420E		B420L

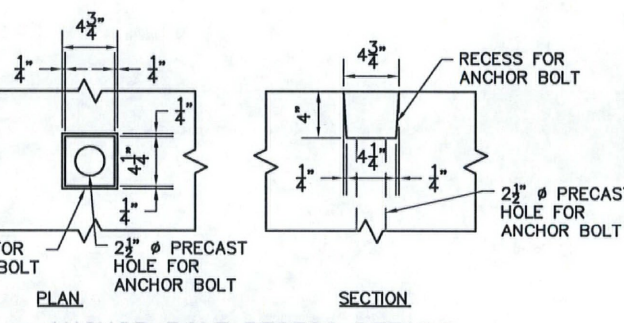

Vermont Agency of Transportation  
**RECEIVED**  
CK'D BY: *Timothy F. Beck* OK'D BY: *KMM*  
3:26 pm, Jul 21, 2010  
RESUBMIT APPROVED 43-00102  
BY: *KMM* DATE: 7-23-2010

**W.M. DAILEY**  
PRECAST CONCRETE PRODUCTS  
125 Gage Street, 4th Floor, Burlington, VT 05401  
Tel: (802) 261-1331 Fax: (802) 261-4499 www.wmdayle.com  
© Copyright 2010 Hoyle, Tanner & Associates, Inc.

**BRAINTREE, VT**  
T.H. 23 CLASS II  
BRIDGE #12  
PROJECT NO: BRO 1444 (36)  
SHEET 2 OF 5

*033 Bar Beck*



**GENERAL NOTES:**

- SEE DRAWINGS 1, 2, & 3 FOR PLANS AND DETAILS.
- ALL BEAMS ARE LABELED AS FOLLOWS:  
PRODUCT TYPE-IDENTIFICATION NUMBER-SEQUENCE NUMBER
- MARK BEAMS RB-01 & RB-02 ENDS "EAST END" FOLLOWED BY THE CORRESPONDING BEAM LABEL.
- MARK BEAM RB-03 END "WEST END" FOLLOWED BY THE CORRESPONDING BEAM LABEL.
- THE BAR QUANTITIES LISTED ARE FOR THE SELECTED SOLID HOOP STRIPUP CONFIGURATION. IF IT IS DECIDED TO USE THE BAR ALTERNATIVES OF 2 INTERLOCKING "U" BARS THAN THE BAR QUANTITIES FOR THOSE BARS WILL NEED TO BE DOUBLED. SEE SHEET 2 OF 4 FOR BAR CONFIGURATIONS.

Vermont Agency of Transportation

**RECEIVED**

CK'D BY: Timothy F. Bouché, OK'D BY: KSHH

3:26 pm, Jul 21, 2010


RESUBMIT: KSHH, APPROVED: KSHH

BY: KSHH, DATE: 7/23/2010

PART NO.	DESCRIPTION	QTY.
<b>RB-01 &amp; RB-03 BEAMS</b>		
B400E	#4 BENT	16
S501E	#5 STRAIGHT	8
S502E	#5 STRAIGHT	8
B403E	#4 BENT	12
B404E	#4 BENT	16
B405E	#4 BENT	4
B309E	#3 BENT	80
B407E	#4 BENT	50
S408E	#4 STRAIGHT	30
B409E	#4 BENT	30
<b>RB-02 BEAM</b>		
B400E	#4 BENT	16
S501E	#5 STRAIGHT	8
S502E	#5 STRAIGHT	8
B403E	#4 BENT	12
B404E	#4 BENT	16
B405E	#4 BENT	4
B309E	#3 BENT	80
B407E	#4 BENT	70
S408E	#4 STRAIGHT	30


VDS.5	2" # VOID DRAIN 5" LONG	10
LH301G	LIFT HOOP (3) 2" STRANDS	4
V16A	16" VOID, 13"-1" LONG	2
V16B	16" VOID, 11"-4" LONG	2
V16C	16" VOID, 9"-4" LONG	1
D24301	1/4" FERRULE INSERT	22
B16NS	1/2" DIA. 1'-0" LONG, WITH 3" SLEEVE NUT	22
VERMONT STATE MIX DESIGN		

<b>RB-02 BEAM</b>		
VDS.5	2" # VOID DRAIN 5" LONG	10
LH301G	LIFT HOOP (3) 2" STRANDS	4
V16X37A	16"X37" VOID, 13"-1" LONG	2
V16X37B	16"X37" VOID, 11"-4" LONG	2
V16X37C	16"X37" VOID, 9"-4" LONG	1
VERMONT STATE MIX DESIGN		

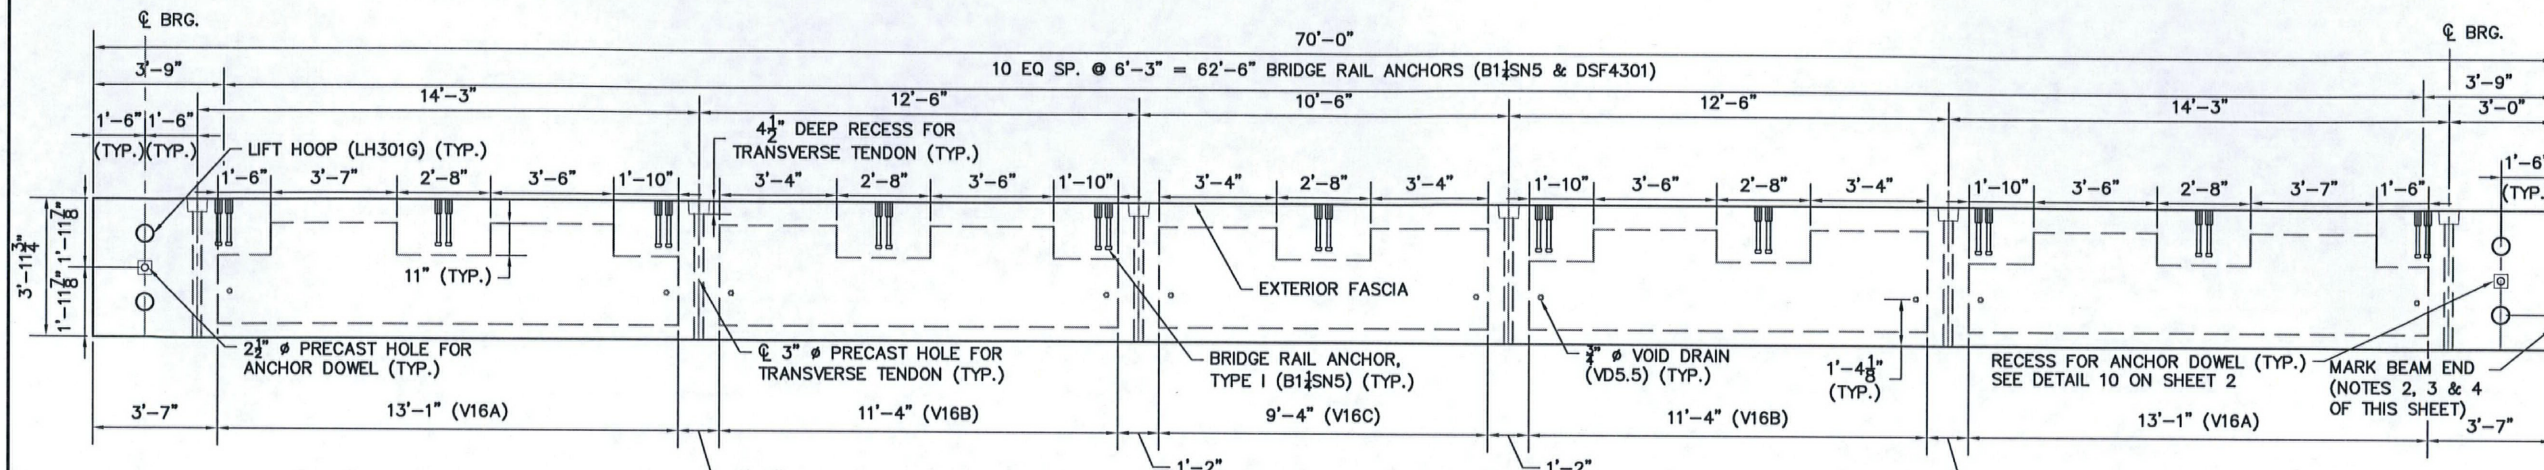


1 RB-01 & RB-03 BEAM PLANS

SCALE: 1/2" = 1'-0"

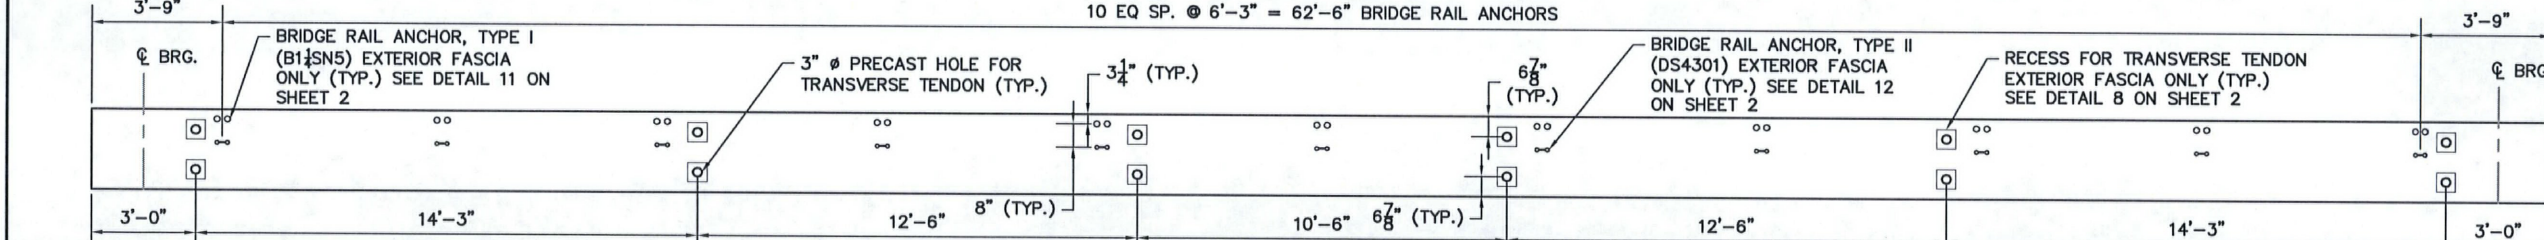


2 RB-01 & RB-03 BEAM ELEVATION

SCALE: 1/2" = 1'-0"

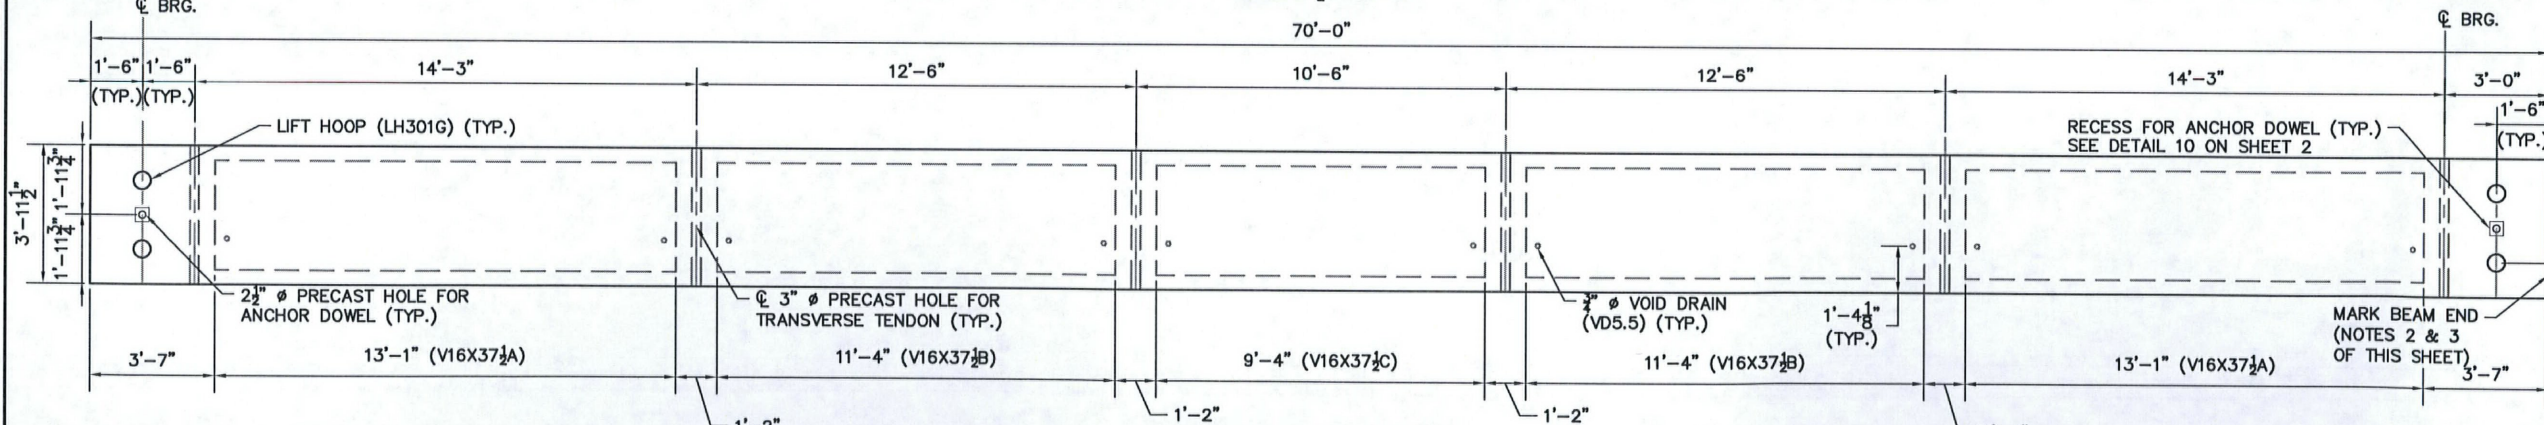

3 RB-02 BEAM PLAN

SCALE: 1/2" = 1'-0"

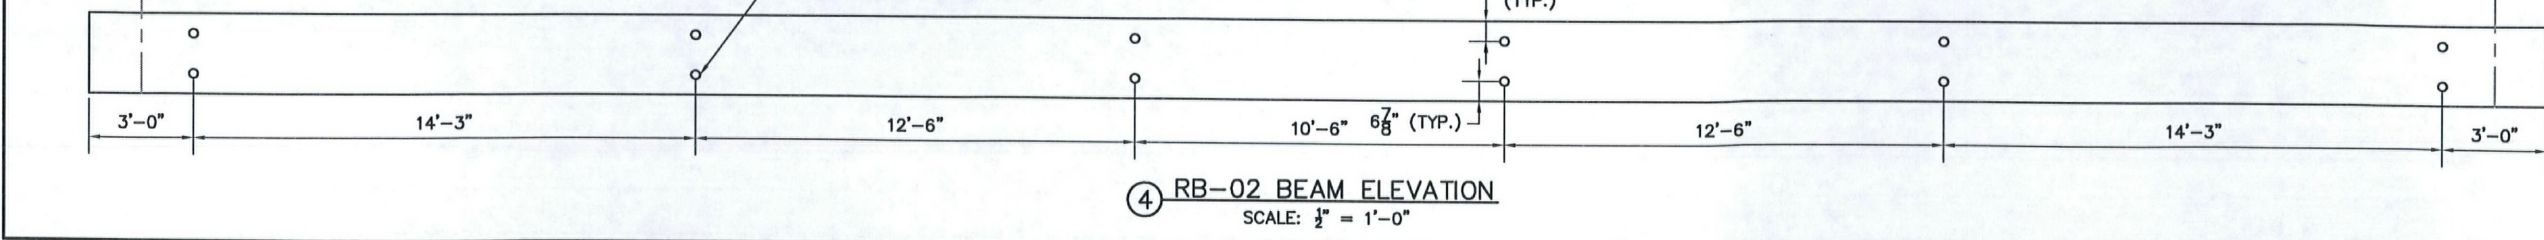


4 RB-02 BEAM ELEVATION

SCALE: 1/2" = 1'-0"

**Hoyle, Tanner & Associates, Inc.**

125 College Street, 4th Floor, Burlington, VT 05401  
Tel: (802) 251-1351 Fax: (802) 251-4491 www.hoyletanner.com  
© Copyright 2010 Hoyle, Tanner & Associates, Inc.

DATE: 7/23/2010 TIME: 3:26 PM  
PROJECT NO.: BRD 1444 (36)

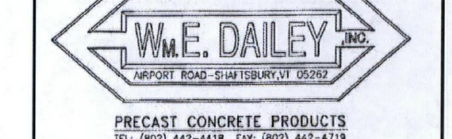

**BRAINTREE, VT**

T.M. 23 CLASS III  
BRIDGE #12

PROJECT NO.: BRD 1444 (36)

SHEET 4 OF 5

035 Bar Beam

### 1. CONCRETE MIX DESIGN

#### MIX COMPONENTS

PRODUCT DESCRIPTION	LSB PER CY	DENSITY	
CEMENT	757	3.15	
POZZOLAN	CLASS F FLY ASH	134	2.3
SAND	WE DALEY NATURAL	1239	2.7
STONE	WE DALEY #87	1470	2.73
WATER	DALEY WELL	242	1
HIGH-RANGE WATER-REDUCING ADMIXTURE	GLENUM 3400	91	
AIR-ENTRAINING ADMIXTURE	WB-4500	8	
CORROSION-INHIBITING ADMIXTURE	RECRETE CNI	704	
DESIGN AIR			

#### VARIOUS PROPERTIES

UNIT WEIGHT: 144 LB/CF  
WATER/CEMENT RATIO: 0.32  
AIR SPEC: 1.5%  
SLUMP/SPREAD: NOT MORE THAN 29"

#### ADDMIXTURE NOTE:

THE AMOUNT AND TYPE OF WATER REDUCING ADMIXTURES MAY VARY SLIGHTLY FROM DAY TO DAY DEPENDING ON ALLOWABLE VARIATIONS IN RAW MATERIALS (E.G., MOISTURE CONTENT, TEMPERATURE, GRADATIONS, ETC.) VARIATIONS IN ADMIXTURES ARE MADE TO MAINTAIN A FAVORABLE WATER/CEMENT RATIO WHILE MAINTAINING A WORKABLE MIXTURE. THEREFORE, WHEN THERE IS AN INCREASE IN THE HIGH RANGE WATER REDUCER, THERE IS A CORRESPONDING DECREASE IN THE AMOUNT OF WATER REQUIRED. THIS IN TURN INCREASES SLIGHTLY THE AMOUNT OF SAND AND STONE REQUIRED TO MAINTAIN A 1.0 CUBIC YARD YIELD.

#### GENERAL NOTE:

MODIFICATIONS OR DEVIATIONS FROM THE ORIGINAL MIX AT ANY TIME AFTER THE SHOP DRAWINGS HAVE BEEN APPROVED WILL BE SUBJECT TO THE ACCEPTANCE OF THE ENGINEER.

### 2. CURING METHOD

UNDER SECTION 310-10 CURING OF PRESTRESSED CONCRETE THE CURING BY METHOD OF RADIANT HEAT IS CITED. WITH CONTROLLED ENVIRONMENT AT DALEY PRECAST, INC. WITH BURLAP AND BLANKETS ENCAPSULATION THE BRIDGE BEAM, THE BEAM ITSELF IS A SOURCE OF RADIANT HEAT FOR ITSELF.

DALEY PRECAST, INC. REQUESTS THAT THE RADIANT HEAT OF THE BEAM IS COVERED BY WET BURLAP AND BLANKETS BE CONSIDERED AN ACCEPTABLE METHOD OF CURING.

### 3. GROUTING PROCEDURES

#### GROUTING OF SHEAR KEYS:

- CLEAN JOINTS WITH AN OIL FREE AIR-BLAST IMMEDIATELY BEFORE GROUT PLACEMENT. VERIFY THAT THE BACKER ROD IS STILL IN PLACE.
- FOLLOW MANUFACTURER'S RECOMMENDATIONS FOR ADDITIONAL JOINT PREPARATION AND GROUT PLACEMENT.

#### GROUTING OF POST-TENSION TRANSVERSE TENDONS:

- GROUT SHALL ATTAIN A MINIMUM COMPRESSIVE STRENGTH OF 1500 PSI, BASED ON THE MANUFACTURER'S RECOMMENDATIONS. PRIOR TO STRESSING, THE GROUT NEED NOT BE CURED FOR THREE DAYS PRIOR TO THE COMMENCING OF POST-TENSIONING.
- PROVIDE APPROPRIATE CURB MOLDS AS DESCRIBED IN A84810 FOR 3 SETS OF 3 DAY CUBES, 3 SETS OF 28 DAY CUBES AND AT A MINIMUM OF 3 MORE CUBES TO TEST FOR THE 1500 PSI MINIMUM COMPRESSIVE STRENGTH.

#### GROUTING OF END DETAILS:

- GROUT ANCHOR BOLTS INTO THE SLEEVES IN THE PRESTRESSED UNITS AT THE FIXED ENDS. BEFORE THE GROUT CURES, PLACE THE WASHER PLATE, AND INSTALL THE NUT ON TOP AND TIGHTEN.
- PLACE THE COLD POURED JOINT SEALER IN THE SLEEVES IN THE PRESTRESSED UNITS AS THE EXPANSION ENDS. PLACE THE WASHER PLATE AND INSTALL THE NUT ON TOP. HAND TIGHTEN AND THEN LOOSEN 1/2 TURN.
- GROUT OVER THE NUT AND BOLT IN THE ANCHOR BOLT BLOCK OUTS ON THE FIXED ENDS. FILL THE ANCHOR BOLT BLOCK OUTS ON THE EXPANSION ENDS WITH COLD POURED JOINT SEALER.

### 4. TRANSPORTATION, HANDLING, AND STORAGE DETAILS

- DEFECTS, WHICH THE SAFETY OF EMPLOYEES AND THE PROTECTIVE CARE OF THE PRODUCT BEING HANDLED, ARE THE CRITICAL FACTORS EACH TIME ANY PRODUCT IS MOVED.
- THE RECOMMENDED METHOD FOR ANY HANDLING IS TO USE EMBEDDED LIFTING DEVICES WHENEVER POSSIBLE.
- SPECIAL CARE SHOULD BE TAKEN WHEN FORKTRUCK EQUIPMENT IS USED TO PREVENT DAMAGE BY THE FORKS. LIFTING FORKS SHALL HAVE RUBBER PADS OR LIAN TO PROTECT THE CONCRETE FROM DAMAGE.
- TRUCKS AND OTHER CONVEYANCES USED TO TRANSPORT PRECAST CONCRETE PRODUCTS FROM THE PLANT TO THE ERECTION SITE SHALL BE EQUIPPED AND MAINTAINED TO DELIVER THE PRODUCTS WITHOUT DAMAGE.
- SOME FORM OF PADDING FOR TIE-DOWN SHALL BE USED TO PROTECT THE EDGE OF THE PRODUCT.
- SHIPPING RECORDS SHALL BE KEPT OF ALL PRODUCTS AND ACCESSORIES. TRANSPORTATION DAMAGE SHOULD BE RECORDED ON THE SHIPPING RECORDS. SHIPPING MANAGER OR QUALITY ASSURANCE IS TO PREPARE A CERTIFICATION AND AUTHORIZING OF EACH SHIPMENT.

### 5. INSTALLATION PROCEDURE

#### 1. LAY OUT WORKING LINES:

- LAY OUT WORKING LINES FOR THE ENTIRE BRIDGE WIDTH ON THE BEAM SEAT.
- MEASURE ALL WORKING LINES FROM A COMMON WORKING POINT.
- BASE THE WORKING LINES ON THE NOMINAL BEAM WIDTHS.

#### 2. VERIFY BEAM SEAT ELEVATIONS:

- MEASURE ELEVATIONS AT BEAM SEATS.
- IF SEATS ARE HIGH OR LOW, TAKE CORRECTIVE ACTION.
- INSTALL BEARINGS.

#### 3. ERECT BEAMS:

- PLACE BEAMS TO FIT WITHIN THE WORKING LINES.
- AS WORK PROGRESSES, INSTALL HARDWOOD WEDGES BETWEEN ADJACENT BEAMS TO MAINTAIN PROPER JOINT OPENING (A MINIMUM OF ONE WEDGE AT EACH TRANSVERSE TENDON).
- DRILL ANCHOR BOLT HOLES.
- PLACE ANCHOR BOLTS.

#### 4. INSTALL BACKER ROD: PLACE FILLER BELOW THE KEYWAY BOTTOM.

#### 5. INSTALL TRANSVERSE TENDONS:

- FEED TENDONS THROUGH DUCTS.
- VERIFY THAT HARDWOOD WEDGES ARE IN PLACE AS REQUIRED TO PREVENT SLIPPAGE OF BEAMS.
- TRANSVERSE TENDONS SHALL BE COVERED BY SEAMLESS POLYPROPYLENE SHEATH WITH CORROSION INHIBITOR GREASE BETWEEN SHEATH AND STRAND FOR THE LENGTH OF THE STRAND, EXCEPT AT ANCHORAGE LOCATIONS.

#### 6. GROUT SHEAR KEYS:

- REFERENCE ITEM 3. GROUTING PROCEDURES.
- AFTER GROUTING, CAREFULLY ROD JOINTS TO ELIMINATE ANY POSSIBILITY OF VOIDS.

#### 7. POST-TENSION TRANSVERSE TENDONS:

- REFERENCE ITEM 3. GROUTING PROCEDURES.
- AFTER GROUTING, POST-TENSION TENDONS TO 30 KIPS USING A CALIBRATED JACK OPERATED BY QUALIFIED PERSONNEL.

#### 8. GROUT END DETAILS:

- REFERENCE ITEM 3. GROUTING PROCEDURES.

#### 9. FINISH WORK: REMOVE WEDGES AND PATCH SURFACE AND FASCIA BEAMS AT TRANSVERSE TENDONS.

### 6. QUALITY CONTROL PROCEDURES

#### QUALITY ASSURANCE

- WM. E. DALEY PRECAST LLC HAS AN ENTIRE DEPARTMENT DEVOTED TO QUALITY CONTROL. THE QUALITY ASSURANCE DEPARTMENT MONITORS, TESTS, AND INSPECTS ALL PRODUCTION IN THE PLANT AND REPORTS DIRECTLY TO THE PLANT MANAGER. IT IS THE POLICY OF THE QUALITY CONTROL DEPARTMENT TO FOLLOW ALL PCI STANDARDS AND TEST PROCEDURES AND ALL APPLICABLE ACI AND ASTM STANDARDS.
- WM. E. DALEY PRECAST LLC EMPLOYS A QUALITY ASSURANCE INSPECTOR TO MAINTAIN DAILY OVERVIEW AND INSPECTION OF ALL PRODUCTION. RESPONSIBILITIES INCLUDE THE FOLLOWING:

PLANT TESTING OF MATERIALS	POSTPOUR INSPECTION
MIX DESIGN	OVERALL DIMENSIONS
PRE-POUR INSPECTION	INSERT TYPE AND LOCATION
GENERAL CONDITION OF MOLD, CHAMBERS	VOIDS
DIMENSIONAL VERIFICATION	CONCRETE TESTING
SIZE, POSITION OF STRANDS	SURFACE FINISHES, APPEARANCE
SIZE, POSITION OF REINFORCING STEEL	CRACKS, DAMAGE
POSITION OF INSERTS	IDENTIFICATION OF PIECE
SIZE, POSITION OF VOIDS, BLOCKOUTS, ETC.	HANDLING AND STORAGE
POSITION OF INTEGRAL ITEMS AND ACCESSORIES	PRE-SHIP INSPECTION
INSPECTION OF BATCHING, MIXING AND CONVEYING CONCRETE	
PLACEMENT AND CONSOLIDATION OF CONCRETE	
FINISHING OF CONCRETE	
INTEGRAL ITEMS, ACCESSORIES, PLATES, LIFTERS	

#### ACCEPTANCE TESTING

WM. E. DALEY PRECAST LLC EMPLOYS ACI CERTIFIED CONCRETE TESTERS TO MONITOR AND TEST CONCRETE DELIVERIES. THE CONCRETE TESTER AND THE INSPECTOR CHECK ALL MATERIAL CERTIFICATES FOR CONTRACT COMPLIANCE AND CONFORMANCE TO STANDARDS.

#### SAMPLING OF CONCRETE FOR COMPRESSIVE STRENGTH


- ONCE ALL INGREDIENTS ARE BATCHED AND MIXED FOR A MINIMUM OF 90 SECONDS, THE CONCRETE SHALL BE PLACED INTO A 4 CUBIC YARD BUCKET FOR PLACEMENT INTO FORM. PRIOR TO DELIVERING TO FORM, A SAMPLE OF CONCRETE SHALL BE OBTAINED BY AN ACI GRADE 1 FIELD TECHNICIAN.
- ONCE SAMPLE IS OBTAINED TESTING FOR TEMPERATURE (ASTM C1064), AIR CONTENT (ASTM C231), SLUMP/SPREAD (ASTM C143) AS WELL AS UNIT WEIGHT (ASTM 138) SHALL BEGON.
- ONCE ALL TESTING HAS BEEN COMPLETED CONCRETE CYLINDERS SHALL BE CAST WITH SAME CONCRETE AS ABOVE TESTS AS THE CYLINDERS ARE BEING CAST. FORK TRUCK DRIVER SHALL BE INFORMED BY FIELD TECHNICIAN THAT THE CONCRETE HAS EITHER PASSED OR FAILED. IF PASSED FORK TRUCK DRIVER SHALL DELIVER TO THE BED, IF FAILED CONCRETE SHALL BE REJECTED AND DEPOSITED ELSEWHERE.

### 7. CAMBER

DALEY PRECAST, INC. TAKES PRIDE IN ABILITY AND DUE DILIGENCE IN PROVIDING QUALITY PRODUCTS WITH CONSISTENT CAMBER THAT ARE WELL WITHIN THE RANGE OF PCI TOLERANCES. THAT BEING SAID, CAMBER WILL BE CHECKED. IF NEEDED, AN ARRAY OF WEIGHTS WILL BE ON SITE TO ENSURE THAT ALL BEAMS ARE AT THE SAME CAMBER PRIOR TO THE GROUT AND POST-TENSIONING PROCESSES.

### 8. TRANSFER OF PRESTRESSING FORCE PROCEDURE

DE-TENSIONING THE STRANDS WILL BE PERFORMED WITH TWO SETS OF OXYGEN ACETYLENE TORCHES SIMULTANEOUSLY AT THE LOCATIONS SHOWN BELOW, DEPENDING ON NUMBER OF BEAMS CAST, THE STRANDS WILL BE CUT SYMMETRICALLY AROUND THE VERTICAL CENTERLINE OF THE STRAND PATTERN.

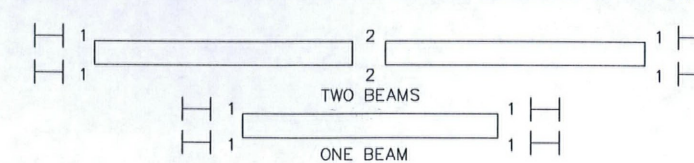

Vermont Agency of Transportation

RECEIVED

OK'D BY: Timothy F. Beech

3:26 pm, Jul 21, 2010

RESUBMIT: KMI

APPROVED: 10/20/10

DATE: 7/23/2010

BY: KMI

DATE: 7/23/2010

DATE: 7/23/2010

DATE: 7/23/2010</



State of Vermont  
PDD/Structures Design Section  
One National Life Drive  
Montpelier, VT 05603-5001  
[www.aot.state.vt.us](http://www.aot.state.vt.us)

[phone] 802-828-2621  
[fax] 802-828-2566  
[tdd] 800-253-0191

Agency of Transportation

May 5, 2010

DI Highway Sign & Structure Corporation  
P.O. Box 123 (40 Greenman Ave)  
New York Mills, N.Y. 13417

**Project Name: Braintree BRO 1444(36)**

**Structure Identification: Bridge 12 over Ayers Brook**

The Bridge Railing, Item 900.640 Special Provision (Bridge Railing, Galvanized HDSB/Fascia Mounted/Steel Tubing) fabrication drawings, for the above-referenced bridge project (General Contractor – Renaud Brothers, Inc.), have been reviewed and are being returned herewith.

**All Sheets and welding procedures are approved.**

You must provide notice to our fabrication inspector, Jeff Clark, as to the date fabrication represented by these drawings will begin. Jeff may be contacted by phone at (802)828-0044 or email at [jeff.clark@state.vt.us](mailto:jeff.clark@state.vt.us). Any material fabricated prior to the notification date is subject to rejection without further cause.

Sincerely,

Kristin M. Higgins PE  
Structures Project Manager

Attachments

cc:  Resident Engineer – Jeremy Reed  
 Shop Inspector – Jeff Clark  
 Contractor – Renaud Brothers, Inc.  
 Construction Division letter only  
 Materials & Research Section (C&IA Unit) letter only  
 Files (Structures)



037 Bridge Rail

WELDING PROCEDURE SPECIFICATION

MATERIAL SPECIFICATION A572 GR 50, A709 GR 50, AASHTO M270-50  
 WELDING PROCESS FCAW  
 MANUAL, SEMIAUTOMATIC, AUTOMATIC SEMIAUTOMATIC  
 POSITION OF WELDING 1F (FLAT)  
 FILLER METAL SPECIFICATIONS AWS 5.20  
 FILLER METAL CLASSIFICATION E71T-1  
 ELECTRODE & MANUFACTURE Ultacore 71C (Lincoln)  
 FLUX & MANUFACTURE N/A  
 SHIELDING GAS 100% CO2 DEW POINT -40°F FLOW RATE MIN 49.5 CFH MAX 60 CFH  
 SINGLE OR MULTIPLE PASS SINGLE  
 SINGLE OR MULTIPLE ARC N/A  
 WELDING CURRENT DC POLARITY DCEP (REVERSE)  
 WELDING PROGRESSION N/A  
 ROOT TREATMENT CLEAN TO REMOVE ALL CONTAMINANTS  
 PREHEAT AND INTERPASS 3/4 TO 1 1/2 = 70°F, 1 1/2 TO 2 1/2 = 150°F > 2 1/2 = 225°F  
350°F MAX INTERPASS TEMP.  
 POSTHEAT TREATMENT NONE

WELDING PROCEDURE

PASS NO.	ELECTRODE SIZE	AMPS	VOLTS	TRAVEL SPEED IN/MIN	JOINT DETAIL
ALL	1/16"	300	27	11.6	<p>Bridge post</p>
		Max 330 Min 270	Max 29 Min 25	Max 12.7 Min 10.5	

PROCEDURE NO: DI-01 FABRICATOR DL HIGHWAY SIGN & STRUCTURE


OUR JOB NO. V04-02 Bridge Post AUTHORIZED BY [Signature]

PQR REF NO. DI-01-09a DATE 4/23/10




JOEL W. SIMS  
 CWI 96689971  
 QCI EXP. 03/01/11

038 Bridge Rail

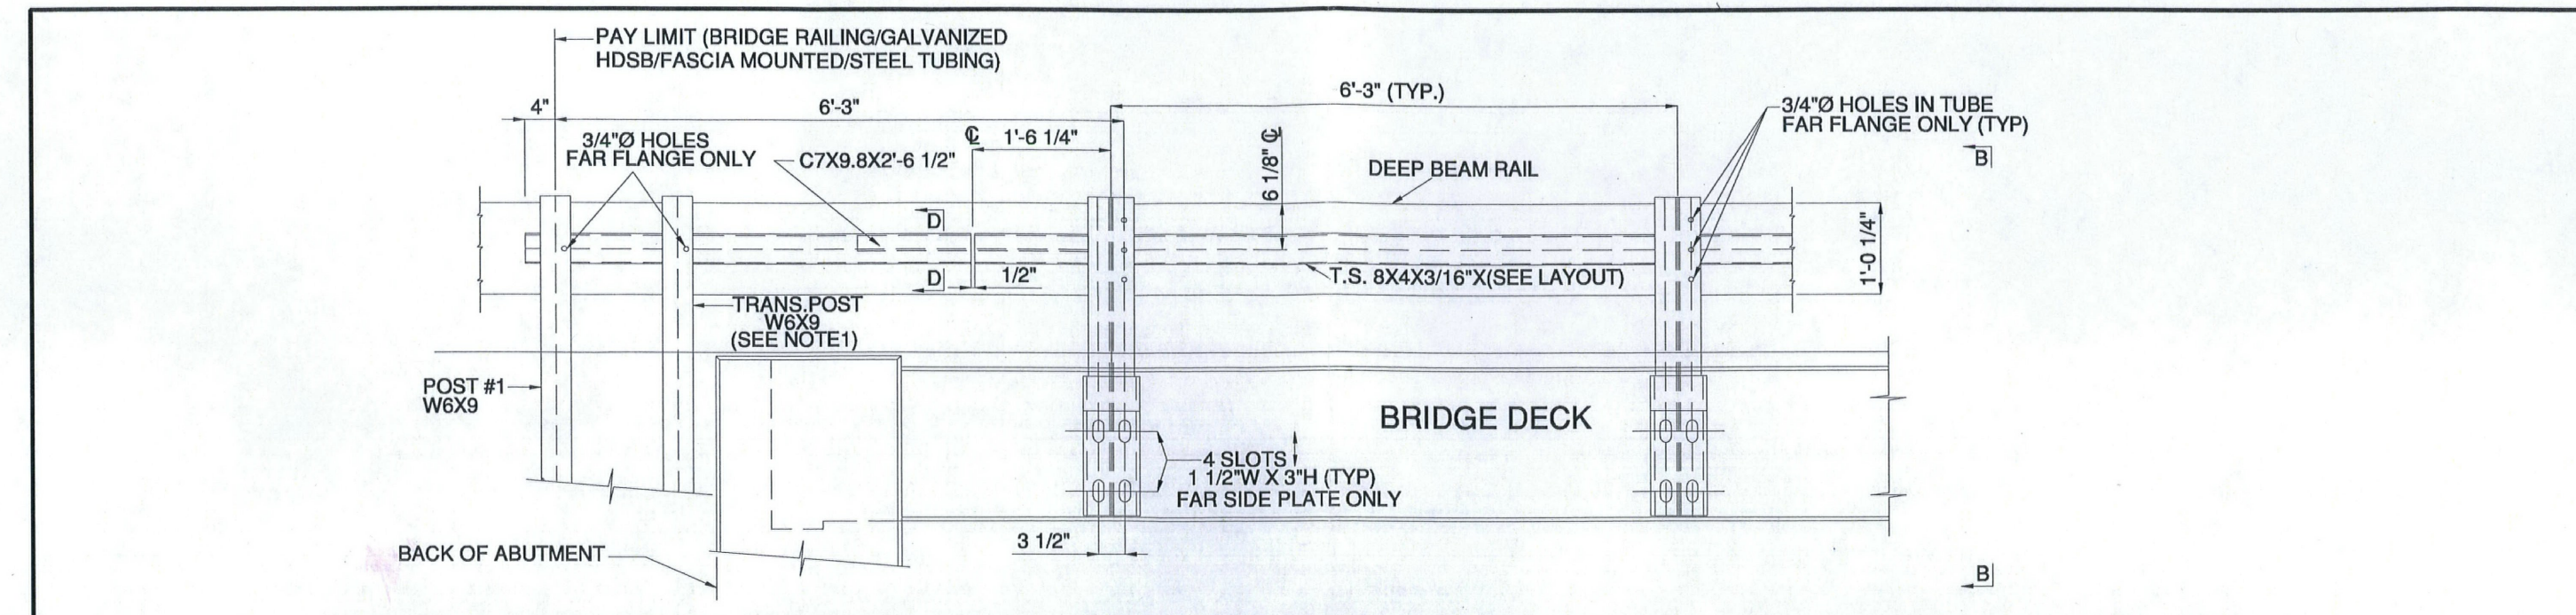

NOTE 1: LOCATE TRANSITION POST AS CLOSE TO ABUTMENT WALL AS PRACTICAL.

**RAILING ELEVATION**

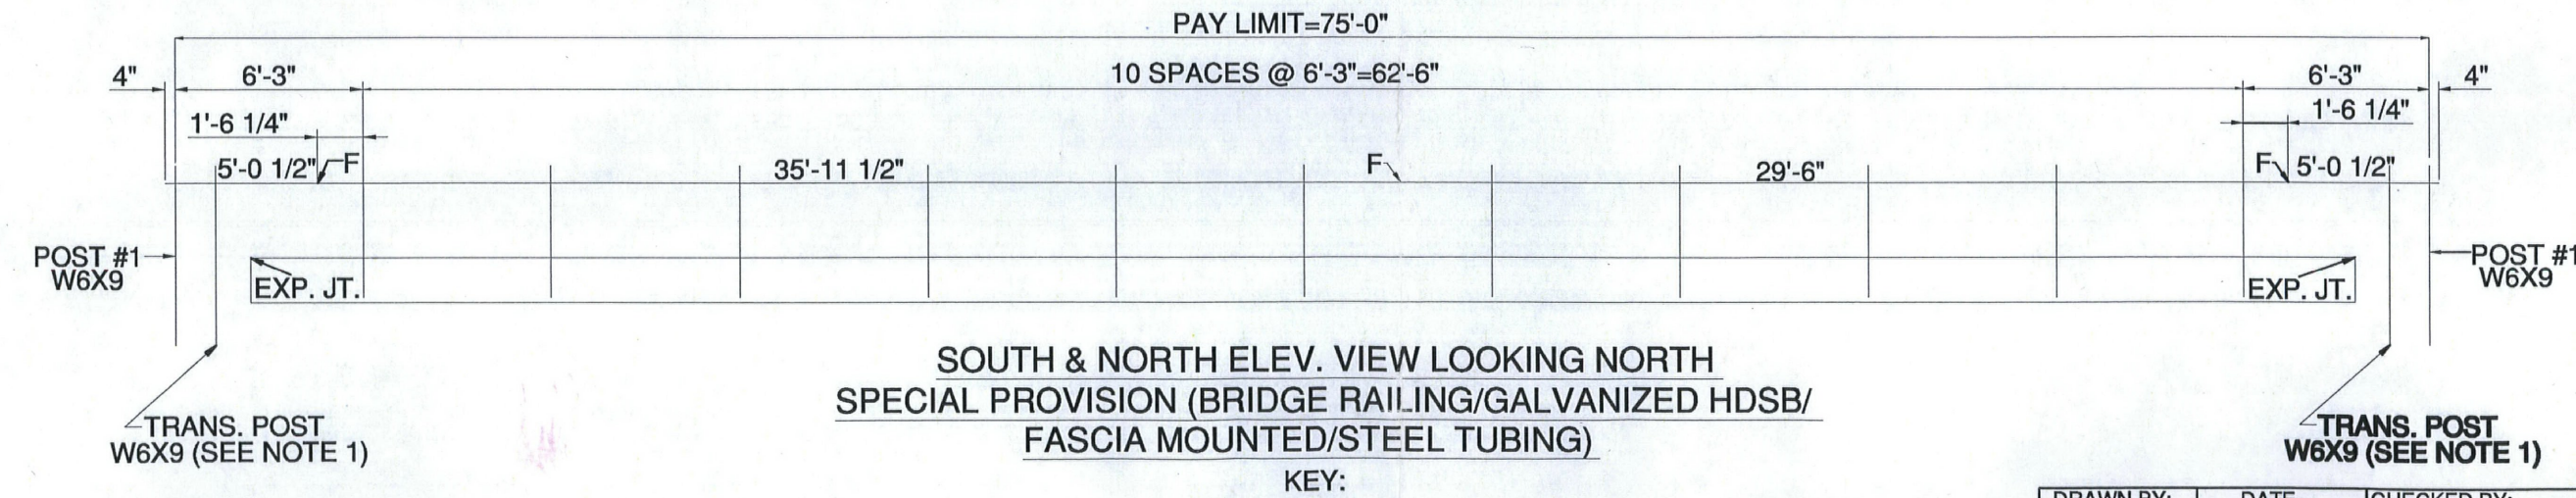

NOTES: FOR SECTION VIEWS B-B & D-D SEE SHEET 2 OF 3.


KEY:  
F=1/2" SPL. JT.

**Vermont Agency of Transportation**  
**RECEIVED**  
CK'D BY **TCF** OK'D BY **JTS**  
9:09 am, Apr 27, 2010  
RESUBMIT  APPROVED   
BY **KMH** DATE **4-27-10**

ALL DIMENSIONS MUST BE FIELD VERIFIED BY CONTRACTOR PRIOR TO FABRICATION

DRAWN BY: JJP	DATE 4/9/10	CHECKED BY: DCK	SHEET NO. 1 OF 3
<b>BRIDGE RAILING LAYOUT</b>			
VERMONT AGENCY OF TRANSPORTATION HEWARD ROAD BRIDGE (STA. 11+85.00) OVER AYER'S BROOK IN THE TOWN OF BRANTREE IN THE COUNTY OF ORANGE			
CONT. NO. BRO 1444(26)	GEN. CONT. RENAUD BROTHERS, INC.		REGION NO. N/A
ERECTOR: VERMONT RECREATIONAL SURFACING & FENCING, INC.		JOB NO. V04-02	
FABRICATOR: DI HIGHWAY SIGN & STRUCTURE CORPORATION P.O. BOX 123(40 GREENMAN AVE.) NEW YORK MILLS, N.Y. 13417			

039 Bridge Rail

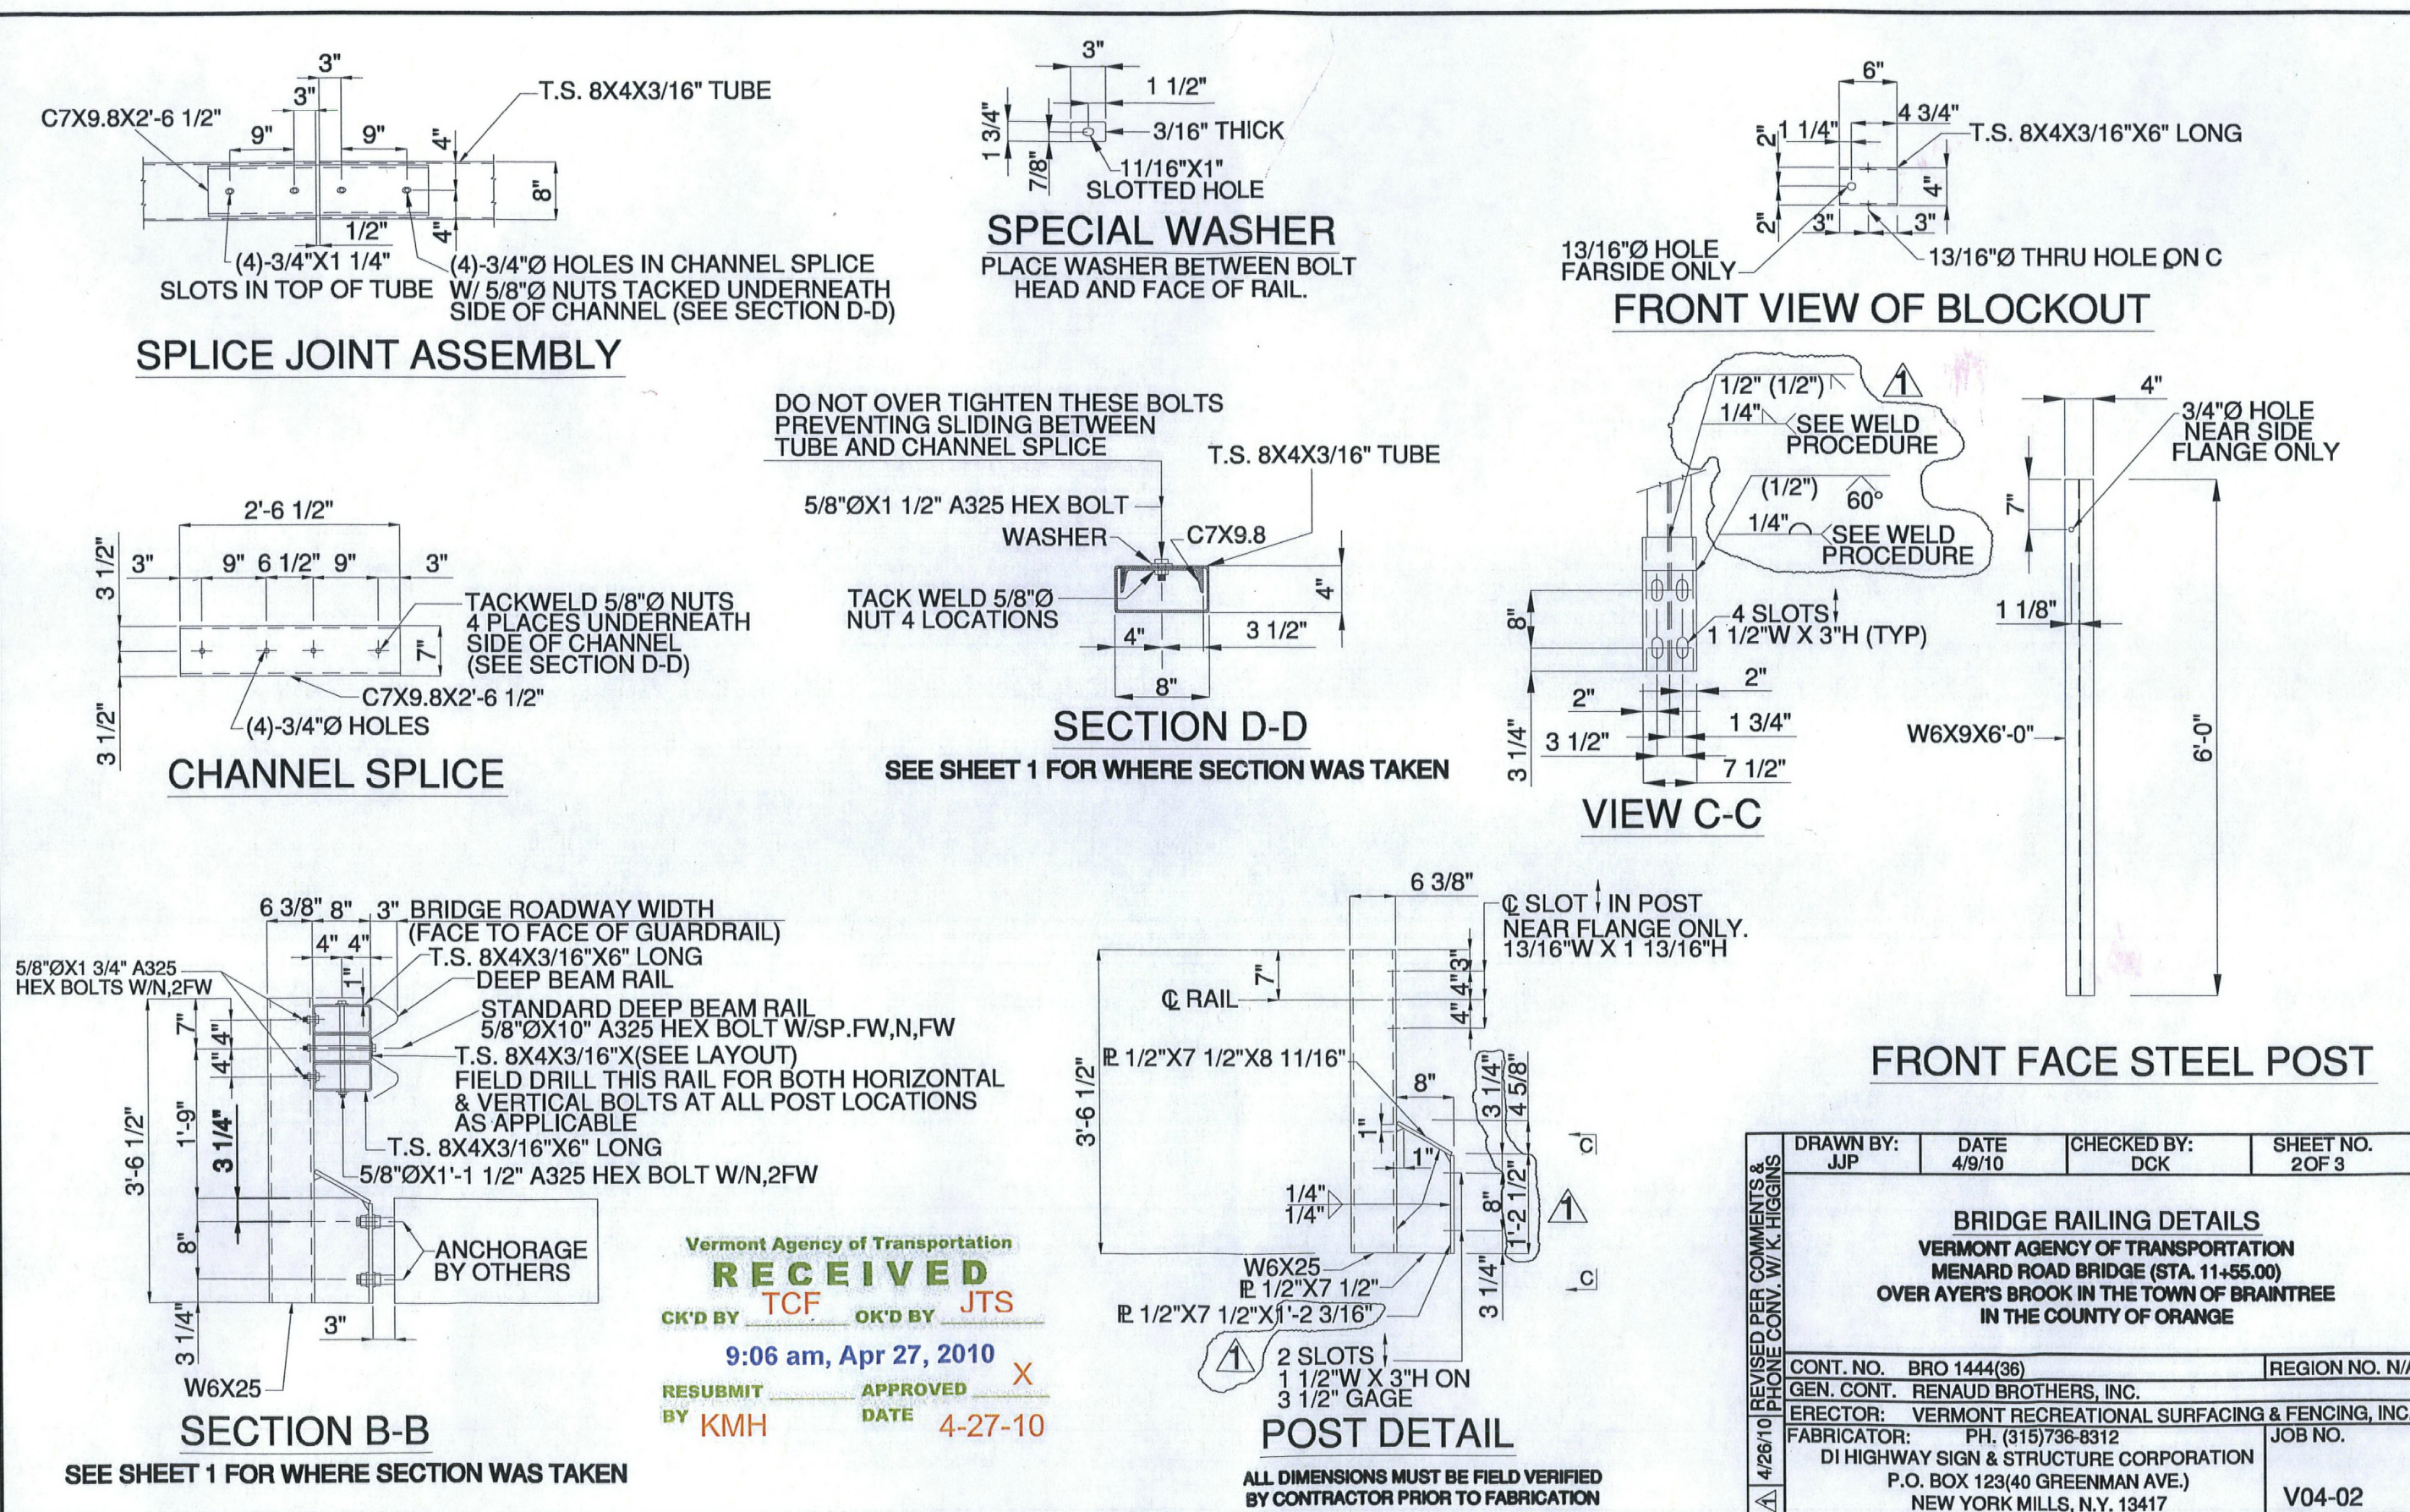

Vermont Agency of Transportation  
**RECEIVED**  
 CHK'D BY TCF OK'D BY JTS  
 9:06 am, Apr 27, 2010  
 RESUBMIT APPROVED X  
 BY KMH DATE 4-27-10

DRAWN BY: JJP	DATE 4/9/10	CHECKED BY: DCK	SHEET NO. 2 OF 3
<b>BRIDGE RAILING DETAILS</b> VERMONT AGENCY OF TRANSPORTATION MENARD ROAD BRIDGE (STA. 11+55.00) OVER AYER'S BROOK IN THE TOWN OF BRAINTREE IN THE COUNTY OF ORANGE			
CONT. NO. BRO 1444(36)		REGION NO. N/A	
GEN. CONT. RENAUD BROTHERS, INC.			
ERECTOR: VERMONT RECREATIONAL SURFACING & FENCING, INC.			
FABRICATOR: PH. (515) 786-8312		JOB NO.	
DI HIGHWAY SIGN & STRUCTURE CORPORATION		P.O. BOX 123(40 GREENMAN AVE.)	
NEW YORK MILLS, N.Y. 13417		V04-02	

040 Bridge Rail

FASCIA MOUNTED WITHOUT CURB NOTES

1. HEAVY DUTY STEEL BEAM GUARD RAIL SHALL CONFORM TO VT. SPECIFICATION SECTION 732.
2. STRUCTURAL STEEL TUBING SHALL CONFORM TO VT. SPECIFICATION SECTION 732 GALVANIZED AFTER FABRICATION IN ACCORDANCE WITH (AASHTO M111) ASTM A123.
3. BRIDGE RAIL POSTS, SPECIAL WASHERS, PLATE WASHERS AND SPLICE BARS SHALL CONFORM TO (AASHTO M223) A572 GR50 GALVANIZED AFTER FABRICATION IN ACCORDANCE WITH (AASHTO M111) ASTM A123.
4. ALL BOLTS AND RELATED HARDWARE SHALL CONFORM TO (AASHTO M164) ASTM A325 TYPE 1 BOLTS, HOT DIPPED OR MECHANICALLY GALVANIZED PER SPECIFICATION.
5. ALL POSTS SHALL BE SET NORMAL GRADE.
6. SPLICES FOR THE STEEL BEAM GUARD RAIL SHALL LAP IN THE DIRECTION OF TRAFFIC.
7. ALL FIELD CUT OR DRILLED AREAS SHALL BE REPAIRED PER SECTION 813.
8. ALL FLAT WASHERS SHALL CONFORM TO ASTM F436. A
9. ALL NUTS SHALL CONFORM TO ASTM A563, GRADE H. A

BILL OF MATERIAL					
MARK OR USE	QTY.	SHAPE	SHAPE		REMARKS
			FT.	IN.	
* RAIL	2	T.S. 8"x4"x3/16" WALL	35	11 1/2	ASTM A500GRB
* RAIL	2	T.S. 8"x4"x3/16" WALL	29	6	ASTM A500GRB
* RAIL	4	T.S. 8"x4"x3/16" WALL	5	0 1/2	ASTM A500GRB
CHANNEL SPLICE	6	C7X9.8	2	6 1/2	ASTM A36 <span style="border: 1px solid black; border-radius: 50%; padding: 2px;">A</span> W/4-5/8" H.S. NUTS
SPLICE BOLT	24	5/8" HEX BOLT	1	1 1/2	ASTM A325(AASHTO M164)TYPE1 W/FW
BLOCKOUT	44	T.S. 8"x4"x3/16" WALL		6	ASTM A500GRB
BLOCKOUT BOLT	44	5/8" HEX BOLT	1	3/4	ASTM A325(AASHTO M164)TYPE1 W/N,2FW
POST BOLT	30	5/8" HEX BOLT	1	10	ASTM A325(AASHTO M164)TYPE1 W/SP,FW,N,FW
RAIL BOLT	22	5/8" HEX BOLT	1	1 1/2	ASTM A325(AASHTO M164)TYPE1 W/N,2FW
CORRUGATED RAIL	12	10 GAGE CORRUGATED	13	6	(AASHTO M180 CLASS B, TYPE 2) <span style="border: 1px solid black; border-radius: 50%; padding: 2px;">A</span>
POST ASSY.	22				<span style="border: 1px solid black; border-radius: 50%; padding: 2px;">A</span>
FASCIA PLATE	22	PL 1/2"x7 1/2"	1	2 3/16	ASTM A36(AASHTO M183)
TOP PLATE	22	PL 1/2"x7 1/2"	6	11/16	ASTM A36(AASHTO M183)
WEB PLATE	22	PL 1/2"x7 1/2"	AS REQ'D		ASTM A36(AASHTO M183)
POST	22	W6X25	3	6 1/2	ASTM A572 GR50(AASHTO M223)
POST	8	W6X9	6	0	ASTM A709 GR36(AASHTO M270 GR 250) <span style="border: 1px solid black; border-radius: 50%; padding: 2px;">A</span>
CORRUGATED BOLT	96	5/8" BUTT ON HEAD OVAL SHOULDER CORRUGATED SPLICE BOLT	1	1/4	ASTM A307 W/DL,REC. N

\* THE DROP-WEIGHT TEAR TEST IN SECTION 732 SHALL NOT APPLY TO THE STRUCTURAL TUBING.

Vermont Agency of Transportation  
**RECEIVED**

OK'D BY TCF OK'D BY JTS

1:43 pm, Apr 27, 2010

RESUBMIT \_\_\_\_\_ APPROVED  X  
BY KMH DATE 4-27-10

ALL DIMENSIONS MUST BE FIELD VERIFIED BY CONTRACTOR PRIOR TO FABRICATION

PAY LIMIT FOR SPECIAL PROVISION RAIL=150,000FT.(APPROX.)

DRAWN BY: JJP	DATE: 4/9/10	CHECKED BY: DCK	SHEET NO. 3 OF 3
BRIDGE RAILING LAYOUT B.O.M VERMONT AGENCY OF TRANSPORTATION MENARD ROAD BRIDGE (STA. 11+55.00) OVER AYERS BROOK IN THE TOWN OF BRANTREE IN THE COUNTY OF ORANGE			
CONT. NO. BRO 1444(36)		REGION NO. N/A	
ERECTOR: VERMONT RECREATIONAL SURFACING & FENCING, INC.			
FABRICATOR: DI HIGHWAY SIGN & STRUCTURE CORPORATION P.O. BOX 123(40 GREENMAN AVE.) NEW YORK MILLS, N.Y. 13417		JOB NO. V04-02	

041 Bridge Rail