
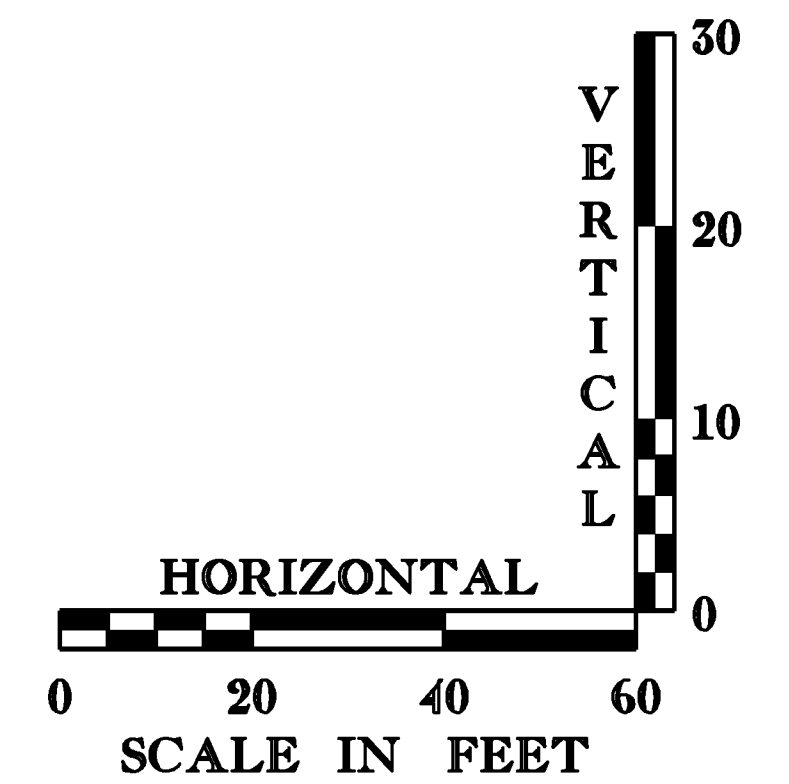


TH 23 (MENARD ROAD)

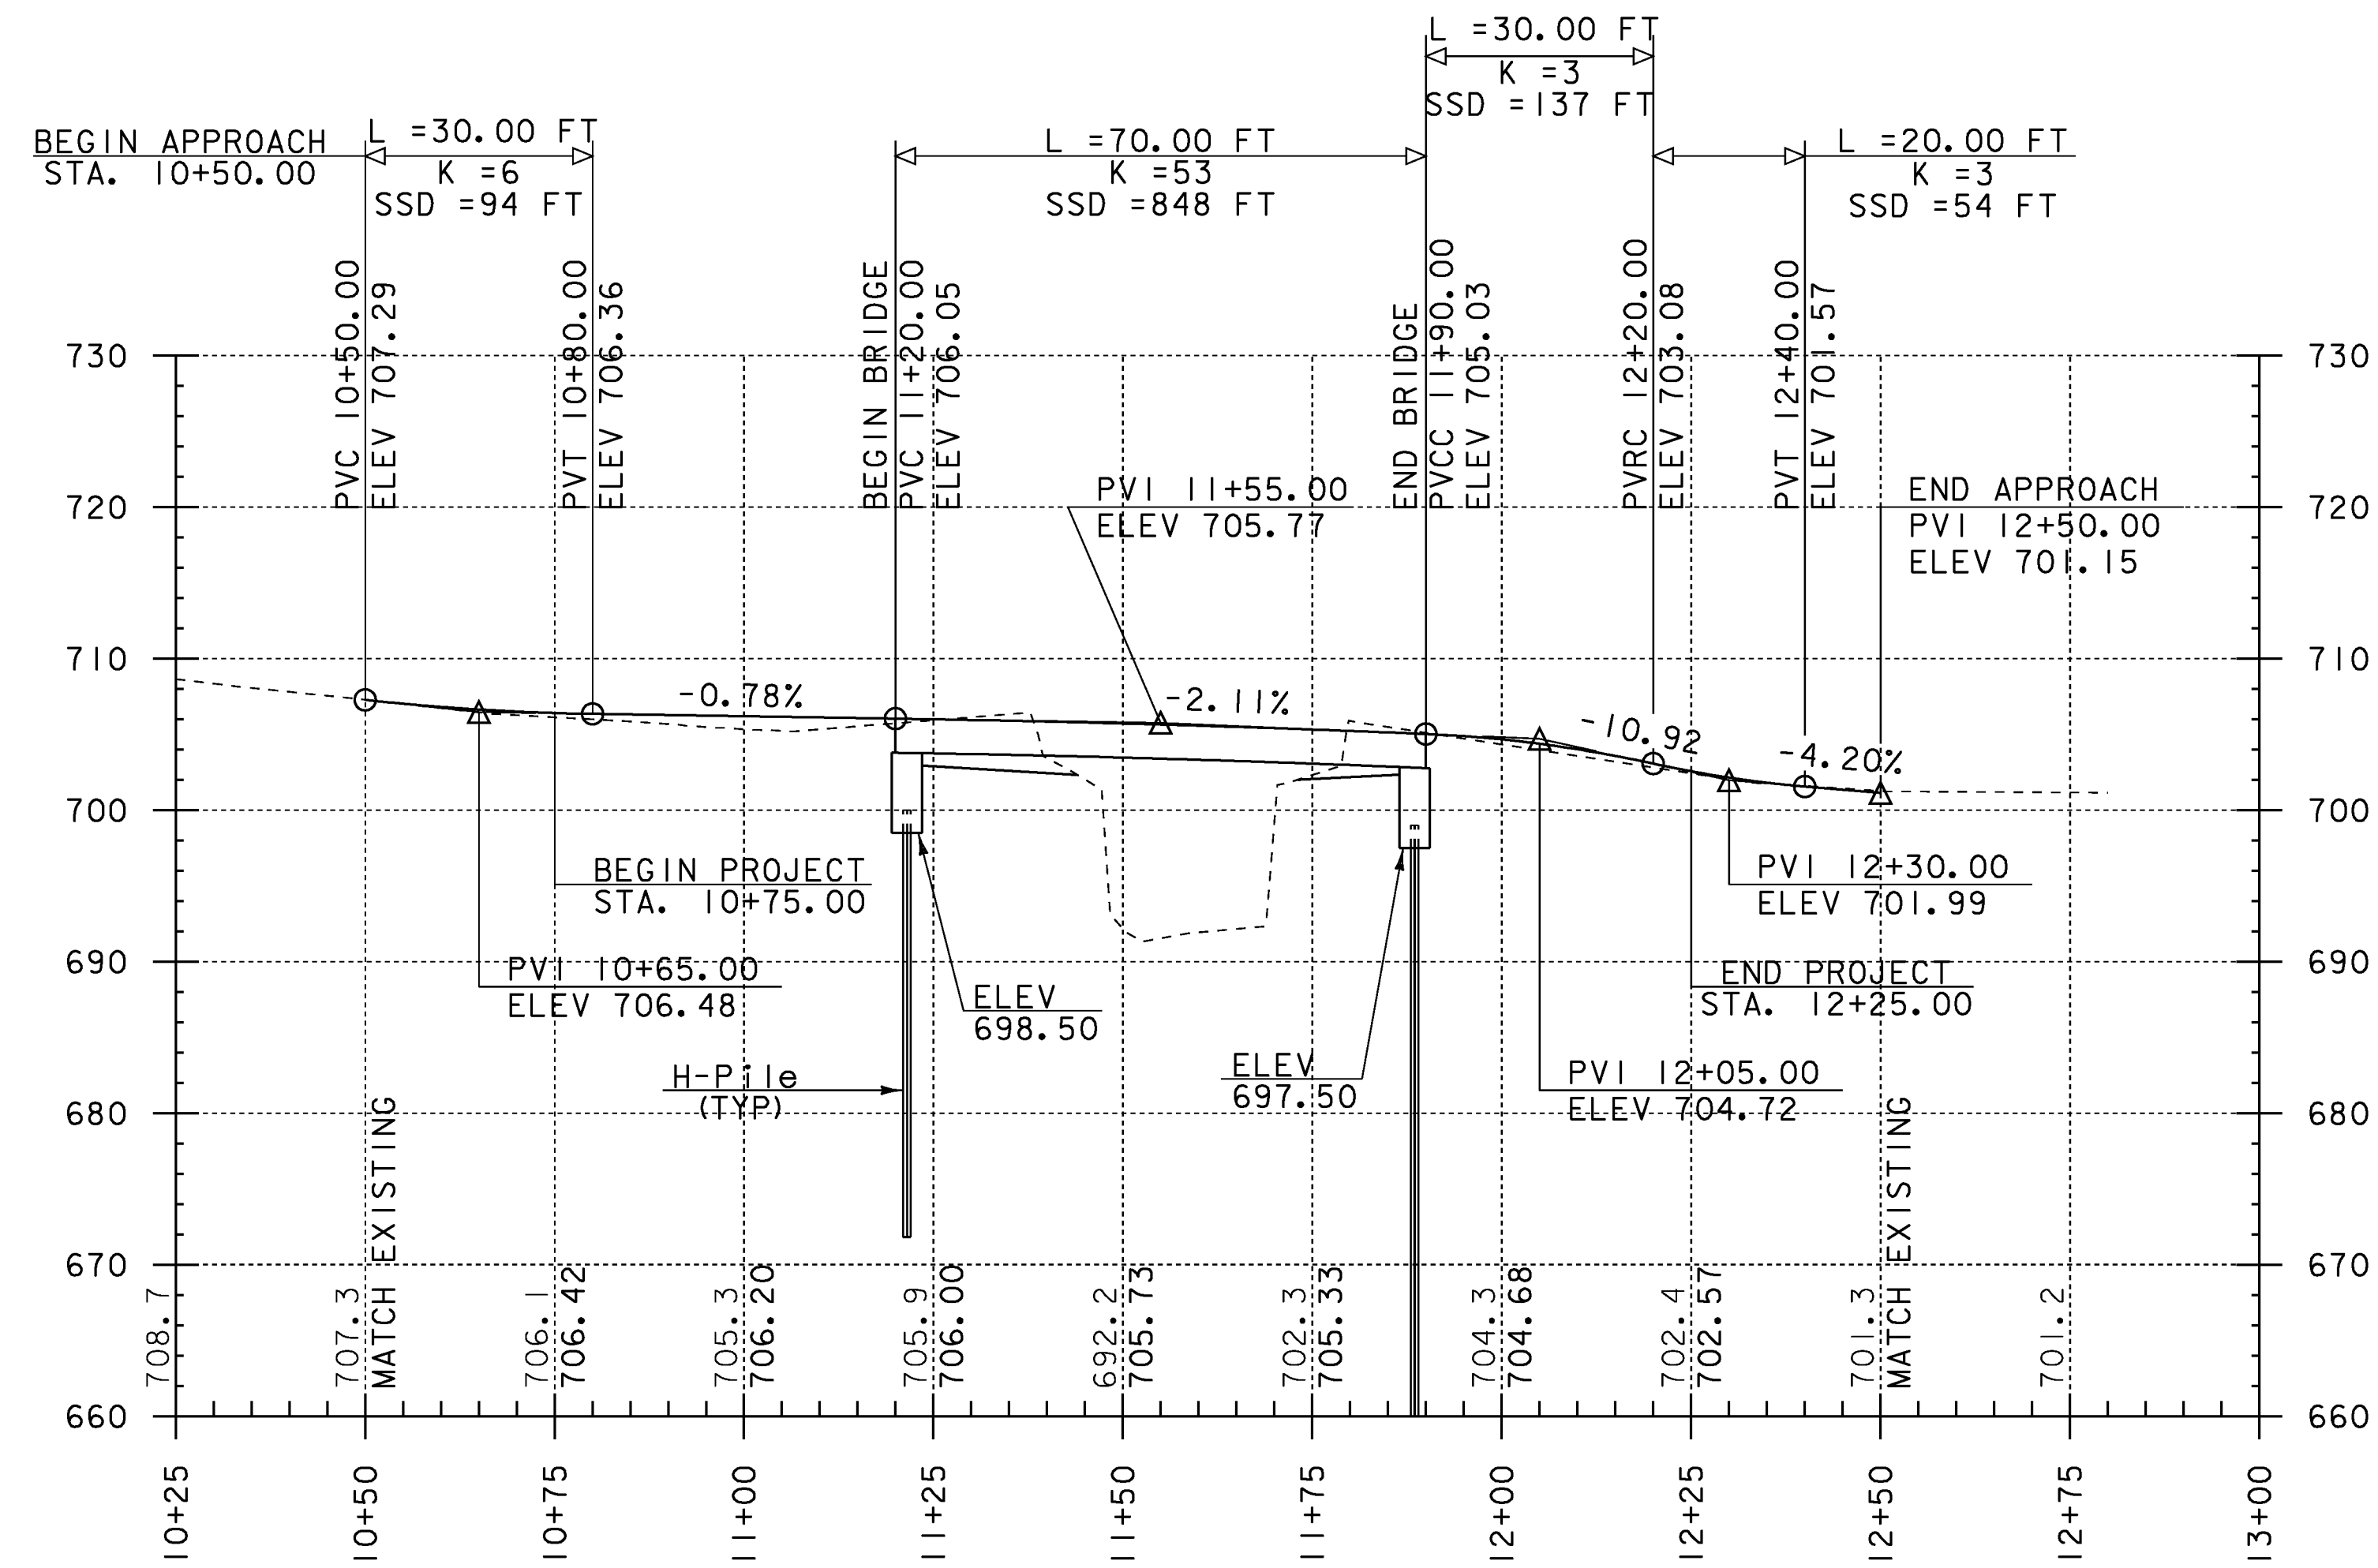

THE GRADES SHOWN TO THE NEAREST TENTH ARE THE ORIGINAL GROUND ELEVATIONS ALONG THE PROPOSED ALIGNMENT.

THE GRADES SHOWN TO THE NEAREST HUNDREDTH ARE THE FINISH GRADES ALONG THE PROPOSED ALIGNMENT.

SEE CROSS SECTIONS FOR MATERIAL TRANSITION INFORMATION.

PROJECT NAME:	BRAINTREE	PLOT DATE:	31-DEC-2009
PROJECT NUMBER:	BRO 1444(36)	DRAWN BY:	K. PATTERSON
FILE NAME:	s95j292pro.dgn	DESIGNED BY:	T. FILLBACH
PROFILE SHEET		CHECKED BY:	T. FILLBACH
		SHEET	9 OF 26