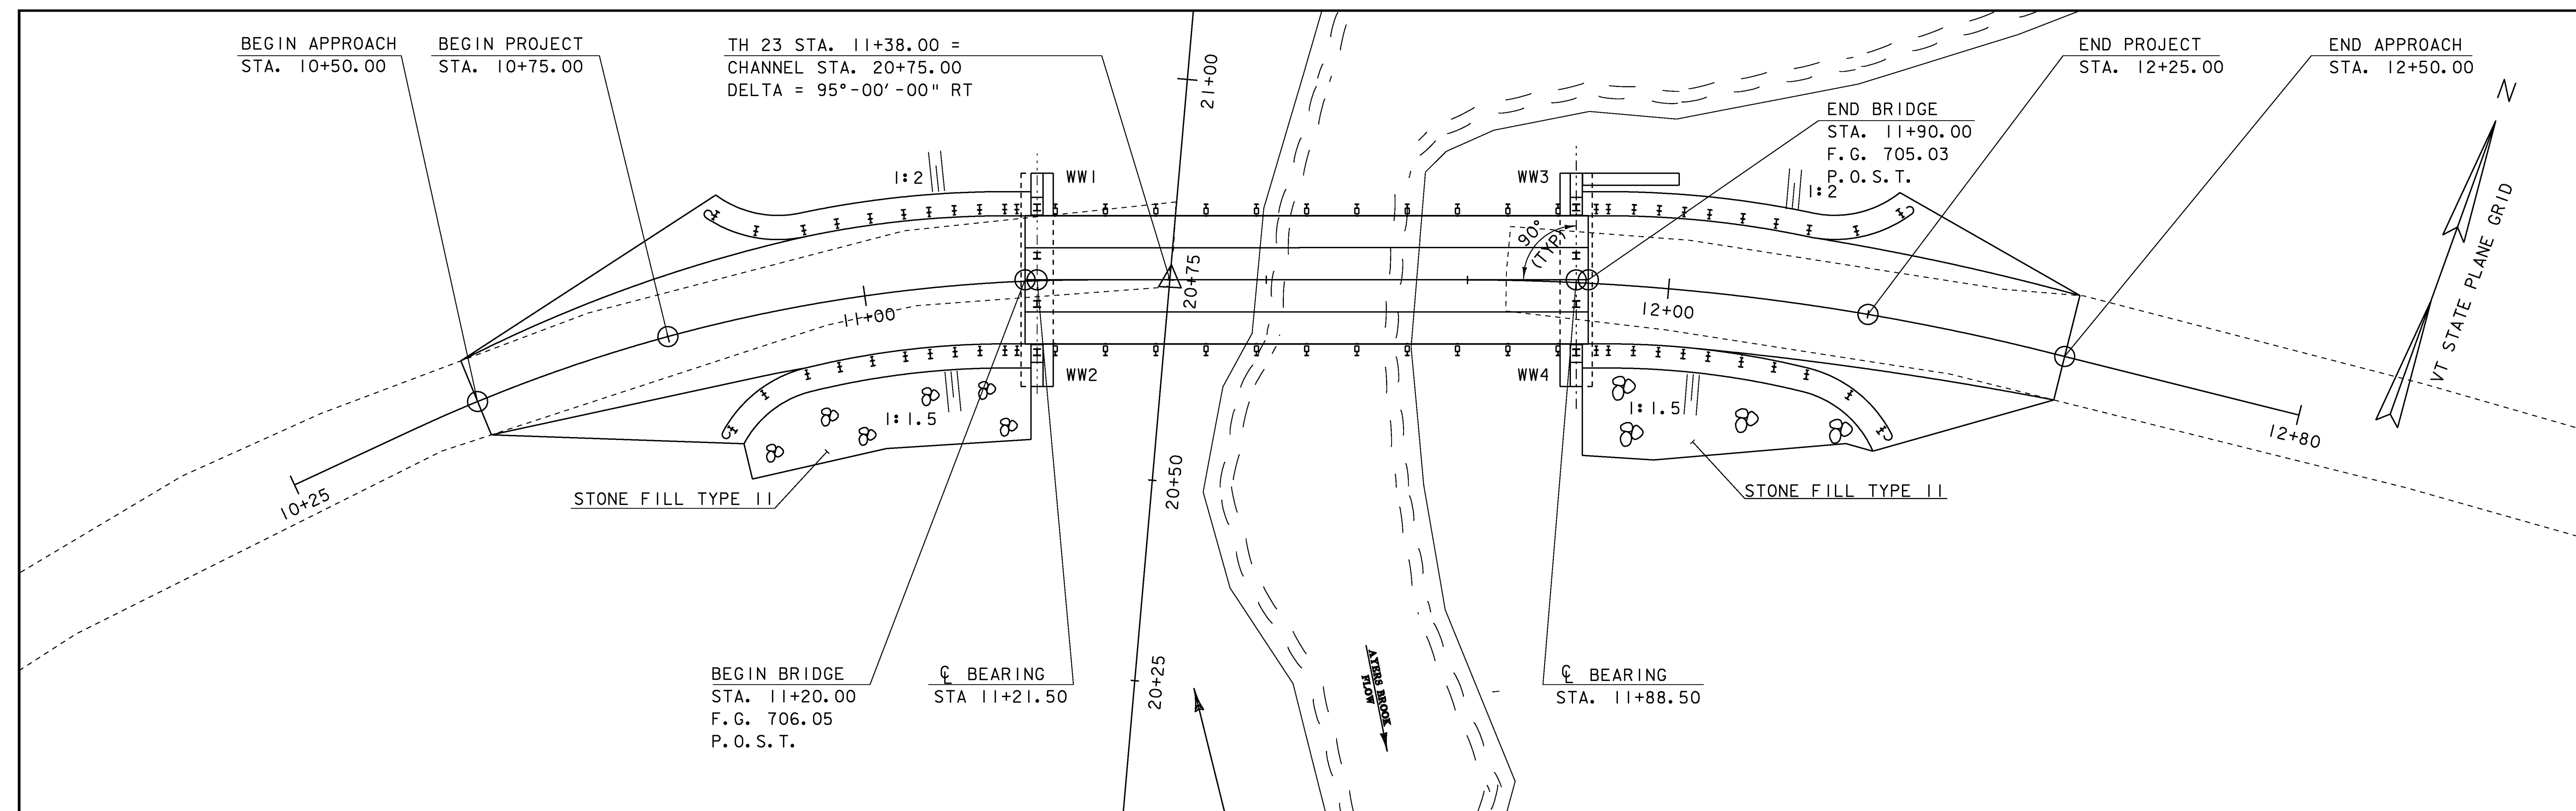


SCALE 1" = 10'-0"

10 0 10

|                    |               |             |             |
|--------------------|---------------|-------------|-------------|
| PROJECT NAME:      | BRAINTREE     | PLOT DATE:  | 31-DEC-2009 |
| PROJECT NUMBER:    | BRO 1444(36)  | DRAWN BY:   | R. PELLETT  |
| FILE NAME:         | s95j292pe.dgn | CHECKED BY: | T. FILLBACH |
| PROJECT LEADER:    | K. HIGGINS    | SHEET       | 14 OF 26    |
| DESIGNED BY:       | T. FILLBACH   |             |             |
| PLAN AND ELEVATION |               |             |             |