


**FRAMING PLAN FOR
BOX BEAM UNITS**

SCALE $\frac{3}{8}$ " = 1'-0"
1 0 1 2 3 4

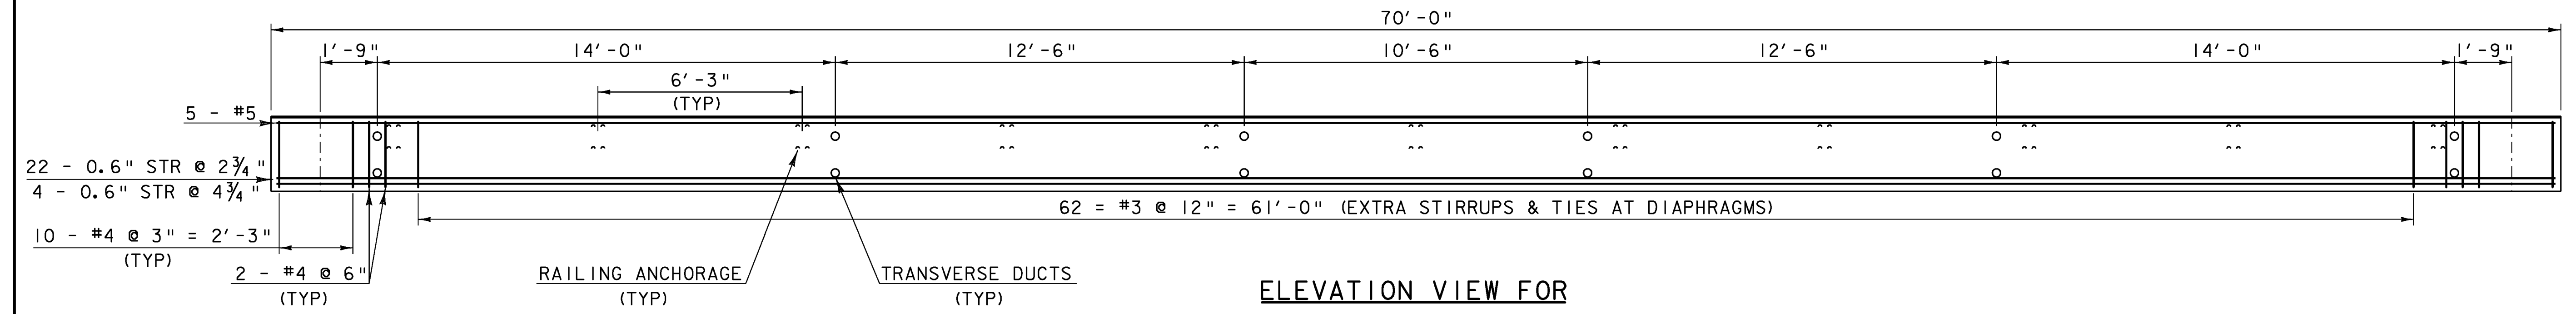

**ELEVATION VIEW FOR
BOX BEAM UNITS**

SCALE $\frac{3}{8}$ " = 1'-0"
1 0 1 2 3 4

PROJECT NAME:	BRAINTREE	PLOT DATE:	14-JAN-2010
PROJECT NUMBER:	BRO 1444(36)	DRAWN BY:	K. PATTERSON
FILE NAME:	s95J292sup.dgn	DESIGNED BY:	T. FILLBACH
PROJECT LEADER:	K. HIGGINS	CHECKED BY:	T. FILLBACH
FRAMING PLAN		SHEET	15 OF 26