




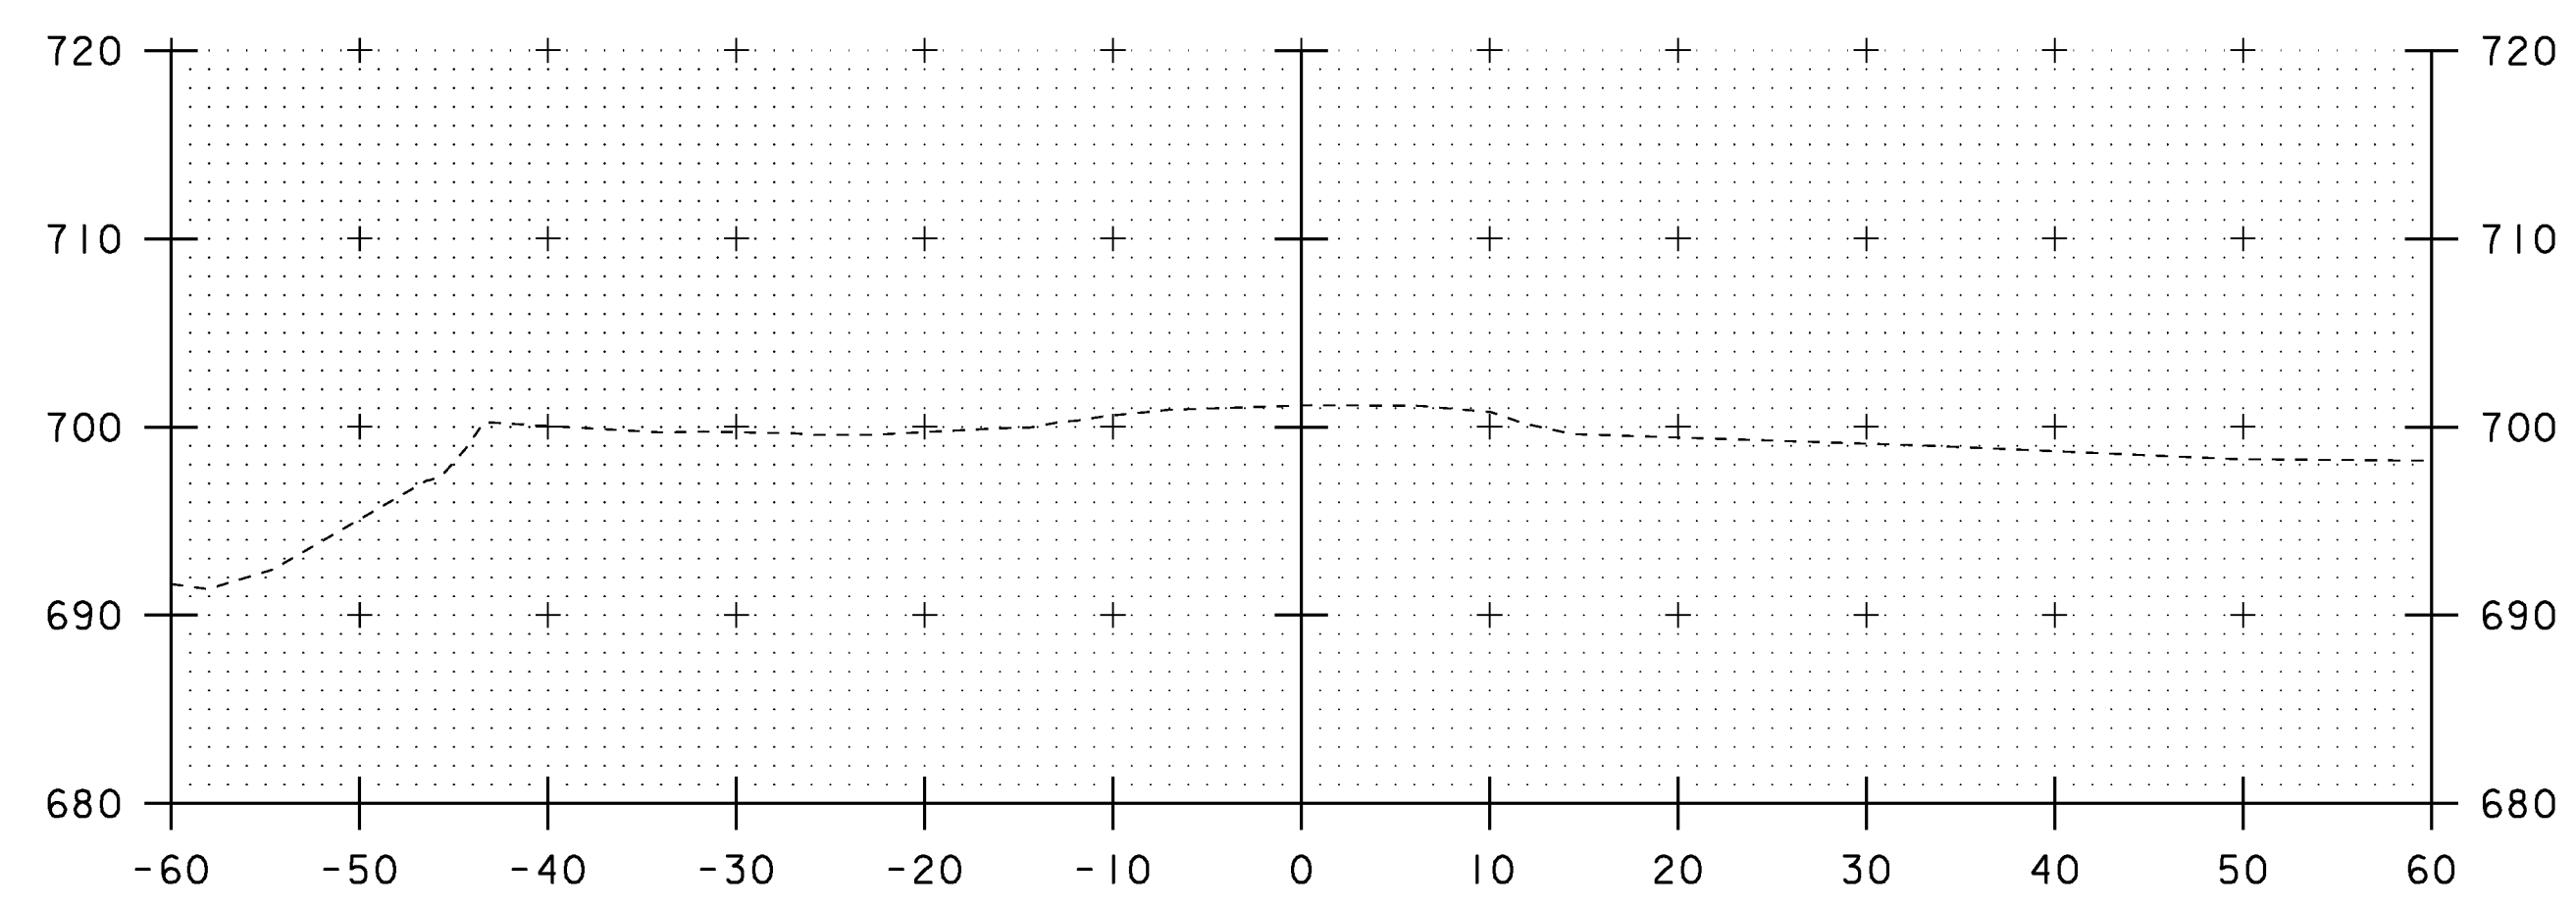

12+75

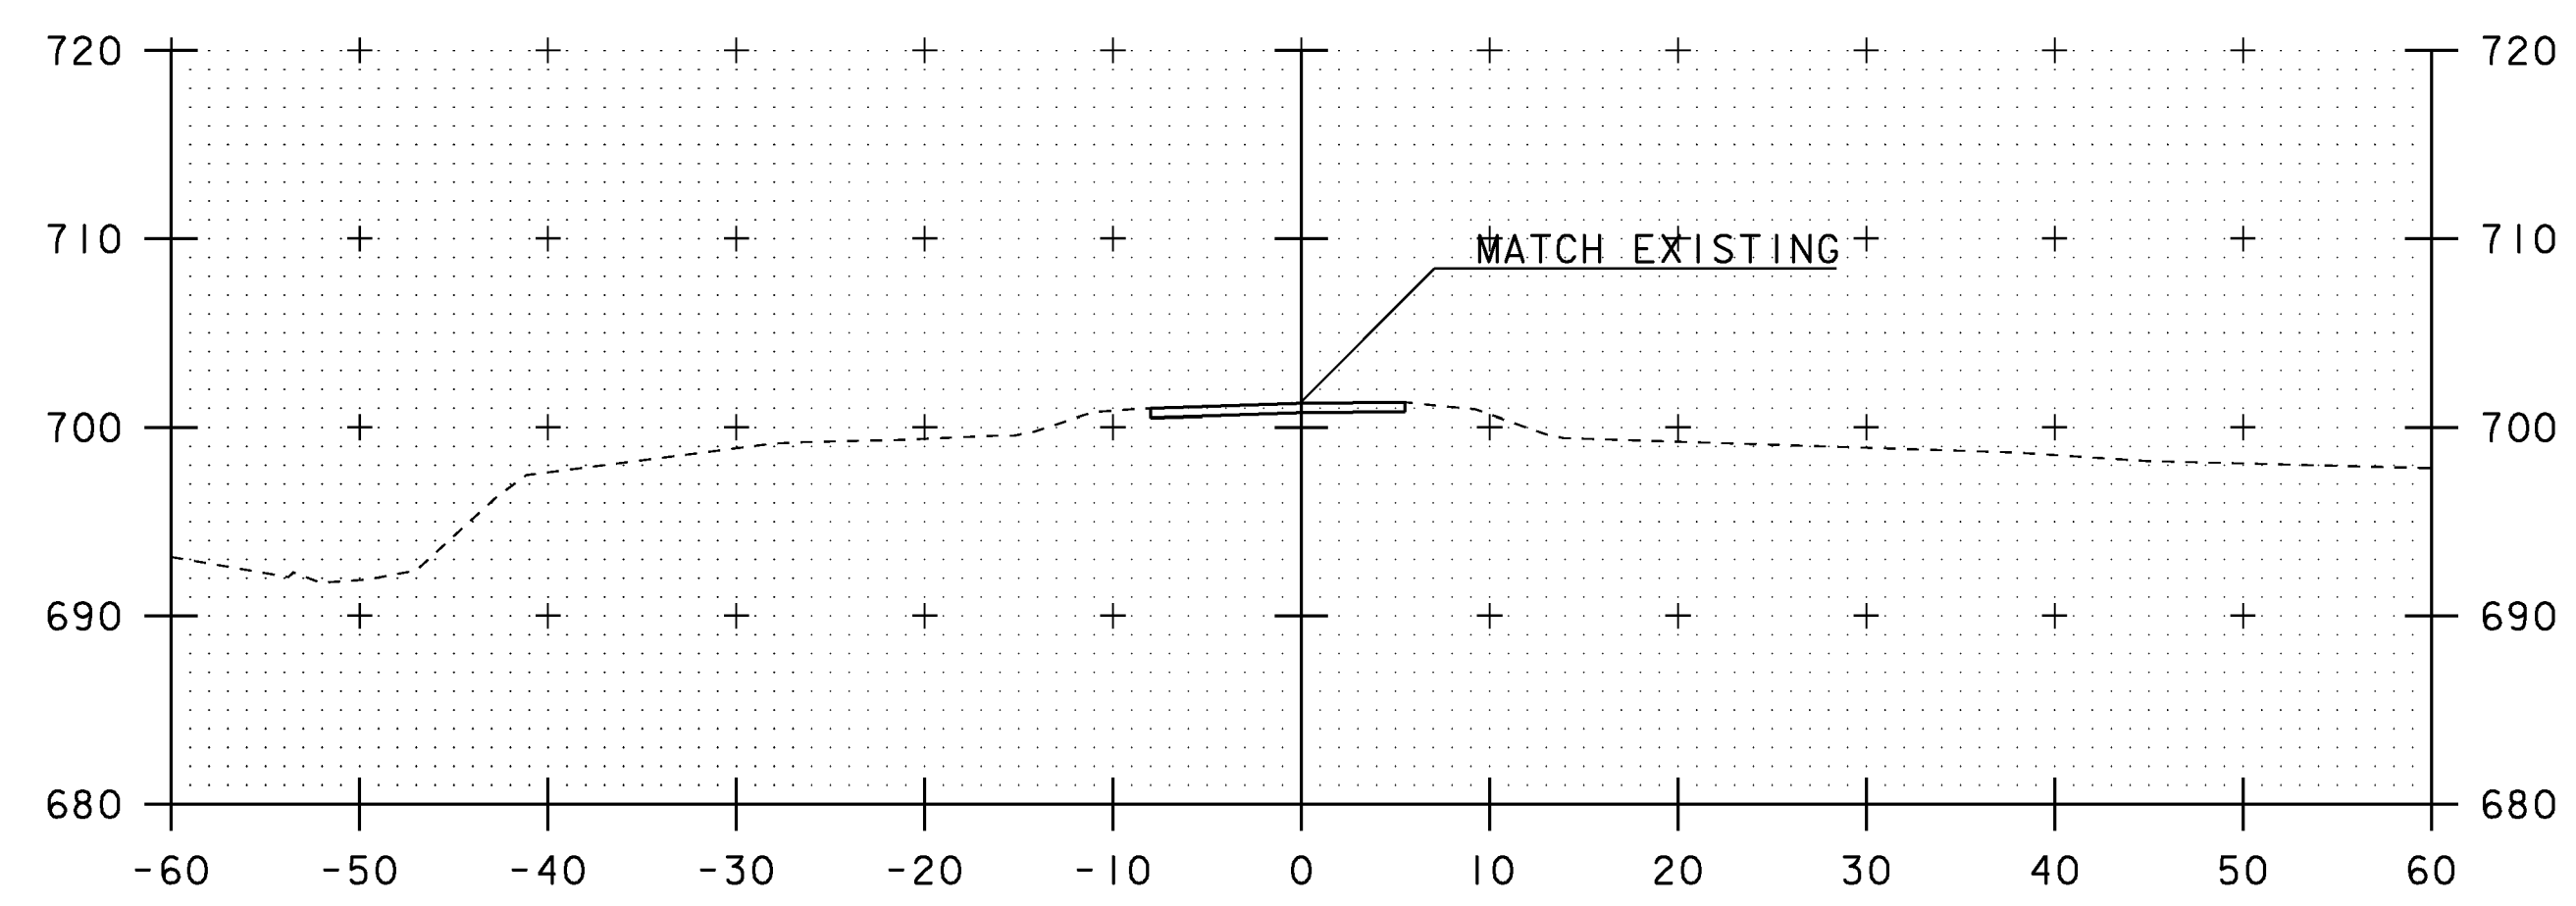

END APPROACH
12+50

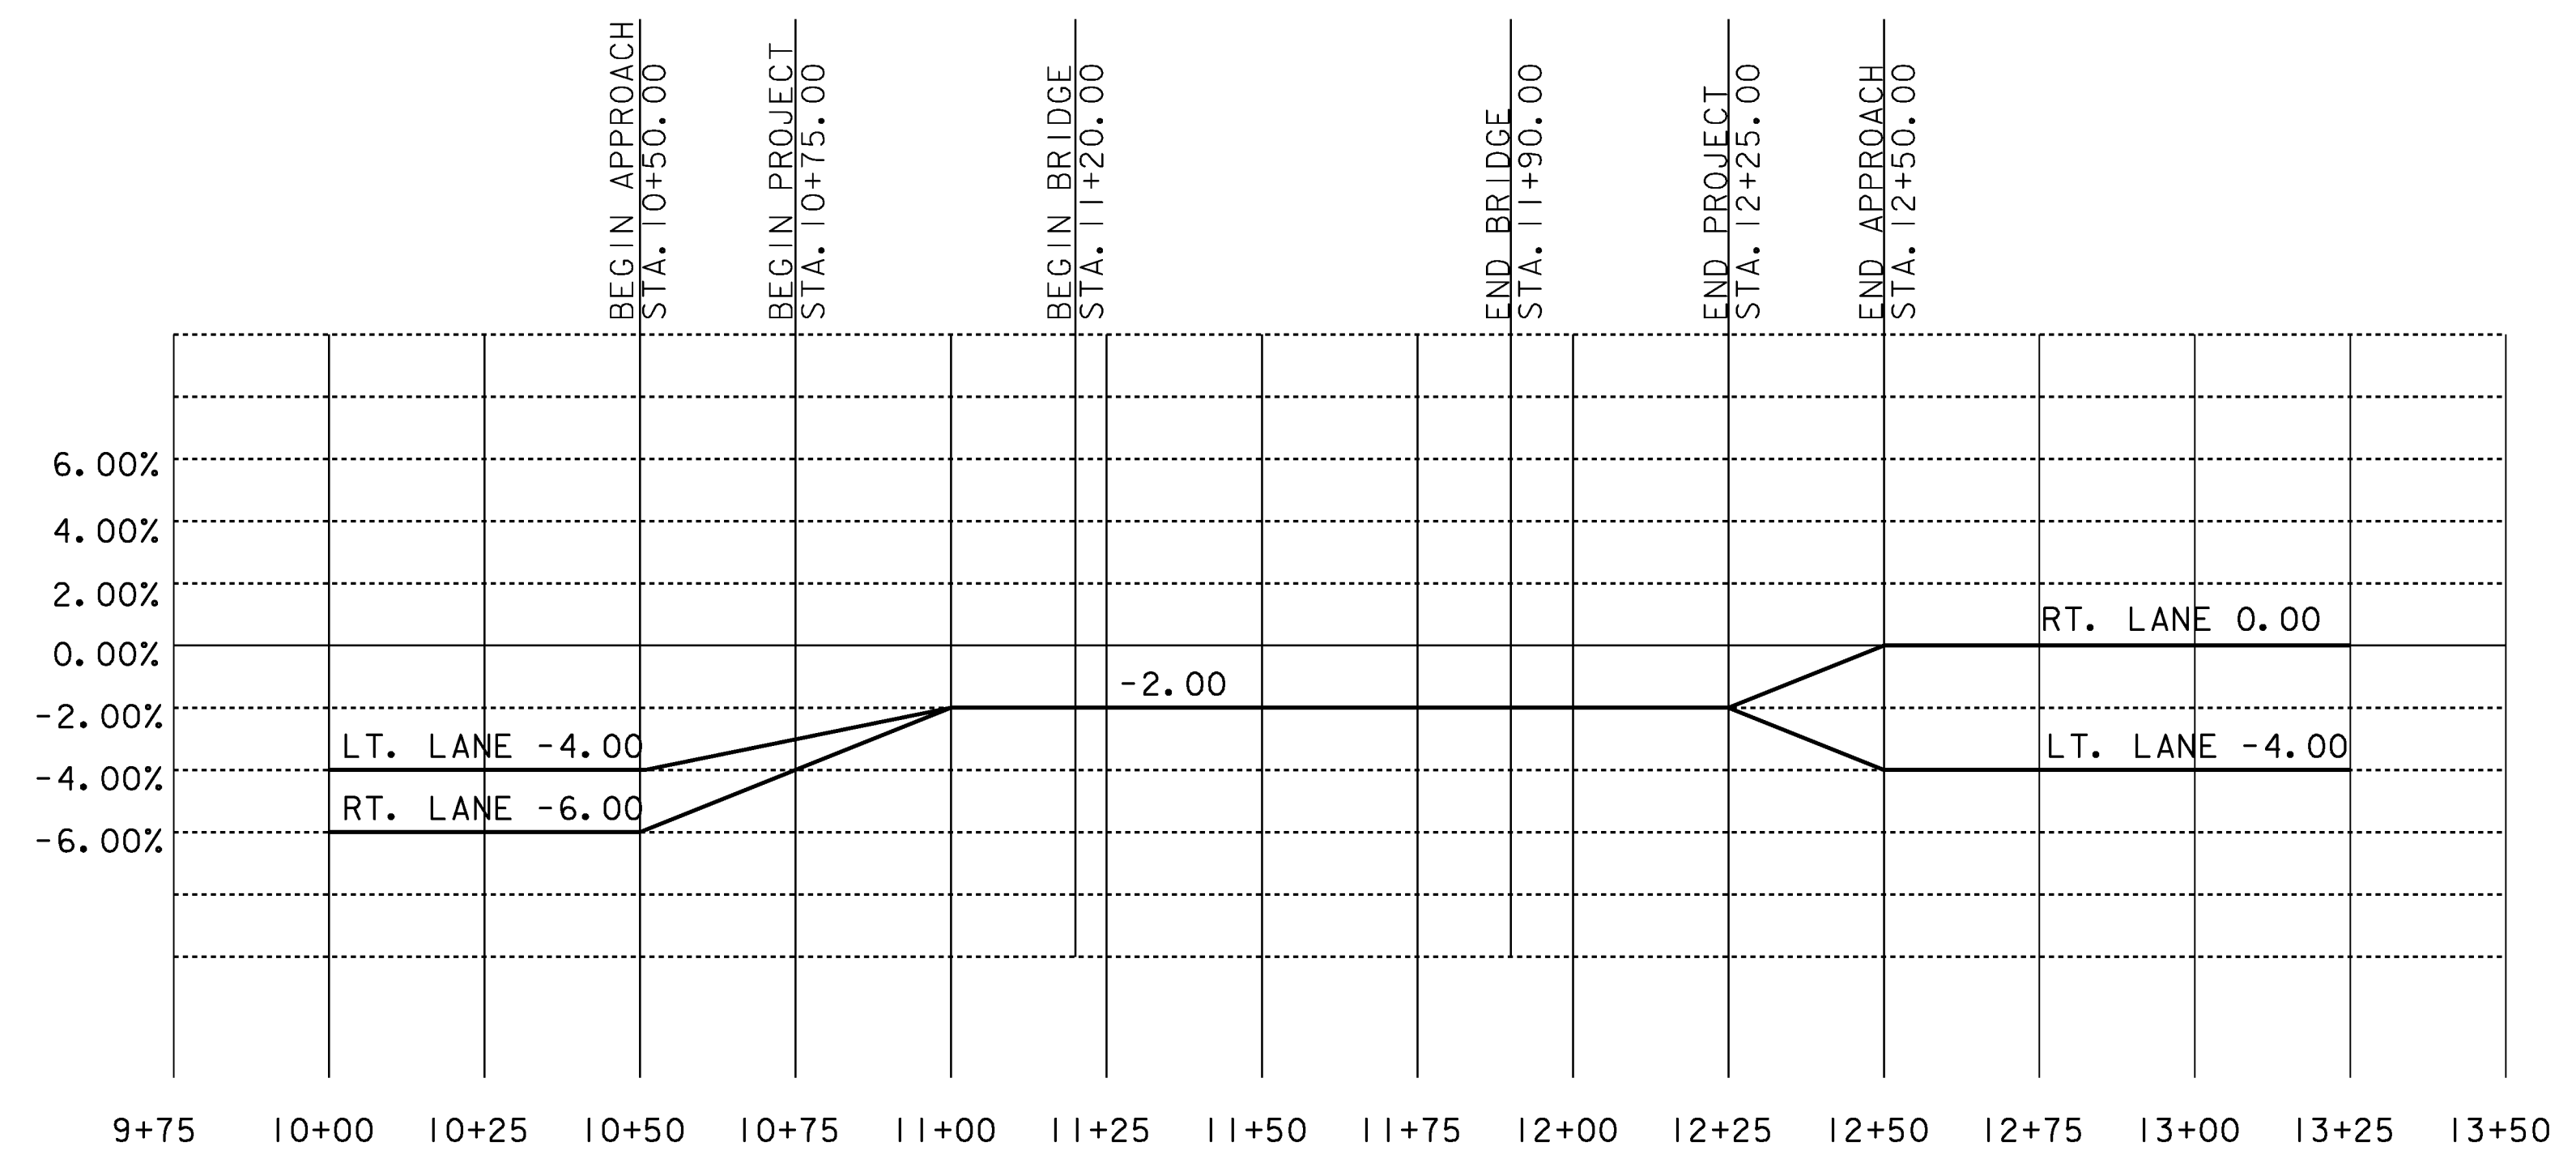

SUPERELEVATION DIAGRAM
NOT TO SCALE

SCALE 1" = 10'-0"
10 0 10

STA. 12+50 TO STA. 12+75

PROJECT NAME: BRAINTREE	
PROJECT NUMBER: BRO 1444(36)	
FILE NAME: s95j292xsl.dgn	PLOT DATE: 31-DEC-2009
PROJECT LEADER: K. HIGGINS	DRAWN BY: T. FILLBACH
DESIGNED BY: T. FILLBACH	CHECKED BY: R. PELLETT
MAINLINE SECTIONS	SHEET 25 OF 26