




20+50

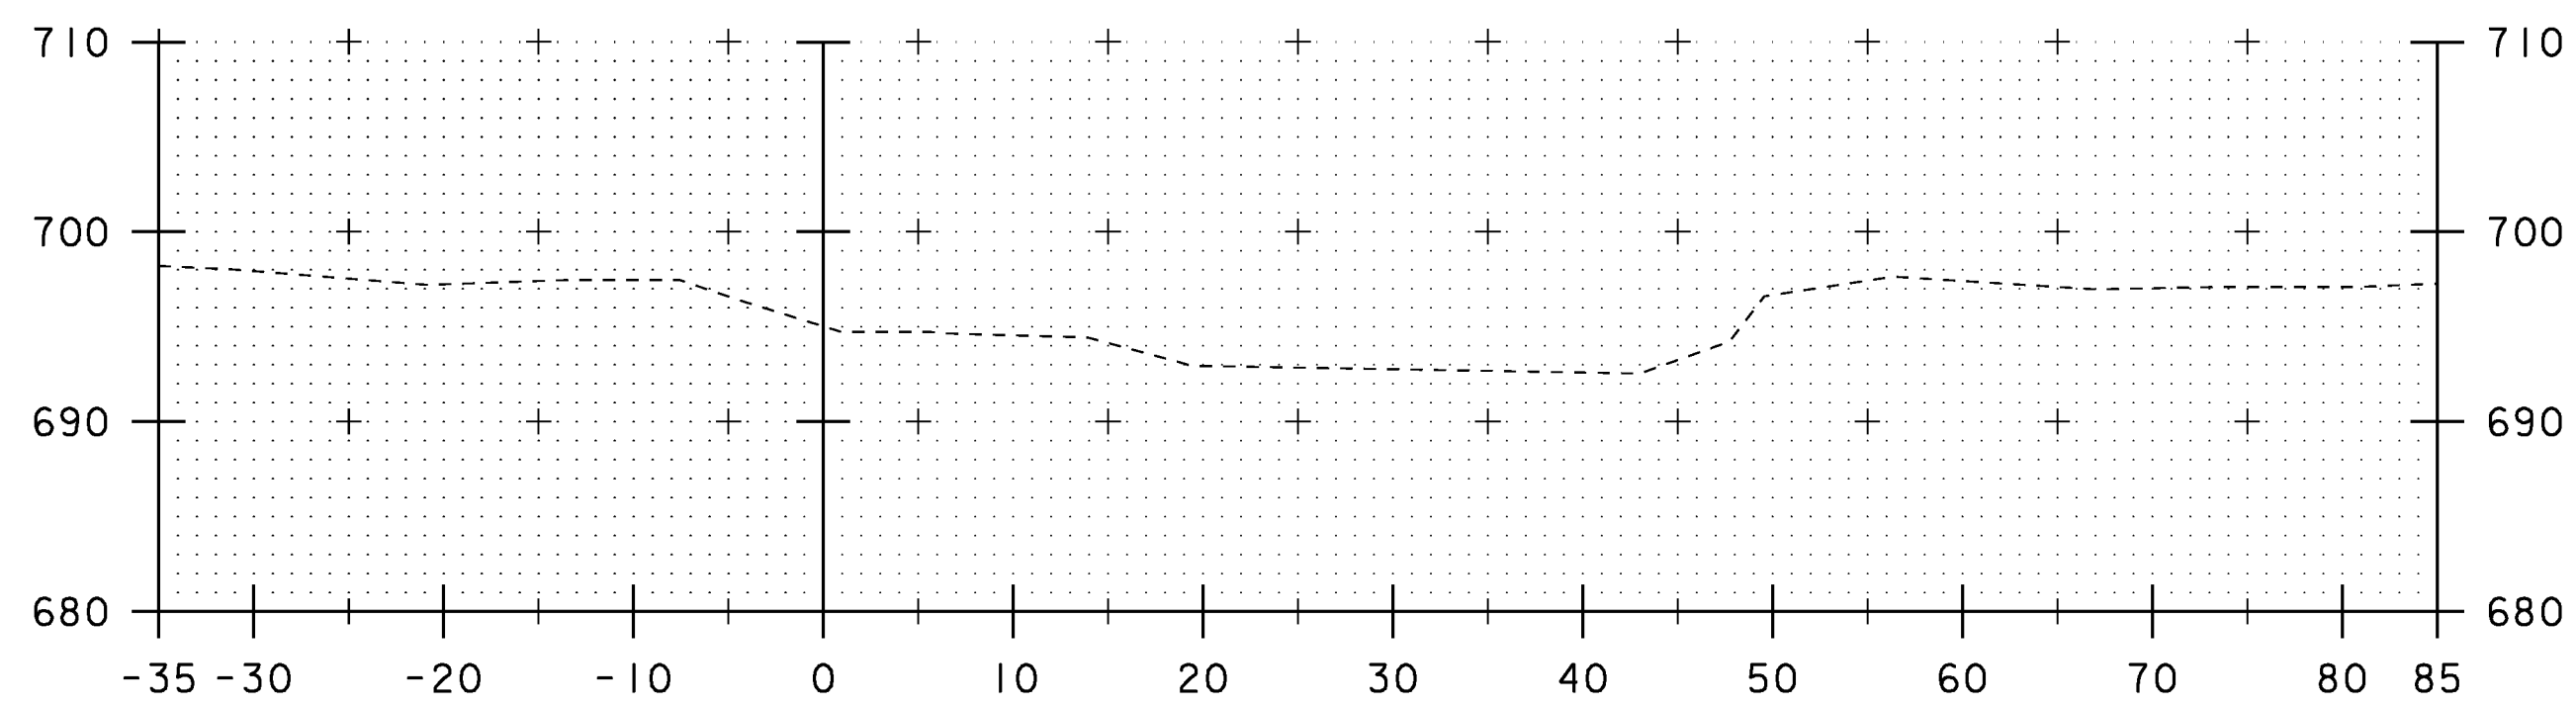


20+25

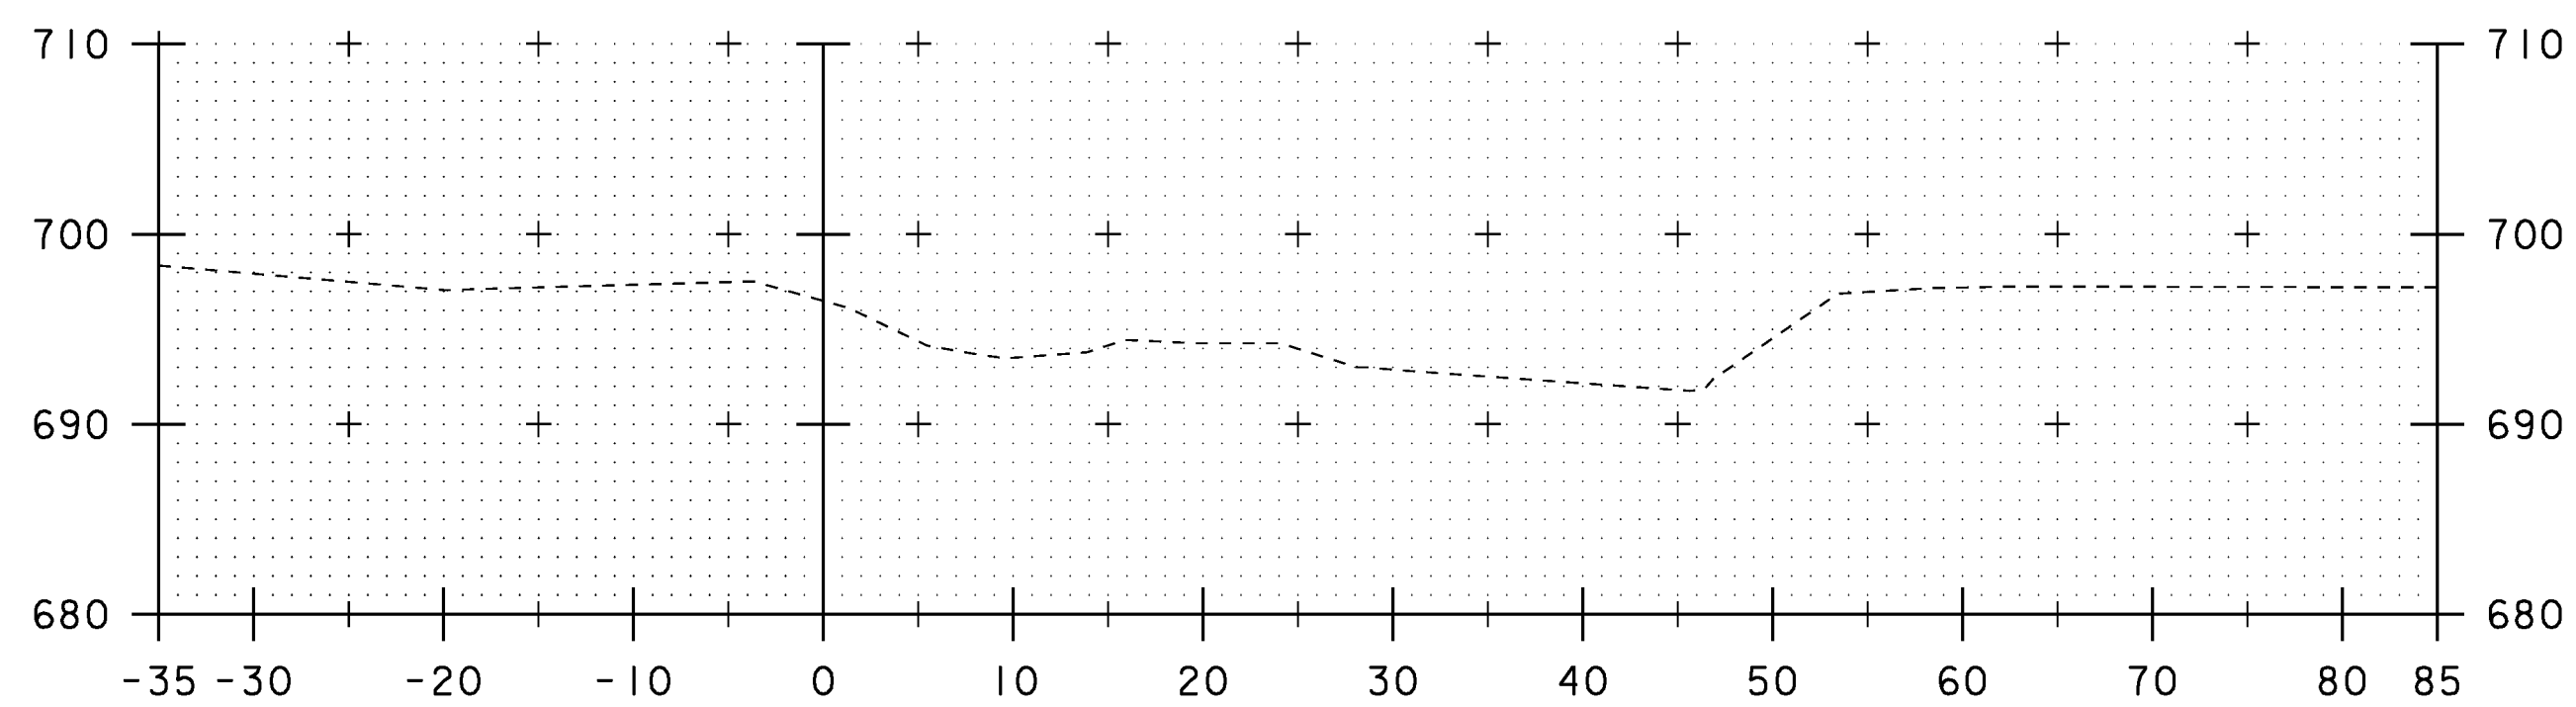


20+00

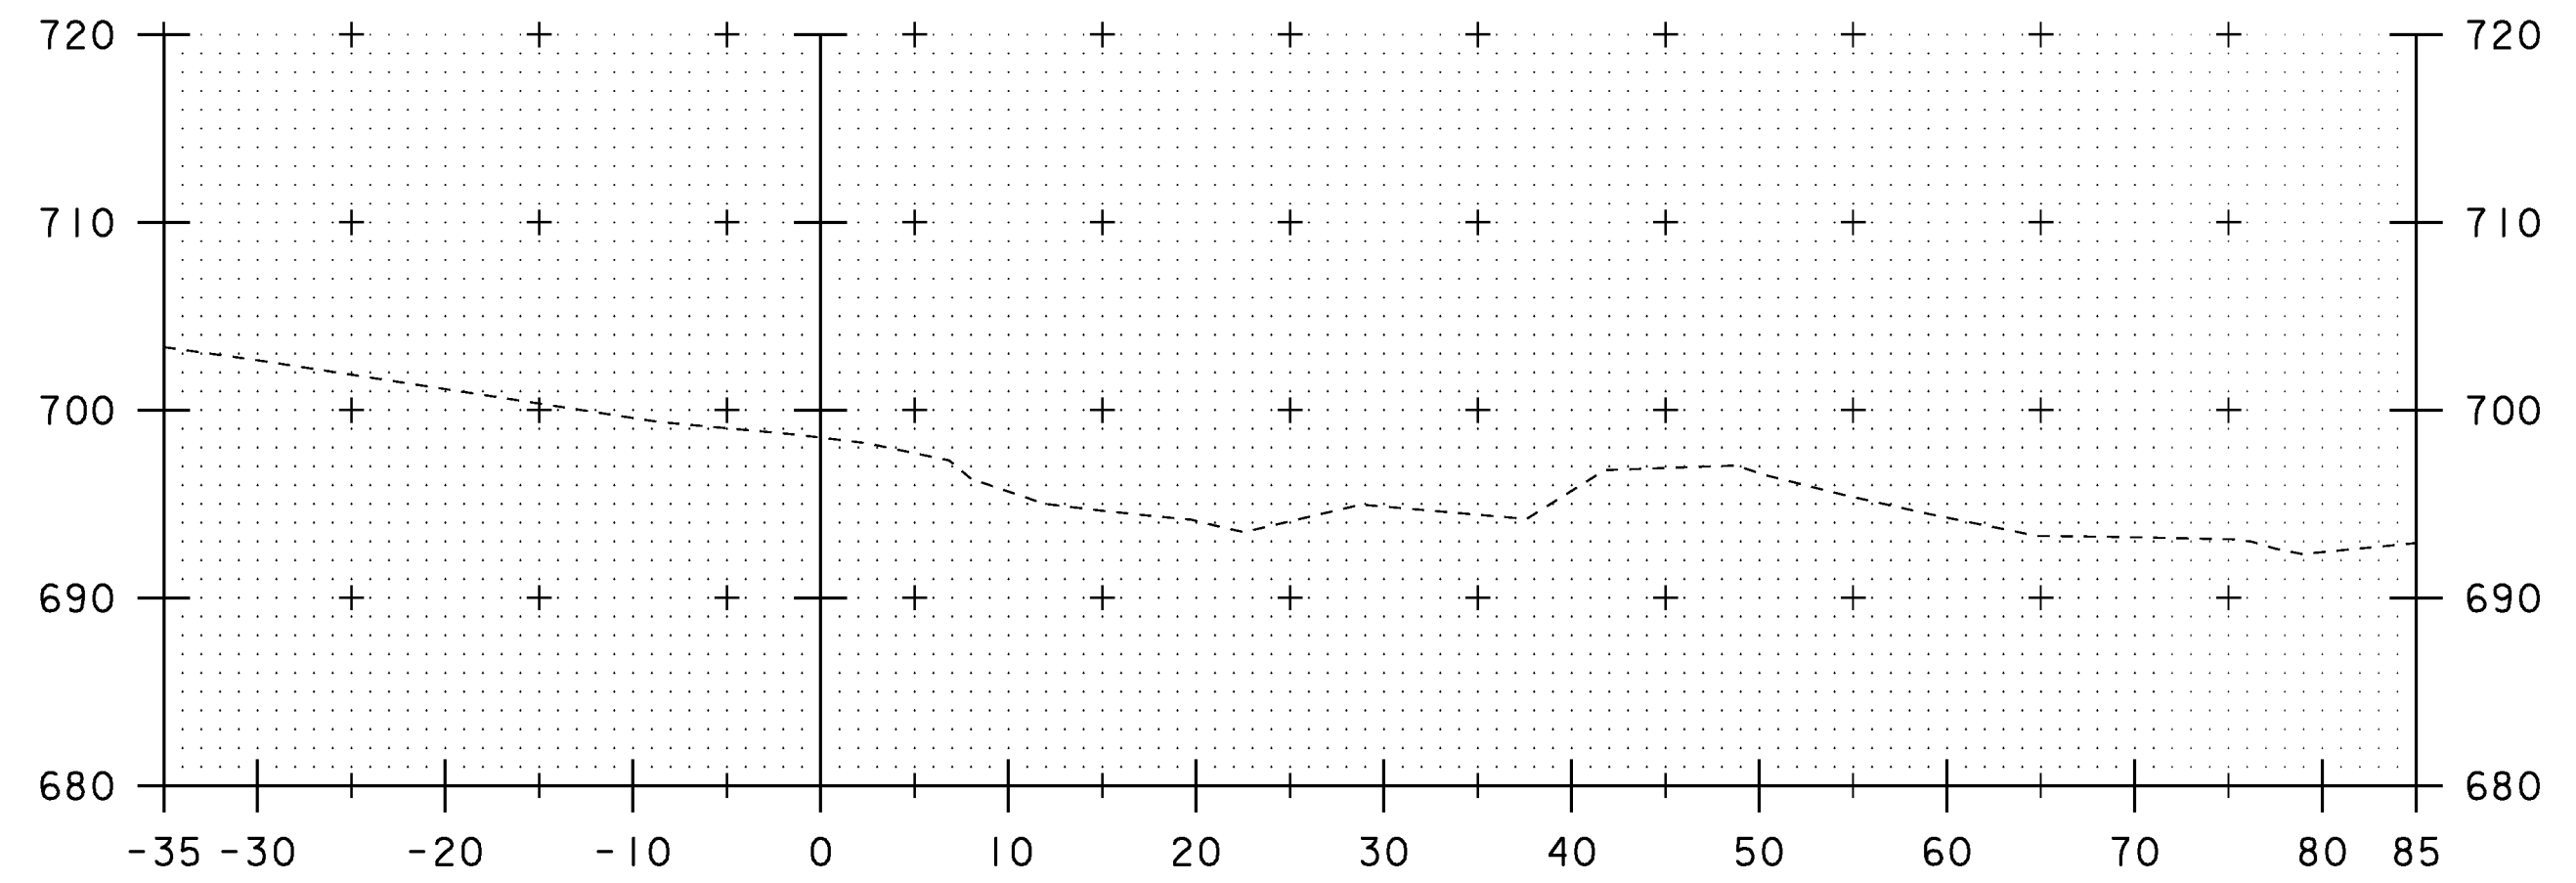

21+25

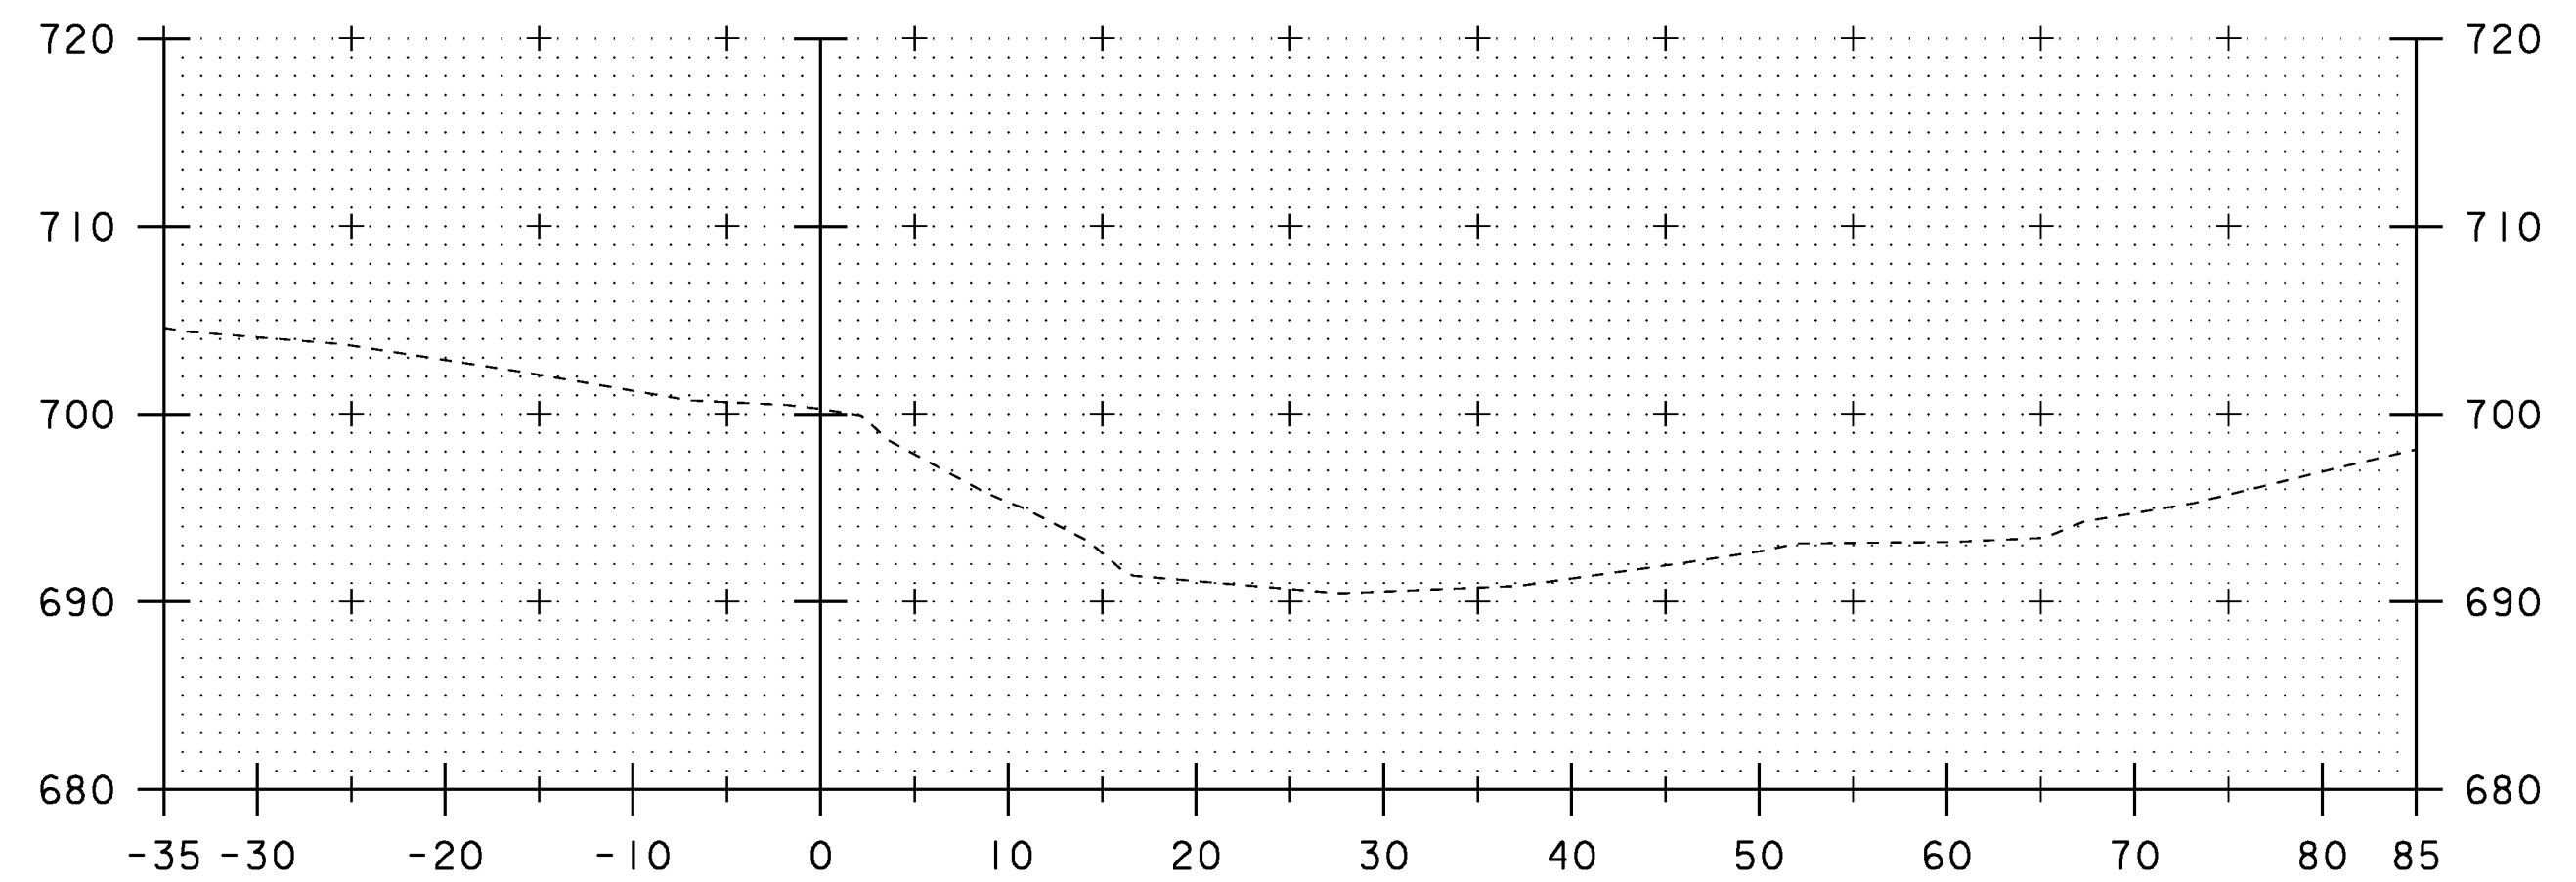

21+00

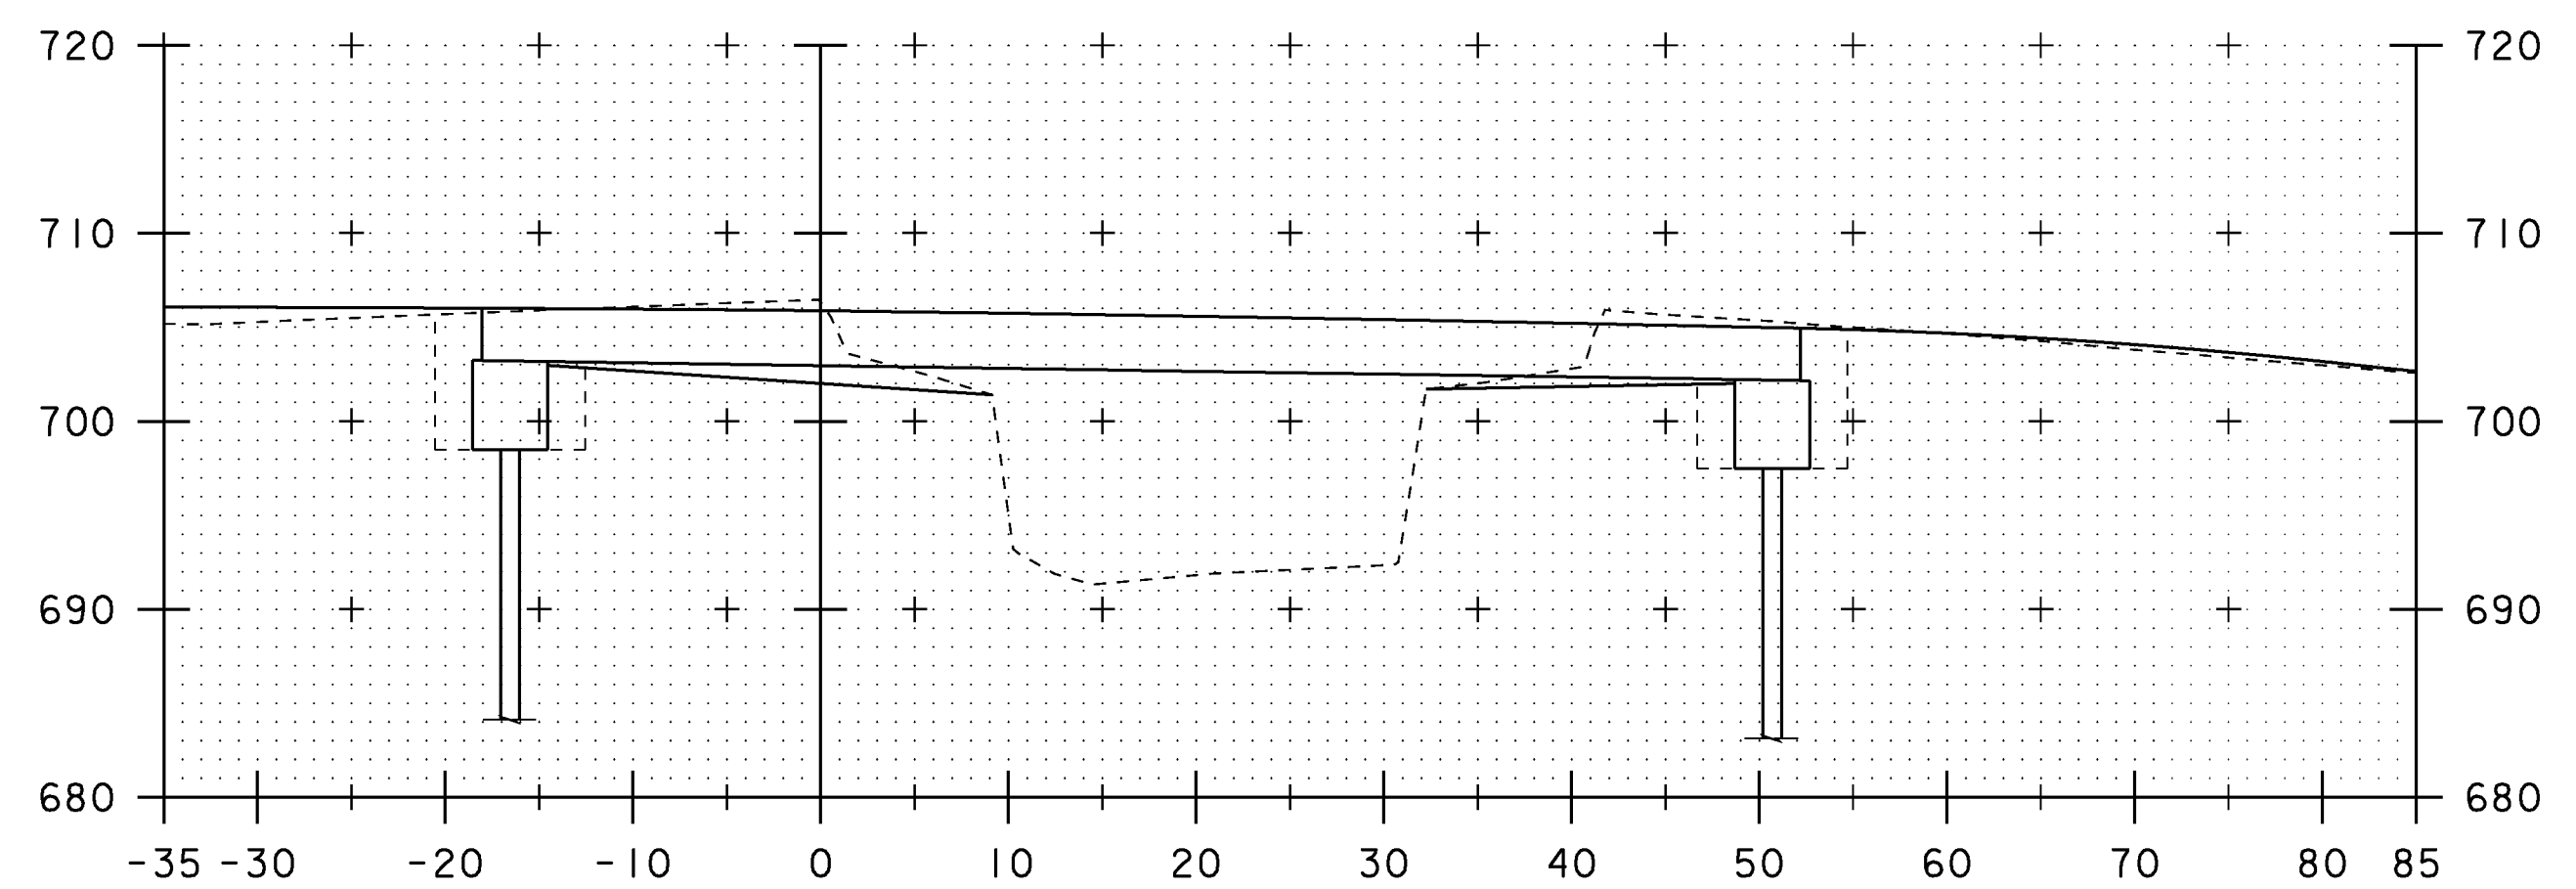

20+75

SCALE 1" = 10'-0"

STA. 20+00 TO STA. 21+25

PROJECT NAME: BRAINTREE	PLOT DATE: 31-DEC-2009
PROJECT NUMBER: BRO 1444(36)	DRAWN BY: T. FILLBACH
FILE NAME: s95j292xsl.dgn	CHECKED BY: R. PELLETT
PROJECT LEADER: K. HIGGINS	SHEET 26 OF 26
DESIGNED BY: T. FILLBACH	
CHANNEL SECTIONS	