


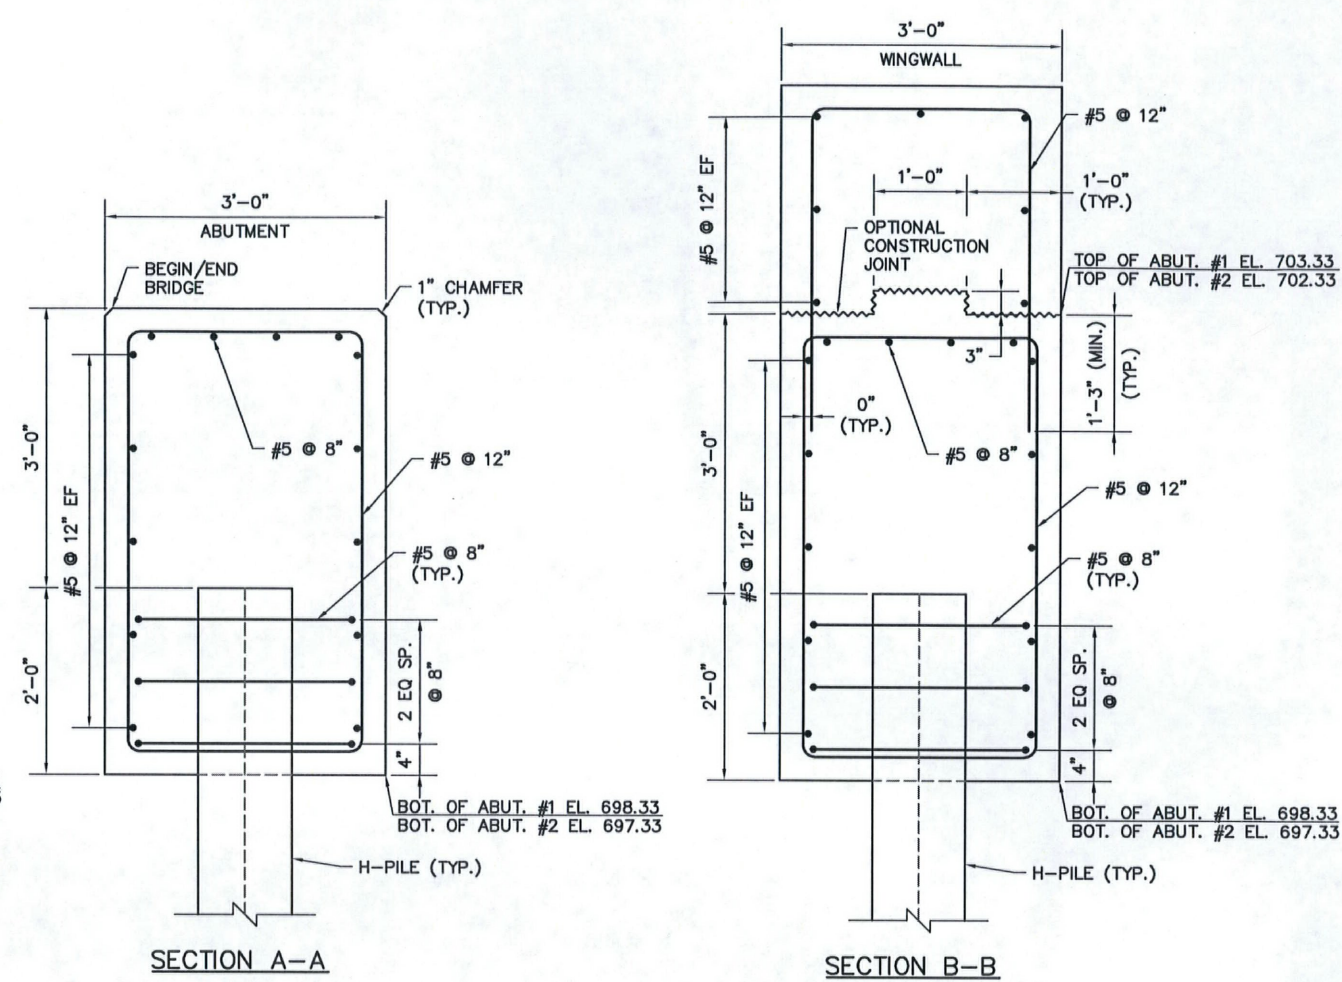

NOTE:
1. LAP LENGTH FOR ALL #5 BARS SHALL BE 2'-2"
2. ALL CONCRETE SHALL BE HIGH PERFORMANCE CLASS B MEETING SECTION 501 OF THE STANDARD SPECIFICATIONS FOR CONSTRUCTION