




TRANSVERSE SECTION  
SCALE: 1/4" = 1'-0"

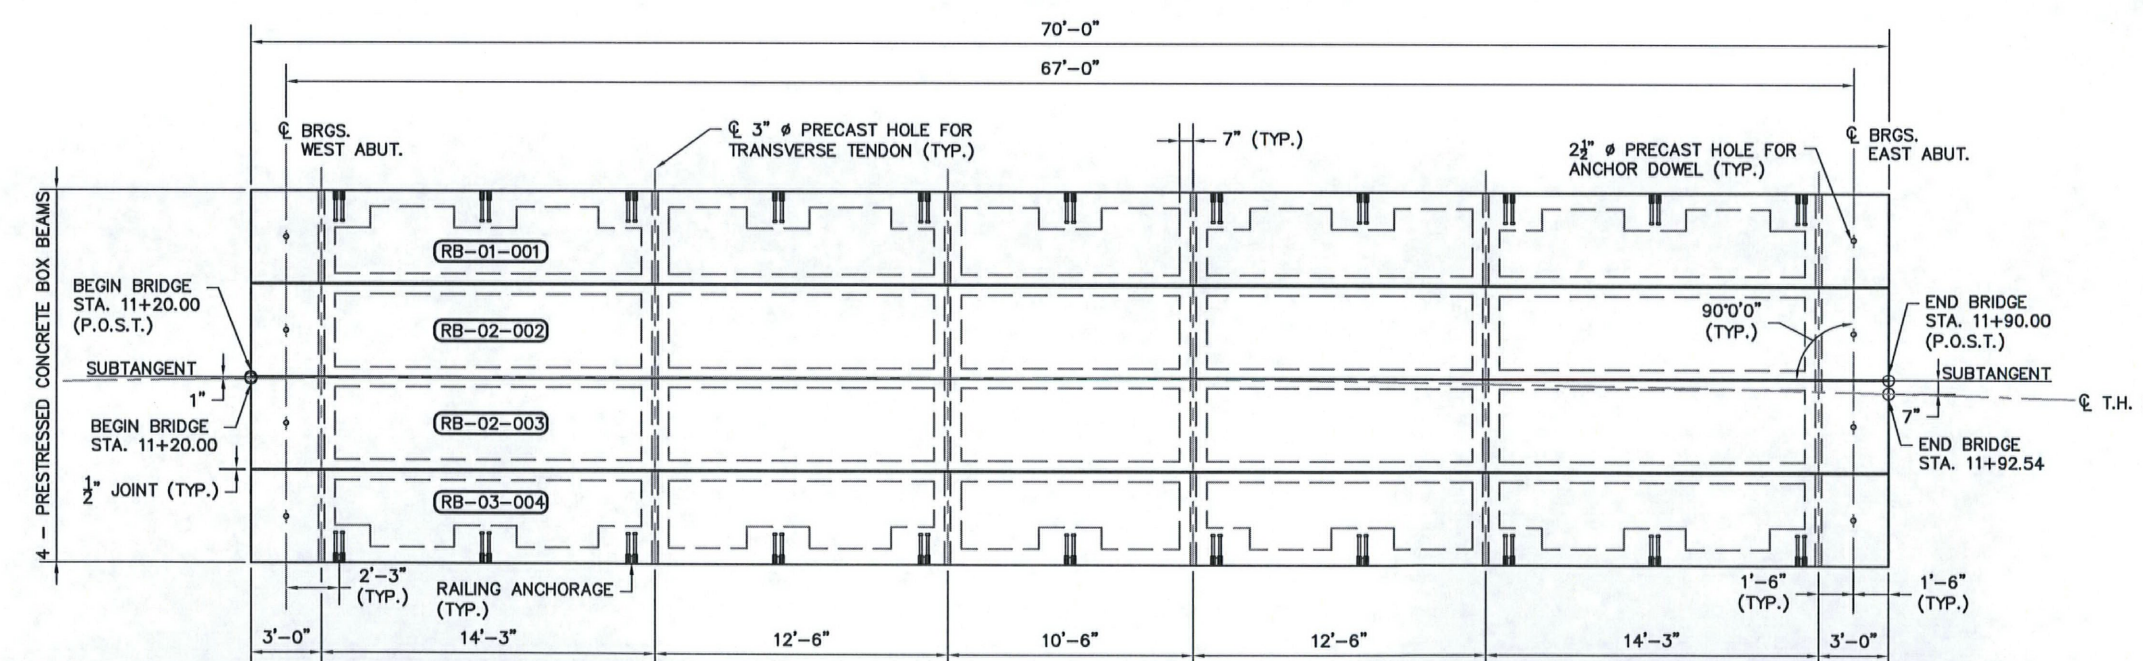

BEAM LAYOUT PLAN  
SCALE: 1/4" = 1'-0"

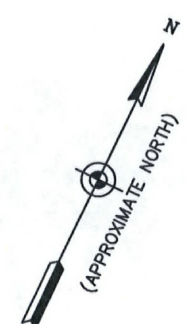


**Hoyle, Tanner & Associates, Inc.**  
125 College Street, 4th Floor, Burlington, VT 05401  
Tel: (802) 260-1331 Fax: (802) 260-4444 www.hoyletanner.com  
© Copyright 2010 Hoyle, Tanner & Associates, Inc.  
DESIGNED BY: JMS DRAWN BY: JMS CHECKED BY: JMS

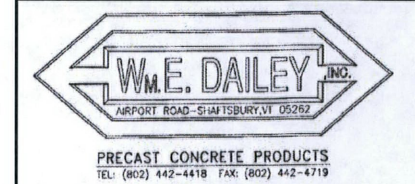

**BRAINTREE, VT**  
T.H. 23 CLASS III  
BRIDGE #12  
PROJECT NO: BRO 1444 (36)  
**SHEET 1 OF 5**

Vermont Agency of Transportation  
**RECEIVED**  
CHK'D BY: Timothy F. Bink, OK'D BY: JMS  
3:26 pm, Jul 21, 2010  
RESUBMIT BY: DATE APPROVED AS NOTED DATE

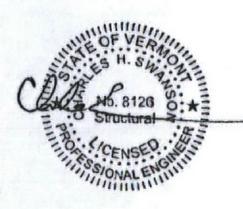

032 Pot Bean