



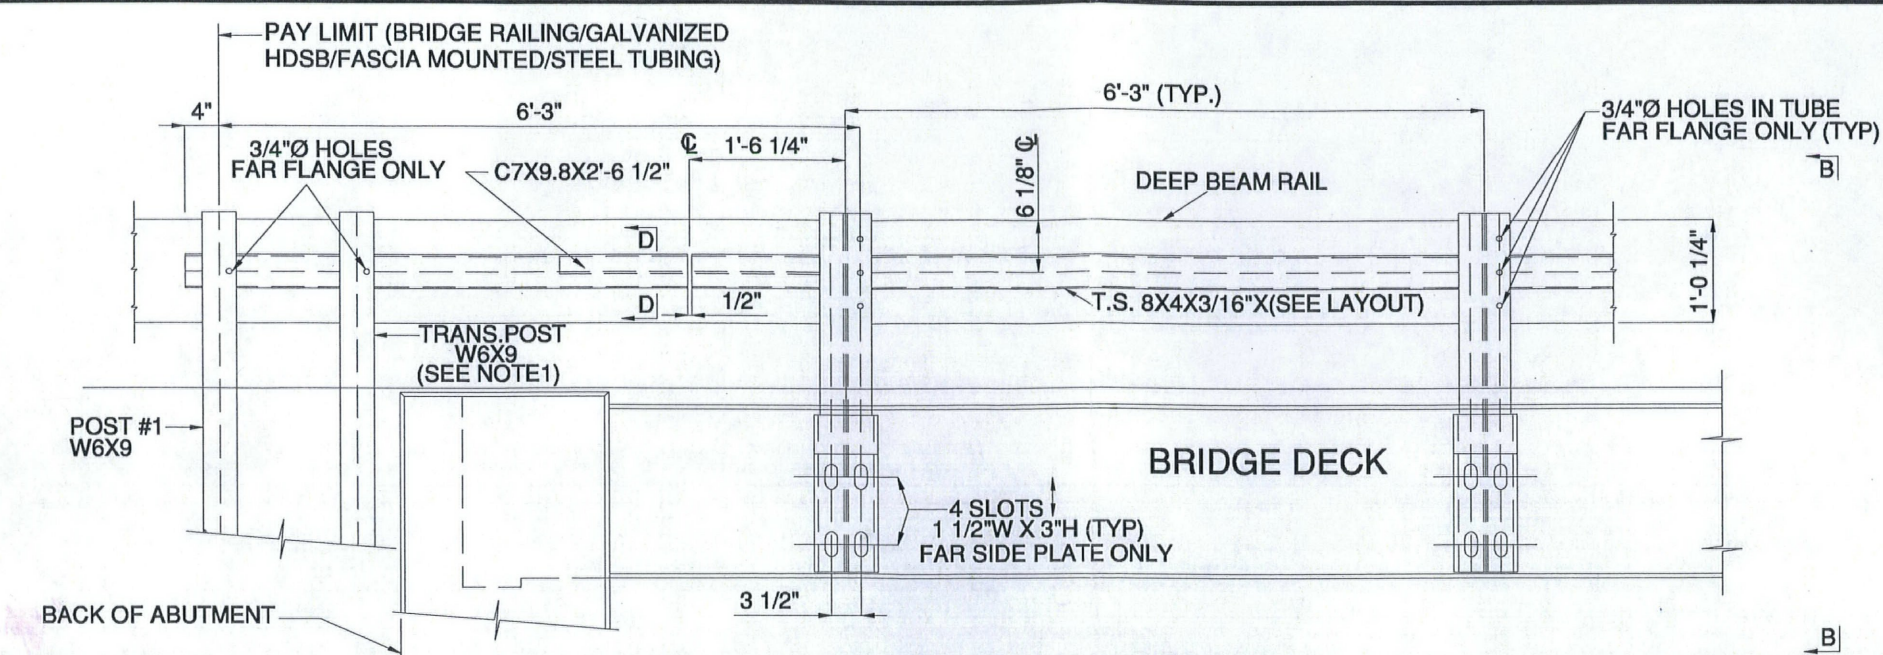

NOTE 1: LOCATE TRANSITION POST AS CLOSE TO ABUTMENT WALL AS PRACTICAL

RAILING ELEVATION

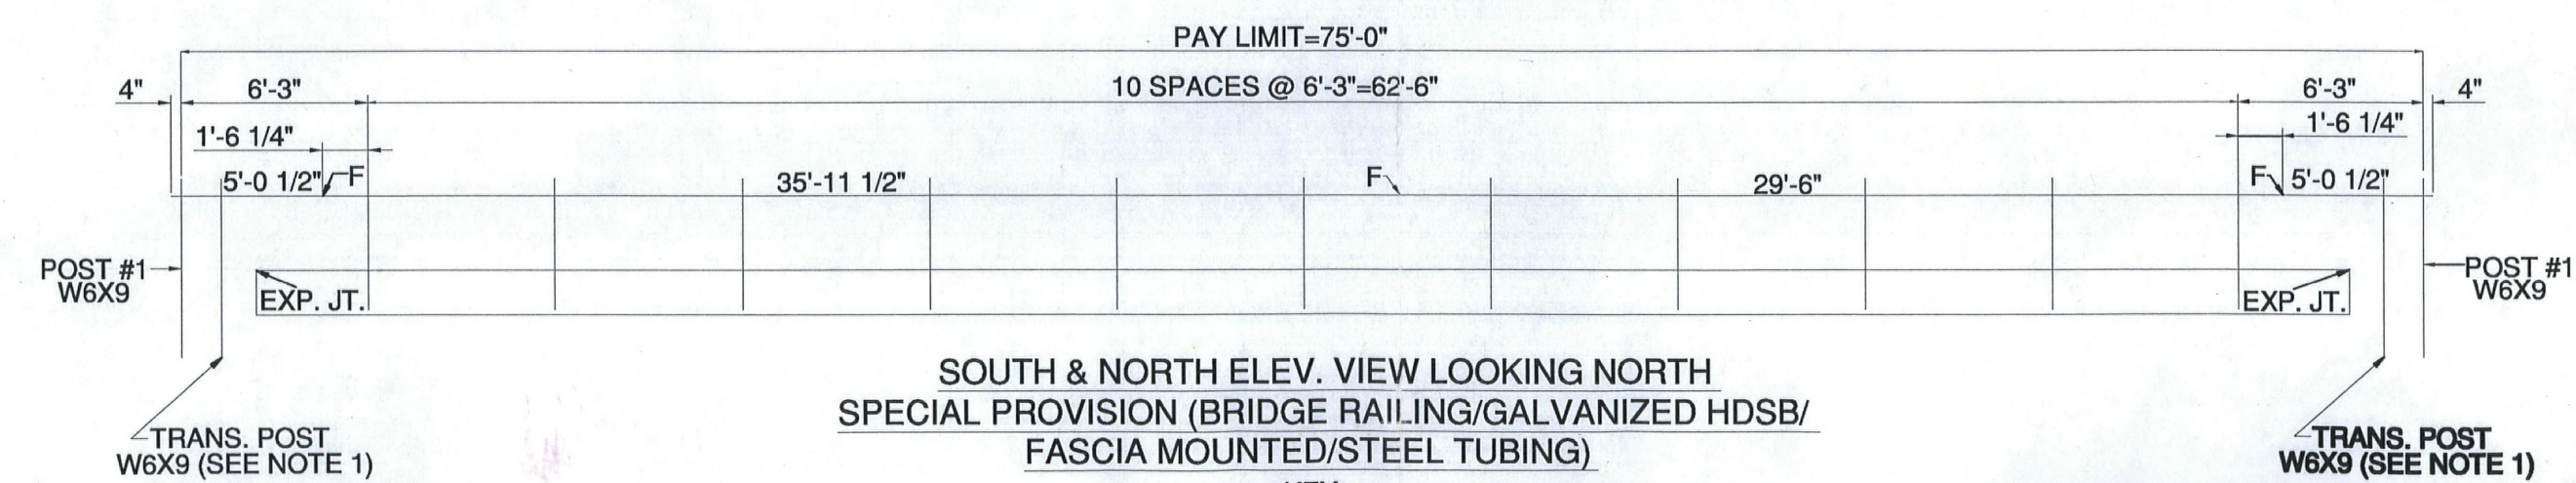

SOUTH & NORTH ELEV. VIEW LOOKING NORTH
SPECIAL PROVISION (BRIDGE RAILING/GALVANIZED HDSS/
FASCIA MOUNTED/STEEL TUBING)

KEY:
F=1/2" SPL. JT.

NOTES: FOR SECTION VIEWS B-B & D-D SEE SHEET 2 OF 3.

Vermont Agency of Transportation

RECEIVED
CK'D BY TCF OK'D BY JTS

9:09 am, Apr 27, 2010

RESUBMIT APPROVED X
BY KMH DATE 4-27-10

ALL DIMENSIONS MUST BE FIELD VERIFIED
BY CONTRACTOR PRIOR TO FABRICATION

DRAWN BY: JJP	DATE 4/9/10	CHECKED BY: DCK	SHEET NO. 1 OF 3
BRIDGE RAILING LAYOUT VERMONT AGENCY OF TRANSPORTATION NEWARD ROAD BRIDGE (STA. 11+55.00) OVER AYER'S BROOK IN THE TOWN OF BRANTREE IN THE COUNTY OF ORANGE			
CONT. NO. BRO 1444(26)	REGION NO. N/A		
GEN. CONT. RENAUD BROTHERS, INC.			
ERECTOR: VERMONT RECREATIONAL SURFACING & FENCING, INC.			
FABRICATOR: DI HIGHWAY SIGN & STRUCTURE CORPORATION P.O. BOX 123(40 GREENMAN AVE.) NEW YORK MILLS, N.Y. 13417	JOB NO. V04-02		

039 Bridge Rail