


SEE SHEET 2 FOR
INDEX OF SHEETS
AND LIST OF STANDARDS

STATE OF VERMONT AGENCY OF TRANSPORTATION

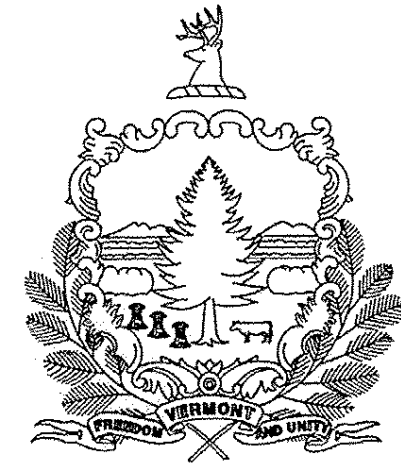


PROPOSED IMPROVEMENT BRIDGE PROJECT TOWN OF BRAINTREE COUNTY OF ORANGE

ROUTE NO : TH 23 CLASS III BRIDGE NO : 12


PROJECT LOCATION : LOCATED ON TH 23 APPROXIMATELY 0.1 MILES
FROM ITS JUNCTION WITH VT ROUTE 12.

PROJECT DESCRIPTION : REPLACEMENT OF BRIDGE 12 WITH RELATED ROADWAY
APPROACH WORK.

LENGTH OF STRUCTURE : 70 FEET.
LENGTH OF ROADWAY : 80 FEET.
LENGTH OF PROJECT : 150 FEET.

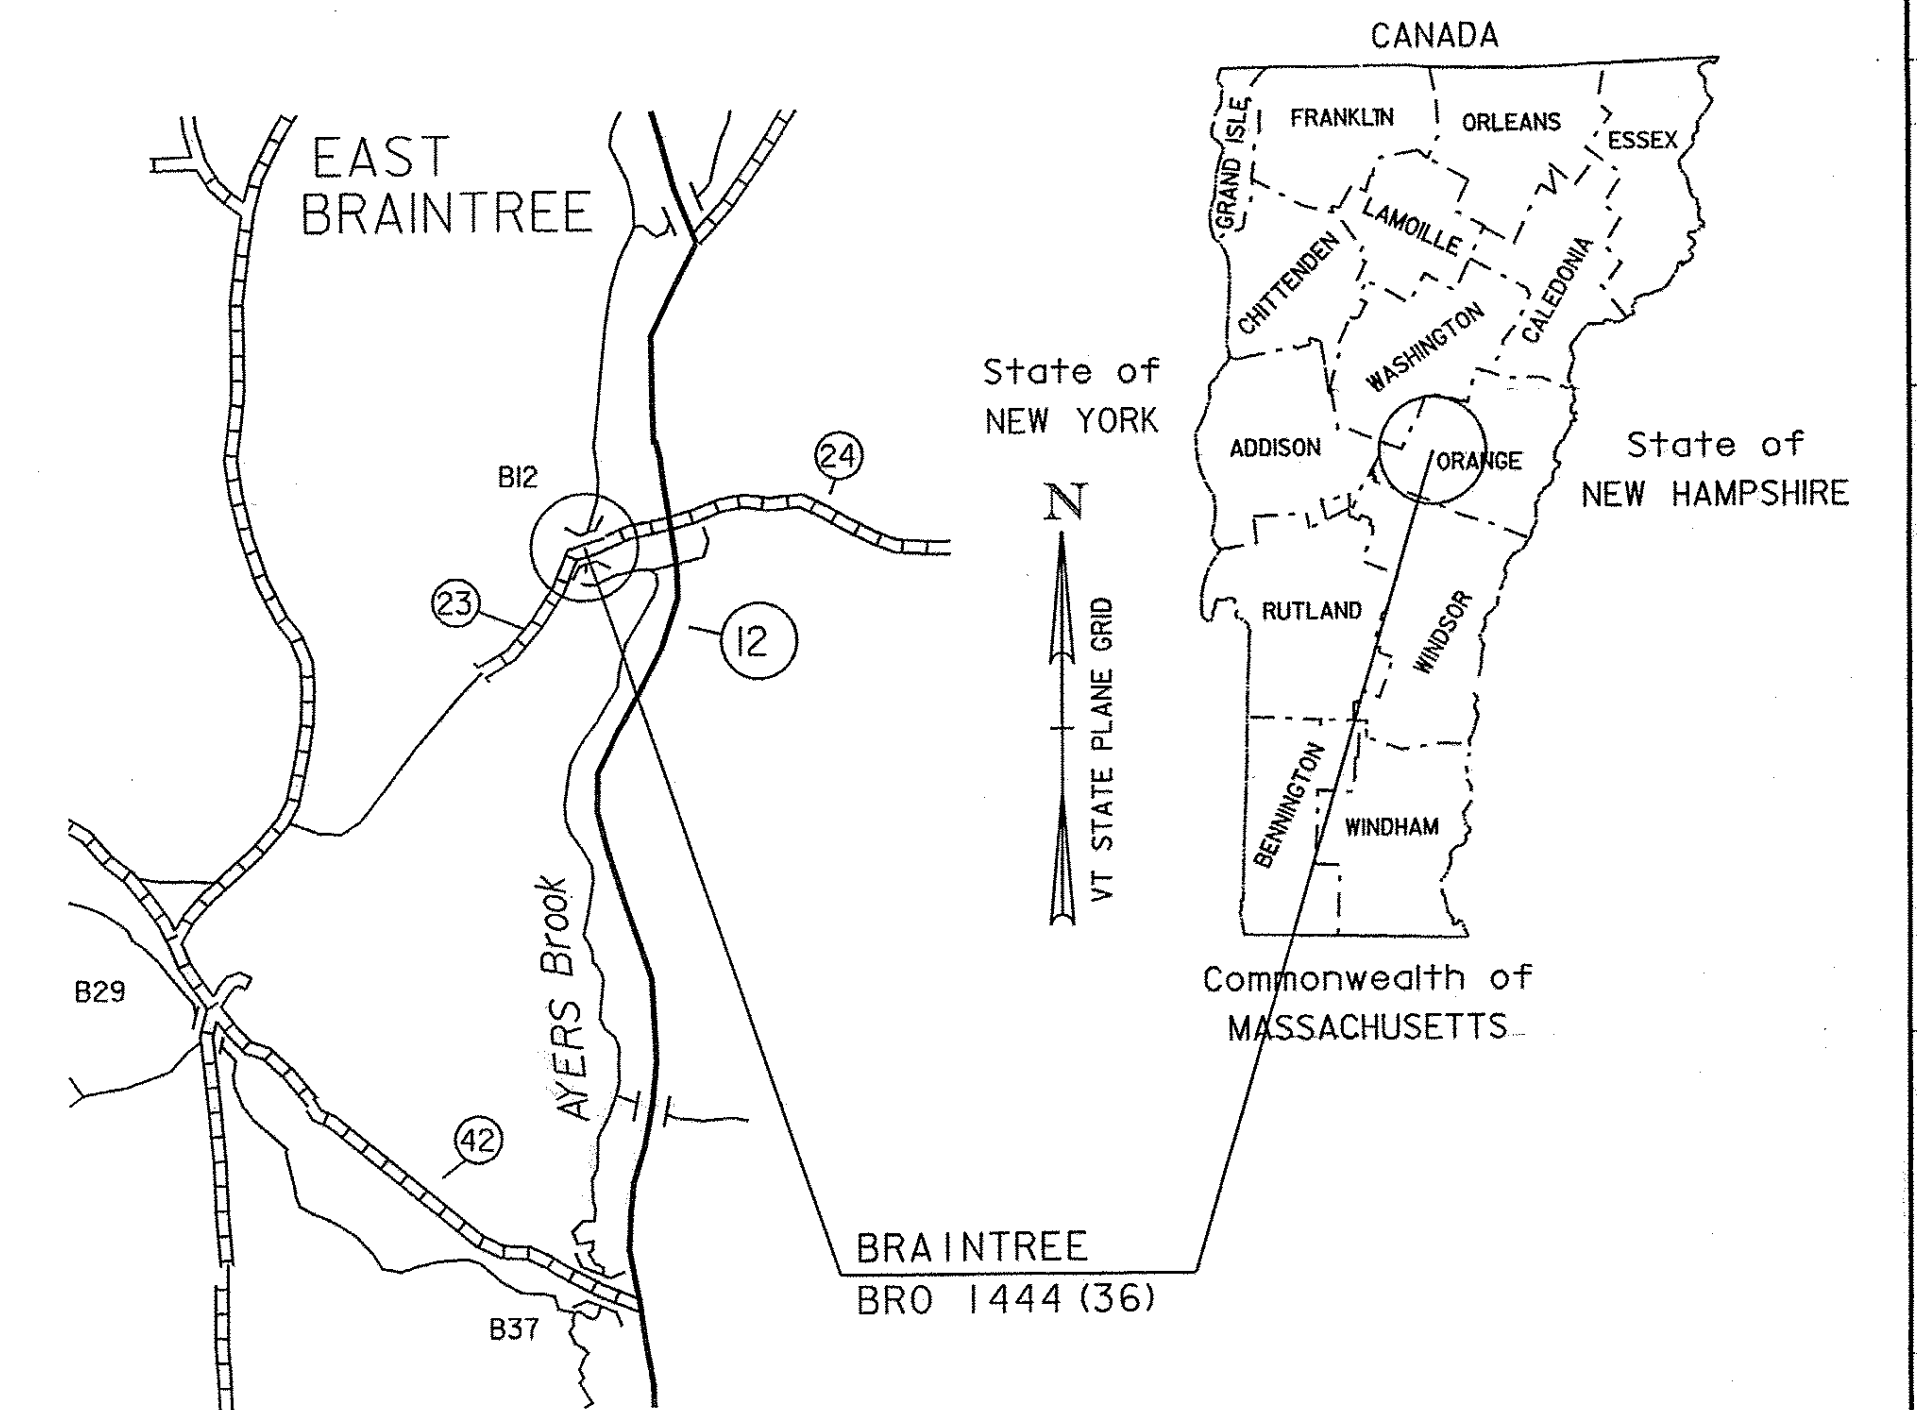

RECORD PLANS	
CONTRACTOR:	RENAUD BROTHERS, INC. - VERNON, VT
RESIDENT ENGINEER:	JEREMY REED
CONSTRUCTION BEGAN:	SEPTEMBER 14, 2010
CONSTRUCTION COMPLETE:	OCTOBER 13, 2010
RECORD PLANS BY:	JEREMY REED & NICK GARBACIK
I HEREBY CERTIFY THAT ALL THE CONSTRUCTION REQUIRED BY THIS SET OF DRAWINGS HAS BEEN ACCOMPLISHED AS INDICATED HEREIN.	
BY	<i>Jeremy Reed</i> RESIDENT ENGINEER
DATE	3/30/2013
NOTE: Any further information concerning final quantities, amounts or other details relative to this project may be found at Central Files in the electronic archives.	

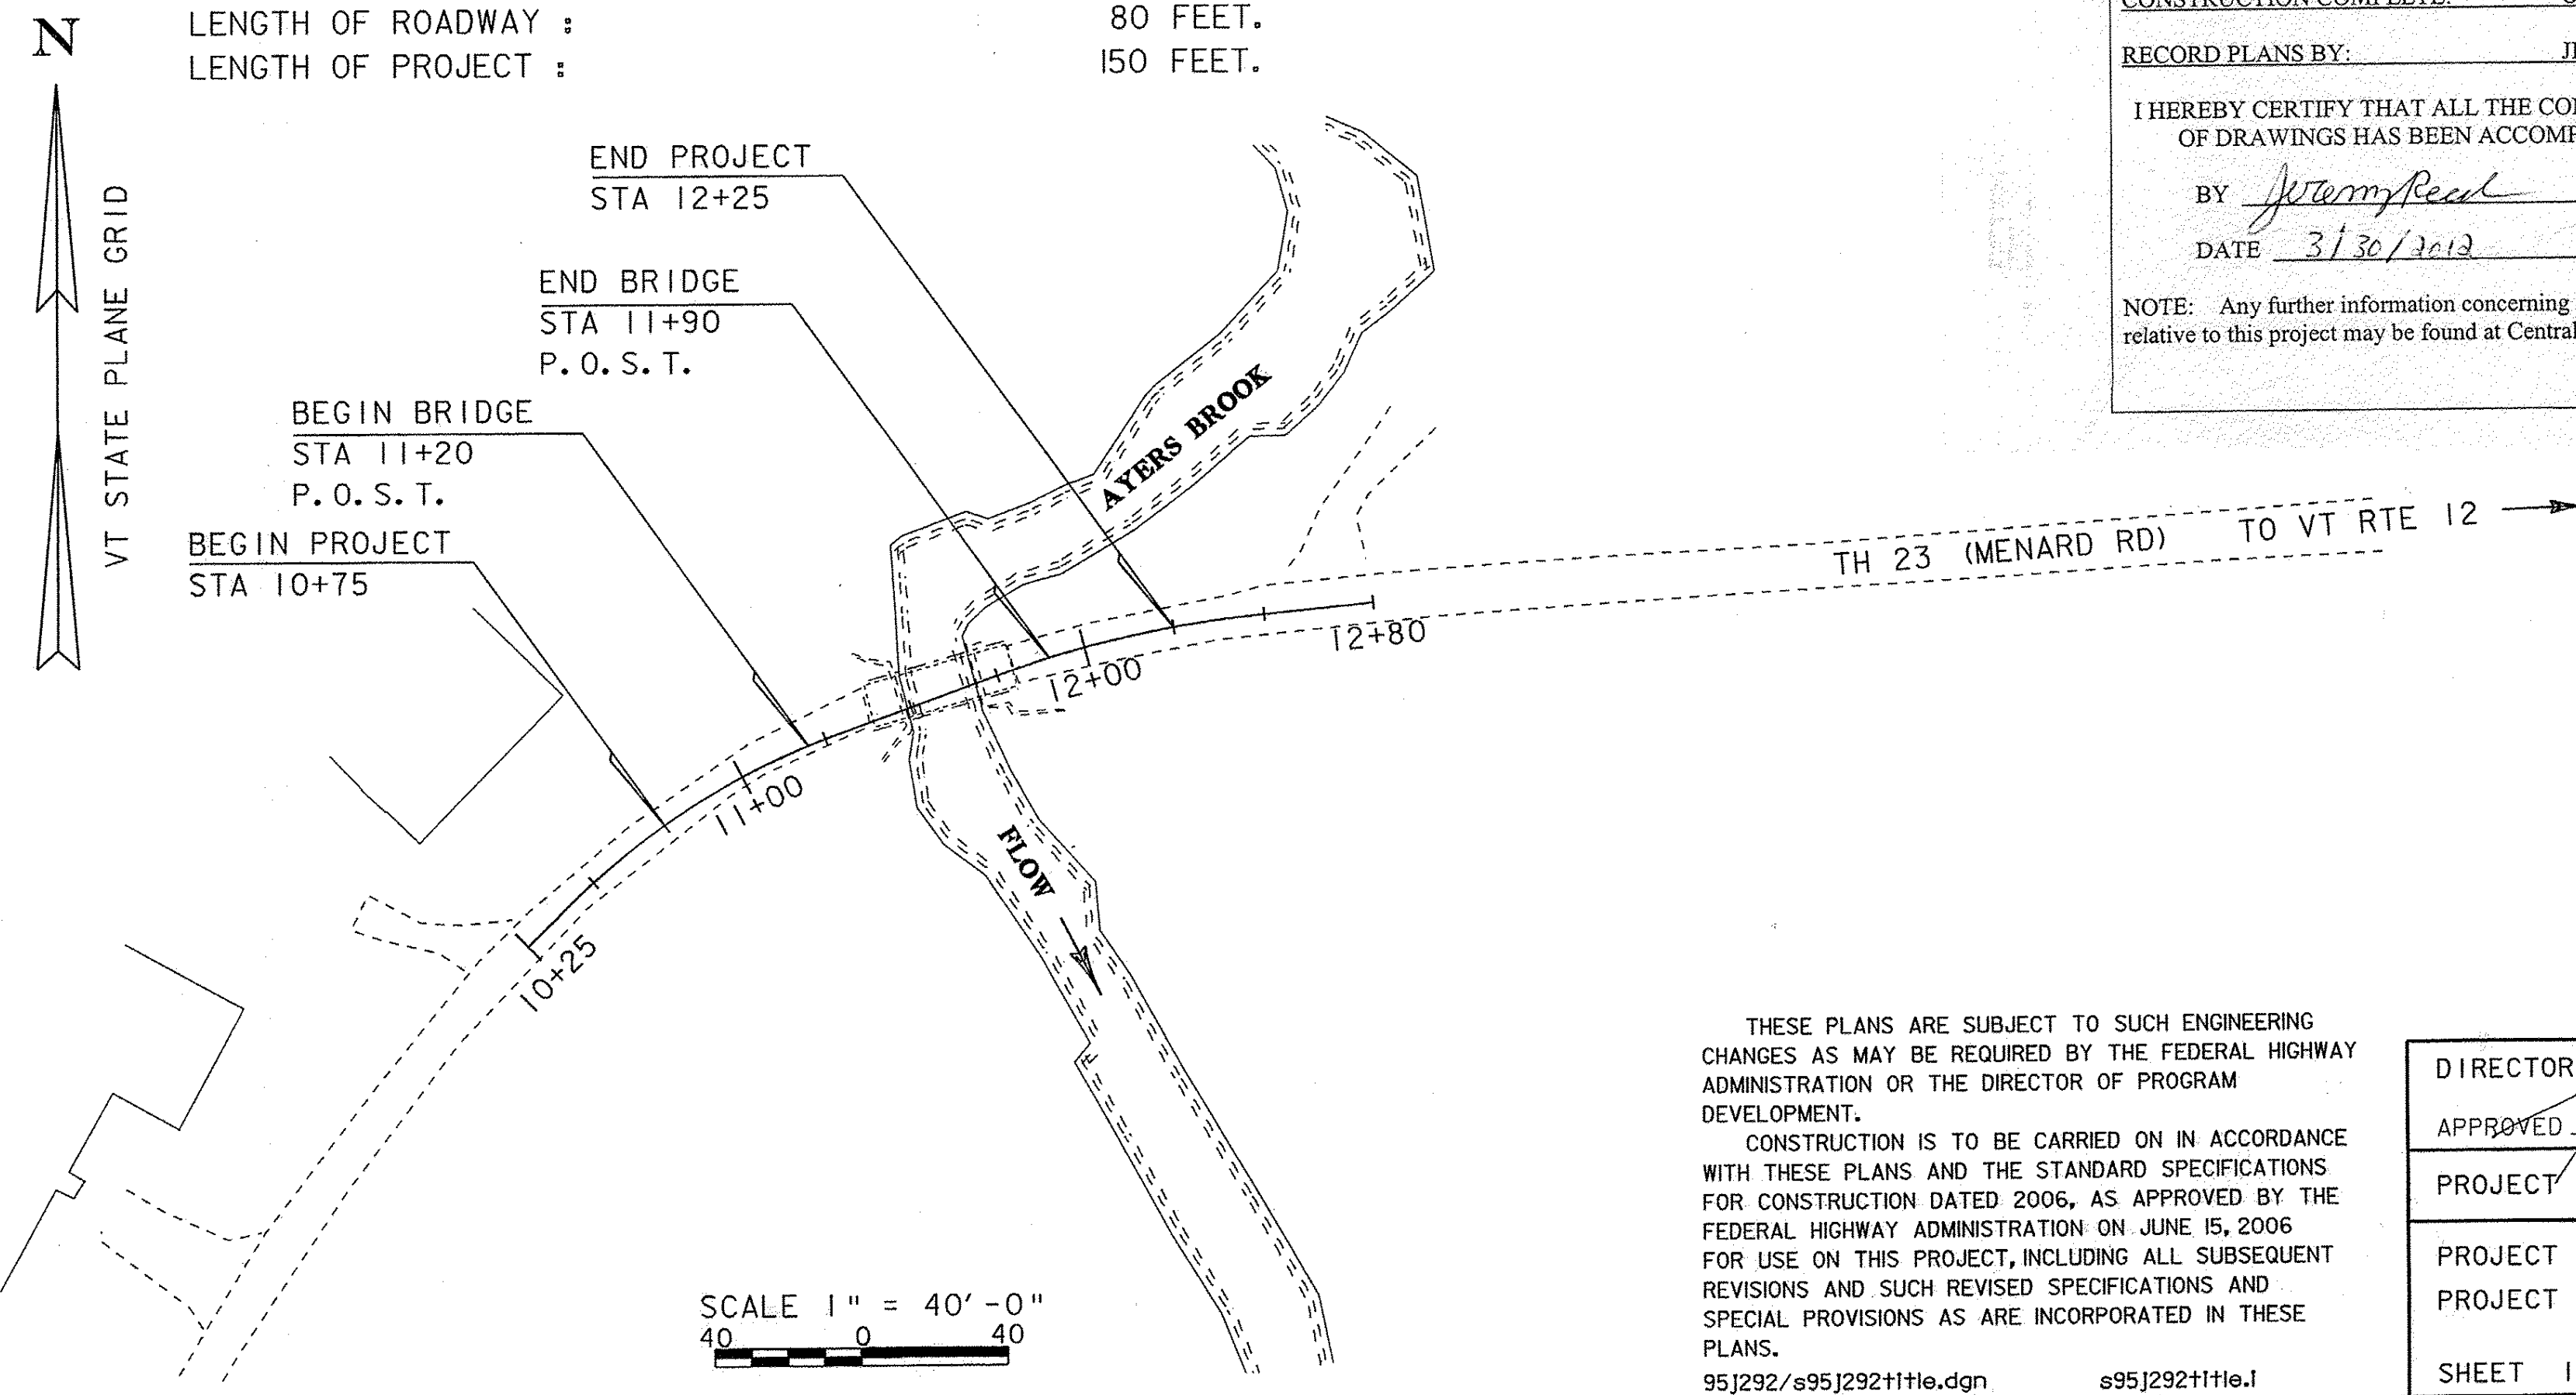

CONVENTIONAL SYMBOLS	
COUNTY LINE	
TOWN LINE	
LIMITS OF ACCESS	
POINT OF ACCESS	
FENCE LINE	
STONE WALL	
TRAVELED WAY	
GUARD RAIL	
RAILROAD	
SURVEY LINE	
CULVERT	
POWER POLE	
TELEPHONE POLE	
TREES	
CONTROL OF ACCESS	
PROPERTY LINE	
R.O.W. TAKING LINE	
SLOPE RIGHTS	
TOP OF CUT	
TOE OF SLOPE	

SURVEYED BY : GILMAN/MOREAU
SURVEYED DATE : 10/03/1996

DATUM
VERTICAL NAVD 88
HORIZONTAL NAD 83 (92)

THESE PLANS ARE SUBJECT TO SUCH ENGINEERING CHANGES AS MAY BE REQUIRED BY THE FEDERAL HIGHWAY ADMINISTRATION OR THE DIRECTOR OF PROGRAM DEVELOPMENT.

CONSTRUCTION IS TO BE CARRIED ON IN ACCORDANCE WITH THESE PLANS AND THE STANDARD SPECIFICATIONS FOR CONSTRUCTION DATED 2006, AS APPROVED BY THE FEDERAL HIGHWAY ADMINISTRATION ON JUNE 15, 2006 FOR USE ON THIS PROJECT, INCLUDING ALL SUBSEQUENT REVISIONS AND SUCH REVISED SPECIFICATIONS AND SPECIAL PROVISIONS AS ARE INCORPORATED IN THESE PLANS.

95J292/95J29211He.dgn 95J29211He.J

DIRECTOR OF PROGRAM DEVELOPMENT	
APPROVED <i>Richard Johnson</i>	DATE 12-29-09
PROJECT MANAGER : K.M. HIGGINS	
PROJECT NAME :	BRAINTREE
PROJECT NUMBER :	BRO 1444 (36)
SHEET 1 OF 26 SHEETS	

SCALE 1" = 40'-0"

PRELIMINARY INFORMATION SHEET (BRIDGE)

LRFD

INDEX OF SHEETS

FINAL HYDRAULIC REPORT

PLAN SHEETS

1	TITLE SHEET
2	PRELIMINARY INFORMATION (BRIDGE)
3	GENERAL NOTES
4 - 5	QUANTITY SHEETS
6	TYPICAL SECTIONS
7	TIE SHEET
8	LAYOUT SHEET
9	PROFILE SHEET
10	EPSC NARRATIVE
11	EPSC EXISTING CONDITIONS
12	BORING LAYOUT SHEET
13	BORING LOGS
14	PLAN AND ELEVATION
15	FRAMING PLAN
16 - 17	BOX BEAM DETAILS #1-#2
18	BEARING DETAILS
19	ABUTMENTS
20	RETAINING WALL
21	RAL LAYOUT SHEET
22	RAL DETAIL
23 - 25	MAINLINE SECTIONS
26	CHANNEL SECTIONS

STANDARDS LIST

E-100	CONSTRUCTION APPROACH SIGNS	2-Jan-04
E-100A	SIDE ROAD CONSTRUCTION - APPROACH SIGNS	2-Jan-04
E-101	CONSTRUCTION SIGN DETAILS	30-May-03
E-102	CONSTRUCTION SIGN DETAILS	30-Jun-03
E-102A	CONSTRUCTION SIGN DETAILS	1-May-04
E-106	TRAFFIC CONTROL- MISCELLANEOUS DETAILS	1-Mar-04
E-107	DELINEATION, BARRICADES AND DETOURS FOR CONSTRUCTION AREAS	30-Jun-03
E-107A	BREAKAWAY BARRICADE DETAILS	8-Jun-09
E-108	CONSTRUCTION ZONE LONGITUDINAL DROP OFFS	8-Jun-09
E-120	STANDARD SIGN PLACEMENT - EXPRESSWAY & FREEWAY	8-Aug-95
E-121	STANDARD SIGN PLACEMENT - CONVENTIONAL ROAD	8-Aug-95
E-138	MILE MARKER DETAILS - STATE & TOWN HIGHWAYS	30-May-03
E-150	WARNING SIGN DETAILS	1-May-04
E-151	WARNING SIGN DETAILS	1-May-04
E-160	FLANGED CHANNEL STEEL SIGN POST	20-May-99
E-161	W-SHAPED STEEL SIGN POST	18-Aug-95
E-162	TUBULAR ALUMINUM SIGN POST	20-May-99
E-163	TUBULAR STEEL SIGN POST	20-May-99
E-164	SQUARE STEEL SIGN POST	8-Jun-09
E-197	DELINEATOR PLACEMENT TYPICAL	1-Apr-05
E-198	DELINEATOR SAND MILE POSTS	1-Apr-05
E-199	DELINEATOR AND MILE POST MOUNTING ON BRIDGE RAIL	1-Apr-05
G-1	STEEL BEAM GUARDRAIL DETAILS (POST, DELINEATOR, TYPICALS)	3-Jan-00
G-1D	STEEL BEAM GUARDRAIL DETAILS (END TERMINAL, ANCHOR, MEDIAN)	3-Jan-00
SB-R6-82	BRIDGE RAILING - HEAVY DUTY STEEL BEAM	6-Jan-95

HYDROLOGIC DATA

Date: Sept 2009

DRAINAGE AREA : 18.8 sq. mi.
 CHARACTER OF TERRAIN : Rural, mixed forest and open, moderate to steep slopes
 STREAM CHARACTERISTICS : Incised, unstable stream banks
 NATURE OF STREAMBED : Sand, gravel and cobbles

PEAK FLOW DATA

Q 2.33 =	700 cfs	Q 50 =	2275 cfs
Q 10 =	1400 cfs	Q 100 =	2700 cfs
Q 25 =	1850 cfs	Q 500 =	3500 cfs

DATE OF FLOOD OF RECORD: November 1927
 ESTIMATED DISCHARGE: Unknown
 WATER SURFACE ELEV.: Unknown
 NATURAL STREAM VELOCITY: @ Q25 = 10.2 fps
 ICE CONDITIONS: Moderate
 DEBRIS: Moderate
 DOES THE STREAM REACH MAXIMUM HIGHWATER ELEV. RAPIDLY? Yes
 IS ORDINARY RISE RAPID? Yes
 IS STAGE AFFECTED BY UPSTREAM OR DOWNSTREAM CONDITIONS? No
 IF YES, DESCRIBE: N/A

WATERSHED STORAGE: < 1% HEADWATERS:
 UNIFORM: X
 IMMEDIATELY ABOVE SITE:

EXISTING STRUCTURE INFORMATION

STRUCTURE TYPE: Temporary Mabey bridge
 YEAR BUILT: Original structure built in 1929
 CLEAR SPAN(NORMAL TO STREAM): 21'
 VERTICAL CLEARANCE ABOVE STREAMBED: ~11'
 WATERWAY OF FULL OPENING: 220 sq. ft.
 DISPOSITION OF STRUCTURE: Remove and replace superstructure
 TYPE OF MATERIAL UNDER SUBSTRUCTURE: See borings

WATER SURFACE ELEVATIONS AT:

Q2.33 =	697.8'	VELOCITY =	7.2 fps
Q10 =	700.5'	"	11.8 fps
Q25 =	701.7'	"	14.2 fps
Q50 =	702.3'	"	14.6 fps
Q100 =	703.7'	"	11.2 fps

LONG TERM STREAMBED CHANGES: Channel has moved laterally within floodplain over time.

IS THE ROADWAY OVERTOPPED BELOW Q100: Yes
 FREQUENCY: Q25
 RELIEF ELEVATION: 701.1'
 DISCHARGE OVER ROAD @Q100: 1290 cfs

UPSTREAM STRUCTURE

TOWN: Braintree DISTANCE: 5700'
 HIGHWAY #: VT 12 STRUCTURE #: BR 47
 CLEAR SPAN: 25' CLEAR HEIGHT: 11.5'
 YEAR BUILT: 1928, reconstructed in 1969 FULL WATERWAY:
 STRUCTURE TYPE: T beam bridge and multiplate arch

DOWNSTREAM STRUCTURE

TOWN: Randolph DISTANCE: 9500'
 HIGHWAY #: TH 42 STRUCTURE #: BR 37
 CLEAR SPAN: 37' CLEAR HEIGHT: 11'
 YEAR BUILT: 1985 FULL WATERWAY:
 STRUCTURE TYPE: Concrete Slab

LRFR LOAD RATING FACTORS

LOADING LEVELS	TRUCK						
	H-20	HL-93	3S2	6 AXLE	3A STR	4A STR	5A SEM
TONNAGE	20	36	36	66	30	34.5	38
INVENTORY	1.67	1.07					
POSTING							
OPERATING	2.17	1.38	1.83	1.10	1.54	1.38	1.53
COMMENTS:							

PILE DRIVING AND TESTING REQUIREMENTS
 1. NOMINAL PILE DRIVING CAPACITY: Prop. 465.00 KIP
 2. PILE TEST RESISTANCE FACTOR: ϕ : 0.40
 3. MAXIMUM PILE TIP ELEVATION: SEE BORING LOGS
 4. $\bar{\sigma}$

PROPOSED STRUCTURE

STRUCTURE TYPE: Single span
 CLEAR SPAN(NORMAL TO STREAM): 21'
 VERTICAL CLEARANCE ABOVE STREAMBED: ~12'
 WATERWAY OF FULL OPENING: 225 sq. ft.

WATER SURFACE ELEVATIONS AT:

Q2.33 =	697.8'	VELOCITY =	7.3 fps
Q10 =	700.5'	"	11.9 fps
Q25 =	701.7'	"	14.2 fps
Q50 =	702.3'	"	14.6 fps
Q100 =	703.7'	"	11.2 fps

IS THE ROADWAY OVERTOPPED BELOW Q100: Yes
 FREQUENCY: Q25
 RELIEF ELEVATION: 701.1'
 DISCHARGE OVER ROAD @Q100: 1290 cfs

AVERAGE LOW ELEVATION OF SUPERSTRUCTURE: 702.7'
 VERTICAL CLEARANCE: @ Q25 = 1.0'

SCOUR: Contraction scour of 6.0' at Q25

REQUIRED CHANNEL PROTECTION: None required.

PERMIT INFORMATION

AVERAGE DAILY FLOW:	40 cfs	DEPTH OR ELEVATION:	
ORDINARY LOW WATER:	20 cfs		0.5' *
ORDINARY HIGH WATER:	300 cfs		2.5' *

TEMPORARY BRIDGE REQUIREMENTS

STRUCTURE TYPE: None
 CLEAR SPAN (NORMAL TO STREAM):
 VERTICAL CLEARANCE ABOVE STREAMBED:
 WATERWAY AREA OF FULL OPENING:

ADDITIONAL INFORMATION

Elevations based on NAVD88
 Existing abutments will be retained with the new bridge constructed over and behind them.
 * Water depths given are those where no scour holes occur in river.

DESIGN VALUES

1. DESIGN LIVE LOAD	HL-93
2. FUTURE PAVEMENT	d_p : 2.0 INCH
3. DESIGN SPAN	L : 67.00 FT
4. MIN. MID-SPAN POS. CAMBER @ RELEASE (PRESTRESSED UNITS)	Δ : 1.56 INCH
5. PRESTRESSING STRAND (0.60 INCH DIAMETER - LOW RELAX)	f_y : 270 KSI
6. PRESTRESSED CONCRETE STRENGTH	f_c : 7.0 KSI
7. PRESTRESSED CONCRETE RELEASE STRENGTH	f_{cr} : 5.5 KSI
8. CONCRETE, HIGH PERFORMANCE CLASS AA	f_c : 4.0 KSI
9. CONCRETE, HIGH PERFORMANCE CLASS A	f_c : 4.0 KSI
10. CONCRETE, HIGH PERFORMANCE CLASS B	f_c : 3.5 KSI
11. CONCRETE, CLASS C	f_c : 3.0 KSI
12. REINFORCING STEEL	f_y : 60 KSI
13. STRUCTURAL STEEL AASHTO M270	f_y : ---
14. SOIL UNIT WEIGHT	γ : 0.140 KCF
15. NOMINAL BEARING RESISTANCE OF SOIL	q_n : 9.0 KSF
16. SOIL BEARING RESISTANCE FACTOR (REFER TO AASHTO LRFD)	ϕ : 0.45
17. NOMINAL BEARING RESISTANCE OF ROCK	q_n : ---
18. ROCK BEARING RESISTANCE FACTOR (REFER TO AASHTO LRFD)	ϕ : ---
19. NOMINAL AXIAL PILE RESISTANCE	q_p : 465.0 KIPS
20. PILE YIELD STRENGTH ASTM A572	f_y : 50 KSI
21. PILE SIZE	HP 12X53
22. EST. PILE LENGTH	SEE BORING LOGS
L_p :	
23. PILE RESISTANCE FACTOR	ϕ : 0.40
24. LATERAL PILE DEFLECTION	Δ : 0.25 INCH
25. BASIC WIND SPEED	V_{3s} : ---
26. MINIMUM GROUND SNOW LOAD	p_g : ---
27. SEISMIC DATA	PGA : ---
S_s	---
S_f	---

PROJECT NAME: BRAINTREE
 PROJECT NUMBER: BRO 1444(36)

FILE NAME: s95j292pi.xls PLOT DATE: 12/29/2009
 PROJECT LEADER: K. HIGGINS DRAWN BY: R. PELLETT
 DESIGNED BY: T. FILLBACH CHECKED BY: T. FILLBACH
 PRELIMINARY INFORMATION (BRIDGE) SHEET 2 OF 26

TRAFFIC DATA

YEAR	ADT	DHV	% D	% T	ADTT	
2009	20	5	52	4	6	20 year ESAL for flexible pavement from 2009 to 2029 : < 50000
2029	30	5	52	4	6	40 year ESAL for flexible pavement from 2009 to 2049 : <50000
						Design Speed : 30 mph

GENERAL

1. ALL MATERIALS AND CONSTRUCTION SHALL CONFORM TO THE STATE OF VERMONT, AGENCY OF TRANSPORTATION STANDARD SPECIFICATIONS FOR CONSTRUCTION, DATED 2006, AND ITS LATEST REVISIONS, THE AASHTO LRFD BRIDGE DESIGN SPECIFICATIONS FOURTH EDITION, AND ITS LATEST REVISIONS AND THE AASHTO LRFD BRIDGE CONSTRUCTION SPECIFICATIONS, SECOND EDITION, AND ITS LATEST REVISIONS.
2. THE BRIDGE IS DESIGNED FOR HL-93 LIVE LOAD WITH AN ALLOWANCE FOR 2 INCHES OF FUTURE PAVEMENT.
3. ALL DIMENSIONS SHOWN IN THE PLANS ARE HORIZONTAL OR VERTICAL AND ARE GIVEN AT 68 DEGREES FAHRENHEIT, UNLESS NOTED OTHERWISE.
4. ANY STRUCTURE SUCH AS STEEL PANELS OR WOOD PANELS USED TO BRIDGE EXCAVATIONS SHALL BE DESIGNED BY A PROFESSIONAL ENGINEER.
5. ITEM 529.15 "REMOVAL OF STRUCTURE" IS FOR THE REMOVAL OF THE EXISTING MABEY BRIDGE SUPERSTRUCTURE AND ANY EXISTING SUBSTRUCTURE COMPONENTS REQUIRED TO COMPLETE THE PROPOSED WORK. SEE SPECIAL PROVISIONS FOR REQUIREMENTS ON THE REMOVAL AND DELIVERY OF THE MABEY BRIDGE COMPONENTS.
6. THE BID PRICE FOR ITEM 620.55 REMOVAL OF EXISTING FENCE SHALL INCLUDE STOCKPILING THE FENCE IN A LOCATION ACCEPTABLE TO THE PROPERTY OWNER.
7. SEE THE UTILITY SPECIAL PROVISIONS FOR A DESCRIPTION OF WHEN AND WHERE ITEM 204.22 TRENCH EXCAVATION OF EARTH, EXPLORATORY (N.A.B.I.) MAY BE REQUIRED.

CONCRETE

8. ALL EXPOSED EDGES OF CONCRETE SHALL BE CHAMFERED 1 INCH X 1 INCH.
9. ITEM 514.10 "WATER REPELLENT, SILANE", SHALL BE APPLIED TO ALL EXPOSED CONCRETE SURFACES, EXCEPT THE UNDERSIDE OF THE DECK BETWEEN DRIP NOTCHES.
10. JOINTS AND SCORE MARKS IN CONCRETE SHALL BE CONSTRUCTED AS SHOWN IN THE PLANS OR AS DIRECTED BY THE RESIDENT ENGINEER.

PRESTRESSED BOX BEAMS & PRECAST ABUTMENTS

11. ITEM 510.21 "PRESTRESSED CONCRETE BOX BEAMS" SHALL:
 - A. CONFORM TO SECTION 510 "PRESTRESSED CONCRETE".
 - B. HAVE THE ENDS OF THE STRANDS RECESSED AND GROUTED ACCORDING TO STANDARD PRACTICE.
 - C. INCLUDE COLD POURED JOINT FILLER, AND TRANSVERSE TENDONS.
 - D. GALVANIZE TRANSVERSE TENDONS PLATES AND CHUCKS AFTER FABRICATION ACCORDING TO AASHTO M 232M/M 232.
12. ITEM 510.24 "GROUTING SHEAR KEYS": FILL THE JOINTS BETWEEN THE BEAMS WITH MORTAR, TYPE IV, AS DESCRIBED IN SUBSECTION 510.13.
13. DESIGN VALUES
 - A. CONCRETE: $f_c = 7$ ksi AND $f_c = 5.5$ ksi
 - B. LIVE LOAD: AASHTO HL-93
 - C. PRESTRESSING STRANDS: 0.6" DIAMETER, 270 ksi, LOW-RELAXATION 7-WIRE STRANDS PULLED TO 75% OF THEIR YIELD STRENGTH
 - D. POST-TENSIONING STRANDS: 0.5" DIAMETER, 270 ksi, LOW-RELAXATION 7-WIRE STRANDS.
 - E. THE ASSUMED MODULUS OF ELASTICITY FOR THE STRAND IS 28,500 KSI.
 - F. THERE SHALL BE TWO (2) STRANDS PER POST-TENSION DUCT.
 - G. TRANSVERSE TENDONS SHALL BE COVERED BY SEAMLESS POLYPROPYLENE SHEATH (WITH CORROSION INHIBITOR GREASE BETWEEN SHEATH AND STRAND) FOR THE LENGTH OF THE STRAND. TIES SHALL BE TENSIONED TO 33 KIPS FOR EACH 0.5" DIAMETER STRAND AND 47 KIPS FOR EACH 0.6" DIAMETER STRAND.
 - H. SERVICE LOADS

MEMBER MOMENT	523 & 635 K-FT
SUPERIMPOSED DEAD LOAD MOMENT	66 K-FT
LIVE LOAD & IMPACT MOMENT	860 K-FT
DEAD LOAD REACTION	35 & 42 K
LIVE LOAD & IMPACT REACTION	56 K
TOTAL REACTION	91 & 98 K
FINAL CAMBER	1.2 & 1.7 IN
14. THE FABRICATOR MAY, WITH THE APPROVAL OF THE PROJECT MANAGER, ALTER THE DESIGN AS DETAILED TO MEET THE PLANT'S PRESTRESSING OPERATION AND MATERIAL REQUIREMENTS. ALTERNATE STRAND, TRANSVERSE TIE AND CROSS-SLOPE CONFIGURATIONS MAY BE SUBMITTED TO THE ENGINEER FOR APPROVAL. ANY DESIGN CHANGES SHALL MEET ALL OF THE APPLICABLE DESIGN CRITERIA, LOADINGS AND CODES AND SHALL BE STAMPED AND SIGNED BY A PROFESSIONAL ENGINEER LICENSED IN THE STATE OF VERMONT.

15. THE PRECASTER SHALL SANDBLAST SHEAR KEY FACES PRIOR TO DELIVERY.
16. IF THE SUBSTRUCTURE UNITS ARE PROVIDED IN MULTIPLE PIECES, THE SHEAR KEYS SHALL BE PROVIDED AT THE JOINTS AND THE PIECES SHALL BE MATCH CAST BY THE FABRICATOR.
17. ALL TIES AND STIRRUPS IN THE BOX BEAMS SHALL BE EPOXY COATED.
18. 1/2" SACRIFICIAL WEARING SURFACE HAS BEEN ADDED TO THE TOP OF THE BOX BEAMS. SEE THE SPECIAL PROVISIONS FOR DETAILS ON PROVIDING TEXTURING.

PROPOSED CONSTRUCTION SEQUENCE FOR PRECAST ABUTMENTS

19. PREPARE AND GRADE FOUNDATION TO REQUIRED ELEVATION.
20. PLACE SUBSTRUCTURE UNIT(S) OVER PILES.
 - A. PLUG GROUT HOLES
 - B. CONSTRUCTION JOINTS (IF REQUIRED) SHALL BE KEYED AND MATCH CAST.
21. INSTALL TRANSVERSE TENDONS (IF USING MORE THAN ONE SUBSTRUCTURE UNIT)
 - A. FEED TWO TENDONS THROUGH EACH OF THE SIX DUCTS.
 - B. USING A CALIBRATED JACK, POST-TENSION TO 3 KIPS TO REMOVE SAG IN THE TENDON
22. GROUT SHEAR KEY
23. POST-TENSION TRANSVERSE TENDONS:
 - A. GROUT SHALL ATTAIN A MINIMUM COMPRESSIVE STRENGTH OF 1500 psi, BASED ON THE MANUFACTURER'S RECOMMENDATIONS, PRIOR TO STRESSING. THE GROUT NEED NOT BE CURED FOR THREE DAYS PRIOR TO THE COMMENCING OF POST-TENSIONING.
 - B. PROVIDE APPROPRIATE CUBE MOLDS AS DESCRIBED IN AASHTO T106 FOR 3 SETS OF 3 DAY CUBES, 3 SETS OF 28 DAY CUBES AND AT A MINIMUM OF 3 MORE CUBES TO TEST FOR THE 1500 psi MINIMUM COMPRESSIVE STRENGTH.
 - C. POST-TENSION TENDONS TO 33 KIPS USING A CALIBRATED JACK OPERATED BY QUALIFIED PERSONNEL.
24. GROUT PILE CAVITIES
 - A. UNCOVER DUCTS
 - B. PLACE THE CONCRETE THROUGH FILL DUCTS INTO PILE CAVITIES.
 - C. MONITOR THE QUALITY OF THE GROUT THROUGH THE VENT DUCT.
 - D. CONTINUE GROUTING UNTIL THE CONCRETE COMPLETELY FILLS THE CAVITY AND BOTH DUCTS.
 - E. THE GROUT FOR FILLING THE PILE CAVITIES SHALL MEET THE REQUIREMENTS OF SELF-CONSOLIDATING CONCRETE. SEE THE SPECIAL PROVISIONS FOR DETAILS. ALL COSTS ASSOCIATED WITH GROUTING THE PILE CAVITIES SHALL BE INCLUDED IN THE BID PRICE FOR ITEMS 540.10 PRECAST CONCRETE STRUCTURE (ABUTMENT #1) AND 540.10 PRECAST CONCRETE STRUCTURE (ABUTMENT #2).

BACKFILL ABUTMENT

PROPOSED CONSTRUCTION SEQUENCE FOR PRESTRESSED BOX BEAMS

25. BACKFILL ABUTMENT
26. LAY OUT WORKING LINES:
 - A. LAY OUT WORKING LINES FOR THE ENTIRE BRIDGE WIDTH ON THE BEAM SEAT.
 - B. MEASURE ALL WORKING LINES FROM A COMMON WORKING POINT.
 - C. BASE THE WORKING LINES ON THE NOMINAL BEAM WIDTHS.
27. VERIFY BEAM SEAT ELEVATIONS:
 - A. MEASURE ELEVATIONS AT BEAM SEATS.
 - B. IF SEATS ARE HIGH OR LOW, TAKE CORRECTIVE ACTION.
 - C. INSTALL BEARINGS.
28. ERECT BEAMS:
 - A. PLACE BEAMS TO FIT WITHIN THE WORKING LINES.
 - B. AS WORK PROGRESSES, INSTALL HARDWOOD WEDGES BETWEEN ADJACENT BEAMS TO MAINTAIN PROPER JOINT OPENING (A MINIMUM OF ONE WEDGE AT EACH TRANSVERSE TENDON).
 - C. DRILL ANCHOR BOLT HOLES.
 - D. PLACE ANCHOR BOLTS.
29. INSTALL BACKER ROD: PLACE FILLER BELOW THE KEYWAY BOTTOM, AS SHOWN ON THE PLANS.
30. INSTALL TRANSVERSE TENDONS:
 - A. FEED TENDONS THROUGH DUCTS.
 - B. VERIFY THAT HARDWOOD WEDGES ARE IN PLACE AS REQUIRED TO PREVENT SLIPPAGE OF BEAMS.
 - C. USING A CALIBRATED JACK, POST-TENSION TENDONS TO APPROXIMATELY 3 KIPS TO REMOVE SAG IN THE TENDON AND TO SEAT THE CHUCK.

31. GROUT SHEAR KEYS:
 - A. CLEAN JOINTS WITH AN OIL FREE AIR-BLAST IMMEDIATELY BEFORE GROUT PLACEMENT. VERIFY THAT THE BACKER ROD IS STILL IN PLACE.
 - B. FOLLOW MANUFACTURER'S RECOMMENDATIONS FOR ADDITIONAL JOINT PREPARATION AND GROUT PLACEMENT.
 - C. CAREFULLY ROD JOINTS TO ELIMINATE ANY POSSIBILITY OF VOIDS.
32. POST-TENSION TRANSVERSE TENDONS:
 - A. GROUT SHALL ATTAIN A MINIMUM COMPRESSIVE STRENGTH OF 1500 psi, BASED ON THE MANUFACTURER'S RECOMMENDATIONS, PRIOR TO STRESSING. THE GROUT NEED NOT BE CURED FOR THREE DAYS PRIOR TO THE COMMENCING OF POST-TENSIONING.
 - B. PROVIDE APPROPRIATE CUBE MOLDS AS DESCRIBED IN AASHTO T106 FOR 3 SETS OF 3 DAY CUBES, 3 SETS OF 28 DAY CUBES AND AT A MINIMUM OF 3 MORE CUBES TO TEST FOR THE 1500 psi MINIMUM COMPRESSIVE STRENGTH.
 - C. POST-TENSION TENDONS TO 30 KIPS USING A CALIBRATED JACK OPERATED BY QUALIFIED PERSONNEL.
33. END DETAILS:
 - A. GROUT ANCHOR BOLTS INTO THE SLEEVES IN THE PRESTRESSED UNITS AT THE FIXED ENDS. BEFORE THE GROUT CURES, PLACE THE WASHER PLATE, AND INSTALL THE NUT ON TOP AND TIGHTEN.
 - B. PLACE THE COLD POURED JOINT SEALER IN THE SLEEVES IN THE PRESTRESSED UNITS AT THE EXPANSION ENDS. PLACE THE WASHER PLATE AND INSTALL THE NUT ON TOP. HAND TIGHTEN AND THEN LOOSEN 1/2 TURN.
 - C. GROUT OVER THE NUT AND BOLT IN THE ANCHOR BOLT BLOCK OUTS ON THE FIXED ENDS. FILL THE ANCHOR BOLT BLOCK OUTS ON THE EXPANSION ENDS WITH COLD POURED JOINT SEALER.
34. FINISH WORK: REMOVE WEDGES, AND PATCH SURFACE AND FASCIA BEAMS AT TRANSVERSE TENDONS.

PILES

35. THE PILES SHALL BE HP 12 X 53.
36. PILES SHALL BE DRIVEN TO A NOMINAL RESISTANCE OF 465 KIP. TO PREVENT DAMAGE TO THE PILES, PILE SHOES SHALL BE REQUIRED AND SHALL CONFORM TO SECTION 505.
37. FOR ESTIMATING PURPOSES, THE PILE TIP ELEVATIONS WERE ASSUMED AS SHOWN ON THE BORING LOGS. THE ACTUAL IN PLACE LENGTHS MAY VARY.
38. NO DYNAMIC LOAD TESTING IS REQUIRED FOR THIS PROJECT. THUS, PER SUBSECTION 505.04(C)(3) "THE ENGINEER WILL DETERMINE THE ULTIMATE CAPACITY BASED ON THE AGENCY'S WAVE EQUATION ANALYSIS". PER SUBSECTION 504.02(A) THE CONTRACTOR WILL STILL HAVE TO SUBMIT THE PILE AND DRIVING EQUIPMENT DATA FORM 14 DAYS PRIOR TO DRIVING.

TRAFFIC CONTROL

39. FOR ADDITIONAL SIGNING INSTRUCTIONS SEE STANDARDS E-100, E-100A, E-107, & E-107A.
40. THE CONTRACTOR WILL BE PERMITTED TO CLOSE THE BRIDGE TO TRAFFIC FOR THE FIRST 20 CALENDAR DAYS THAT THE PROJECT IS UNDER CONSTRUCTION. DURING THIS TIME, MENARD ROAD SHALL REMAIN OPEN TO VEHICULAR TRAFFIC WHEN THE CONTRACTOR IS NOT ON-SITE.
41. THE TRAFFIC CONTROL PLAN SHALL INCLUDE PROVISIONS TO ALLOW EMERGENCY VEHICLE ACCESS TO THE PROPERTIES ON MENARD ROAD WITHIN 15 MINUTES OF RECEIVING NOTICE THAT EMERGENCY VEHICLES ARE ON ROUTE OR FROM WHEN THE EMERGENCY VEHICLE ARRIVES ON SITE WITHOUT PRIOR NOTICE, EVEN DURING ANY BRIDGE CLOSURES. AN EXCEPTION, TO THE EMERGENCY VEHICLE PROVISION, SHALL BE ALLOWED FOR THE TIME WHEN THE EXISTING BRIDGE IS BEING REMOVED AND THE NEW SUPERSTRUCTURE IS BEING PLACED.
42. A SCHEDULE OF CLOSURE TIMES AND EXPECTED DURATIONS SHALL BE SUBMITTED TO THE RESIDENT ENGINEER, PROPERTY OWNERS AND EMERGENCY PERSONNEL 14 DAYS PRIOR TO ANY CLOSURES. THE RESIDENT ENGINEER SHALL HAVE 7 DAYS TO APPROVE THOSE TIMES.
43. ALL WORK ASSOCIATED WITH PROVIDING VEHICULAR ACCESS WHEN THE CONTRACTOR IS NOT ON-SITE AND PROVIDING EMERGENCY VEHICLE ACCESS SHALL BE INCIDENTAL TO ITEM 900.645 (TRAFFIC CONTROL, ALL-INCLUSIVE).
44. WORK OUTSIDE THE RIGHT OF WAY AND INSIDE THE TEMPORARY EASEMENT SHALL BE CONDITIONED UPON RESTORING THE PROPERTY TO ITS ORIGINAL CONDITION. THE COST FOR ANY RESTORATION SHALL BE INCLUDED IN THE BID PRICE FOR ITEM 900.645 (TRAFFIC CONTROL, ALL-INCLUSIVE).
45. THE CONTRACTOR SHALL REFER TO SECTION 900 - TRAFFIC CONTROL (ALL-INCLUSIVE) OF THE SPECIAL PROVISIONS FOR ADDITIONAL TRAFFIC CONTROL REQUIREMENTS.


PROJECT NAME:	BRAINTREE
PROJECT NUMBER:	BRO 1444(36)
FILE NAME: s95J292gennot.e.dgn	PLOT DATE: 31-DEC-2009
PROJECT LEADER: K. HIGGINS	DRAWN BY: T. FILLBACH
DESIGNED BY: T. FILLBACH	CHECKED BY: J. LACROIX
GENERAL NOTES	SHEET 3 OF 26

QUANTITY SHEET 1

SUMMARY OF ESTIMATED QUANTITIES										TOTALS		DESCRIPTIONS				DETAILED SUMMARY OF QUANTITIES		
						ROADWAY	EROSION CONTROL	BRIDGE	FULL C.E. ITEMS	GRAND TOTAL	FINAL	UNIT	ITEMS	ITEM NUMBER	ROUND	QUANTITIES	UNIT	ITEMS
						1				1		LS	CLEARING AND GRUBBING, INCLUDING INDIVIDUAL TREES AND STUMPS	201.10				
						220				220		CY	COMMON EXCAVATION	203.15				
						1				1		CY	TRENCH EXCAVATION OF EARTH, EXPLORATORY (N.A.B.I.)	204.22				
								90		90		CY	STRUCTURE EXCAVATION	204.25				
								50		50		CY	GRANULAR BACKFILL FOR STRUCTURES	204.30				
						150				150		CY	SUBBASE OF CRUSHED GRAVEL, COARSE GRADED	301.25				
						40				40		CY	AGGREGATE SURFACE COURSE	401.10				
								1		1		LS	FURNISHING EQUIPMENT FOR DRIVING PILING	504.10				
								368		368		LF	STEEL PILING FOR INTEGRAL ABUTMENTS, HP 12 X 53	505.25				
								140		140		LF	PRESTRESSED CONCRETE BOX BEAMS (27 1/2" - 28 1/2" X 48")	510.21				
								140		140		LF	PRESTRESSED CONCRETE BOX BEAMS (28 1/2" - 29 1/2" X 48")	510.21				
								210		210		LF	GROUTING SHEAR KEYS	510.24				
								27		27		GAL	WATER REPELLENT, SILANE	514.10				
						1				1		LS	MAINTENANCE OF STRUCTURES AND APPROACHES	527.10				
						1				1		EACH	REMOVAL OF STRUCTURE (675 SF - EST.)	529.15				
								16		16		EACH	BEARING DEVICE ASSEMBLY, ELASTOMERIC PAD	531.11				
								1		1		LS	PRECAST CONCRETE STRUCTURE (ABUTMENT #1)	540.10				
								1		1		LS	PRECAST CONCRETE STRUCTURE (ABUTMENT #2)	540.10				
						1				1		MGAL	DUST CONTROL WITH WATER	609.10				
						70				70		CY	STONE FILL, TYPE II	613.11				
						162				162		LF	REMOVAL OF EXISTING FENCE	620.55				
						180				180		LF	HD STEEL BEAM GUARDRAIL, GALVANIZED W/8 FEET POSTS	621.215				
						4				4		EACH	ANCHOR FOR STEEL BEAM RAIL	621.60				
						143				143		LF	REMOVAL AND DISPOSAL OF GUARDRAIL	621.80				
									1	1		LS	FIELD OFFICE, ENGINEERS	631.10				
						1				1		LS	MOBILIZATION/DEMobilIZATION	635.11				
						60	70			130		SY	GEOTEXTILE UNDER STONE FILL	649.31				
							5			5		LB	SEED	651.15				
							5			5		LB	SEED, WINTER RYE	651.17				
							20			20		LB	FERTILIZER	651.18				
							0.1			0.1		TON	AGRICULTURAL LIMESTONE	651.20				
							0.25			0.25		TON	HAY MULCH	651.25				
							10			10		CY	TOPSOIL	651.35				
							70			70		SY	GRUBBING MATERIAL	651.40				
									1000	1000		DL	SPECIAL PROVISION (FIELD OFFICE TELEPHONE) (N.A.B.I.)	900.615				
							50			50		HR	SPECIAL PROVISION (MONITORING EPSC PLAN)	900.630				
								150		150		LF	SPECIAL PROVISION (BRIDGE RAILING, GALVANIZED HDSB/FASCIA MOUNTED/STEEL TUBING)	900.640				
							1			1		LS	SPECIAL PROVISION (EPSC PLAN)	900.645				
						1				1		LS	SPECIAL PROVISION (TRAFFIC CONTROL, ALL-INCLUSIVE)	900.645				

PROJECT NAME: BRAINTREE
PROJECT NUMBER: BRO 1444(36)
FILE NAME: s95j292exqfy.dgn
PROJECT LEADER: K. HIGGINS
DESIGNED BY: T. FILLBACH
QUANTITY SHEET

PLOT DATE: 14-JAN-2010
DRAWN BY: K. PATTERSON
CHECKED BY: T. FILLBACH
SHEET 4 OF 26

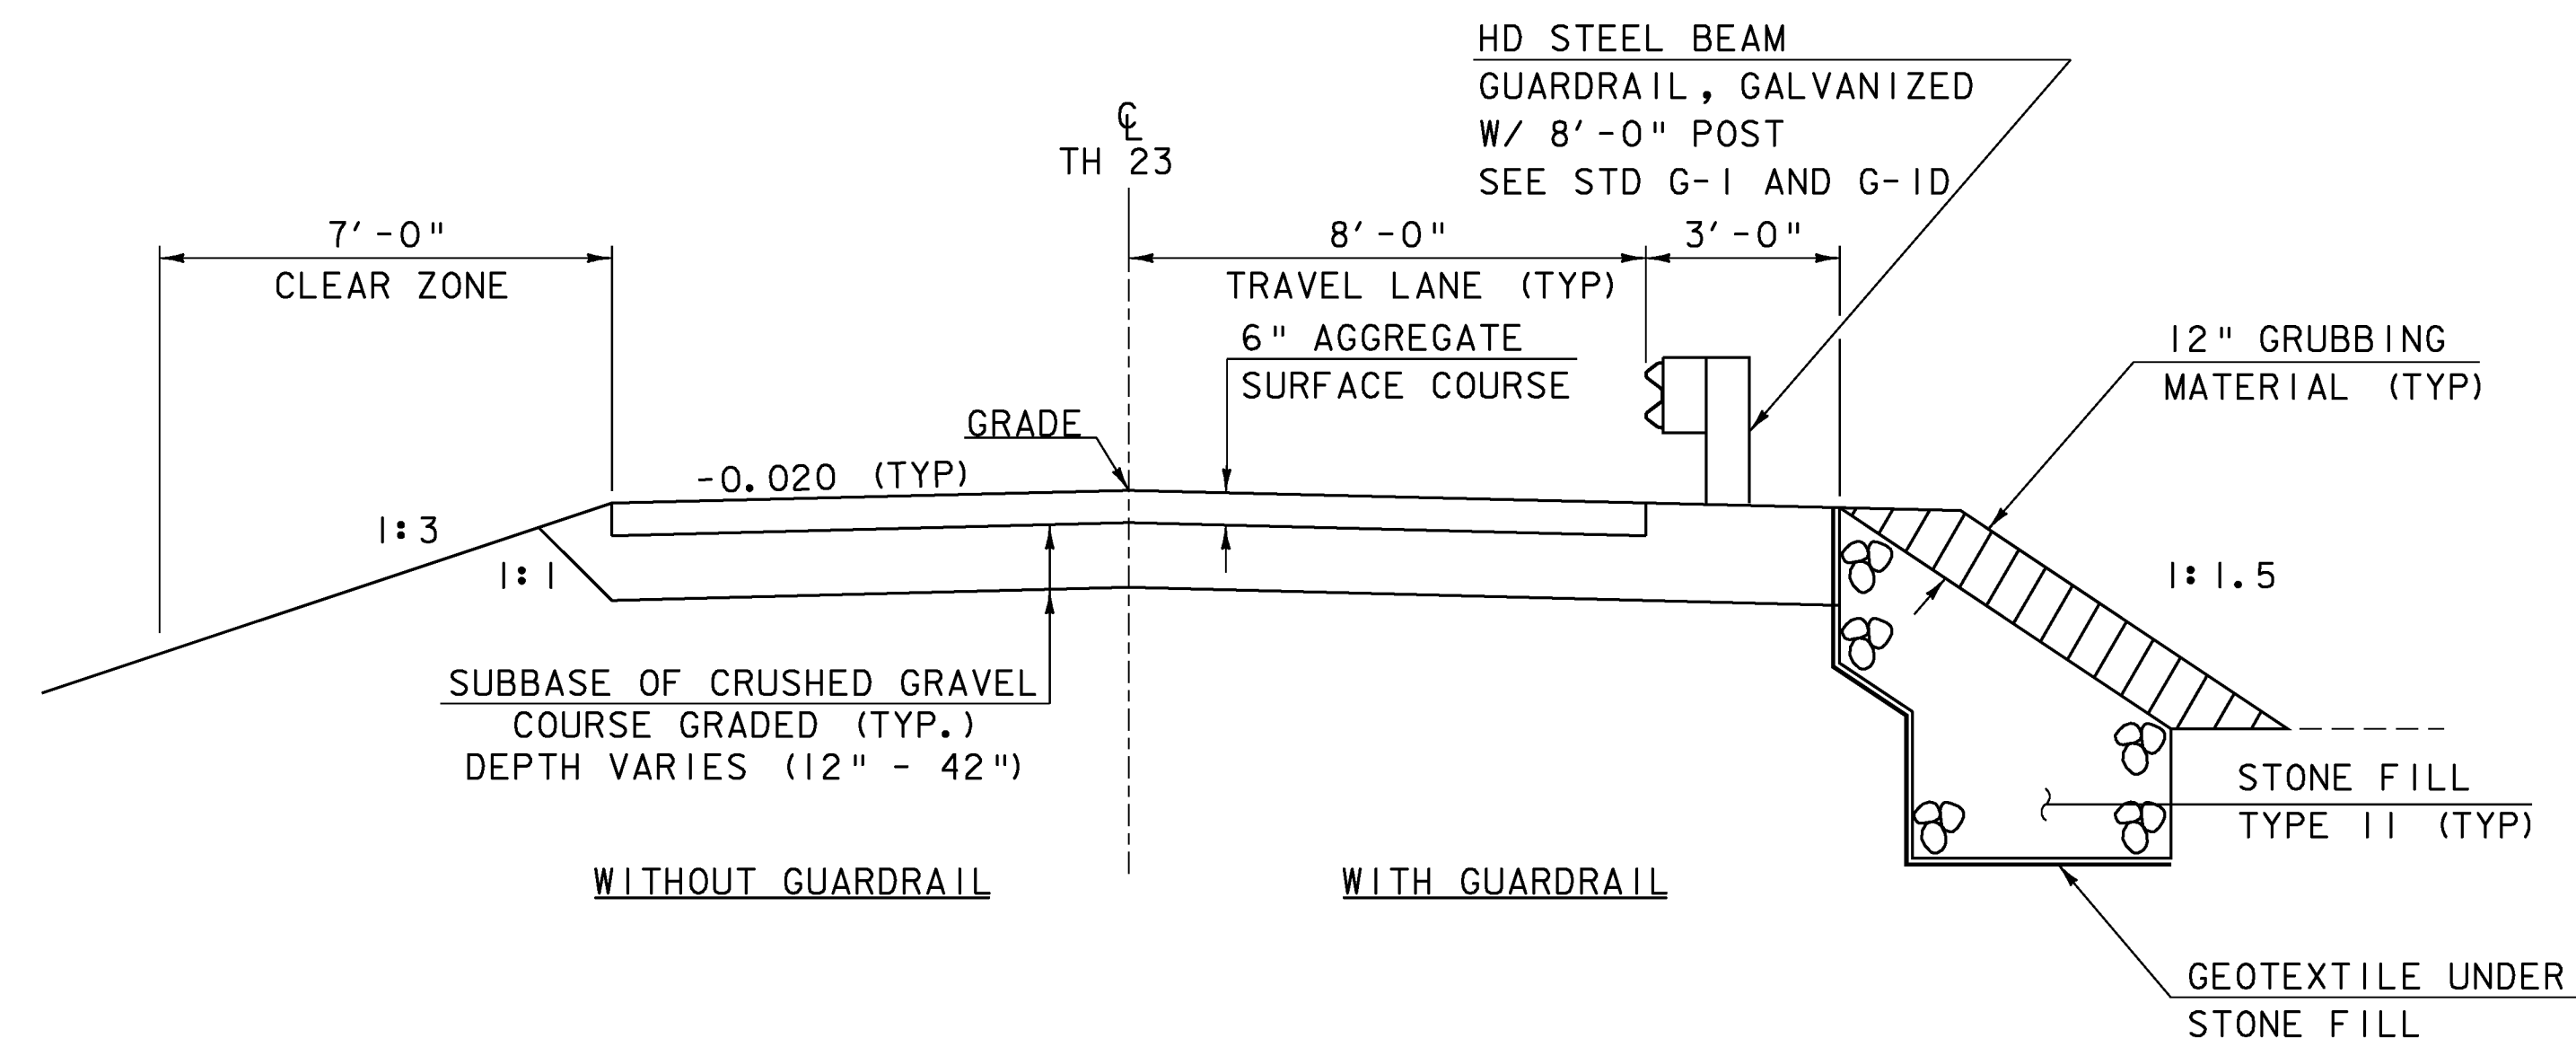


TH 23 TYPICAL SECTION

SCALE 3/8" = 1'-0"
 1 0 1 2 3 4


MATERIAL TOLERANCES
(IF USED ON PROJECT)

SURFACE	
- PAVEMENT	+/- 1/4"
- AGGREGATE SURFACE COURSE	+/- 1/2"
BASE COURSE	+/- 1/2"
SUBBASE	+/- 1"
SAND BORROW	+/- 1"
GRANULAR BORROW	+/- 1"

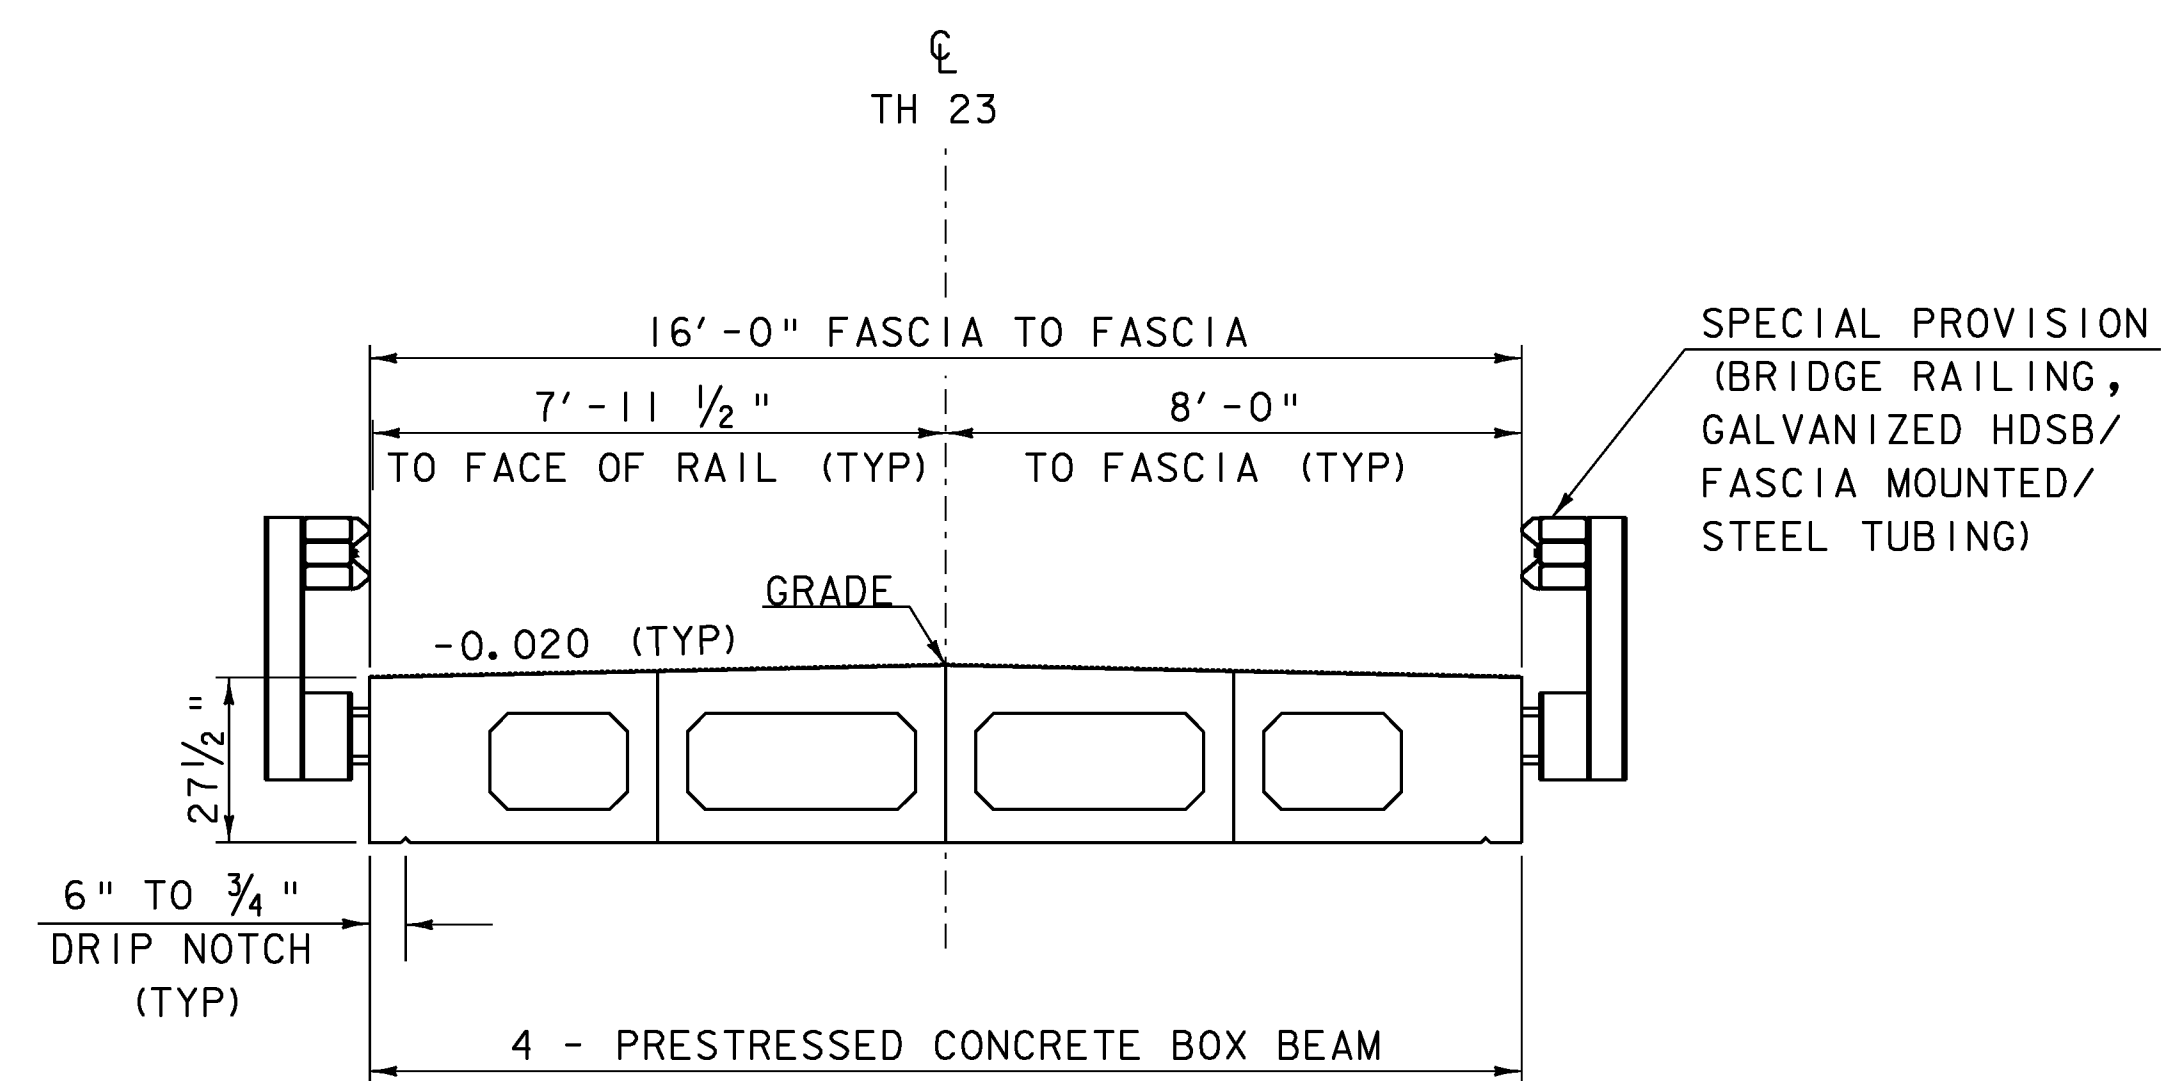

BRIDGE TYPICAL SECTION

SCALE 3/8" = 1'-0"
 1 0 1 2 3 4

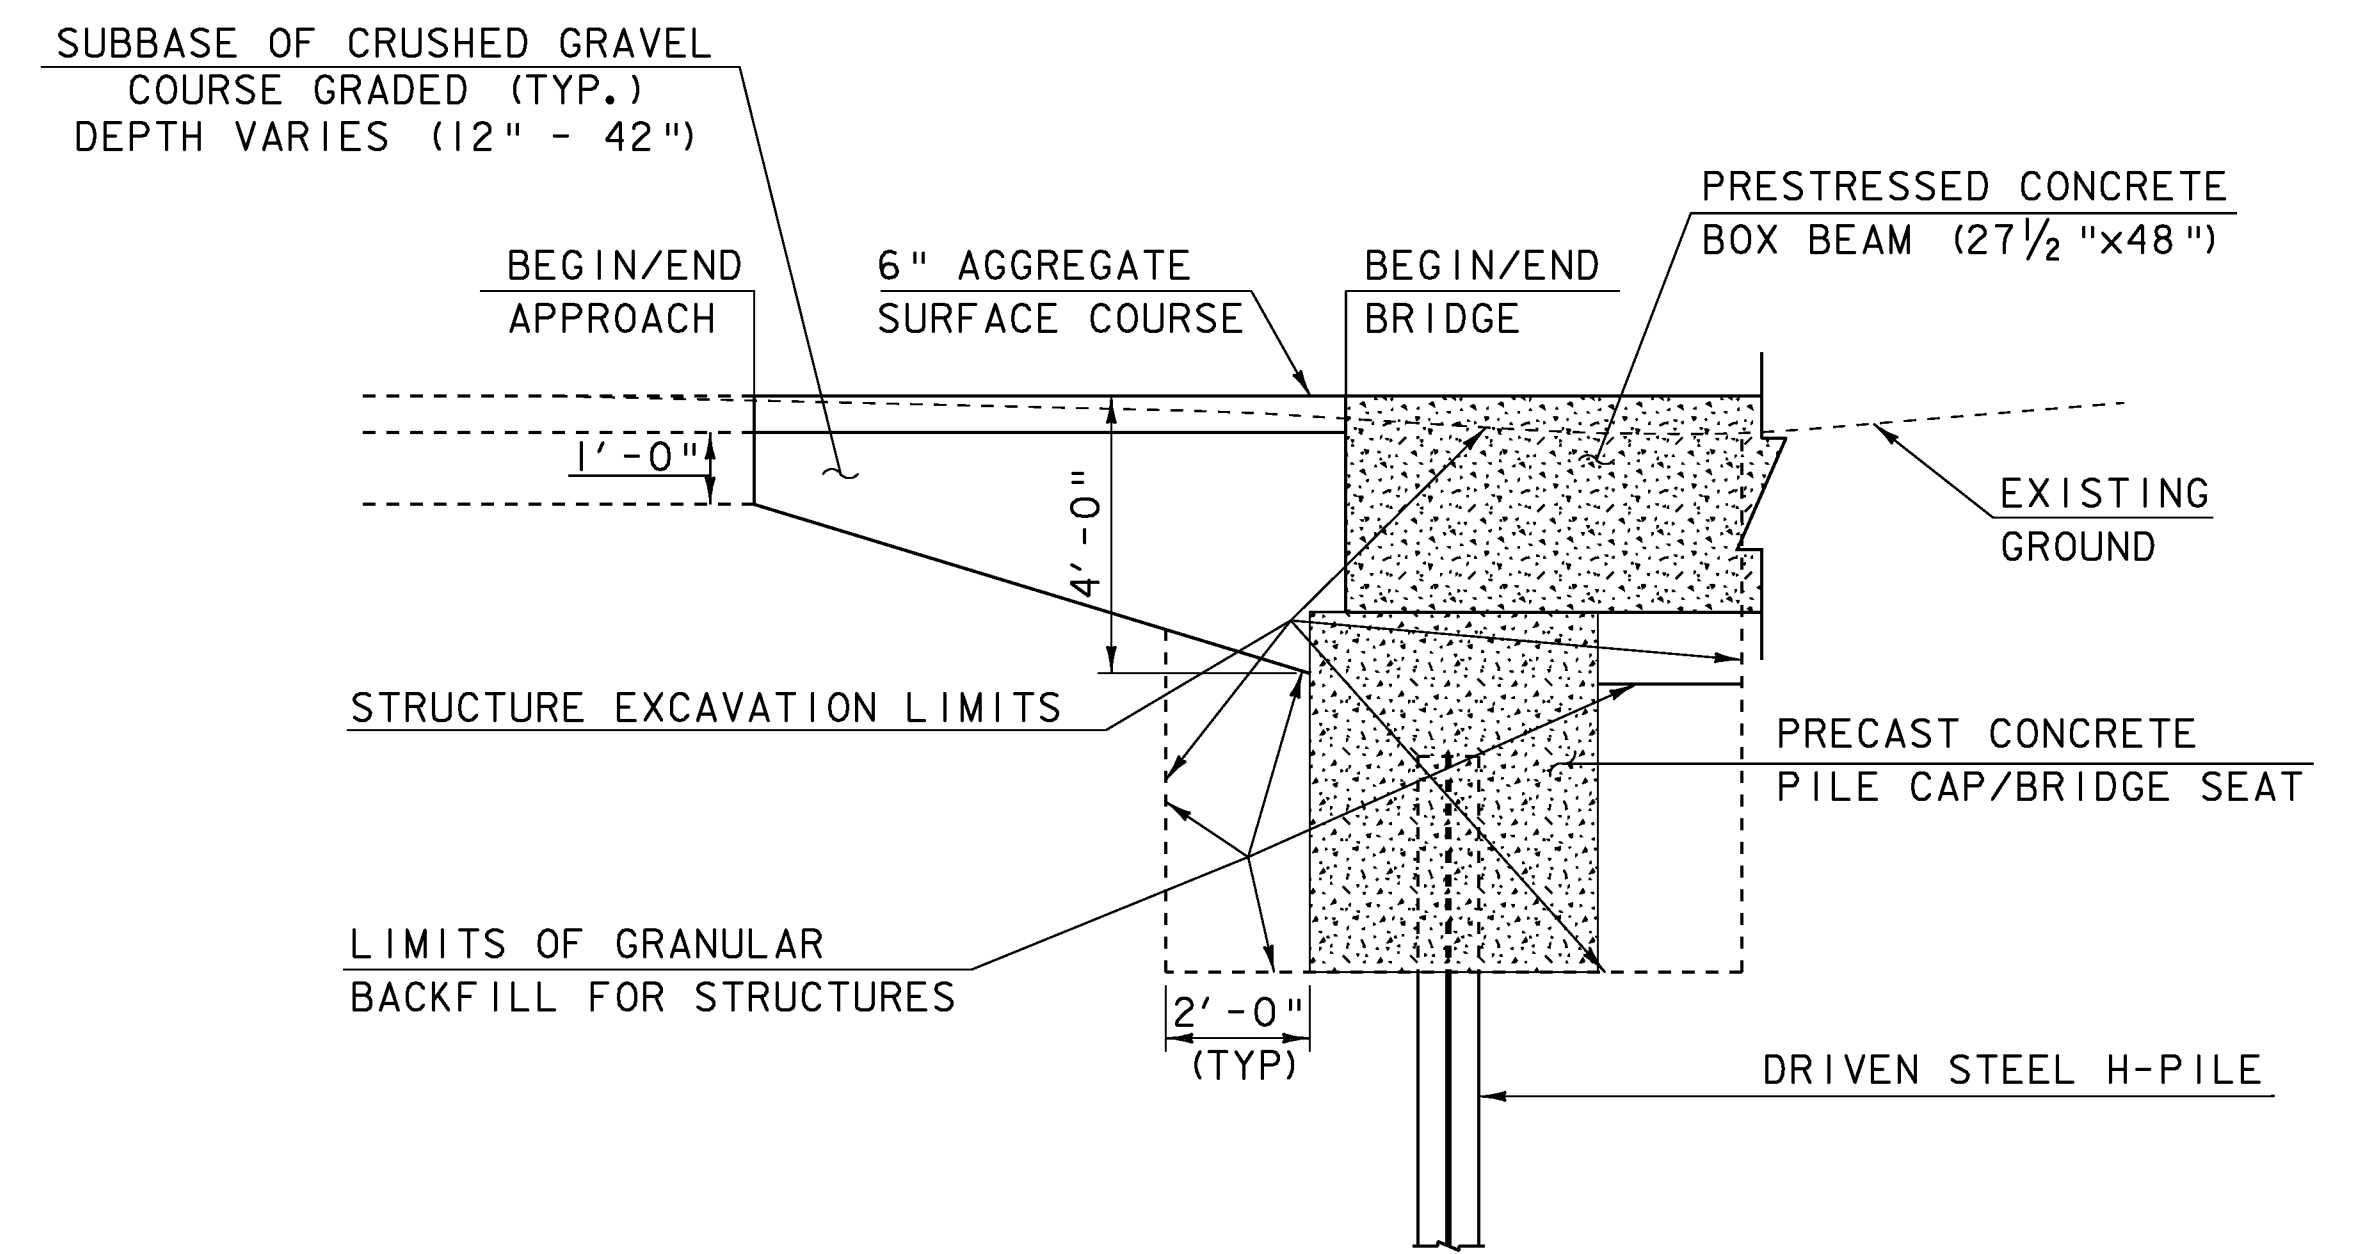

END BRIDGE TYPICAL SECTION

SCALE 3/8" = 1'-0"
 1 0 1 2 3 4

PROJECT NAME:	BRAINTREE
PROJECT NUMBER:	BRO 1444(36)
FILE NAME:	s95J292typ.dgn
PROJECT LEADER:	K. HIGGINS
DESIGNED BY:	T. FILLBACH
TYPICAL SECTIONS	
PLOT DATE:	14-JAN-2010
DRAWN BY:	T. FILLBACH
CHECKED BY:	R. PELLETT
SHEET	6 OF 26

GPS CONTROL POINTS

HVCTRL #1

SNOWSVILLE AZ MK
 NORTH = 548570.766
 EAST = 1599864.917
 ELEV. = 781.69

 
 
 


DESCRIBED BY VERMONT AGENCY OF TRANSPORTATION 1996 (DJM) GENERAL LOCATION - THE STATION IS LOCATED IN THE TOWN OF EAST BRAINTREE, 0.6 MI (1.0 KM) NORTH OF EAST BRAINTREE VILLAGE, 5.8 MI (9.3 KM) NORTH NORTHEAST OF RANDOLPH, AND 11.3 MI (18.2 KM) SOUTH OF NORTHFIELD. TO REACH FROM THE JUNCTION OF VERMONT ROUTE 12 AND VERMONT ROUTE 66 IN RANDOLPH, PROCEED NORTHERLY ALONG ROUTE 12 FOR 5.7 MI (9.2 KM) TO THE MARK ON THE RIGHT. TO REACH FROM THE JUNCTION OF VERMONT ROUTE 12 AND THE ROAD TO WEST BROOKFIELD, PROCEED SOUTH ALONG ROUTE 12 FOR 0.75 MI (1.21 KM) TO THE MARK ON THE LEFT. THE MARK IS A STATE OF VERMONT SURVEY DISK SET IN THE TOP OF A CONCRETE MONUMENT 30 CM IN DIAMETER, FLUSH WITH THE GROUND SURFACE. IT IS LOCATED 141 FT (43.0 M) NORTH NORTHEAST OF UTILITY POLE 136/19, 129 FT (39.3 M) SOUTH OF A SIGN (BRAINTREE / BROOKFIELD), 60.5 FT (18.4 M) SOUTH OF A MAILBOX, 22 FT (6.7 M) SOUTHEAST OF THE CENTERLINE OF VERMONT ROUTE 12, AND 3 FT (0.9 M) NORTHWEST OF A FIBERGLASS WITNESS POST. OWNERSHIP IS THE STATE OF VERMONT.

HVCTRL #2

SNOWSVILLE
 NORTH = 546460.357
 EAST = 1600026.324
 ELEV. = 753.84






EAST BRAINTREE VILLAGE, 5.3 MI (8.5 KM) NORTH NORTHEAST OF RANDOLPH, AND 11.8 MI (19.0 KM) SOUTH OF NORTHFIELD. TO REACH FROM THE JUNCTION OF VERMONT ROUTE 66 AND VERMONT ROUTE 12 IN RANDOLPH, PROCEED NORTHERLY ALONG ROUTE 12 FOR 5.3 MI (8.5 KM) TO THE MARK ON THE RIGHT. TO REACH FROM THE JUNCTION OF VERMONT ROUTE 12 AND THE ROAD TO WEST BROOKFIELD, PROCEED 1.15 MI (1.85 KM) SOUTH ALONG ROUTE 12 TO THE MARK ON THE LEFT. THE MARK IS A STATE OF VERMONT SURVEY DISK SET IN THE TOP OF A CONCRETE MONUMENT 30 CM IN DIAMETER, FLUSH WITH THE GROUND SURFACE. IT IS LOCATED 130 FT (39.6 M) NORTH OF A HIGHWAY SIGN (EAST BRAINTREE), 68.5 FT (20.9 M) SOUTH SOUTHEAST OF UTILITY POLE 13 1/2 / 130X, 36.5 FT (11.1 M) SOUTHWEST OF HIGHWAY SIGN (REDUCED SPEED AHEAD), 17.5 FT (5.3 M) EAST OF THE CENTERLINE OF VERMONT ROUTE 12, 5 FT (1.5 M) WEST OF A WOODEN FENCE, AND 3 FT (0.9 M) WEST OF A FIBERGLASS WITNESS POST. OWNERSHIP IS THE STATE OF VERMONT

TRAVERSE TIES

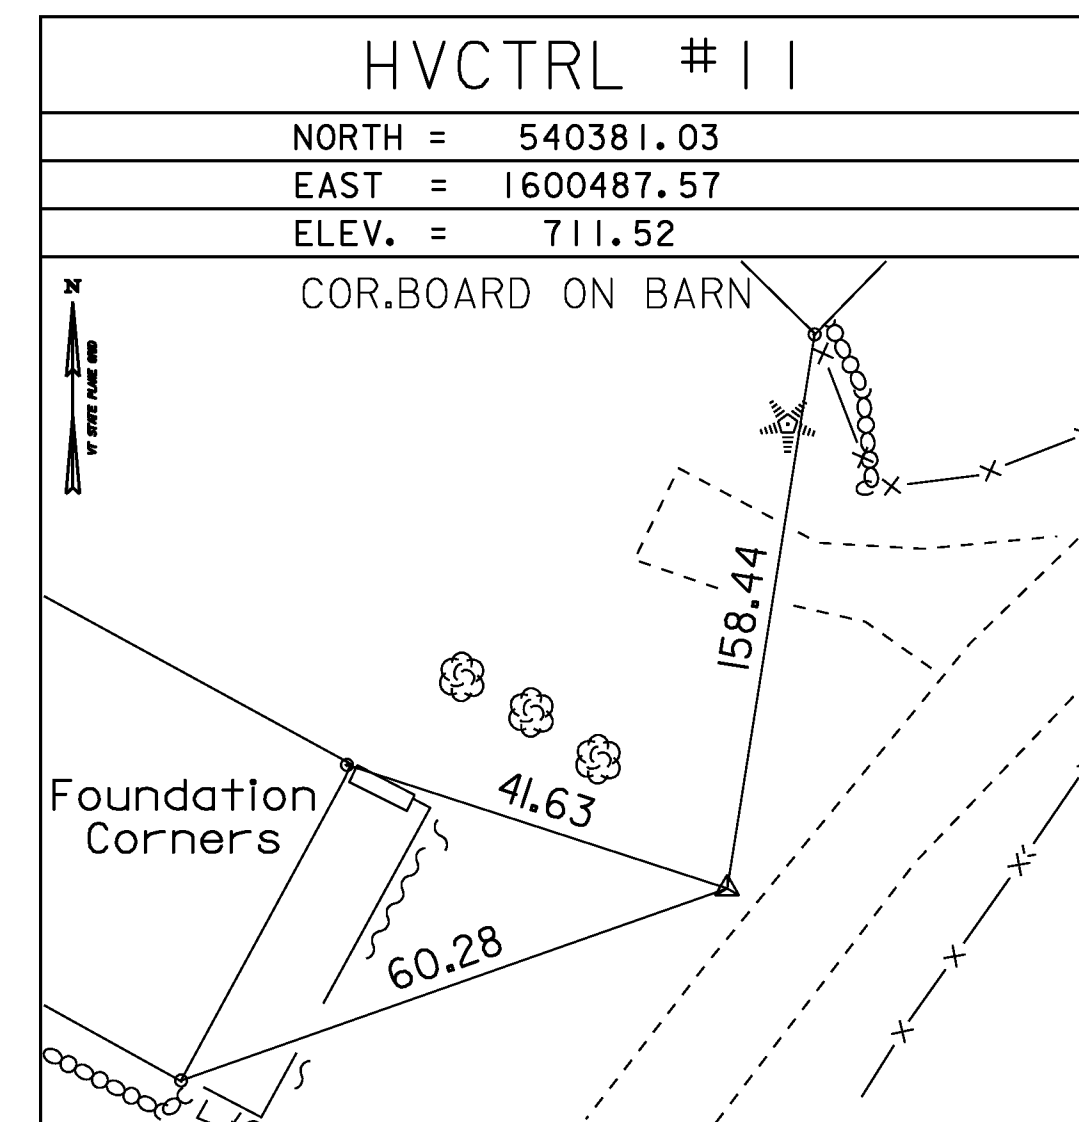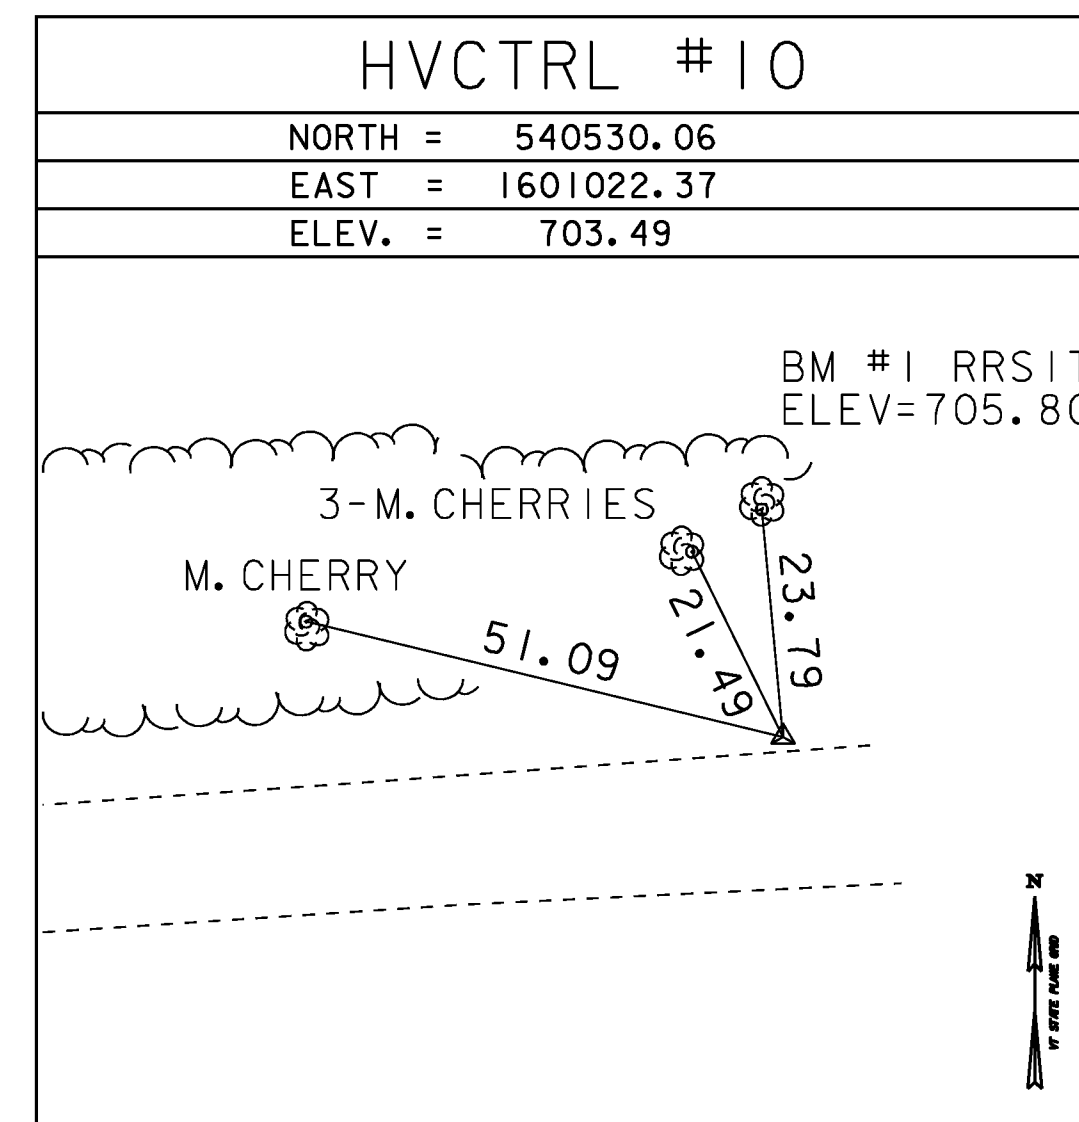

* Main Traverse Completed 10/03/06 by R.Gilman P.C. & R.Moreau

     ALIGNMENT TIES



DATUM
 VERTICAL NAVD 88
 HORIZONTAL NAD 83 (92)
 ADJUSTMENT Compass

PROJECT NAME: Braintree
 PROJECT NUMBER: BRO 1444 (36)
 FILE NAME: survey\x95j292+1.dgn
 PROJECT LEADER: K. HIGGINS
 DESIGNED BY: SURVEY
 TIE SHEET

PLOT DATE: 31-DEC-2009
 DRAWN BY: R. Bullock
 CHECKED BY: SURVEY
 SHEET 7 OF 26

CURVE #1

DELTA = 24°55'00"
 D = 28°38'52"
 R = 200.00'
 T = 44.19'
 L = 86.98'
 E = 4.82'

CURVE #2

DELTA = 14°02'00"
 D = 19°05'55"
 R = 300.00'
 T = 36.92'
 L = 73.48'
 E = 2.26'

REMOVAL AND DISPOSAL OF GUARDRAIL

STA 11+04.3 - 11+38.8 LT
 STA 11+07.0 - 11+37.4 RT
 STA 11+80.1 - 12+17.8 LT
 STA 11+80.3 - 12+18.9 RT

REMOVAL OF EXISTING FENCE

STA 10+50.0 - 11+25.0 RT
 STA 10+75.0 - 11+00.0 LT

SPECIAL PROVISION (BRIDGE RAILING/ GALVANIZED HDSB/ FASCIA MOUNTED/STEEL TUBING)

STA 11+17.5 - 11+92.5 LT
 STA 11+17.5 - 11+92.5 RT

HD STEEL BEAM GUARDRAIL, GALVANIZED W/8 FEET POSTS

STA 10+82.3 - 11+17.5 LT
 STA 10+77.3 - 11+17.5 RT
 STA 11+92.5 - 12+28.0 LT
 STA 11+92.5 - 12+31.4 RT

ANCHOR FOR STEEL BEAM RAIL



STA 10+88.0 RT
 STA 10+84.7 LT
 STA 12+22.3 RT
 STA 12+24.9 LT

SPECIAL PROVISION (RETAINING WALL)

STA 11+88.7 - 12+00.2 LT

STONE FILL TYPE II

STA 10+81.0 - 11+20.0 RT
 STA 11+90.0 - 12+30.0 RT

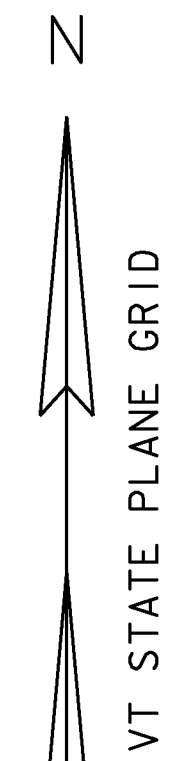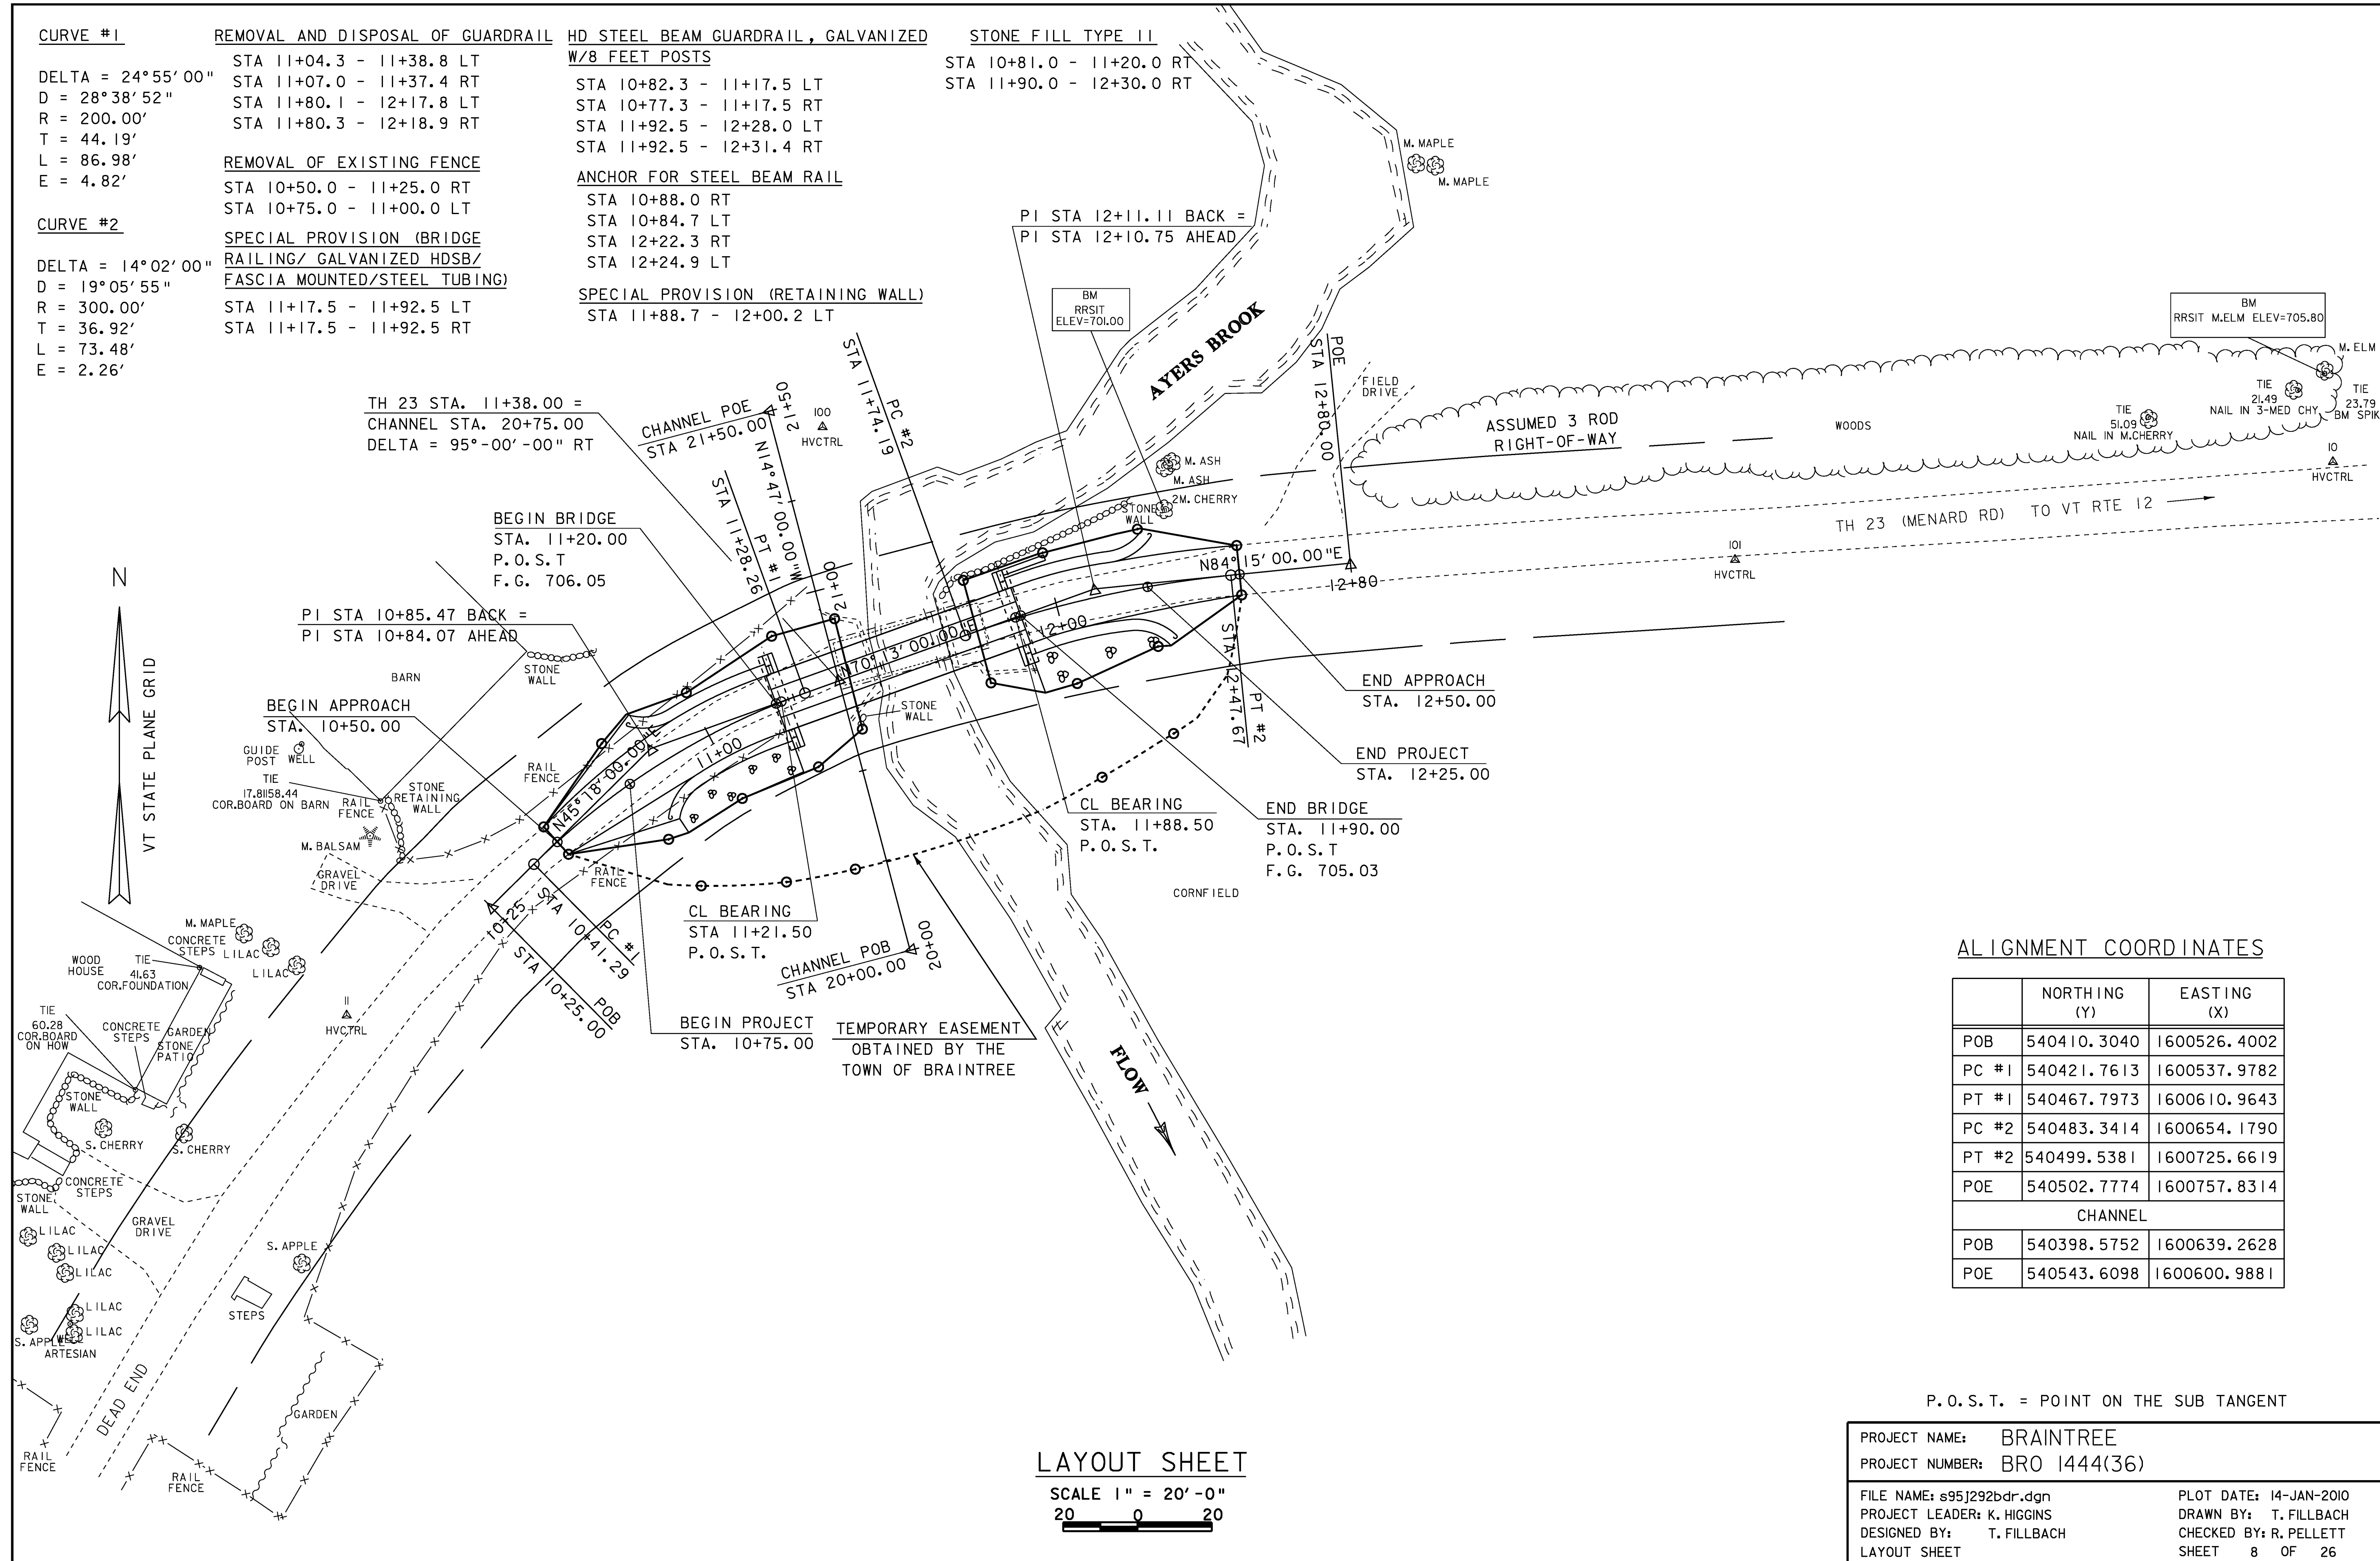

ALIGNMENT COORDINATES

	NORTHING (Y)	EASTING (X)
POB	540410.3040	1600526.4002
PC #1	540421.7613	1600537.9782
PT #1	540467.7973	1600610.9643
PC #2	540483.3414	1600654.1790
PT #2	540499.5381	1600725.6619
POE	540502.7774	1600757.8314
CHANNEL		
POB	540398.5752	1600639.2628
POE	540543.6098	1600600.9881



P.O.S.T. = POINT ON THE SUB TANGENT

LAYOUT SHEET

SCALE 1" = 20'-0"
 20 0 20

PROJECT NAME:	BRAINTREE	PLOT DATE:	14-JAN-2010
PROJECT NUMBER:	BRO 1444(36)	DRAWN BY:	T. FILLBACH
FILE NAME:	s95j292bdr.dgn	CHECKED BY:	R. PELLETT
PROJECT LEADER:	K. HIGGINS	LAYOUT SHEET	SHEET 8 OF 26

TH 23 (MENARD ROAD)

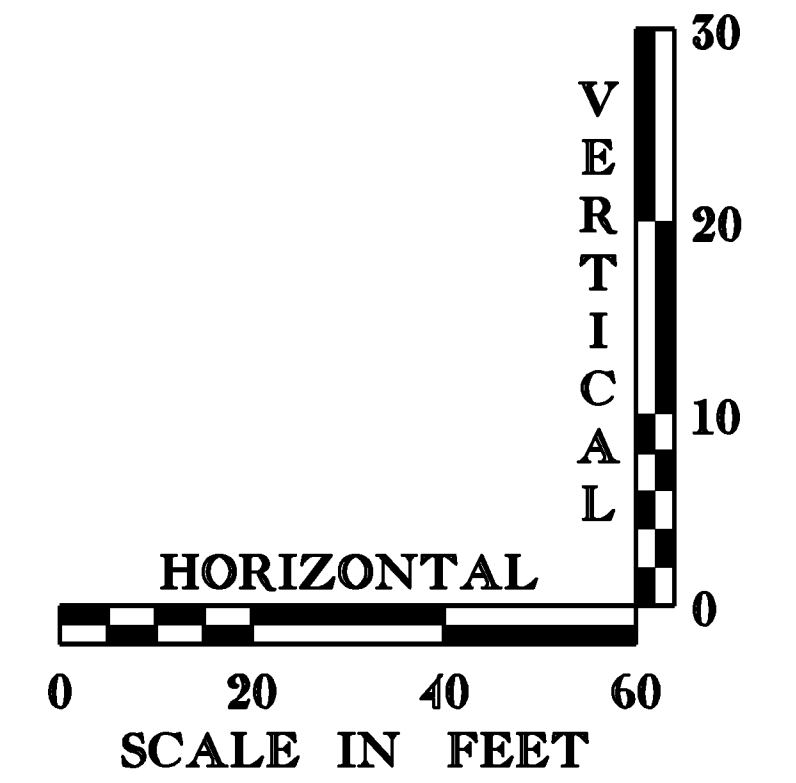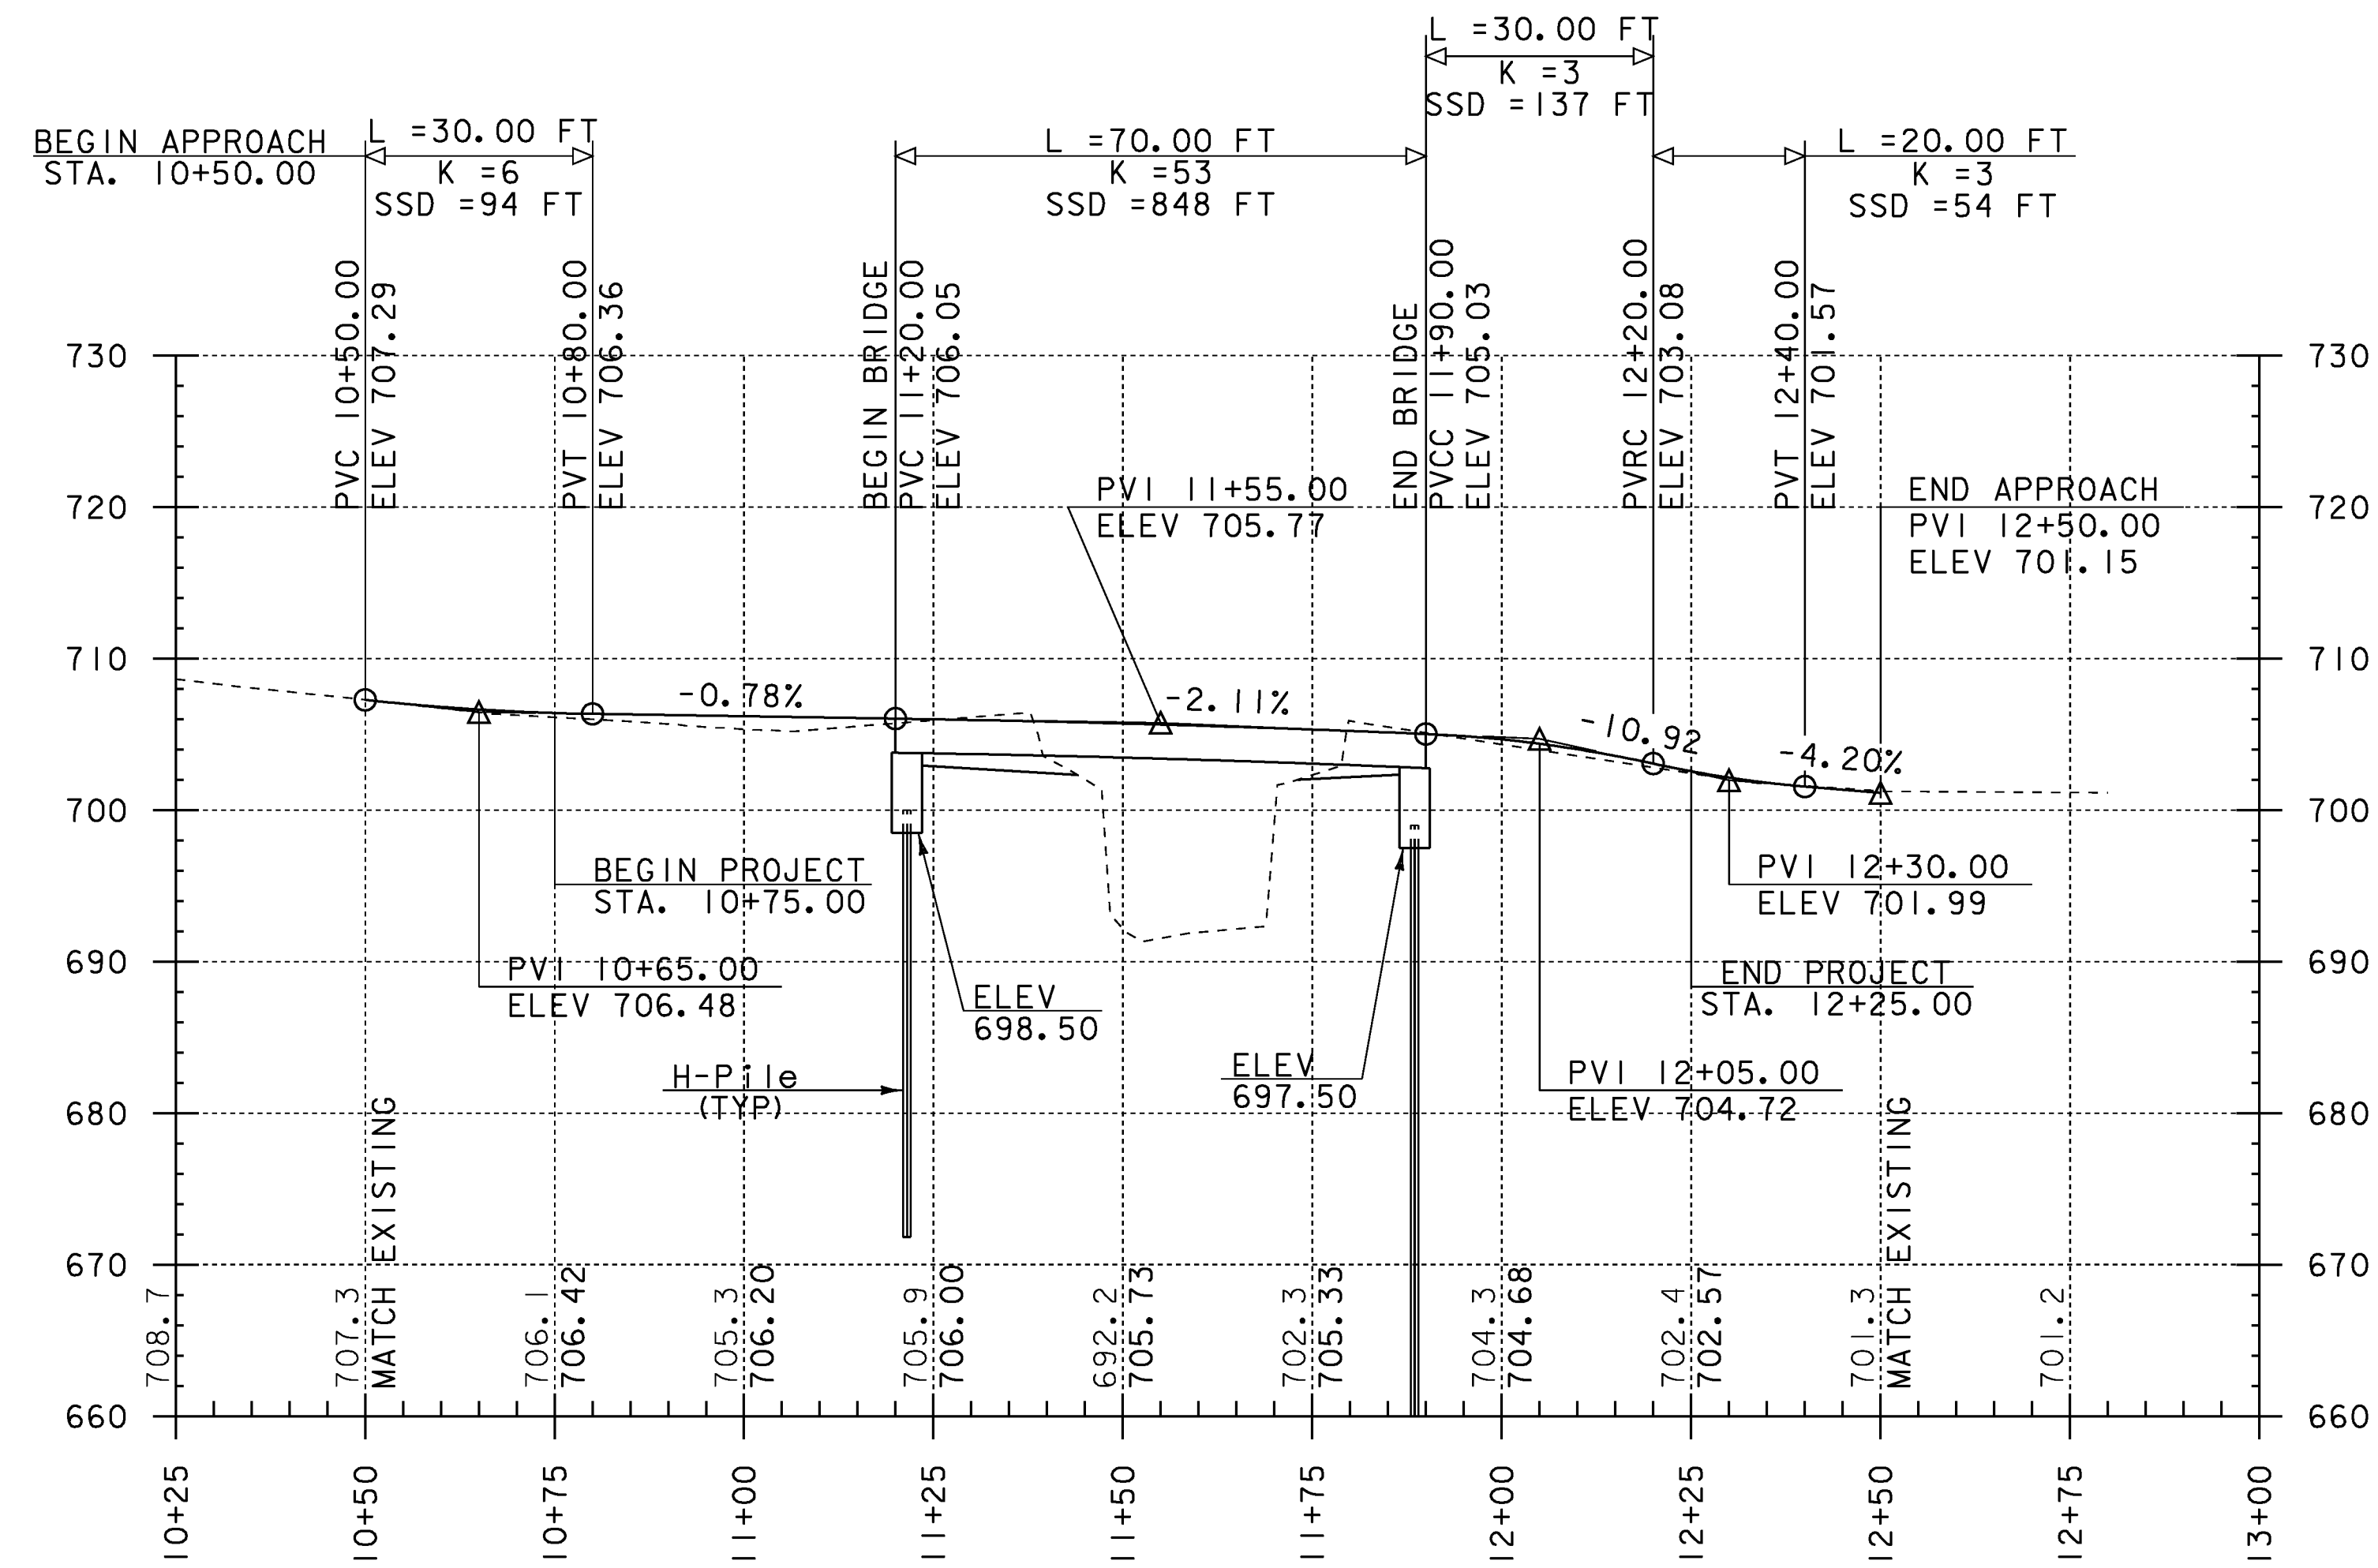

THE GRADES SHOWN TO THE NEAREST TENTH ARE THE ORIGINAL GROUND ELEVATIONS ALONG THE PROPOSED ALIGNMENT.

THE GRADES SHOWN TO THE NEAREST HUNDREDTH ARE THE FINISH GRADES ALONG THE PROPOSED ALIGNMENT.

SEE CROSS SECTIONS FOR MATERIAL TRANSITION INFORMATION.

PROJECT NAME:	BRAINTREE	PLOT DATE:	31-DEC-2009
PROJECT NUMBER:	BRO 1444(36)	DRAWN BY:	K. PATTERSON
FILE NAME:	s95j292pro.dgn	DESIGNED BY:	T. FILLBACH
PROFILE SHEET		CHECKED BY:	T. FILLBACH
		SHEET	9 OF 26

EPSC PLAN NARRATIVE

1.1 PROJECT DESCRIPTION

THIS PROJECT INVOLVES THE REPLACEMENT OF BRIDGE 12 ON TH 23. THE NEW STRUCTURE WILL BE 70 FEET IN LENGTH AND BE SET ON PILES AND PRECAST CONCRETE PILE CAPS OVER AYERS BROOK. THIS PROJECT IS LOCATED IN THE TOWN OF BRAINTREE.

NOTE: AREA OF DISTURBANCE INCLUDES LIMITS OF EARTH DISTURBANCE WITHIN THE PROJECT AREA, AS WELL AS WASTE, BORROW AND STAGING AREAS, AND OTHER EARTH DISTURBING ACTIVITIES WITHIN OR DIRECTLY ADJACENT TO THE PROJECT LIMITS AS SHOWN ON THE ATTACHED EPSC PLAN.

TOTAL AREA OF DISTURBANCE AS SHOWN ON THE ATTACHED EPSC PLAN IS APPROXIMATELY 0.15 ACRES.

IT IS ANTICIPATED THAT THIS PROJECT WILL LAST ONE CONSTRUCTION SEASON.

1.2 SITE INVENTORY

1.2.1 TOPOGRAPHY

THE TOPOGRAPHY OF THE AREA IS A SADDLE THAT IS MOSTLY OPEN FIELDS AND PASTURES WITH SOME FORESTED AREA. MENARD RD IS IN THE PROJECT SITE. THERE IS A RESIDENCE ON THE WEST SIDE OF THE PROJECT WITH A SMALL FARM.

1.2.2 DRAINAGE, WATERWAYS, BODIES OF WATER, AND PROXIMITY TO NATURAL OR MAN-MADE WATER FEATURES

THE AYERS BROOK IS THE ONLY WATER SOURCE ON THE PROJECT SITE. THE BROOK IS CLASSIFIED AS INCISED WITH UNSTABLE STREAM BANKS. THE STREAM BEDS ARE SAND, GRAVEL AND COBBLES.

1.2.3 VEGETATION

THE VEGETATION IN THE PROJECT AREA CONSISTS OF HARDWOOD TREES AND UNDERGROWTH TO THE NORTHWEST AND OPEN FIELDS TO THE SOUTH AND EAST. THE IMPACT TO VEGETATION WILL BE LIMITED TO THAT WHICH IS DIRECTLY AFFECTED BY REPLACEMENT OF THE BRIDGE. DISTURBED VEGETATION WILL BE RE-ESTABLISHED WITH STANDARD SEED AND MULCH PRACTICES.

1.2.4 SOILS

ALL SOIL DATA CAME FROM THE U.S. DEPARTMENT OF AGRICULTURE SOIL CONSERVATION SERVICE FOR THE COUNTY OF ORANGE, VERMONT. SOILS ON THE PROJECT SITE ARE HADLEY VERY FINE SANDY LOAM, MERRIMAC FINE SANDY LOAM WITH 0% TO 3% SLOPES AND VERSHIRE-GLOVER-ROCK OUTCROP COMPLEX WITH 8% TO 25% SLOPES. THE "K FACTOR" FOR HADLEY IS 0.49, MERRIMAC IS 0.24 AND VERSHIRE-GLOVER-ROCK IS 0.24. THE SOIL IS CONSIDERED HIGHLY ERODIBLE DUE TO SIGNIFICANT SLOPES.

NOTE: K-VALUES GENERALLY INDICATE THE FOLLOWING:

0.0-0.23 = LOW EROSION POTENTIAL

0.24-0.36 = MODERATE EROSION POTENTIAL

0.37 AND HIGHER = HIGH EROSION POTENTIAL

1.2.5 SENSITIVE RESOURCE AREAS

CRITICAL HABITATS: NO

HISTORICAL OR ARCHEOLOGICAL AREAS: NO

PRIME AGRICULTURAL LAND: NO (AG LAND SURROUNDS THE PROJECT)

THREATENED AND ENDANGERED SPECIES: NO

WATER RESOURCE: AYERS BROOK

WETLANDS: NO

1.3 RISK EVALUATION

THIS PROJECT DOES NOT FALL UNDER THE JURISDICTION OF GENERAL PERMIT 3-9020 FOR STORMWATER RUNOFF FROM CONSTRUCTION SITES. SHOULD CHANGES PRIOR TO OR DURING CONSTRUCTION RESULT IN ONE OR MORE ACRES OF EARTH DISTURBANCE OR SHOULD THE PROJECT BECOME PART OF A LARGER PLAN OF DEVELOPMENT, THE CONTRACTOR WILL BE RESPONSIBLE FOR ANY ADDITIONAL PERMITTING.

1.4 EROSION PREVENTION AND SEDIMENT CONTROL

THE EROSION CONTROL PLANS ARE MEANT AS A GUIDELINE FOR PREVENTING EROSION AND CONTROLLING SEDIMENT TRANSPORT. THE PRINCIPLES OUTLINED IN THIS NARRATIVE CONSIST OF APPLYING MEASURES THROUGHOUT CONSTRUCTION OF THE PROJECT IN ORDER TO MINIMIZE SEDIMENT TRANSPORT TO THE RECEIVING WATERS. THE MEASURES INCLUDE STABILIZATION AND STRUCTURAL PRACTICES, STORM WATER CONTROLS AND OTHER POLLUTION PREVENTION PRACTICES. REFER TO THE LOW RISK SITE HANDBOOK AND APPROPRIATE DETAIL SHEETS FOR SPECIFIC GUIDANCE AND CONSTRUCTION DETAILING.

ALL MEASURES SHALL BE REGULARLY MAINTAINED AND SHALL BE CHECKED FOR SEDIMENT BUILD-UP. SEDIMENT SHALL BE DISPOSED OF AT AN APPROVED SITE WHERE IT WILL NOT BE SUBJECT TO EROSION.

1.4.1 MARK SITE BOUNDARIES

SITE BOUNDARIES AND AREAS CONSTRUCTION EQUIPMENT CAN ACCESS SHALL BE DELINEATED.

PROJECT DEMARCATION FENCING (PDF) SHALL BE USED TO PHYSICALLY MARK SITE BOUNDARIES.

1.4.2 LIMIT DISTURBANCE AREA

PREVENTING INITIAL SOIL EROSION BY MINIMIZING THE EXPOSED AREA IS MUCH MORE EFFECTIVE THAN TREATING ERODED SEDIMENT. EARTH DISTURBANCE CAN BE MINIMIZED THROUGH CONSTRUCTION PHASING BY ONLY OPENING UP EARTH AS NECESSARY. THIS CAN LIMIT THE AREA THAT WILL BE DISTURBED AND EXPOSED TO EROSION. EMPLOY TEMPORARY CONSTRUCTION STABILIZATION PRACTICES IN INCREMENTAL STAGES AS PHASES CHANGE. FOR PROJECTS WHICH FALL UNDER THE CONSTRUCTION GENERAL PERMIT, ONLY THE ACREAGE LISTED ON THE PERMIT AUTHORIZATION MAY BE EXPOSED AT ANY GIVEN TIME.

MAINTAINING VEGETATED BUFFERS ALONG STREAM BANKS, WETLANDS OR OTHER SENSITIVE AREAS IS A CRUCIAL EROSION AND SEDIMENT CONTROL MEASURE THAT SHOULD BE ESTABLISHED WHEREVER POSSIBLE.

1.4.3 SITE ENTRANCE/EXIT STABILIZATION

TRACKING OF SEDIMENT ONTO PUBLIC HIGHWAYS SHALL BE MINIMIZED TO REDUCE THE POTENTIAL FOR RUNOFF ENTERING RECEIVING WATERS. INSTALLATION SHALL COINCIDE WITH THE CONTRACTORS PROGRESS SCHEDULE.

STABILIZED CONSTRUCTION ENTRANCES SHALL BE INSTALLED ANYWHERE EQUIPMENT WILL BE GOING FROM AREAS OF EXPOSED SOILS TO PAVED SURFACES.

1.4.4 INSTALL SEDIMENT BARRIERS

SEDIMENT BARRIERS SHALL BE UTILIZED TO INTERCEPT RUNOFF AND ALLOW SUSPENDED SEDIMENT TO SETTLE OUT. THEY SHALL BE INSTALLED PRIOR TO ANY UP SLOPE WORK.

1.4.5 DIVERT UPLAND RUNOFF

DIVERSIONARY MEASURES SHALL BE USED TO INTERCEPT RUNOFF FROM ABOVE THE CONSTRUCTION AND DIRECT IT AROUND THE DISTURBED AREA SO THAT CLEAN WATER DOES NOT BECOME MUDDIED WHILE TRAVELING OVER EXPOSED SOILS ON THE CONSTRUCTION SITE.

1.4.6 SLOW DOWN CHANNELIZED RUNOFF

CHECK STRUCTURES SHALL BE UTILIZED TO REDUCE THE VELOCITY, AND THUS THE EROSION POTENTIAL, OF CONCENTRATED FLOW IN CHANNELS.

1.4.7 CONSTRUCT PERMANENT CONTROLS

PERMANENT STORMWATER TREATMENT DEVICES SHALL BE INSTALLED IN ACCORDANCE WITH PERMIT CONDITIONS.

1.4.8 STABILIZE EXPOSED SOILS DURING CONSTRUCTION

ALL AREAS OF DISTURBANCE MUST HAVE TEMPORARY STABILIZATION IN PLACE WITHIN 48 HOURS OF DISTURBANCE OR IN ACCORDANCE WITH THE CONSTRUCTION GENERAL PERMIT 3-9020 AUTHORIZATION.

SURFACE ROUGHENING OF ALL EXPOSED SLOPES, COMBINED WITH TEMPORARY MULCHING, SHALL BE UTILIZED ON A REGULAR BASIS. BIODEGRADABLE EROSION CONTROL MATTING OR AN EQUIVALENT SHALL BE USED TO STABILIZE ALL SLOPES STEEPER THAN 1:3.

THE FORECAST OF RAINFALL EVENTS SHALL TRIGGER IMMEDIATE PROTECTION OF EXPOSED SOILS.

1.4.9 WINTER STABILIZATION

VARIOUS MEASURES SPECIFIC TO WINTER MAY BE NECESSARY SHOULD THE PROJECT EXTEND INTO WINTER (OCTOBER 15 THROUGH APRIL 15). REFER TO THE LOW RISK SITE HANDBOOK FOR GUIDANCE.

1.4.10 STABILIZE SOIL AT FINAL GRADE

EXPOSED SOIL MUST BE STABILIZED WITHIN 48 HOURS OF REACHING FINAL GRADE.

SEED, MULCH, FERTILIZER AND LIME SHALL BE USED TO ESTABLISH PERMANENT VEGETATION. FOR SLOPES STEEPER THAN 1:3, BIODEGRADABLE EROSION CONTROL MATTING OR AN EQUIVALENT SHALL BE USED INSTEAD OF MULCH.

1.4.11 DE-WATERING ACTIVITIES

DISCHARGE FROM DEWATERING ACTIVITIES THAT FLOWS OFF OF THE CONSTRUCTION SITE MUST NOT CAUSE OR CONTRIBUTE TO A VIOLATION OF THE VERMONT WATER QUALITY STANDARDS.

1.4.12 INSPECT YOUR SITE

INSPECT THE PROJECT SITE BASED ON SPECIAL PROVISION REQUIREMENTS OR CONSTRUCTION GENERAL PERMIT AUTHORIZATION STIPULATIONS.

1.5 SEQUENCE AND STAGING



THIS SECTION WILL BE DEVELOPED BY THE CONTRACTOR USING THE GUIDANCE OUTLINED IN THE VTRANS EPSC PLAN CONTRACTOR CHECKLIST.

1.5.1 CONSTRUCTION SEQUENCE

1.5.2 OFF-SITE ACTIVITIES

IN ADDITION TO THE CONTRACTOR CHECKLIST ANY ACTIVITIES OUTSIDE THE CONSTRUCTION LIMITS SHALL FOLLOW SUBSECTIONS 105.25- 105.29 OF THE STANDARD SPECIFICATIONS FOR CONSTRUCTION.

PROJECT NAME:	BRAINTREE
PROJECT NUMBER:	BRO 1444(36)
FILE NAME: s95j292epsc_narrative.dgn	PLOT DATE: 31-DEC-2009
PROJECT LEADER: K. HIGGINS	DRAWN BY: R. PELLET
DESIGNED BY: T. FILLBACH	CHECKED BY: T. FILLBACH
EPSC NARRATIVE	SHEET 10 OF 26

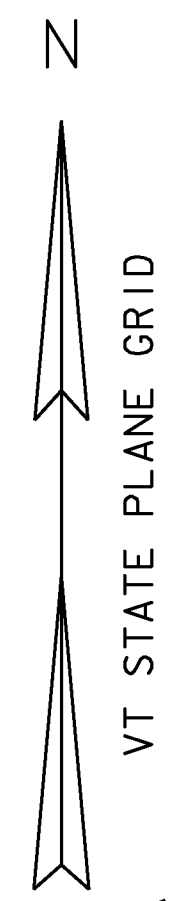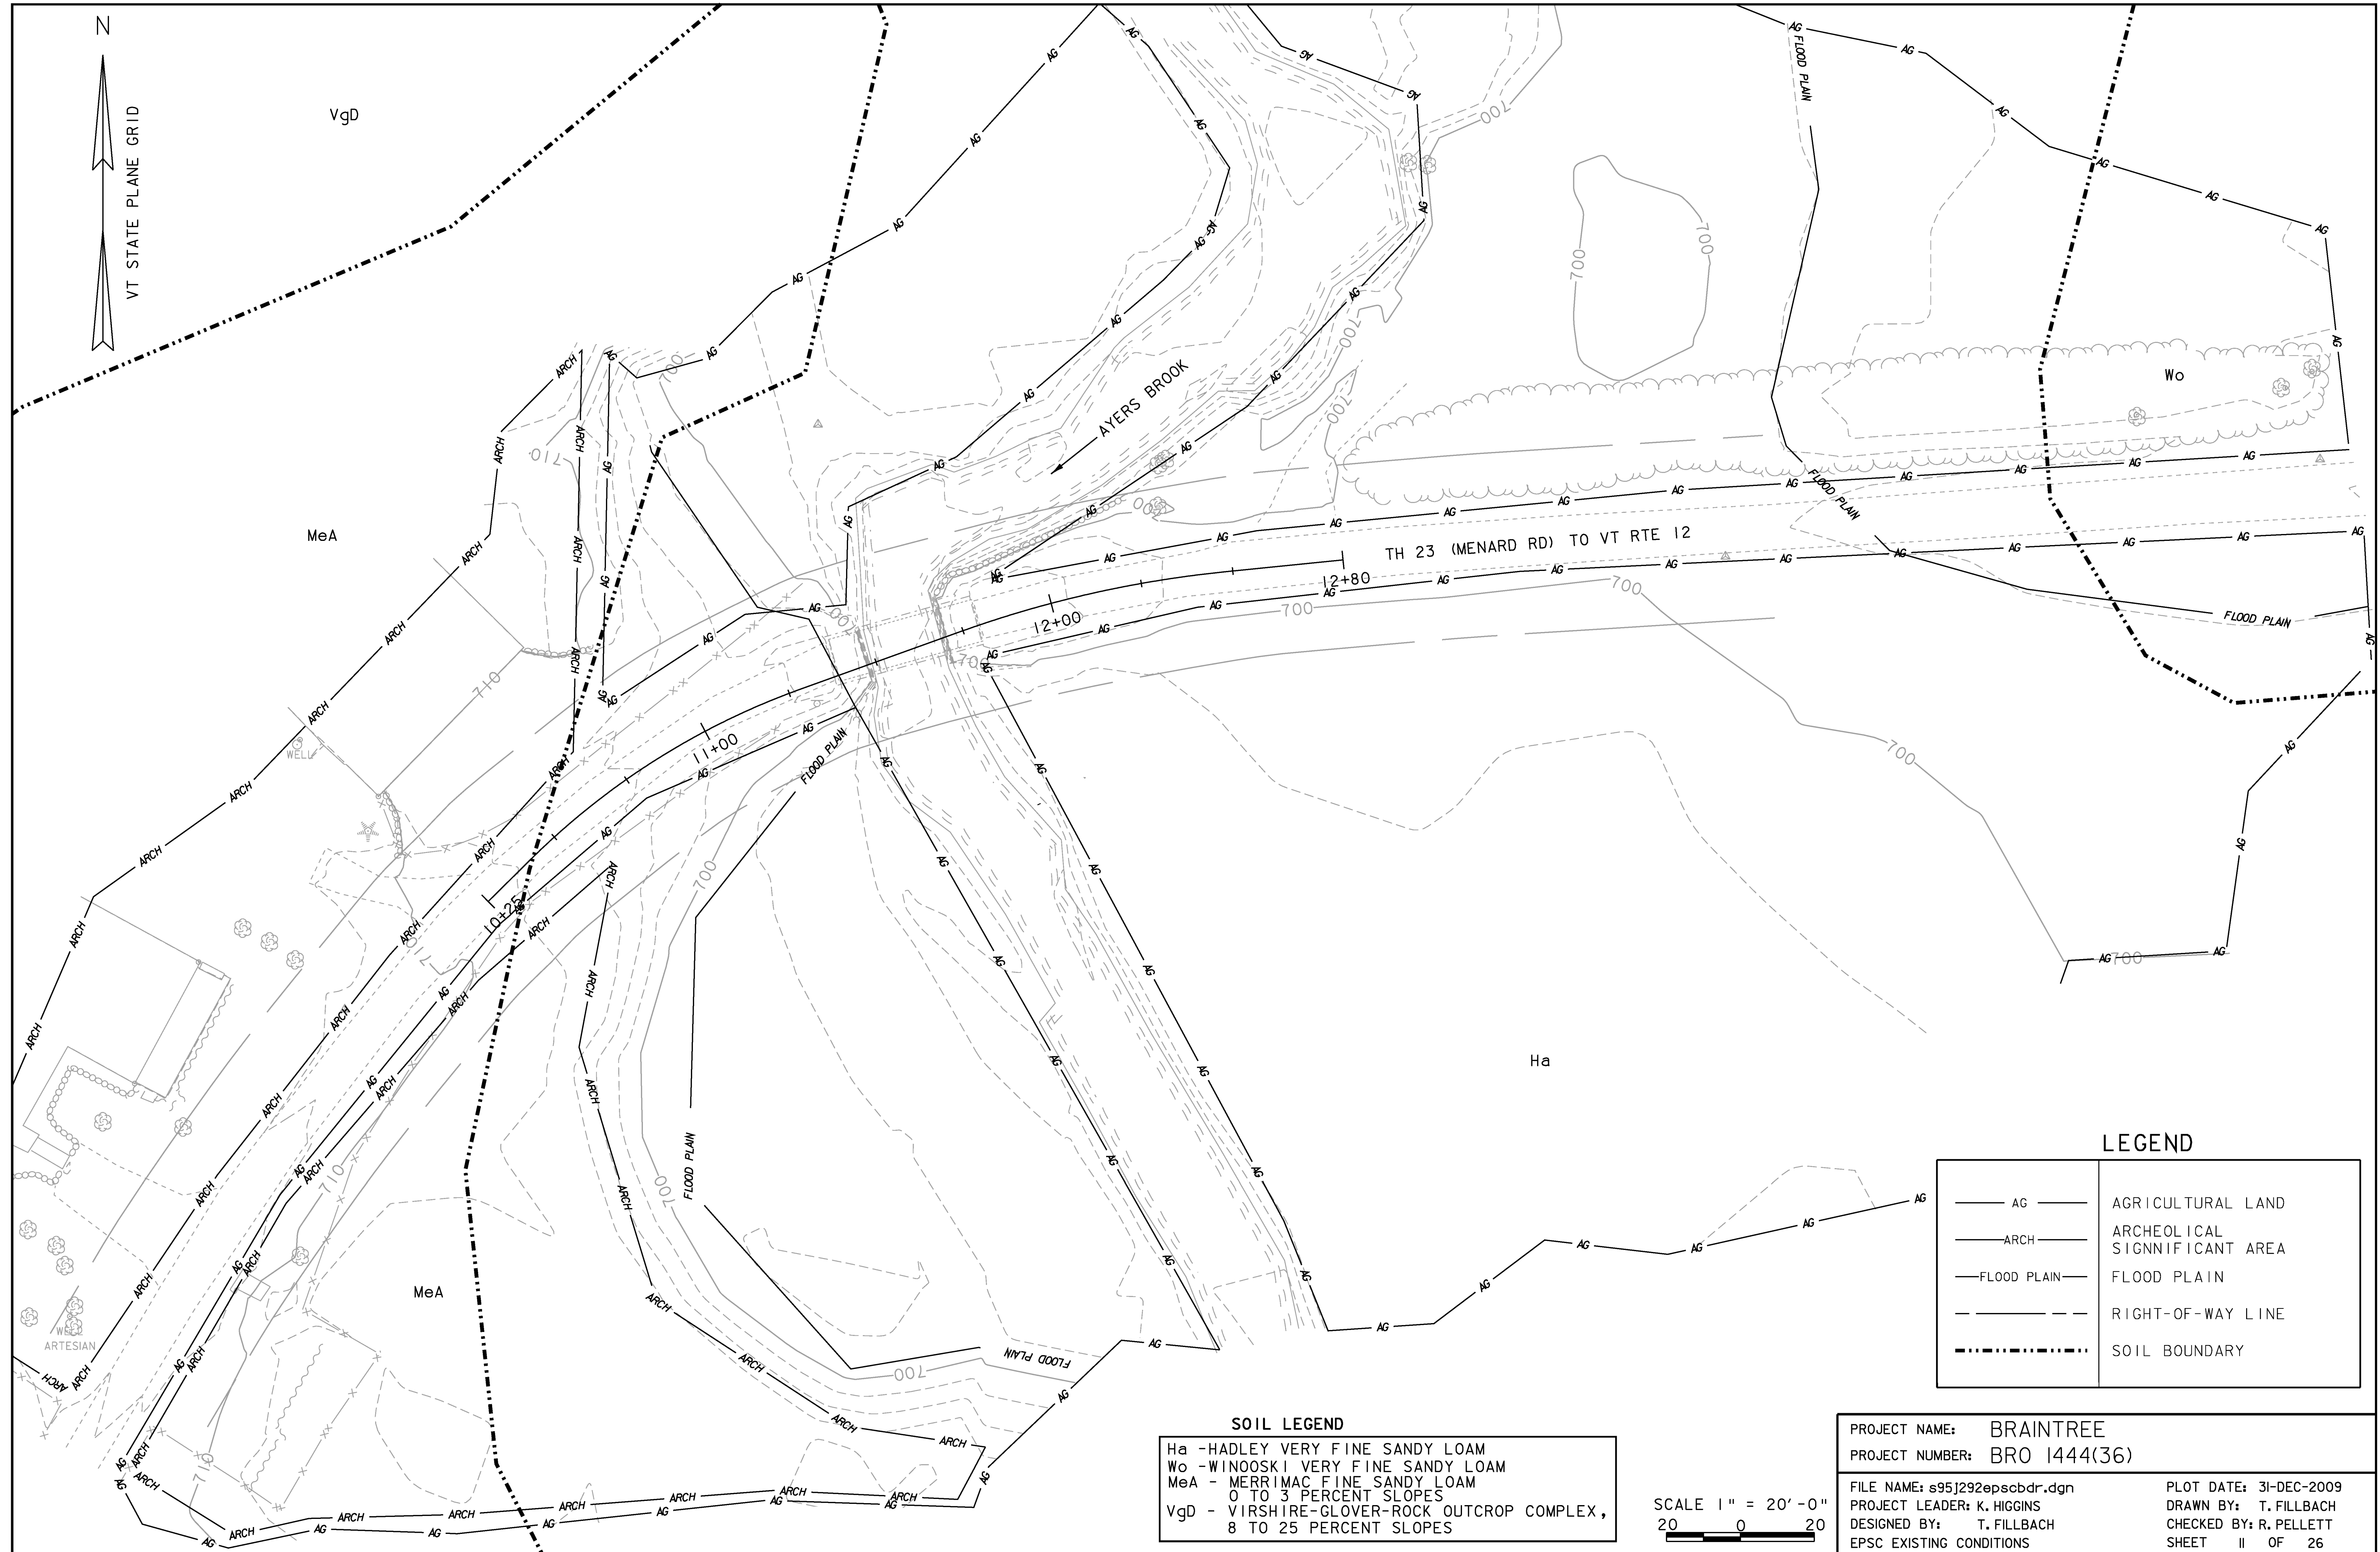

LEGEND

— AG —	AGRICULTURAL LAND
— ARCH —	ARCHEOLOGICAL SIGNIFICANT AREA
— FLOOD PLAIN —	FLOOD PLAIN
- - - - -	RIGHT-OF-WAY LINE
- · - · - · -	SOIL BOUNDARY

SOIL LEGEND

Ha	-HADLEY VERY FINE SANDY LOAM
Wo	-WINOOSKI VERY FINE SANDY LOAM
MeA	-MERRIMAC FINE SANDY LOAM 0 TO 3 PERCENT SLOPES
VgD	-VIRSHIRE-GLOVER-ROCK OUTCROP COMPLEX, 8 TO 25 PERCENT SLOPES

SCALE 1" = 20'-0"
20 0 20

PROJECT NAME:	BRAINTREE	PLOT DATE:	31-DEC-2009
PROJECT NUMBER:	BRO 1444(36)	DRAWN BY:	T. FILLBACH
FILE NAME:	s95j292epsbdr.dgn	CHECKED BY:	R. PELLETT
PROJECT LEADER:	K. HIGGINS	SHEET	II OF 26
DESIGNED BY:	T. FILLBACH		
EPSC EXISTING CONDITIONS			

SOIL CLASSIFICATION

AASHTO

A1	Gravel and Sand
A3	Fine Sand
A2	Silty or Clayey Gravel and Sand
A4	Silty Soil - Low Compressibility
A5	Silty Soil - Highly Compressible
A6	Clayey Soil - Low Compressibility
A7	Clayey Soil - Highly Compressible

ROCK QUALITY DESIGNATION

R.Q.D. (%)	ROCK DESCRIPTION
<25	Very Poor
25 to 50	Poor
51 to 75	Fair
76 to 90	Good
>90	Excellent

SHEAR STRENGTH

UNDRAINED SHEAR STRENGTH IN P.S.F.	CONSISTENCY
<250	Very Soft
250-500	Soft
500-1000	Med. Stiff
1000-2000	Stiff
2000-4000	Very Stiff
>4000	Hard

CORRELATION GUIDE OF "N" TO DENSITY/CONSISTENCY

DENSITY (GRANULAR SOILS)		CONSISTENCY (COHESIVE SOILS)	
N	DESCRIPTIVE TERM	N	DESCRIPTIVE TERM
<5	Very Loose	<2	Very Soft
5-10	Loose	2-4	Soft
11-24	Med. Dense	5-8	Med. Stiff
25-50	Dense	9-15	Stiff
>50	Very Dense	16-30	Very Stiff
		31-60	Hard
		>60	Very Hard


COMMONLY USED SYMBOLS

- ▼ Water Elevation
- ⊕ Standard Penetration Boring
- ⊗ Auger Boring
- ⊙ Rod Sounding
- S Sample
- N Standard Penetration Test
- Blow Count Per Foot For:
- 2" O.D. Sampler
- 1 3/8" I.D. Sampler
- Hammer Weight Of 140 Lbs.
- Hammer Fall Of 30"
- VS Field Vane Shear Test
- US Undisturbed Soil Sample
- B Blast
- DC Diamond Core
- MD Mud Drill
- WA Wash Ahead
- HSA Hollow Stem Auger
- AX Core Size 1 1/8"
- BX Core Size 1 3/8"
- NX Core Size 2 1/8"
- M Double Tube Core Barrel Used
- LL Liquid Limit
- PL Plastic Limit
- PI Plasticity Index
- NP Non Plastic
- w Moisture Content (Dry Wgt. Basis)
- D Dry
- M Moist
- MTW Moist To Wet
- W Wet
- Sat Saturated
- Bo Boulder
- Gr Gravel
- Sa Sand
- Sl Silt
- Cl Clay
- HP Hardpan
- Le Ledge
- NLTD No Ledge To Depth
- CNPF Can Not Penetrate Further
- TLOB To Ledge Or Boulder
- NR No Recovery
- Rec. Recovery
- %Rec. Percent Recovery
- ROD Rock Quality Designation
- CBR California Bearing Ratio
- < Less Than
- > Greater Than
- R Refusal (N > 100)

COLOR			
blk	Black	pnk	Pink
bl	Blue	pu	Purple
brn	Brown	rd	Red
dk	Dark	tn	Tan
gry	Gray	wh	White
gn	Green	yel	Yellow
lt	Light	mltc	Multicolored
or	Orange		

BORING CHART

HOLE NO.	SURV. STATION	OFFSET	NORTHING (Y)	EASTING (X)	TOP OF BEDROCK
B-101	11+86.6	3.5	540483.97	1600666.96	638.06
B-102	11+31.6	-7.5	540475.96	1600611.57	671.82

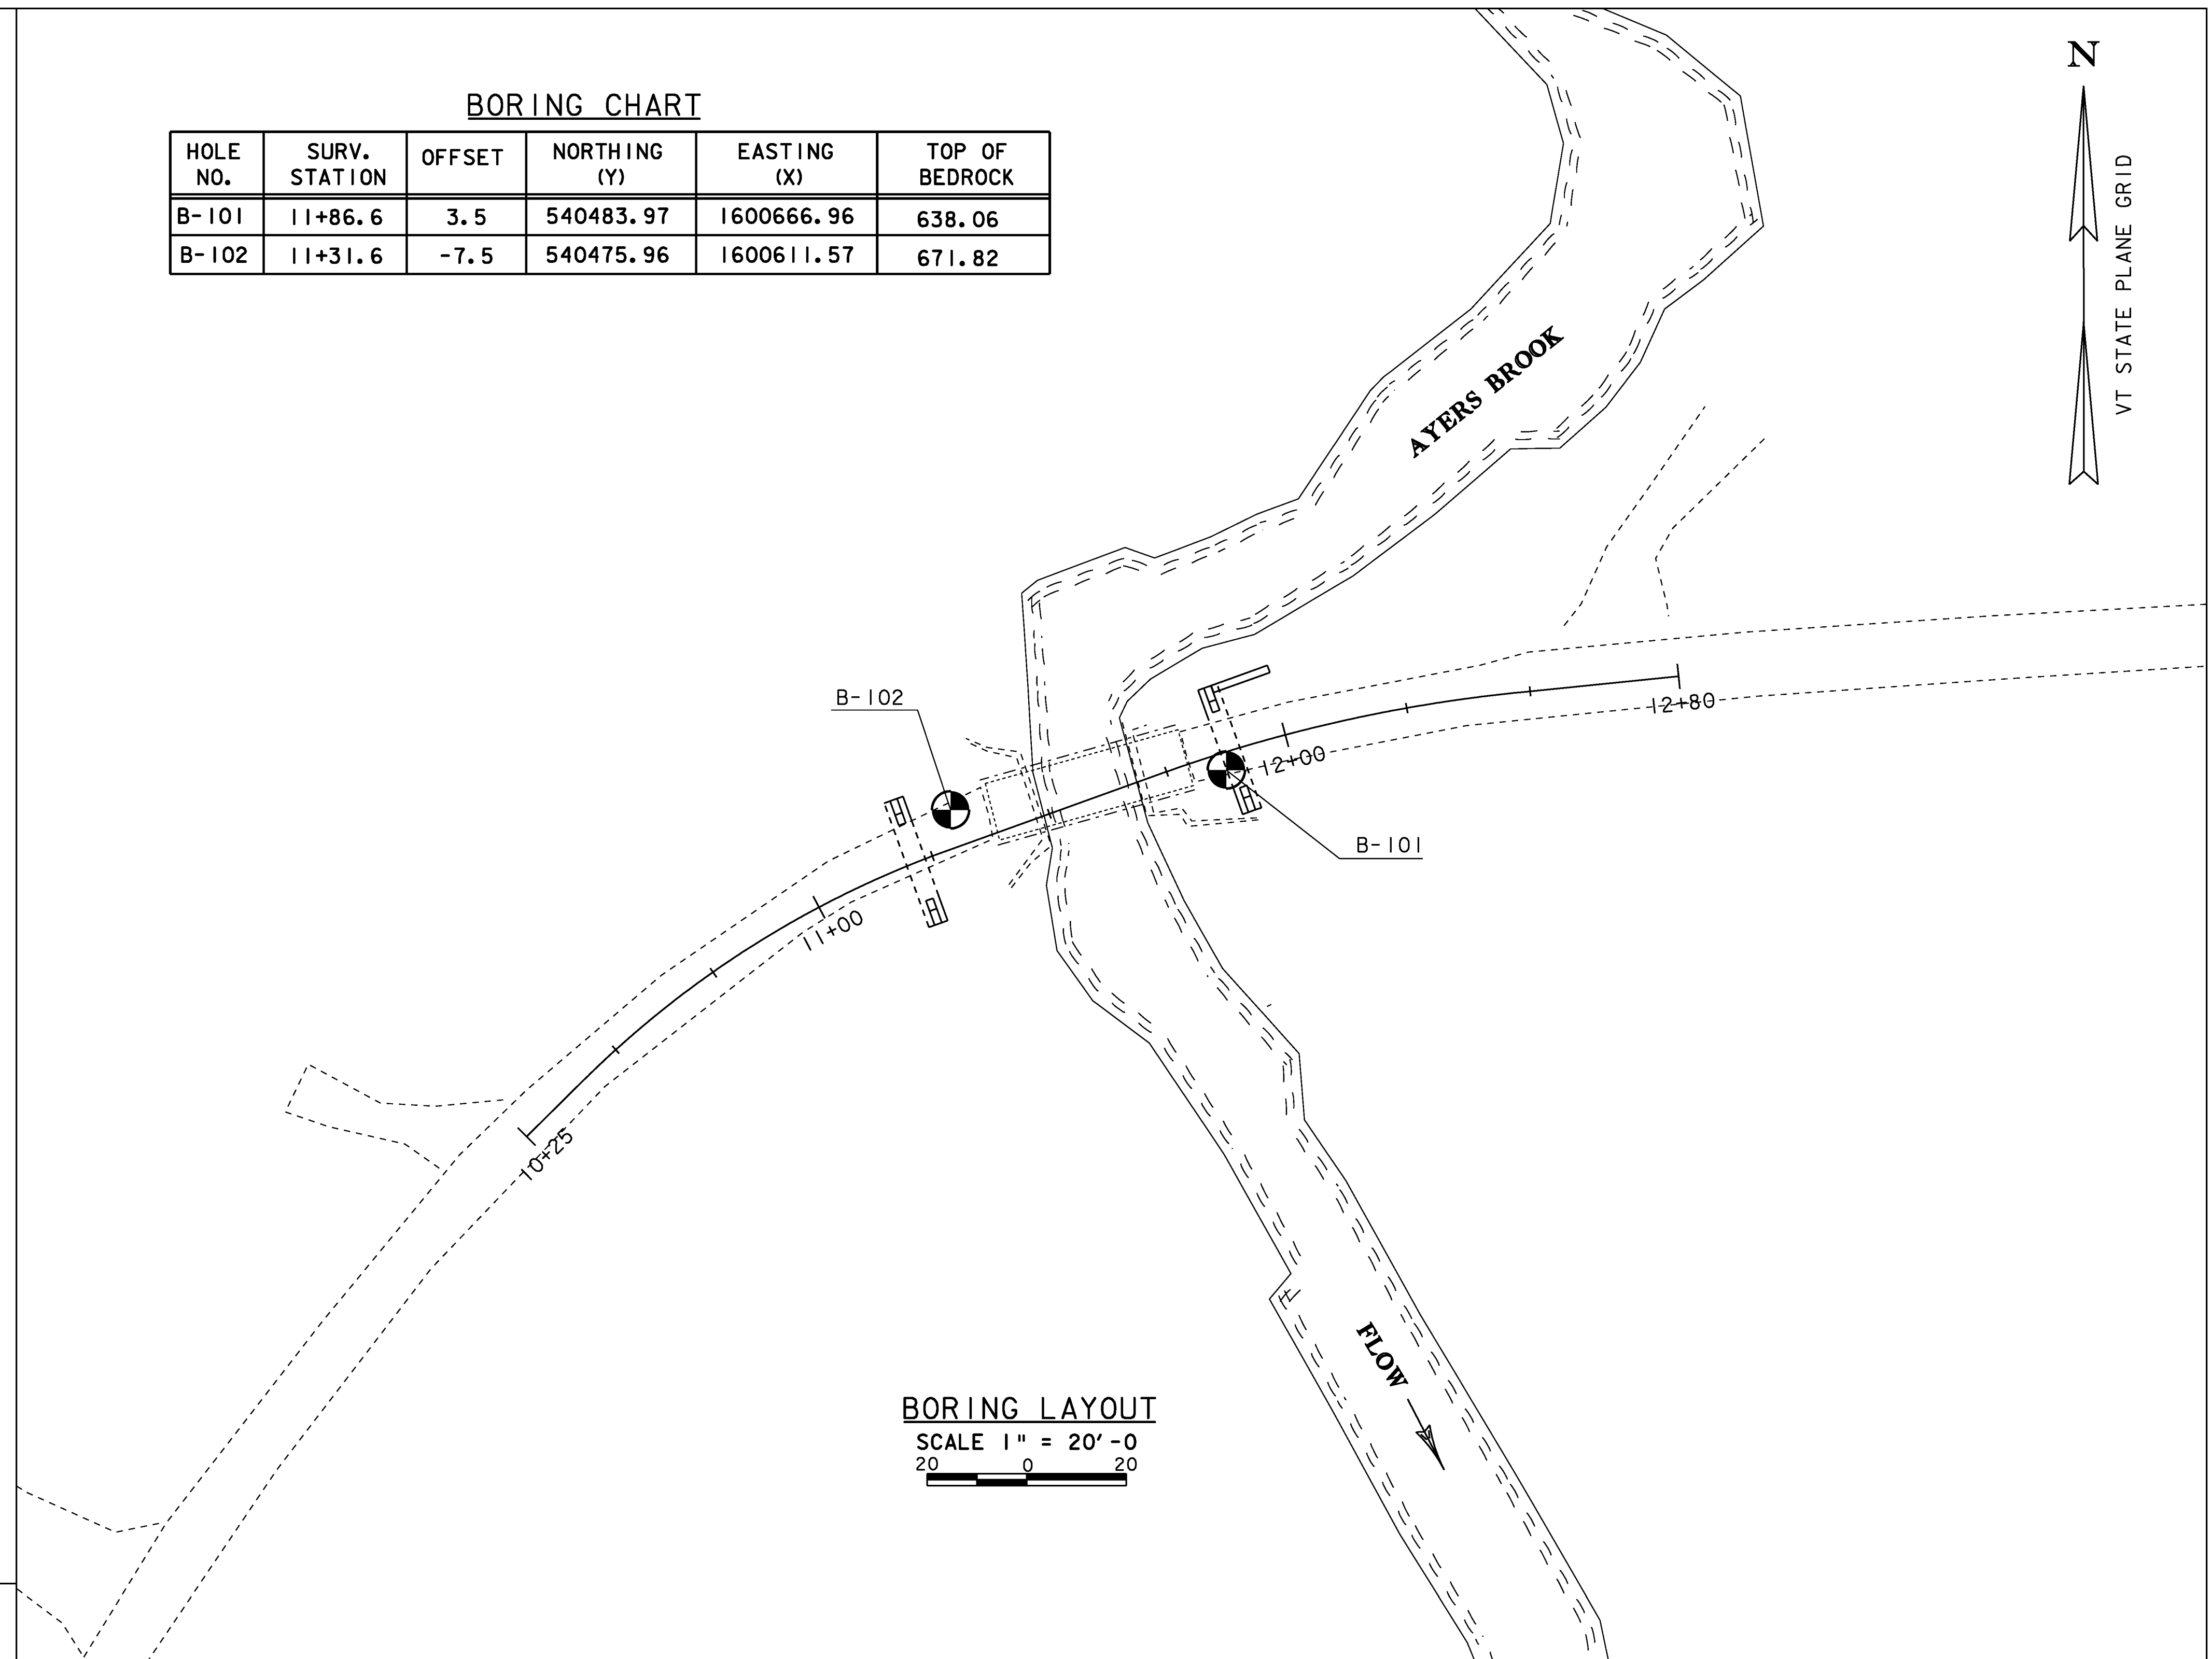

BORING LAYOUT

SCALE 1" = 20'-0"
20 0 20

DEFINITIONS (AASHTO)

- BEDROCK (LEDGE)** - Rock in its native location of indefinite thickness.
- BOULDER** - A rock fragment with an average dimension > 12 inches.
- COBBLE** - Rock fragments with an average dimension between 3 and 12 inches.
- GRAVEL** - Rounded particles of rock < 3" and > 0.075" (#10 sieve).
- SAND** - Particles of rock < 0.075" (#10 sieve) and > 0.0025" (#200 sieve).
- SILT** - Soil < 0.0025" (#200 sieve), non or slightly plastic and exhibits no strength when air-dried.
- CLAY** - Fine grained soil, exhibits plasticity when moist and considerable strength when air-dried.
- VARVED** - Alternate layers of silt and clay.
- HARDPAN** - Extremely dense soil, cemented layer, not softened when wet.
- MUCK** - Soft organic soil (containing > 10% organic material).
- MOISTURE CONTENT** - Weight of water divided by dry weight of soil.
- FLOWING SAND** - Granular soil so saturated (loose) that it flows into drill casing during extraction of wash rod.
- STRIKE** - Angle from magnetic north to line of intersection of bed with a horizontal plane.
- DIP** - Inclination of bed with a horizontal plane.

GENERAL NOTES

1. The subsurface explorations shown herein were made between 6/17/09 and 6/25/09 by the Agency.
2. Soil and rock classifications, properties and descriptions are based on engineering interpretation from available subsurface information by the Agency and may not necessarily reflect actual variations in subsurface conditions that may be encountered between individual boring or sample locations.
3. Observed water levels and/or conditions indicated are as recorded at the time of exploration and may vary according to the prevailing rainfall, methods of exploration and other factors.
4. Engineering Judgment was exercised in preparing the subsurface information presented herein. Analysis and interpretation of subsurface data was performed and interpreted for Agency design and estimating purposes. Presentation of the information in the Contract is intended to provide the Contractor access to the same data available to the Agency. The subsurface information is presented in good faith and is not intended as a substitute for personal investigation, independent interpretation, independent analysis or judgment by the Contractor.
5. Pictorial structure details shown on the boring plan layout or soils profile are for illustrative purposes only and may not accurately portray final contract details.
6. Terminology used on boring logs to describe the hardness, degree of weathering, and spacing of fractures, joints and other discontinuities in the bedrock is defined in the AASHTO Manual on Subsurface Investigations, 1988.

PROJECT NAME:	BRAINTREE	PLOT DATE:	31-DEC-2009
PROJECT NUMBER:	BRO 1444(36)	DRAWN BY:	R. PELLET
FILE NAME:	s95J292bor.dgn	CHECKED BY:	T. FILLBACH
PROJECT LEADER:	K. HIGGINS	BORING LAYOUT SHEET	SHEET 12 OF 26

PROJECT NAME: BRAINTREE
 SITE NAME: TH-23
 STATION: 11+86.6
 OFFSET: 3.50
 VTSPG NAD83: N 540483.97 ft E 1600666.96 ft

PROJECT NUMBER: BRO 1444(36)
 SITE NUMBER: BR-12
 GROUND ELEVATION: 705.06 ft
 GROUNDWATER DEPTH: NONE TAKEN
 PROJECT PIN NUMBER: 95J292

BORING CREW
 CREW CHIEF: PORTER
 DRILLER: PORTER
 LOGGER: WERNER

BORING RIG: LAG TRACK RIG #09 w/AUTO HAMMER
 BORING TYPE: WASH BORE
 SAMPLE TYPE: SPLIT BARREL
 CHECKED BY: NSM

DEPTH (ft)	SYMBOL	CLASSIFICATION OF MATERIALS (Description)	BLOWS PER FOOT	M.C. (%)	GRAVEL (%)	SAND (%)	FINES (%)	LL (%)	PI (%)
			RUN	REC (%)	ROD (%)	Dip (deg)	Drill Rate (min/ft)		
		A-1-a, SaGr, brn, Moist, Rec. = 1.4 ft	14	4.4	52.6	35.2	12.2		
		A-1-b, SiGrSa, brn, Moist, Rec. = 1.6 ft	17	7.0	36.7	43.2	20.1		
		A-1-b, SiGrSa, brn, Moist, Rec. = 1.3 ft	10	8.6	33.7	43.6	22.7		
		A-1-a, SaGr, brn-gry, Moist, Rec. = 1.3 ft	35	8.9	60.4	24.2	15.4		
		A-1-a, SaGr, gry, Wet, Rec. = 1.1 ft	11	12.7	51.1	34.2	14.7		
		A-1-a, SaGr, gry, Wet, Rec. = 1.3 ft	11	11.3	54.8	33.1	12.1		
		A-4, Si, gry, Wet, Rec. = 1.0 ft	5	29.6	8.5	6.6	84.9		
		A-4, Si, gry, Wet	2	30.3	0.0	2.7	97.3		
		Visual Classification, Si, gry, Wet, Rec. = 1.3 ft	2	33.8					
		Visual Classification, Si, gry, Wet, Rec. = 1.4 ft	3	34.0					
		A-4, Si, gry, Wet, Rec. = 2.0 ft	3	35.4	0.0	0.3	99.7		
		Visual Classification, Si, gry, Wet, Rec. = 2.0 ft	2	36.0					
		A-4, Si, gry, Wet, Rec. = 2.0 ft	4	36.9	0.0	1.1	98.9		
		Visual Classification, Si, gry, Wet, Rec. = 2.0 ft	WH	37.3					
		A-4, Si, gry, Wet, Rec. = 0.9 ft	WH	40.8	0.0	0.6	99.4	35	2
		Visual Classification, Si, gry, Wet, Rec. = 2.0 ft	1	38.2					
		Visual Classification, Si, gry, Wet, Rec. = 2.0 ft	1	41.3					
		A-4, Si, gry, Wet, Rec. = 1.1 ft	WH	40.1	0.0	0.8	99.2		
		A-1-a, SaGr, gry, Wet, Rec. = 0.7 ft, Broken Rock was within sample.	35	11.8	61.8	26.0	12.2		
		Dark gray, Phyllite, with occasional pyrite rich zones. Competent. Low ROD possibly due to mechanical breakage during drilling. Moderately soft, Unweathered, BXMDC, 67.0 ft - 72.0 ft, Rec. = 4.6 ft	1	92	18	50	8		
		Dark gray, Phyllite, with occasional pyrite rich zones. Competent. Low ROD possibly due to mechanical breakage during drilling. Moderately soft, Unweathered, BXMDC, 72.0 ft - 77.0 ft, Rec. = 4.95 ft	2	99	60	50	10		
		Hole stopped @ 77.0 ft					10		
							11		
							11		

BOTTOM OF ABUT. 2
ELEV. 697.50

PILE DEPTH (ESTIMATED)
ELEV. 638.00
@ ABUT. 2

LOG OF BORING - BRAINTREE - BRO 1444(36) - VT ADT.GBT 12/4/09

PROJECT NAME: BRAINTREE
 SITE NAME: TH-23
 STATION: 11+31.6
 OFFSET: -7.50
 VTSPG NAD83: N 540475.96 ft E 1600611.57 ft

PROJECT NUMBER: BRO 1444(36)
 SITE NUMBER: BR-12
 GROUND ELEVATION: 706.32 ft
 GROUNDWATER DEPTH: 9.5 ft
 PROJECT PIN NUMBER: 95J292

BORING CREW
 CREW CHIEF: PORTER
 DRILLER: PORTER
 LOGGER: WERNER



BORING RIG: LAG TRACK RIG #09 w/AUTO HAMMER
 BORING TYPE: WASH BORE
 SAMPLE TYPE: SPLIT BARREL
 CHECKED BY: NSM

DEPTH (ft)	SYMBOL	CLASSIFICATION OF MATERIALS (Description)	BLOWS PER FOOT	M.C. (%)	GRAVEL (%)	SAND (%)	FINES (%)
			RUN	REC (%)	ROD (%)	Dip (deg)	Drill Rate (min/ft)
		A-1-a, SaGr, brn, Moist, Rec. = 1.4 ft	19	3.2	54.3	32.4	13.3
		A-2-4, SiGrSa, brn, Moist, Rec. = 1.6 ft	20	7.9	33.3	40.7	26.0
		A-2-4, SiGrSa, brn, Moist, Rec. = 1.4 ft	10	9.1	30.9	44.6	24.5
		A-1-b, SiGrSa, brn, Moist, Rec. = 1.2 ft	4	9.2	35.3	43.9	20.8
		A-1-b, SaGr, brn, Wet, Rec. = 0.9 ft	3	14.6	42.5	39.9	17.6
		A-4, SaSi, brn, Wet, Rec. = 1.3 ft	7	24.1	18.5	30.6	50.9
		Field Note: No Recovery, Appears to be silt	3				
		Visual Classification, Si, gry, Wet, Rec. = 0.8 ft	3	31.7			
		A-4, Si, gry, Wet, Rec. = 1.5 ft	3	34.1	0.0	1.1	98.9
		A-4, Si, gry, Wet, Rec. = 1.6 ft	3	35.1	0.0	0.5	99.5
		Visual Classification, Si, gry, Wet, Rec. = 2.0 ft	3	35.8			
		A-2-4, SiSaGr, gry, Wet, Rec. = 1.4 ft	11	11.2	38.8	34.0	27.2
		Field Class: Cobbles, BXDC, Cleaned out casing					
		A-1-b, SaGr, gry, Wet, Rec. = 0.8 ft	68	9.4	55.1	29.2	15.7
		Dark gray, Meta-Limestone, grading to phyllite. Competent. Low ROD possibly due to mechanical breakage during drilling. Moderately soft to moderately hard, Unweathered, BXMDC, 34.5 ft - 38.5 ft, Rec. = 3.4 ft	1	85	29	50	7
		Dark gray, Phyllite, Competent. Low ROD possibly due to mechanical breakage during drilling. Moderately soft, Unweathered, BXMDC, 38.5 ft - 41.5 ft, Rec. = 2.7 ft	2	90	11	50	6
		Dark gray, Phyllite, Competent. Low ROD possibly due to mechanical breakage during drilling. Moderately soft, Unweathered, BXMDC, 41.5 ft - 42.5 ft, Rec. = 1.0 ft	3	100	0	50	9
		Hole stopped @ 42.5 ft					16
							7
							7
							15
							12

BOTTOM OF ABUT. 1
ELEV. 698.50



PILE DEPTH (ESTIMATED)
ELEV. 671.50
@ ABUT. 1

LOG OF BORING - BRAINTREE - BRO 1444(36) - VT ADT.GBT 12/4/09

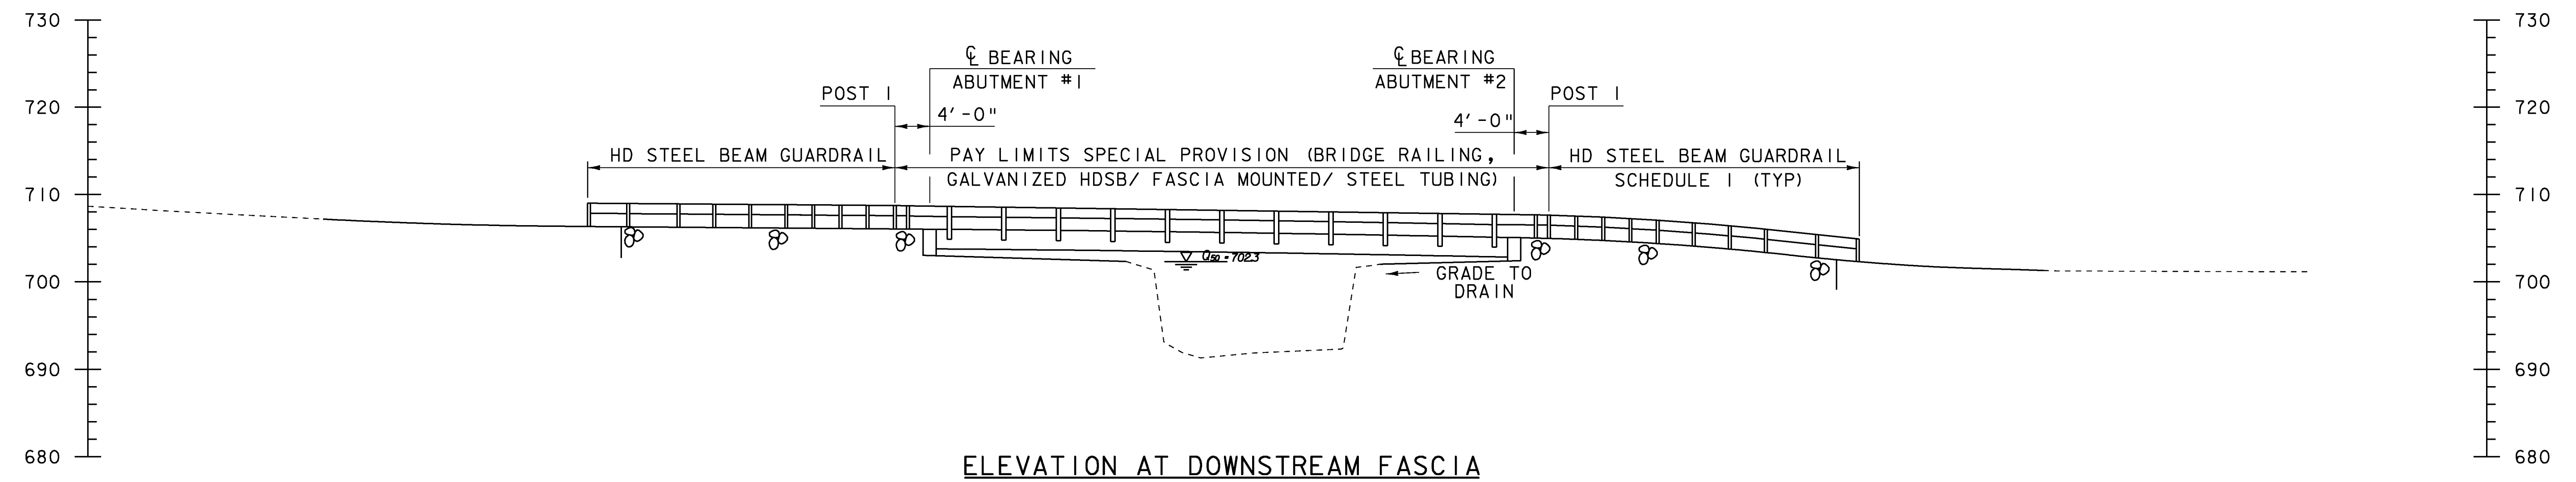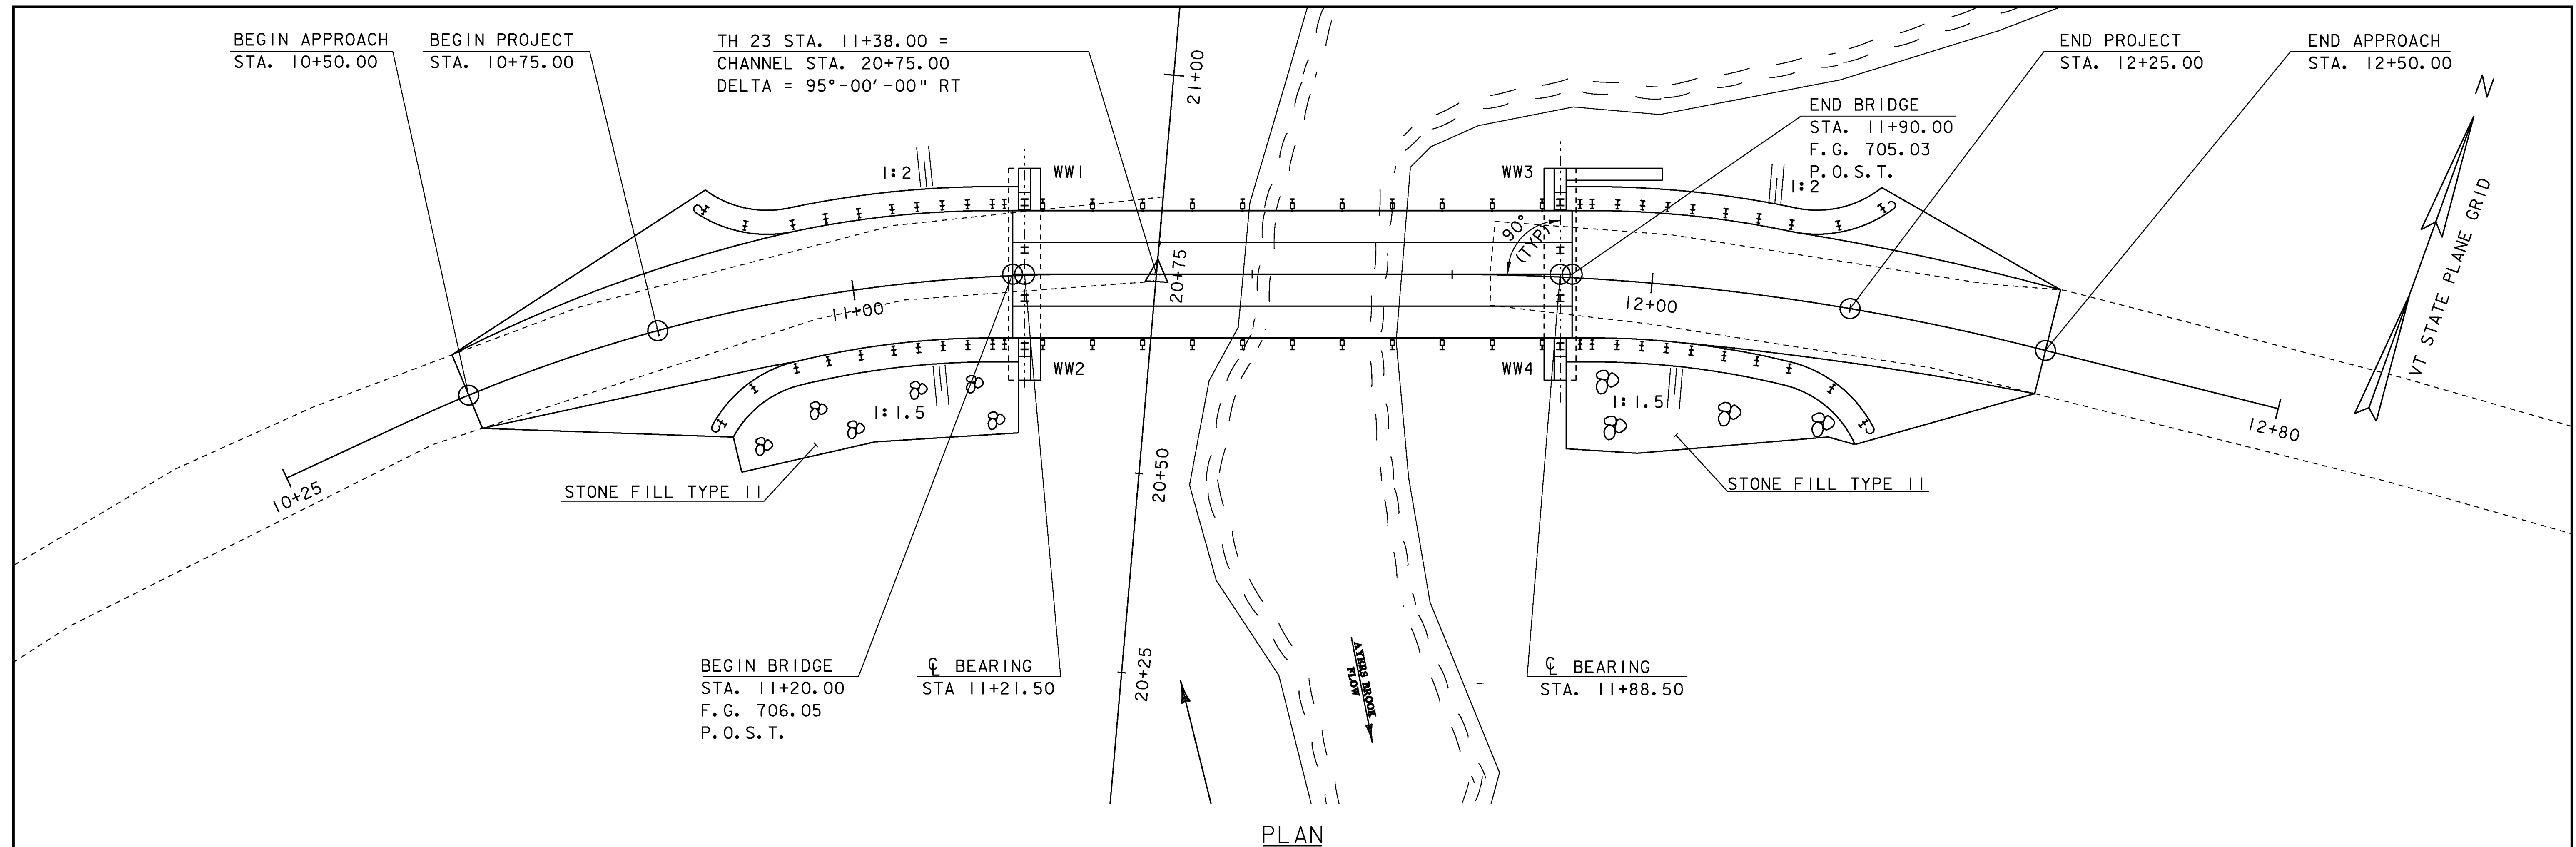


SCALE 1" = 10'-0"
 10 0 10


PROJECT NAME: BRAINTREE	PLOT DATE: 31-DEC-2009
PROJECT NUMBER: BRO 1444(36)	DRAWN BY: R. PELLETT
FILE NAME: s95j292pe.dgn	CHECKED BY: T. FILLBACH
PROJECT LEADER: K. HIGGINS	SHEET 14 OF 26
DESIGNED BY: T. FILLBACH	
PLAN AND ELEVATION	

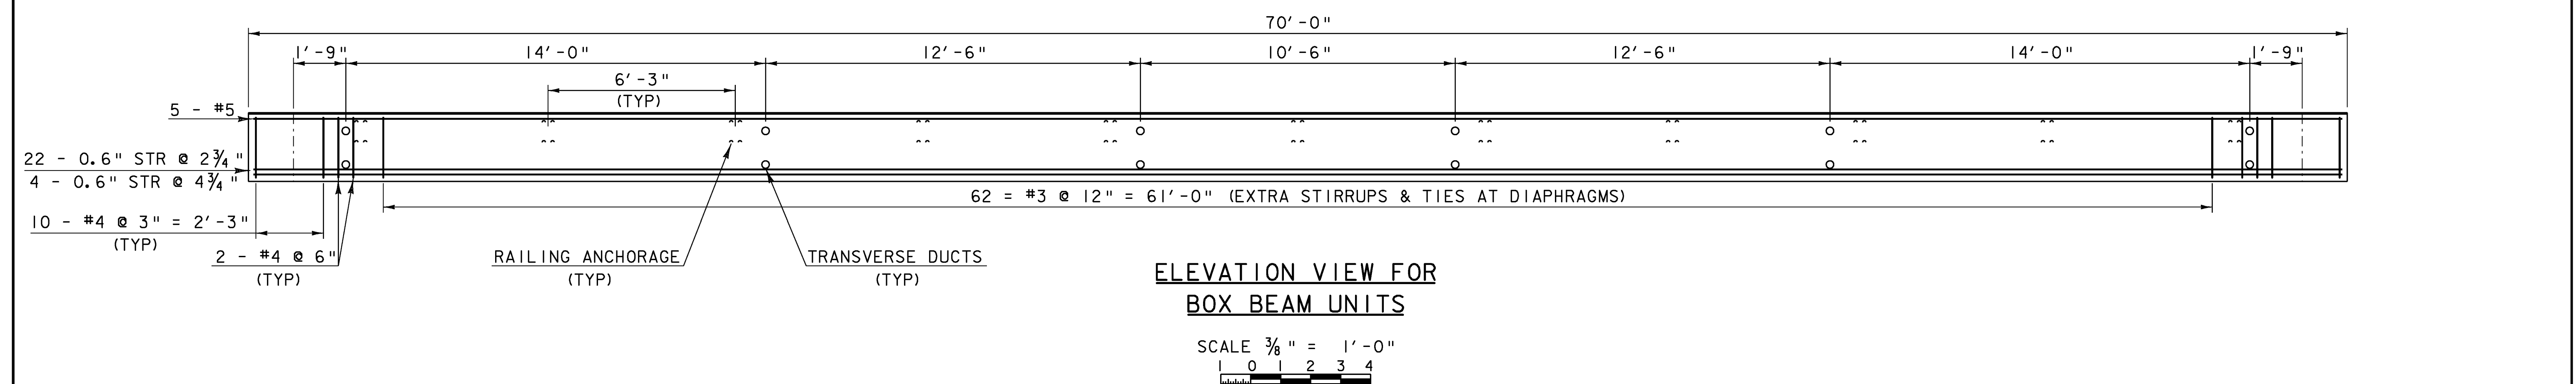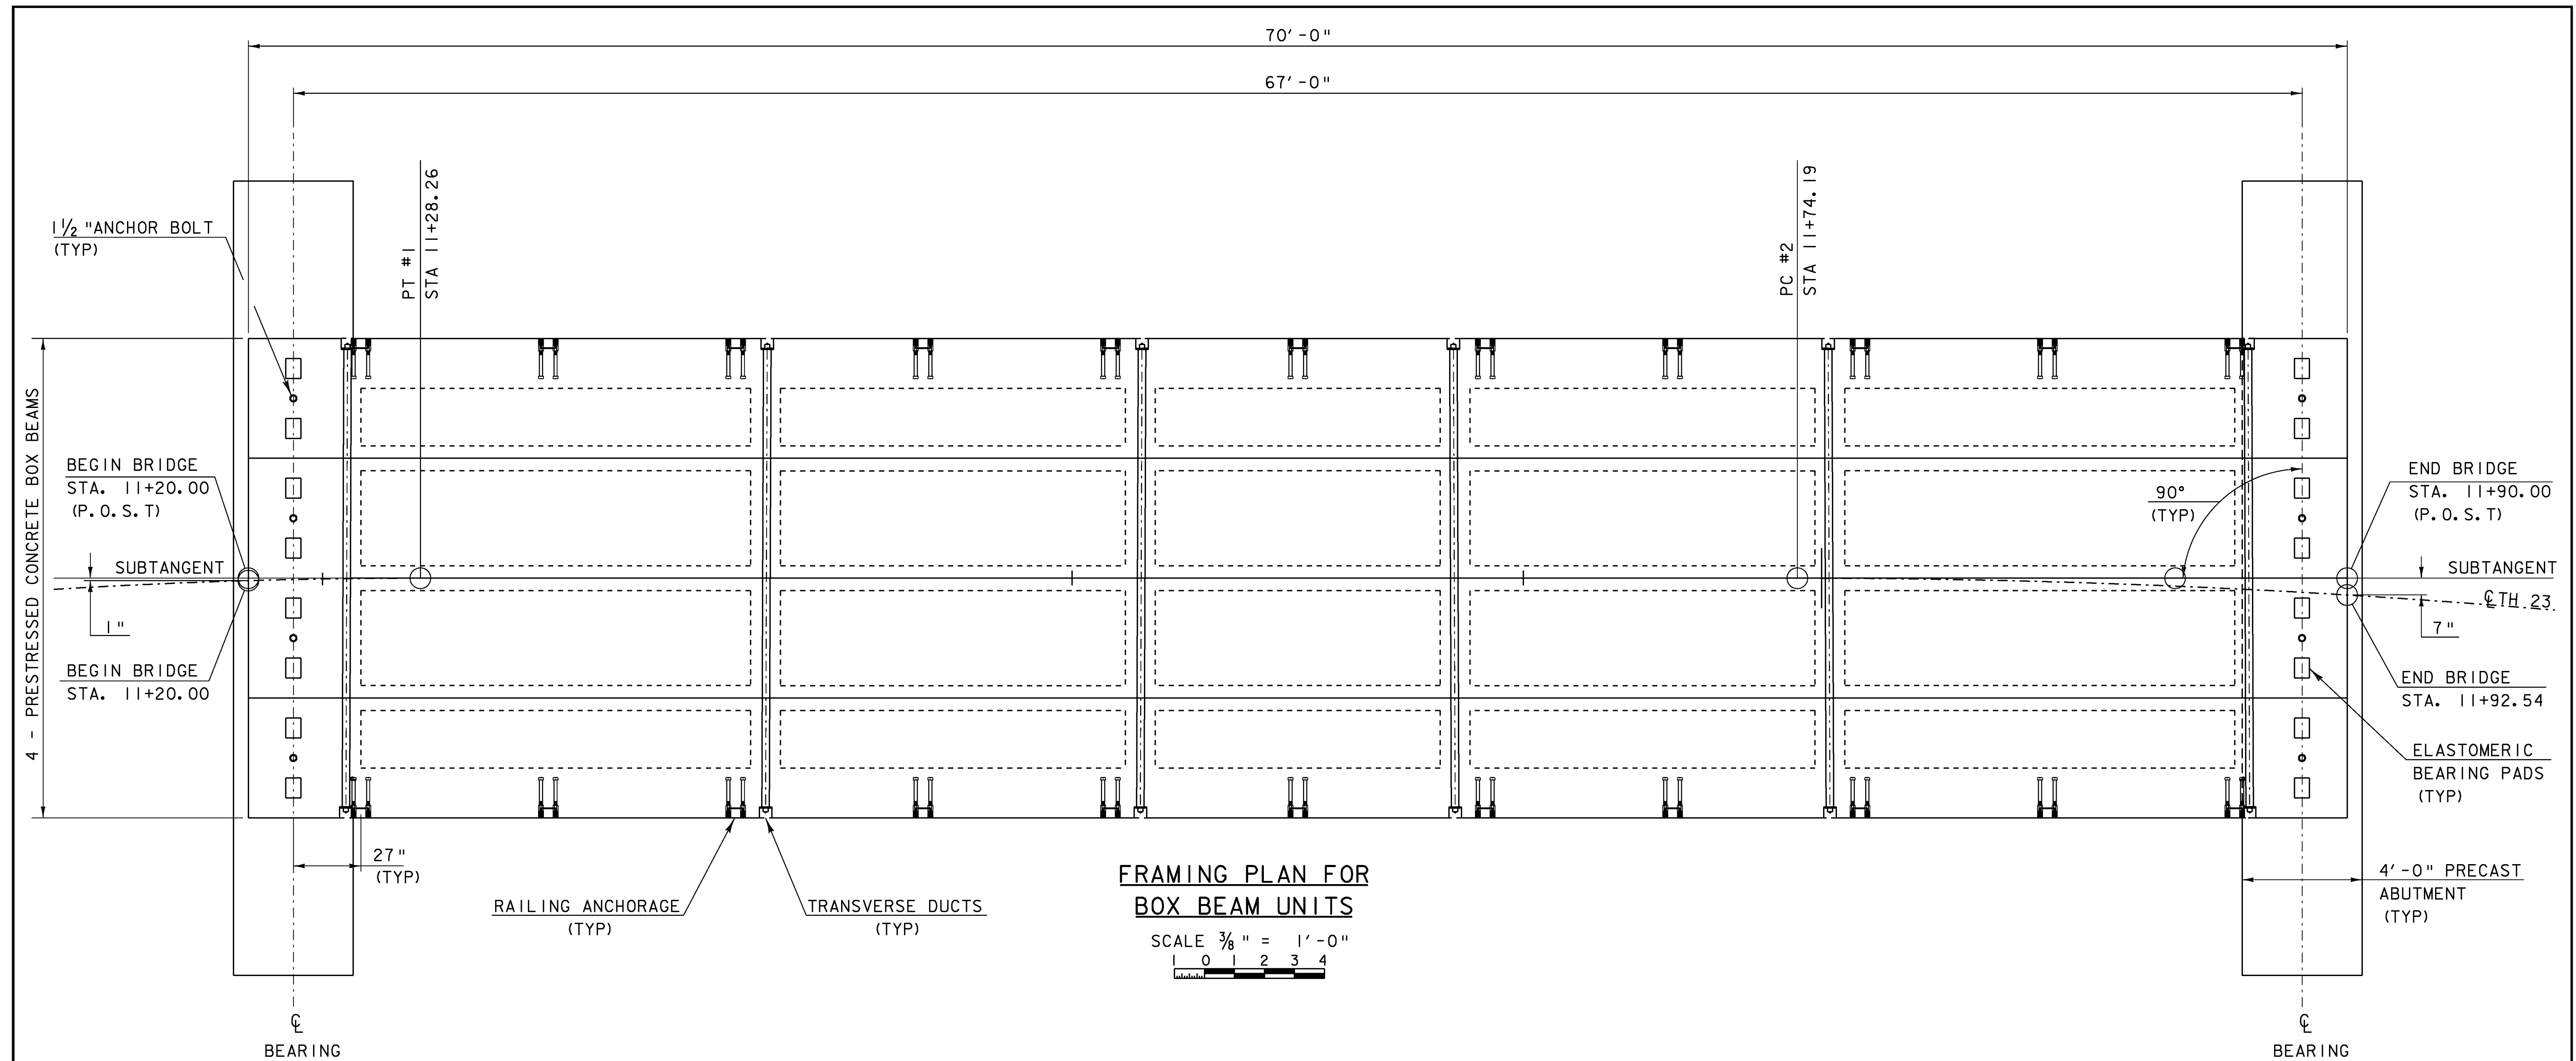


PROJECT NAME:	BRAINTREE	PLOT DATE:	14-JAN-2010
PROJECT NUMBER:	BRO 1444(36)	DRAWN BY:	K. PATTERSON
FILE NAME:	s95J292sup.dgn	DESIGNED BY:	T. FILLBACH
PROJECT LEADER:	K. HIGGINS	CHECKED BY:	T. FILLBACH
FRAMING PLAN		SHEET	15 OF 26

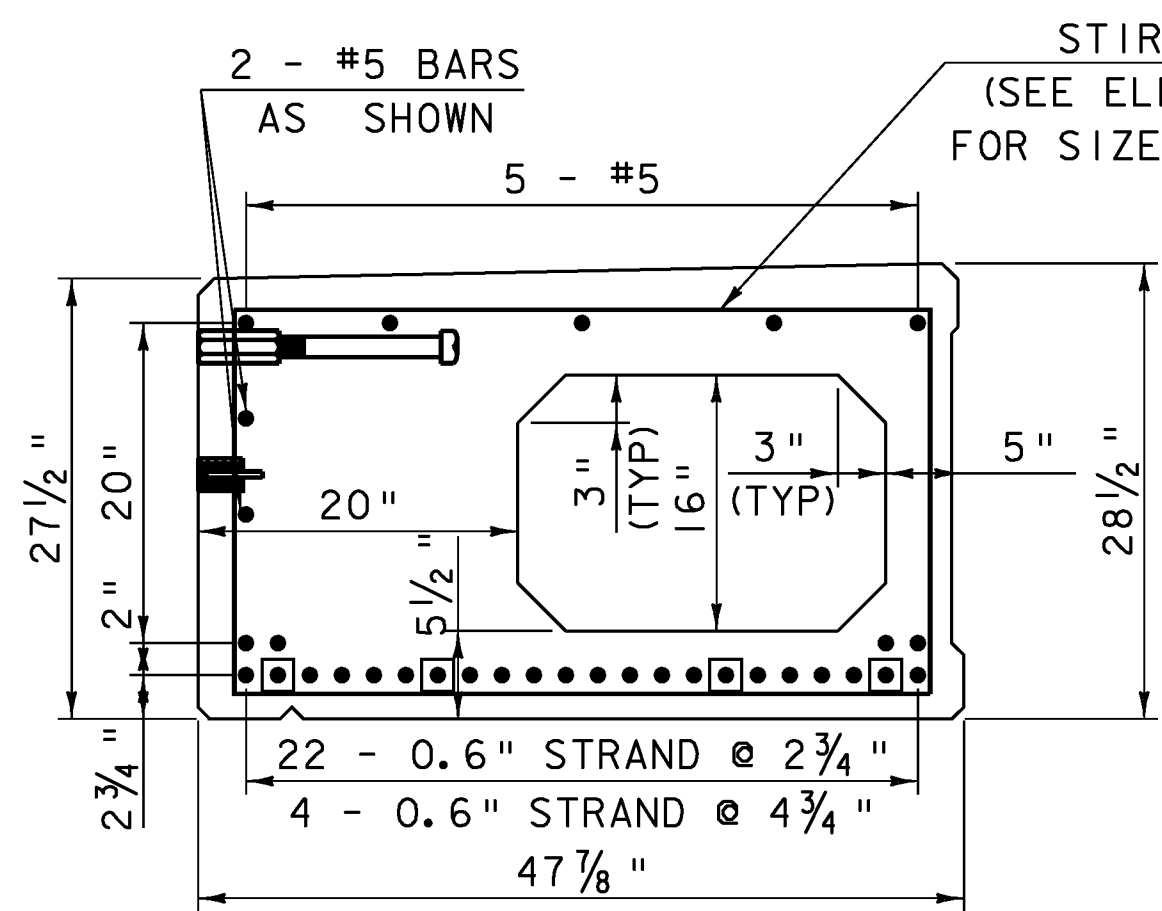

PRESTRESSED CONCRETE BOX BEAM
(27 1/2" - 28 1/2" x 48")
EXTERIOR

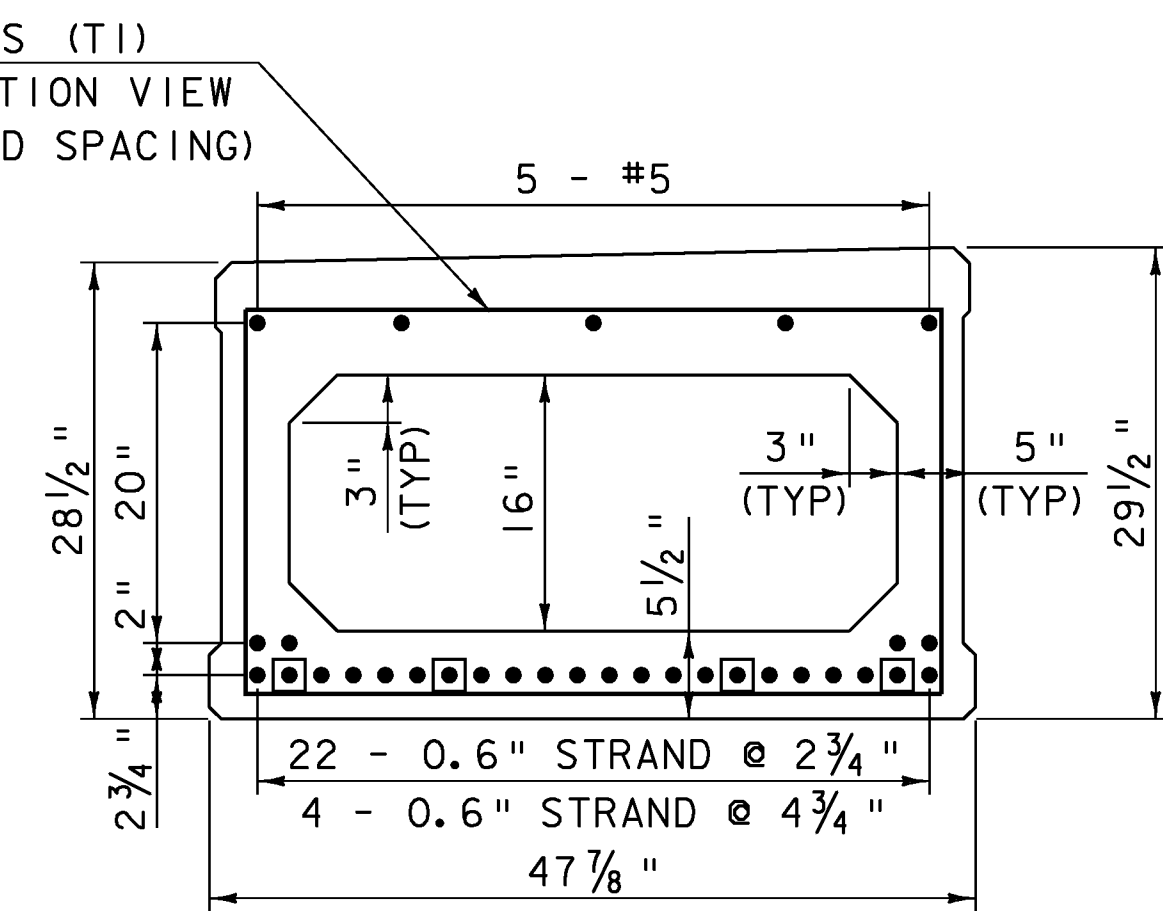


PRESTRESSED CONCRETE BOX BEAM
(28 1/2" - 29 1/2" x 48")
INTERIOR

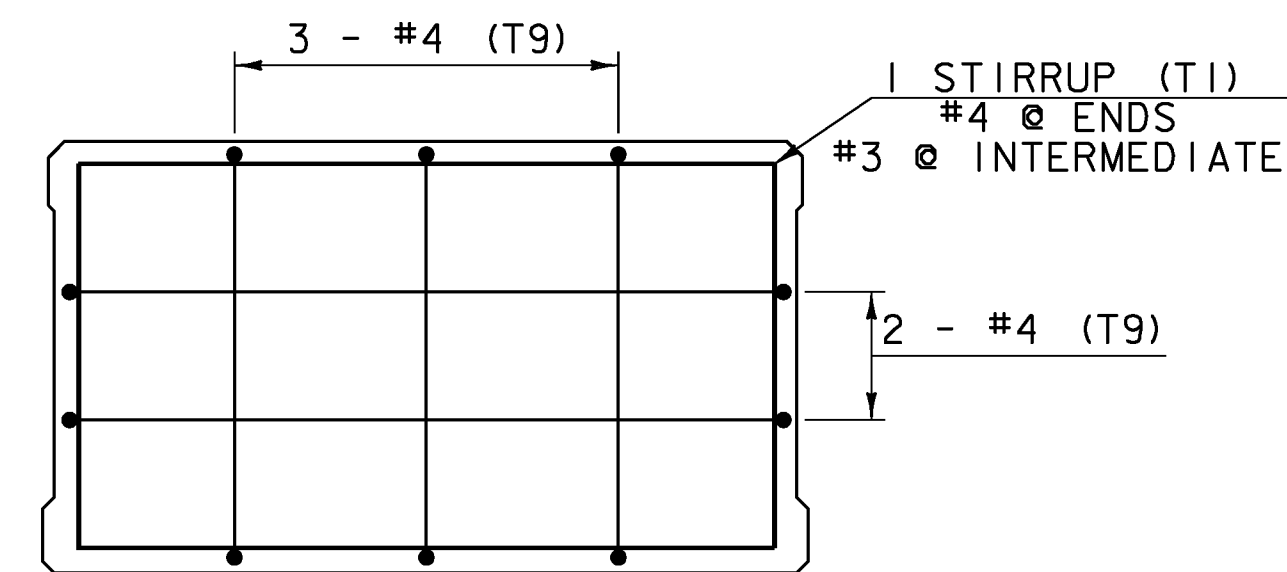


DIAPHRAGM REINFORCING
(INTERIOR & EXTERIOR)

■ - SHIELDED AT ENDS FOR 6'


□ MAT EACH SIDE OF TRANVERSE DUCTS

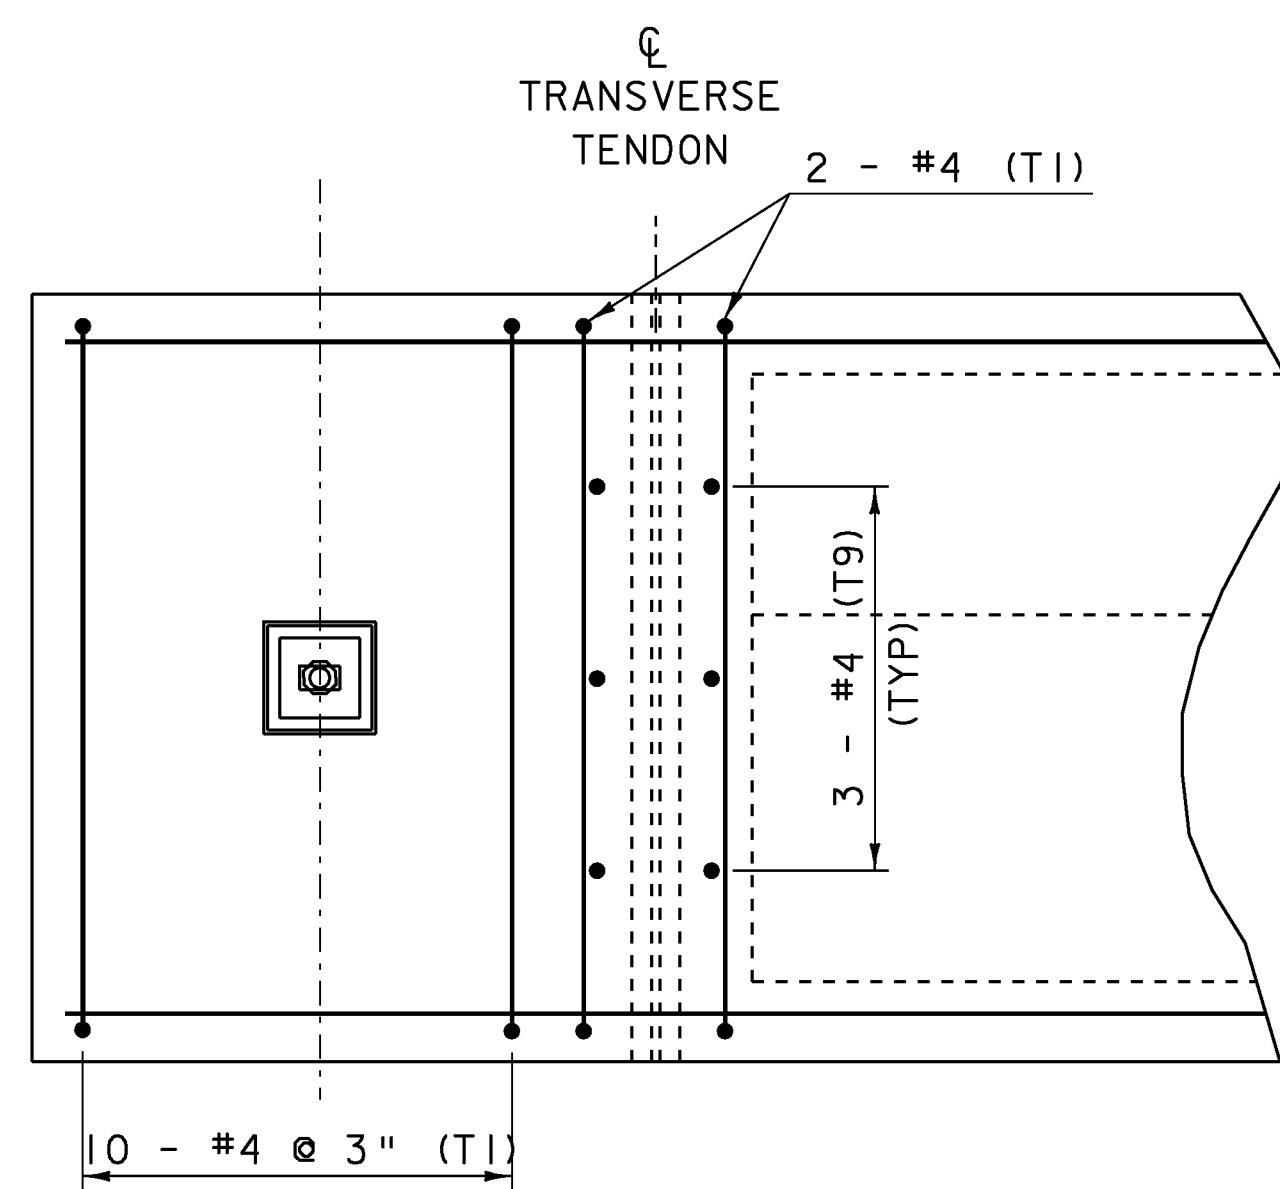

END DIAPHRAGM REINFORCING
(INTERIOR & EXTERIOR)

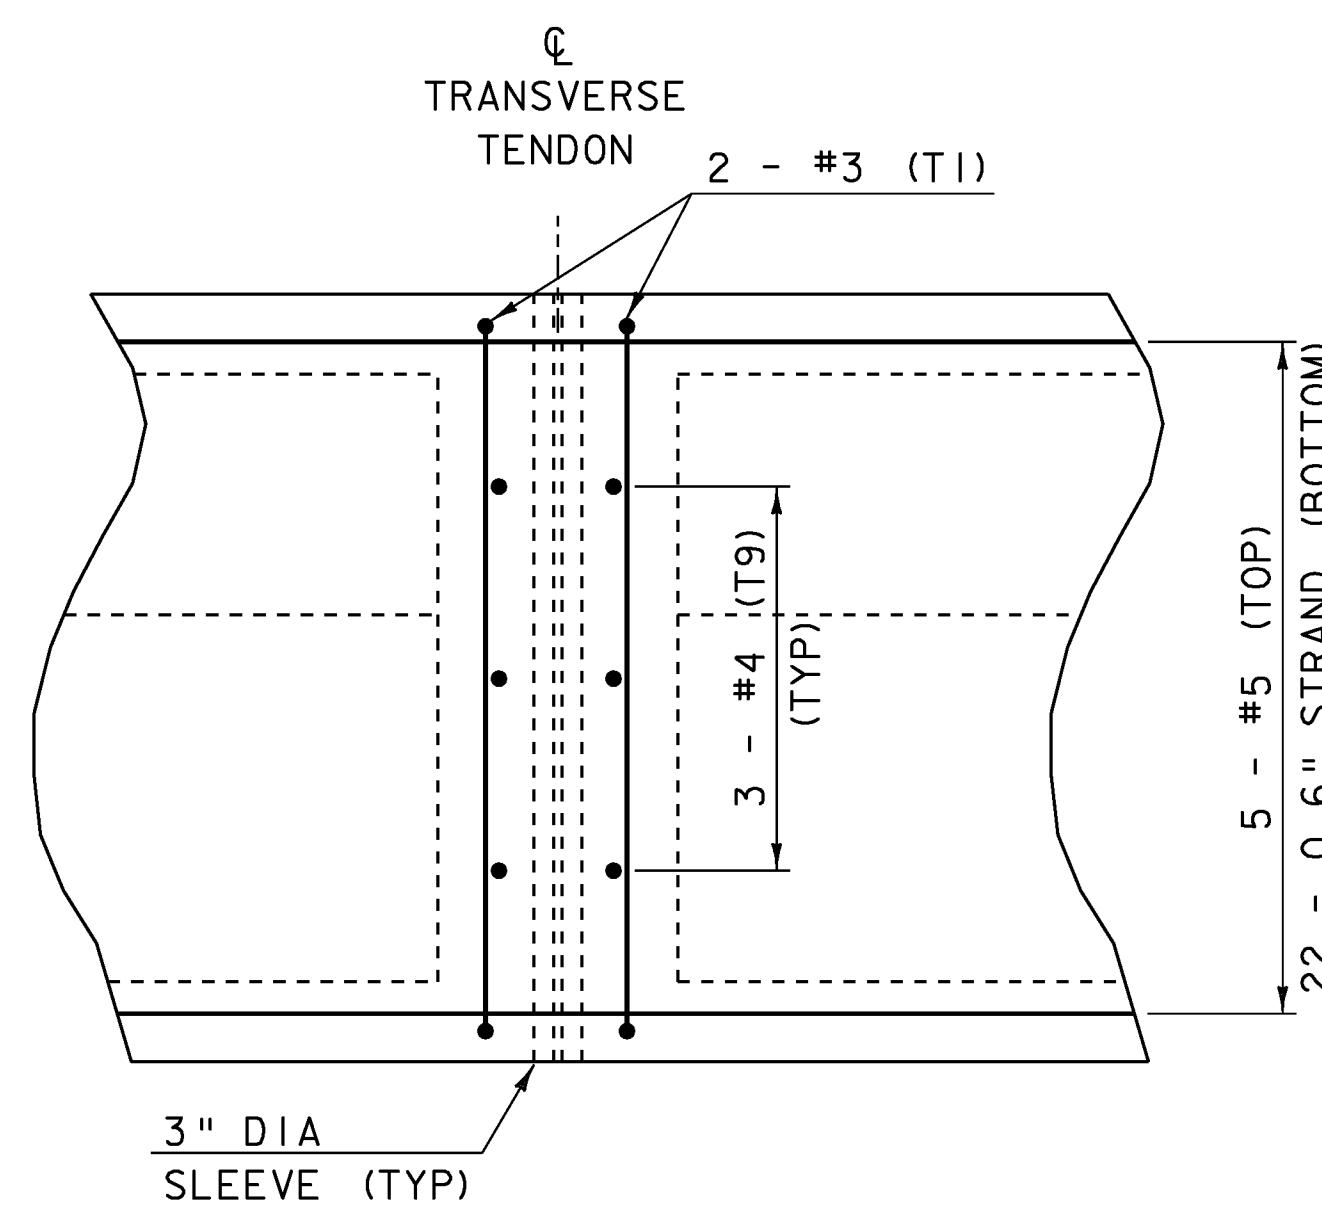


INTERMEDIATE DIAPHRAGM
REINFORCING
(INTERIOR & EXTERIOR)

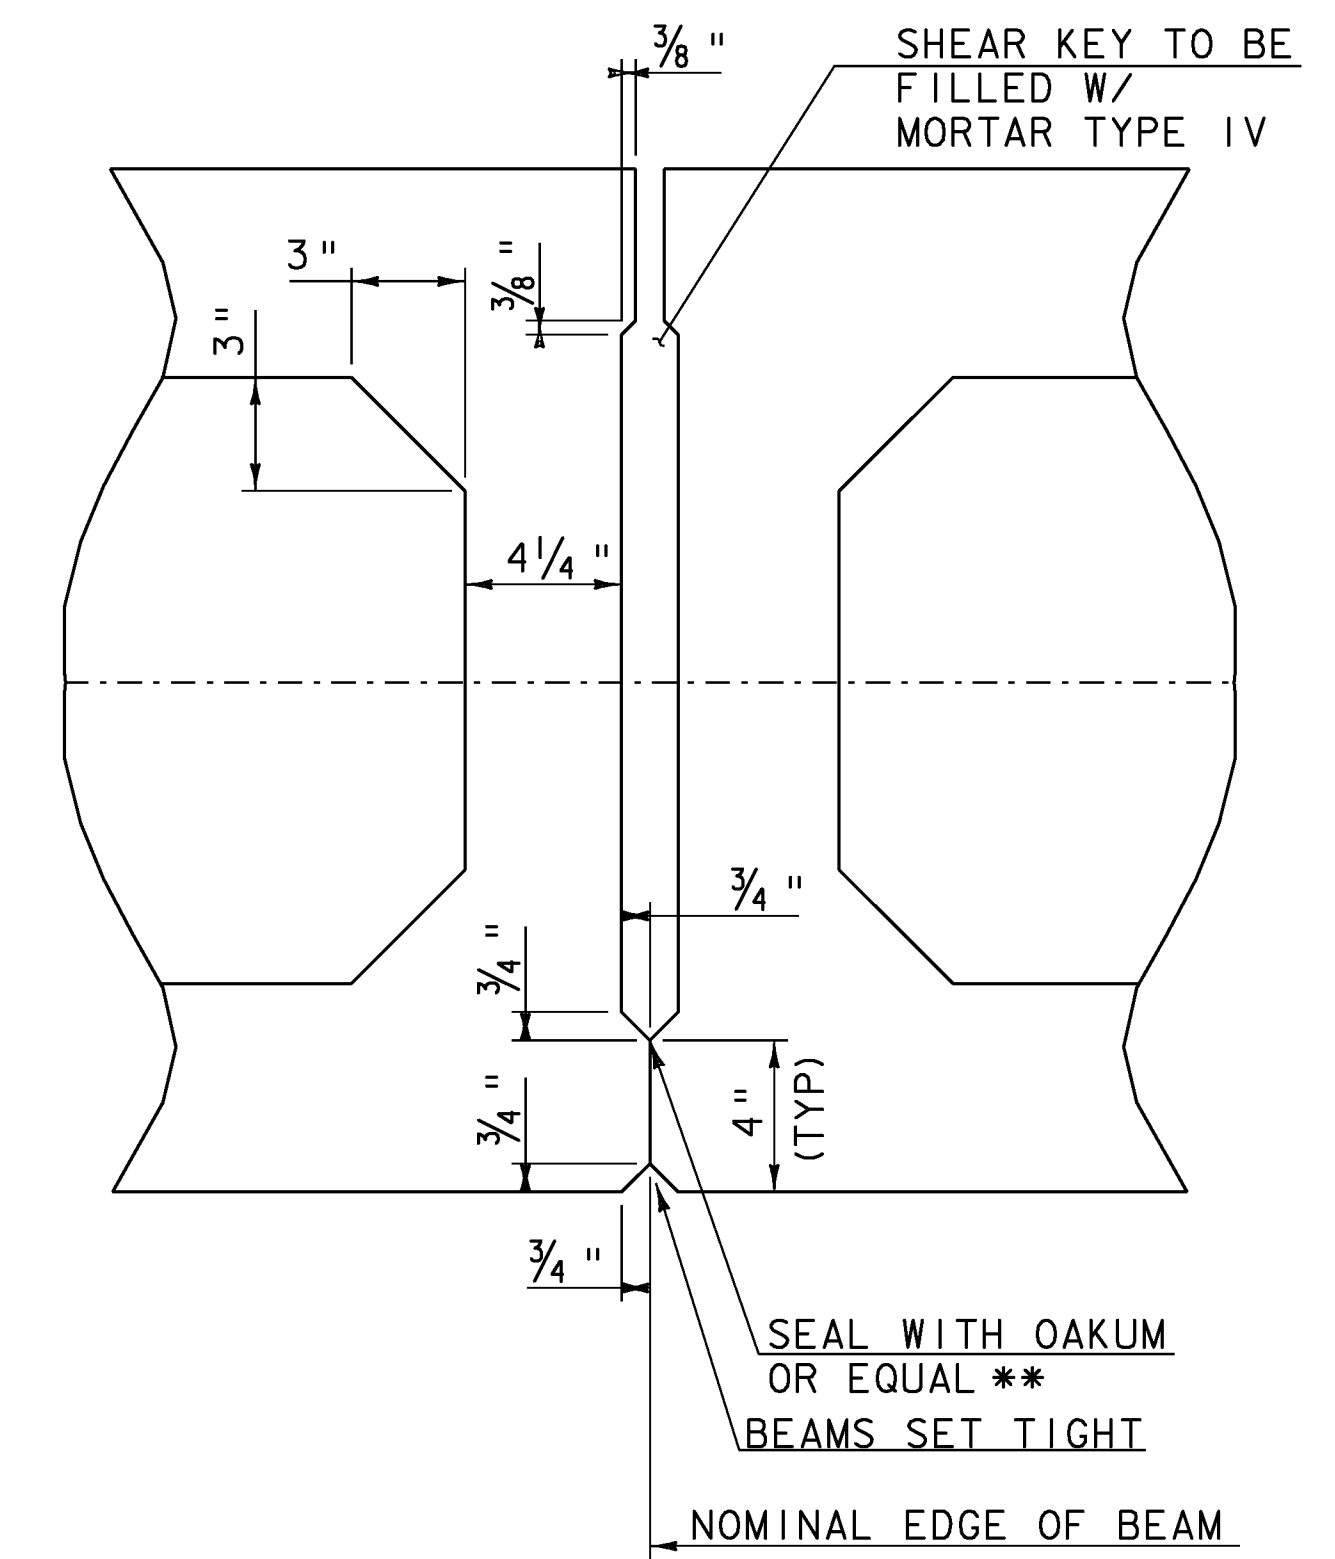


SHEAR KEY DETAIL
FOR BOX BEAM

NTS

** NOTE: INSTALL OAKUM AFTER UNITS HAVE BEEN PLACED

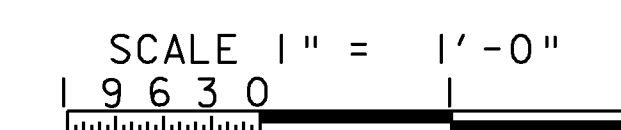


PROJECT NAME:	BRAINTREE	FILE NAME:	s95J292sup.dgn	PLOT DATE:	14-JAN-2010
PROJECT NUMBER:	BRO 1444(36)	PROJECT LEADER:	K. HIGGINS	DRAWN BY:	K. PATTERSON
		DESIGNED BY:	T. FILLBACH	CHECKED BY:	T. FILLBACH
		BOX BEAM DETAILS #1			SHEET 16 OF 26

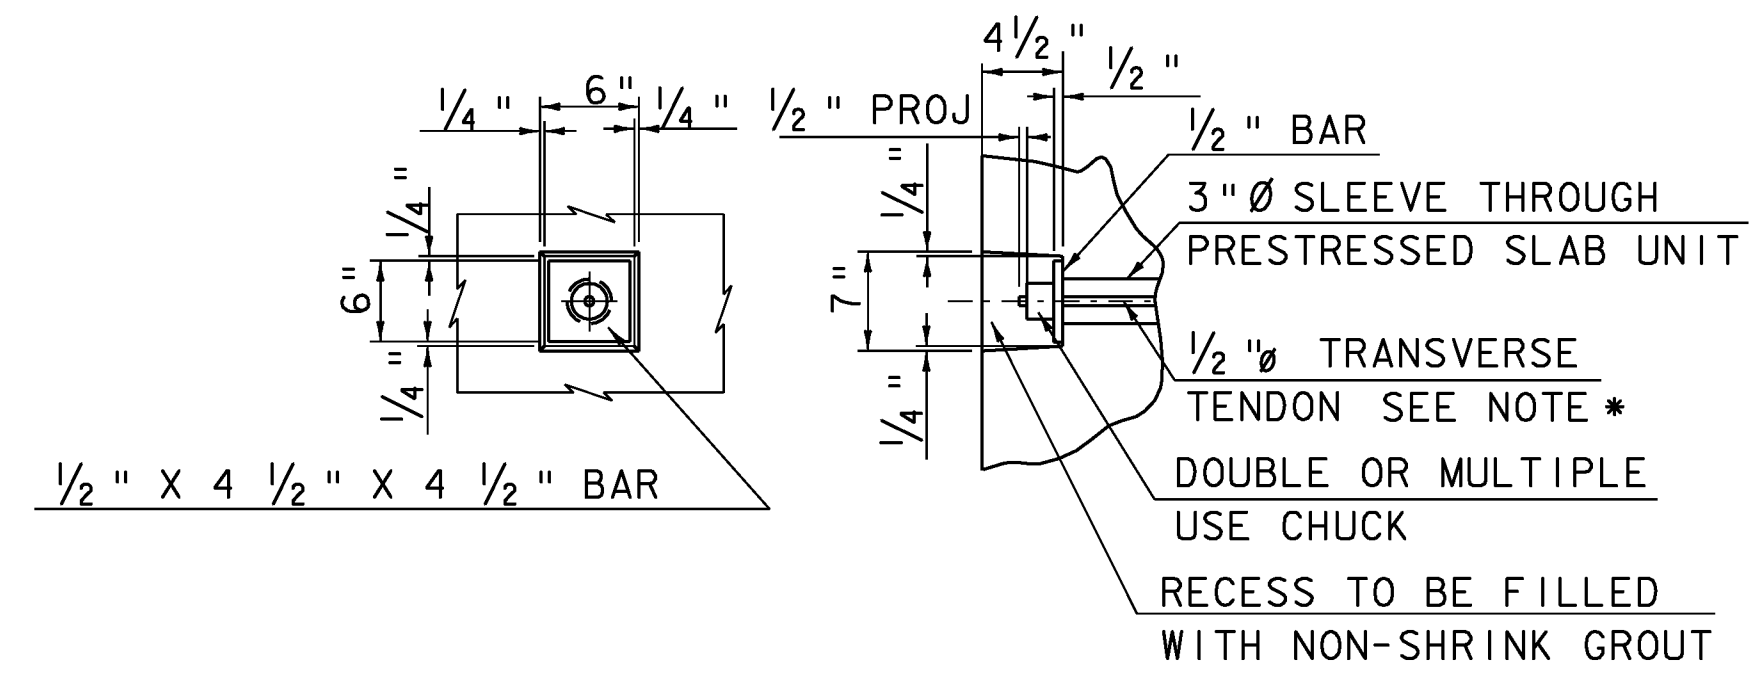


$1/2$ " \emptyset TRANSVERSE TENDON DETAIL
(NOT TO SCALE)


* TRANSVERSE TIES SHALL BE COVERED BY SEAMLESS POLYPROPYLENE SHEATH (WITH CORROSION INHIBITER GREASE BETWEEN SHEATH AND STRAND) FOR THE LENGTH OF STRAND, EXCEPT AT ANCHORAGE LOCATIONS, EACH STRAND SHALL BE TENSIONED TO 33 KIPS

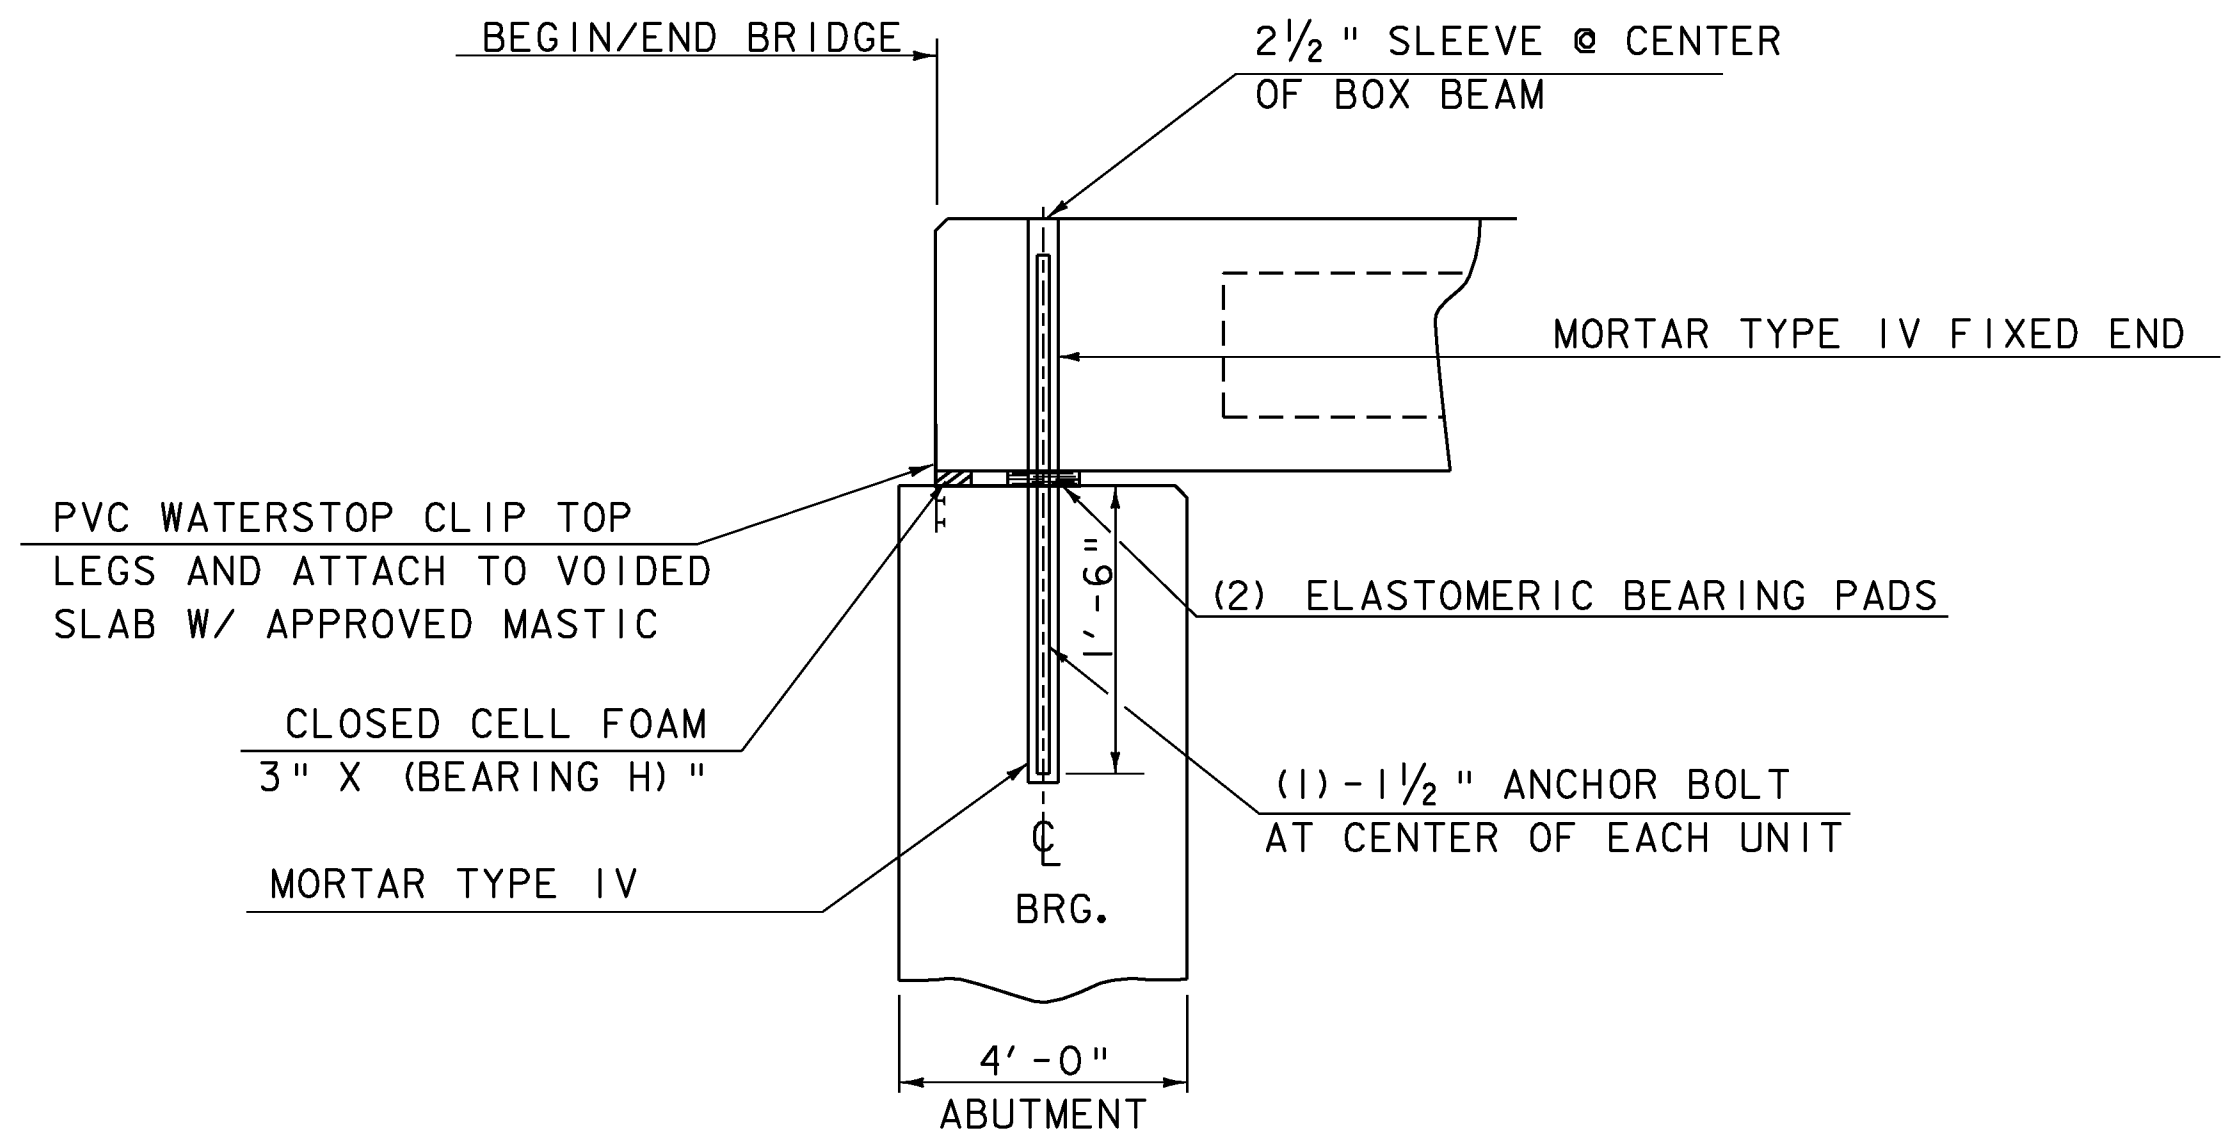

VOIDED SLAB/BOX BEAM
NO PAVEMENT/NO APPROACH SLAB
(NOT TO SCALE)


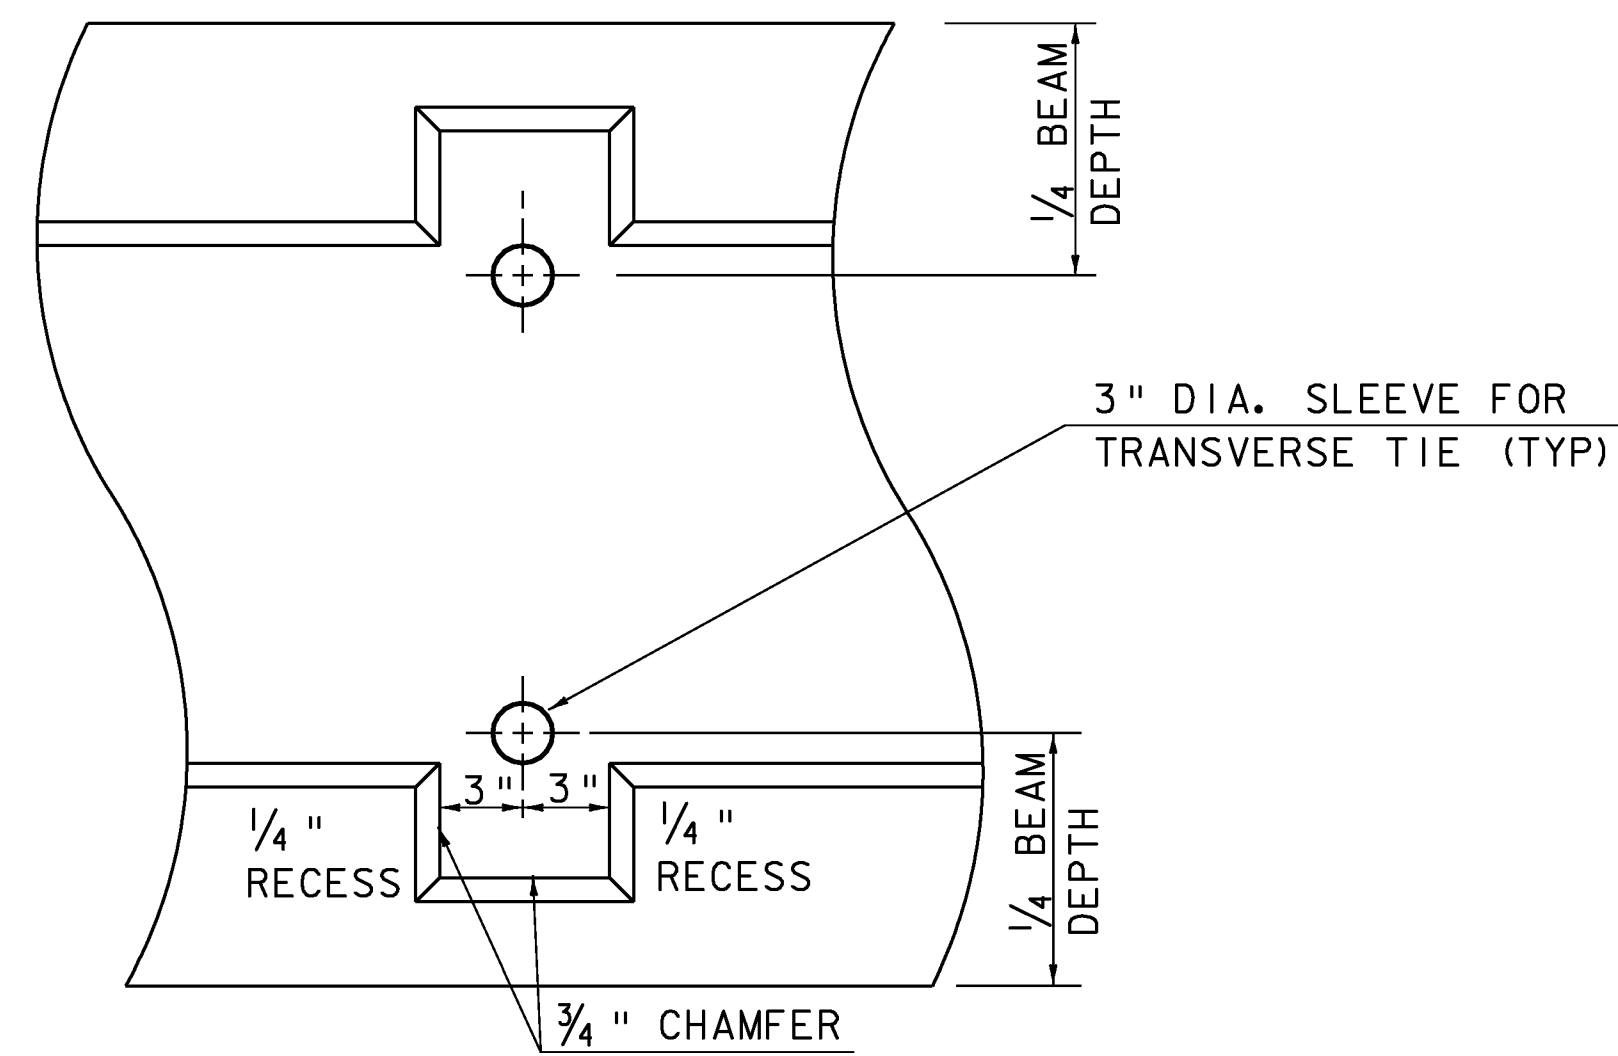


TYPICAL BEAM ELEVATION AT TRANSVERSE TIE LOCATIONS
(NOT TO SCALE)

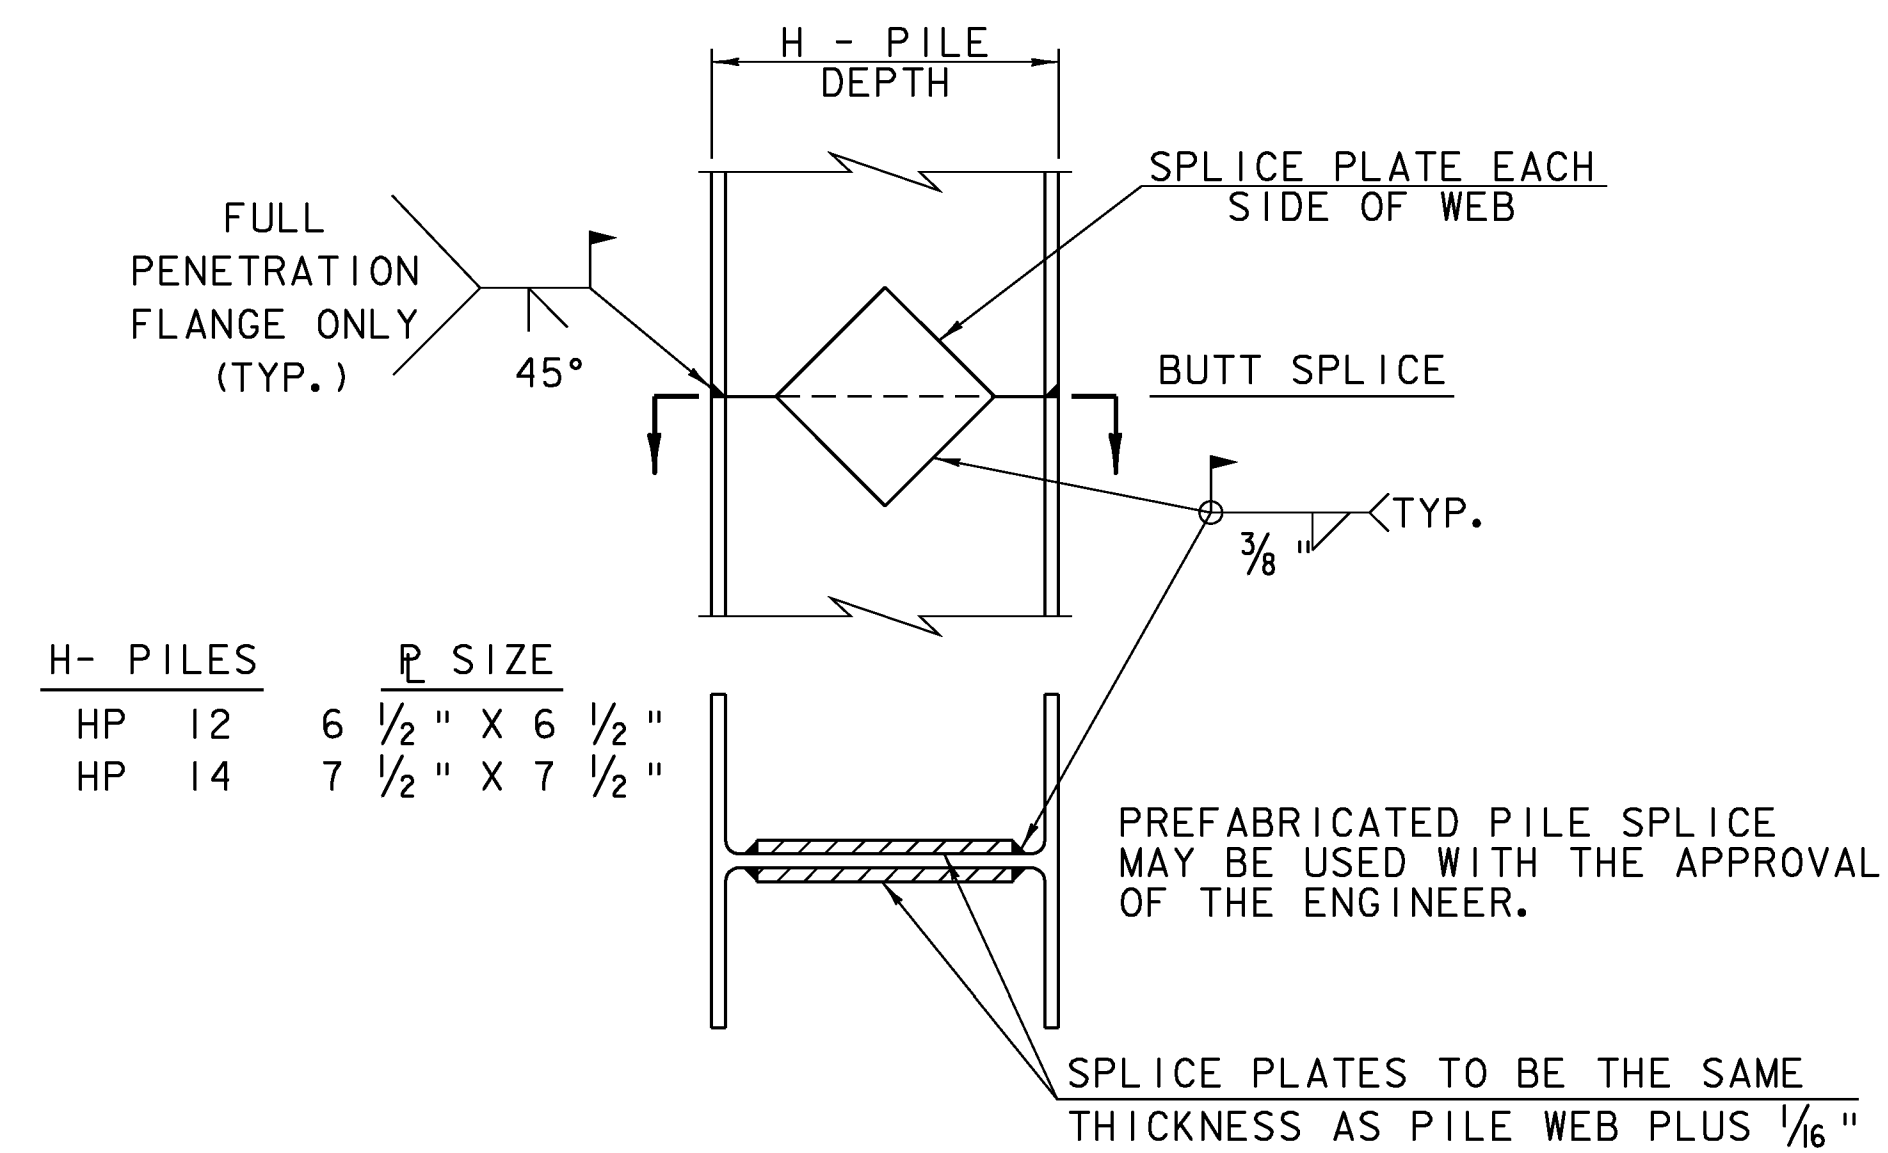

DETAIL OF PILE SPLICE
(NOT TO SCALE)


PROJECT NAME: BRAINTREE	PLOT DATE: 31-DEC-2009
PROJECT NUMBER: BRO 1444(36)	DRAWN BY: K. PATTERSON
FILE NAME: s95J292sup.dgn	CHECKED BY: T. FILLBACH
PROJECT LEADER: K. HIGGINS	SHEET 17 OF 26
DESIGNED BY: T. FILLBACH	
BOX BEAM DETAILS #2	

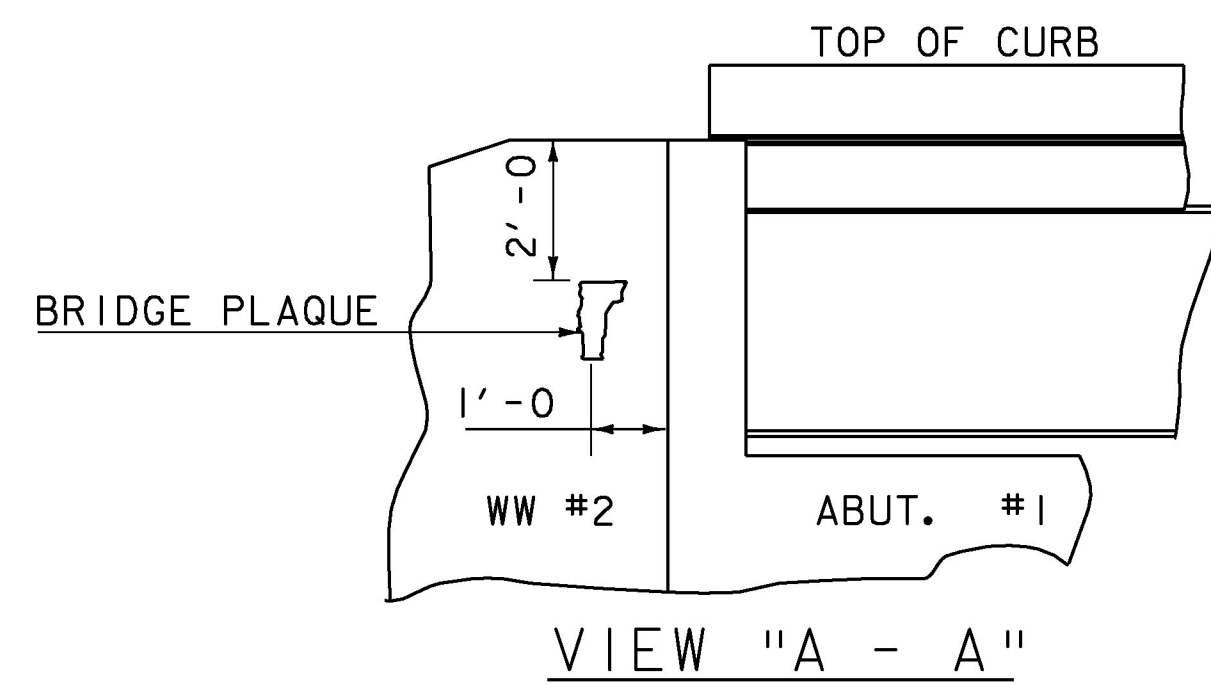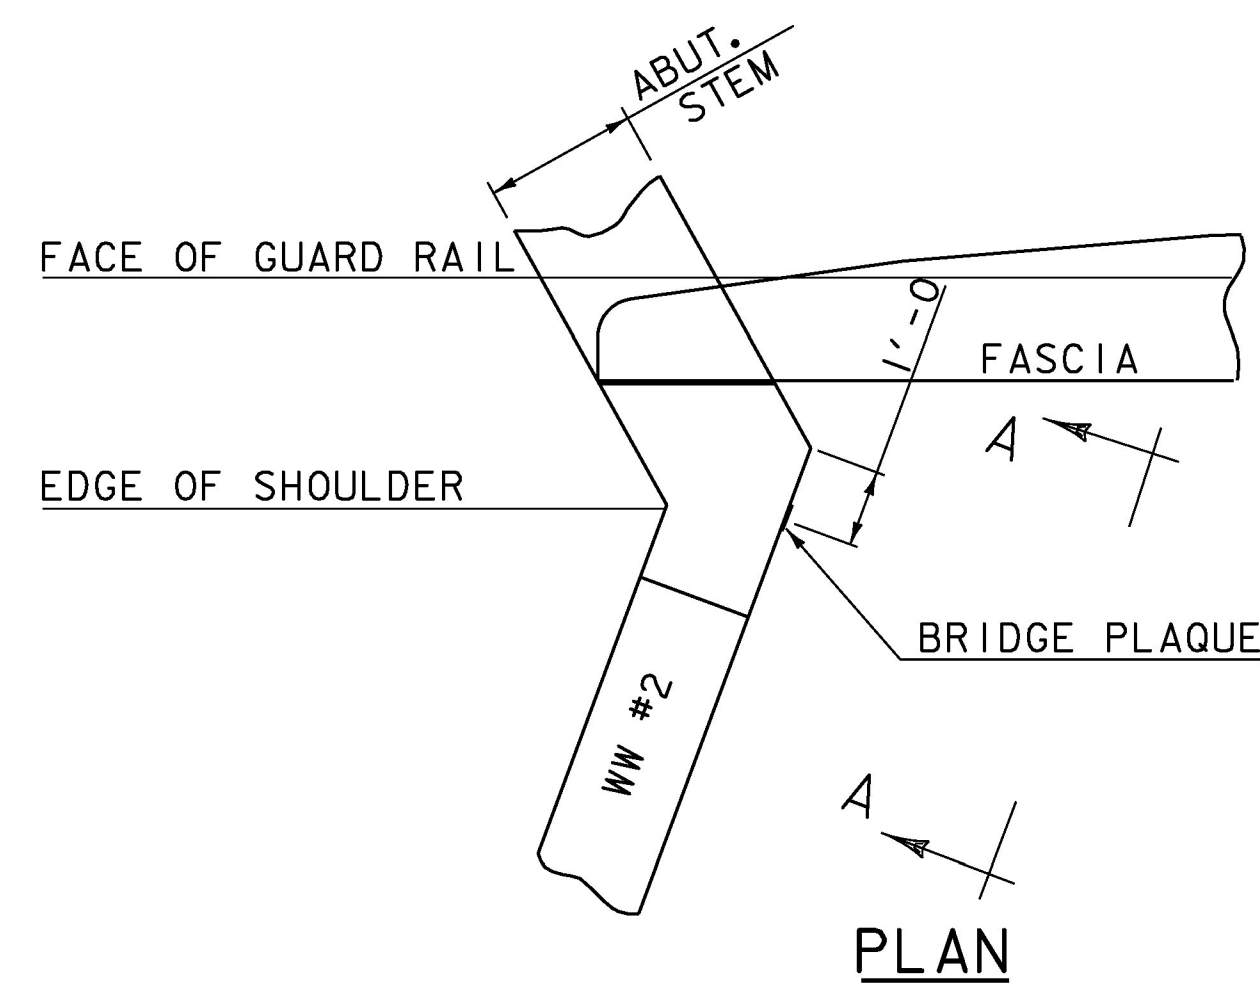

BRIDGE PLAQUE
(NOT TO SCALE)

THE BRIDGE PLAQUE WILL BE SUPPLIED BY THE AGENCY OF TRANSPORTATION AND SHALL BE INSTALLED BY THE CONTRACTOR AT ABUTMENT #1 ON THE RIGHT SIDE AS SHOWN OR AS DIRECTED BY THE ENGINEER.


PAYMENT FOR INSTALLATION OF THE BRIDGE PLAQUE SHALL BE INCIDENTAL TO THE ADJACENT CONCRETE.

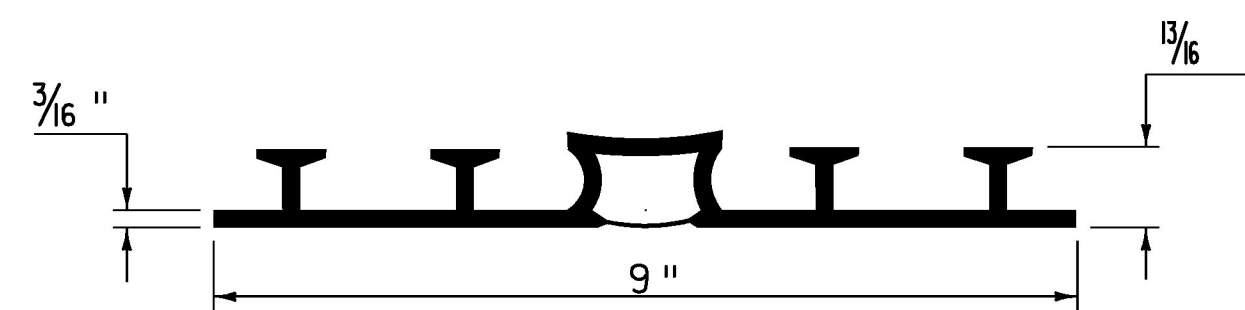


P.V.C. WATERSTOP FOR EXPANSION JOINTS
(NOT TO SCALE)

PAYMENT FOR THE P.V.C. WATERSTOP SHALL BE INCIDENTAL TO THE UNIT BID PRICE FOR THE ADJACENT CONCRETE.

OTHER CONFIGURATIONS OF WATERSTOP MAY BE USED UPON APPROVAL OF THE ENGINEER.

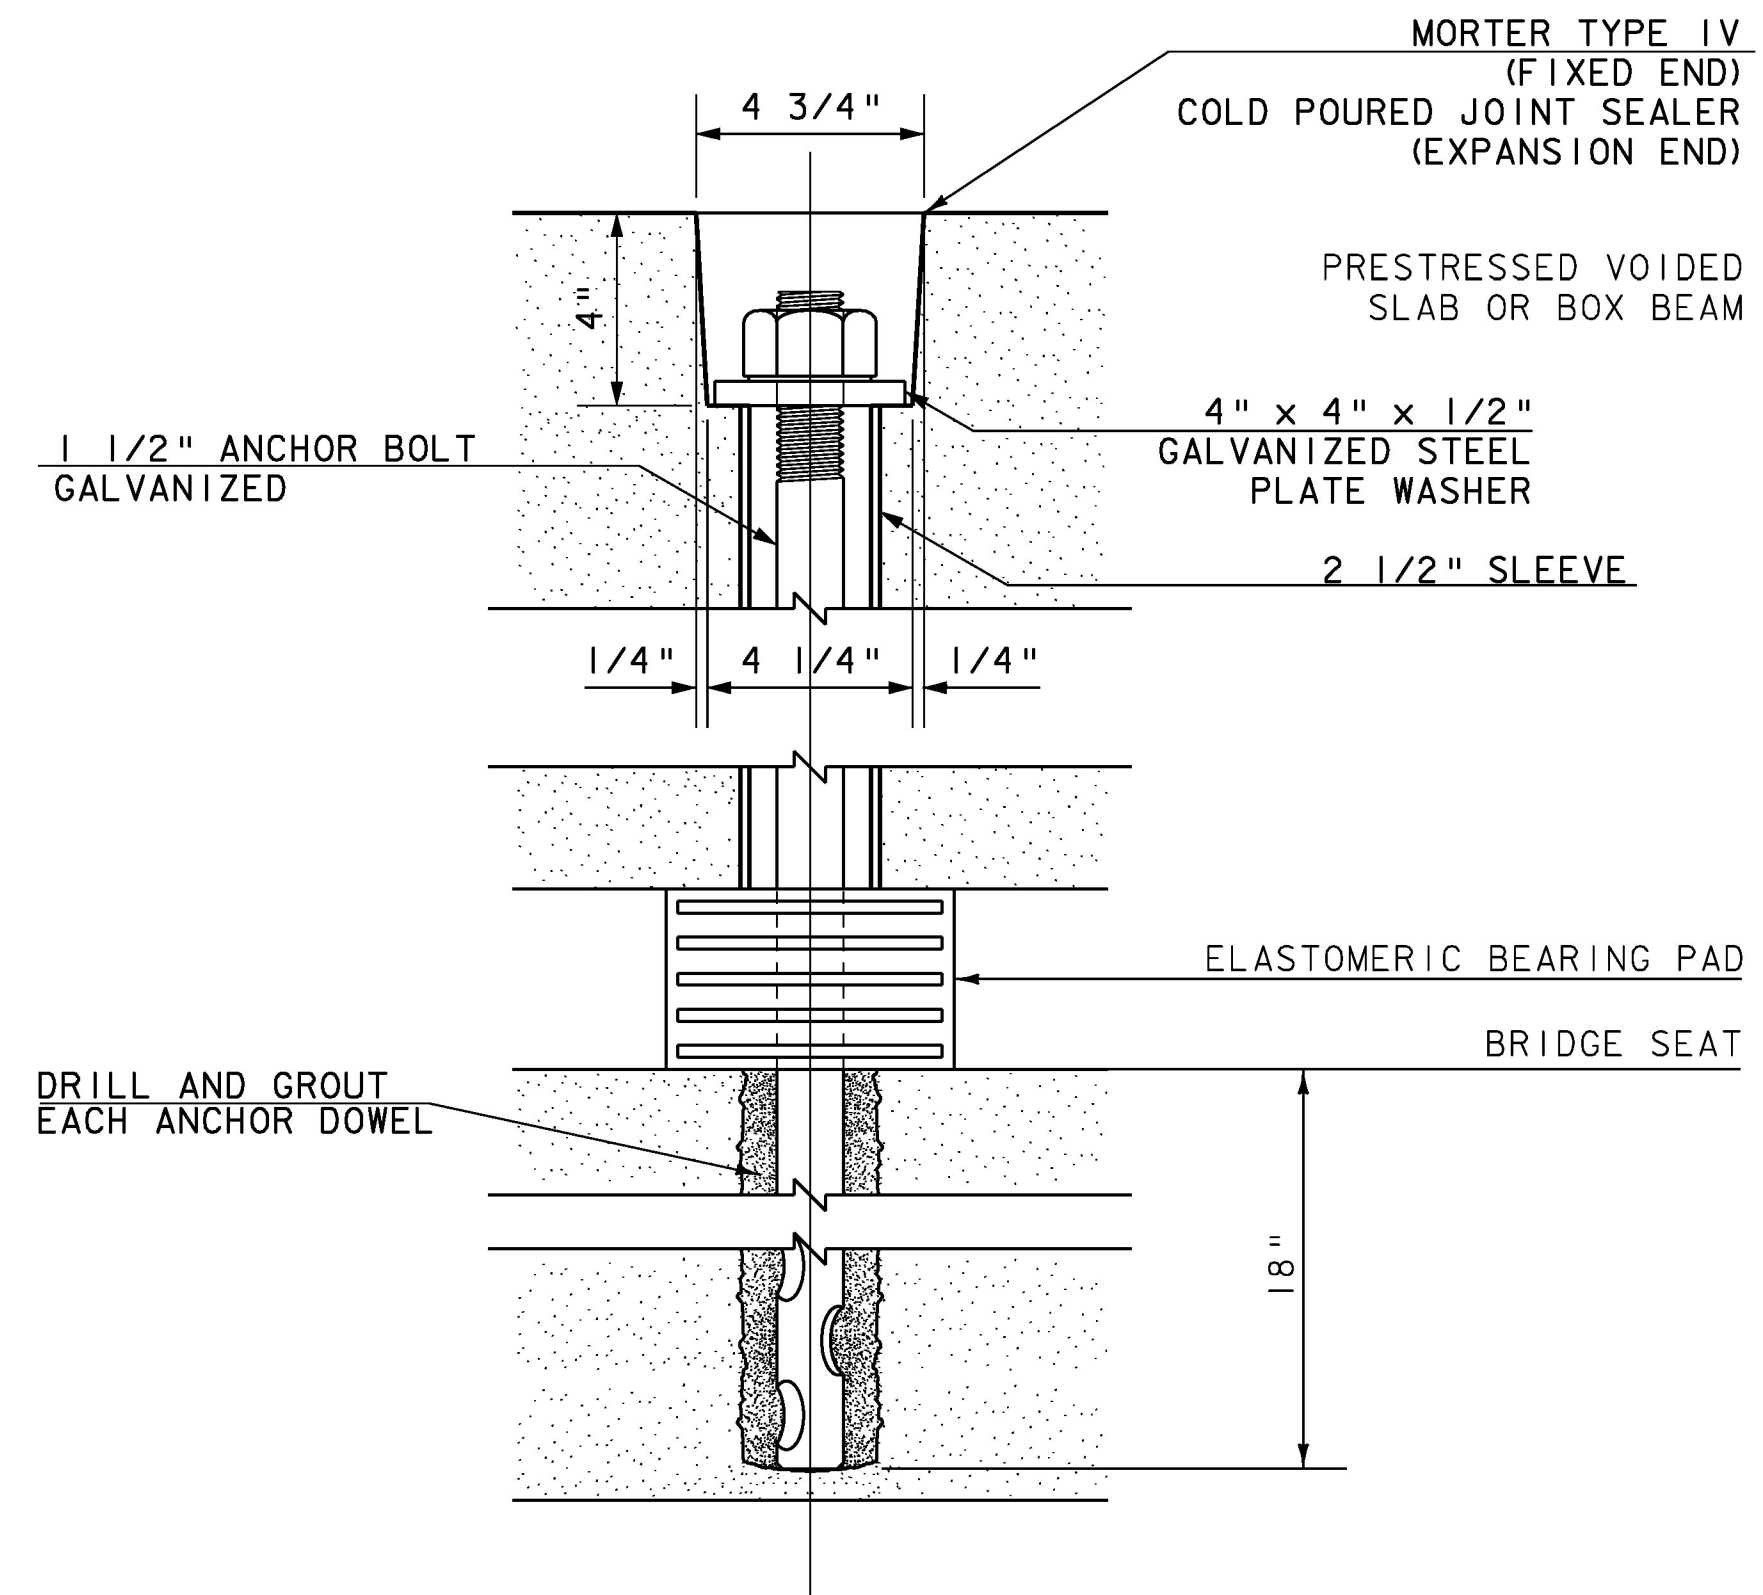


ANCHOR BOLT DETAIL
(NOT TO SCALE)

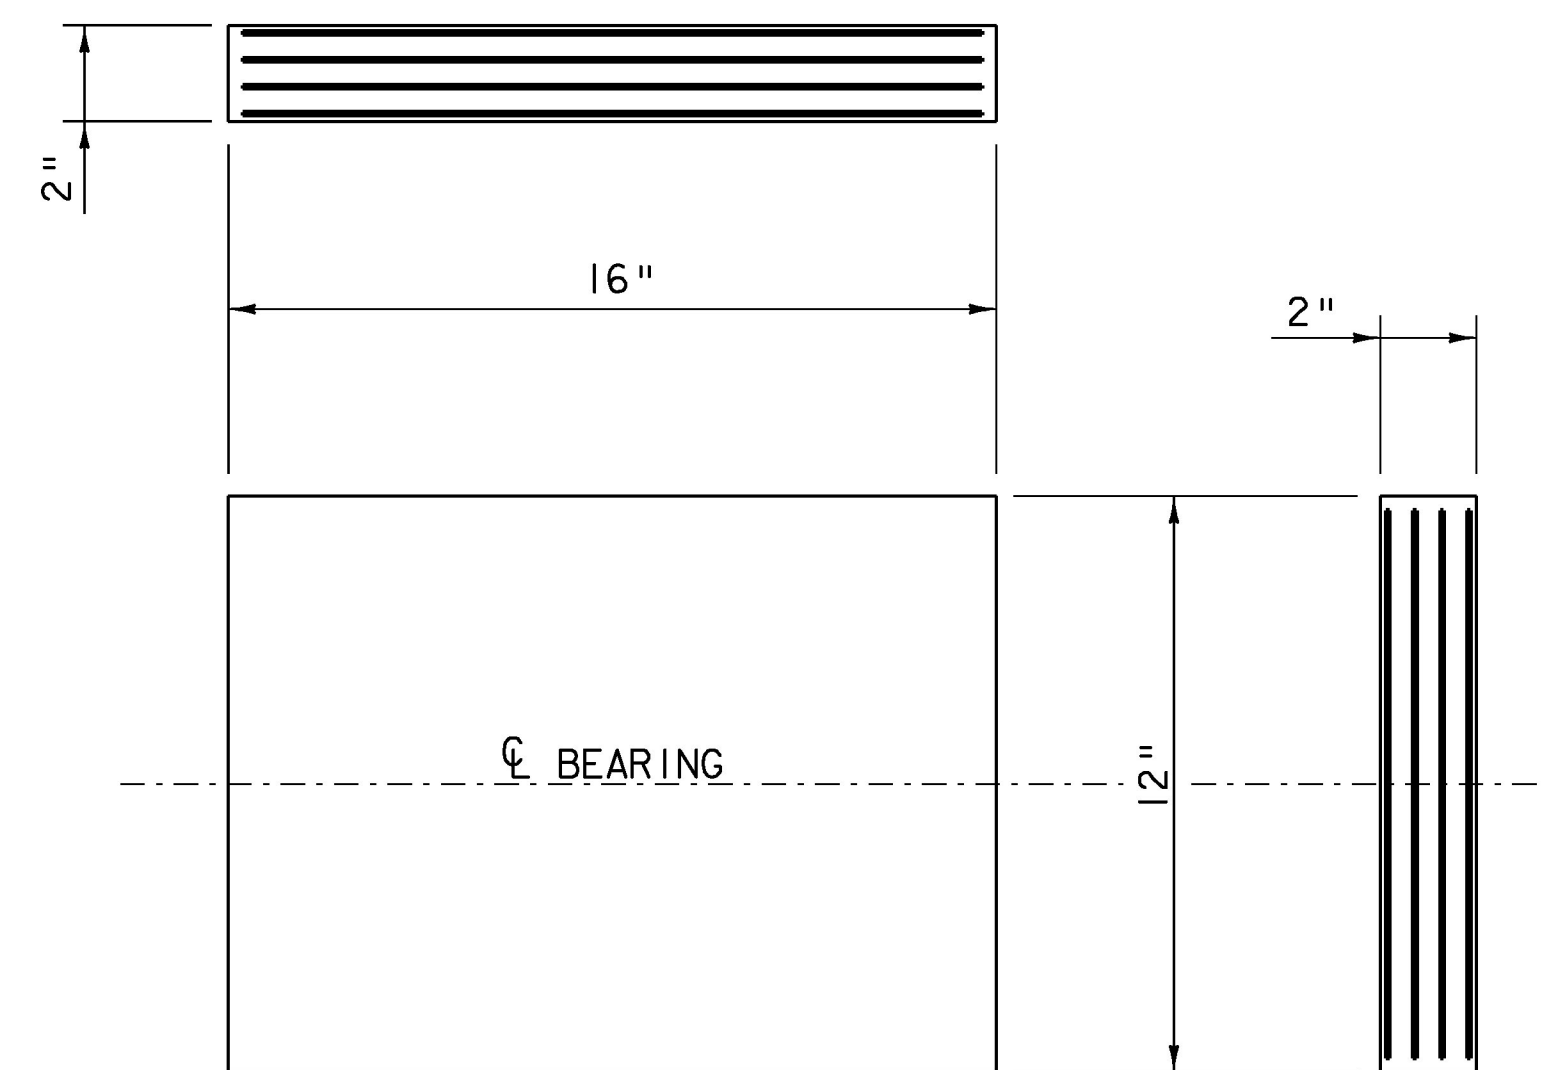

ELASTOMERIC BEARING DETAIL

- 2 - 1/8" EXTERIOR LAYERS OF ELASTOMER
- 3 - 1/2" INTERIOR LAYERS OF ELASTOMER
- 4 - 1/16" STEEL REINFORCING PLATES

SCALE 3" = 1'-0"

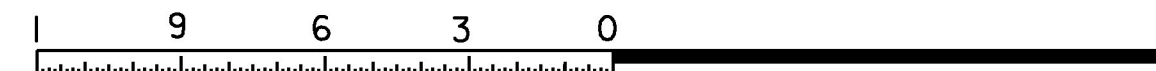


Bearing Notes

1. Bearings shall conform to the applicable subsections of Standard Specifications sections 531 and 731.
2. The bearings, including anchor bolts, drilling and grouting, washers and nuts shall be paid for under the item 531.11 "Bearing Device Assembly, Elastomeric Pad."
3. All washers shall be 1/2" plate (minimum).
4. All plates, nuts, washers and anchor bolts, unless noted otherwise, shall be galvanized or metalized as per subsections 531.04 (b) and 506.15 of the Standard Specifications. If the bearings are metalized, they shall be sealed with an approved sealer as specified in subsection 506.15 (b) of the standard specifications. Areas of galvanizing or metalizing damaged by field welding or handling shall be repaired in conformance with standard specification 513.
5. All steel in the bearing devices shall be AASHTO M270M/M270 Grade 50, unless noted otherwise.
6. Anchor bolts shall be ASTM A-449, type I with a yield strength of 58 ksi and have a minimum embedment of 18" into the concrete and shall conform to subsection 714.08.
7. All reinforcement between layers of elastomer shall be steel AASHTO M270M/M270 Grade 36. All internal steel plates shall be sand blasted and free of coatings, rust and mill scale. The plates shall be free of sharp edges and burrs.
8. Steel reinforced elastomeric bearings shall have a minimum 1/8" edge seal of elastomer integral with bearing over all internal plates.
9. The elastomer was designed with a shear modulus of 100 psi +/- 15%.
10. The elastomer shall meet the requirements of Low Temperature Zone D, Grade 4.
11. The concrete under the bearing device shall be level.
12. All designs done for the bearings shall be per the AASHTO LRFD Bridge Design Specifications 4th edition and its latest revisions.
13. Alternate configurations for bearings may be submitted for approval. Any alternate submitted shall be designed and certified to meet the design loads and criteria shown on the plans.
14. Bridge seat elevations may be revised to accommodate an alternative configuration.

Design Load (kip)	Service Limit State	Vertical	Max	74.4
			Min	28.4
Strength Limit State		Permanent	30.6	
		Transverse	6.7	
		Longitudinal	2.5	
Service Limit State	Irreversible	Vertical	113.1	
		Transverse	22.9	
		Longitudinal	16.5	
Translation (in)	Service Limit State	Reversible	0	
		Longitudinal	1/16	
		Transverse	1/8	
Rotation (rad)	Service Limit State	Irreversible	0.000	
		Longitudinal	0.018	
		Reversible	0.000	
		Longitudinal	0.009	


PROJECT NAME: BRAINTREE
PROJECT NUMBER: BRO 1444(36)

FILE NAME: s95J292sup.dgn PLOT DATE: 31-DEC-2009
PROJECT LEADER: K. HIGGINS DRAWN BY: T. FILLBACH
DESIGNED BY: T. FILLBACH CHECKED BY: J. LACROIX
BEARING DETAILS SHEET 18 OF 26

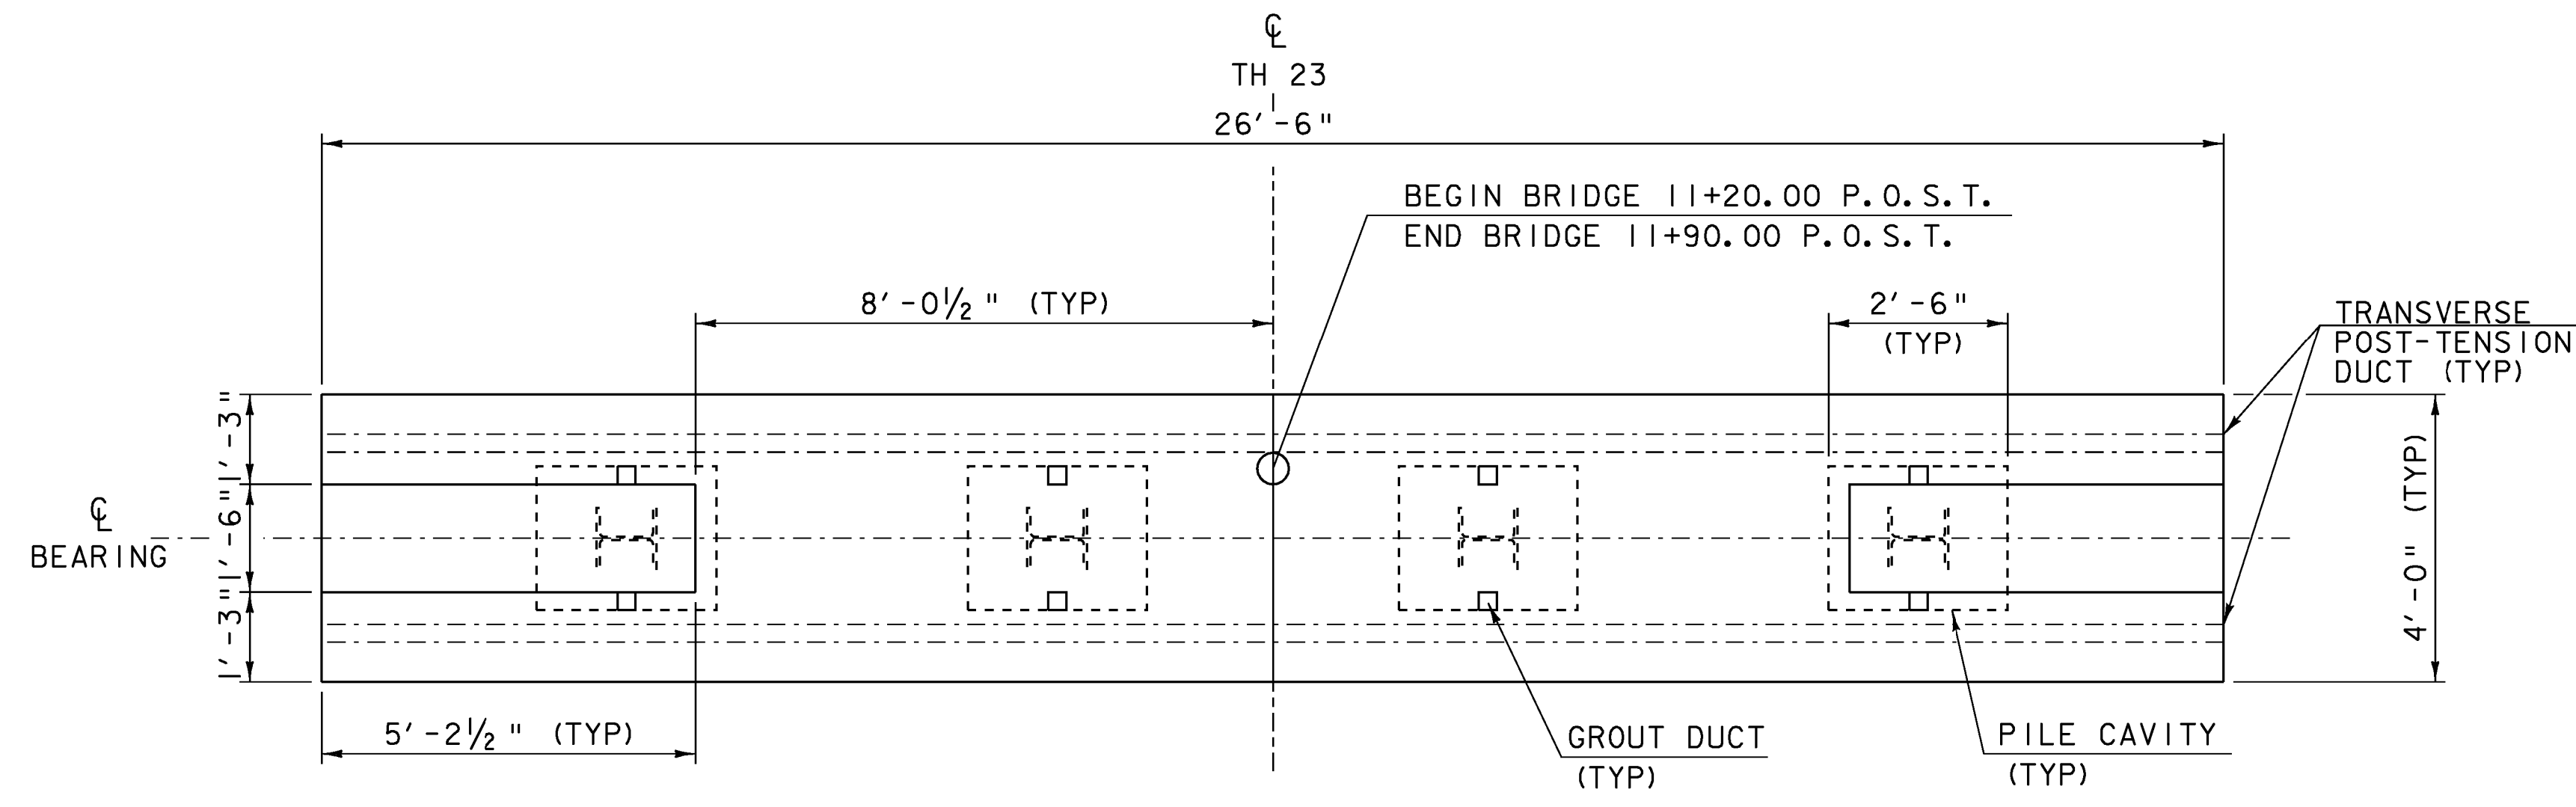

TYPICAL ABUTMENT PLAN


SCALE 1/2" = 1'-0"

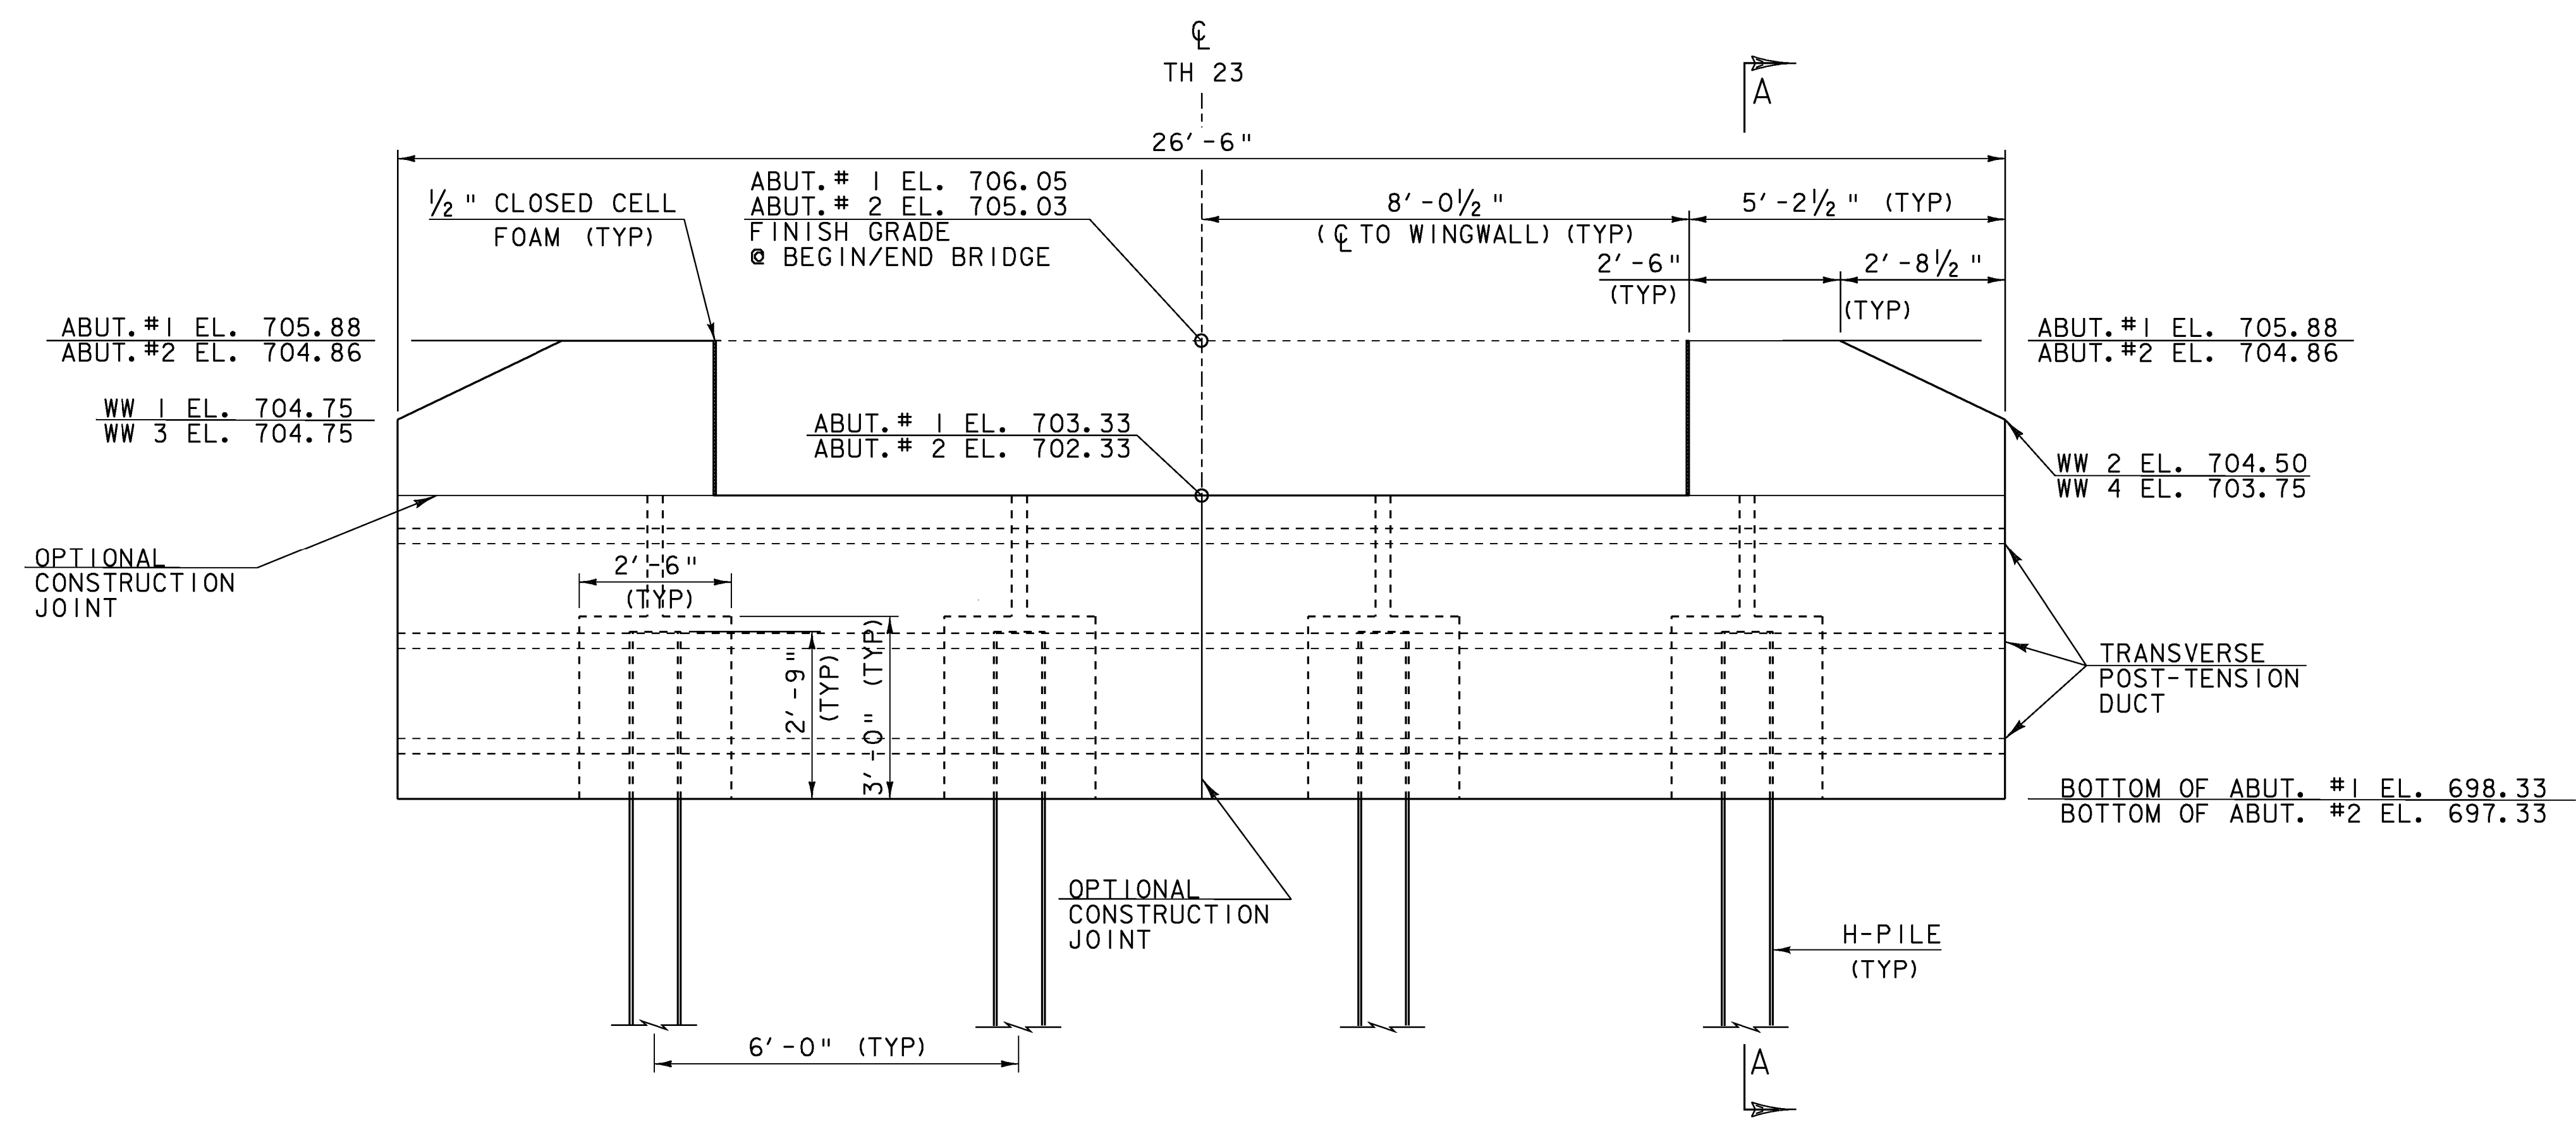

TYPICAL ABUTMENT ELEVATION

SCALE 1/2" = 1'-0"

NOT BUILT, USED CAST-IN-PLACE
 SEE SHOP DRAWINGS FOR DETAILS

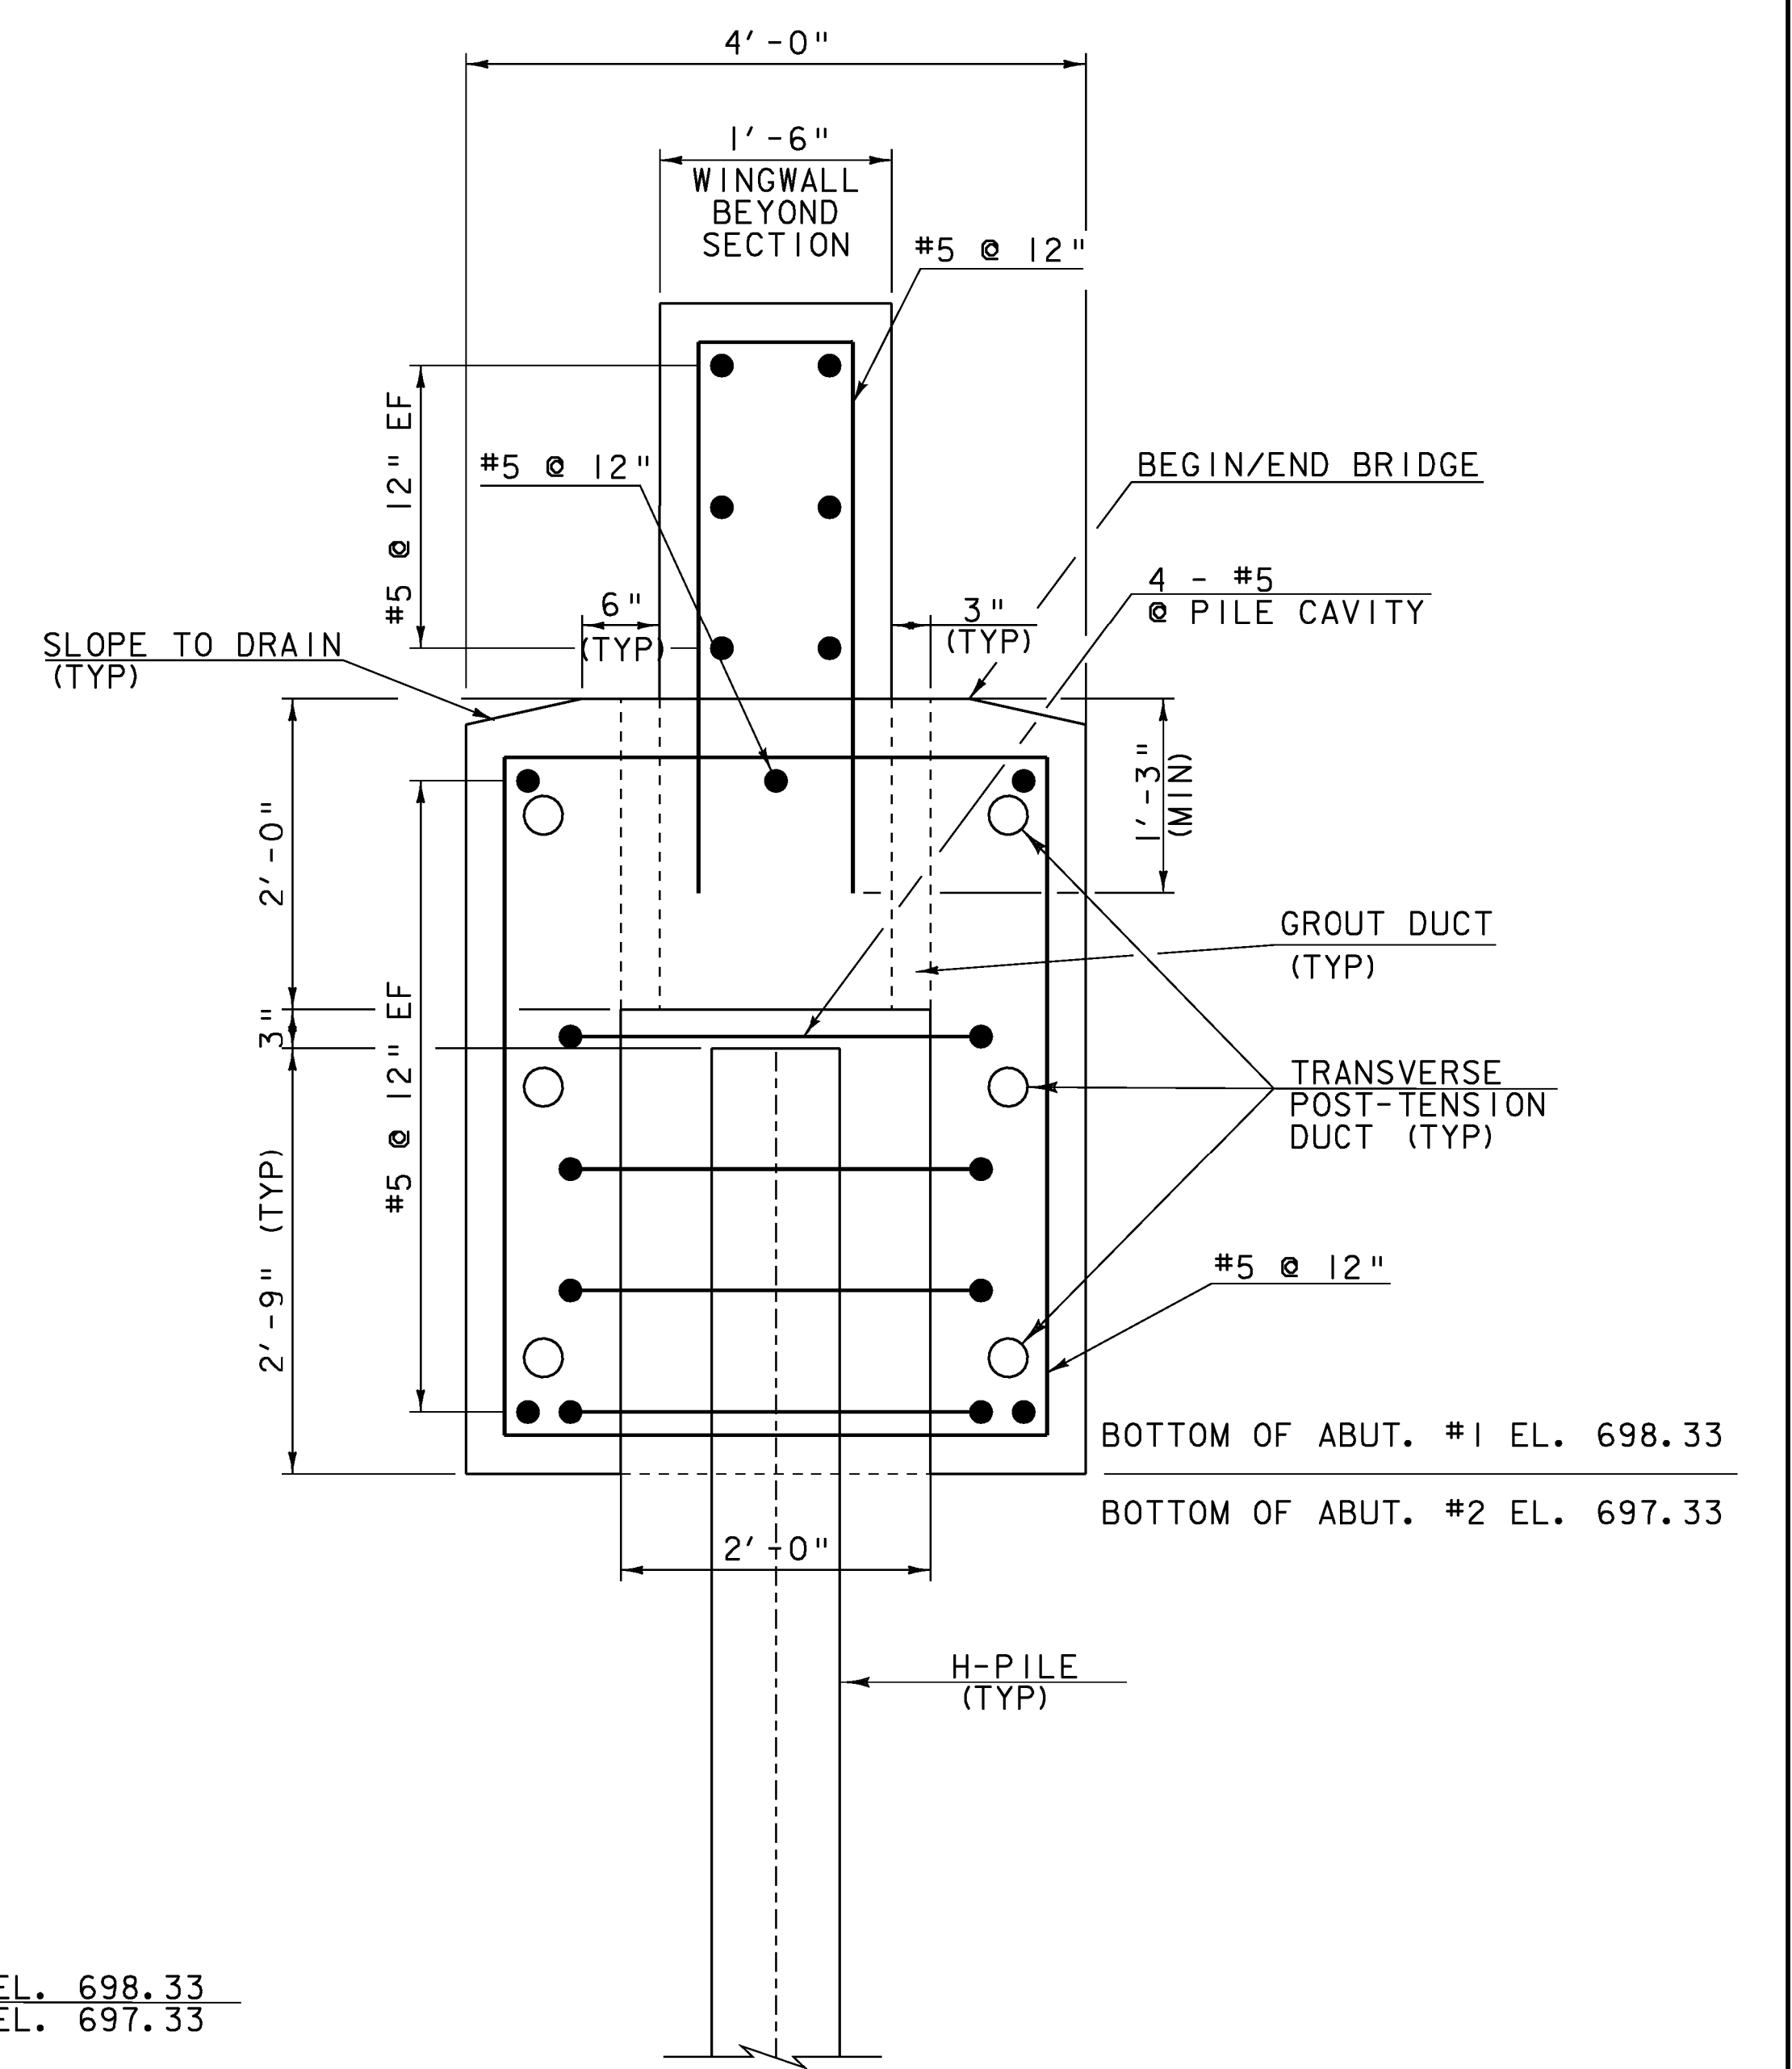

SECTION A-A

SCALE 1" = 1'-0"


NOTE:
 NF = NEAR FACE
 FF = FAR FACE
 EF = EACH FACE
 ▲ = CUT TO FIT IN FIELD
 3" CLEAR, UNLESS OTHERWISE SPECIFIED ON THE PLANS.
 2'-2" BAR LAP UNLESS OTHERWISE SPECIFIED ON THE PLANS.

NOTES:
 ONCE PILES HAVE BEEN CUT TO THEIR FINAL ELEVATIONS, 1" x 12" x 12" STEEL PLATES SHALL BE WELDED TO THE TOP OF THE PILES.

PILE CAVITY GROUT (FILL AND VENT) DUCTS SHALL BE CORRUGATED.

SEE GENERAL NOTES FOR ADDITIONAL FABRICATION, CONSTRUCTION AND SEQUENCE NOTES.

PROJECT NAME:	BRAINTREE	PLOT DATE:	14-JAN-2010
PROJECT NUMBER:	BRO 1444(36)	DRAWN BY:	K. PATTERSON
FILE NAME:	s95J292sub.dgn	CHECKED BY:	T. FILLBACH
PROJECT LEADER:	K. HIGGINS	SHEET	19 OF 26
DESIGNED BY:	T. FILLBACH		
ABUTMENTS			


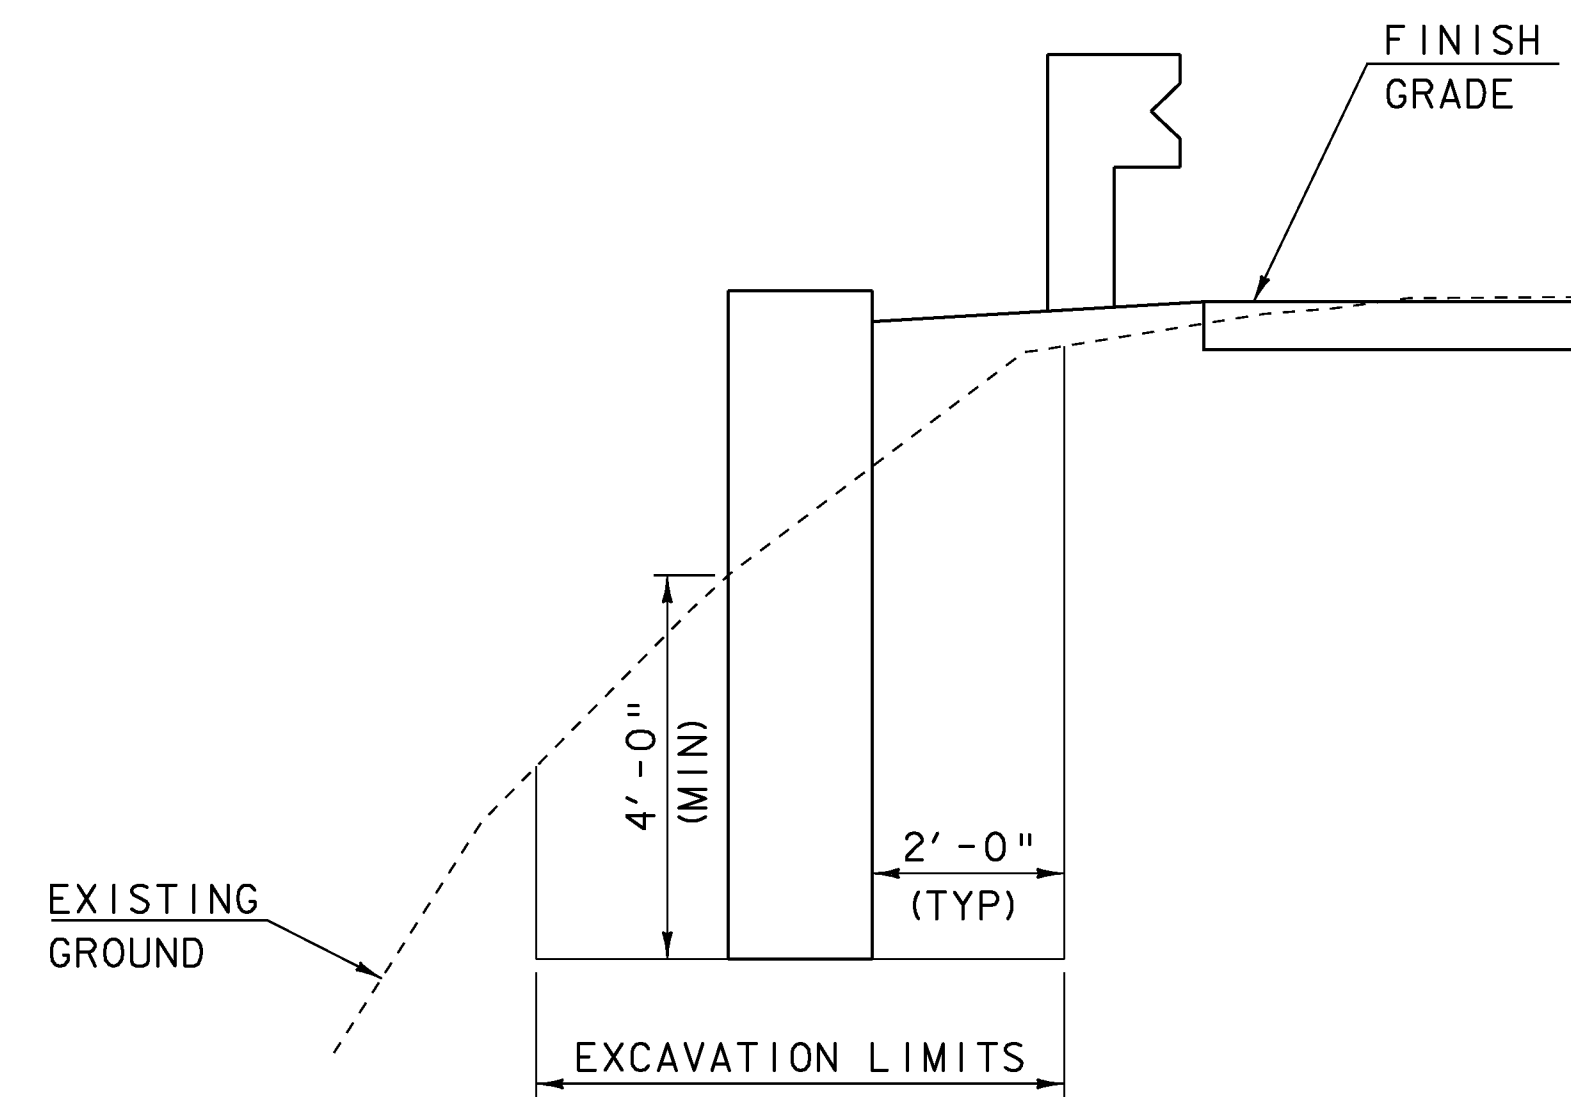


TYPICAL RETAINING WALL EARTHWORKS DETAIL

SCALE 1/2" = 1'-0"


RETAINING WALL NOTES:

1. THE DETAILS SHOWN ARE CONCEPTUAL IN NATURE AND ARE INTENDED TO PROVIDE OVERALL INFORMATION SUCH AS BEGINNING AND END OF WALL AND APPROXIMATE TOP AND BOTTOM PROFILE OF THE WALL.
2. THE WALL SHALL BE SELECTED FROM THE LIST OF WALLS IN THE APPROVED RETAINING WALL DOCUMENT AVAILABLE FROM VAOT MATERIALS & RESEARCH WEB SITE.
3. THE BOTTOM OF WALL SHALL BE A MINIMUM OF 4 FEET BELOW THE FINISH GRADE IN THE FRONT OF WALL.
4. THE WALL SHALL BE DESIGNED IN ACCORDANCE WITH THE 2009 AASHTO LRFD BRIDGE DESIGN SPECIFICATIONS AND ITS LATEST REVISIONS.
5. THE DESIGN SHALL CONSIDER THE EFFECTS OF ALL LOADS INCLUDING BUT NOT LIMITED TO LOADS FROM THE GUARDRAIL, EARTH SURCHARGE, LIVE LOAD SURCHARGE, AND HYDROSTATIC PRESSURE.
6. THE TYPE OF WALL SELECTED SHALL BE COMPATIBLE WITH THE GUARD RAIL SYSTEM SHOWN ON THE PLANS AND SHALL CONSIDER THE EFFECT OF 8 FOOT GUARD RAIL POSTS ON ANY REINFORCING OR ANCHORING SYSTEM.
7. THE FOLLOWING SOIL PROPERTIES SHALL BE USED IN THE DESIGN:
 - a. SELECT BACKFILL (GRANULAR BACKFILL FOR STRUCTURES)
 - i. UNIT WEIGHT: 140 PCF
 - ii. FRICTION ANGLE: 34 DEGREES
 - iii. COHESION, c: 0
 - b. RETAINED SOIL
 - i. UNIT WEIGHT: 130 PCF
 - ii. FRICTION ANGLE: 32 DEGREES
 - iii. COHESION, c: 0
 - c. FOUNDATION SOIL
 - i. UNIT WEIGHT: 115 PCF
 - ii. FRICTION ANGLE: 30 DEGREES
 - iii. COHESION, c: 0
 - iv. NOMINAL BEARING RESISTANCE: 9 KSF
8. THE INTERFACE BETWEEN THE RETAINING WALL AND THE ABUTMENT STEM SHALL BE DESIGNED AND SUBMITTED TO THE PROJECT MANAGER FOR REVIEW AND APPROVAL.
9. THE WALL, INCLUDING ALL COMPONENTS, EXCAVATION AND BACKFILL, NECESSARY TO CONSTRUCT THE WALL, SHALL BE INCLUDED IN THE UNIT PRICE BID FOR ITEM 900.670 "SPECIAL PROVISION (RETAINING WALL)".

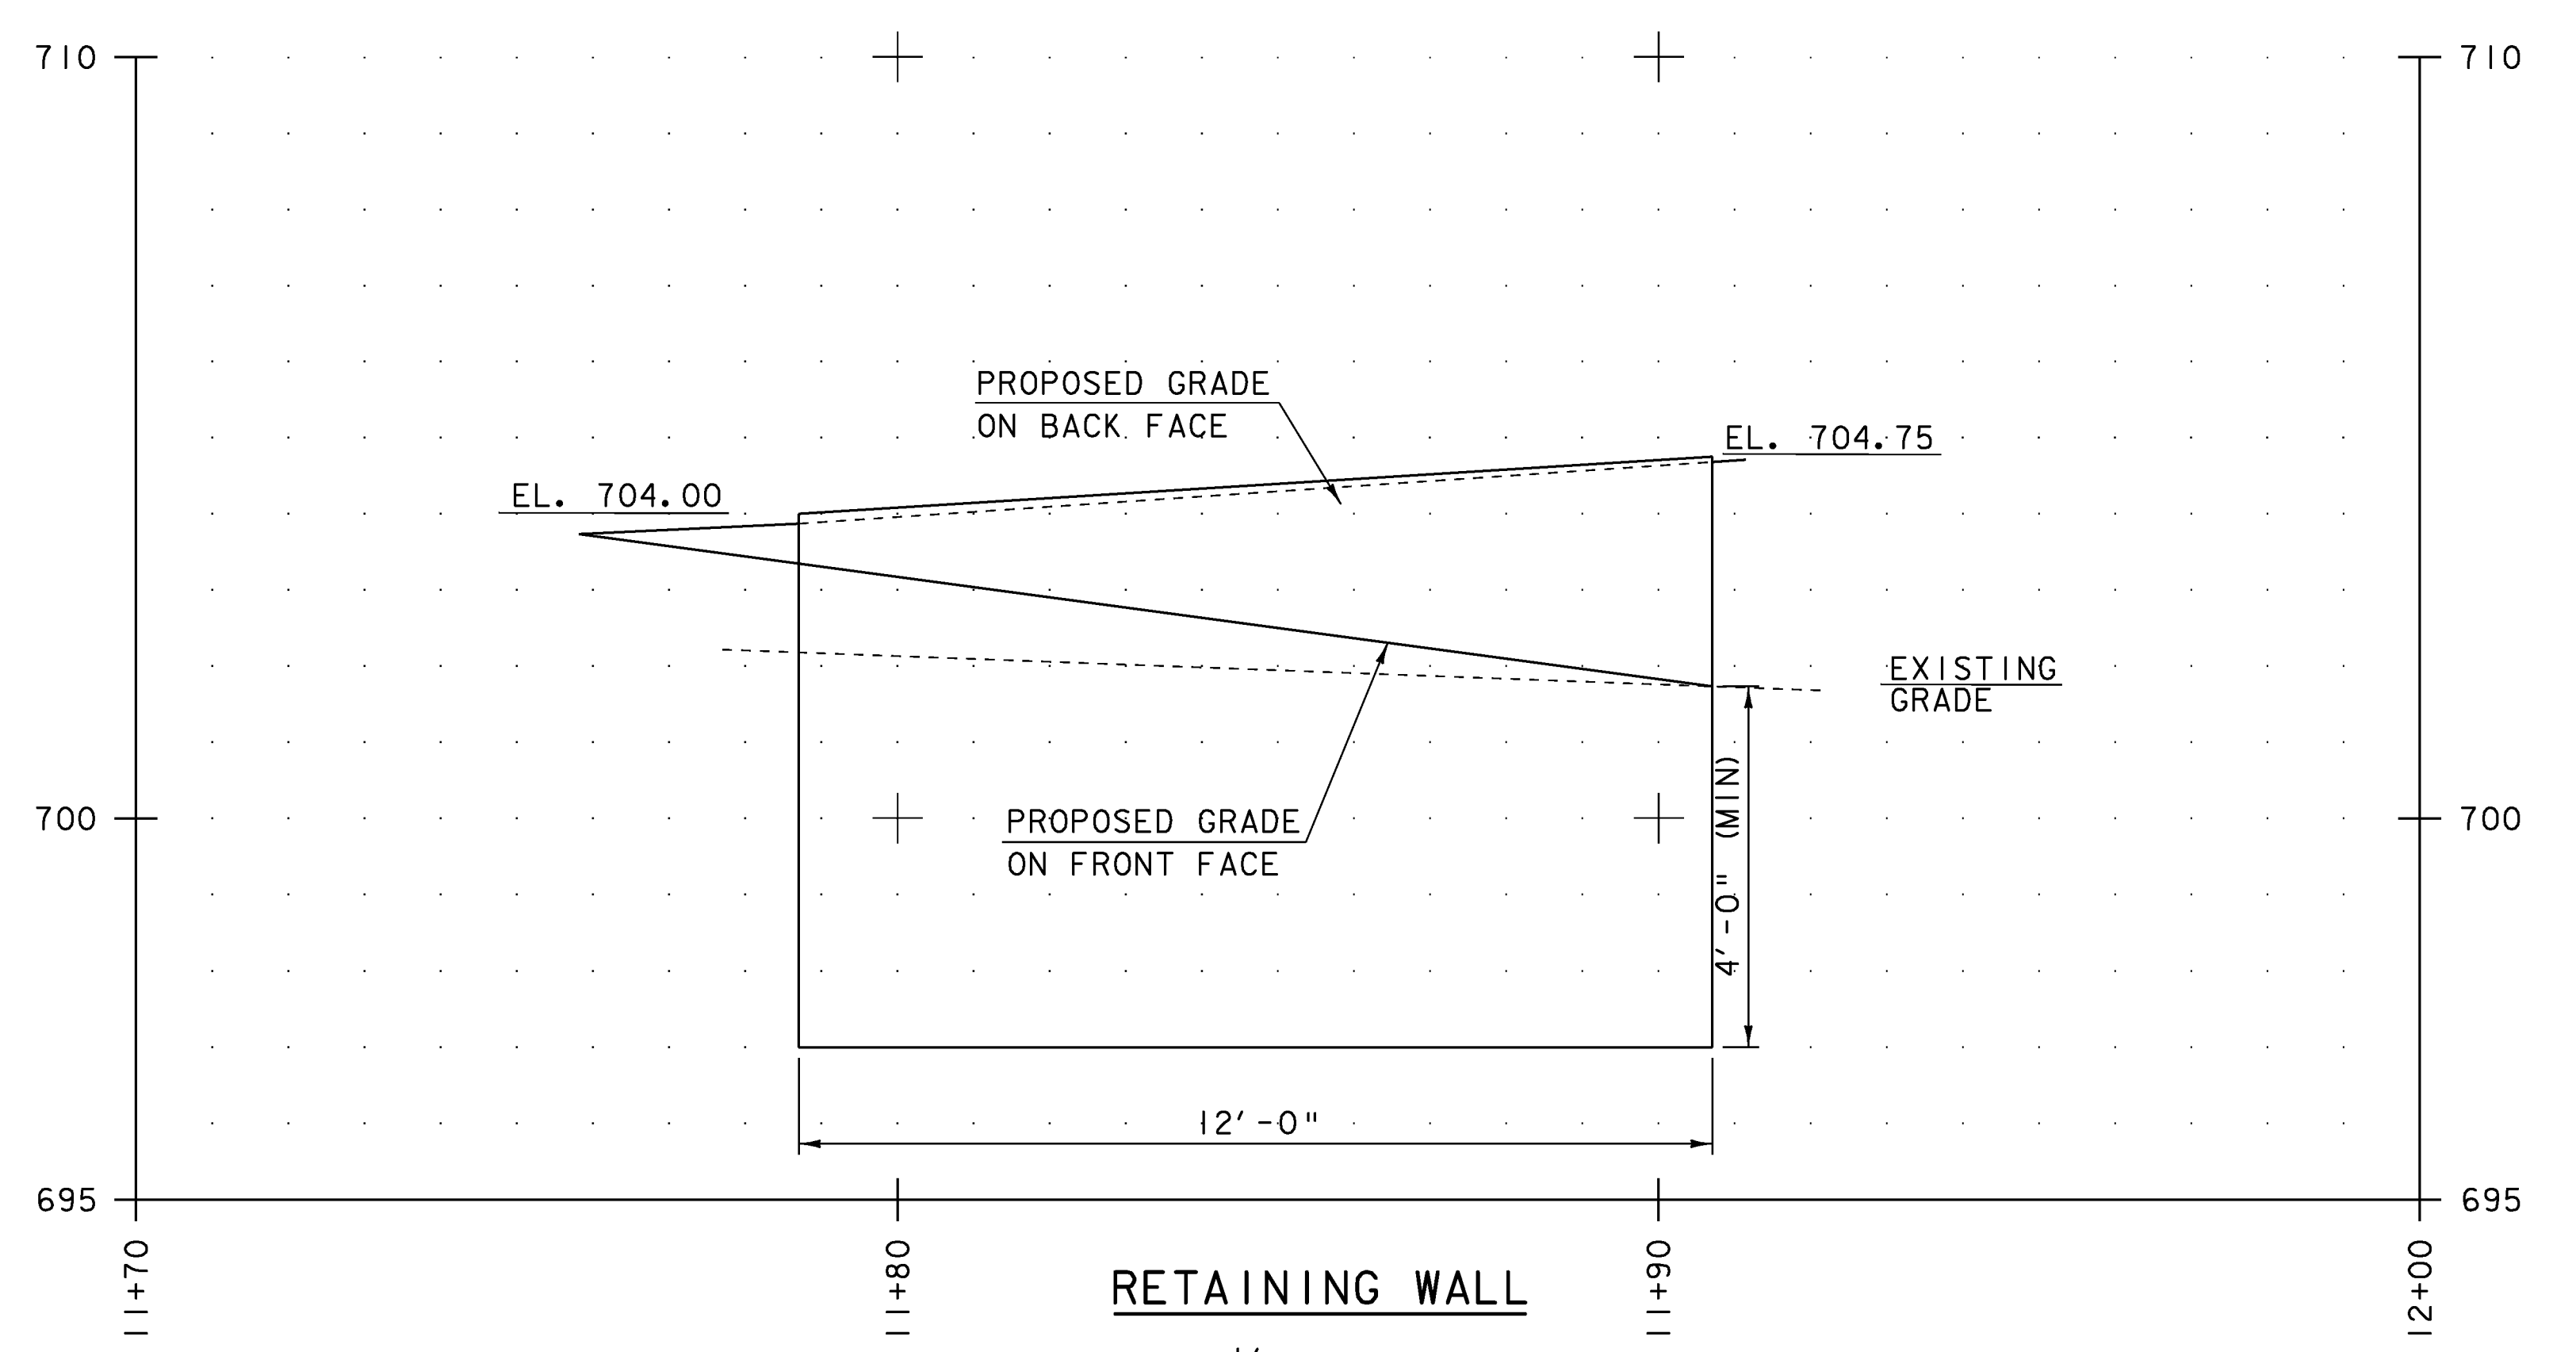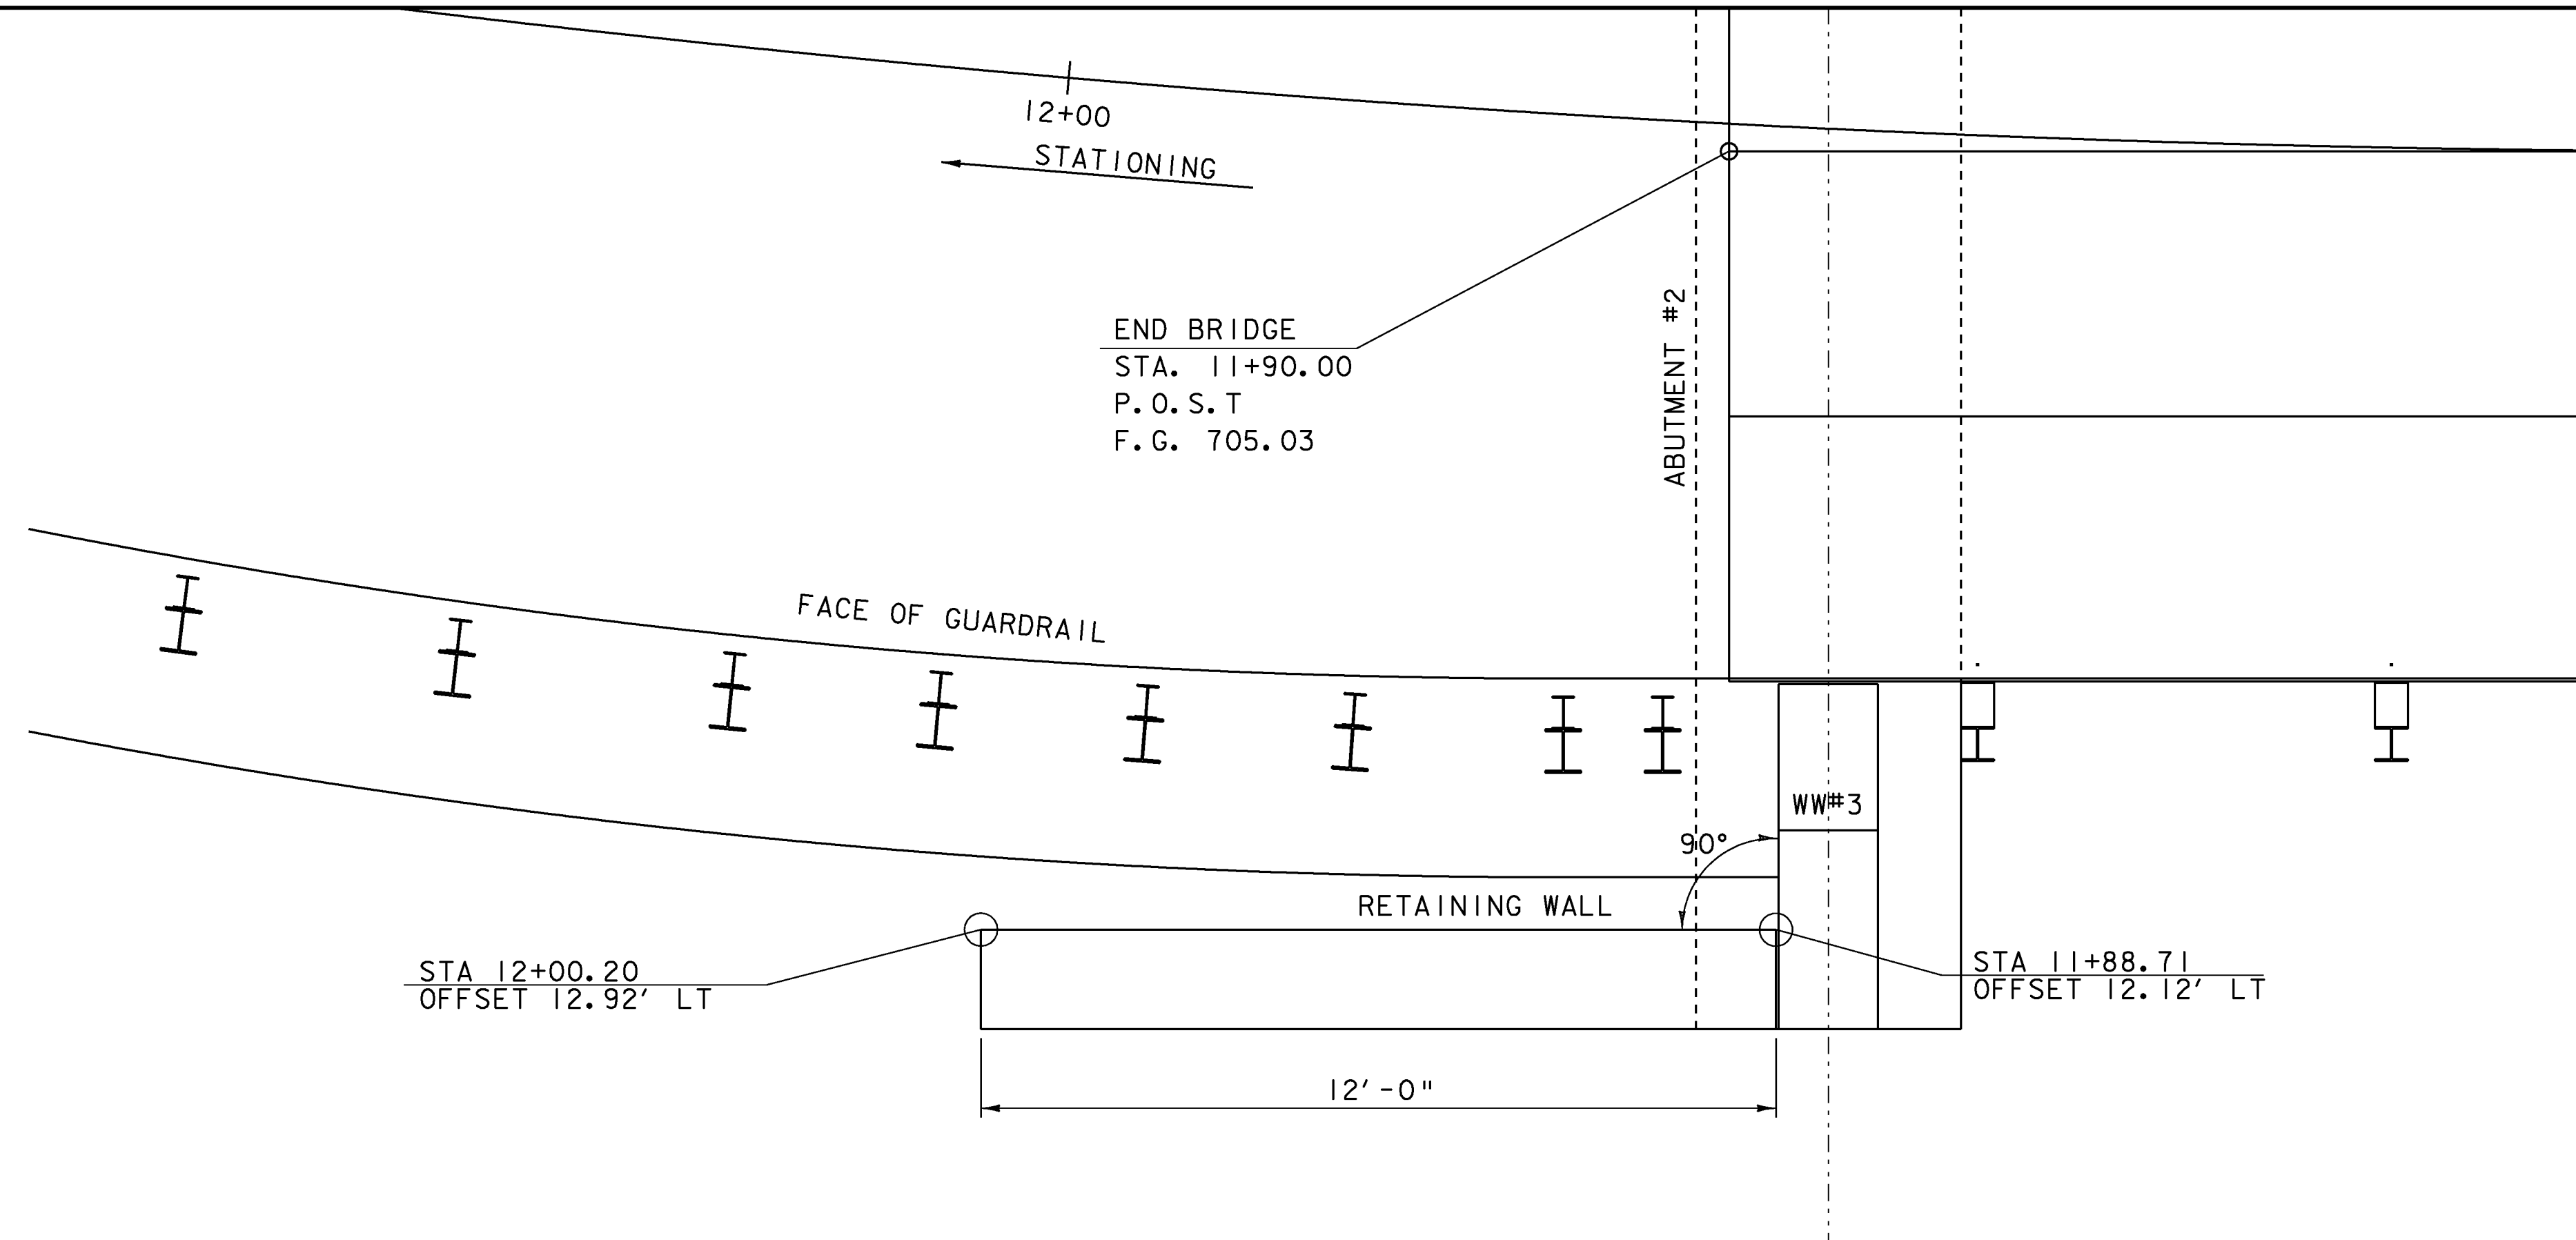


RETAINING WALL

SCALE 1/2" = 1'-0"

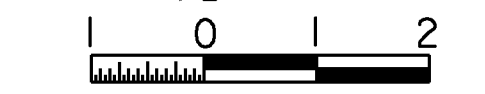

PROJECT NAME:	BRAINTREE
PROJECT NUMBER:	BRO 1444(36)
FILE NAME:	s95J292sub.dgn
PROJECT LEADER:	K. HIGGINS
DESIGNED BY:	T. FILLBACH
RETAINING WALL	
PLOT DATE:	31-DEC-2009
DRAWN BY:	K. PATTERSON
CHECKED BY:	T. FILLBACH
SHEET	20 OF 26

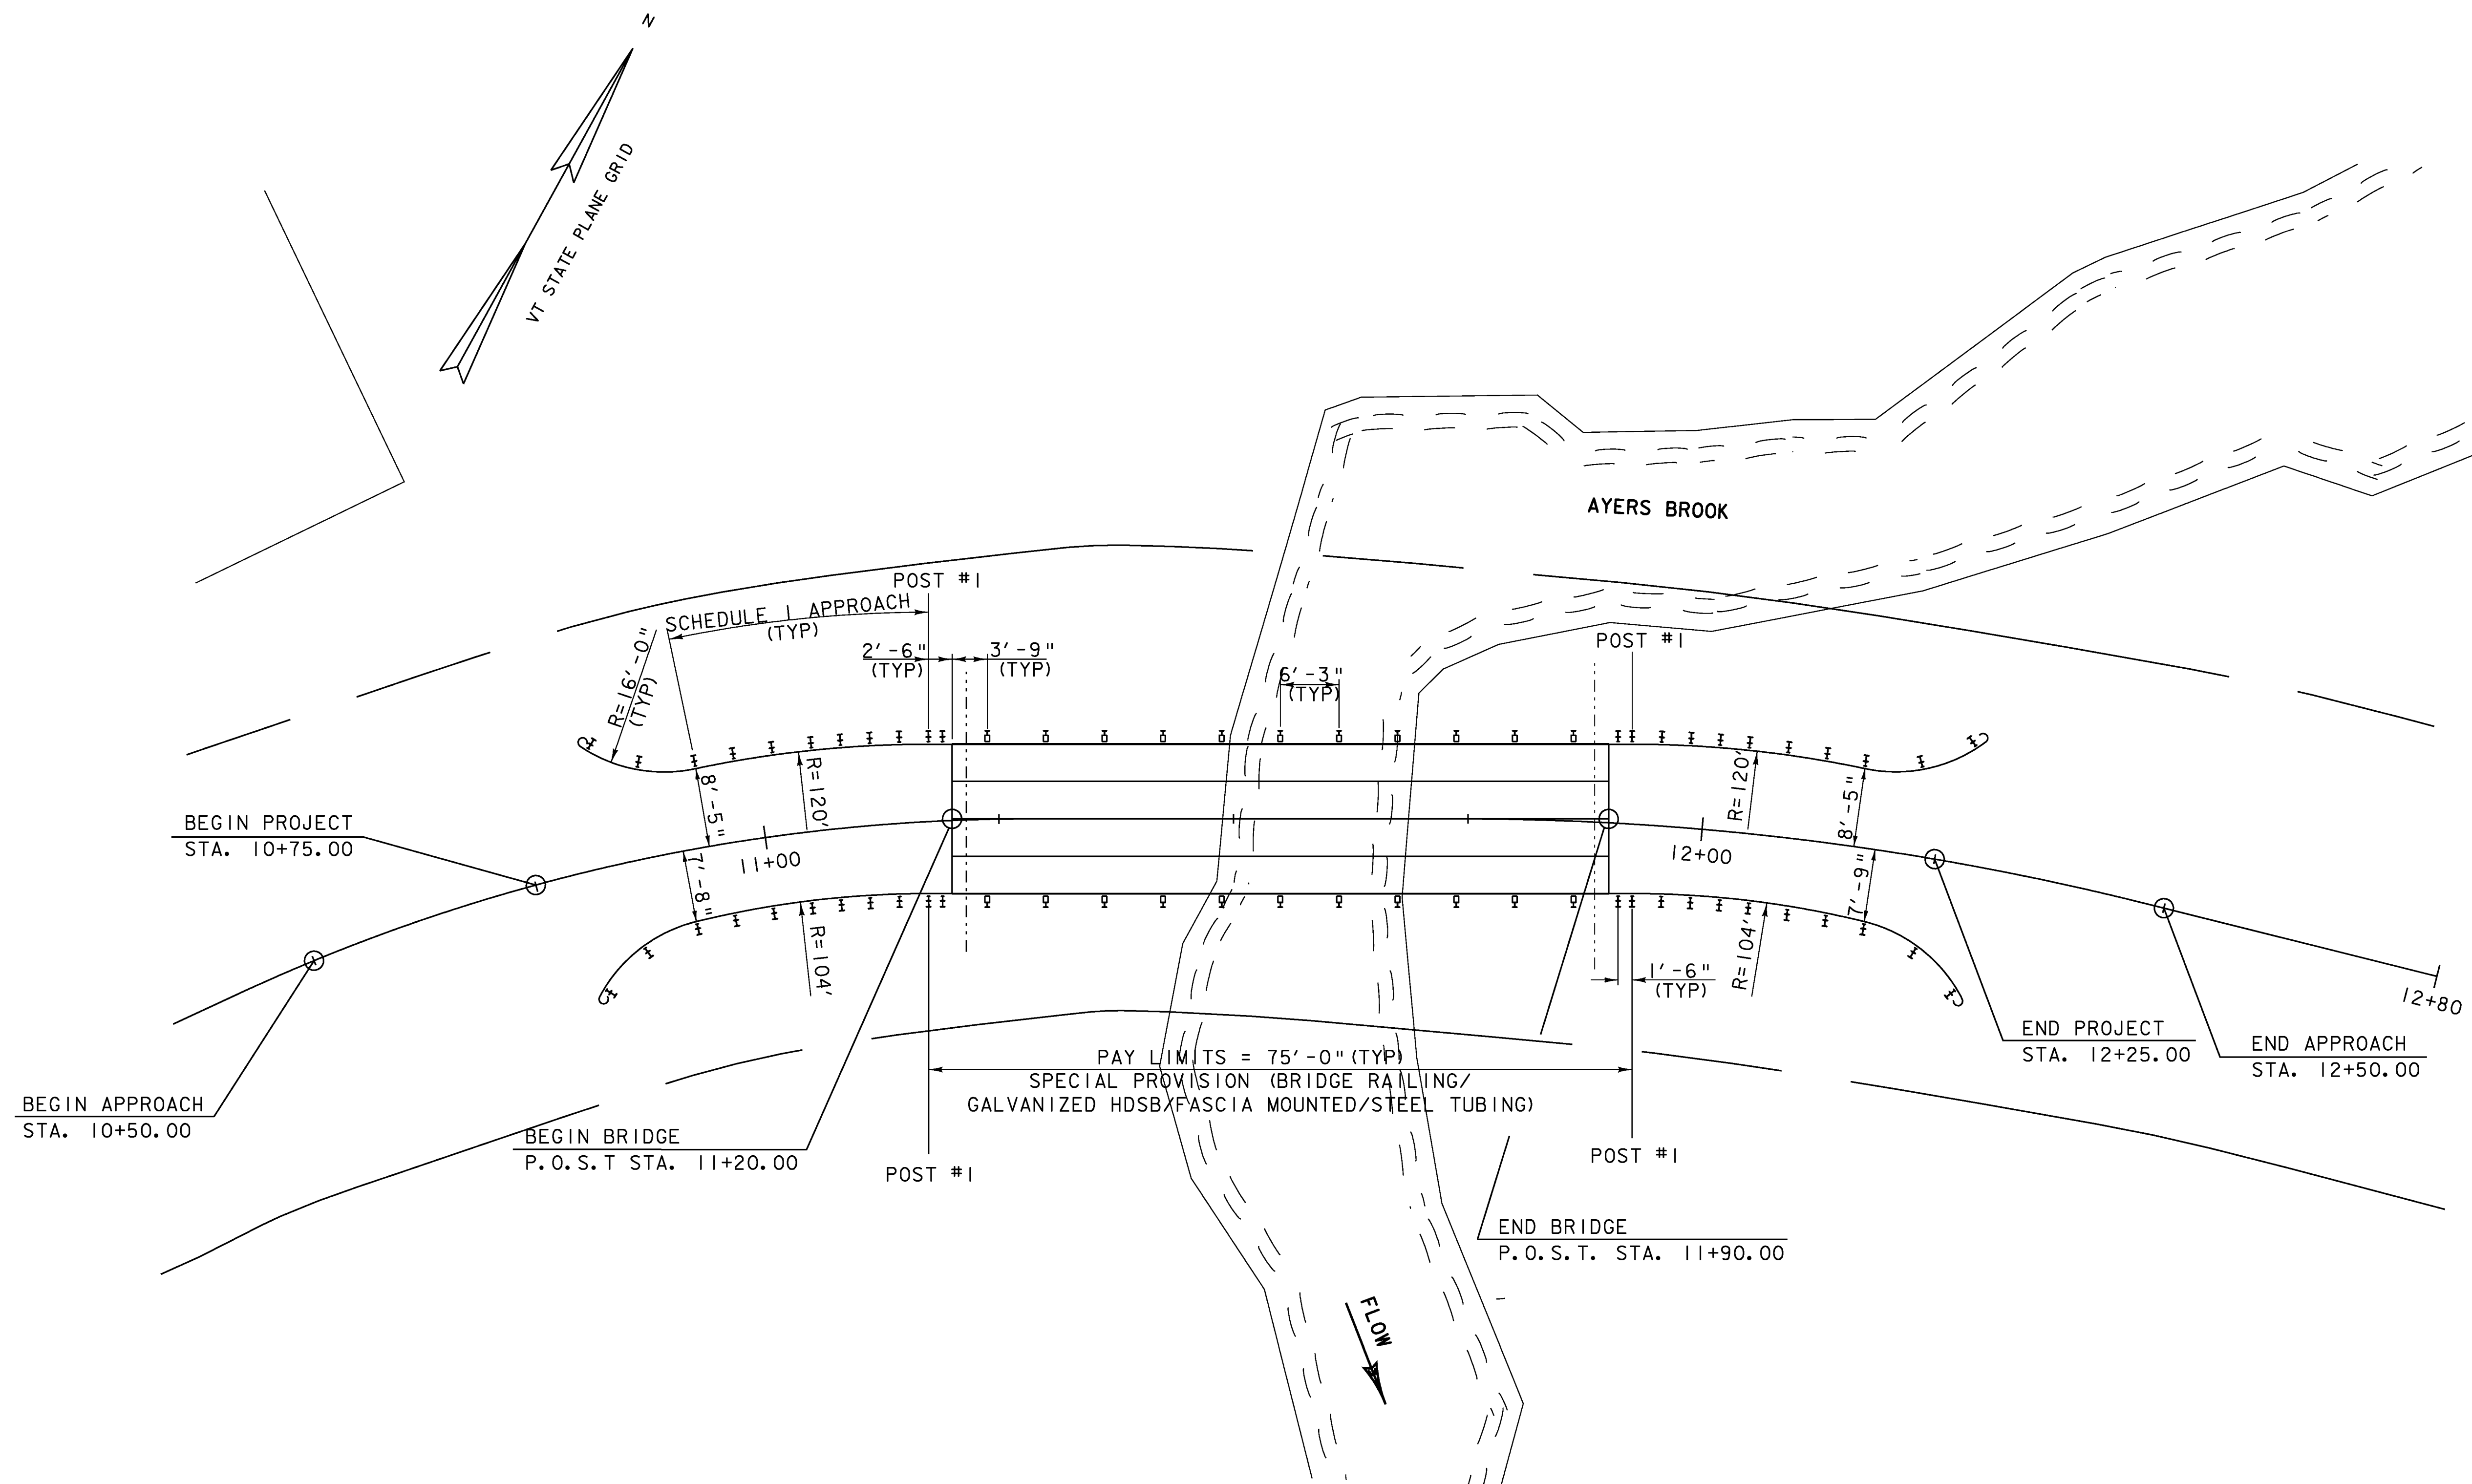


RAIL LAYOUT
 SCALE 1" = 10'-0"
 10 0 10


PROJECT NAME: BRAINTREE	PLOT DATE: 14-JAN-2010
PROJECT NUMBER: BRO 1444(36)	DRAWN BY: K. PATTERSON
FILE NAME: s95j292rail.dgn	CHECKED BY: T. FILLBACH
PROJECT LEADER: K. HIGGINS	SHEET 21 OF 26
DESIGNED BY: T. FILLBACH	
RAIL LAYOUT SHEET	

FASCIA MOUNTED WITHOUT CURB NOTES


BOLTS IN SLOTTED HOLES SHALL NOT BE DRAWN UP SO TIGHT AS TO PREVENT SLIDING BETWEEN THE TUBE AND CHANNEL.

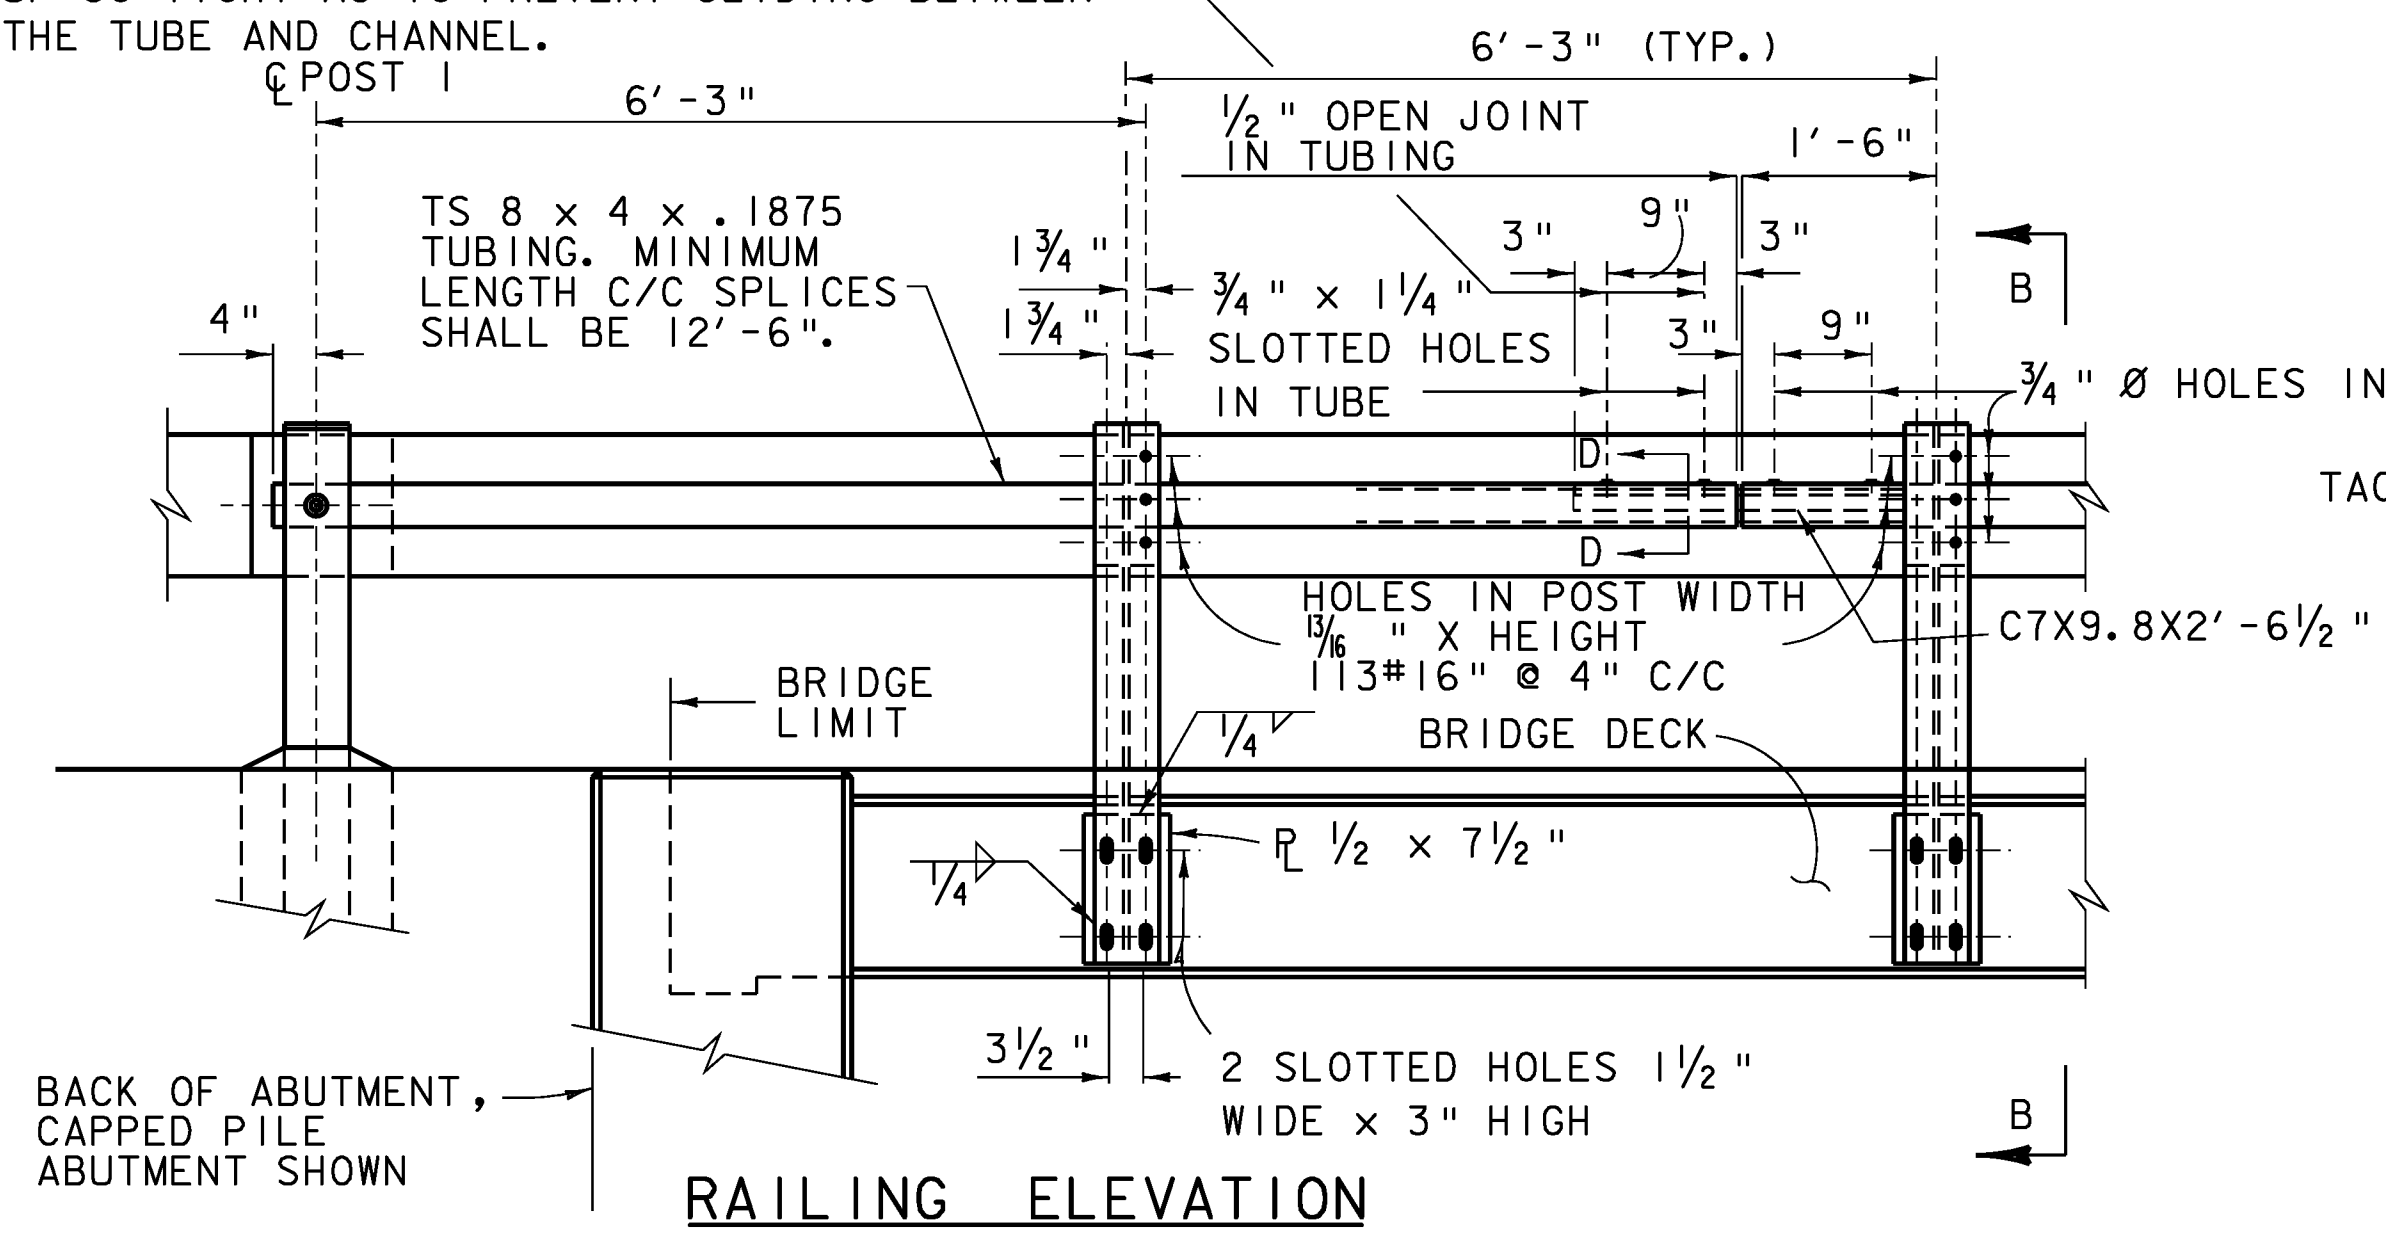

RAILING ELEVATION

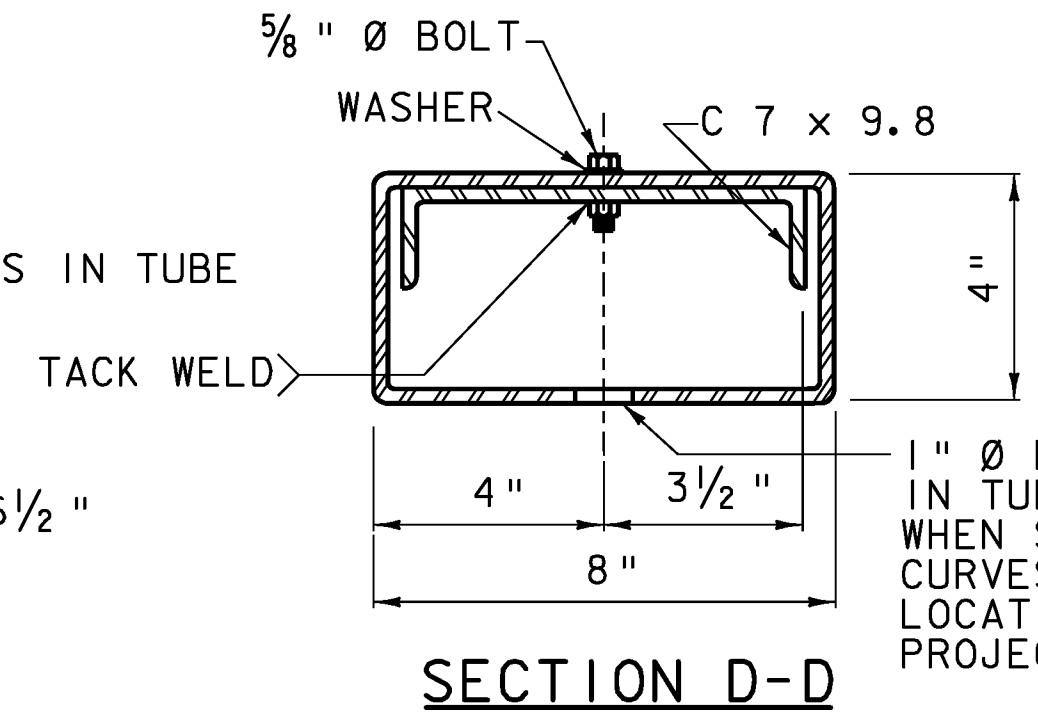


SECTION D-D

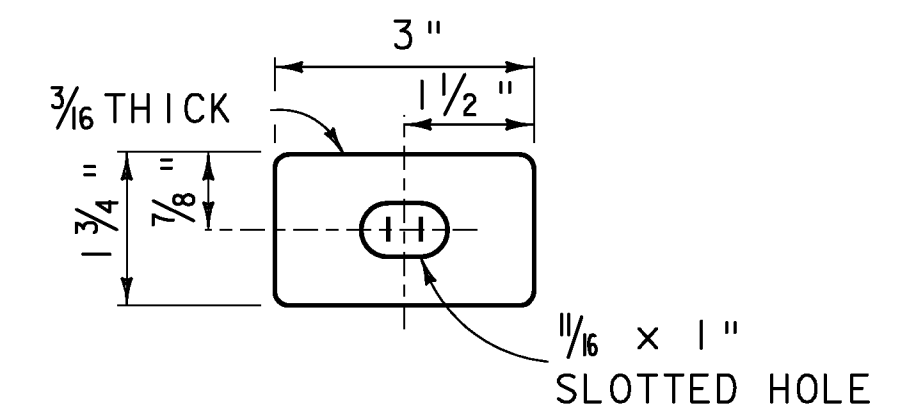

SPECIAL WASHER


PLACE WASHER BETWEEN BOLT HEAD AND FACE OF RAIL.

1. HEAVY DUTY STEEL BEAM GUARD RAIL SHALL CONFORM TO VT. SPECIFICATION SECTION 732.
2. STRUCTURAL STEEL TUBING SHALL CONFORM TO VT. SPECIFICATION SECTION 732 GALVANIZED AFTER FABRICATION IN ACCORDANCE WITH AASHTO M111M/M111.
3. ANCHOR BOLTS, NUTS AND WASHERS SHALL BE GALVANIZED IN ACCORDANCE WITH AASHTO M232M/M232 GALVANIZED AFTER FABRICATION IN ACCORDANCE WITH AASHTO M111M/M111.
4. BRIDGE RAIL POSTS, SPECIAL WASHERS, PLATE WASHERS AND SPLICE BARS SHALL CONFORM TO AASHTO M223M/M223 GALVANIZED AFTER FABRICATION IN ACCORDANCE WITH AASHTO M111M/M111.
5. ALL BOLTS AND RELATED HARDWARE SHALL CONFORM TO AASHTO M164 TYPE 1 BOLTS, HOT DIPPED OR MECHANICALLY GALVANIZED PER SPECIFICATION.
6. SEE STANDARD DRAWING G-1 AND G-1d FOR ADDITIONAL DETAILS CONCERNING GUARD RAIL.
7. SEE STANDARD DRAWING SB-R6-82 FOR APPROACH RAIL DETAILS AND FOR INFORMATION RELATIVE TO SCHEDULE I AND SCHEDULE II. ALL APPROACH RAIL SHALL BE HEAVY DUTY STEEL BEAM GUARD RAIL. ALSO SEE STD. DRWG. SB-R6-82 FOR HANDRAIL DETAILS (EXCEPT END DETAILS) IF HAND RAIL IS REQUIRED.
8. ALL POSTS SHALL BE SET NORMAL TO GRADE.
9. SPLICES FOR THE STEEL BEAM GUARD RAIL SHALL LAP IN THE DIRECTION OF TRAFFIC.
10. SEE STANDARD DRAWING G-1 FOR DETAILS OF DELINEATORS. A DELINEATOR SHALL BE LOCATED AT EVERY FIFTH POST. PAYMENT SHALL BE INCIDENTAL TO OTHER ITEMS.
11. A RAILING JOINT SPLICE SHALL BE PROVIDED AT EACH SUPERSTRUCTURE EXPANSION JOINT.
12. ALL FIELD CUT OR DRILLED AREAS SHALL BE REPAIRED PER SECTION 513.
13. FOR RADIUS LESS THAN 950 FEET, THE STEEL TUBING SHALL BE SHOP BENT TO FIT THE APPLICABLE CURVE.
14. THE DROP-WEIGHT TEAR TEST IN SECTION 732 SHALL NOT APPLY TO THE STRUCTURAL TUBING.

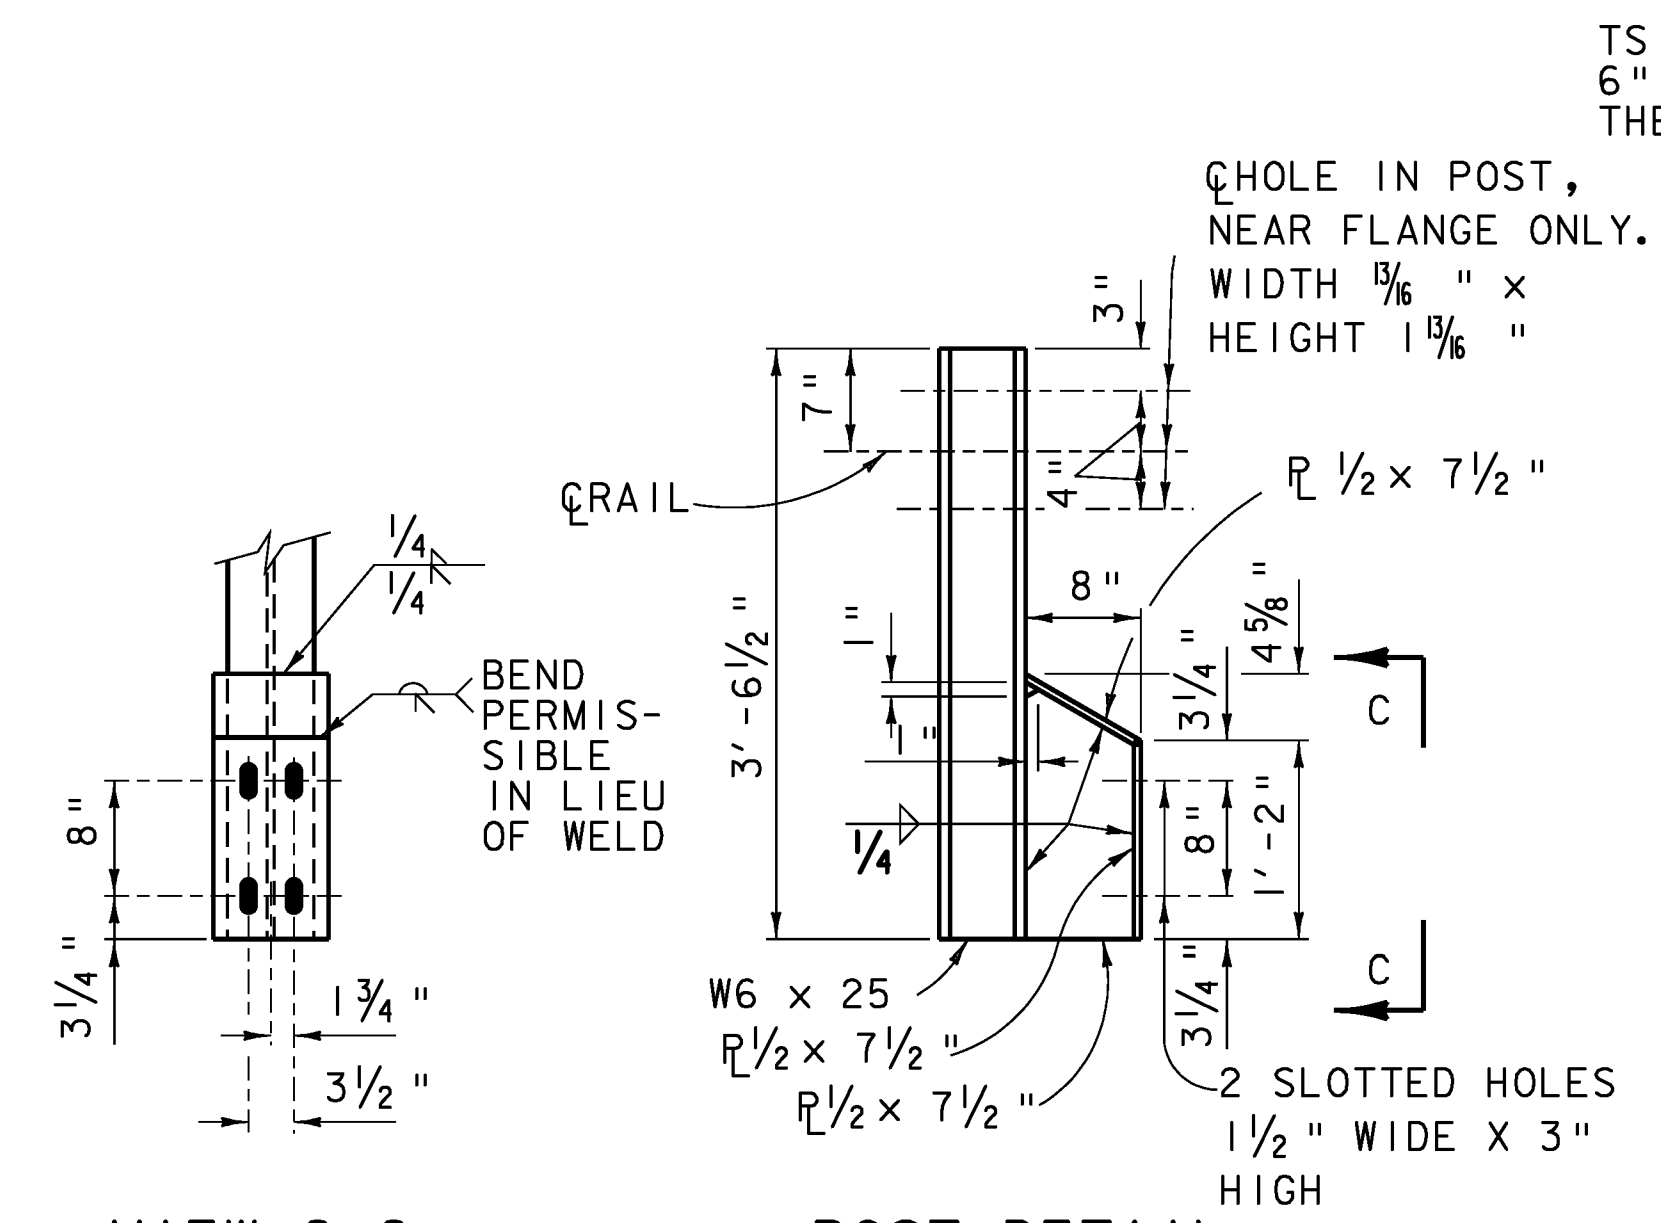


VIEW C-C

POST DETAIL

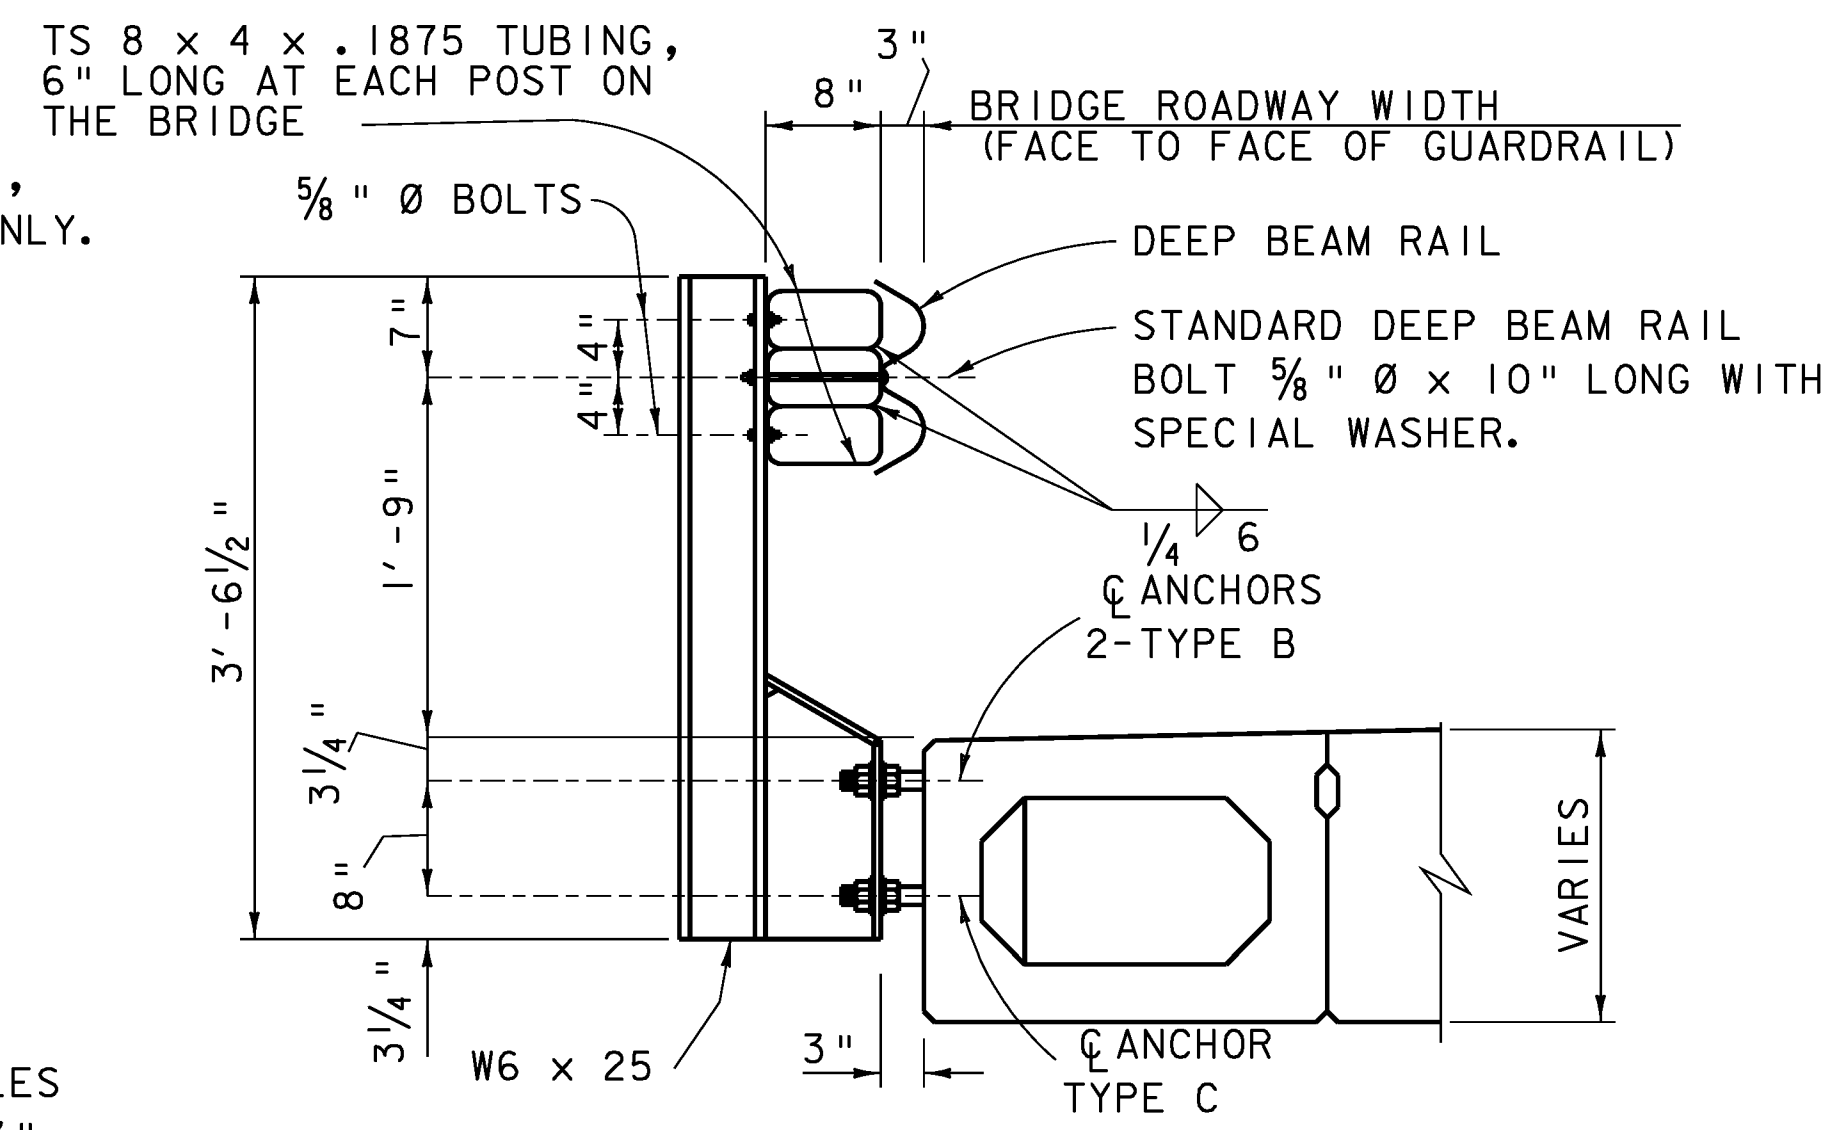


SECTION B-B

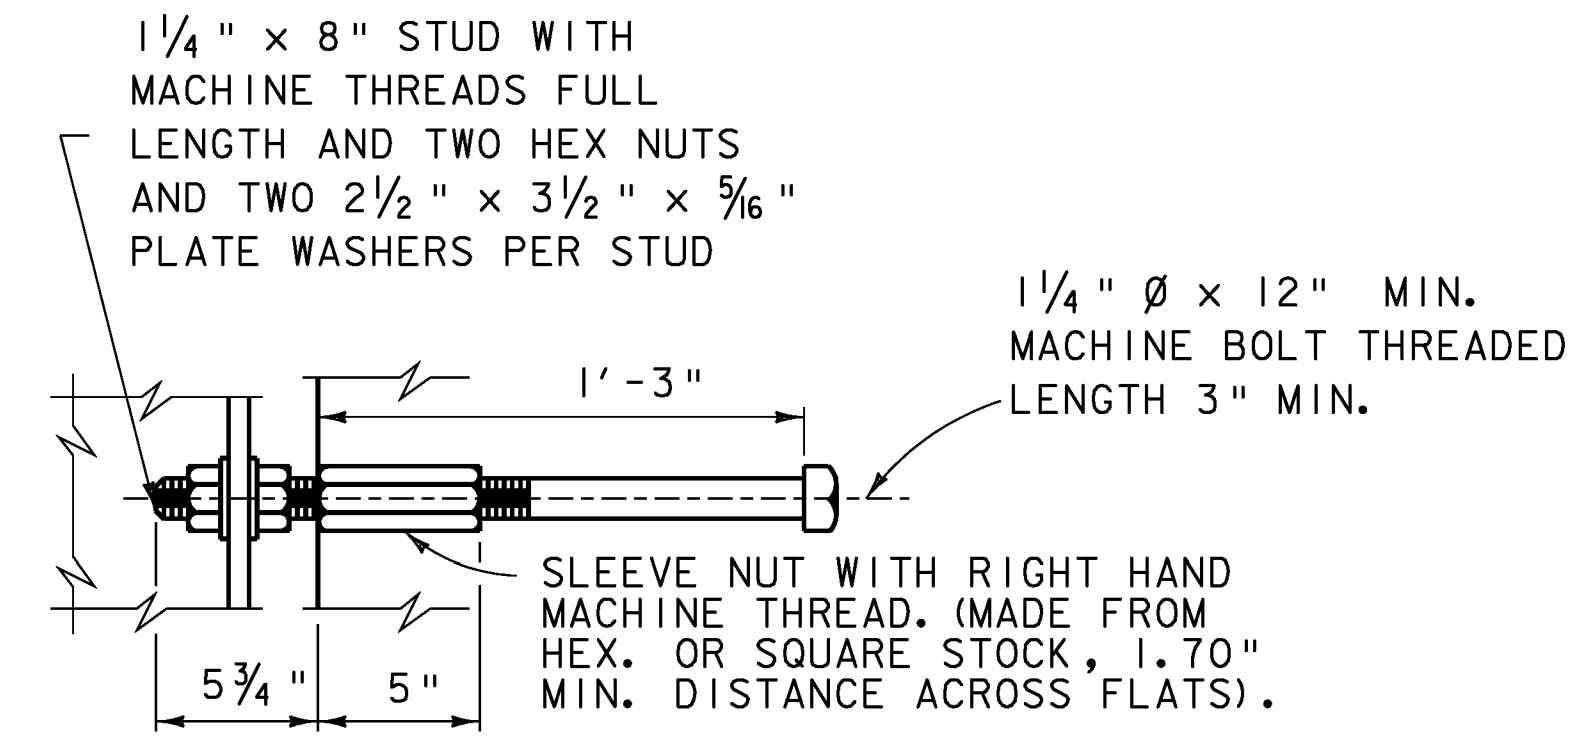

TYPE B ANCHOR DETAIL

TWO 1 1/4" x 8" STUDS WITH MACHINE THREADS FULL LENGTH AND TWO HEX NUTS AND TWO 2 1/2" x 3 1/2" x 5/16" PLATE WASHERS PER STUD.

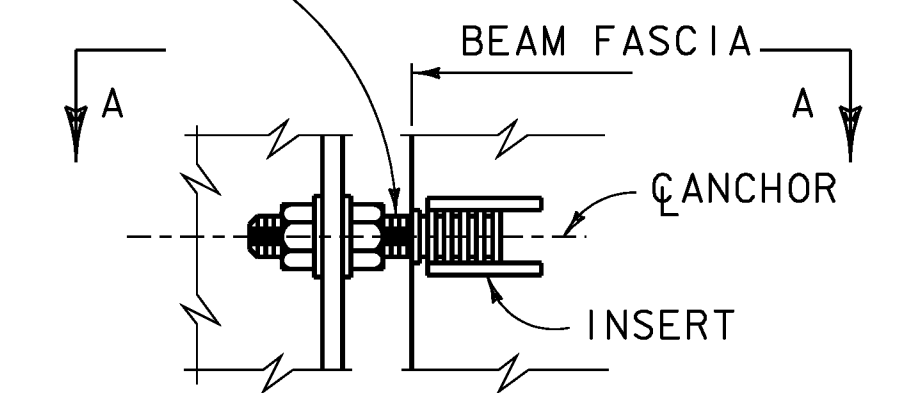


**SECTION A-A
TYPE C ANCHOR DETAIL**


NOTE:
ALTERNATE TYPE C ANCHOR MAY BE SUBMITTED FOR ACCEPTANCE. FERRULE SHALL BE DAYTON SUPERIOR F-43 PLAIN OR EQUIVALENT.

PROJECT NAME:	BRAINTREE
PROJECT NUMBER:	BRO 1444(36)
FILE NAME:	s95J292Raildet.dgn
PROJECT LEADER:	K. HIGGINS
DESIGNED BY:	T. FILLBACH
RAIL DETAIL	
PLOT DATE:	31-DEC-2009
DRAWN BY:	G. LAROCHE
CHECKED BY:	T. FILLBACH
SHEET	22 OF 26


N. T. S.

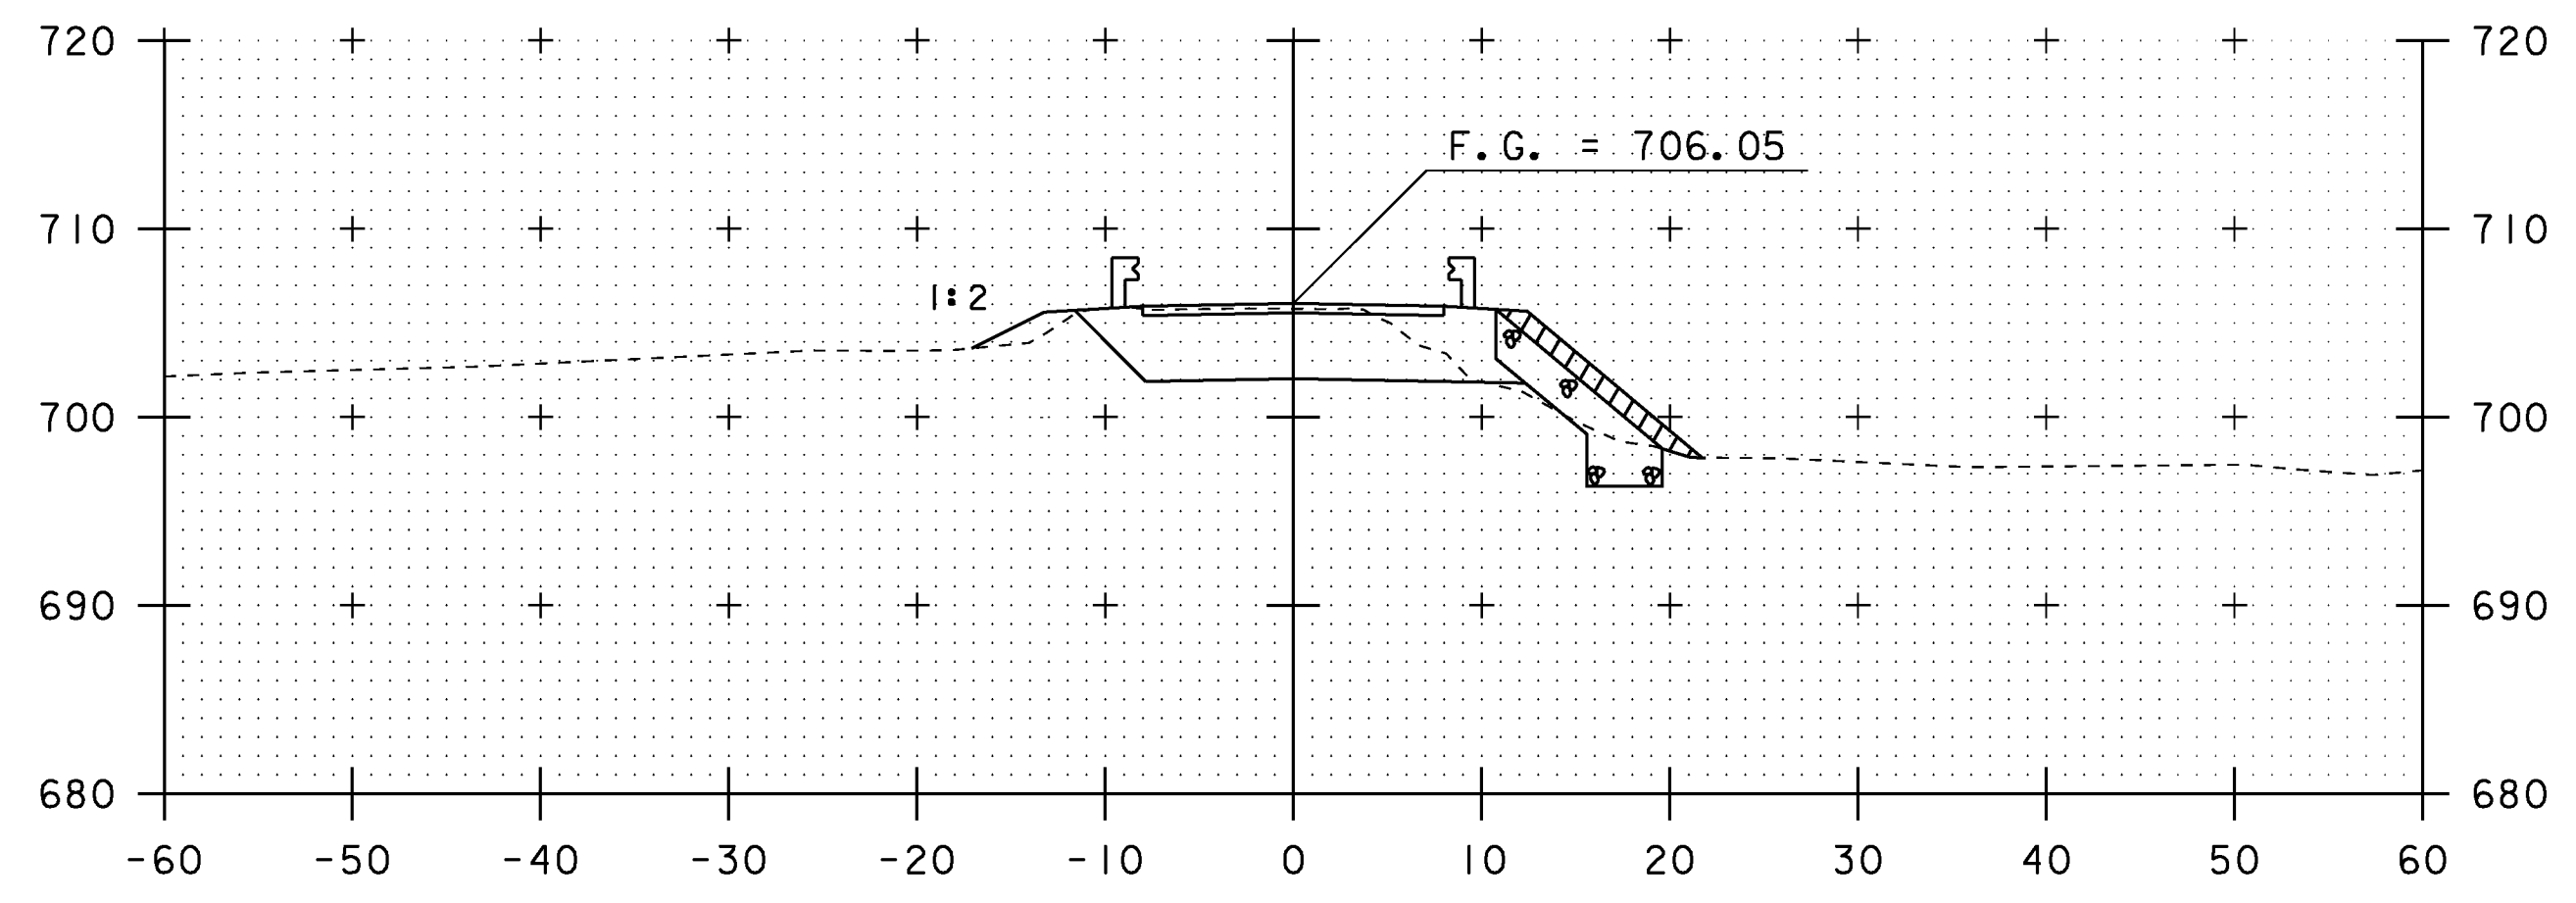


BEGIN BRIDGE
11+20

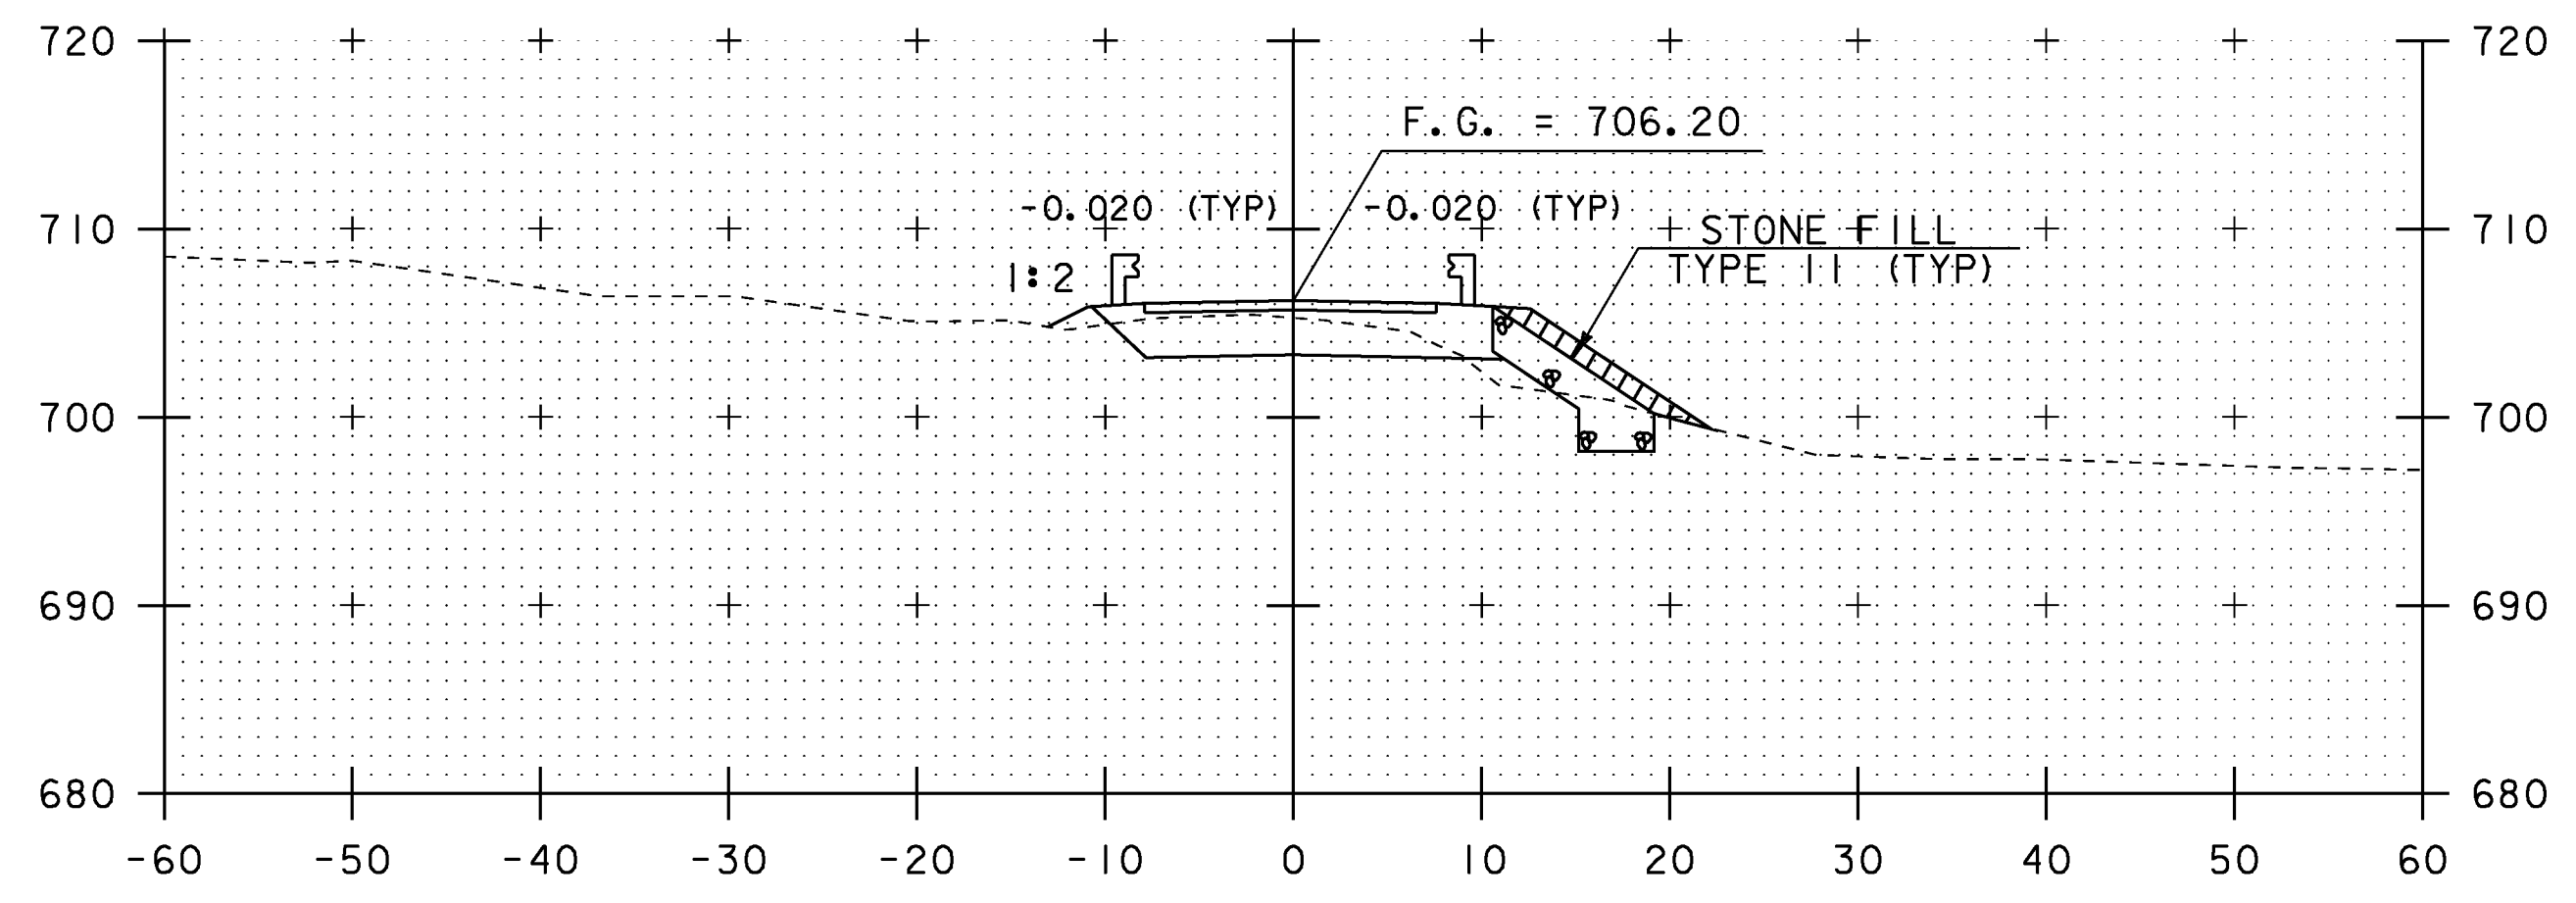


11+00

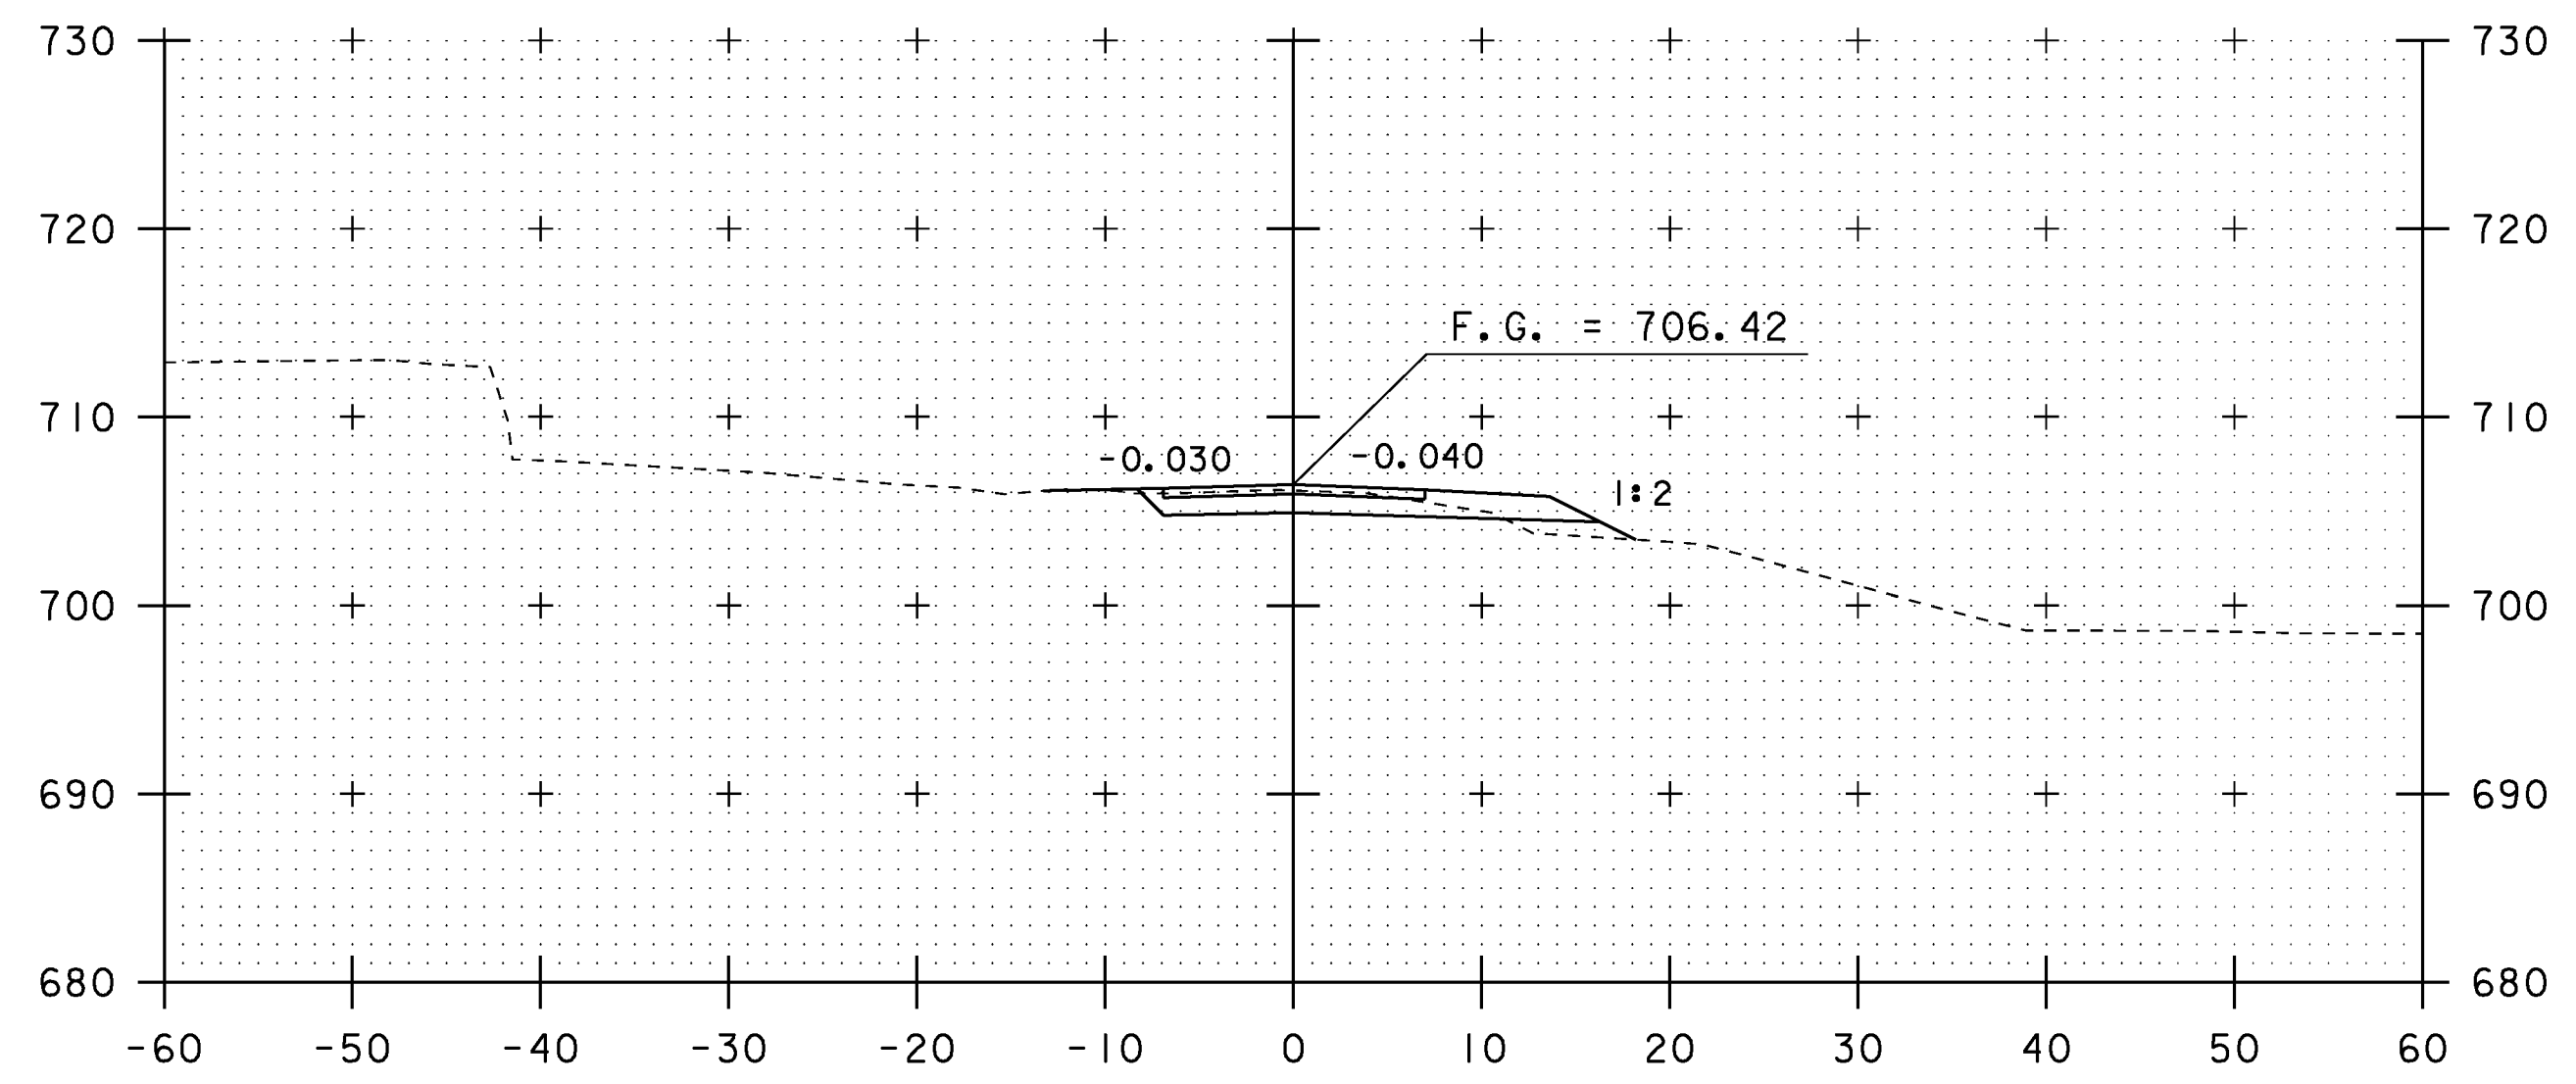

BEGIN PROJECT
10+75

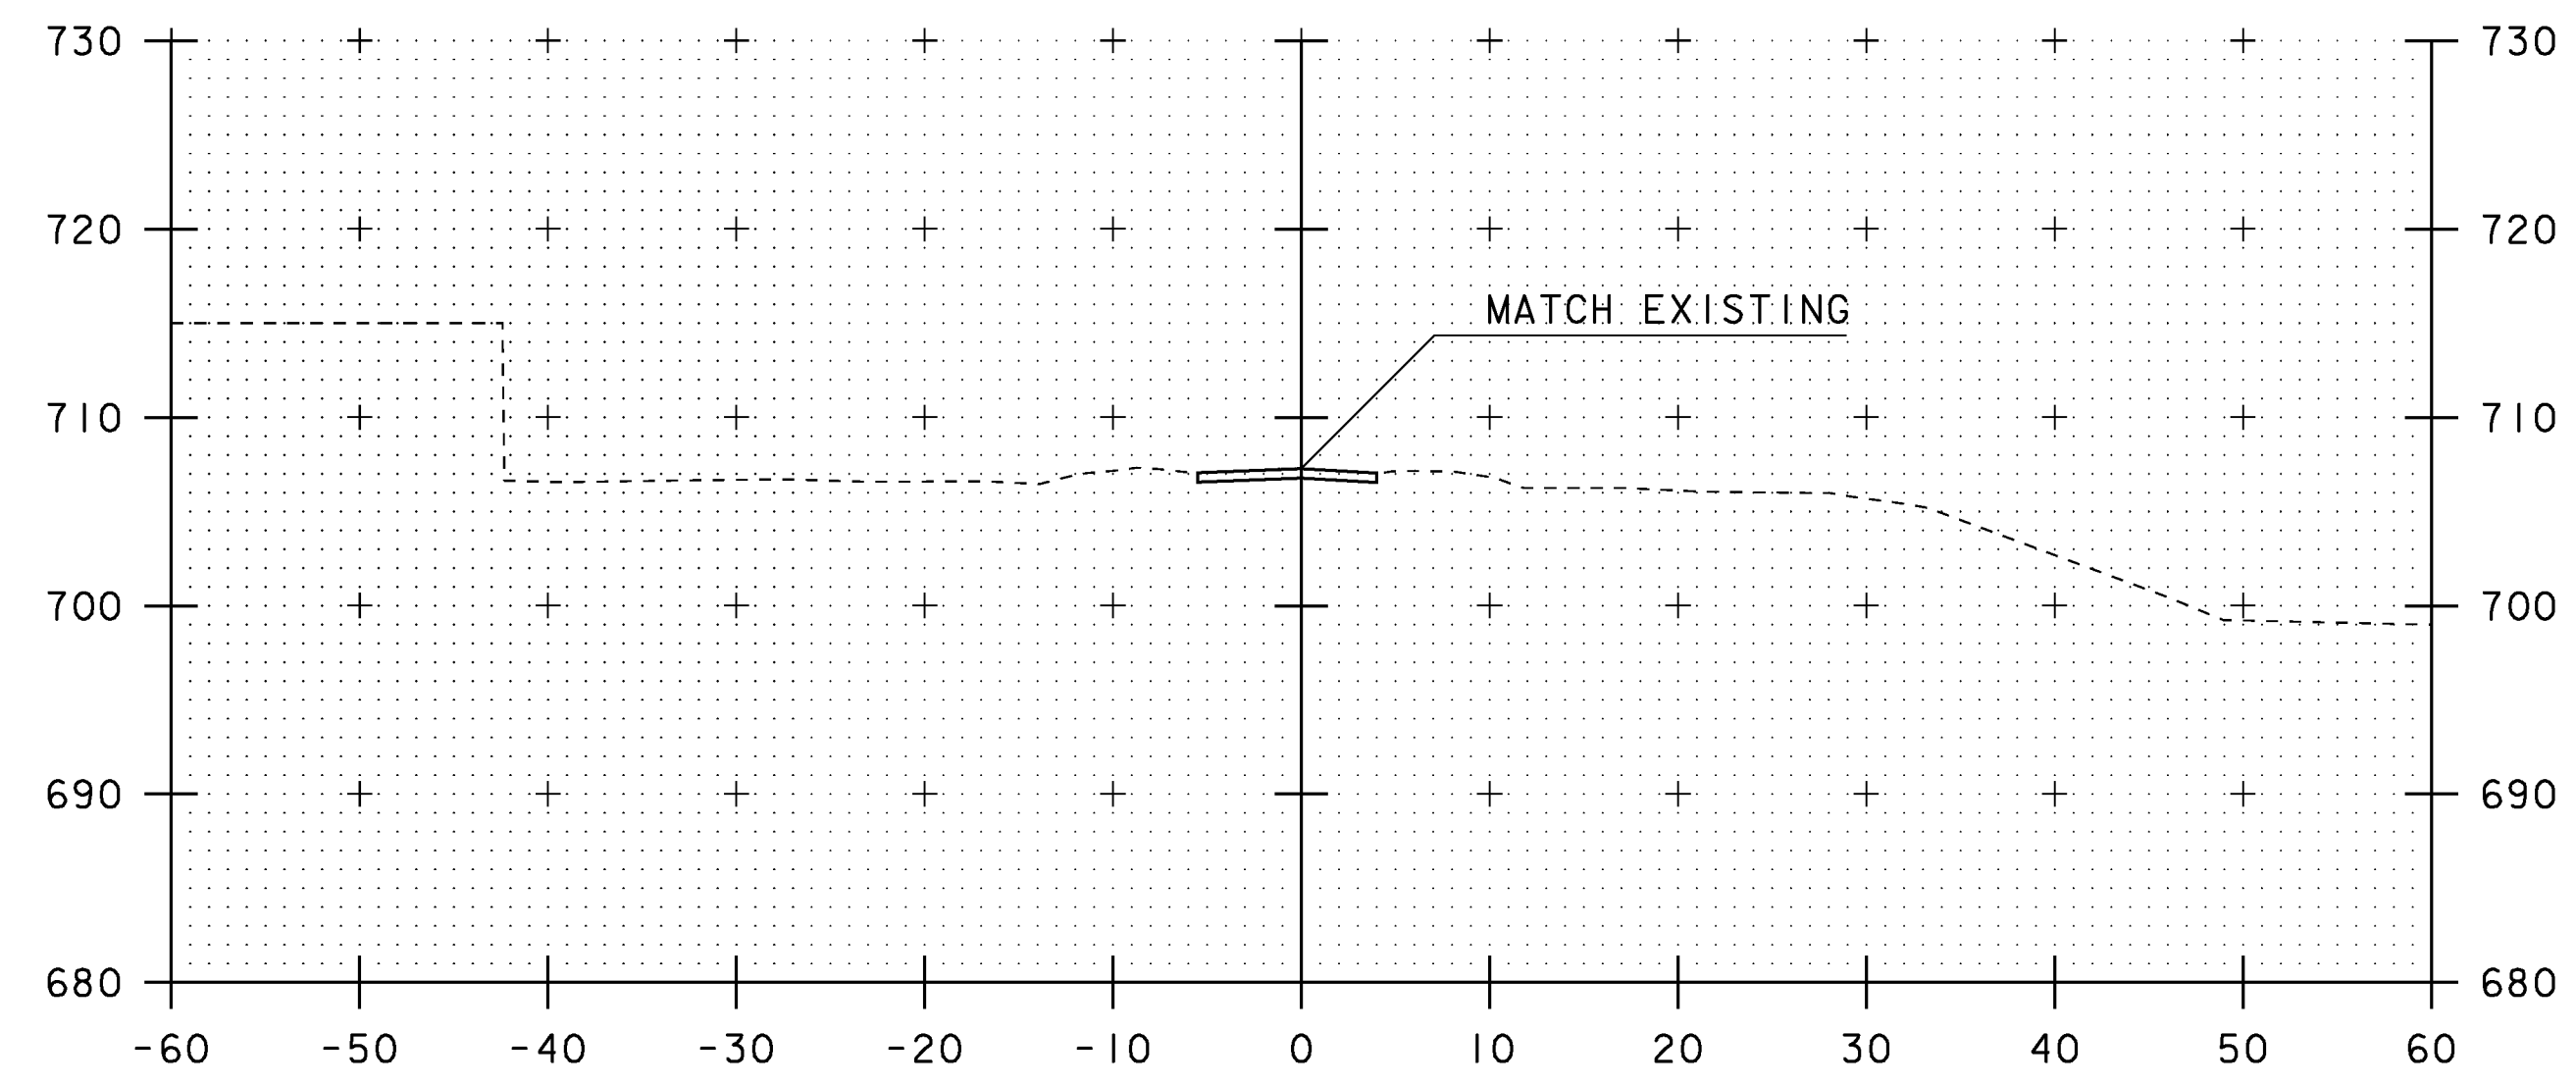

BEGIN APPROACH
10+50

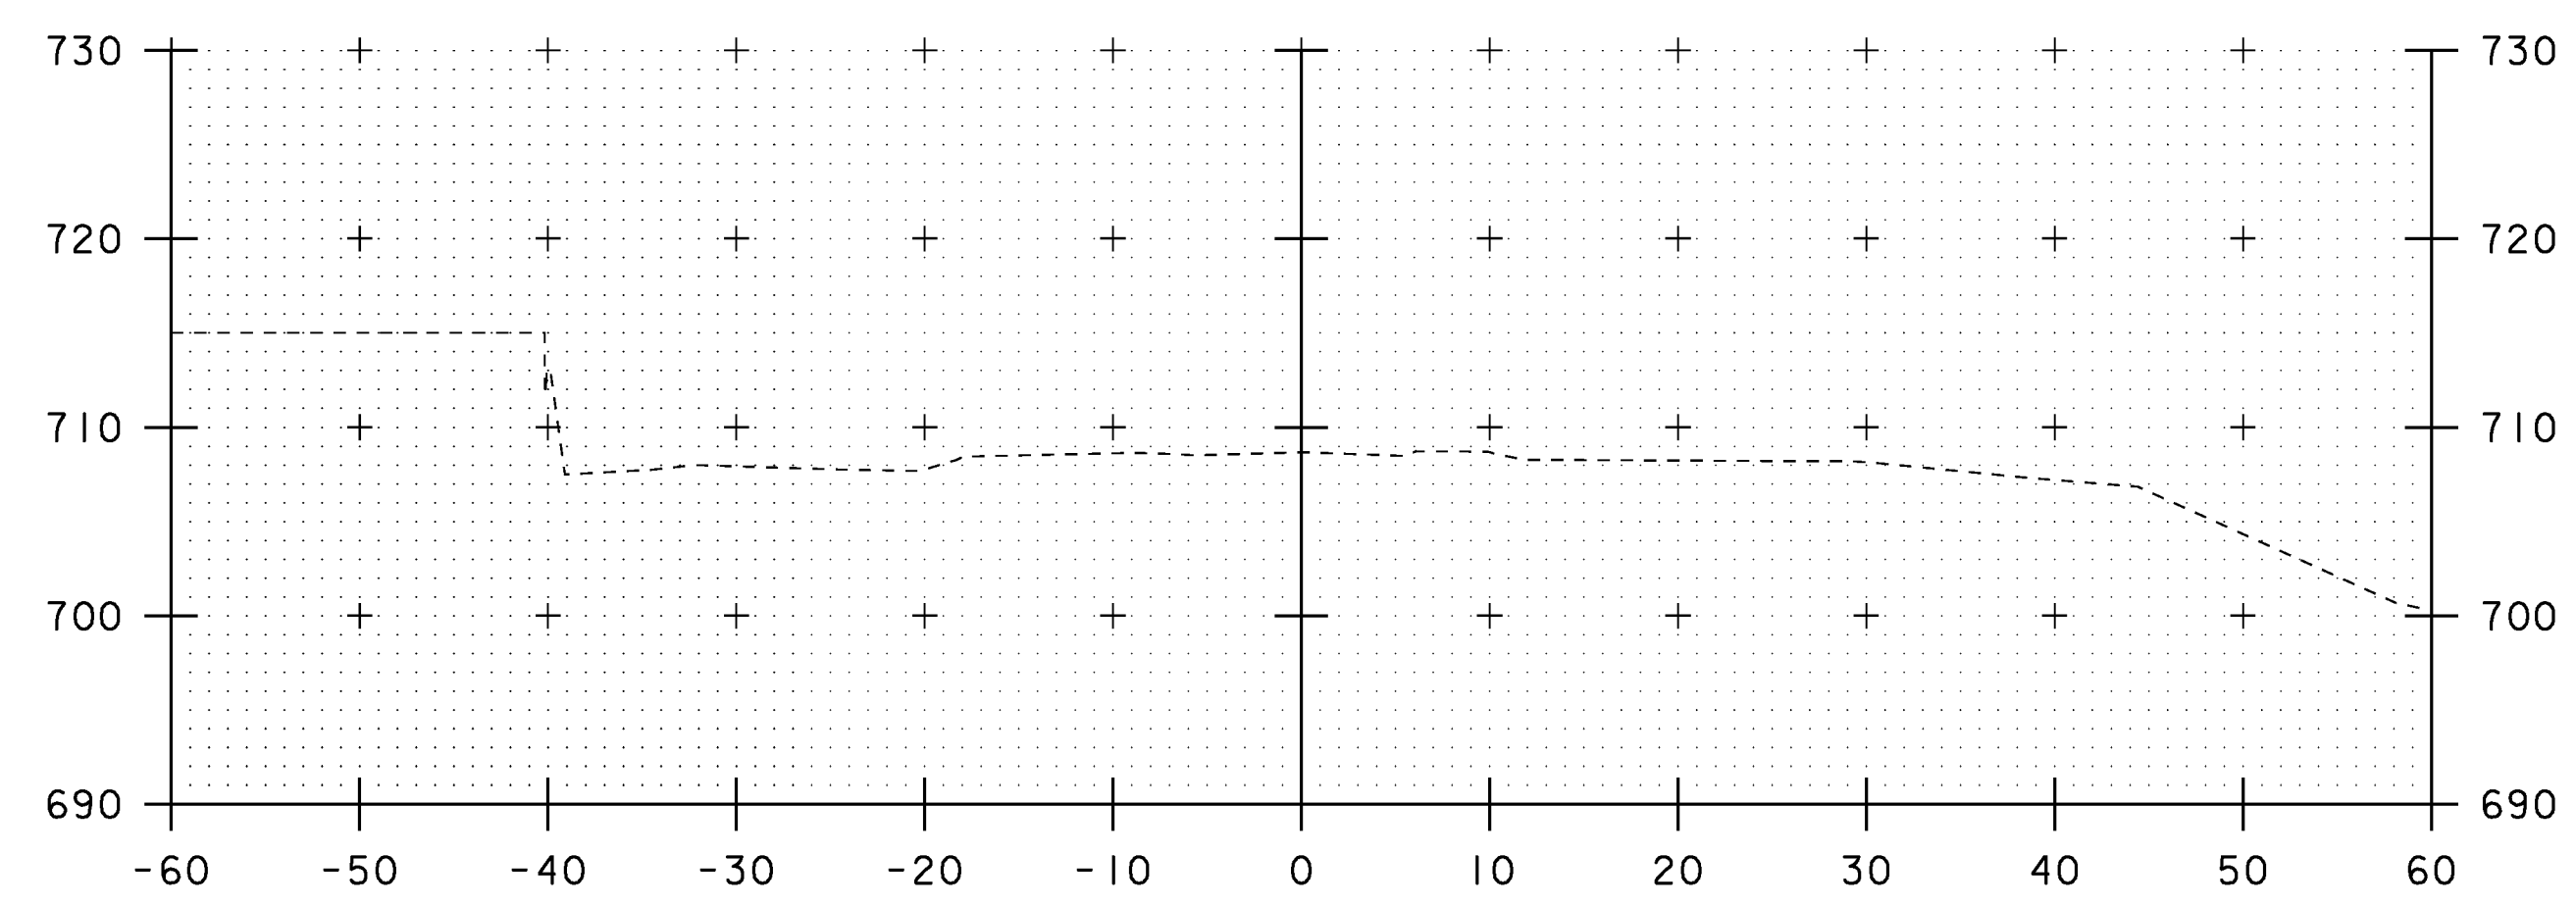


10+25


SCALE 1" = 10'-0"
10 0 10

STA. 10+25 TO STA. 11+20


PROJECT NAME: BRAINTREE	PLOT DATE: 31-DEC-2009
PROJECT NUMBER: BRO 1444(36)	DRAWN BY: T. FILLBACH
FILE NAME: s95j292xsl.dgn	CHECKED BY: R. PELLETT
PROJECT LEADER: K. HIGGINS	SHEET 23 OF 26
DESIGNED BY: T. FILLBACH	
MAINLINE SECTIONS	

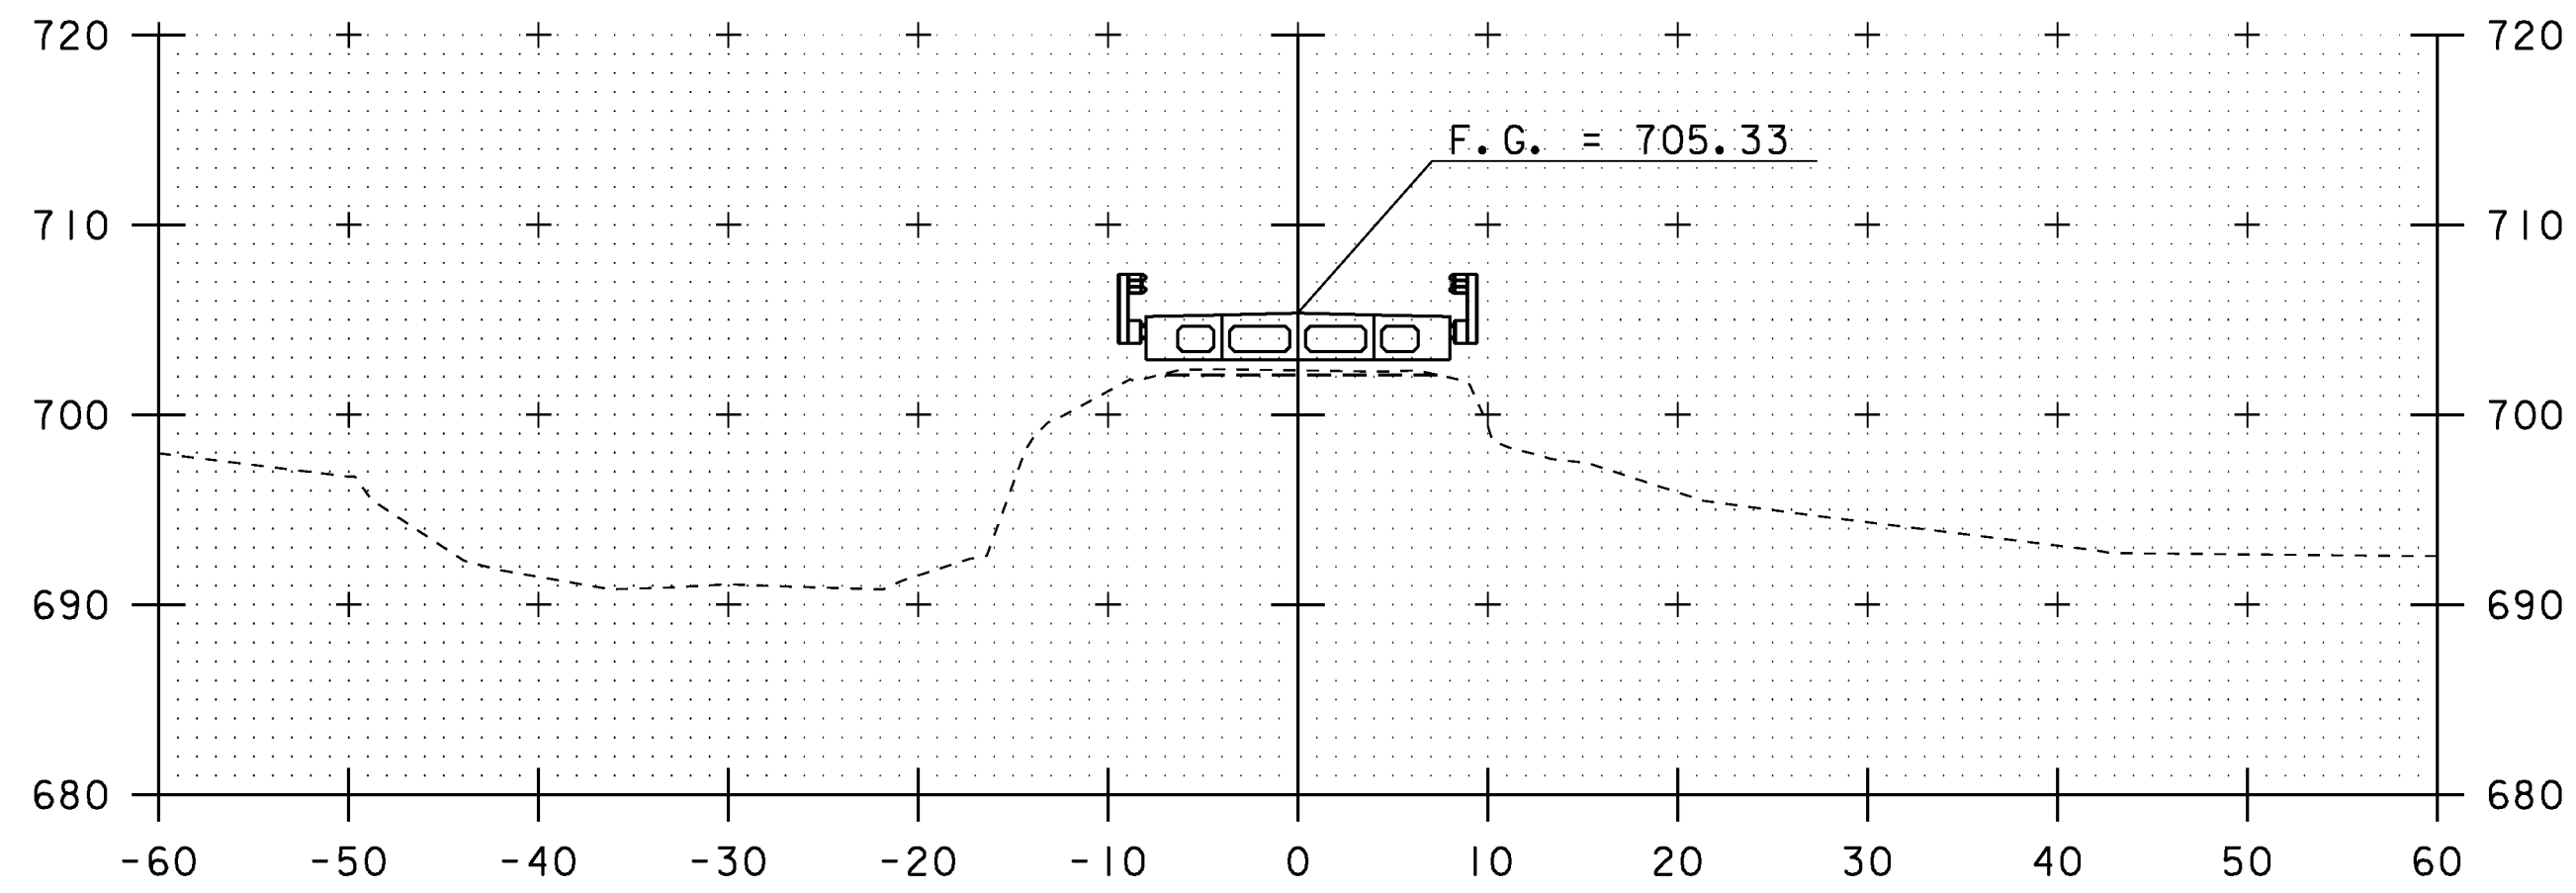


11+75

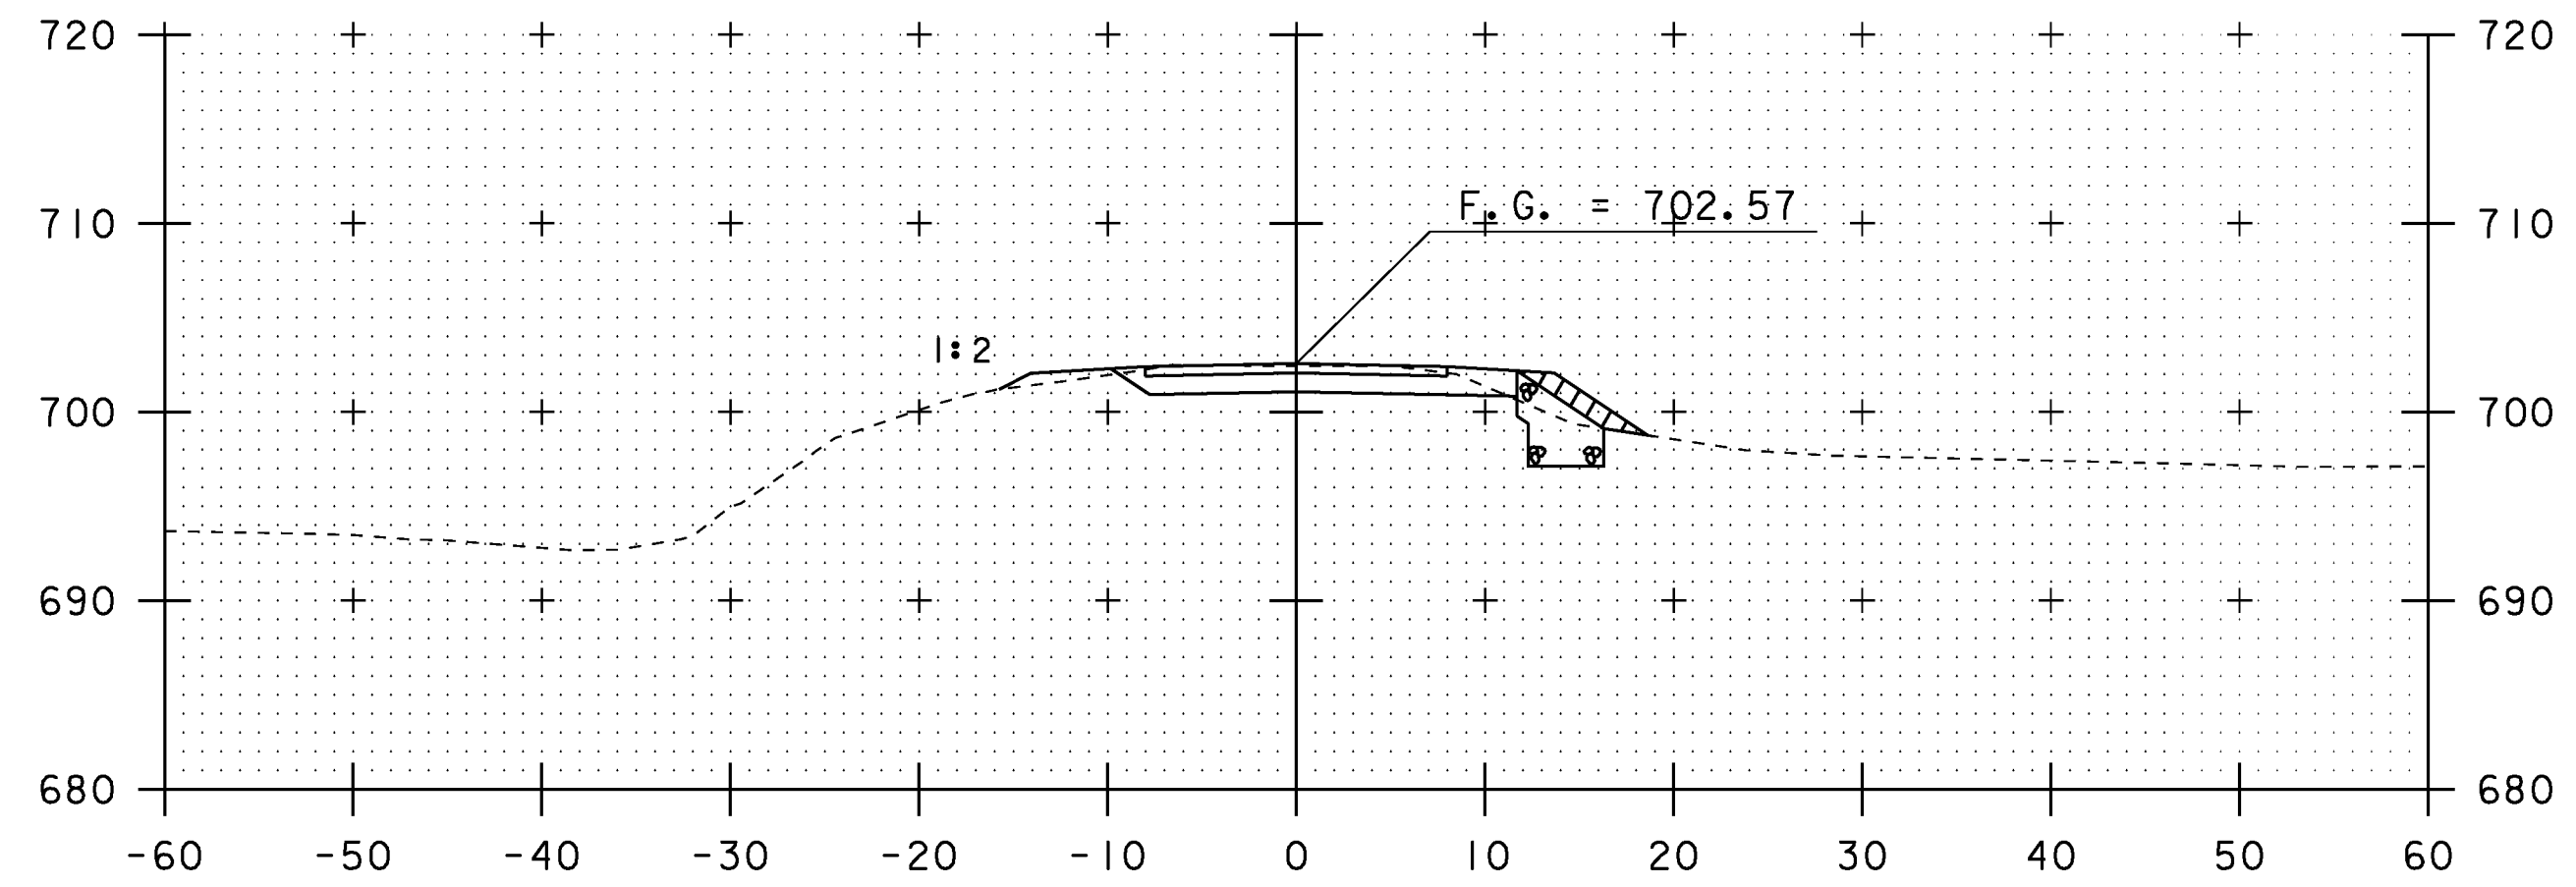


END PROJECT
12+25

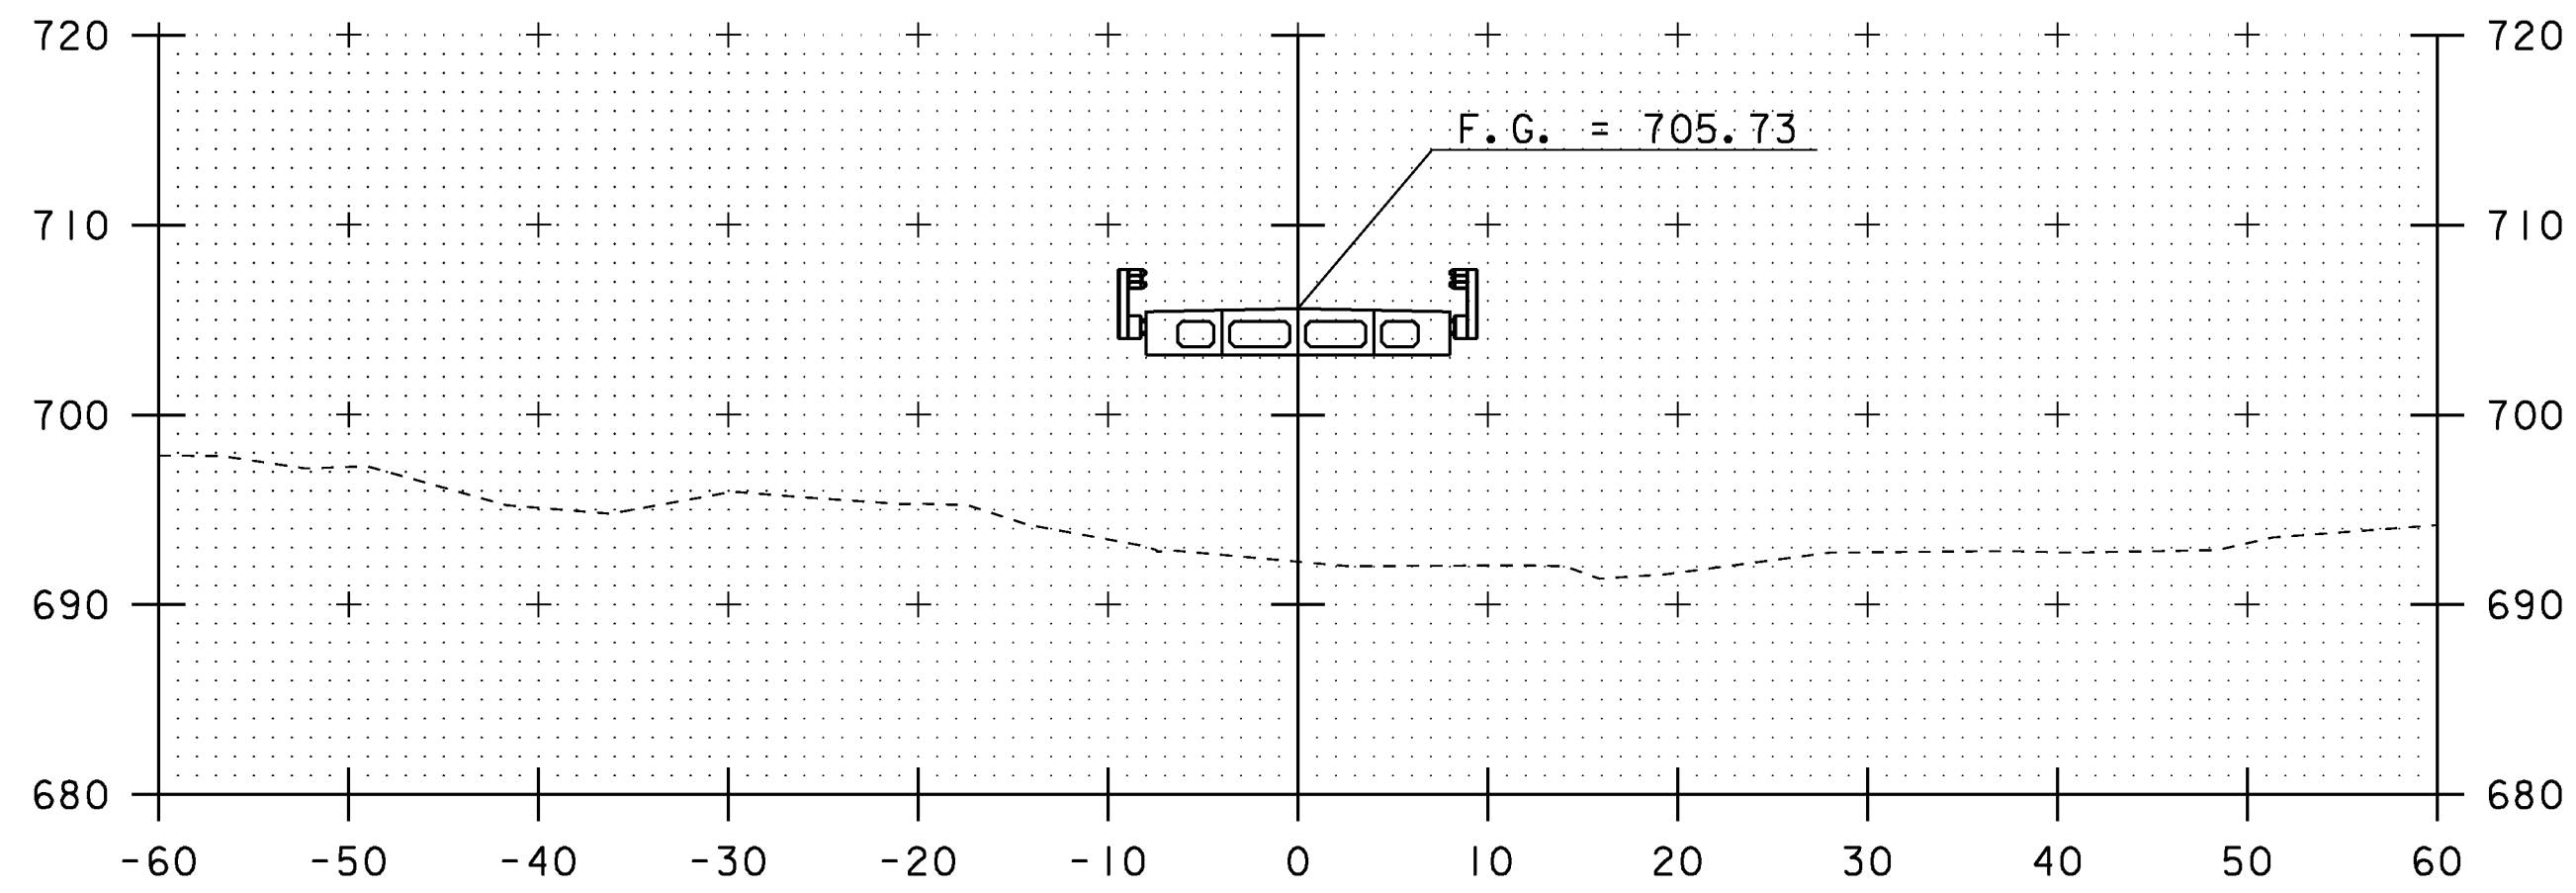


11+50

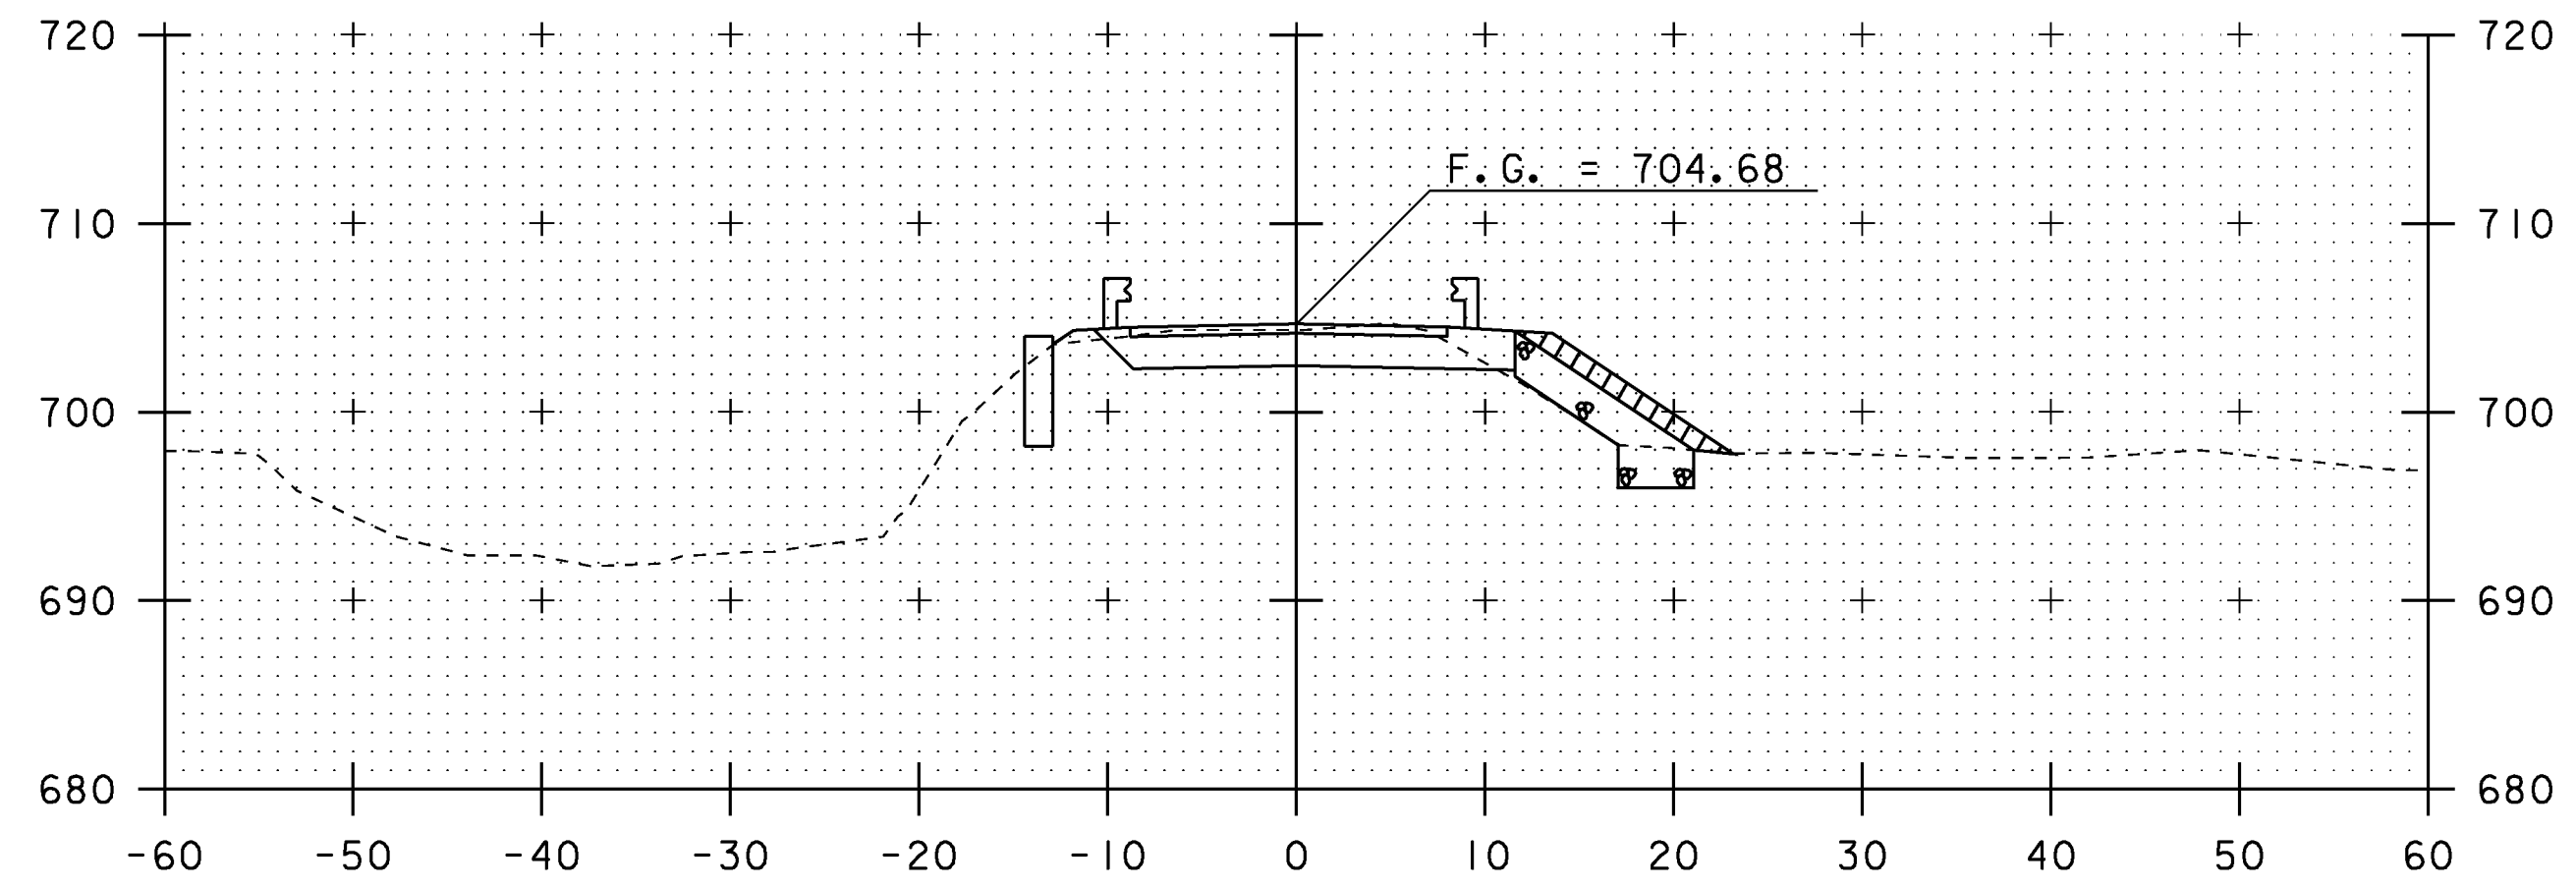

12+00

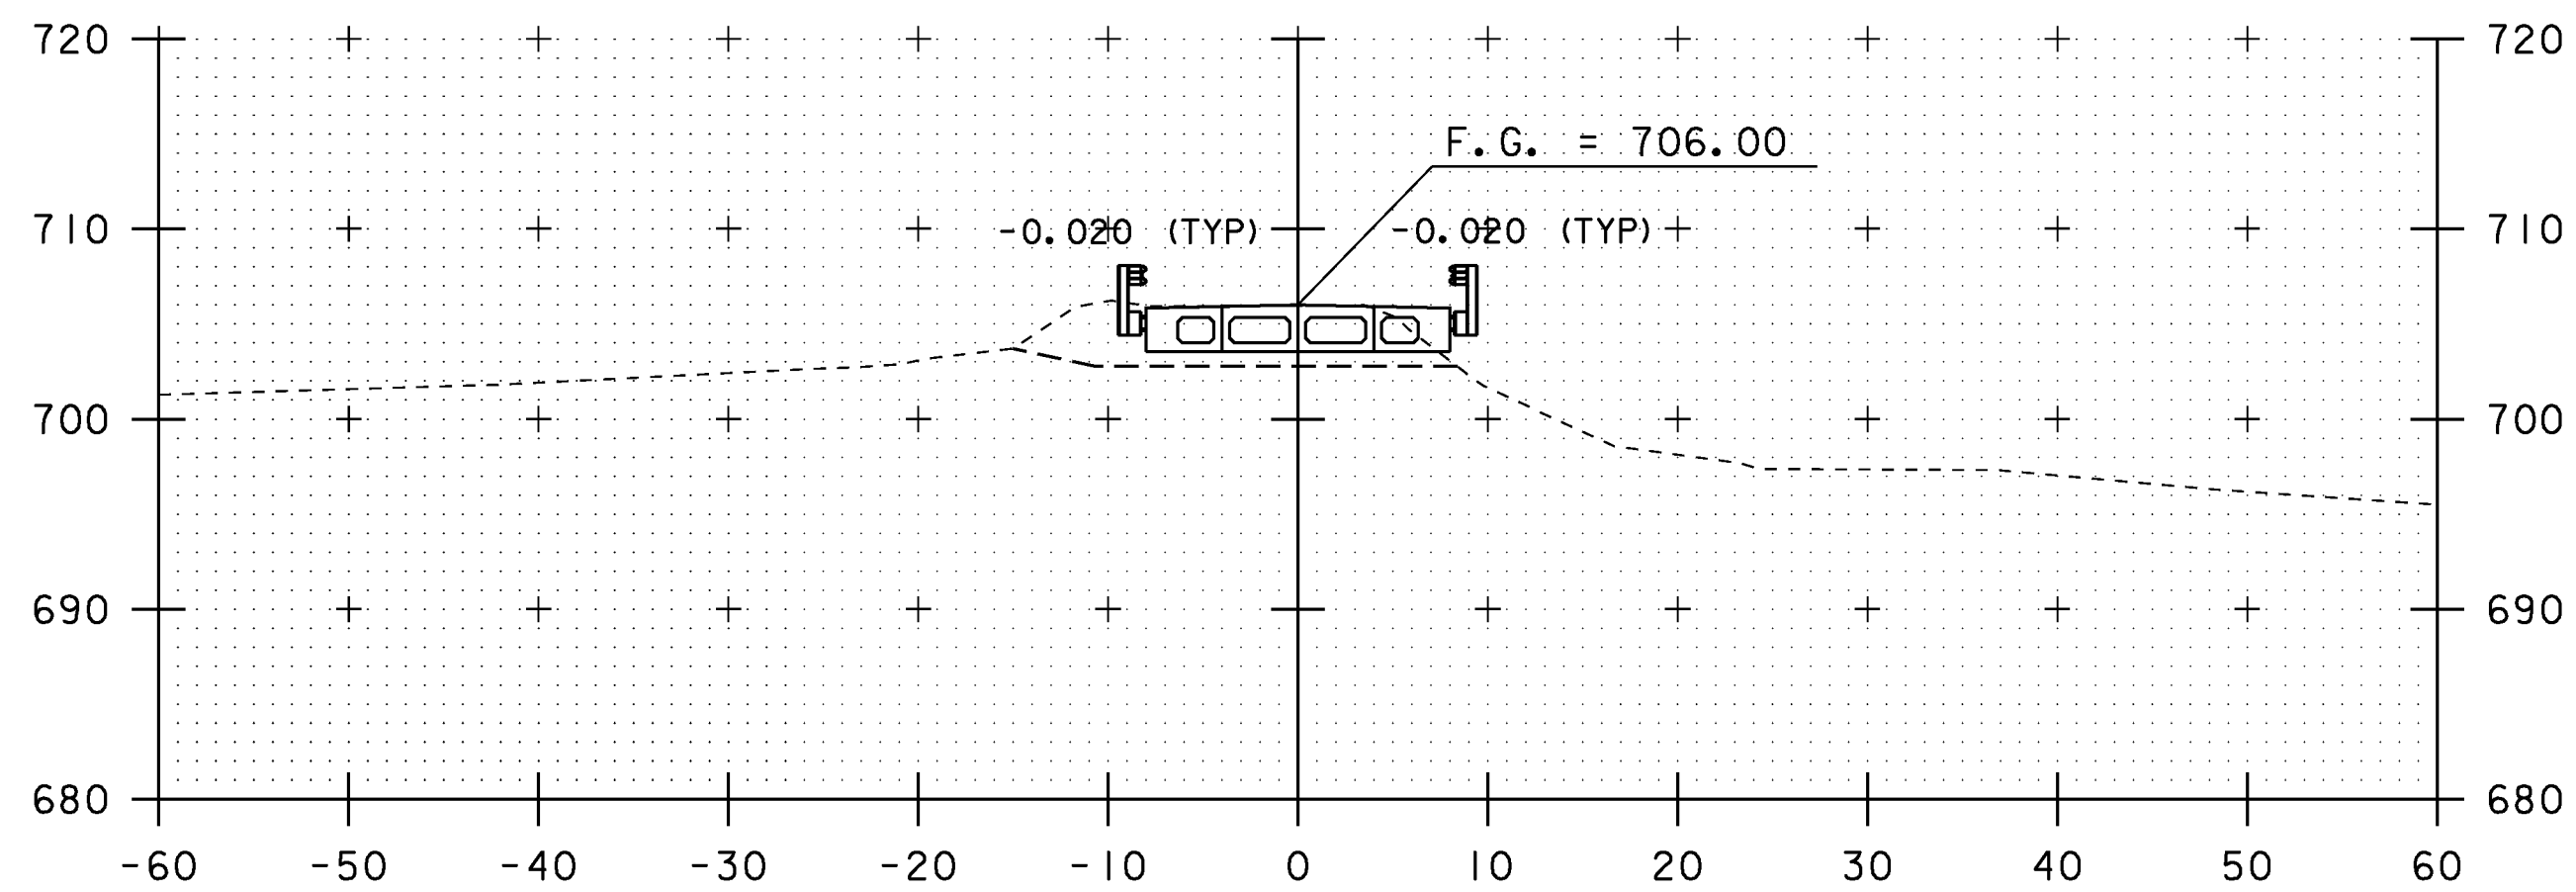

11+25

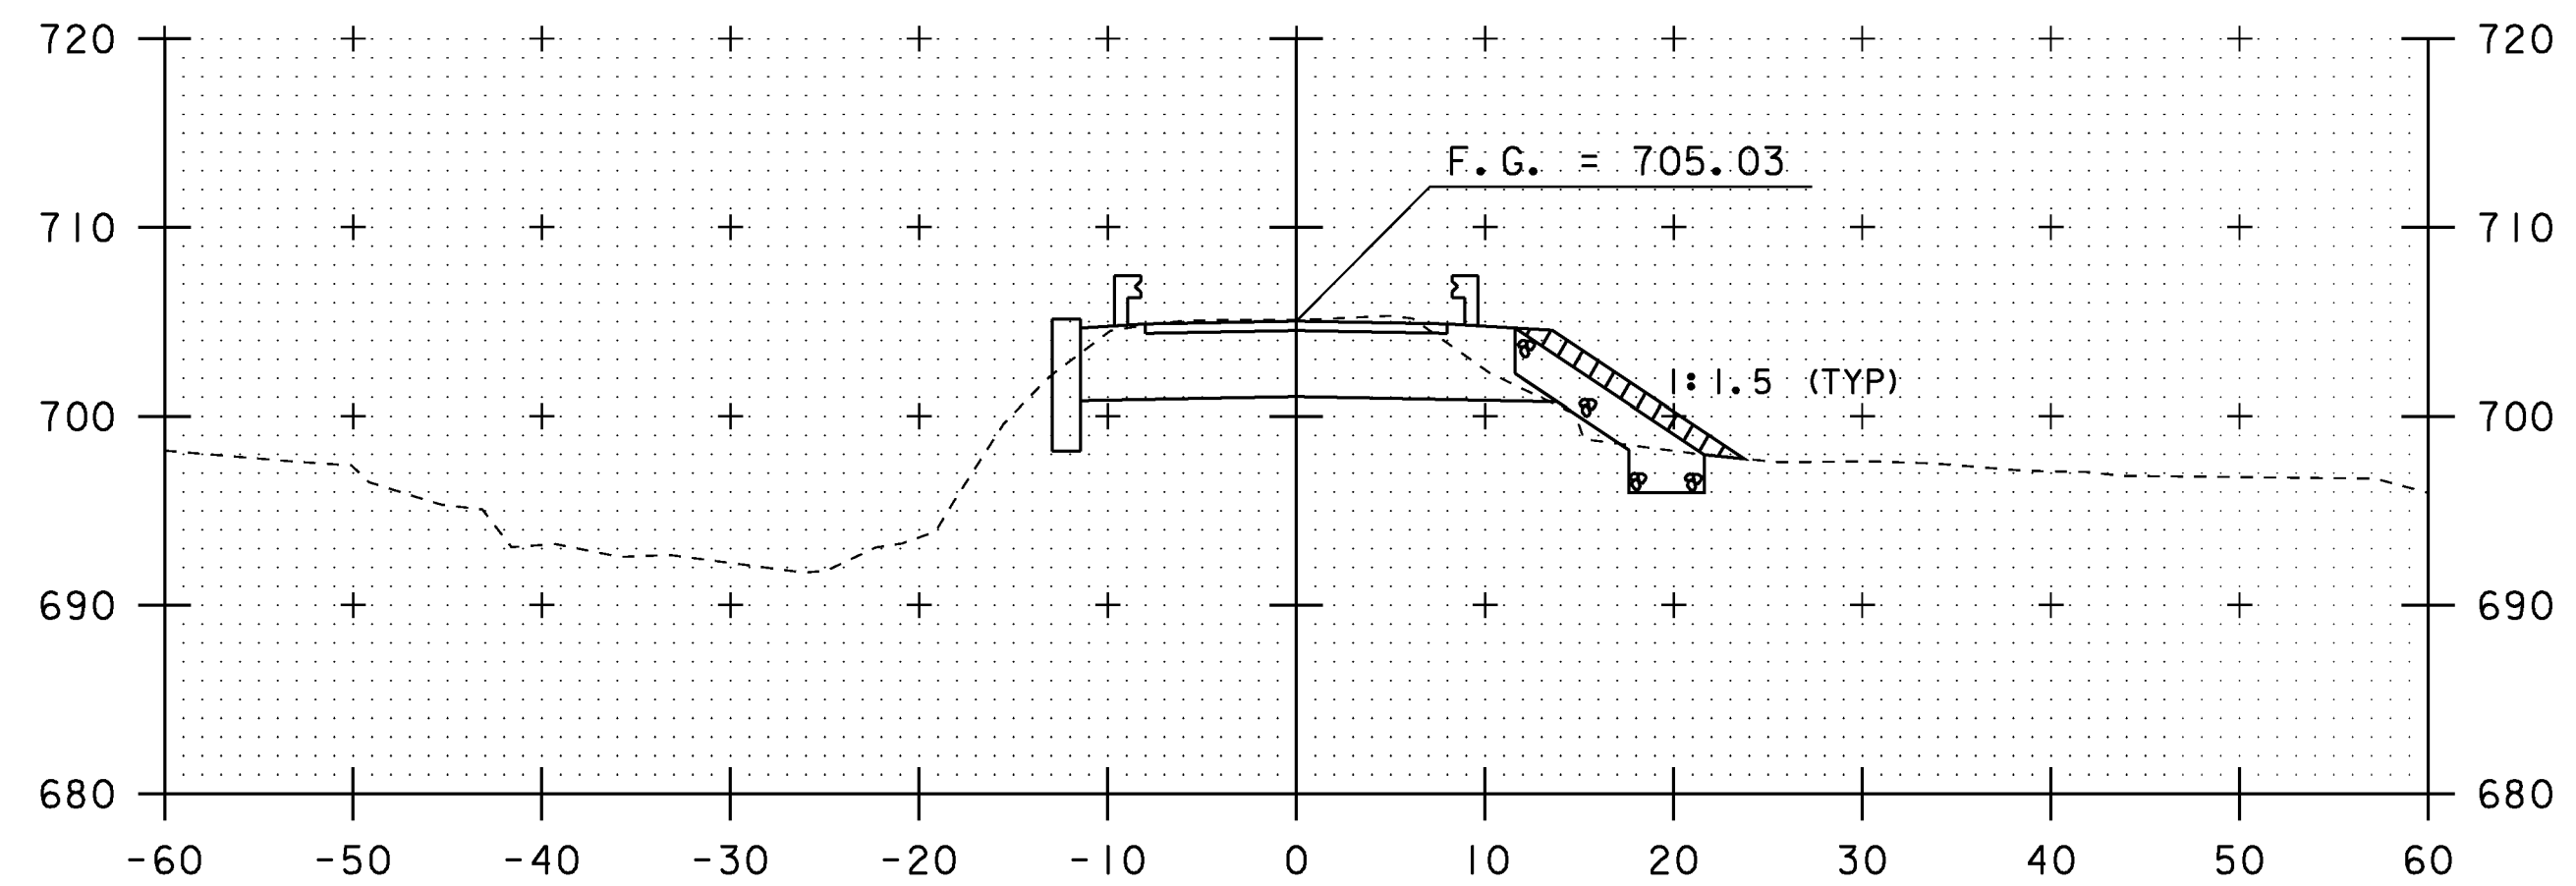

END BRIDGE
11+90


SCALE 1" = 10'-0"
10 0 10

STA. 11+25 TO STA. 12+25


PROJECT NAME: BRAINTREE
PROJECT NUMBER: BRO 1444(36)

FILE NAME: s95j292xsl.dgn
PROJECT LEADER: K. HIGGINS
DESIGNED BY: T. FILLBACH
MAINLINE SECTIONS


PLOT DATE: 31-DEC-2009
DRAWN BY: T. FILLBACH
CHECKED BY: R. PELLETT
SHEET 24 OF 26

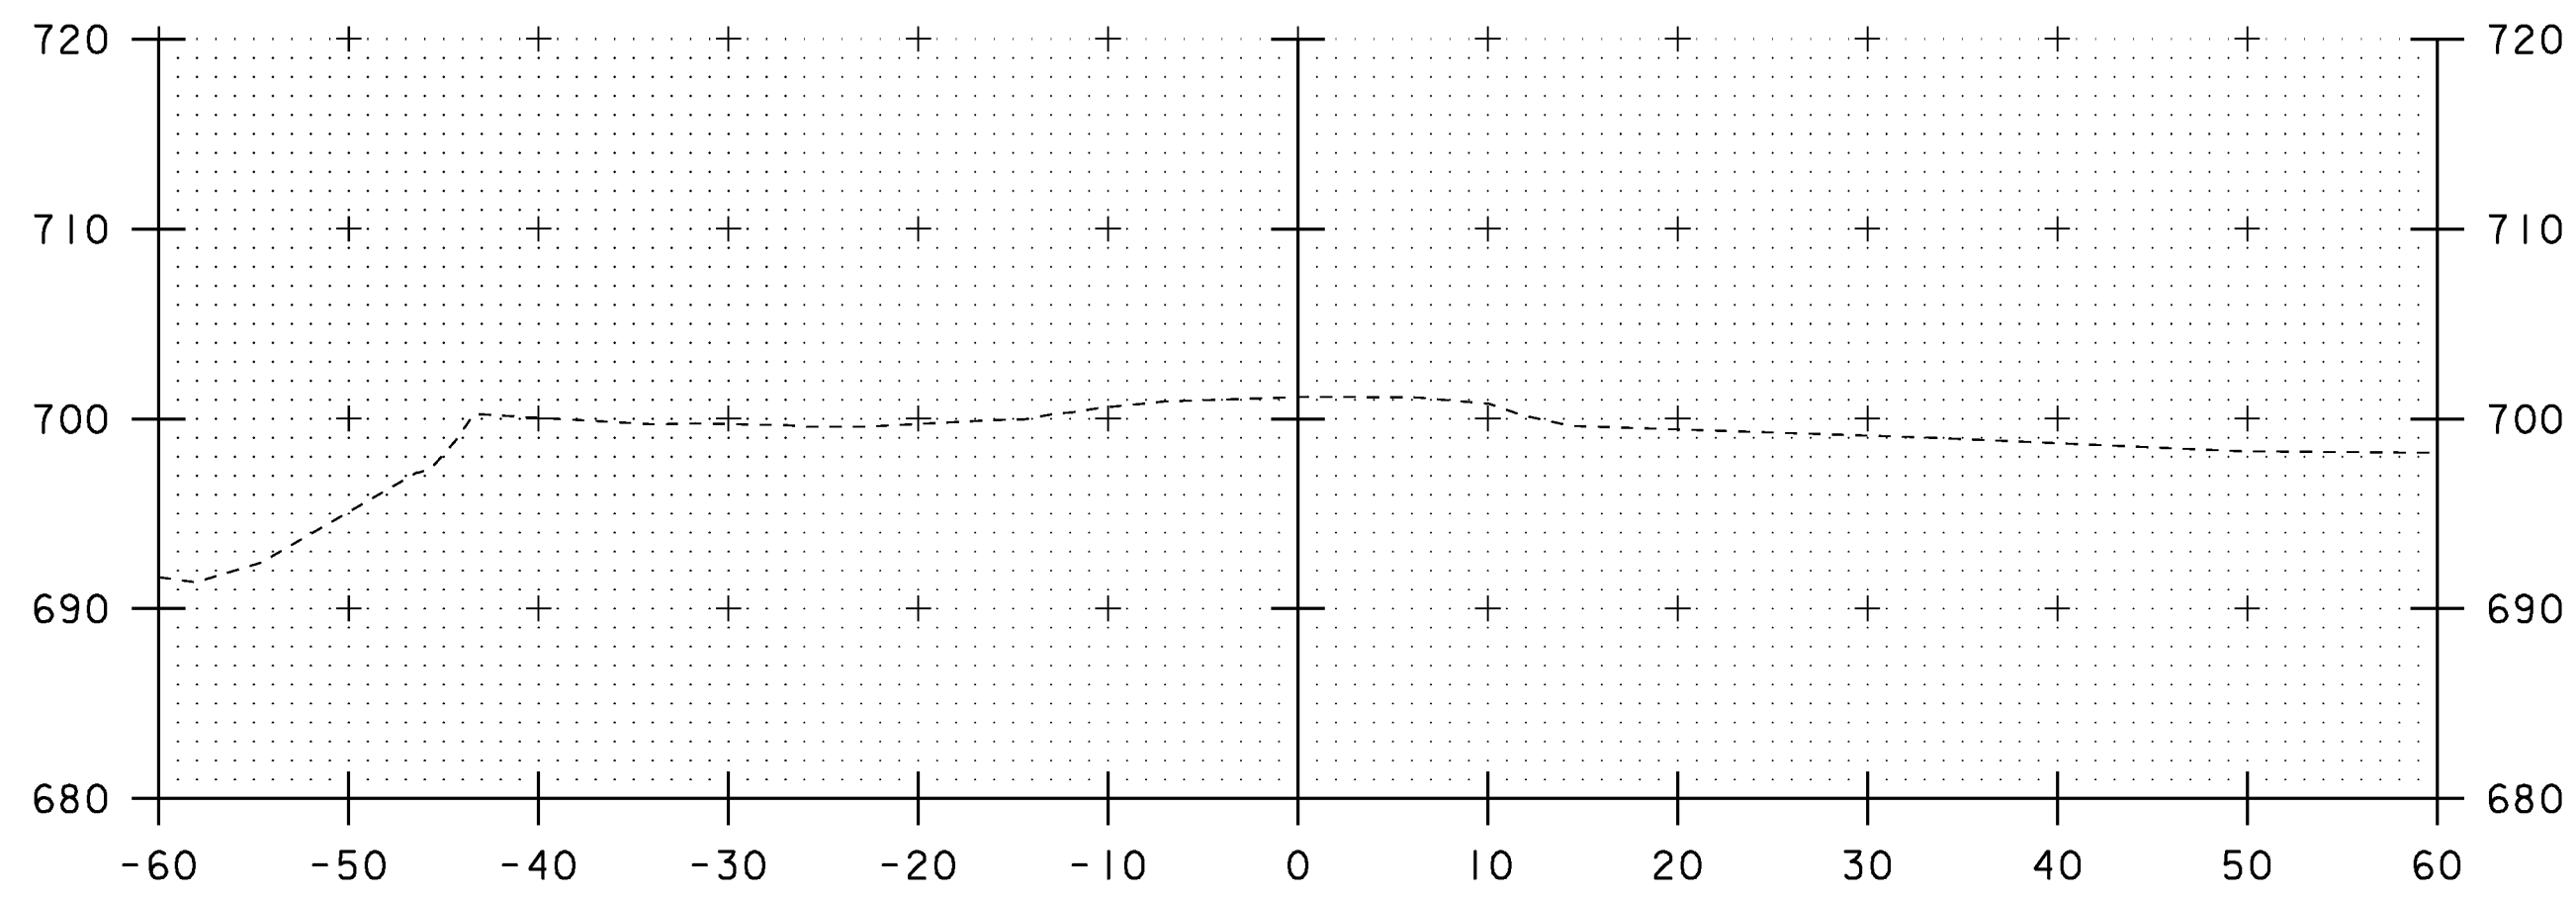

12+75

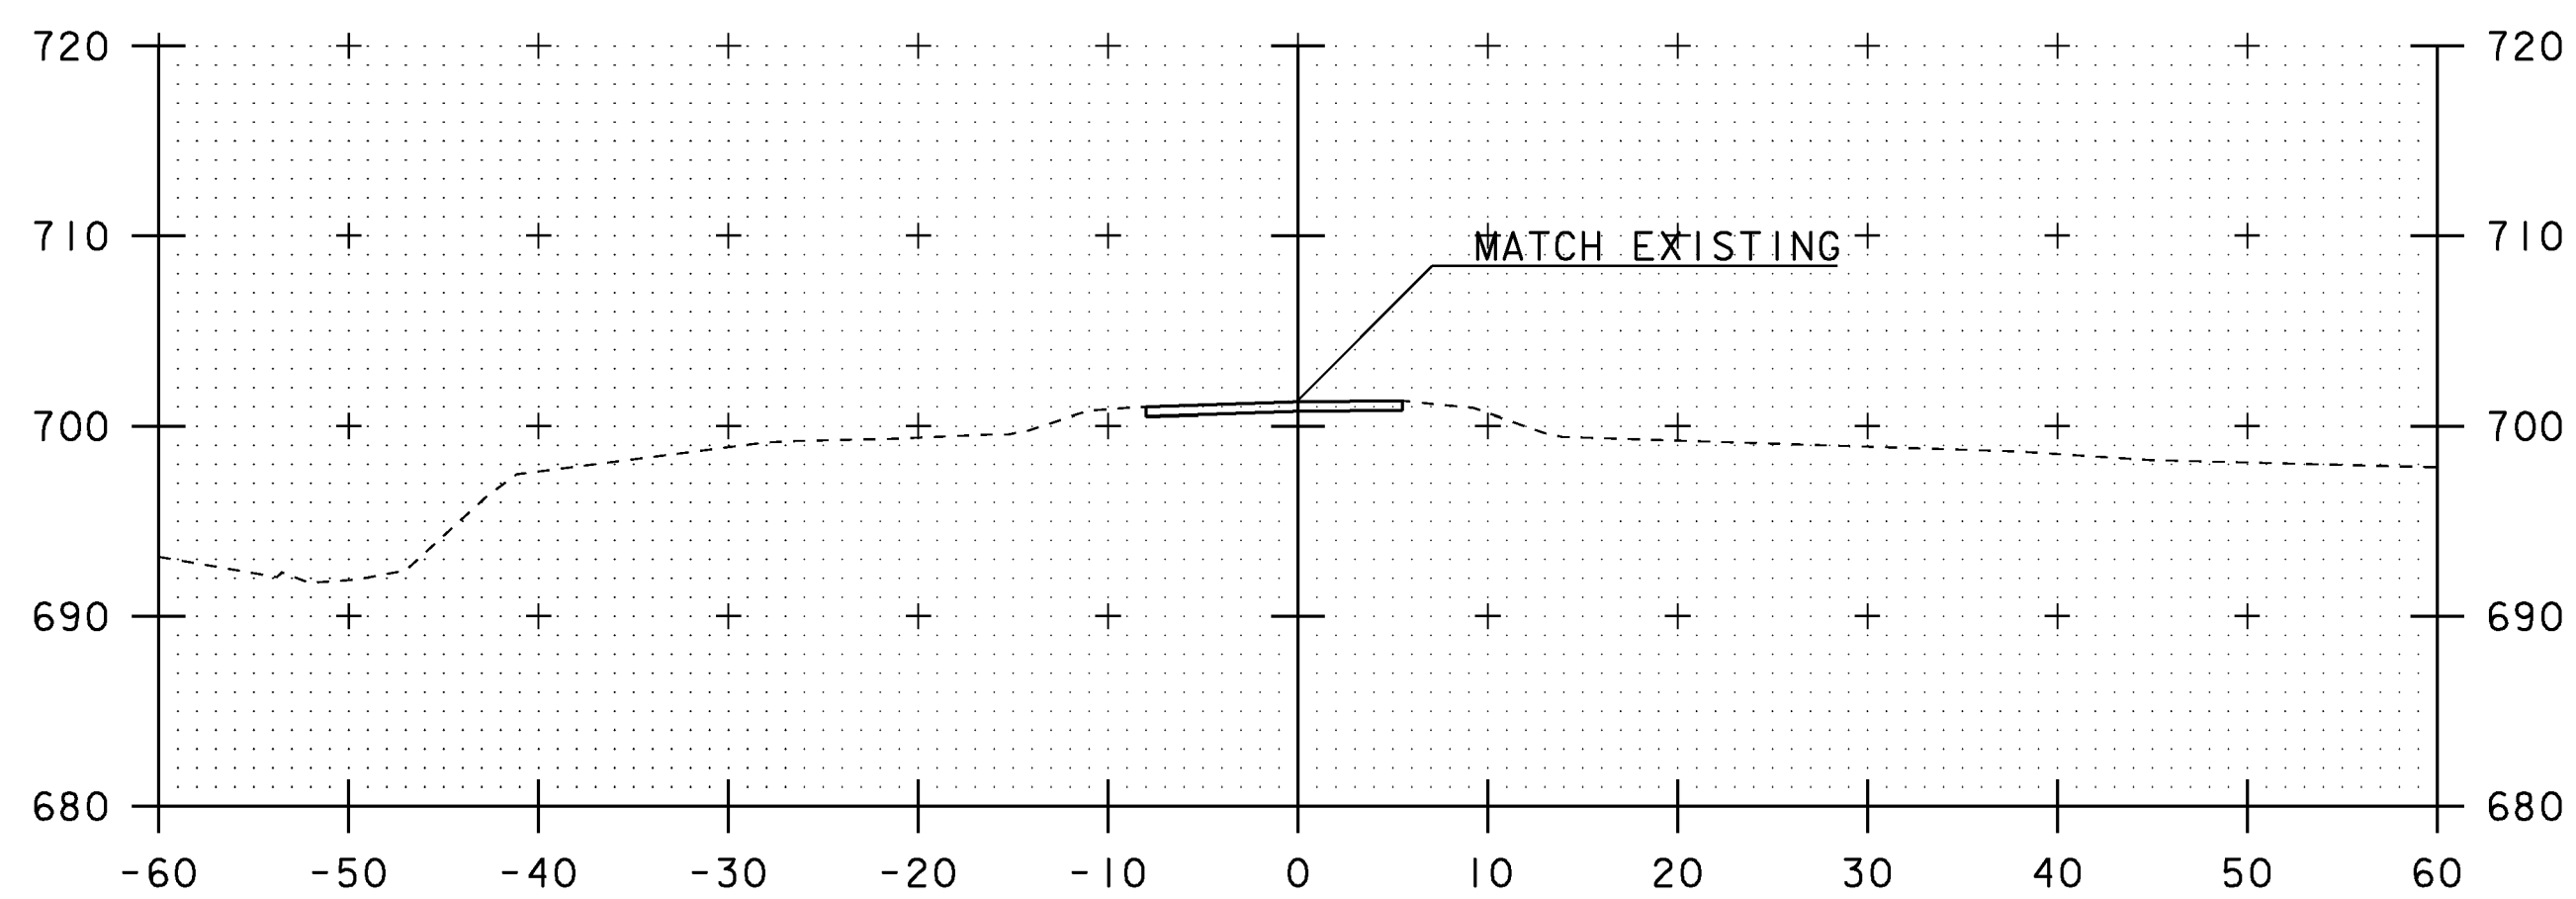

END APPROACH
12+50

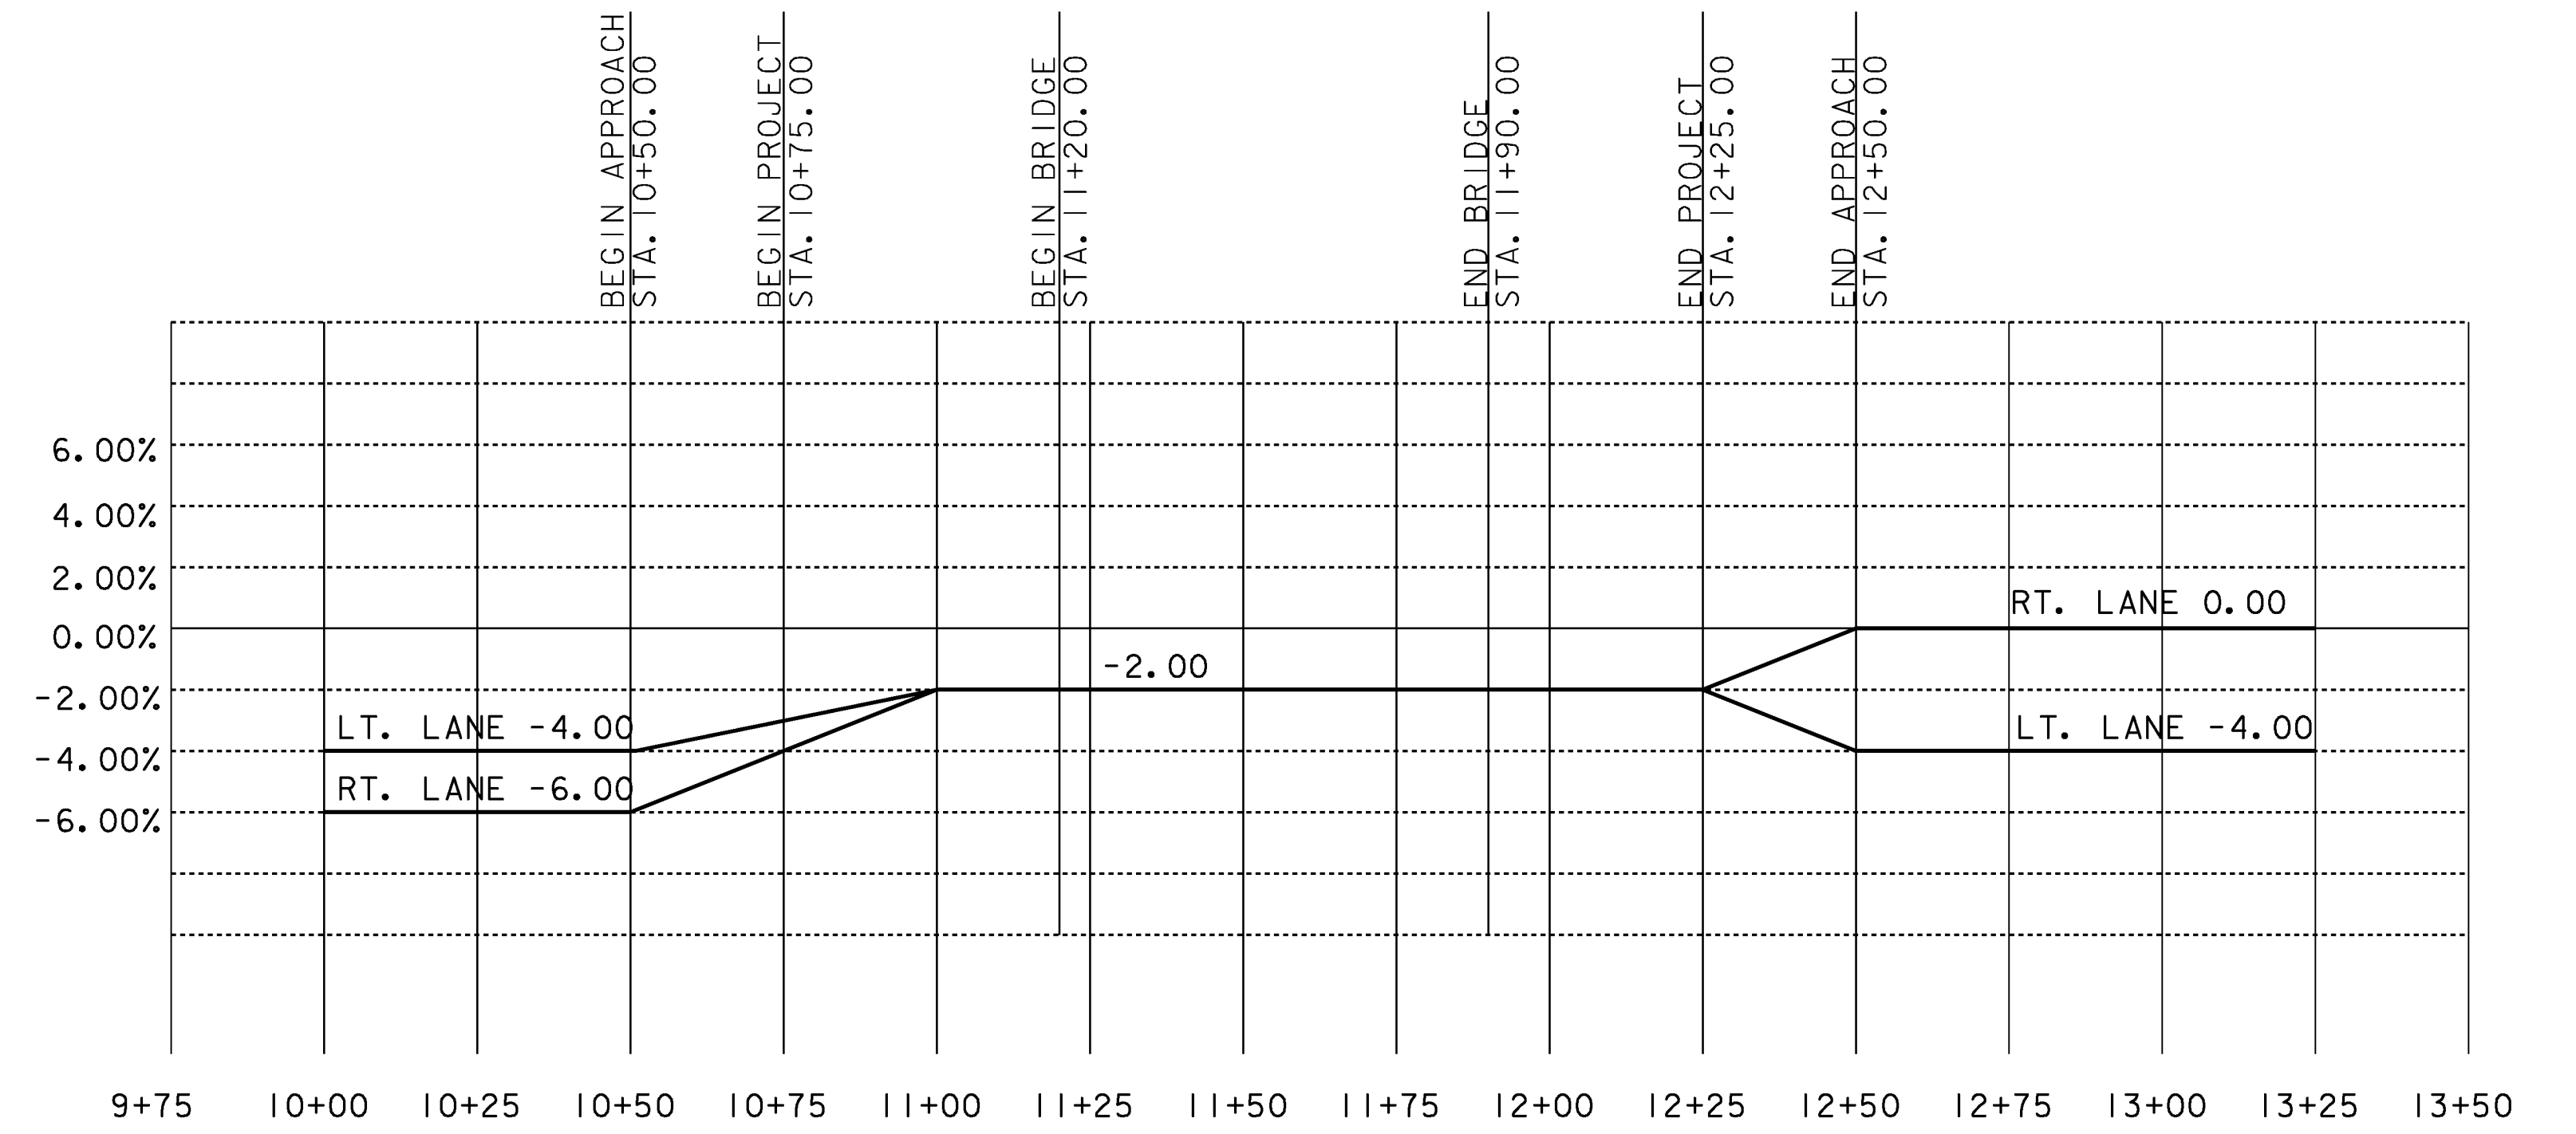


SUPERELEVATION DIAGRAM
NOT TO SCALE


SCALE 1" = 10'-0"
10 0 10

PROJECT NAME: BRAINTREE	PLOT DATE: 31-DEC-2009
PROJECT NUMBER: BRO 1444(36)	DRAWN BY: T. FILLBACH
FILE NAME: s95J292xsl.dgn	CHECKED BY: R. PELLETT
PROJECT LEADER: K. HIGGINS	SHEET 25 OF 26
DESIGNED BY: T. FILLBACH	
MAINLINE SECTIONS	


STA. 12+50 TO STA. 12+75

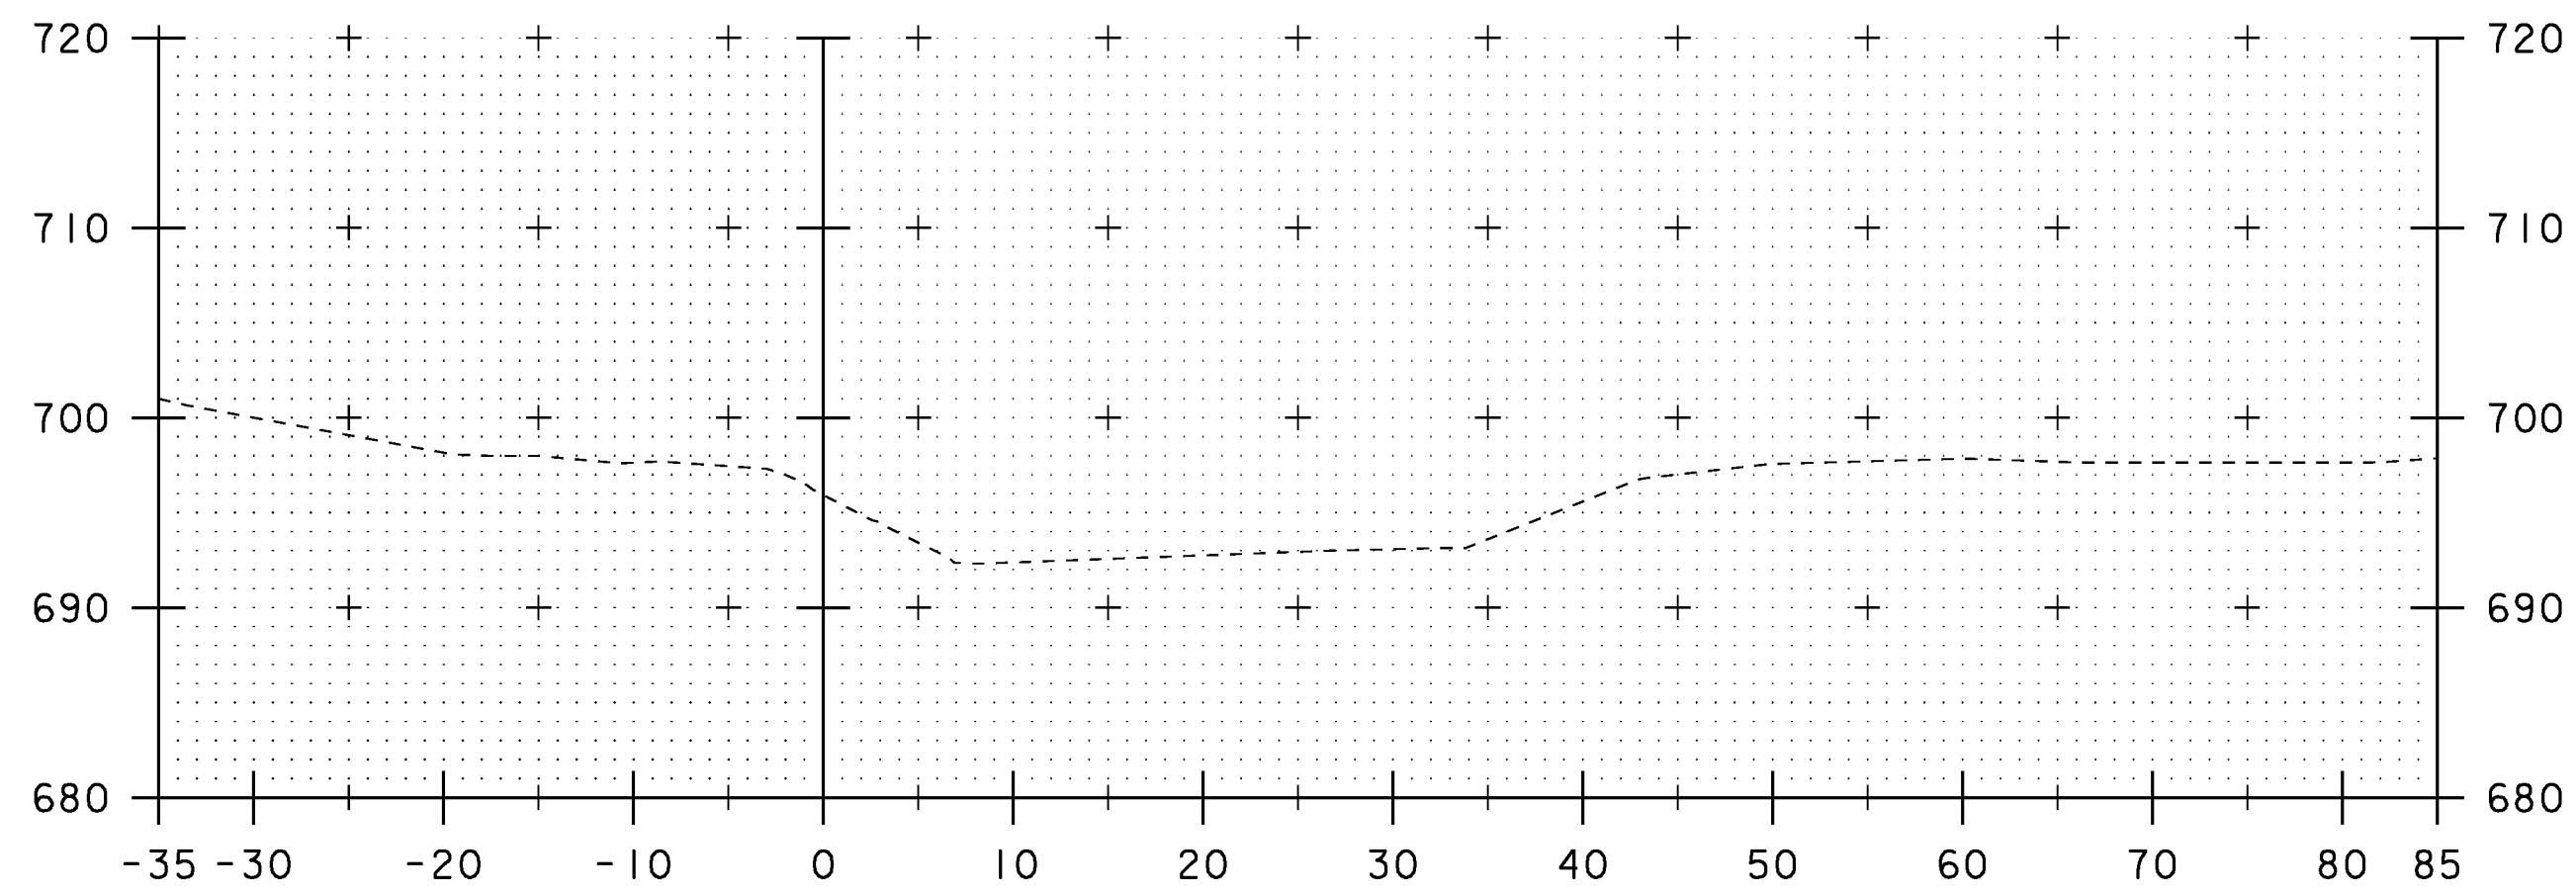


20+50

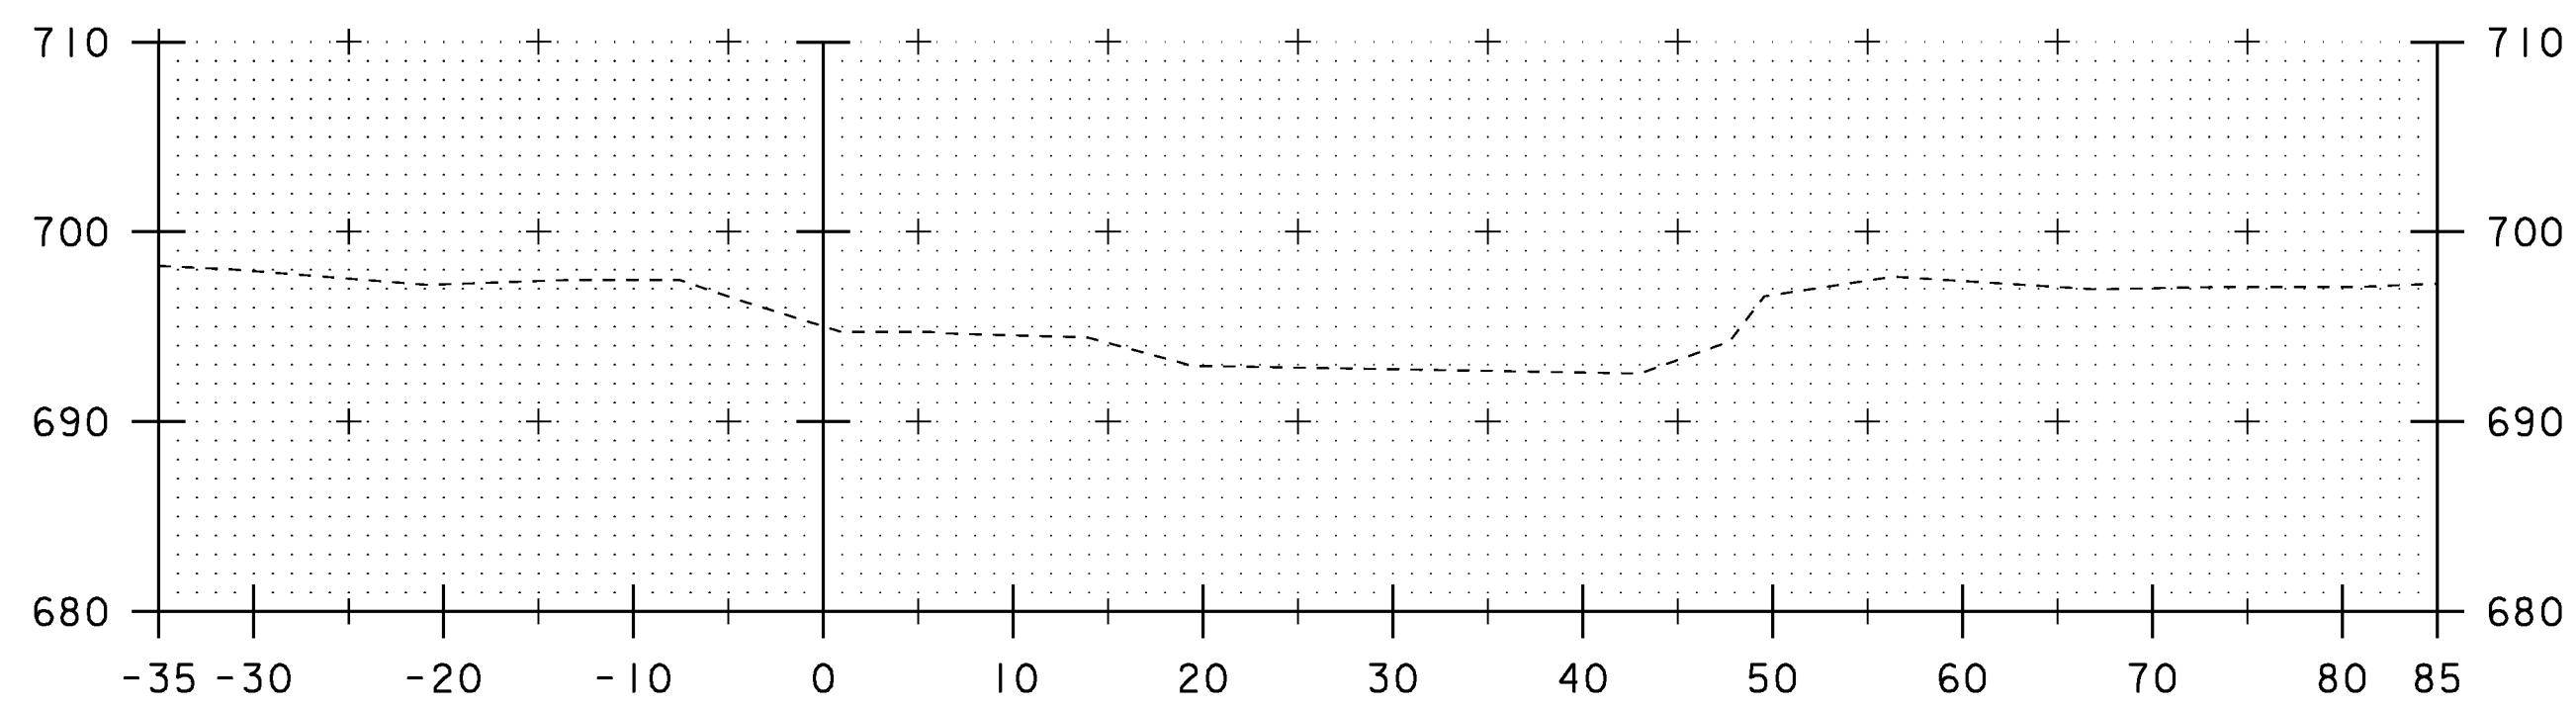


20+25

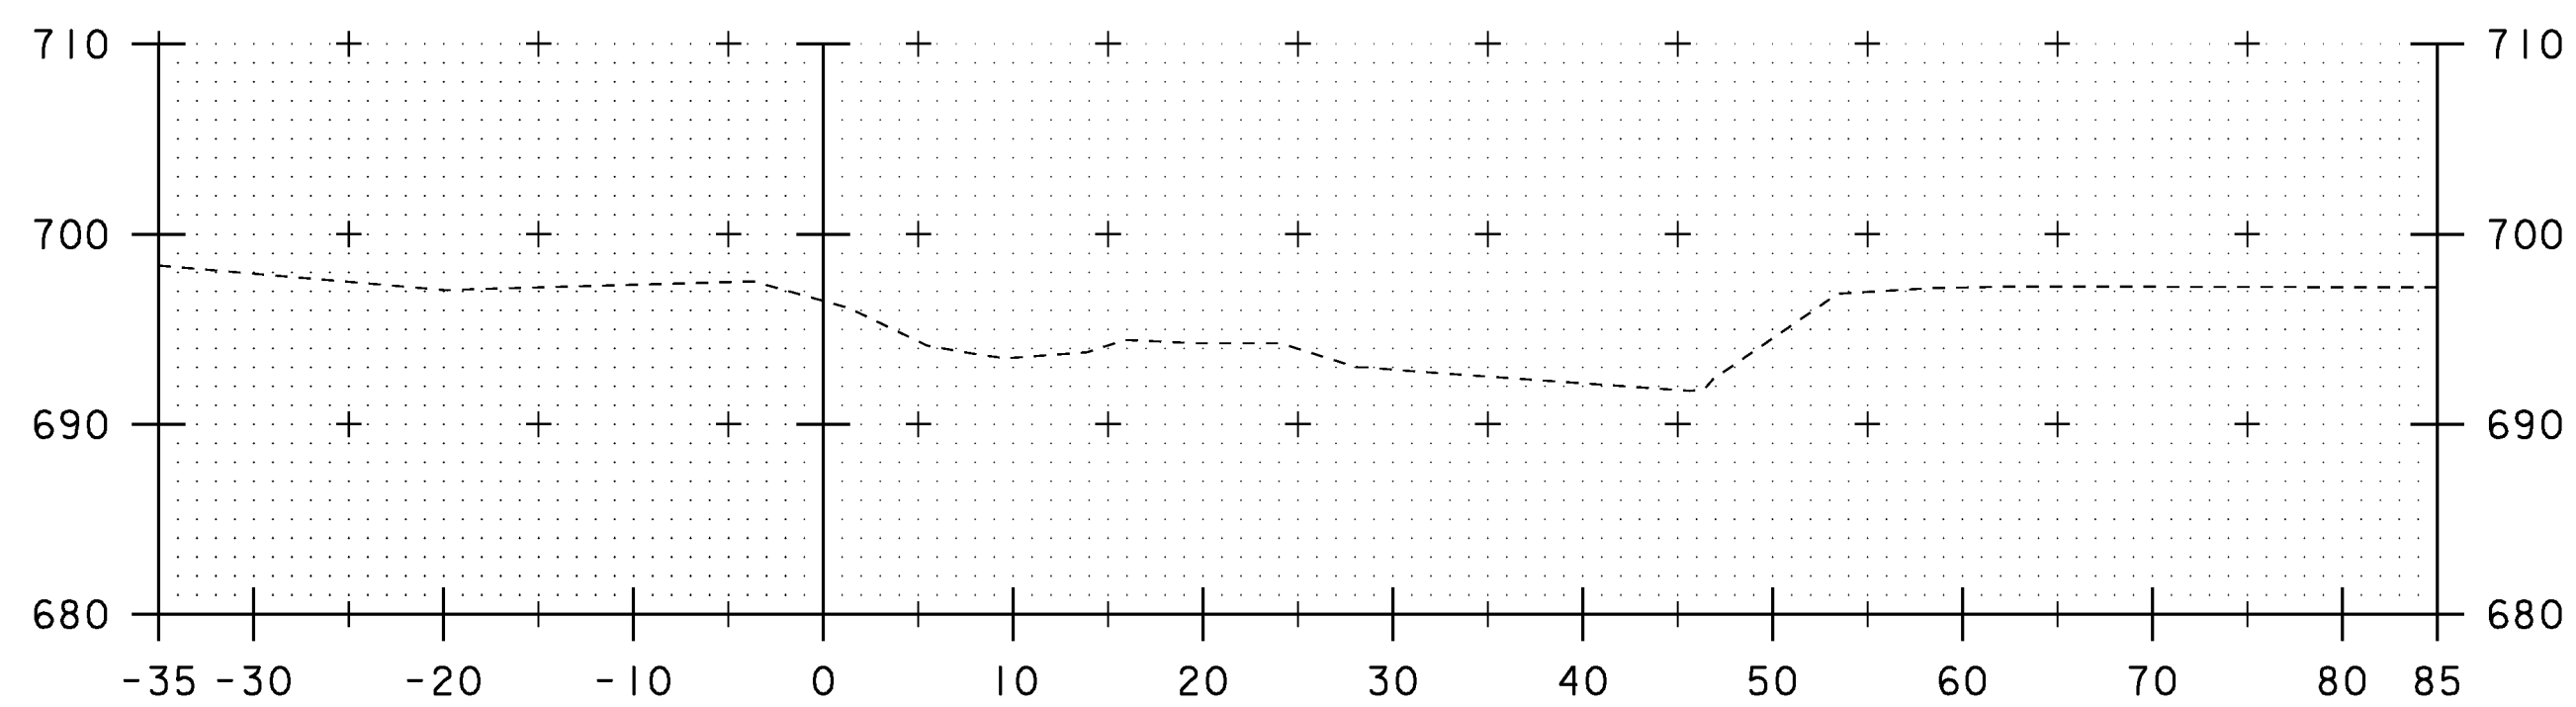


20+00

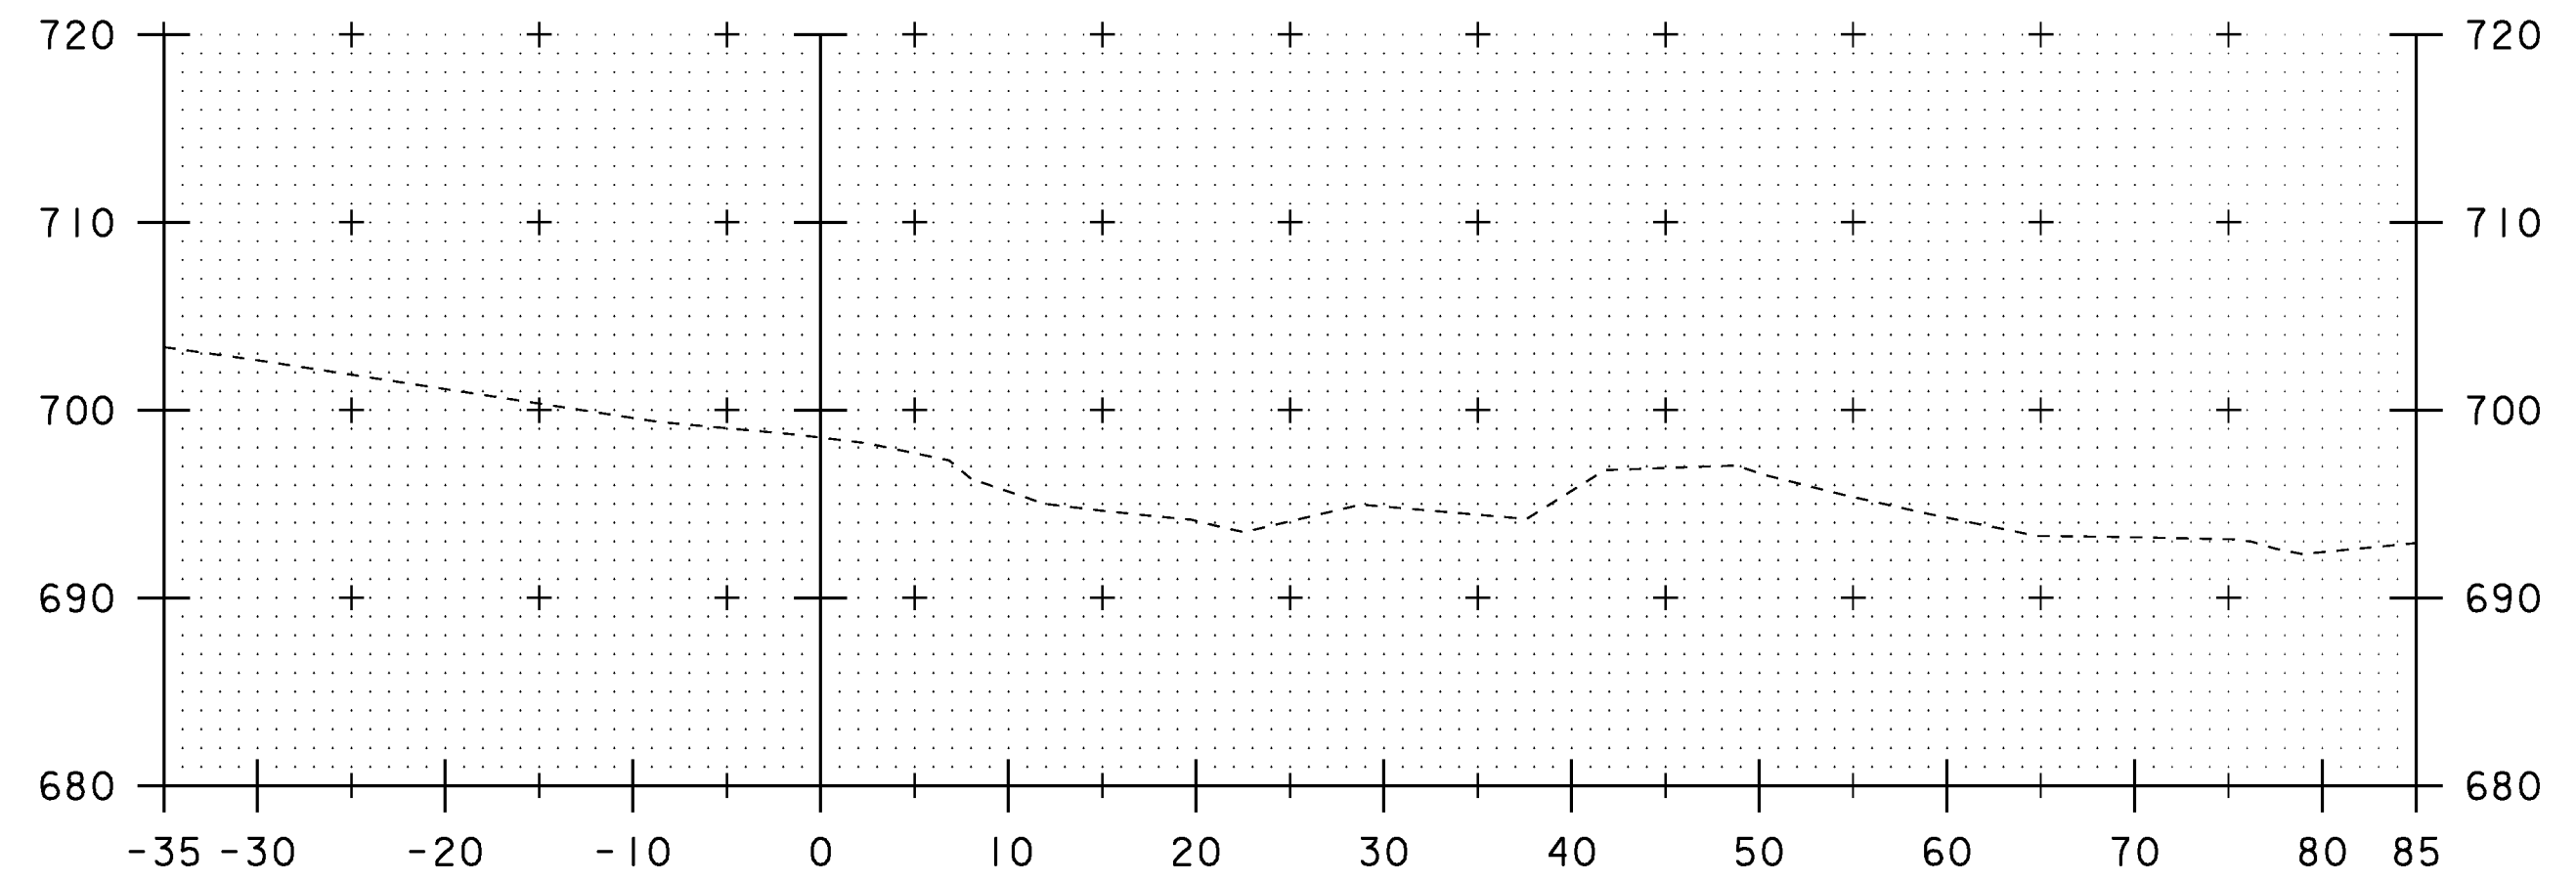

21+25

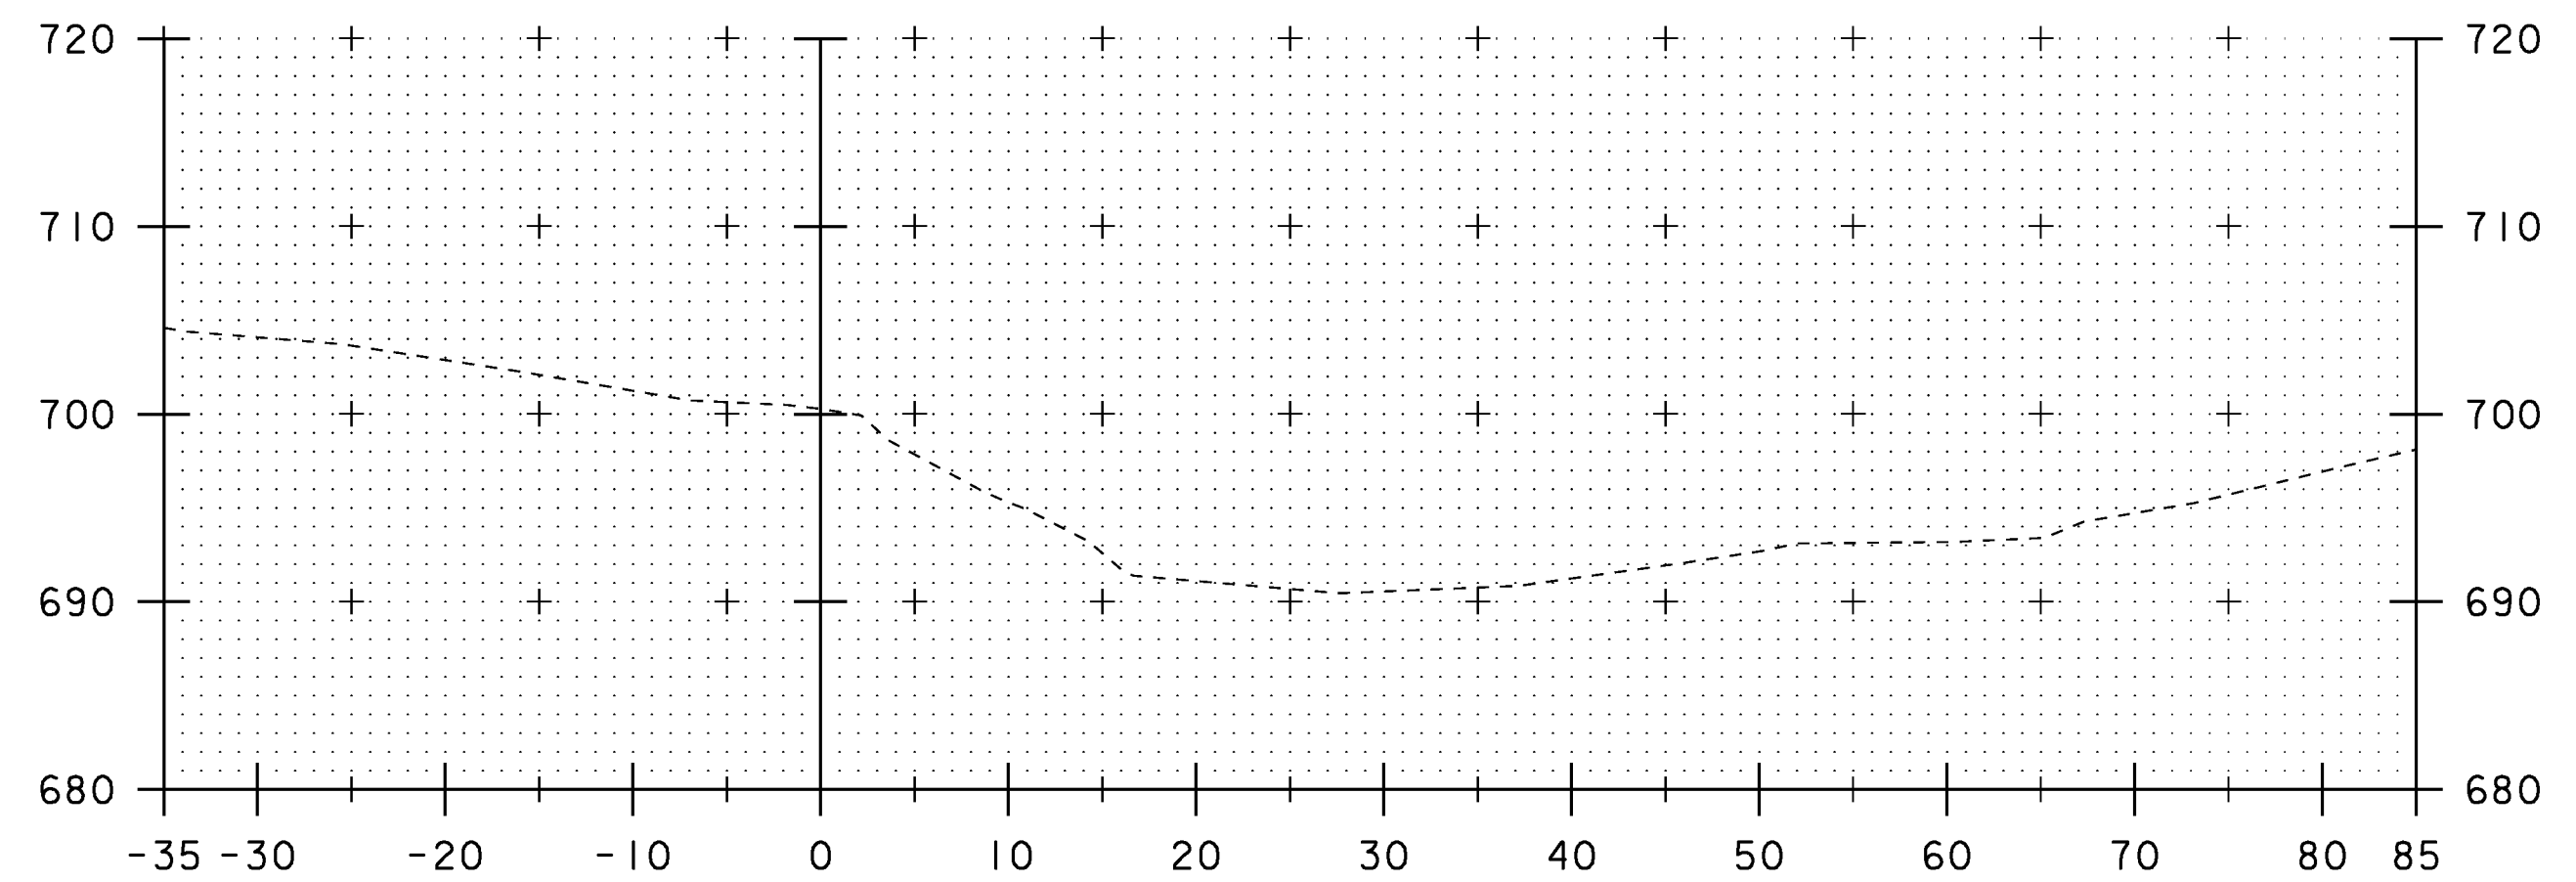

21+00

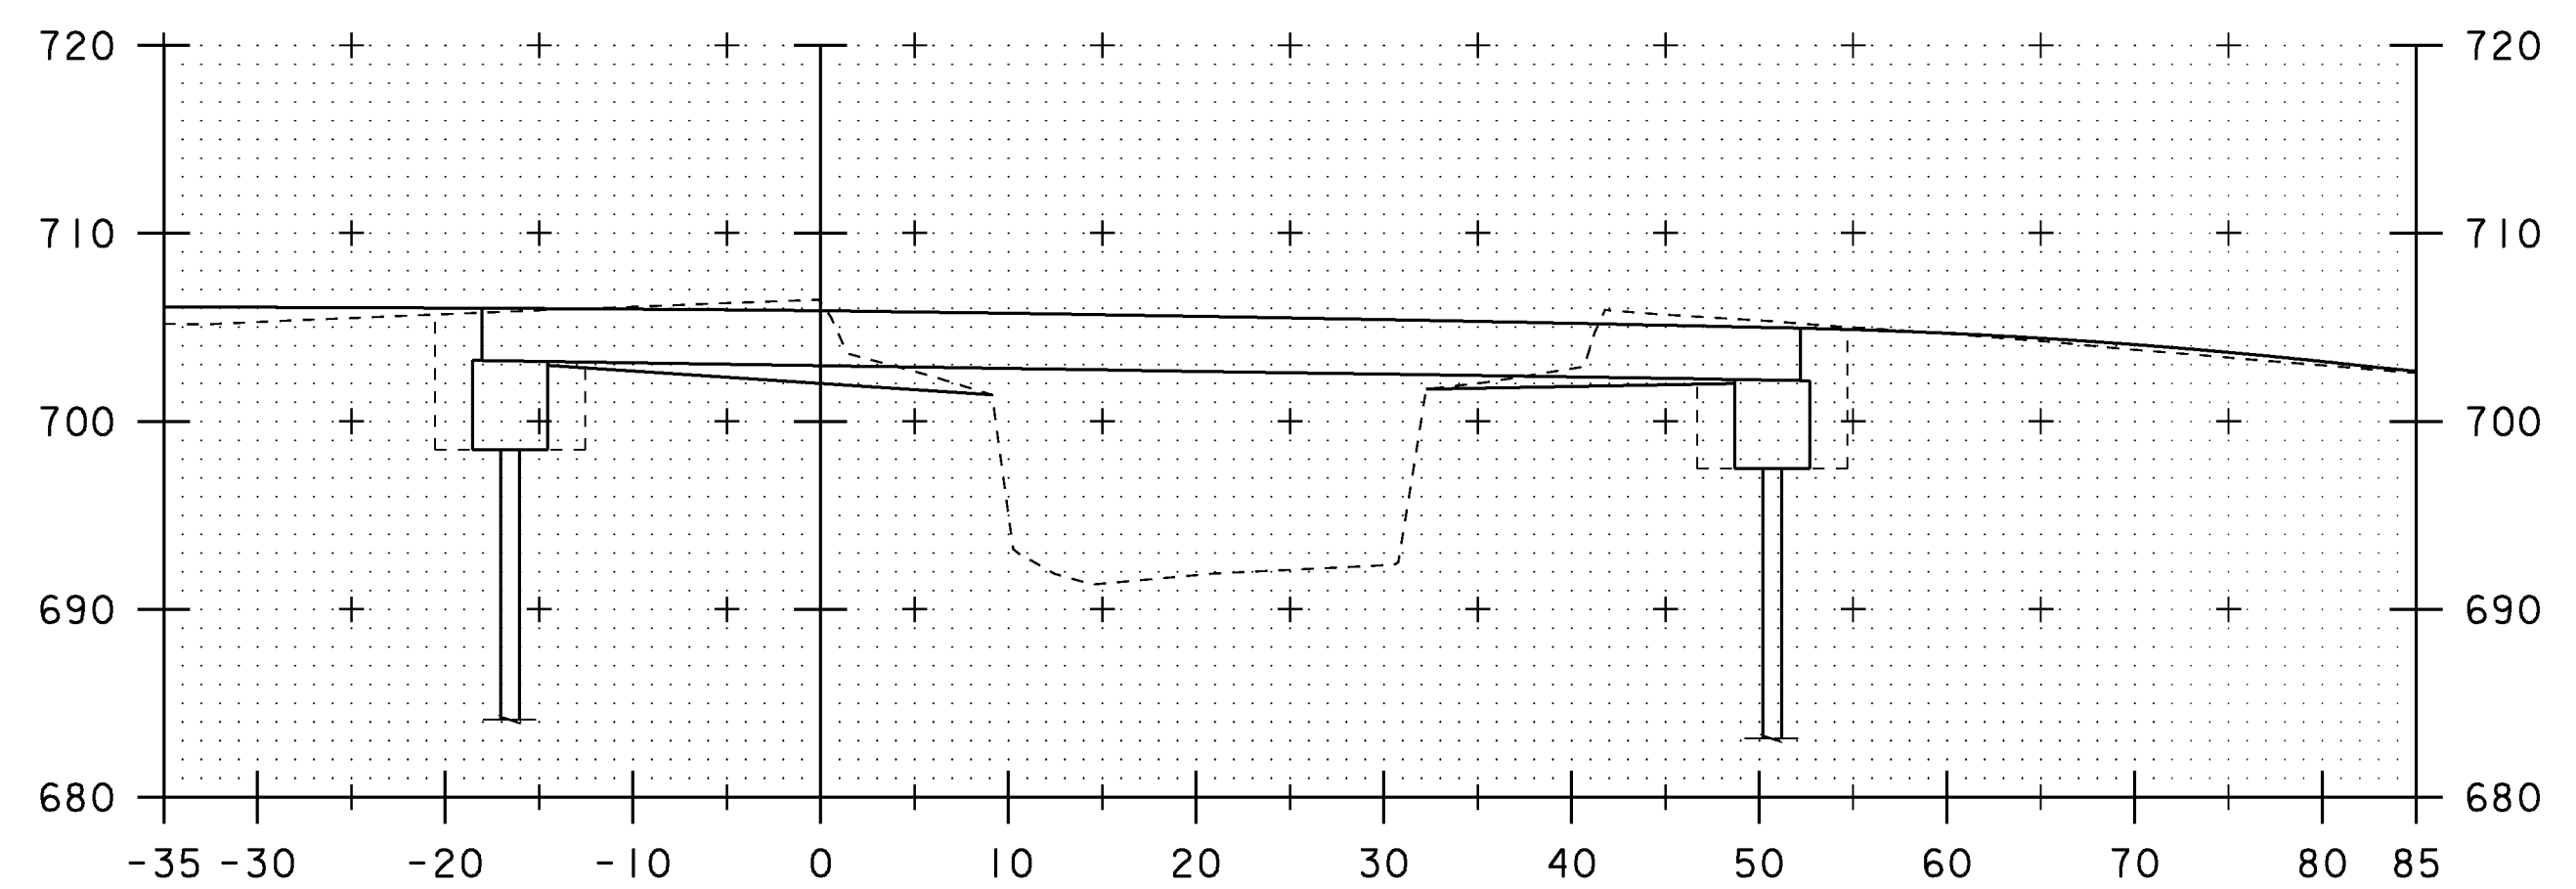

20+75

SCALE 1" = 10'-0"

STA. 20+00 TO STA. 21+25

PROJECT NAME: BRAINTREE	PLOT DATE: 31-DEC-2009
PROJECT NUMBER: BRO 1444(36)	DRAWN BY: T. FILLBACH
FILE NAME: s95j292xsl.dgn	CHECKED BY: R. PELLETT
PROJECT LEADER: K. HIGGINS	SHEET 26 OF 26
DESIGNED BY: T. FILLBACH	
CHANNEL SECTIONS	



State of Vermont
PDD/Structures Design Section
One National Life Drive
Montpelier, VT 05633-5001
www.aot.state.vt.us

(phone) 802-888-2621
(fax) 802-888-3566
(tdd) 800-253-0191

Agency of Transportation

July 12, 2010


Renaud Bros. Construction
283 Fort Bridgeman Rd #2
Vernon, VT 05354

Project Name: Braintree BRO 1444(36)

Structure Identification: Bridge 12 over Ayers Brook


The following Bridge Abutment Plans (Incidental to Items 540.10 Precast Concrete Structure (Abutment #1) and 540.10 Precast Concrete Structure (Abutment #2) for the above project received in this office on June 29, 2010 has been reviewed and is being returned herewith.

All details are approved as noted. The details for the retaining wall have not been received as of this time.


Sincerely,

Kristin M. Higgins, P.E.
Structures Project Manager

Attachments
cc: Jeremy Reed - Resident Engineer - letter and plans
 Renaud Bros Construction - Contractor - letter and Plans
 Construction Division - letter only
 Files (KMH)

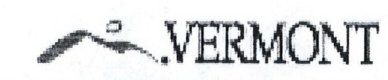
Abutment Details_Approval_0712.doc

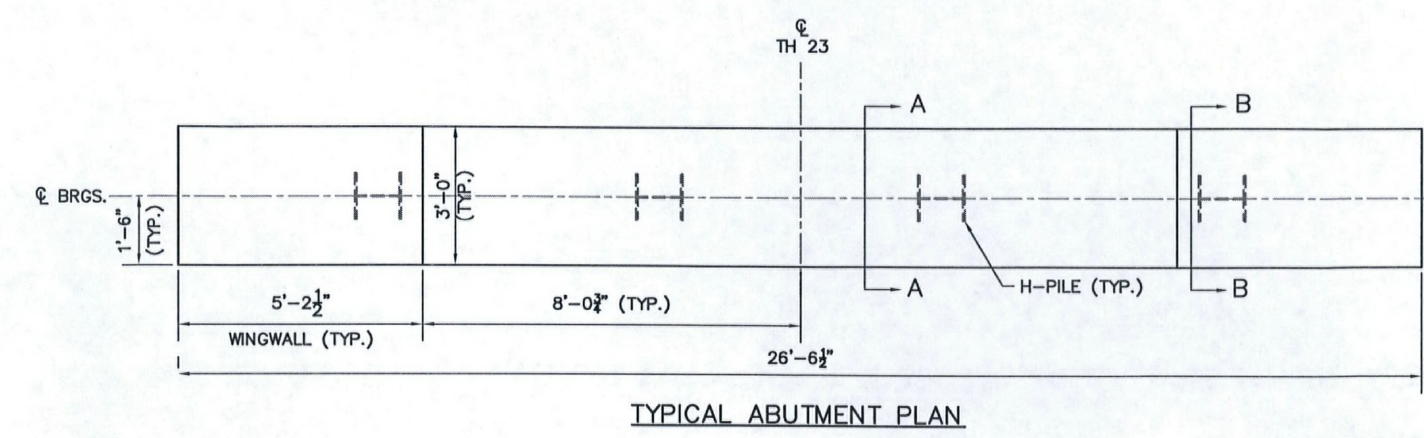


027-ABUT




TYPICAL ABUTMENT PLAN

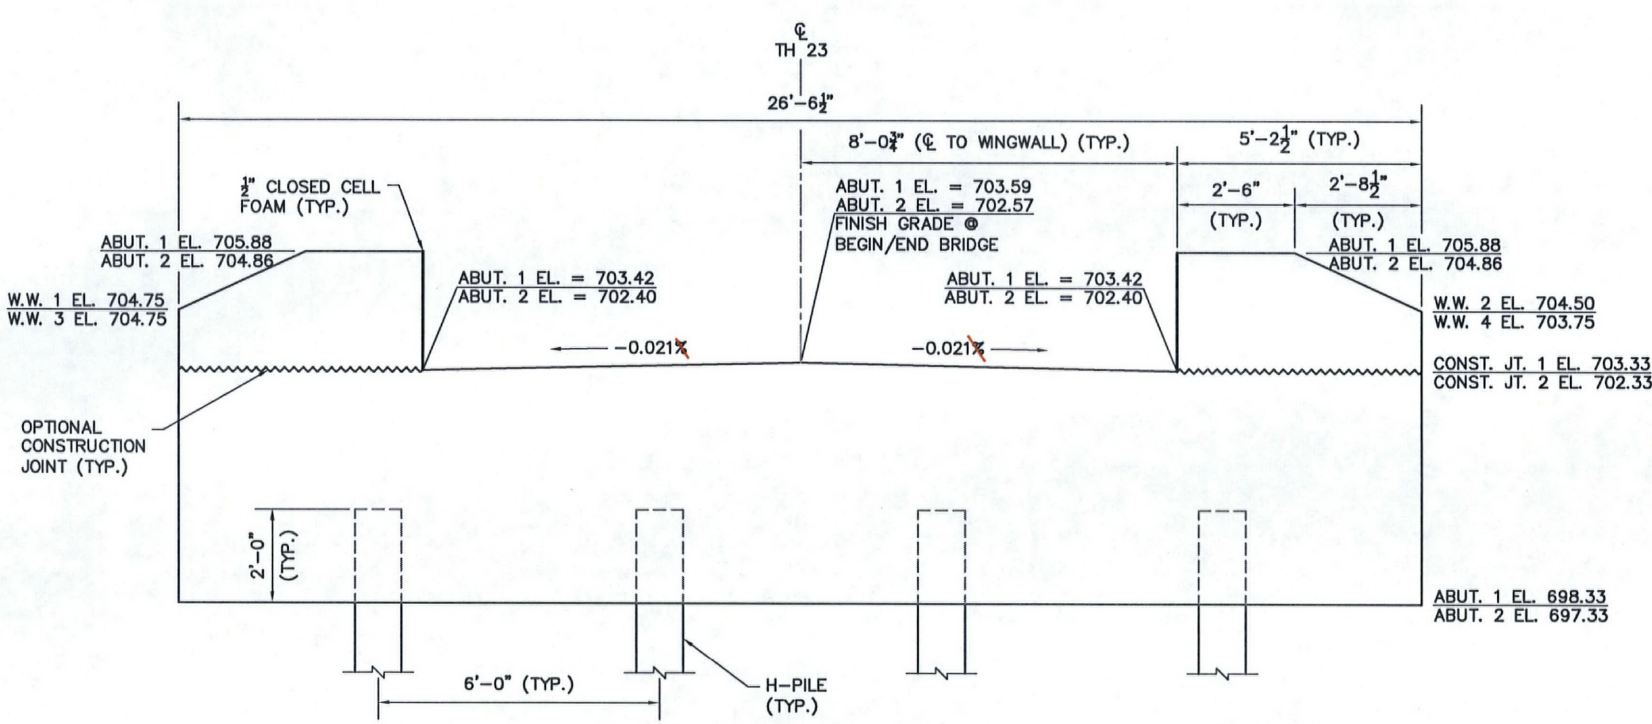

TYPICAL ABUTMENT ELEVATION

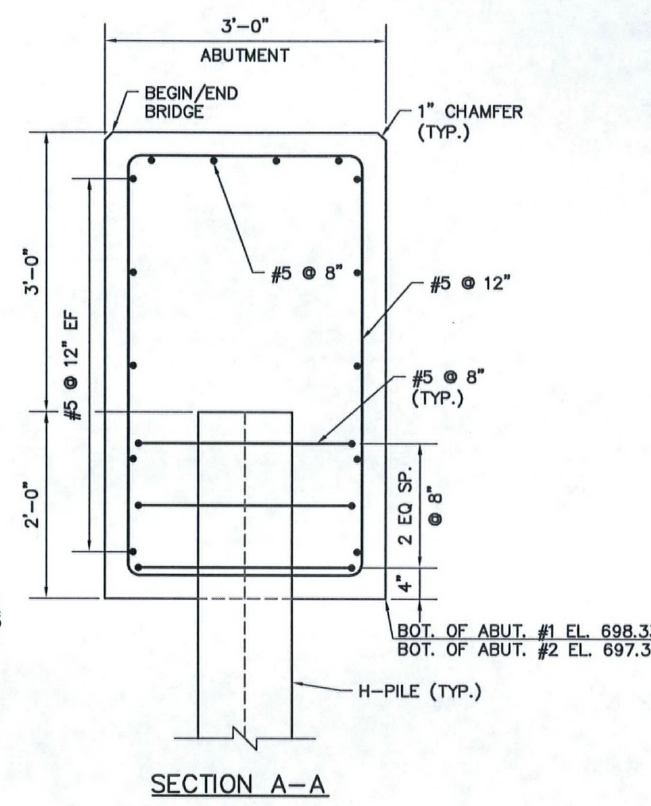


SECTION A-A

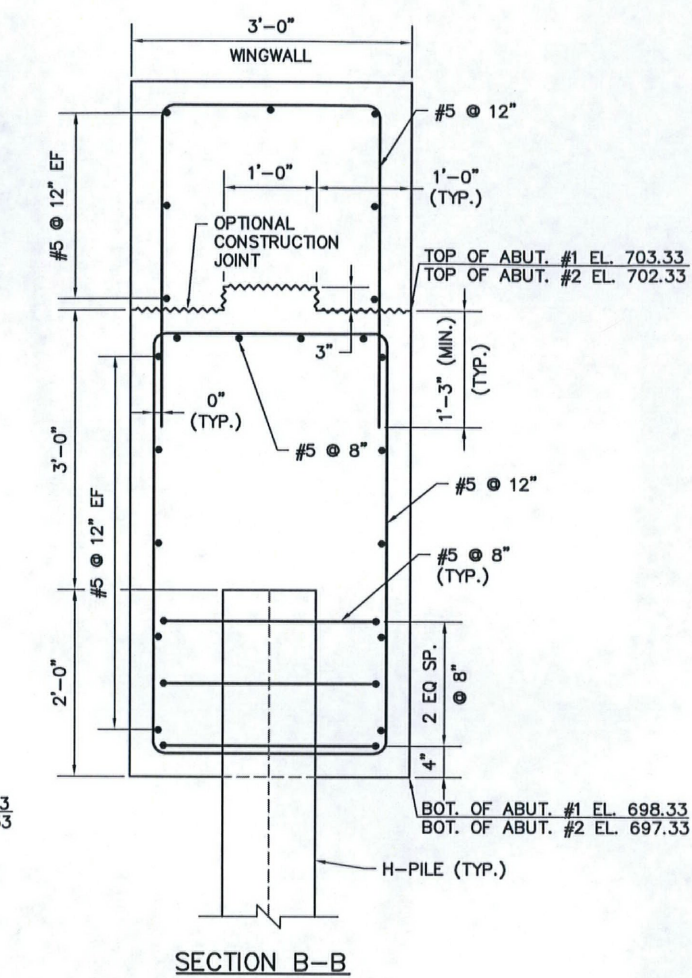

SECTION B-B

Vermont Agency of Transportation
RECEIVED
 CK'D BY TCF OK'D BY KMH
 10:04 am, Jul 8, 2010
 RESUBMIT APPROVED AS NOTED
 BY KMH DATE 7-12-10

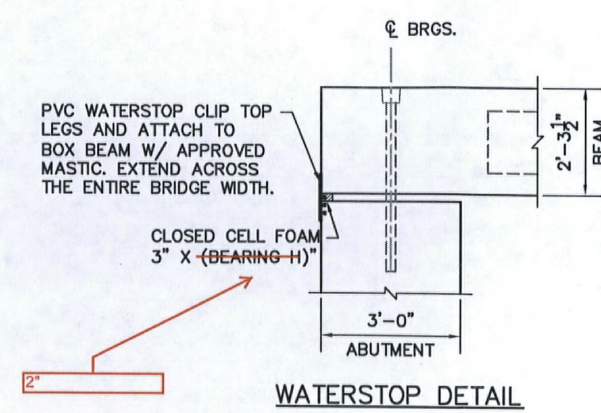

WATERSTOP DETAIL

NOTE:
 1. LAP LENGTH FOR ALL #5 BARS SHALL BE 2'-2"
 2. ALL CONCRETE SHALL BE HIGH PERFORMANCE CLASS B MEETING SECTION 501 OF THE STANDARD SPECIFICATIONS FOR CONSTRUCTION



State of Vermont
PDD/Structures Design Section
National Life Building – Drawer 33
Montpelier, VT 05633-5001
www.aot.state.vt.us

Agency of Transportation

[phone] 802-828-2621
[fax] 802-828-3566
[toll] 800-253-0191

Cosmec, Inc.
1501 Rocky Ridge Road
P.O. Box 2159
Athens, Texas 75751

April 23, 2010

Project Name: Braintree Project #: BRO 1444 (36)


Structure Identification: Bridge 12 over Ayers Brook

The following Bridge Bearing fabrication drawings, for the above project (General Contractor – Renaud Bros., Inc.), have been reviewed and are being returned herewith.

Bearing fabrication drawings are approved.

You must provide notice to our fabrication inspector, Jeff Clark, as to the date fabrication represented by these drawings will begin. That notice must be received and acknowledged at least seven days prior to that date, as per Specification 506.03. Jeff may be contacted by phone at (802)828-0044 or email at jeff.clark@state.vt.us. Any material fabricated prior to the notification date is subject to rejection without further cause.

Sincerely,

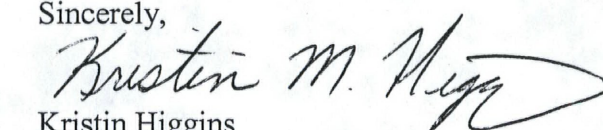

Kristin Higgins
Structures Project Manager

Attachments


cc: Resident Engineer w/prints – Jeremy Reed
 Shop Inspector w/prints – Jeff Clark
 Contractor w/prints – Renaud Bros., Inc.
 Construction Division – letter only
 Materials & Research Section (C&IA Unit) – letter only
 Files




029 Bearings

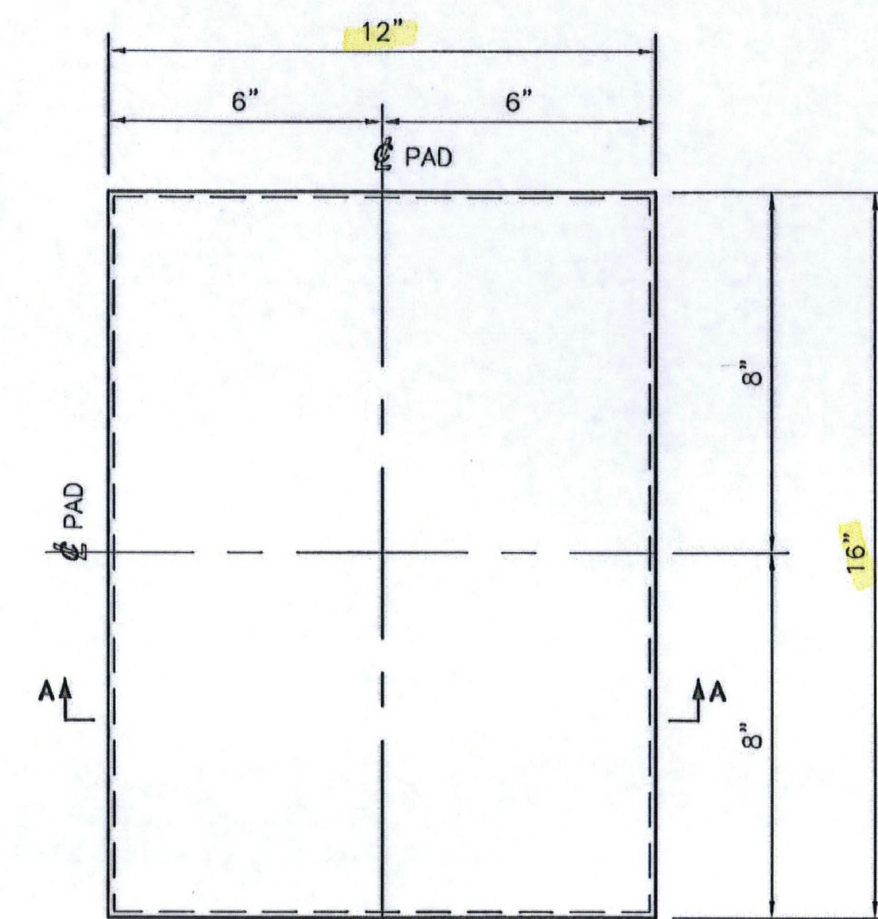

PLAN VIEW

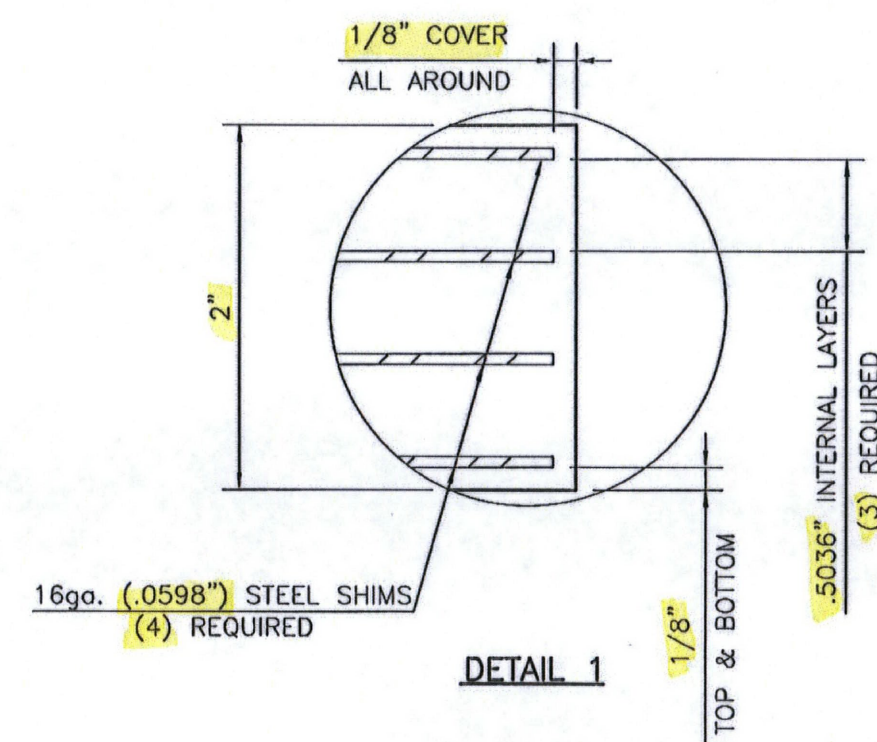

DETAIL 1

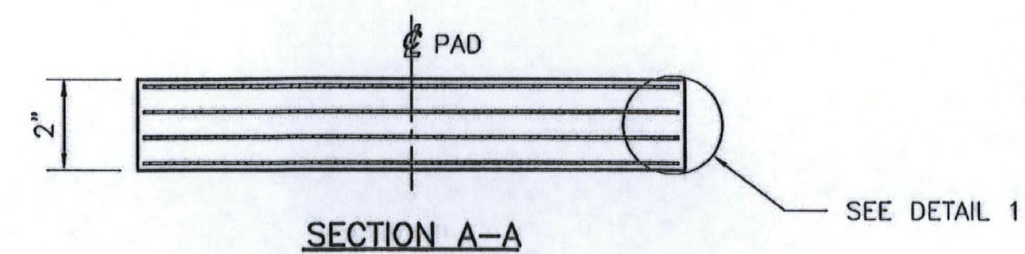

SECTION A-A

(16) LAMINATED ELASTOMERIC BEARING PADS
LOCATE @ ABUTMENTS

SHOP NOTES:

1. BEARINGS SHALL CONFORM TO THE APPLICABLE SUBSECTIONS OF STANDARD SPECIFICATIONS SECTIONS 531 & 731.
2. ELASTOMER - 50 DUROMETER NATURAL RUBBER.
3. INTERNAL STEEL LAMINATES (SHIMS) SHALL BE AASHTO M270M/M270 GRADE 36.
4. ELASTOMER SHALL HAVE A SHEAR MODULUS OF 100 psi ± 15% AND MEET THE REQUIREMENTS OF LOW TEMPERATURE ZONE D, GRADE 4.

RECEIVED
 COUNTY FR CITY KMH
 APR 16 2010
 RESUBMIT APPROVED
 BY KMH DATE 4/23/10

LAMINATED ELASTOMERIC BEARING PADS		
STATE OF VERMONT		
AGENCY OF TRANSPORTATION		
TOWN OF BRAINTREE		
REPLACEMENT OF BRIDGE NO: 12		
STATE	COUNTY	CONTROL NO.
VT	CRANCE	N/A
PROJECT NO.: BRO-1444 (36)		
DYNAMIC RUBBER; LAMINATED BEARING ASSEMBLIES		
Cosma		
1501 ROCKY RIDGE ROAD P.O. BOX 2159 ATHENS, TEXAS 75751		
SCALE: NONE	DRAWN BY	CHECKED BY
	DATE: 4/2/10	DATE: 4/12/10
SHEET 1 OF 1		JOB NO.: 10631

REV.	DESCRIPTION	BY	DATE	CHKD	DATE

D30 Bearing



State of Vermont
PDD/Structures Design Section
National Life Building - Drawer 33
Montpelier, VT 05633-5001
www.aot.state.vt.us

(phone) 802-828-2521
(fax) 802-828-2566
(toll) 800-253-0191

Agency of Transportation

July 22, 2010

Wm. E. Dailey Inc.
Airport Rd
Shaftsbury, VT 05262

Project Name: Braintree

Project #: BRO 1444 (36)


Structure Identification: Bridge #12 over Ayers Brook

The Prestressed Concrete Box Beam fabrication drawings [Item 510.21 Prestressed Concrete Box Beams] for the above project (General Contractor - Renaud Bros., Inc.) have been reviewed and are being returned herewith.

All sheets are approved or approved as noted.

You must provide notice to our fabrication inspector, Jim Wild, as to the date fabrication represented by these drawings will begin. Jim must receive and acknowledge your notice at least seven days prior to that date. You may contact Jim by phone at (802)828-6931 or email at jim.wild@state.vt.us. Any material fabricated prior to the notification date is subject to rejection without further cause.

Sincerely,





Kristin M. Higgins P.E.
Project Manager

Attachments


cc: Resident Engineer - Jeremy Reed w/prints
 Shop Inspector - Jim Wild w/prints
 Contractor - Renaud Bros., Inc. w/prints
 Construction Division - letter only
 Materials & Research Section (C&IA Unit) - letter only
 Files (Structures & Central)



031 Bar Beam

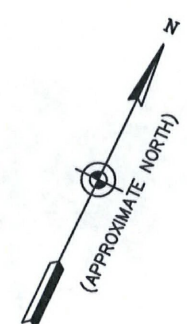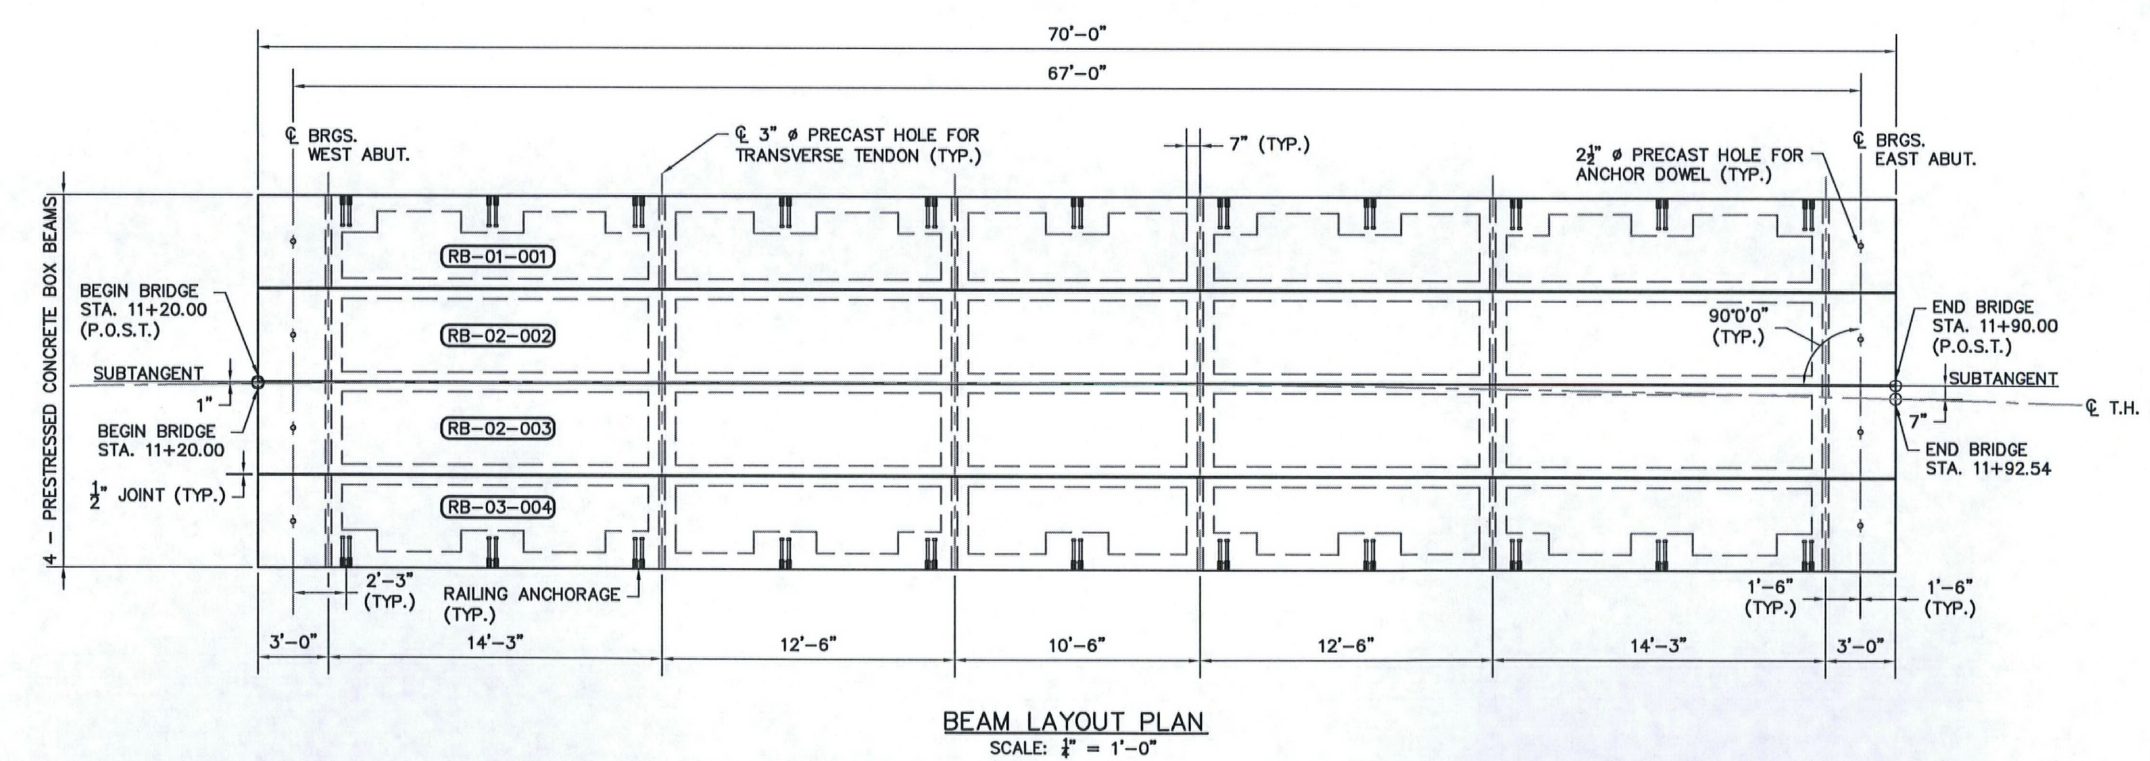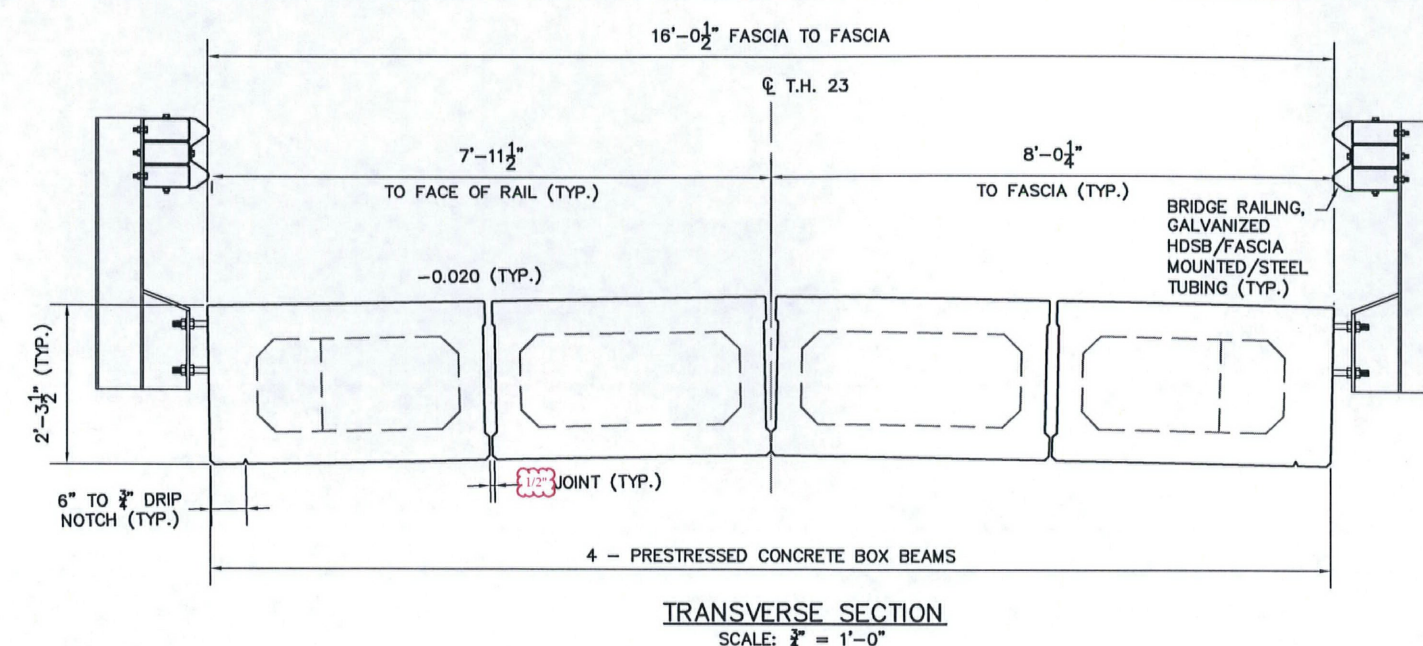


Hoyle, Tanner & Associates, Inc.
125 College Street, 4th Floor, Burlington, VT 05401
Tel: (802) 260-1331 Fax: (802) 260-4444 www.hoyletanner.com
© Copyright 2010 Hoyle, Tanner & Associates, Inc.

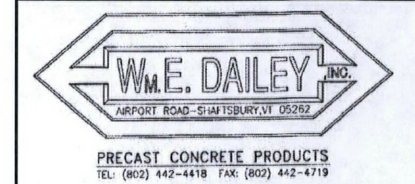


BRAINTREE, VT
T.H. 23 CLASS II
BRIDGE #12
PROJECT NO: BRO 1444 (36)
SHEET 1 OF 5

Vermont Agency of Transportation
RECEIVED
CHK'D BY: Timothy F. Baskin OK'D BY: [Signature]
3:26 pm, Jul 21, 2010
RESUBMIT BY: [Signature] APPROVED DATE: [Signature]

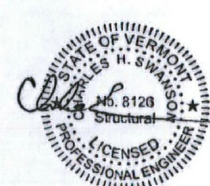

032 Pot Bean

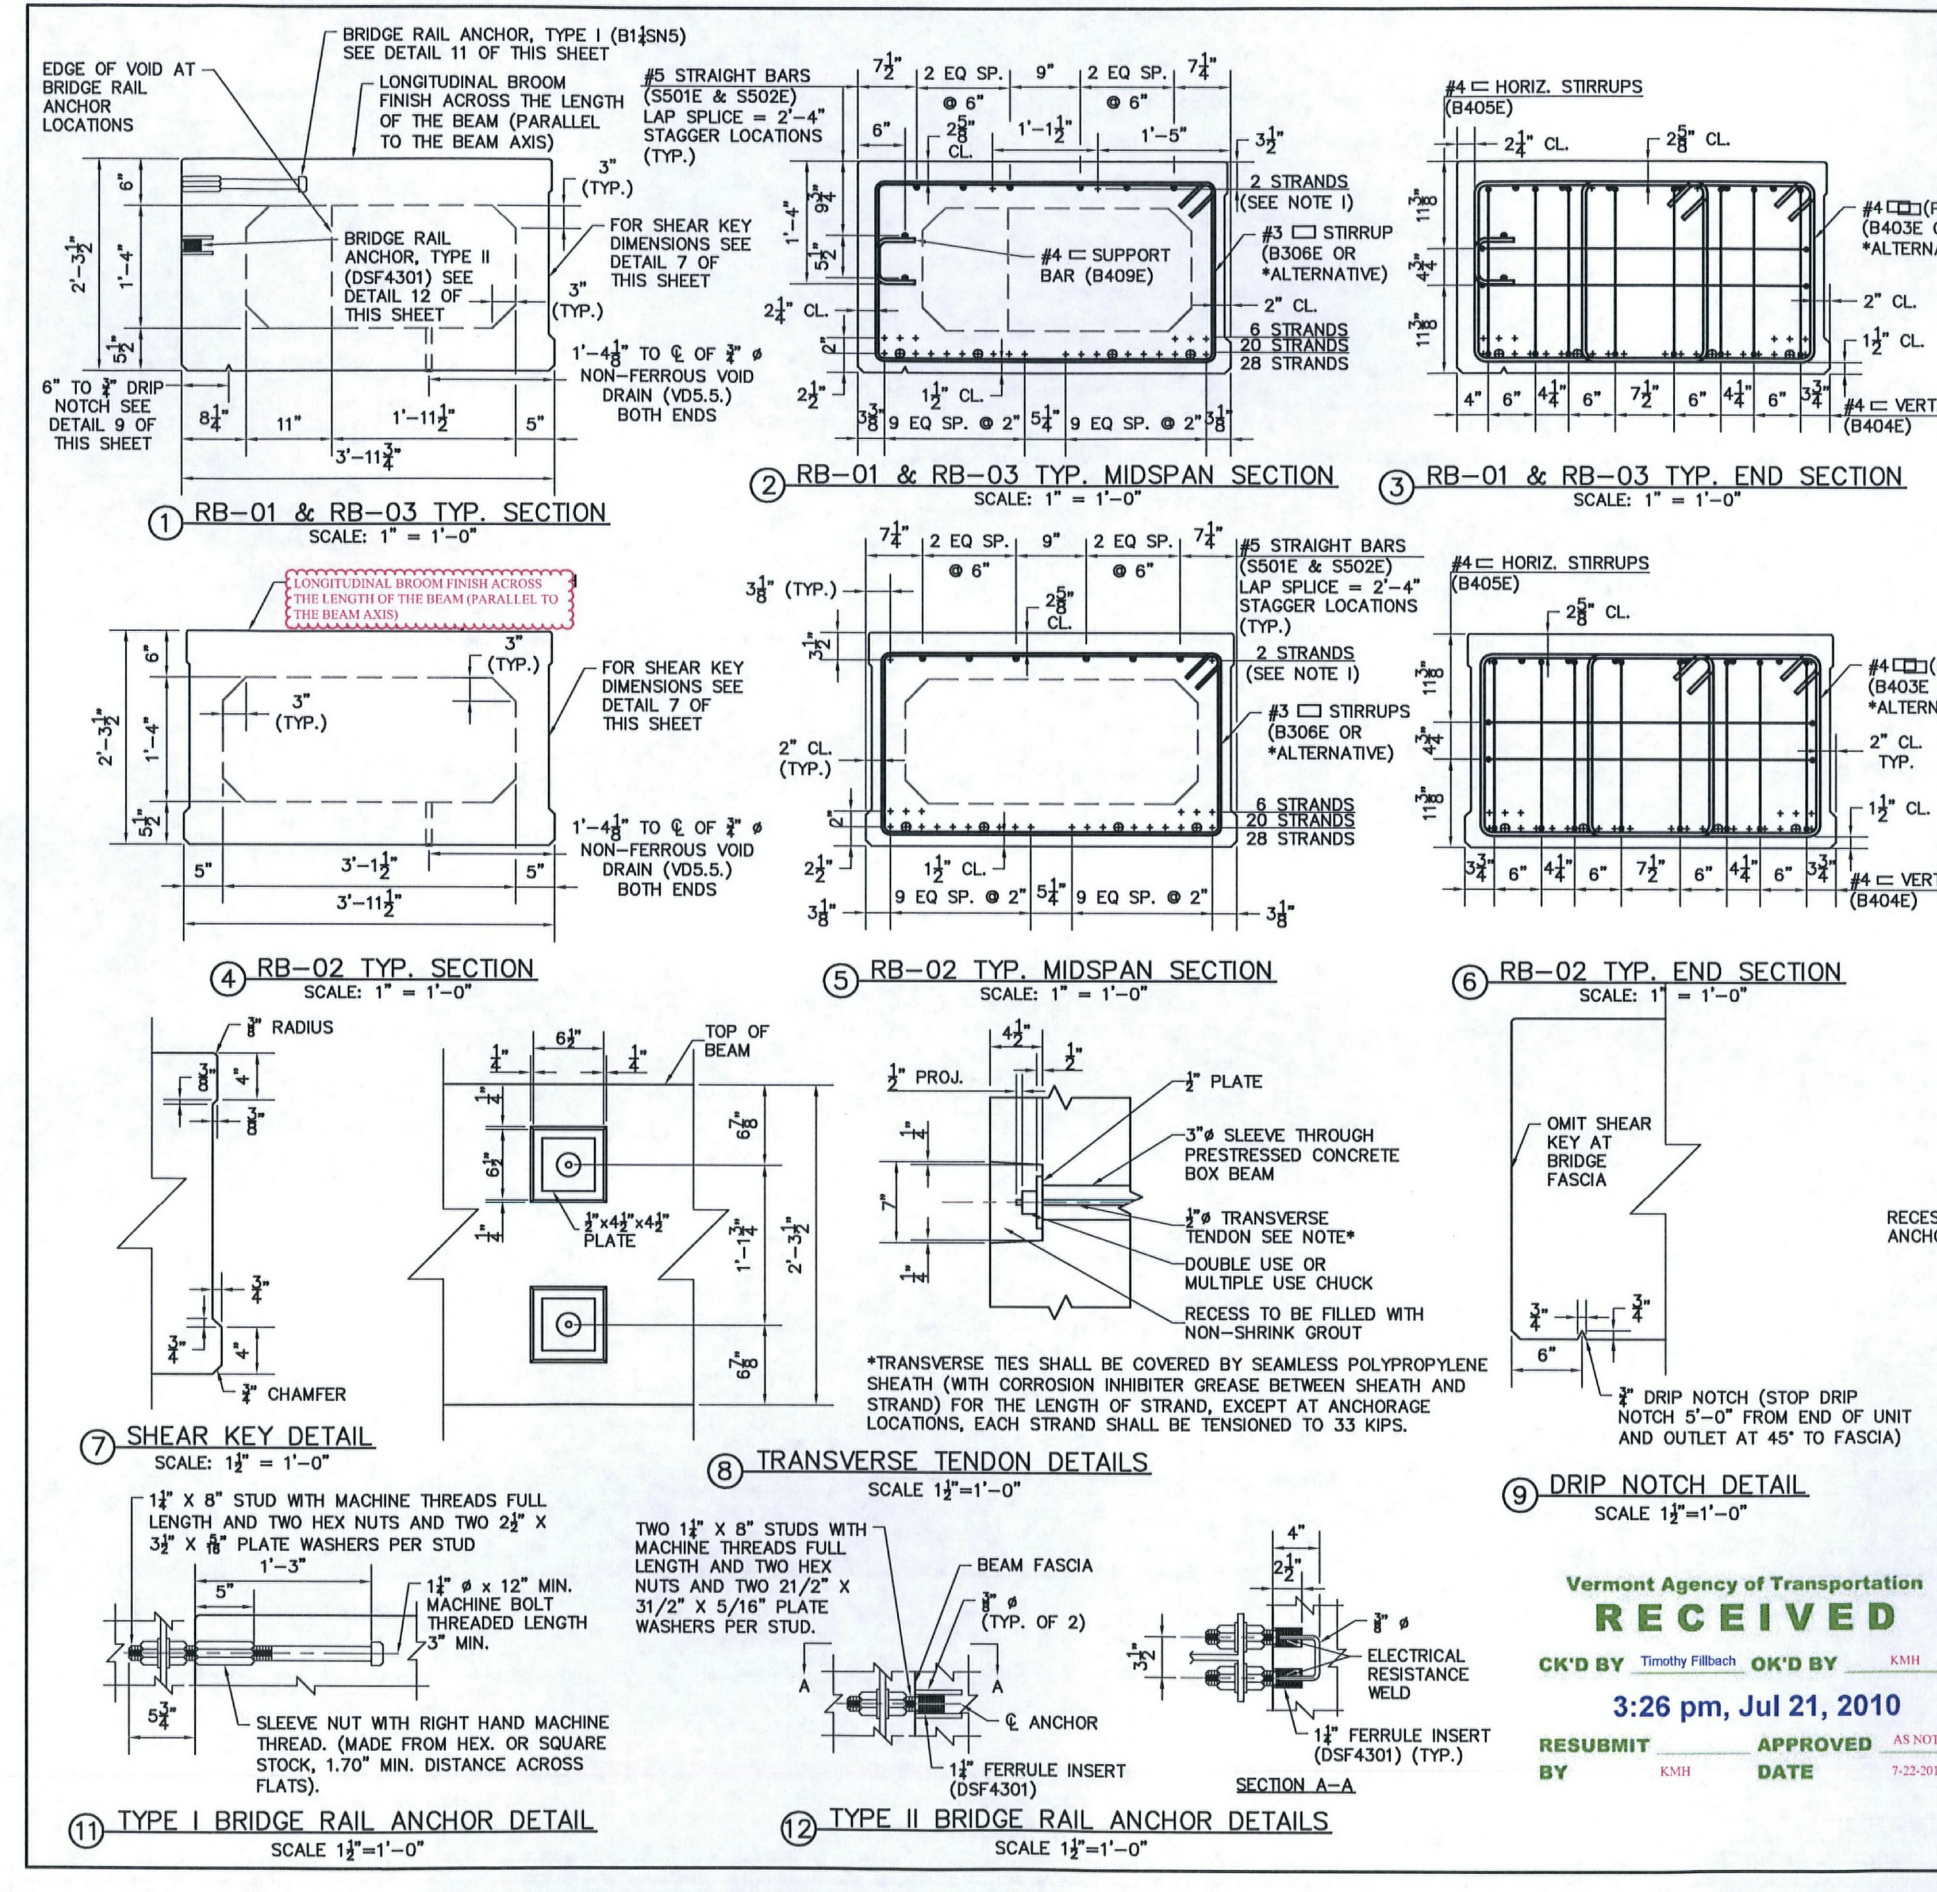

NOTES:

- (+) INDICATES 0.6" # LOW RELAXATION STRAIGHT STRAND. AASHTO M203. BOTTOM ROWS OF STRANDS INITIAL TENSION 44 KIPS. TOP ROWS OF STRANDS INITIAL TENSION 2 KIPS. 270 KSI MINIMUM ULTIMATE TENSILE STRENGTH.
- (@) INDICATES 0.6" # LOW RELAXATION DEBONDED STRAND AASHTO M203. DEBOND 6'-0" FROM END OF BEAM. INITIAL TENSION 44 KIPS. 270 KSI MINIMUM ULTIMATE TENSILE STRENGTH.
- CONCRETE COMPRESSIVE STRENGTH TESTED BY CYLINDER BREAK TEST.
- EACH STRAND SHALL BE FINALLY BURNED OR CUT OFF AT A DEPTH OF 3" INTO THE END OF THE BEAM AND THE RECESSED AREA AROUND THE STRAND SHALL BE FILLED WITH COMPACT 100 NON-SHRINK, NON-METALLIC GROUT MANUFACTURED BY DAYTON SUPERIOR (THIS PRODUCT CAN BE FOUND ON THE PRE-APPROVED PRODUCTS LIST).
- OMIT SHEAR KEY ON EXPOSED EDGES.
- THE PRECASTER SHALL SANDBLAST SHEAR KEY FACES PRIOR TO DELIVERY.

MATERIAL SPECIFICATION:

CONCRETE MIX:
28 DAY STRENGTH: 7000 PSI
RELEASE STRENGTH: 5000 PSI
STRAND: AASHTO M203
MILD REINFORCING: ASTM A615M, GR 60
EPOXY COATED

FINISHES:
TOP: LONGITUDINAL BROOM FINISH
SIDES: STEEL FORM
BOTTOM: STEEL FORM
ENDS: FORM (SEE NOTE 4)


DUNNAGE:
STORAGE: BELOW LIFTING LOOPS
SHIPPING: BELOW LIFTING LOOPS

EXTERIOR BEAM:
TOTAL HEIGHT: 70.149 LBS
CONC. YARDAGE: 17.32 CY

INTERIOR BEAM:
TOTAL HEIGHT: 63.215 LBS
CONC. YARDAGE: 15.61 CY


PARTS & PART NUMBERS

	B402E		B402L
	S502E		S402E
	B403E		B403L
	B404E		B404L
	B405E		B405L
	B406E		B406L
	B407E		B407L
	B408E		B408L
	B409E		B409L
	B410E		B410L
	B411E		B411L
	B412E		B412L
	B413E		B413L
	B414E		B414L
	B415E		B415L
	B416E		B416L
	B417E		B417L
	B418E		B418L
	B419E		B419L
	B420E		B420L

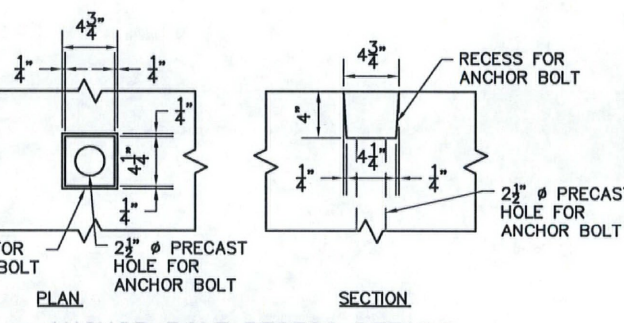

Vermont Agency of Transportation
RECEIVED
CK'D BY: *Timothy F. B...* OK'D BY: *K...*
3:26 pm, Jul 21, 2010
RESUBMIT APPROVED 43-00102
BY: *K...* DATE: 7-23-2010



Hoyle, Tanner & Associates, Inc.
125 College Street, 4th Floor, Burlington, VT 05401
Tel: (802) 261-1331 Fax: (802) 261-4499 www.hoyletanner.com
© Copyright 2010 Hoyle, Tanner & Associates, Inc.
FORM NO. 101
REVISED: 06/2009

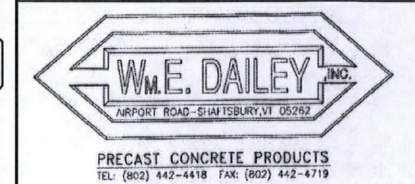


PRECAST CONCRETE PRODUCTS
BRAINTREE, VT
T-11 23 CLASS II
BRIDGE #12
PROJECT NO: BRO 1444 (36)
SHEET 2 OF 5

033 Bar Beccu


NOTES:
 1. DIMENSIONS TO BEAM FASCIA ARE SHOWN FOR 3'-11" WIDE INTERIOR BEAMS. FOR DIMENSIONS TO BEAM FASCIA FOR 3'-11" WIDE EXTERIOR BEAMS SEE DETAILS 2 AND 3 ON SHEET 2.
 2. #4 SUPPORT BARS (B409E) ARE FOR BEAMS RB-01 AND RB-03 ON THE SIDE OF THE EXTERIOR FASCIA ONLY.

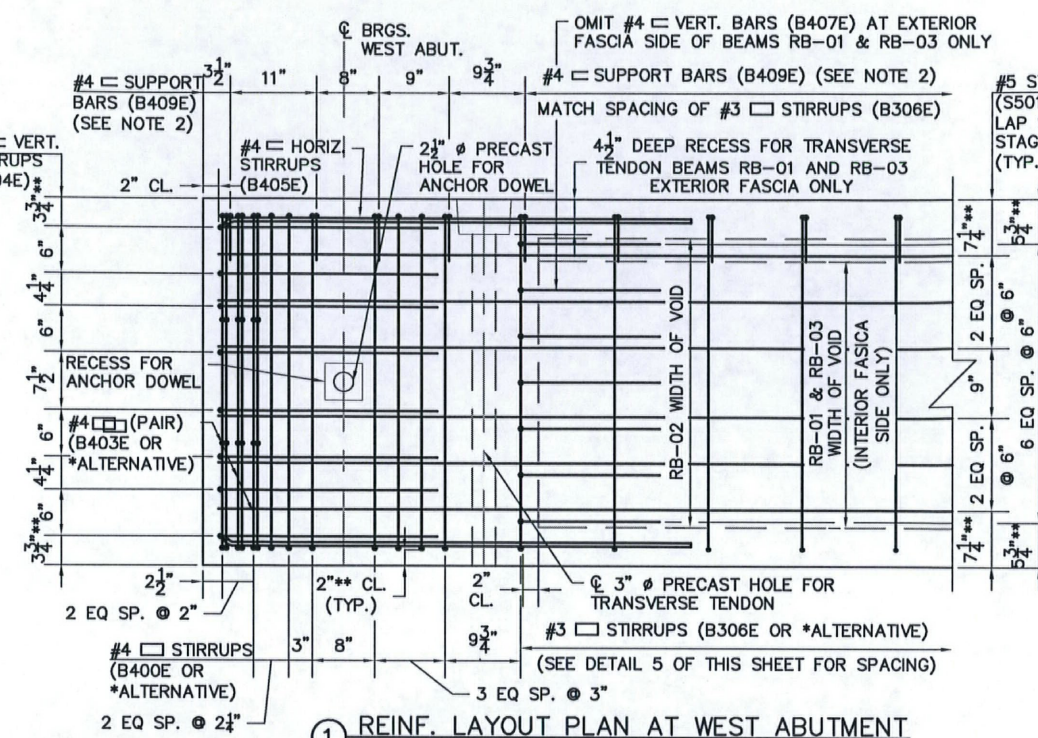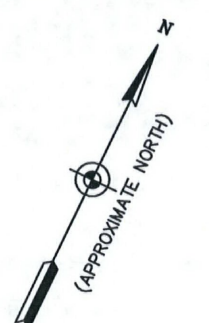


1 REIN. LAYOUT PLAN AT WEST ABUTMENT
 NOTE: REIN. LAYOUT PLAN AT EAST ABUTMENT SIMILAR.
 SCALE: 1" = 1'-0"

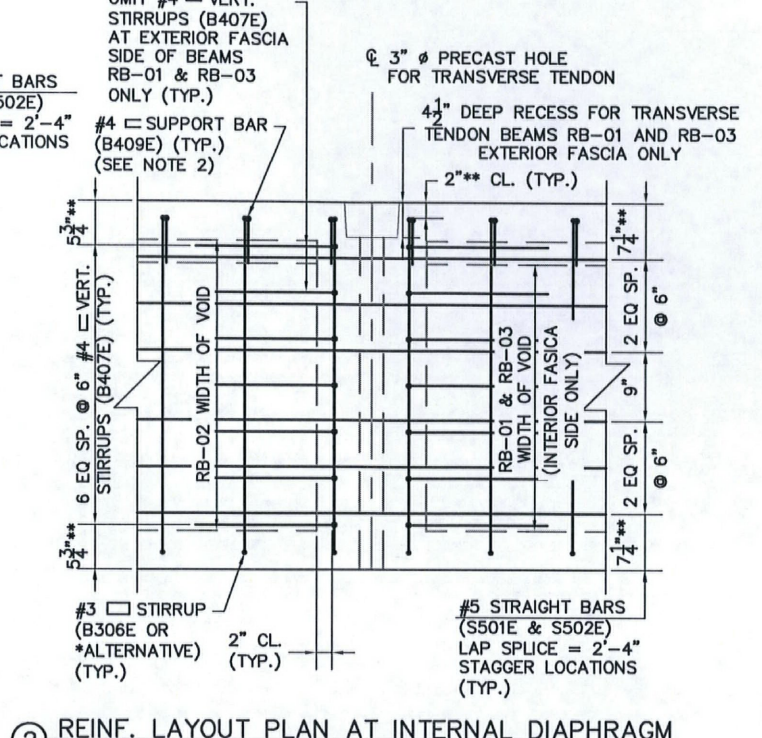


2 REIN. LAYOUT PLAN AT INTERNAL DIAPHRAGM
 SCALE: 1" = 1'-0"

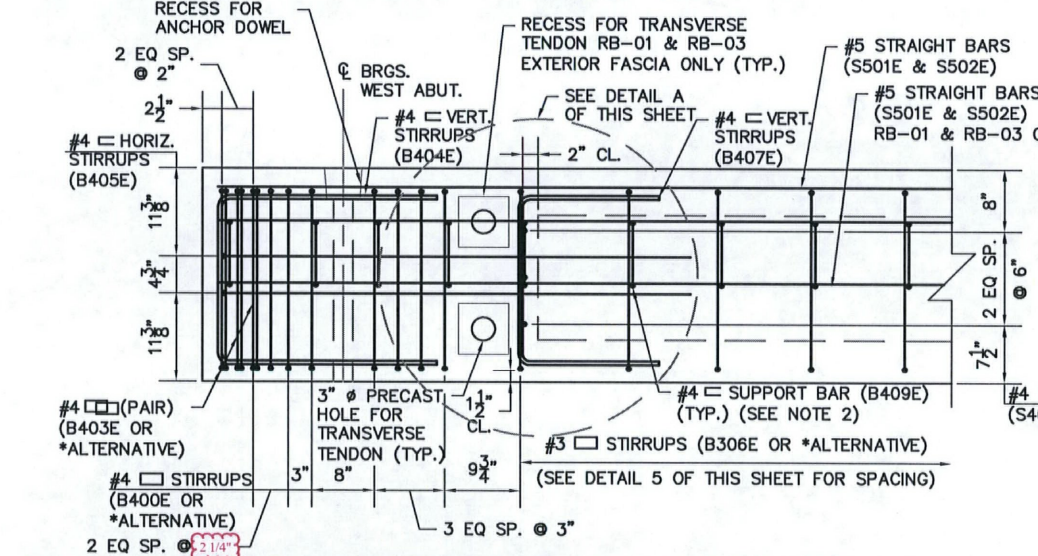


3 LONGITUDINAL SECTION AT WEST ABUTMENT
 NOTE: LONGITUDINAL SECTION AT EAST ABUTMENT SIMILAR.
 SCALE: 1" = 1'-0"

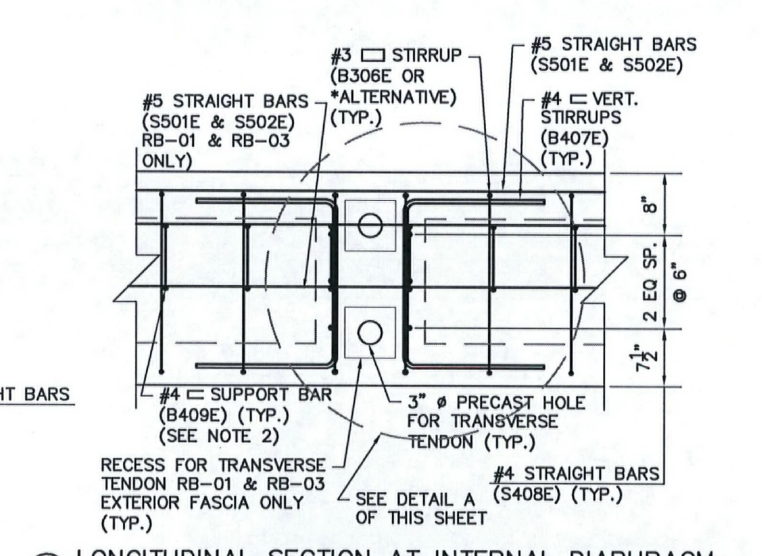

4 LONGITUDINAL SECTION AT INTERNAL DIAPHRAGM
 SCALE: 1" = 1'-0"

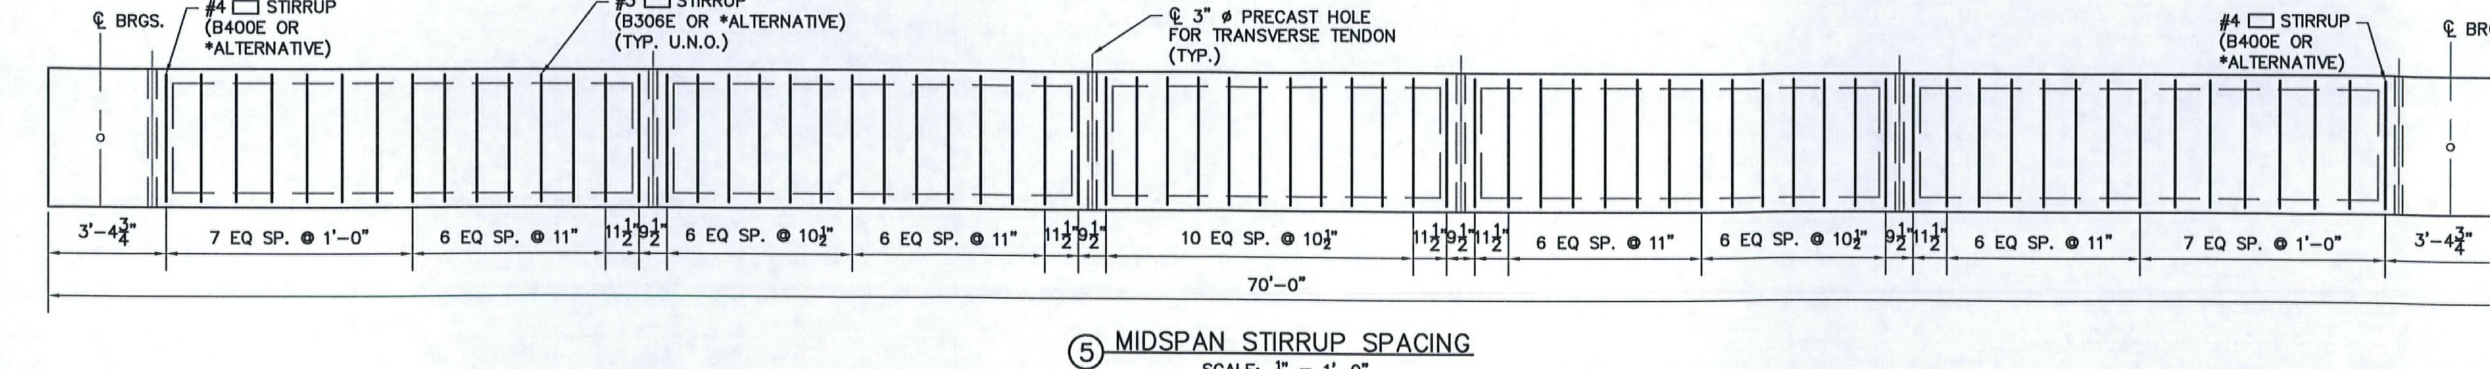


5 MIDSPAN STIRRUP SPACING
 SCALE: 1" = 1'-0"

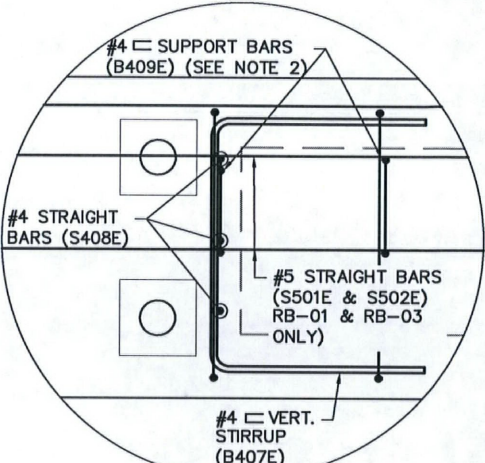

DETAIL A
 SCALE: 1/2" = 1'-0"

Vermont Agency of Transportation
RECEIVED
 CK'D BY: Timothy Fibach OK'D BY: KXH
 3:26 pm, Jul 21, 2010
 RESUBMIT APPROVED
 BY: KXH DATE: 7.23.2010

Hoyle, Tanner & Associates, Inc.
 120 Colgate Street, 4th Floor, Burlington, VT 05401
 Tel: (802) 249-1331 Fax: (802) 249-4444 www.hoyletanner.com
 © Copyright 2010 Hoyle, Tanner & Associates, Inc.

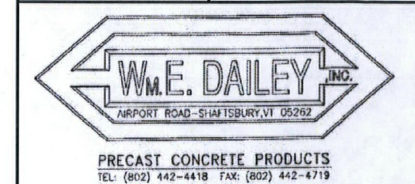

BRAINTREE, VT
 T.H. 23 CLASS III
 BRIDGE #12
 PROJECT NO.: BRO 1444 (36)
SHEET 3 OF 5

034 Bat Beam

GENERAL NOTES:

- SEE DRAWINGS 1, 2, & 3 FOR PLANS AND DETAILS.
- ALL BEAMS ARE LABELED AS FOLLOWS:
PRODUCT TYPE-IDENTIFICATION NUMBER-SEQUENCE NUMBER
- MARK BEAMS RB-01 & RB-02 ENDS "EAST END" FOLLOWED BY THE CORRESPONDING BEAM LABEL.
- MARK BEAM RB-03 END "WEST END" FOLLOWED BY THE CORRESPONDING BEAM LABEL.
- THE BAR QUANTITIES LISTED ARE FOR THE SELECTED SOLID HOOP STRIPUP CONFIGURATION. IF IT IS DECIDED TO USE THE BAR ALTERNATIVES OF 2 INTERLOCKING "U" BARS THAN THE BAR QUANTITIES FOR THOSE BARS WILL NEED TO BE DOUBLED. SEE SHEET 2 OF 4 FOR BAR CONFIGURATIONS.

Vermont Agency of Transportation

RECEIVED





CK'D BY: Timothy F. Bouché, OK'D BY: KSHH

3:26 pm, Jul 21, 2010

RESUBMIT: KSHH, APPROVED: KSHH


BY: KSHH, DATE: 7/23/2010

PART NO.	DESCRIPTION	QTY.
RB-01 & RB-03 BEAMS		
B400E	#4 BENT	16
S501E	#5 STRAIGHT	8
S502E	#5 STRAIGHT	8
B403E	#4 BENT	12
B404E	#4 BENT	16
B405E	#4 BENT	4
B309E	#3 BENT	80
B407E	#4 BENT	50
S408E	#4 STRAIGHT	30
B409E	#4 BENT	30
RB-02 BEAM		
B400E	#4 BENT	16
S501E	#5 STRAIGHT	8
S502E	#5 STRAIGHT	8
B403E	#4 BENT	12
B404E	#4 BENT	16
B405E	#4 BENT	4
B309E	#3 BENT	80
B407E	#4 BENT	70
S408E	#4 STRAIGHT	30
DETAILS		
VD3.5	#3 VOID DRAIN 3" LONG	10
LH3010	LIFT HOOP (3) 2" STRANDS	4
V16A	16" VOID, 13'-1" LONG	2
V16B	16" VOID, 11'-4" LONG	2
V16C	16" VOID, 9'-4" LONG	1
DS4301	1" FERRULE INSERT	22
BF2NS	1/2" DIA. 1'-0" LONG, WITH 3" SLEEVE NUT	22
VERMONT STATE MIX DESIGN		

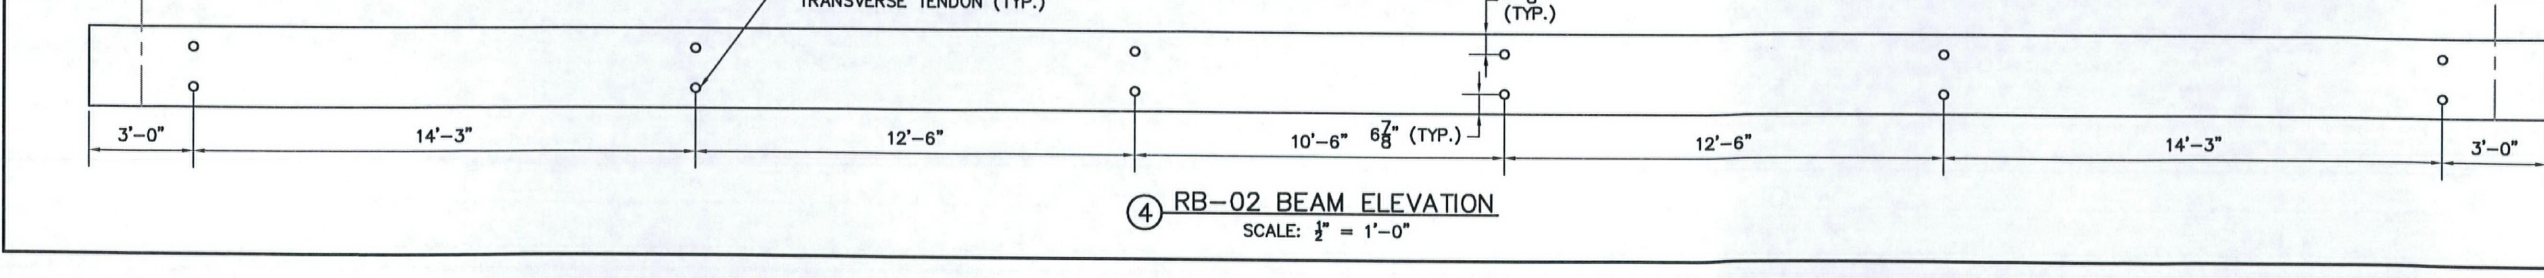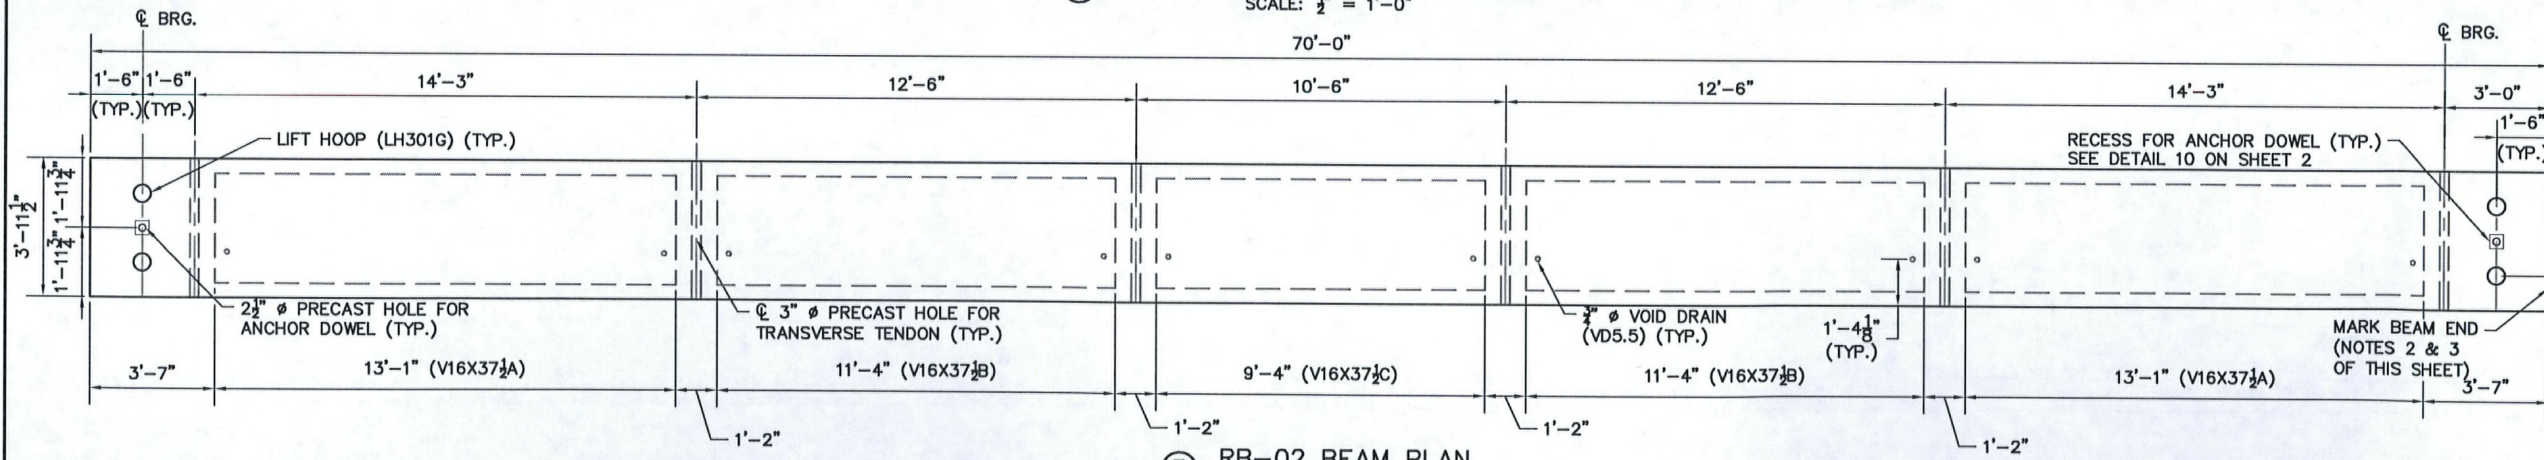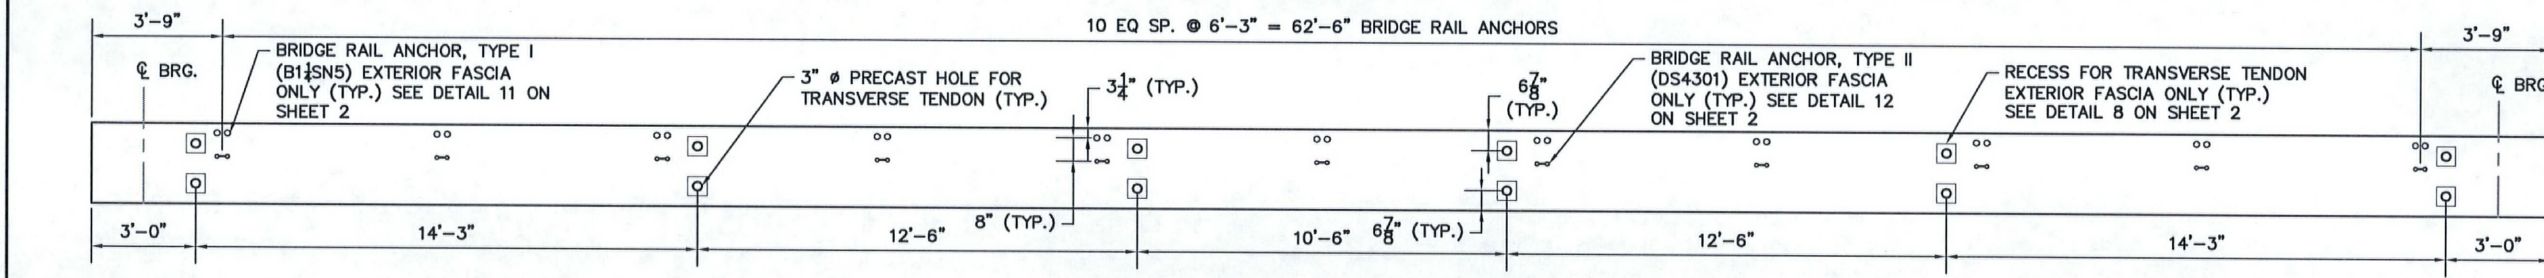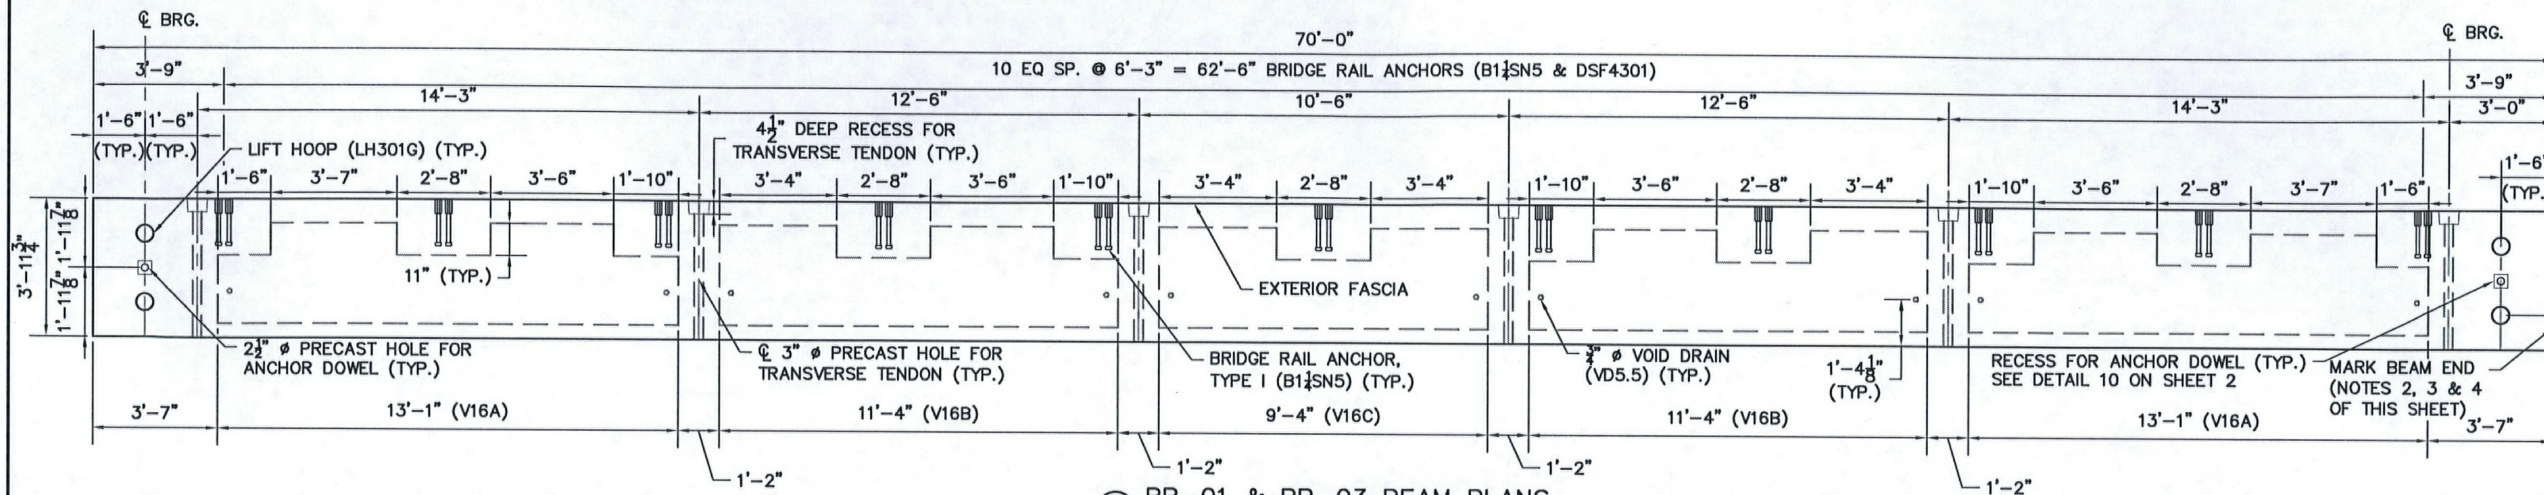

Hoyle, Tanner & Associates, Inc.

125 College Street, 4th Floor, Burlington, VT 05401
Tel: (802) 261-1331 Fax: (802) 261-4491 www.hoyletanner.com
© Copyright 2010 Hoyle, Tanner & Associates, Inc.

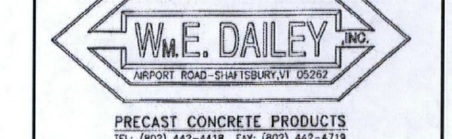

PRECAST CONCRETE PRODUCTS
100 West Street, Braintree, MA 01905

BRAINTREE, VT
T.M. 23 CLASS III
BRIDGE #12
PROJECT NO.: BR0 1444 (36)
SHEET 4 OF 5

035 Bar Beam



State of Vermont
PDD/Structures Design Section
One National Life Drive
Montpelier, VT 05603-5001
www.aot.state.vt.us

[phone] 802-828-2621
[fax] 802-828-2566
[tdd] 800-253-0191

Agency of Transportation

May 5, 2010

DI Highway Sign & Structure Corporation
P.O. Box 123 (40 Greenman Ave)
New York Mills, N.Y. 13417

Project Name: Braintree BRO 1444(36)

Structure Identification: Bridge 12 over Ayers Brook

The Bridge Railing, Item 900.640 Special Provision (Bridge Railing, Galvanized HDSB/Fascia Mounted/Steel Tubing) fabrication drawings, for the above-referenced bridge project (General Contractor – Renaud Brothers, Inc.), have been reviewed and are being returned herewith.

All Sheets and welding procedures are approved.

You must provide notice to our fabrication inspector, Jeff Clark, as to the date fabrication represented by these drawings will begin. Jeff may be contacted by phone at (802)828-0044 or email at jeff.clark@state.vt.us. Any material fabricated prior to the notification date is subject to rejection without further cause.

Sincerely,

Kristin M. Higgins PE
Structures Project Manager

Attachments

- cc: Resident Engineer – Jeremy Reed
 Shop Inspector – Jeff Clark
 Contractor – Renaud Brothers, Inc.
 Construction Division letter only
 Materials & Research Section (C&IA Unit) letter only
 Files (Structures)



037 Bridge Rail

WELDING PROCEDURE SPECIFICATION

MATERIAL SPECIFICATION A572 GR 50, A709 GR 50, AASHTO M270-50
 WELDING PROCESS FCAW
 MANUAL, SEMIAUTOMATIC, AUTOMATIC SEMIAUTOMATIC
 POSITION OF WELDING 1F (FLAT)
 FILLER METAL SPECIFICATIONS AWS 5.20
 FILLER METAL CLASSIFICATION E71T-1
 ELECTRODE & MANUFACTURE Ultracore 71C (Lincoln)
 FLUX & MANUFACTURE N/A
 SHIELDING GAS 100% CO2 DEW POINT -40°F FLOW RATE MIN 49.5 CFH MAX 60 CFH
 SINGLE OR MULTIPLE PASS SINGLE
 SINGLE OR MULTIPLE ARC N/A
 WELDING CURRENT DC POLARITY DCEP (REVERSE)
 WELDING PROGRESSION N/A
 ROOT TREATMENT CLEAN TO REMOVE ALL CONTAMINANTS
 PREHEAT AND INTERPASS 3/4 TO 1 1/2 = 70°F, 1 1/2 TO 2 1/2 = 150°F > 2 1/2 = 225°F
350°F MAX INTERPASS TEMP.
 POSTHEAT TREATMENT NONE

WELDING PROCEDURE

PASS NO.	ELECTRODE SIZE	AMPS	VOLTS	TRAVEL SPEED IN/MIN	JOINT DETAIL
ALL	1/16"	300	27	11.6	<p>Bridge post</p> <p>W 6 X 25 I-beam with 7/16" flange & 5/16" web with 1/2" PL welded to beam.</p> <p>Make fillet weld first, clean all contaminants prior to making groove weld.</p> <p>Make backing weld first, clean all contaminants prior to making groove weld.</p> <p>1/2"</p> <p>1/2"</p> <p>60°</p> <p>1/2"</p> <p>1/2"</p> <p>Illustrated in the horizontal position for clarity only welding to be completed in the flat position.</p>
		Max 330 Min 270	Max 29 Min 25	Max 12.7 Min 10.5	

PROCEDURE NO: DI-01 FABRICATOR DL HIGHWAY SIGN & STRUCTURE

OUR JOB NO. V04-02 Bridge Post AUTHORIZED BY [Signature]


PQR REF NO. DI-01-09a

DATE 4/23/10




JOEL W. SIMS
 CWI 96689971
 QCI EXP. 03/01/11

038 Bridge Rail

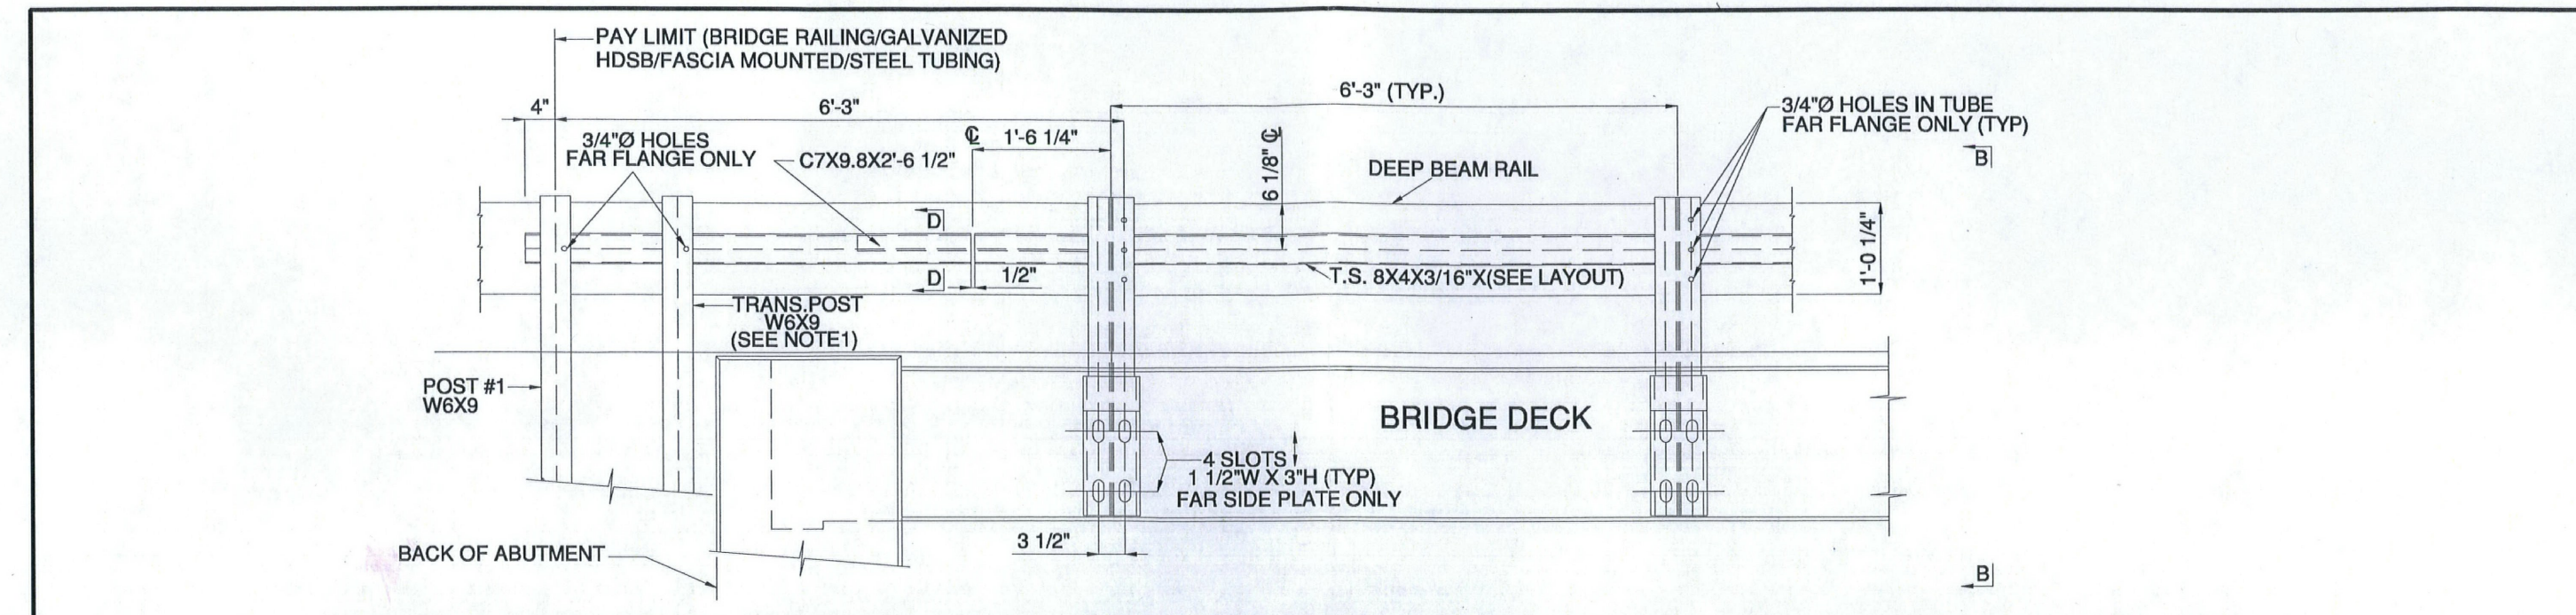

RAILING ELEVATION

NOTE 1: LOCATE TRANSITION POST AS CLOSE TO ABUTMENT WALL AS PRACTICAL.

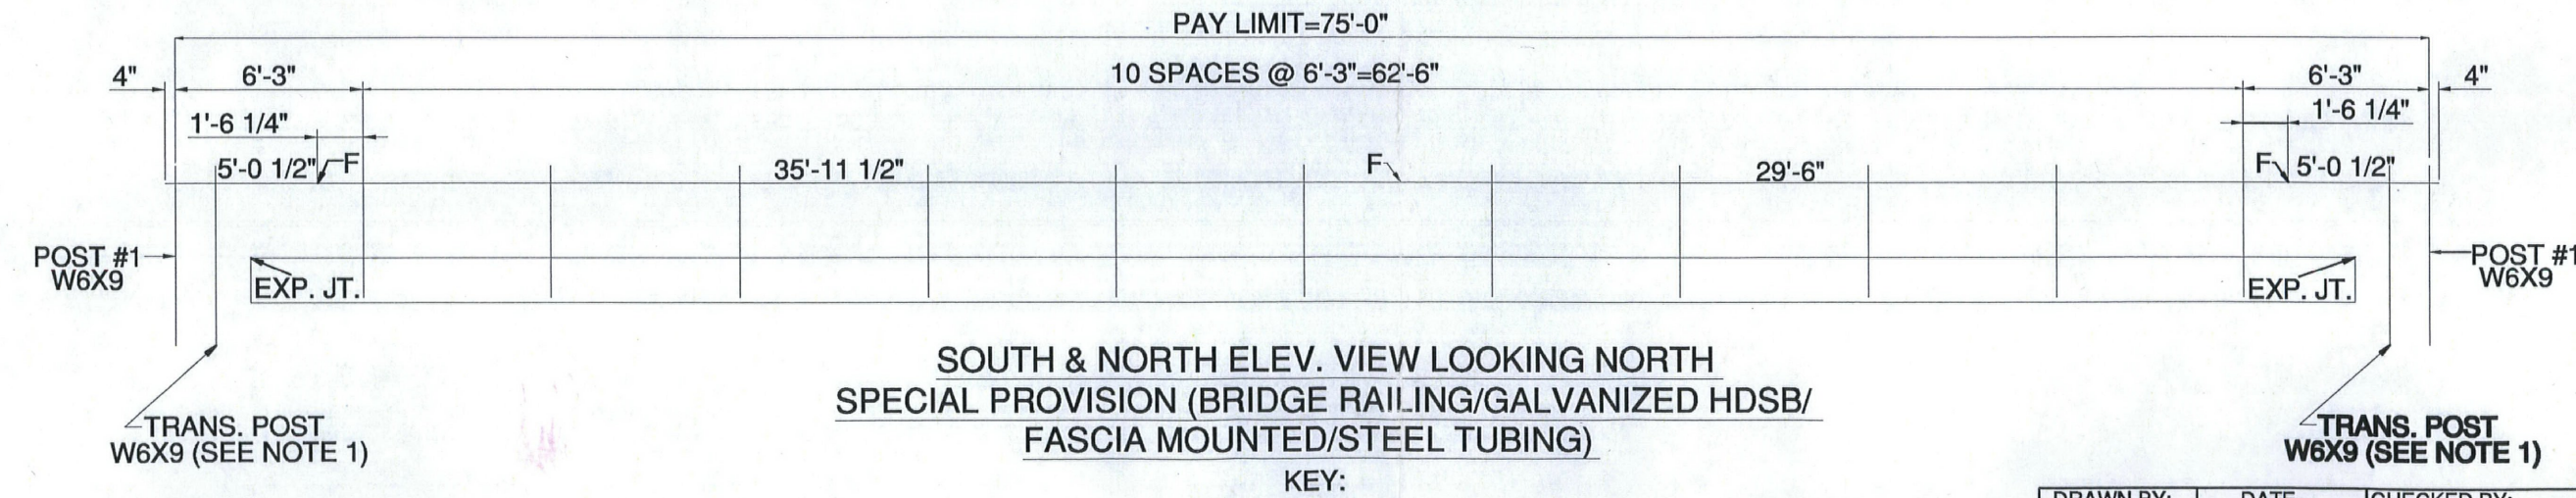

**SOUTH & NORTH ELEV. VIEW LOOKING NORTH
SPECIAL PROVISION (BRIDGE RAILING/GALVANIZED HDSS/
FASCIA MOUNTED/STEEL TUBING)**


NOTES: FOR SECTION VIEWS B-B & D-D SEE SHEET 2 OF 3.

Vermont Agency of Transportation
RECEIVED
 CK'D BY TCF OK'D BY JTS
 9:09 am, Apr 27, 2010
 RESUBMIT APPROVED X
 BY KMH DATE 4-27-10

ALL DIMENSIONS MUST BE FIELD VERIFIED
 BY CONTRACTOR PRIOR TO FABRICATION

DRAWN BY: JJP	DATE: 4/9/10	CHECKED BY: DCK	SHEET NO. 1 OF 3
BRIDGE RAILING LAYOUT			
VERMONT AGENCY OF TRANSPORTATION HERWARD ROAD BRIDGE (STA. 11+85.00) OVER AYER'S BROOK IN THE TOWN OF BRANTREE IN THE COUNTY OF ORANGE			
CONT. NO. BRO 1444(26)	GEN. CONT. RENAUD BROTHERS, INC.		REGION NO. N/A
ERECTOR: VERMONT RECREATIONAL SURFACING & FENCING, INC.			JOB NO.
FABRICATOR: D1 HIGHWAY SIGN & STRUCTURE CORPORATION P.O. BOX 123(40 GREENMAN AVE.) NEW YORK MILLS, N.Y. 13417			V04-02

039 Bridge Rail

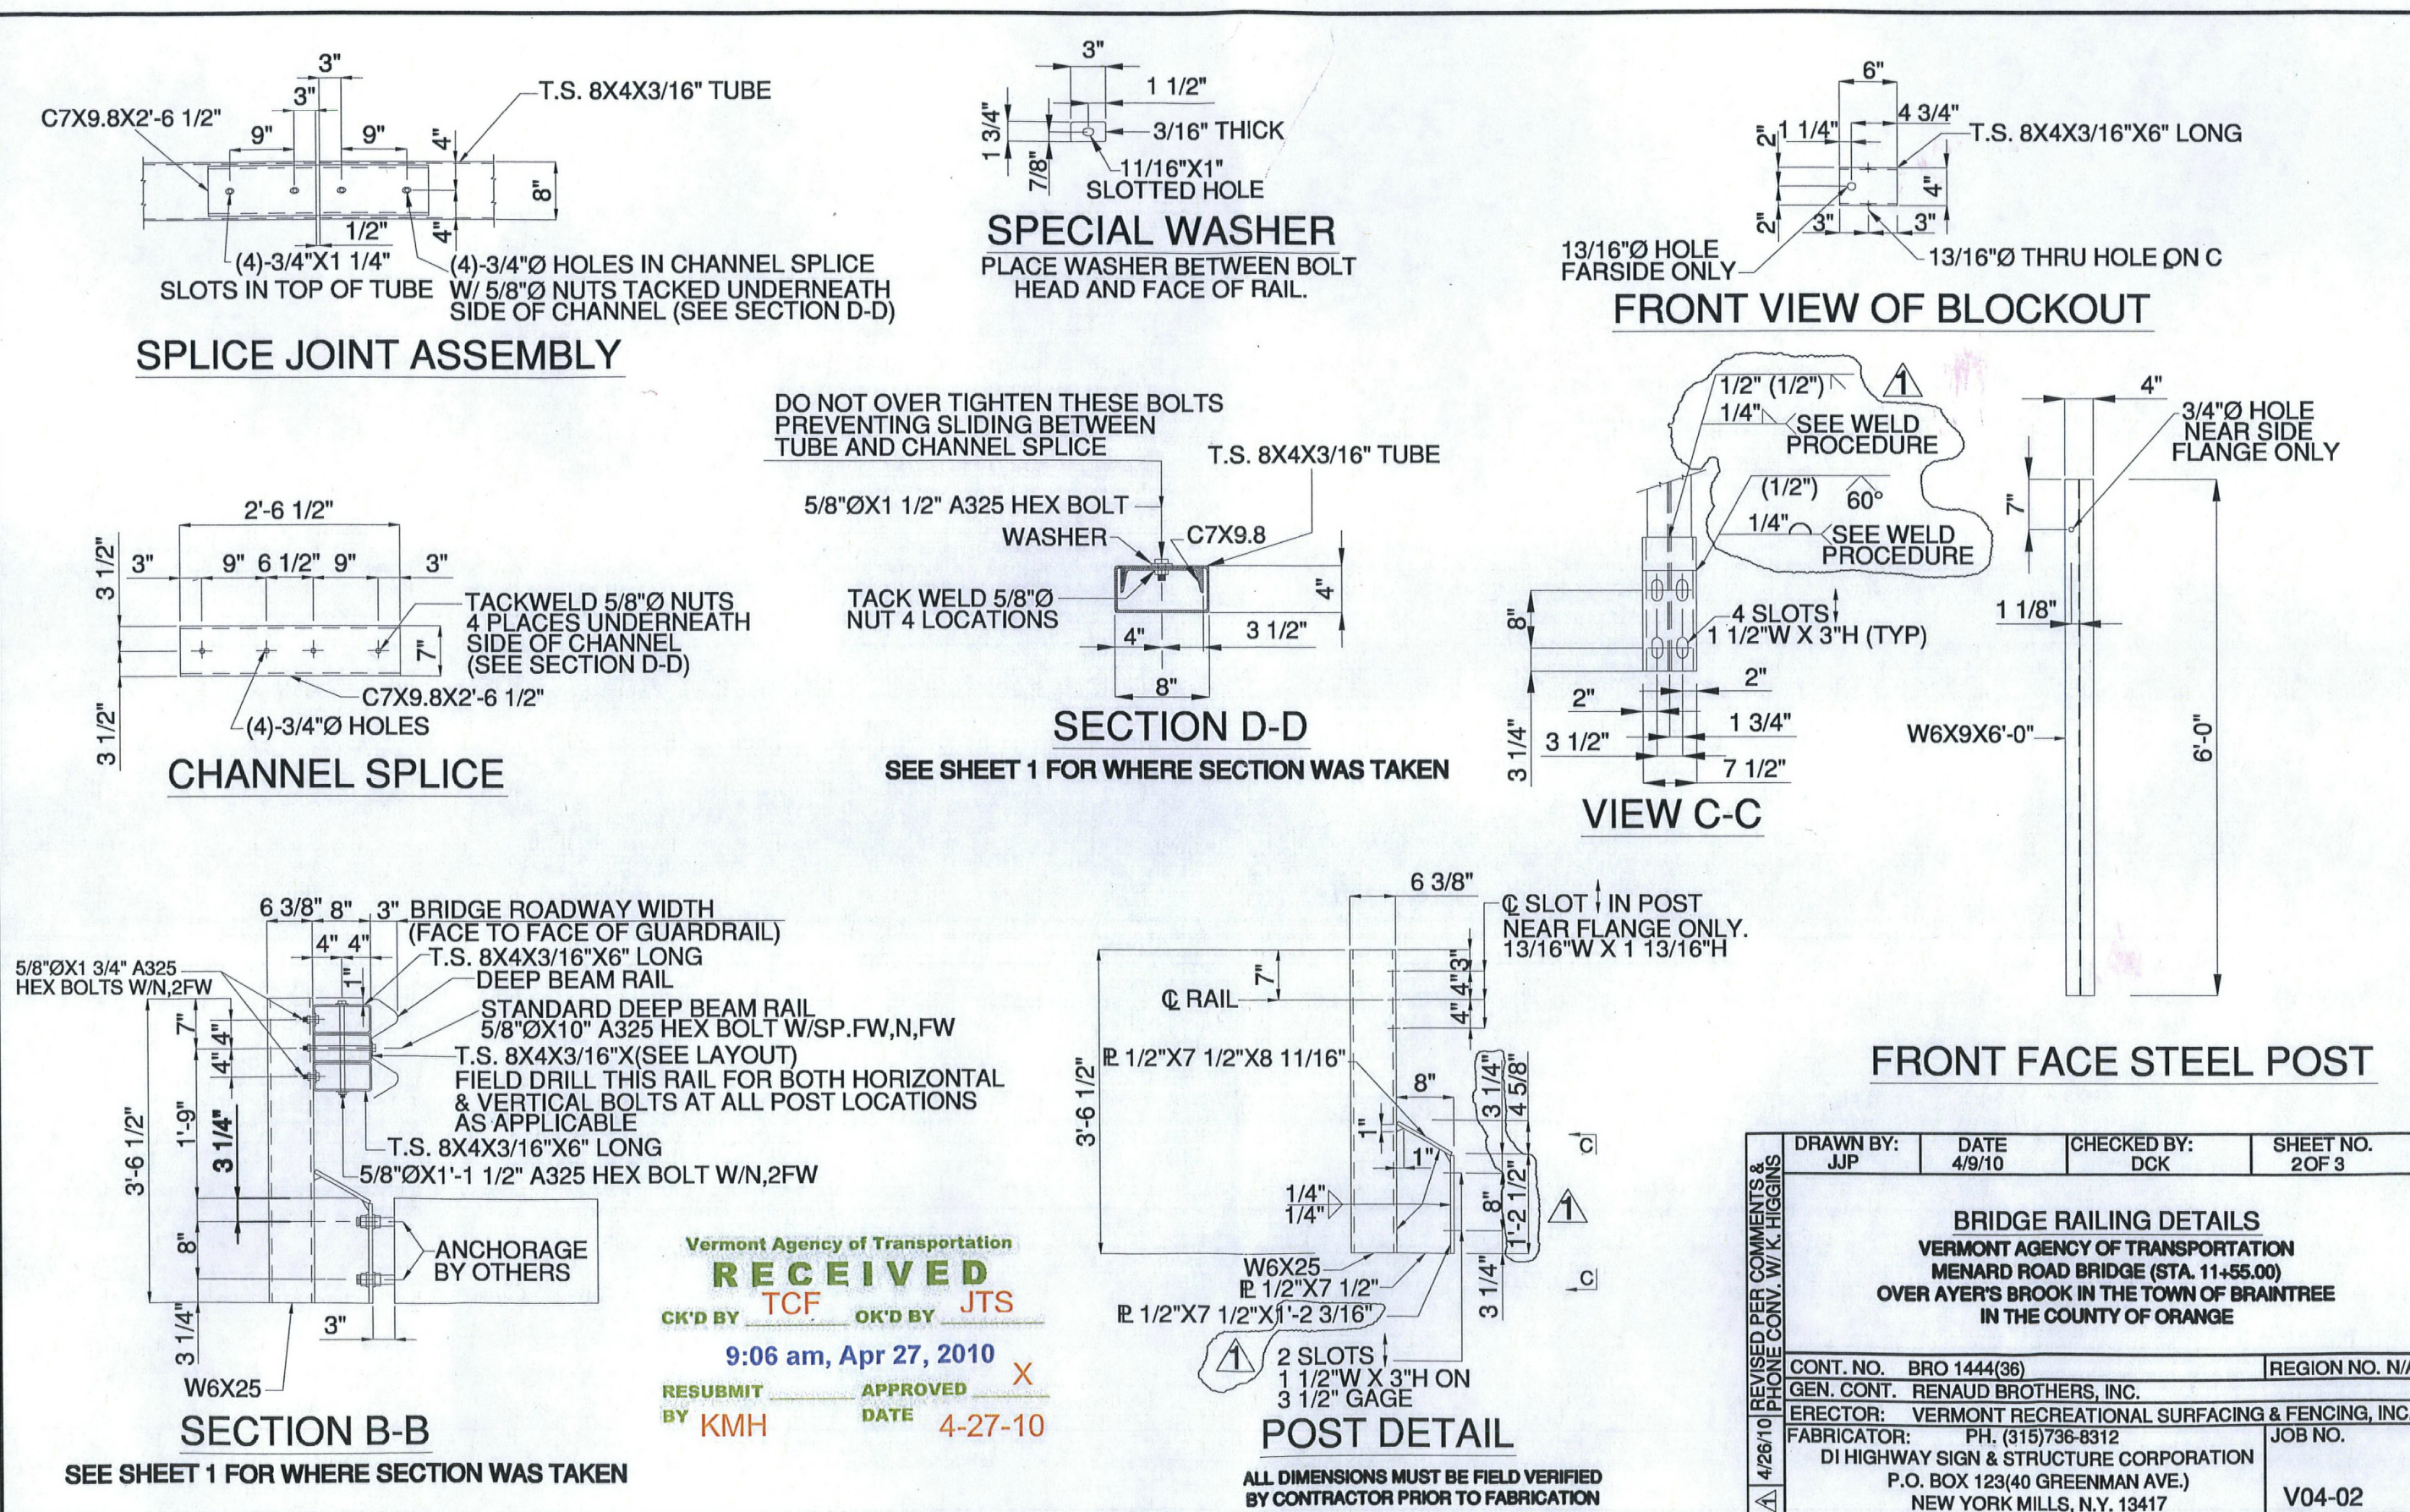

Vermont Agency of Transportation
RECEIVED
 CHK'D BY TCF OK'D BY JTS
 9:06 am, Apr 27, 2010
 RESUBMIT APPROVED X
 BY KMH DATE 4-27-10

DRAWN BY: JJP	DATE 4/9/10	CHECKED BY: DCK	SHEET NO. 2 OF 3
BRIDGE RAILING DETAILS VERMONT AGENCY OF TRANSPORTATION MENARD ROAD BRIDGE (STA. 11+55.00) OVER AYER'S BROOK IN THE TOWN OF BRAINTREE IN THE COUNTY OF ORANGE			
CONT. NO. BRO 1444(36)		REGION NO. N/A	
GEN. CONT. RENAUD BROTHERS, INC.			
ERECTOR: VERMONT RECREATIONAL SURFACING & FENCING, INC.			
FABRICATOR: PH. (515) 786-8312		JOB NO.	
DI HIGHWAY SIGN & STRUCTURE CORPORATION		P.O. BOX 123(40 GREENMAN AVE.)	
NEW YORK MILLS, N.Y. 13417		V04-02	

040 Bridge Rail

FASCIA MOUNTED WITHOUT CURB NOTES

1. HEAVY DUTY STEEL BEAM GUARD RAIL SHALL CONFORM TO VT. SPECIFICATION SECTION 732.
2. STRUCTURAL STEEL TUBING SHALL CONFORM TO VT. SPECIFICATION SECTION 732 GALVANIZED AFTER FABRICATION IN ACCORDANCE WITH (AASHTO M111) ASTM A123.
3. BRIDGE RAIL POSTS, SPECIAL WASHERS, PLATE WASHERS AND SPLICE BARS SHALL CONFORM TO (AASHTO M223) A572 GR50 GALVANIZED AFTER FABRICATION IN ACCORDANCE WITH (AASHTO M111) ASTM A123.
4. ALL BOLTS AND RELATED HARDWARE SHALL CONFORM TO (AASHTO M164) ASTM A325 TYPE 1 BOLTS, HOT DIPPED OR MECHANICALLY GALVANIZED PER SPECIFICATION.
5. ALL POSTS SHALL BE SET NORMAL GRADE.
6. SPLICES FOR THE STEEL BEAM GUARD RAIL SHALL LAP IN THE DIRECTION OF TRAFFIC.
7. ALL FIELD CUT OR DRILLED AREAS SHALL BE REPAIRED PER SECTION 813.
8. ALL FLAT WASHERS SHALL CONFORM TO ASTM F436. A
9. ALL NUTS SHALL CONFORM TO ASTM A563, GRADE H. A

BILL OF MATERIAL						
MARK OR USE	QTY.	SHAPE	SHAPE		REMARKS	
			FT.	IN.		
* RAIL	2	T.S. 8"x4"x3/16" WALL	35	11 1/2	ASTM A500GRB	
* RAIL	2	T.S. 8"x4"x3/16" WALL	29	6	ASTM A500GRB	
* RAIL	4	T.S. 8"x4"x3/16" WALL	5	0 1/2	ASTM A500GRB	
CHANNEL SPLICE	6	C7X9.8	2	6 1/2	ASTM A36	W/4-5/8" H.S. NUTS
SPLICE BOLT	24	5/8" HEX BOLT	1	1 1/2	ASTM A325(AASHTO M164)TYPE1 W/FW	
BLOCKOUT	44	T.S. 8"x4"x3/16" WALL		6	ASTM A500GRB	
BLOCKOUT BOLT	44	5/8" HEX BOLT		1 3/4	ASTM A325(AASHTO M164)TYPE1 W/N,2FW	
POST BOLT	30	5/8" HEX BOLT		10	ASTM A325(AASHTO M164)TYPE1 W/SP,FW,N,FW	
RAIL BOLT	22	5/8" HEX BOLT		1 1/2	ASTM A325(AASHTO M164)TYPE1 W/N,2FW	
CORRUGATED RAIL	12	10 GAGE CORRUGATED	13	6	(AASHTO M180 CLASS B, TYPE 2) A	
POST ASSY.	22					
FASCIA PLATE	22	PL 1/2"x7 1/2"	1	2 3/16	ASTM A36(AASHTO M183)	
TOP PLATE	22	PL 1/2"x7 1/2"		6 11/16	ASTM A36(AASHTO M183)	
WEB PLATE	22	PL 1/2"x7 1/2"	AS REQ'D		ASTM A36(AASHTO M183)	
POST	22	W6X25	3	6 1/2	ASTM A572 GR50(AASHTO M223)	
POST	8	W6X9	6	0	ASTM A709 GR36(AASHTO M270 GR 250) A	
CORRUGATED BOLT	96	5/8" BUTT ON HEAD OVAL SHOULDER CORRUGATED SPLICE BOLT		1 1/4	ASTM A307 W/DL,REC. N	

* THE DROP-WEIGHT TEAR TEST IN SECTION 732 SHALL NOT APPLY TO THE STRUCTURAL TUBING.

Vermont Agency of Transportation
RECEIVED

OK'D BY TCF OK'D BY JTS

1:43 pm, Apr 27, 2010

RESUBMIT APPROVED
BY KMH DATE 4-27-10

ALL DIMENSIONS MUST BE FIELD VERIFIED BY CONTRACTOR PRIOR TO FABRICATION

PAY LIMIT FOR SPECIAL PROVISION RAIL=150,000FT.(APPROX.)

DRAWN BY: JJP	DATE 4/9/10	CHECKED BY: DCK	SHEET NO. 3 OF 3
BRIDGE RAILING LAYOUT B.O.M VERMONT AGENCY OF TRANSPORTATION MENARD ROAD BRIDGE (STA. 11+55.00) OVER AYERS BROOK IN THE TOWN OF BRANTREE IN THE COUNTY OF ORANGE			
CONT. NO. BRO 1444(36)		REGION NO. N/A	
ERECTOR: VERMONT RECREATIONAL SURFACING & FENCING, INC.			
FABRICATOR: DI HIGHWAY SIGN & STRUCTURE CORPORATION P.O. BOX 123(40 GREENMAN AVE.) NEW YORK MILLS, N.Y. 13417		JOB NO. V04-02	

041 Bridge Rail