




2+75

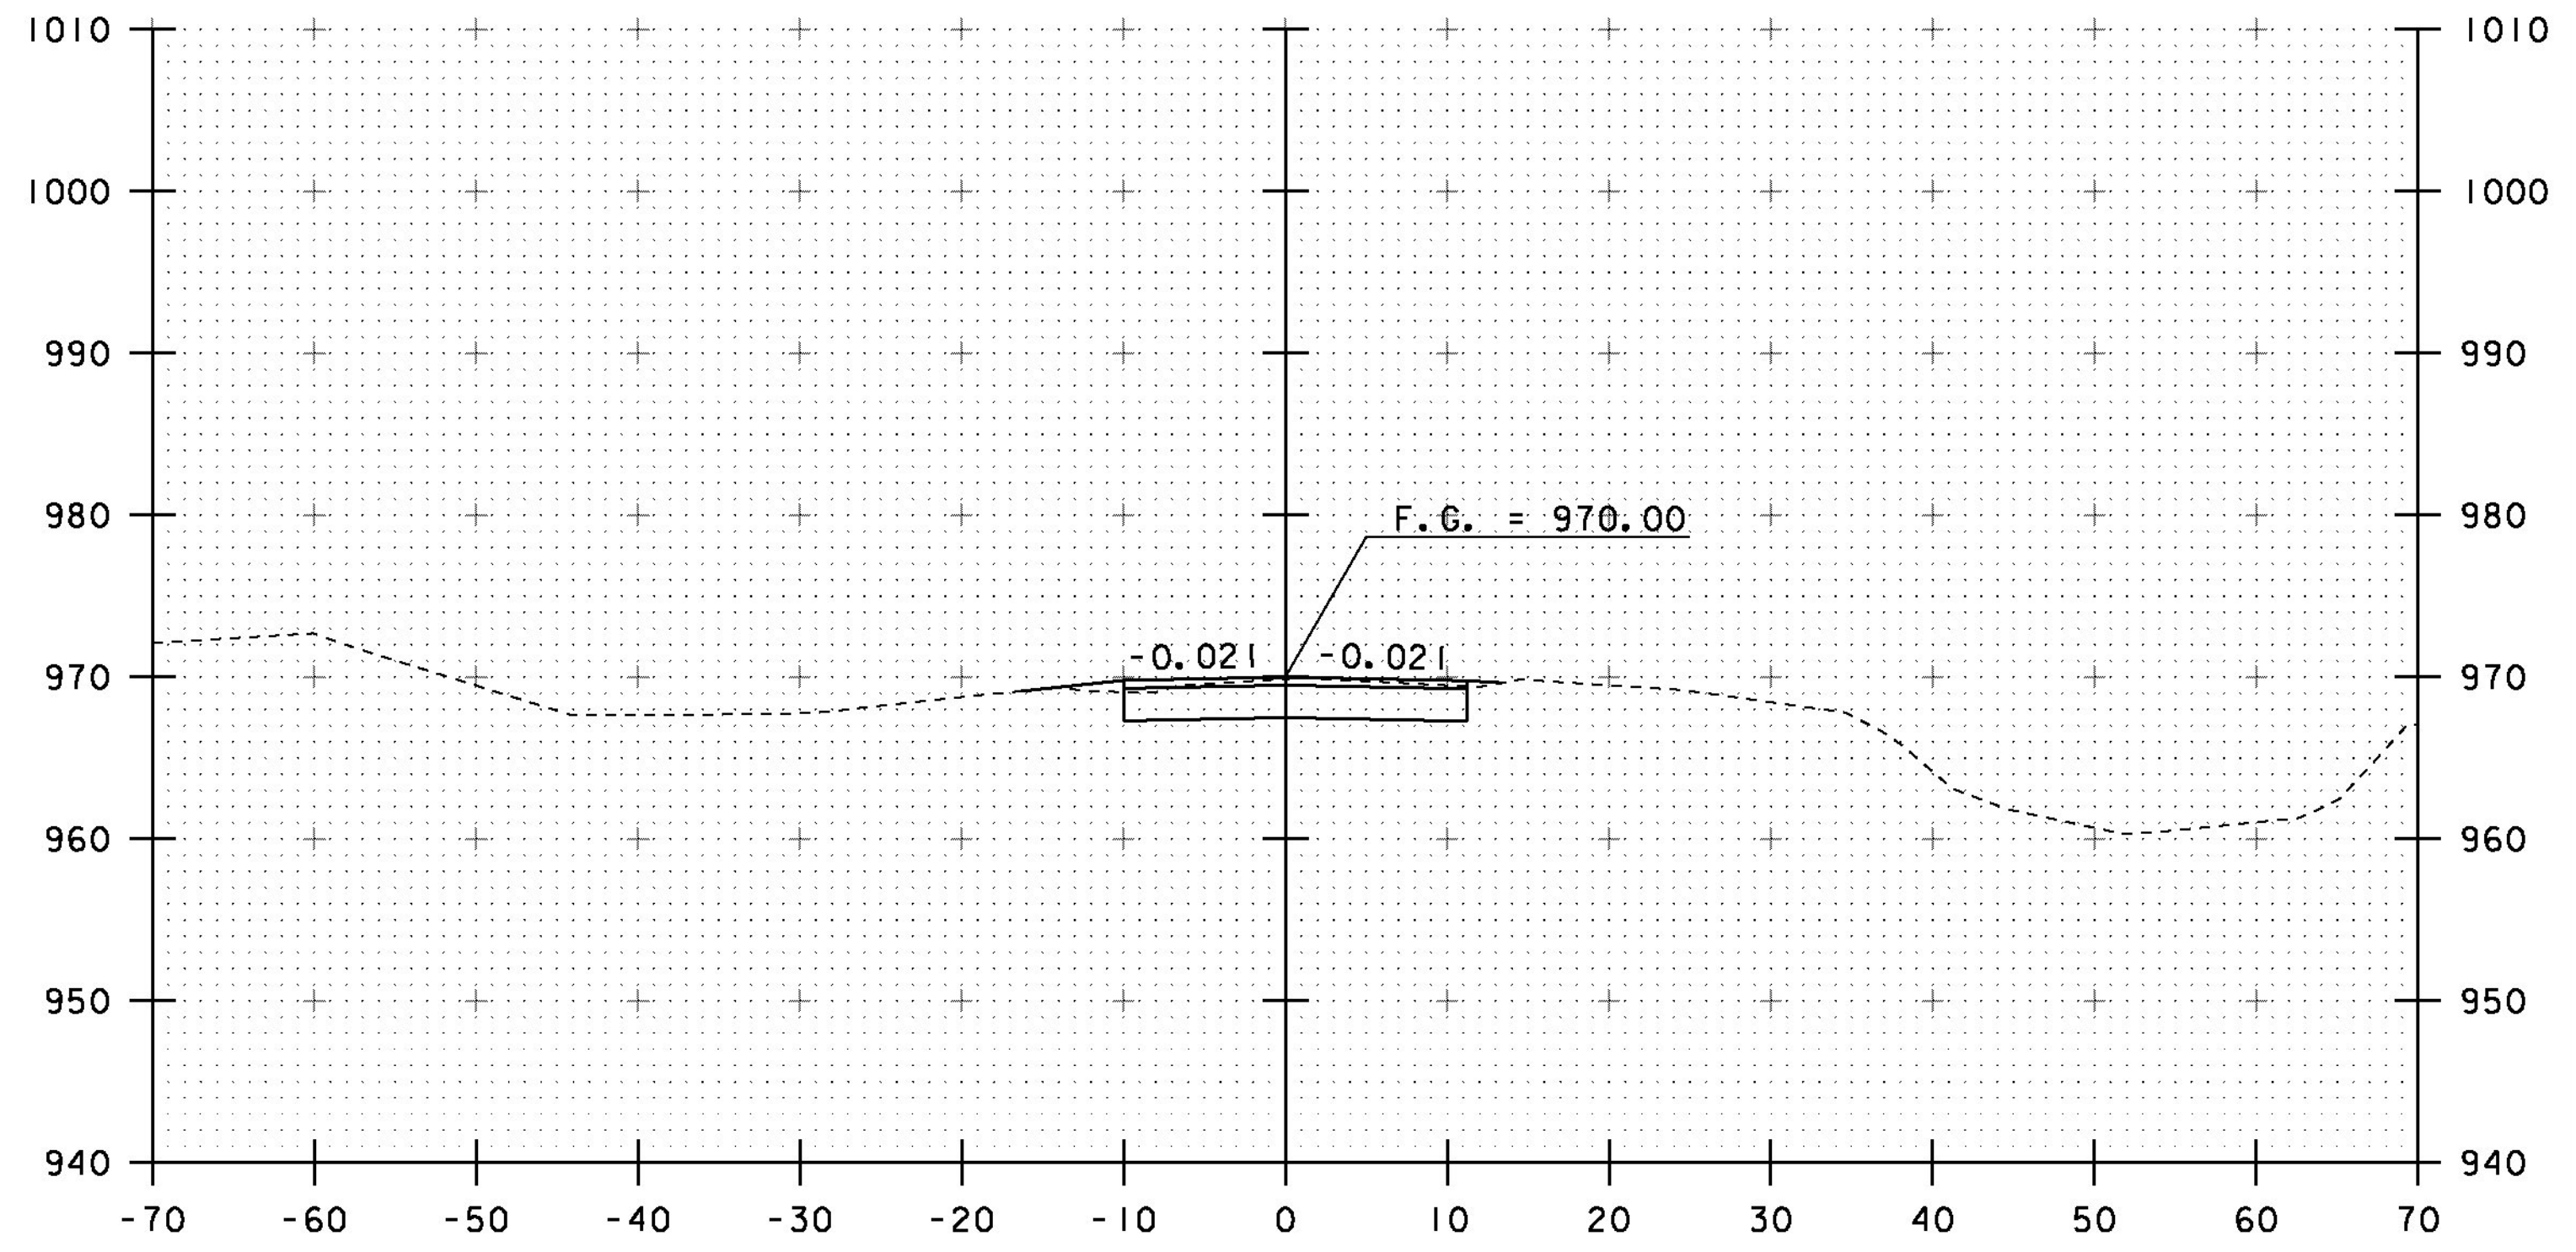

3+25

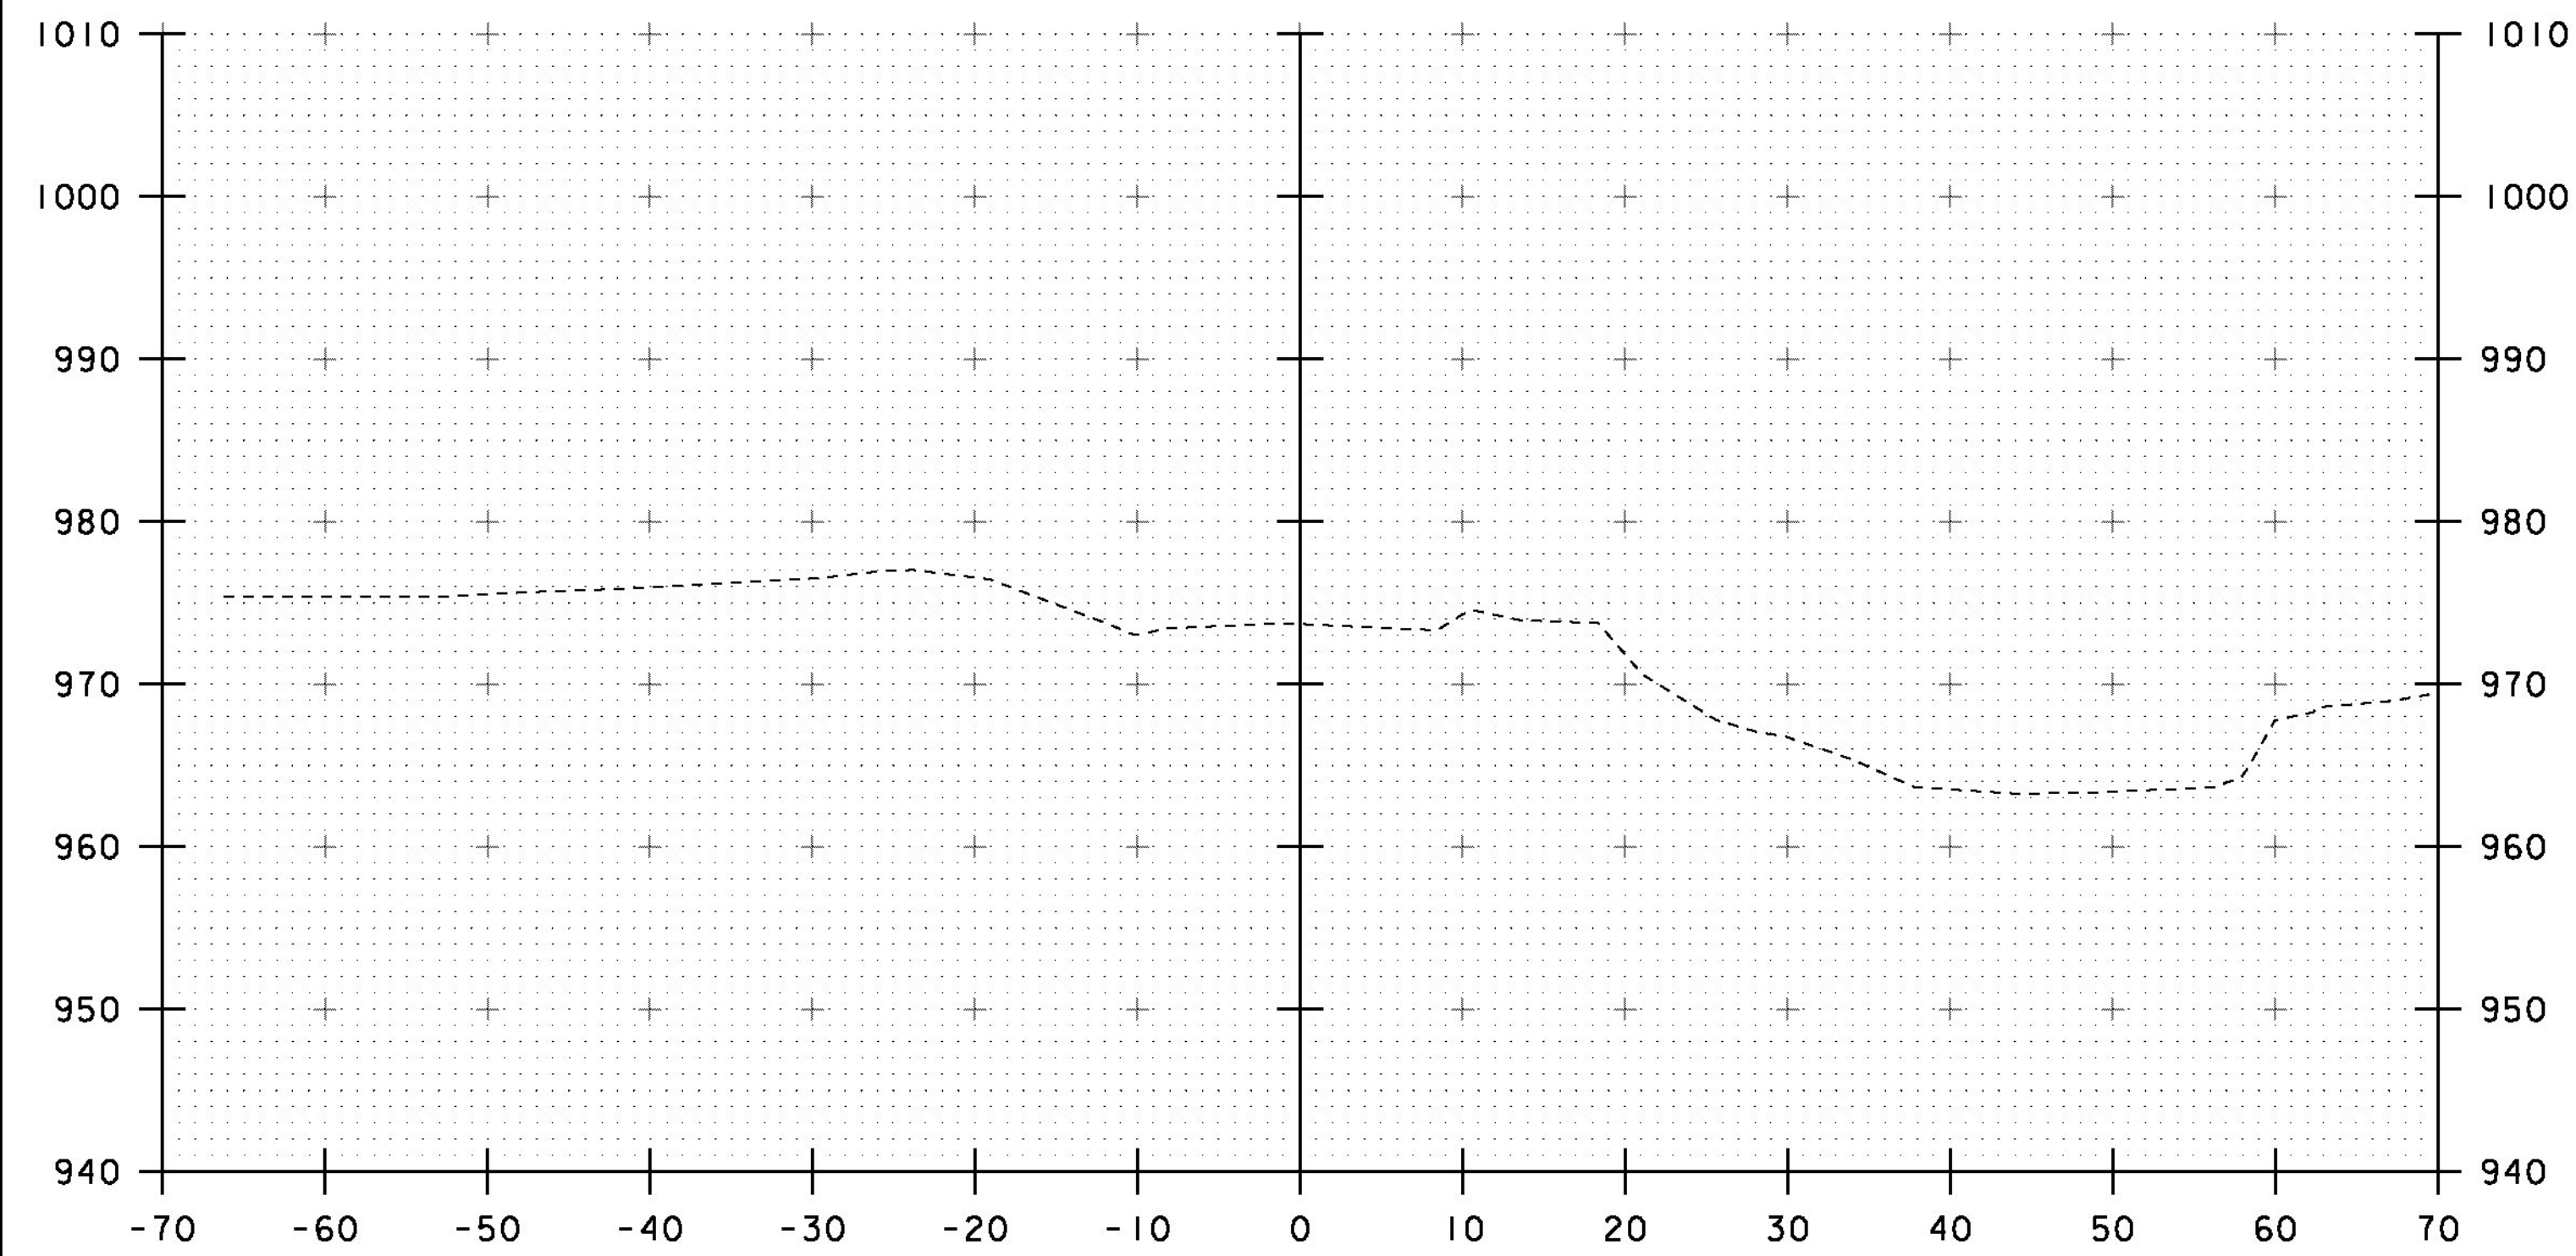

2+50

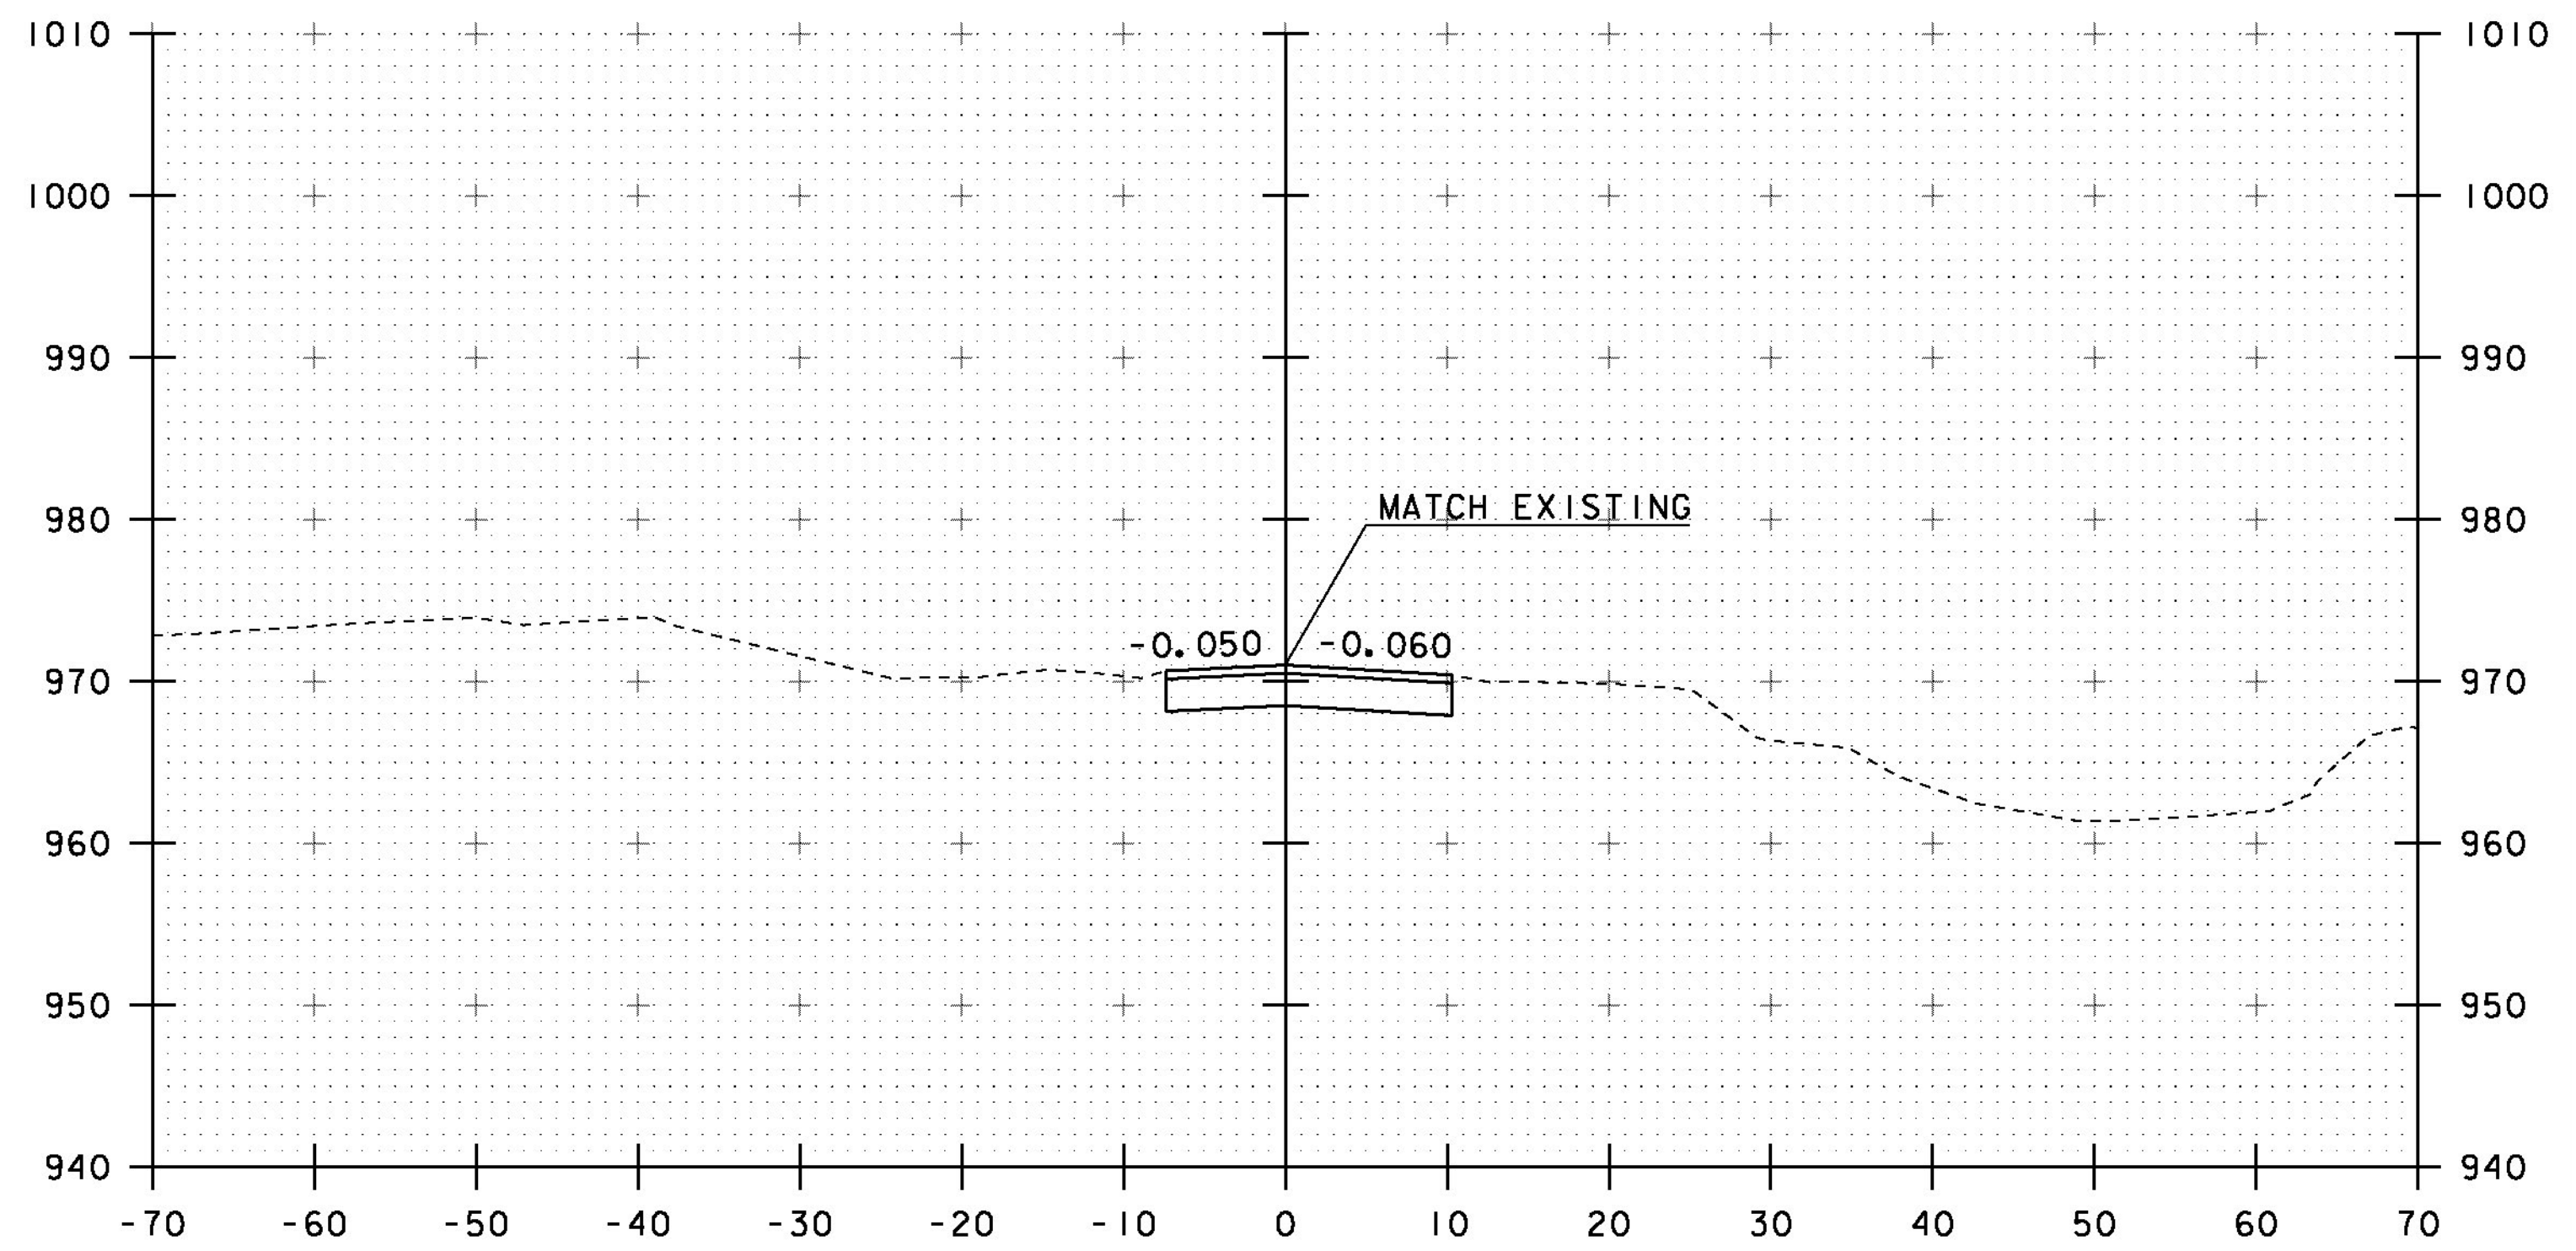

3+00
BEGIN APPROACH

STA. 2+50 TO STA. 3+25

PROJECT NAME:	WOODSTOCK	PLOT DATE:	13-FEB-2013
PROJECT NUMBER:	BRO 1444(55)	DRAWN BY:	J. SALVATORI
FILE NAME:	s95j294xsl.dgn	DESIGNED BY:	J. SALVATORI
PROJECT LEADER:	K.M. HIGGINS	CHECKED BY:	W. LAMMER
DESIGNED BY:	J. SALVATORI	MAINLINE SECTIONS:	1
		SHEET	21 OF 28