




5+50
END APPROACH

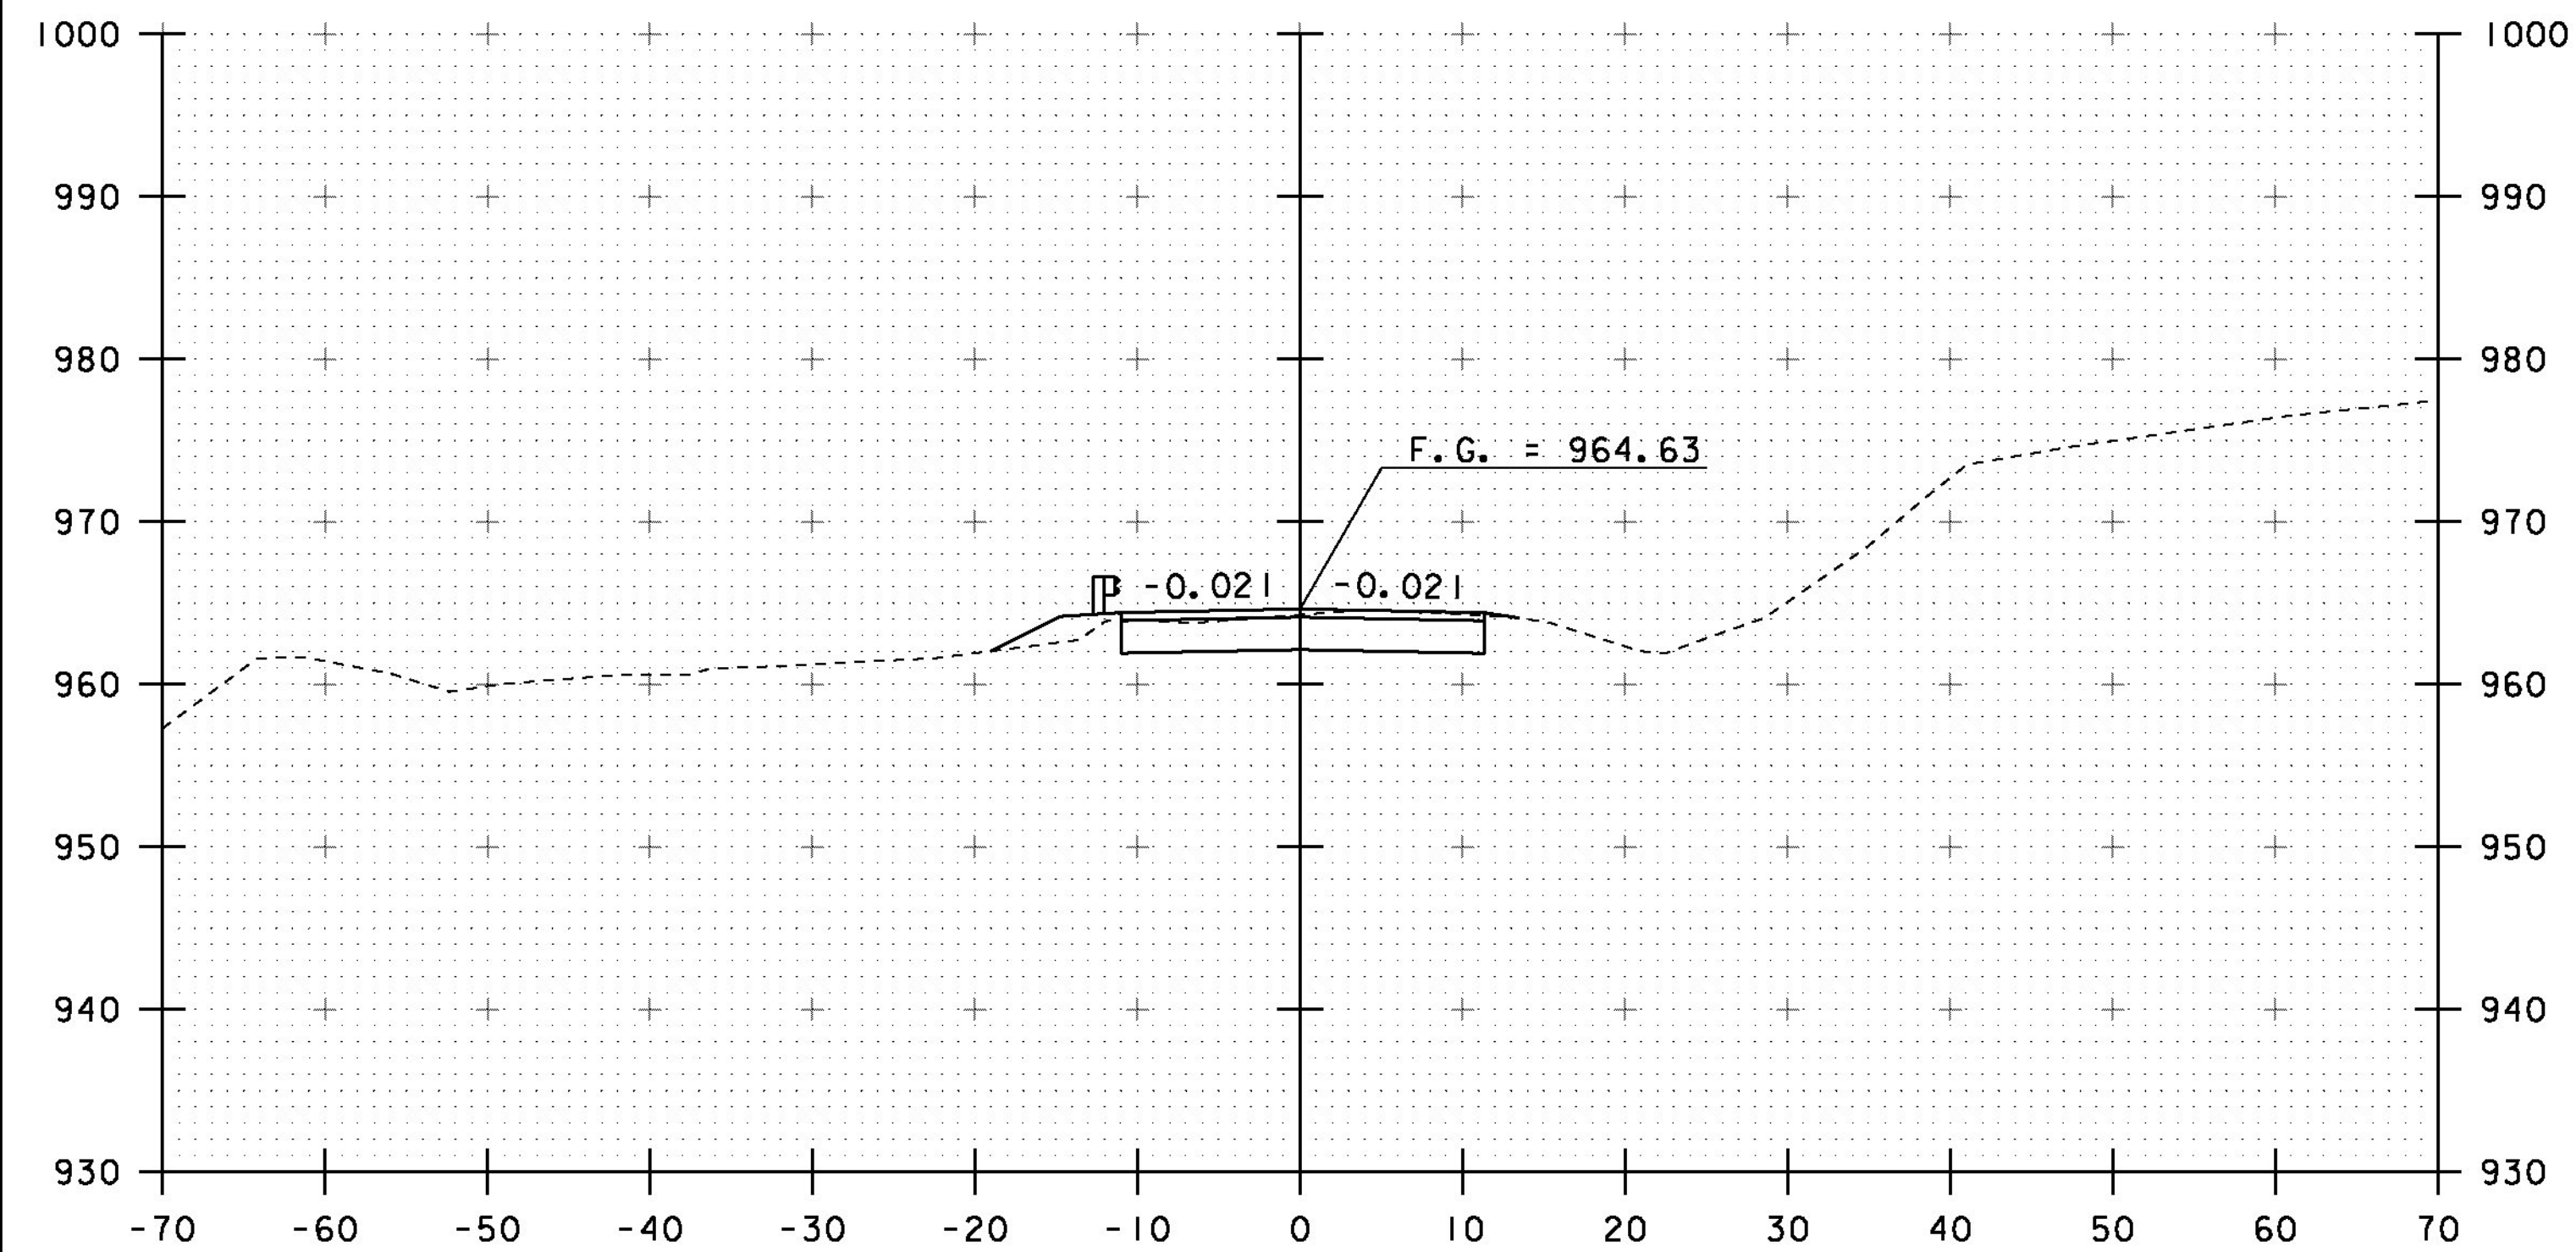

5+25

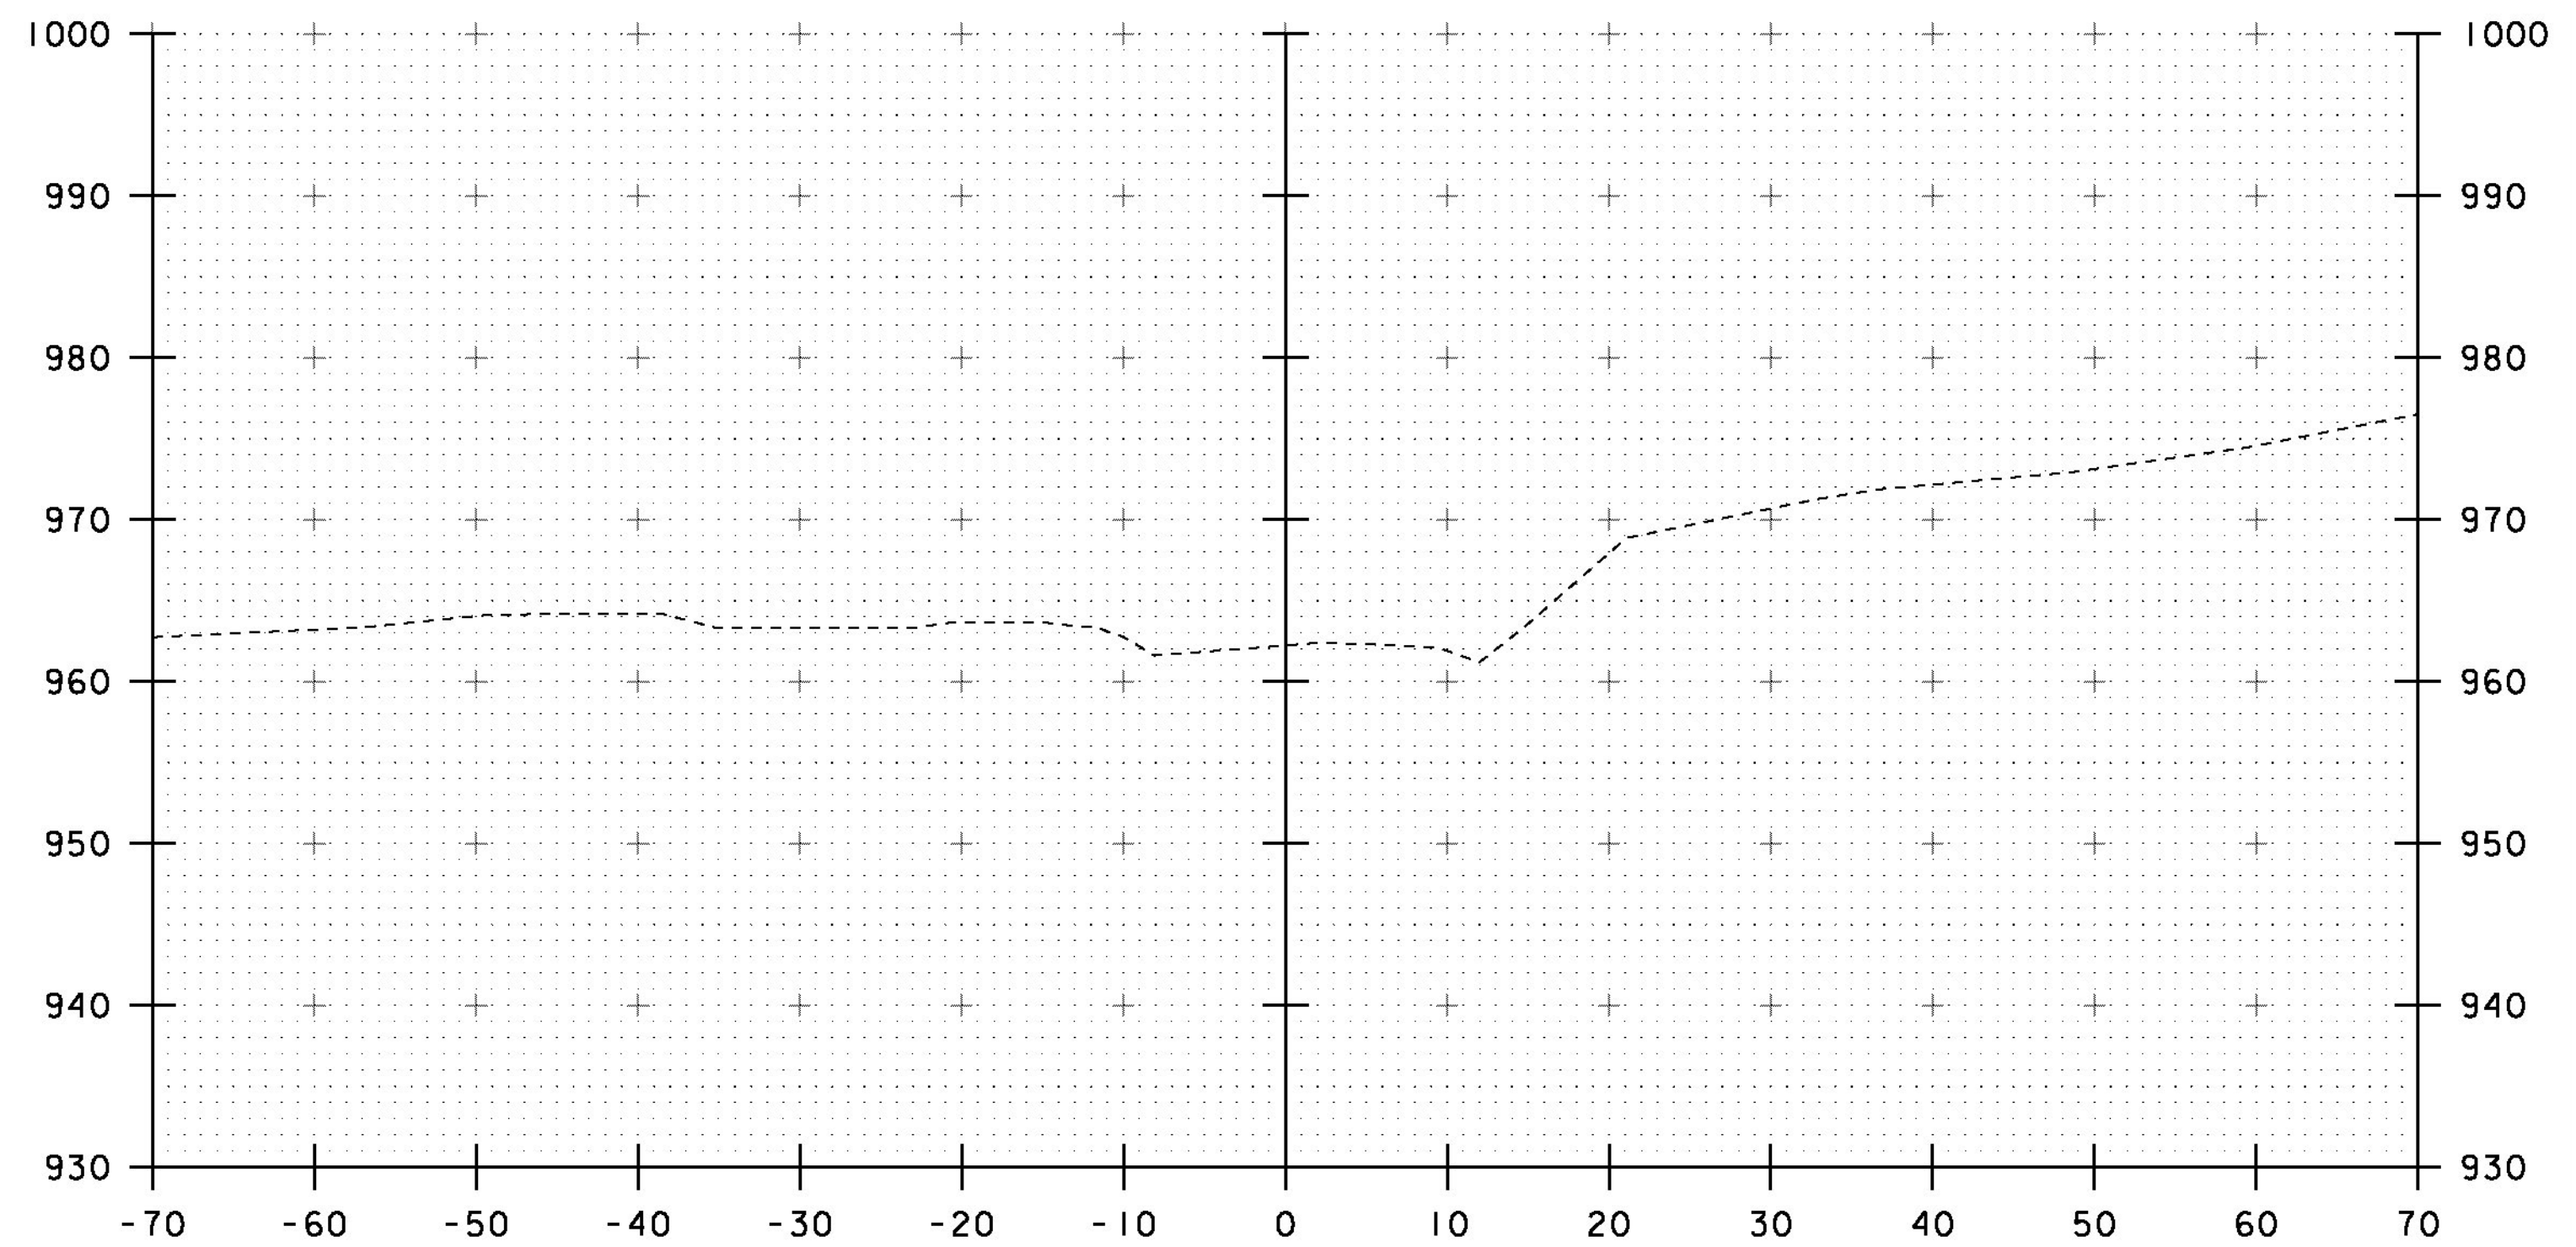

5+75

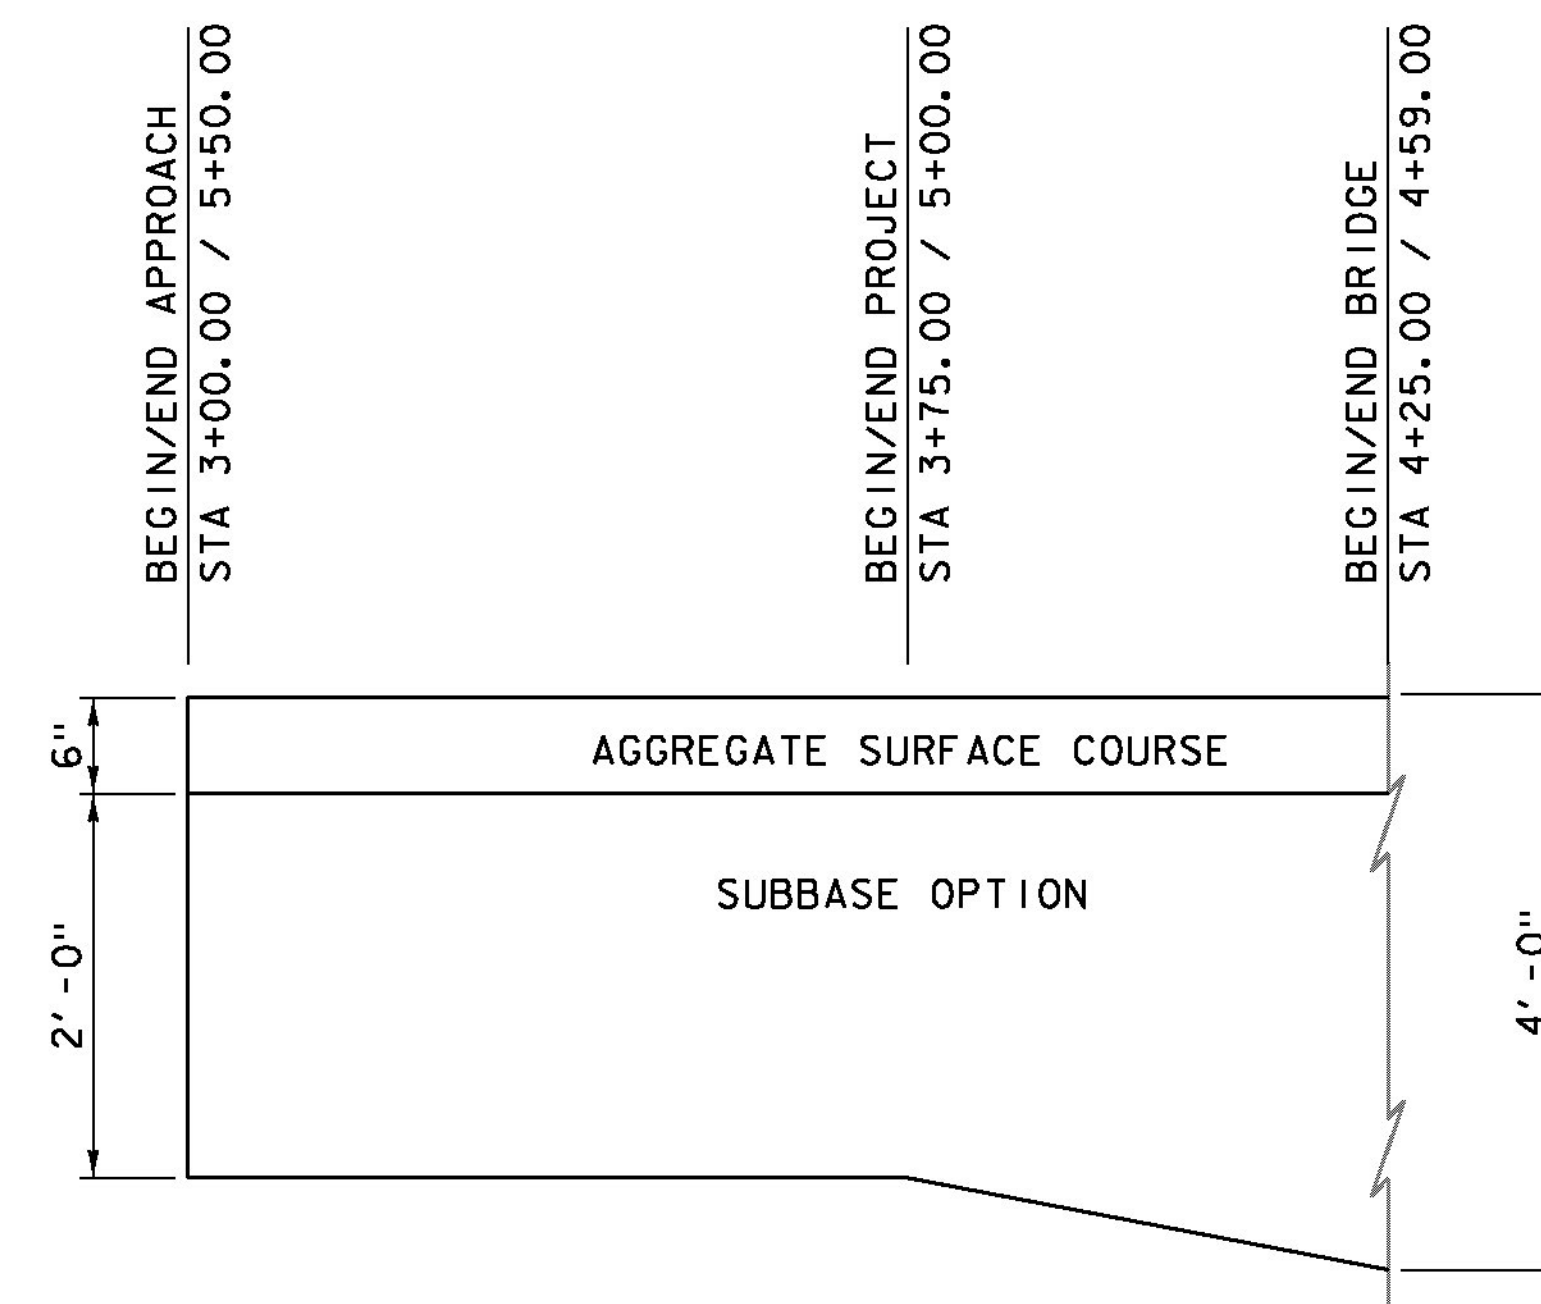

MATERIAL TRANSITION
NOT TO SCALE

STA. 5+25 TO STA. 5+75

PROJECT NAME:	WOODSTOCK	FILE NAME:	s95j294xsl.dgn	PLOT DATE:	18-FEB-2013
PROJECT NUMBER:	BRO 1444(55)	PROJECT LEADER:	K.M. HIGGINS	DRAWN BY:	J. SALVATORI
		DESIGNED BY:	J. SALVATORI	CHECKED BY:	W. LAMMER
		MAINLINE SECTIONS 4		SHEET	24 OF 28