


STATE OF VERMONT AGENCY OF TRANSPORTATION

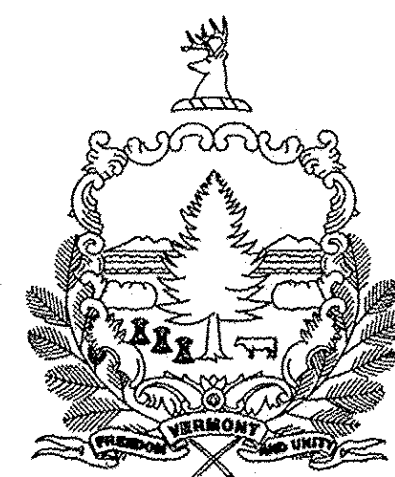

PROPOSED IMPROVEMENT BRIDGE PROJECT



TOWN OF COLCHESTER
COUNTY OF CHITTENDEN

ROUTE NO : TH 27 (URBAN COLLECTOR) BRIDGE NO : 12


PROJECT LOCATION : PROJECT IS LOCATED AT THE TH27 CROSSING OVER THE INDIAN BROOK ON THE NORTH END OF MILL POND ROAD AND ADJACENT TO THE MILL POND DAM. THE BRIDGE IS 0.4 MILES SOUTH OF THE VERMONT 2A & TH27 INTERSECTION.

PROJECT DESCRIPTION : PROJECT IS FOR REPLACEMENT OF BRIDGE NO. 12 ON TH27 INCLUDING APPROACH ROADWAY AND CHANNEL WORK.

LENGTH OF STRUCTURE : 74.00 FEET
LENGTH OF ROADWAY : 326.00 FEET
LENGTH OF PROJECT : 400.00 FEET

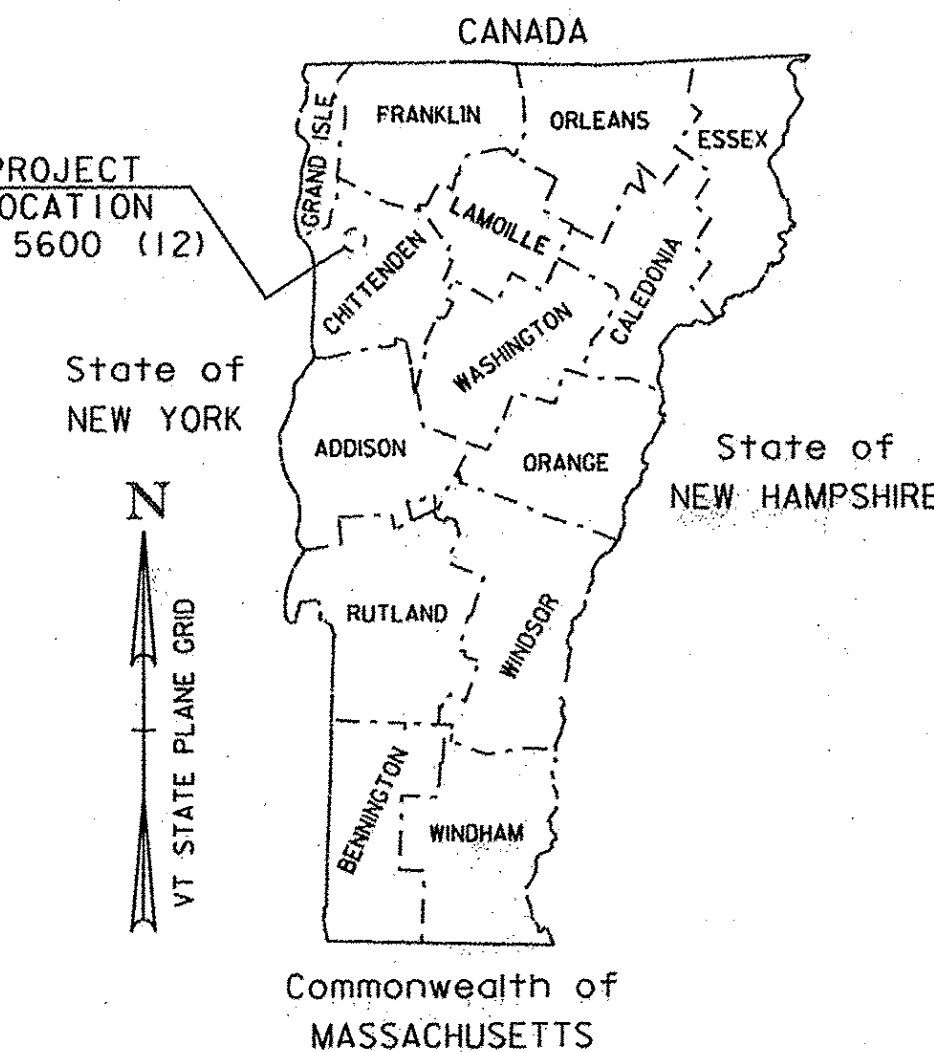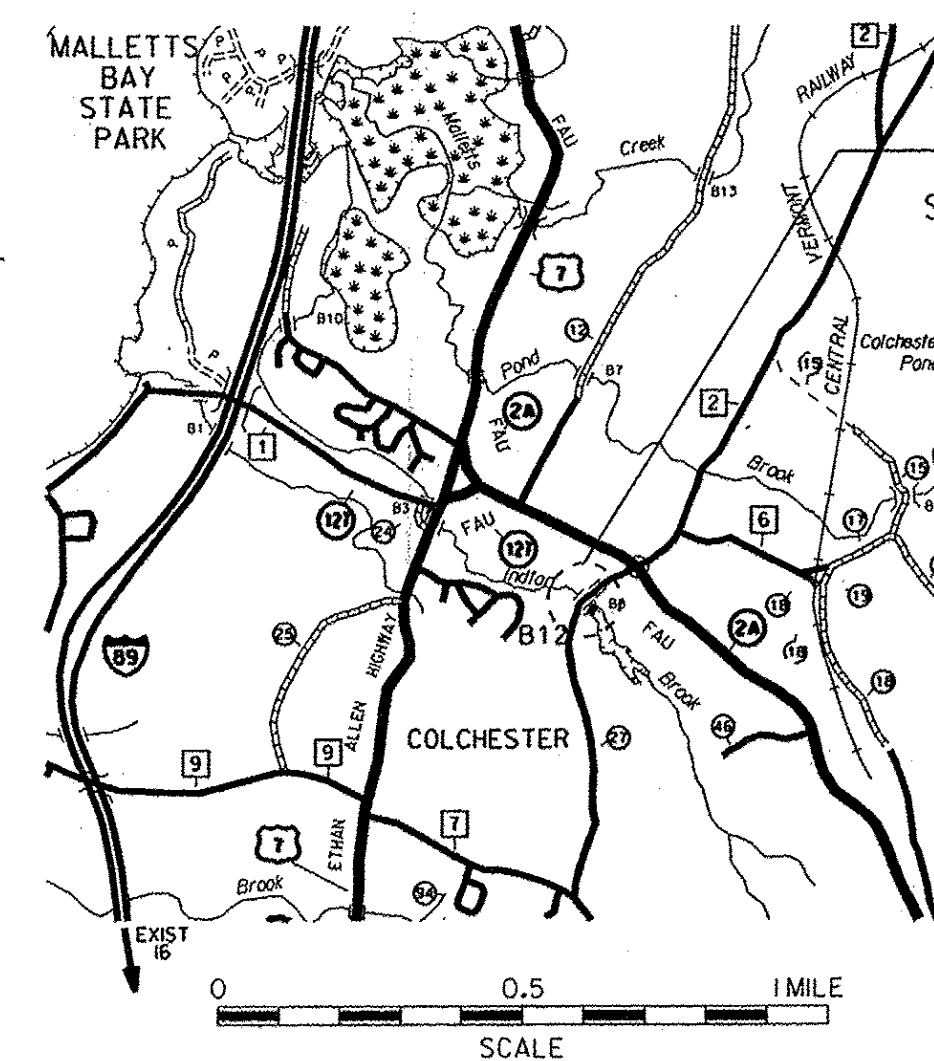

| RECORD PLANS | |
|--|--|
| CONTRACTOR: | A. L. ST. ONGE CONTRACTOR, INC. - MONTGOMERY, VT |
| RESIDENT ENGINEER: | JOSH HULETT |
| CONSTRUCTION BEGAN: | APRIL 13, 2015 |
| CONSTRUCTION COMPLETE: | OCTOBER 1, 2015 |
| RECORD PLANS BY: | JOSH HULETT & AARON JAMES |
| I HEREBY CERTIFY THAT ALL THE CONSTRUCTION REQUIRED BY THIS SET OF DRAWINGS HAS BEEN ACCOMPLISHED AS INDICATED HEREIN. | |
| BY | <i>Josh Hulett</i> RESIDENT ENGINEER |
| DATE | <i>June 20, 2016</i> |
| NOTE: Any further information concerning final quantities, amounts or other details relative to this project may be found at Central Files in the electronic archives. | |

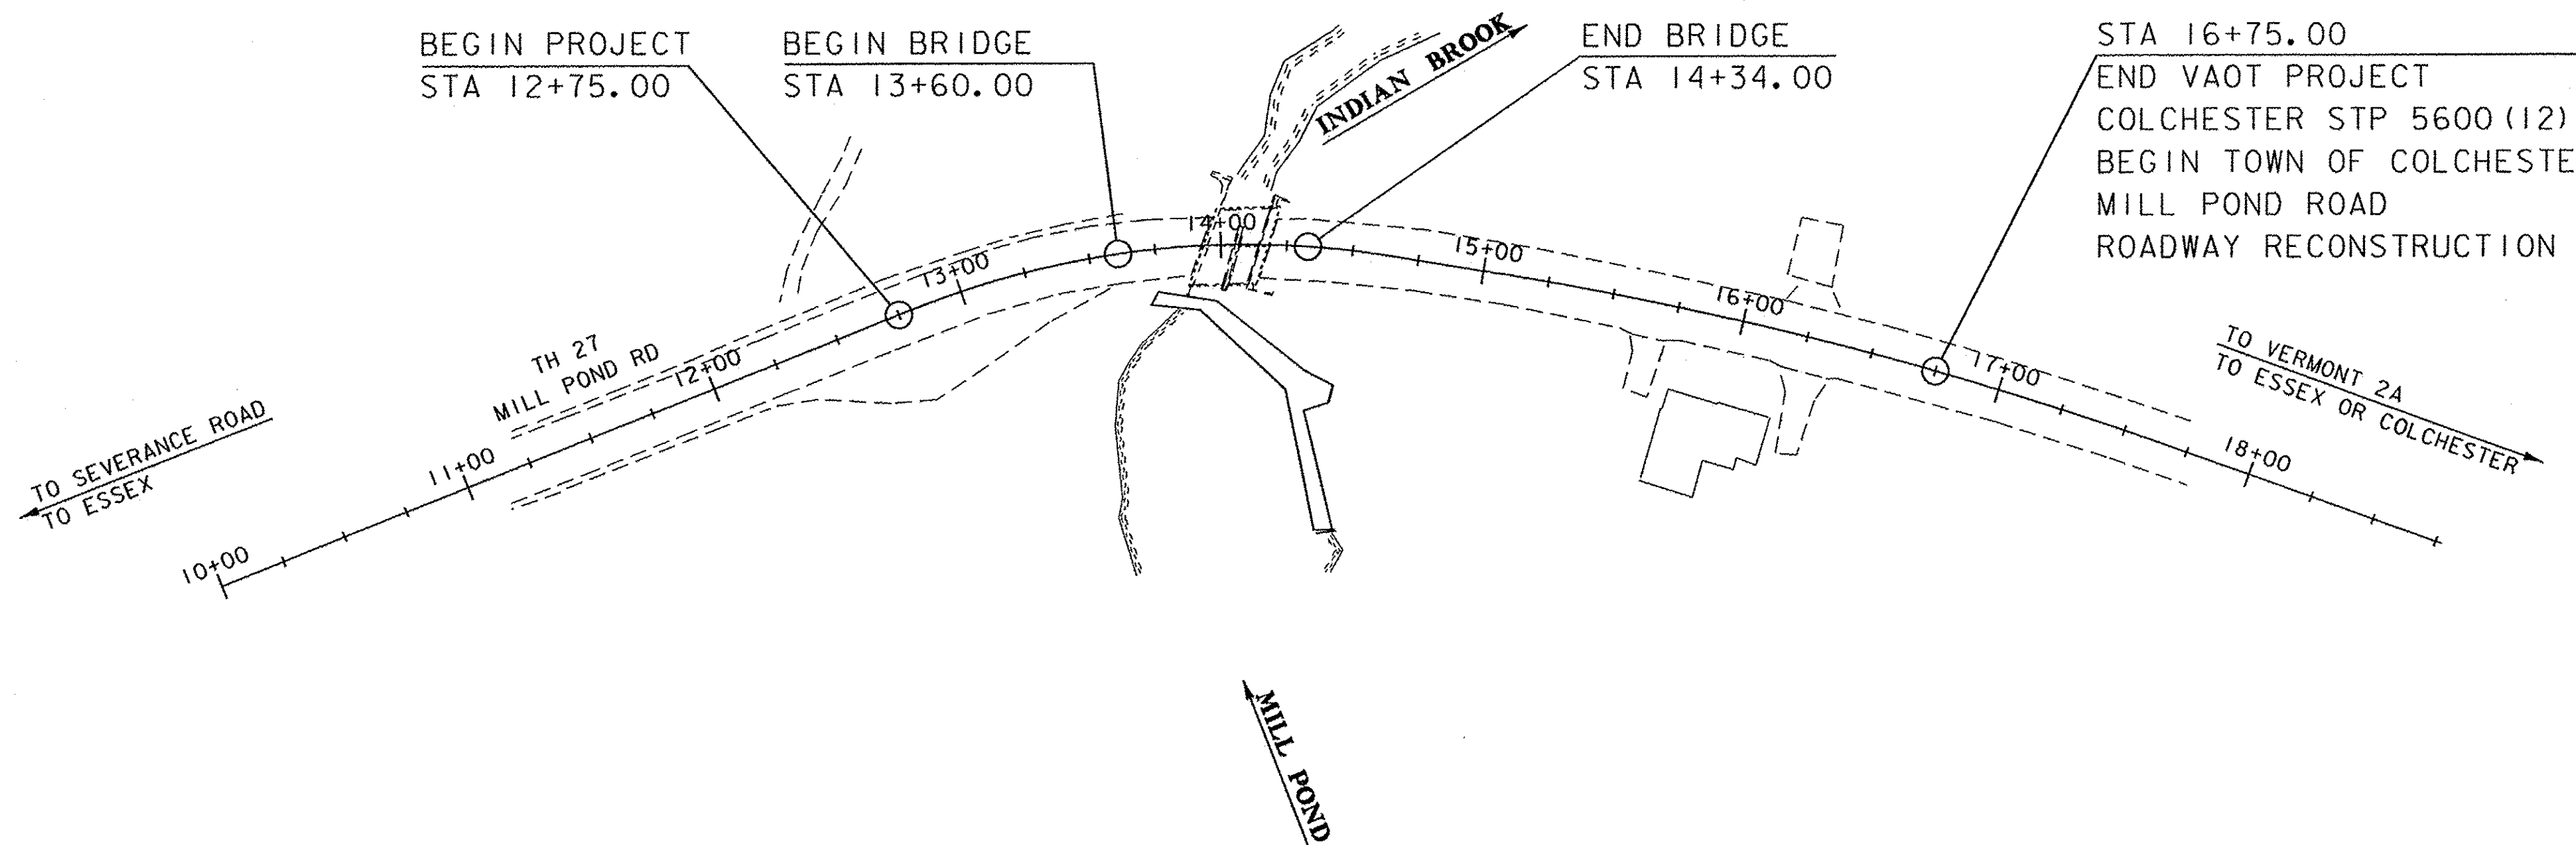

SCALE 1" = 50'-0"
50 0 50

CONSTRUCTION IS TO BE CARRIED ON IN ACCORDANCE WITH THESE PLANS AND THE STANDARD SPECIFICATIONS FOR CONSTRUCTION DATED 2011, AS APPROVED BY THE FEDERAL HIGHWAY ADMINISTRATION ON JULY 20, 2011 FOR USE ON THIS PROJECT, INCLUDING ALL SUBSEQUENT REVISIONS AND SUCH REVISED SPECIFICATIONS AND SPECIAL PROVISIONS AS ARE INCORPORATED IN THESE PLANS.

| | |
|-------------------------------------|---------------|
| QUALITY ASSURANCE PROGRAM : LEVEL 2 | |
| SURVEYED BY : | R. D. GILMAN |
| SURVEYED DATE : | 07-09-1997 |
| DATUM | |
| VERTICAL | NAVD 88 |
| HORIZONTAL | NAD 83 (1992) |

| | |
|--|----------------------|
| DIRECTOR OF PROJECT DELIVERY | |
| APPROVED <i>J. H. [Signature]</i> | DATE <i>1/9/2015</i> |
| PROJECT MANAGER : CAROLYN CARLSON, P. E. | |
| PROJECT NAME : | COLCHESTER |
| PROJECT NUMBER : | STP 5600 (12) |
| SHEET 1 OF 53 SHEETS | |