


PLAN
SCALE 1" = 10'

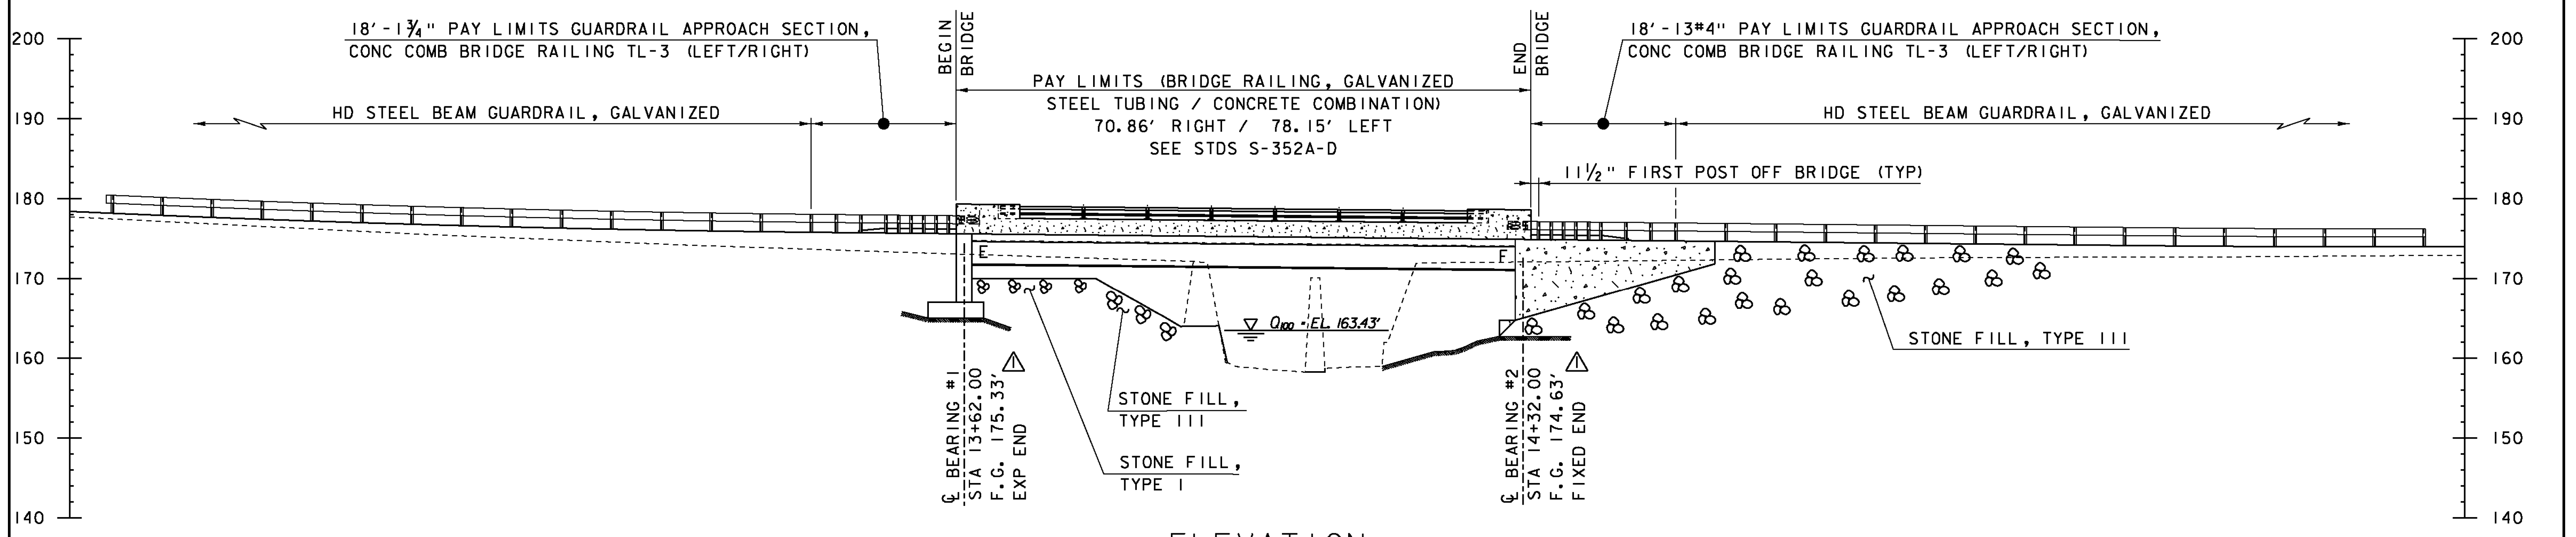

ELEVATION
SCALE 1" = 10'

KEY	DATE	BY	REVISION
△	09/01/2015	VAOT	MODIFIED FINISH GRADES & SIDEWALK WIDTH.

PROJECT NAME: COLCHESTER
 PROJECT NUMBER: STP 5600 (12)
 FILE NAME: s95j298pe.dgn
 PROJECT LEADER: C. CARLSON
 DESIGNED BY: N. VANDENBERG
 PLAN AND ELEVATION
 PLOT DATE: 01-SEP-2015
 DRAWN BY: G. ROKES
 CHECKED BY: D. PETERSON
 SHEET 22 OF 53