



**ABUTMENT #1 PLAN**

SCALE 1/4" = 1'-0"

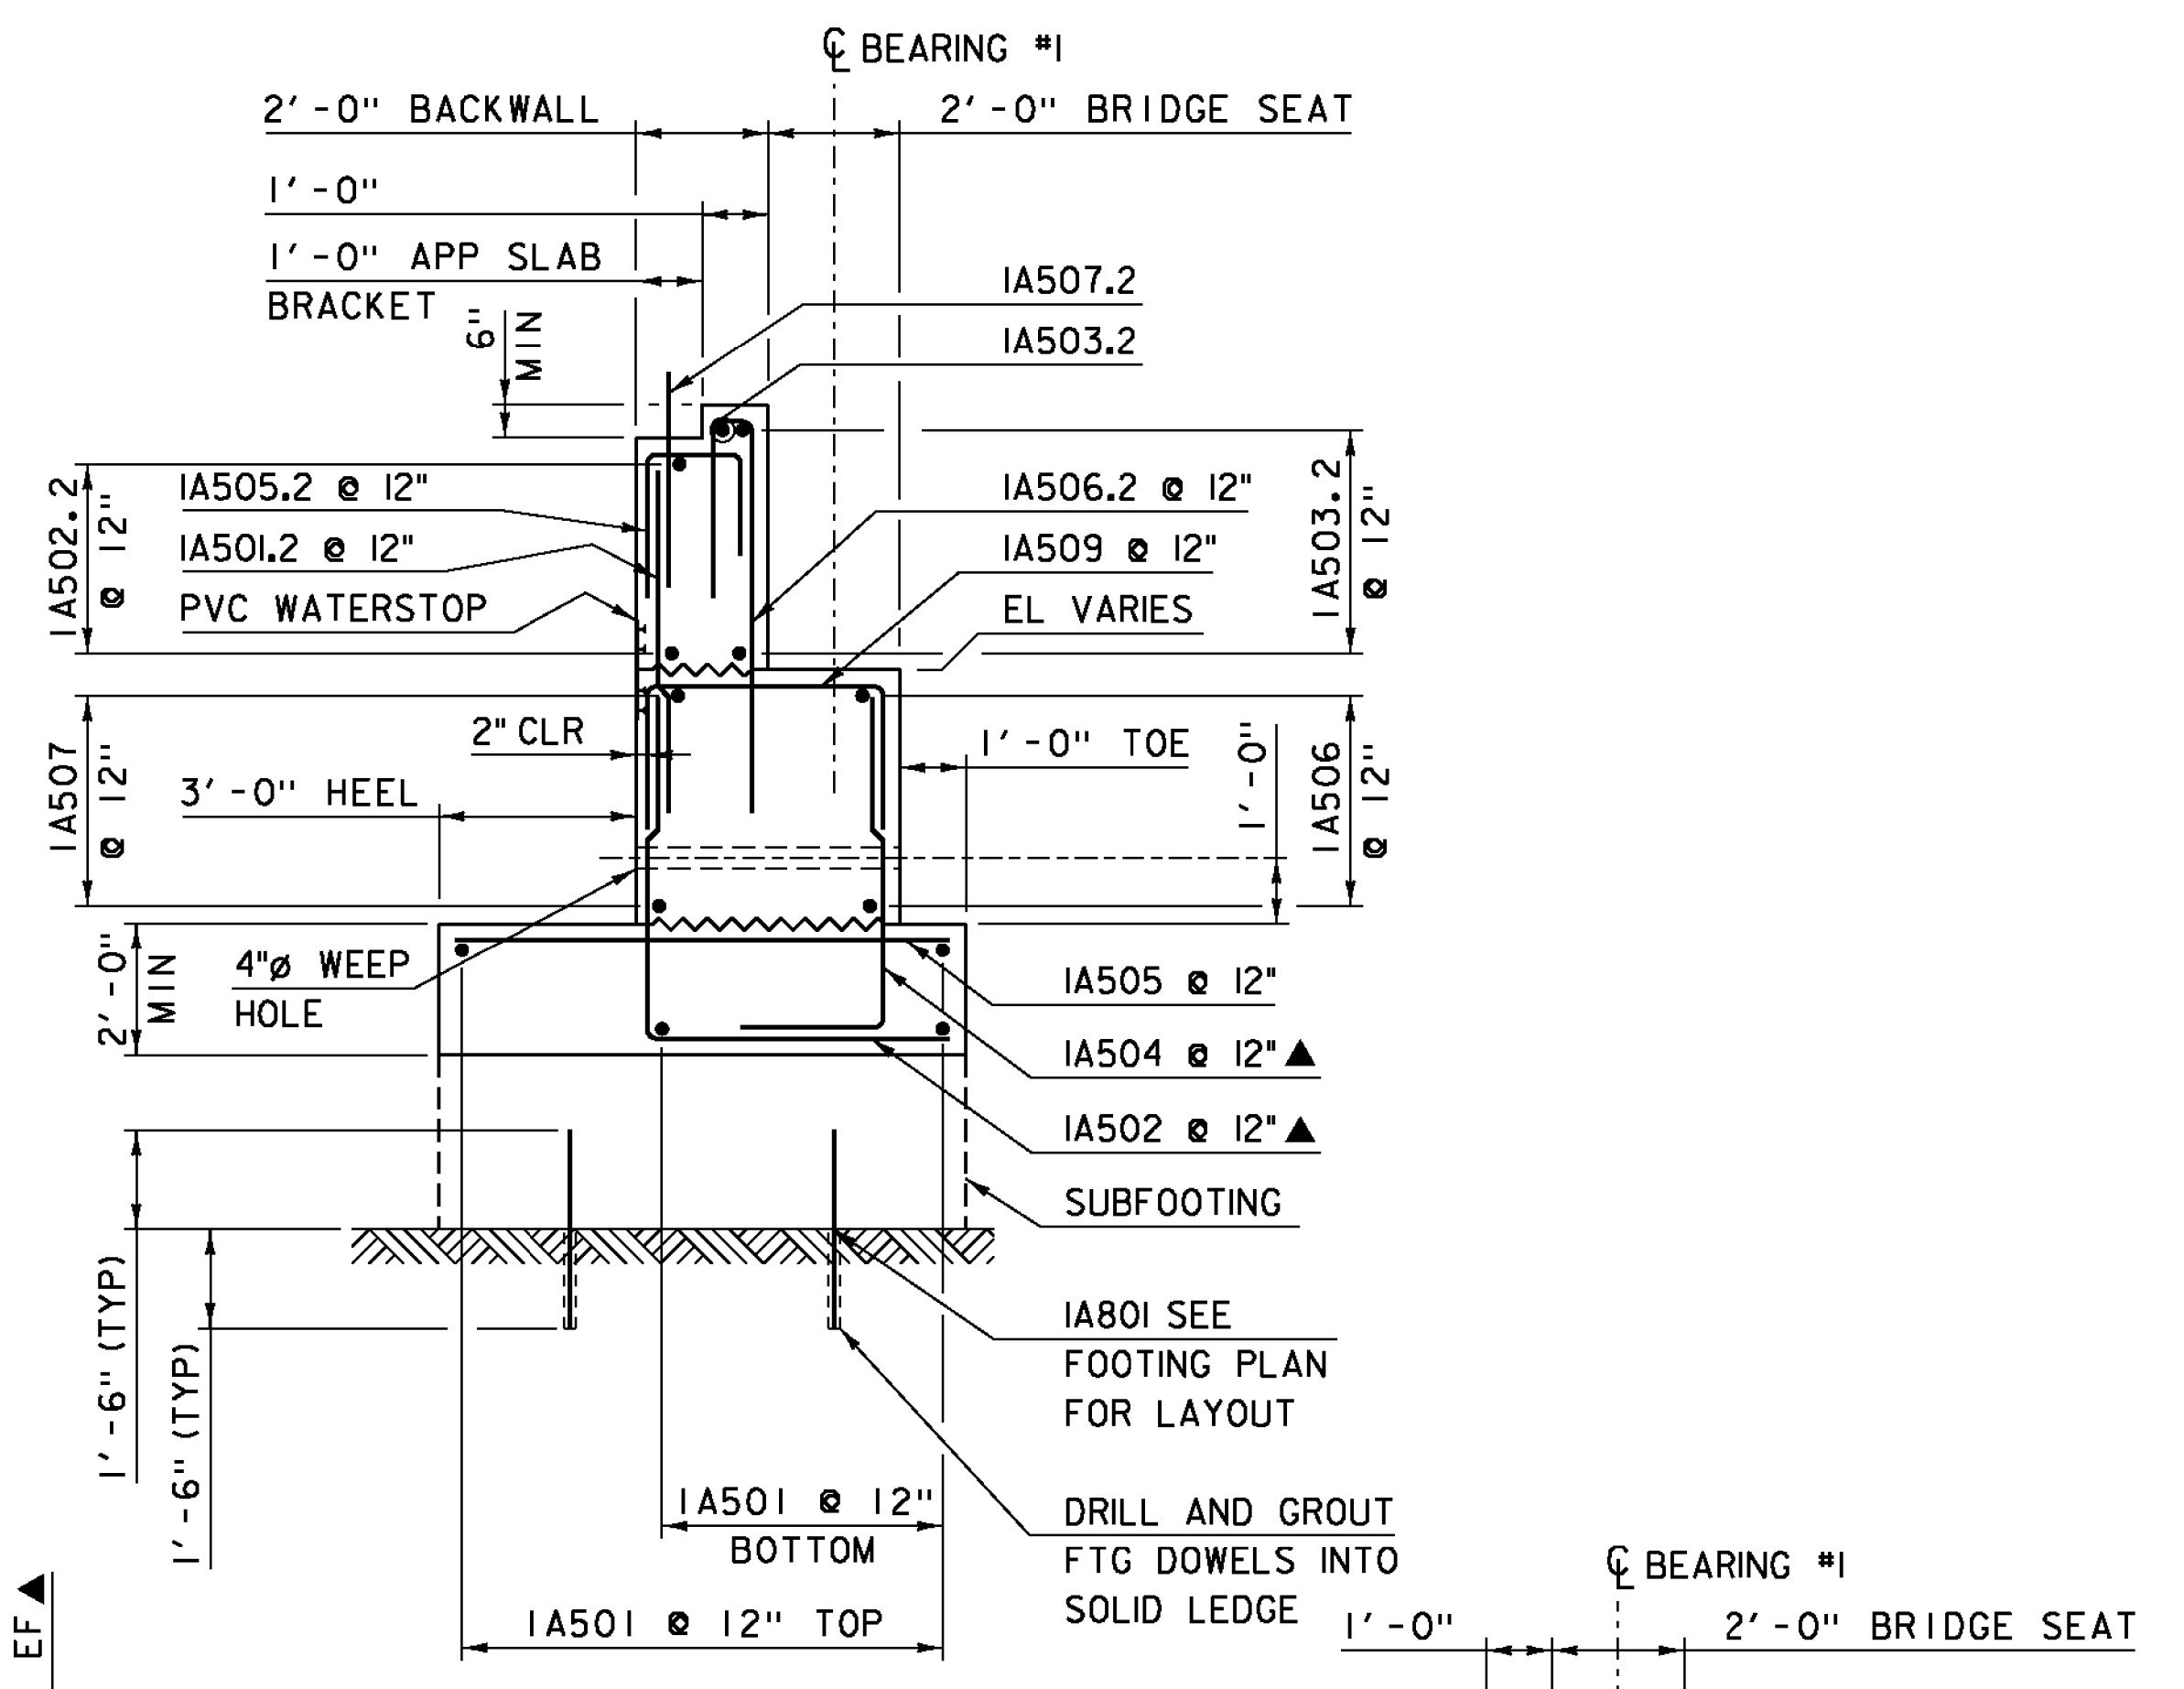


**ABUTMENT #1 TYPICAL**

SCALE 3/8" = 1'-0"

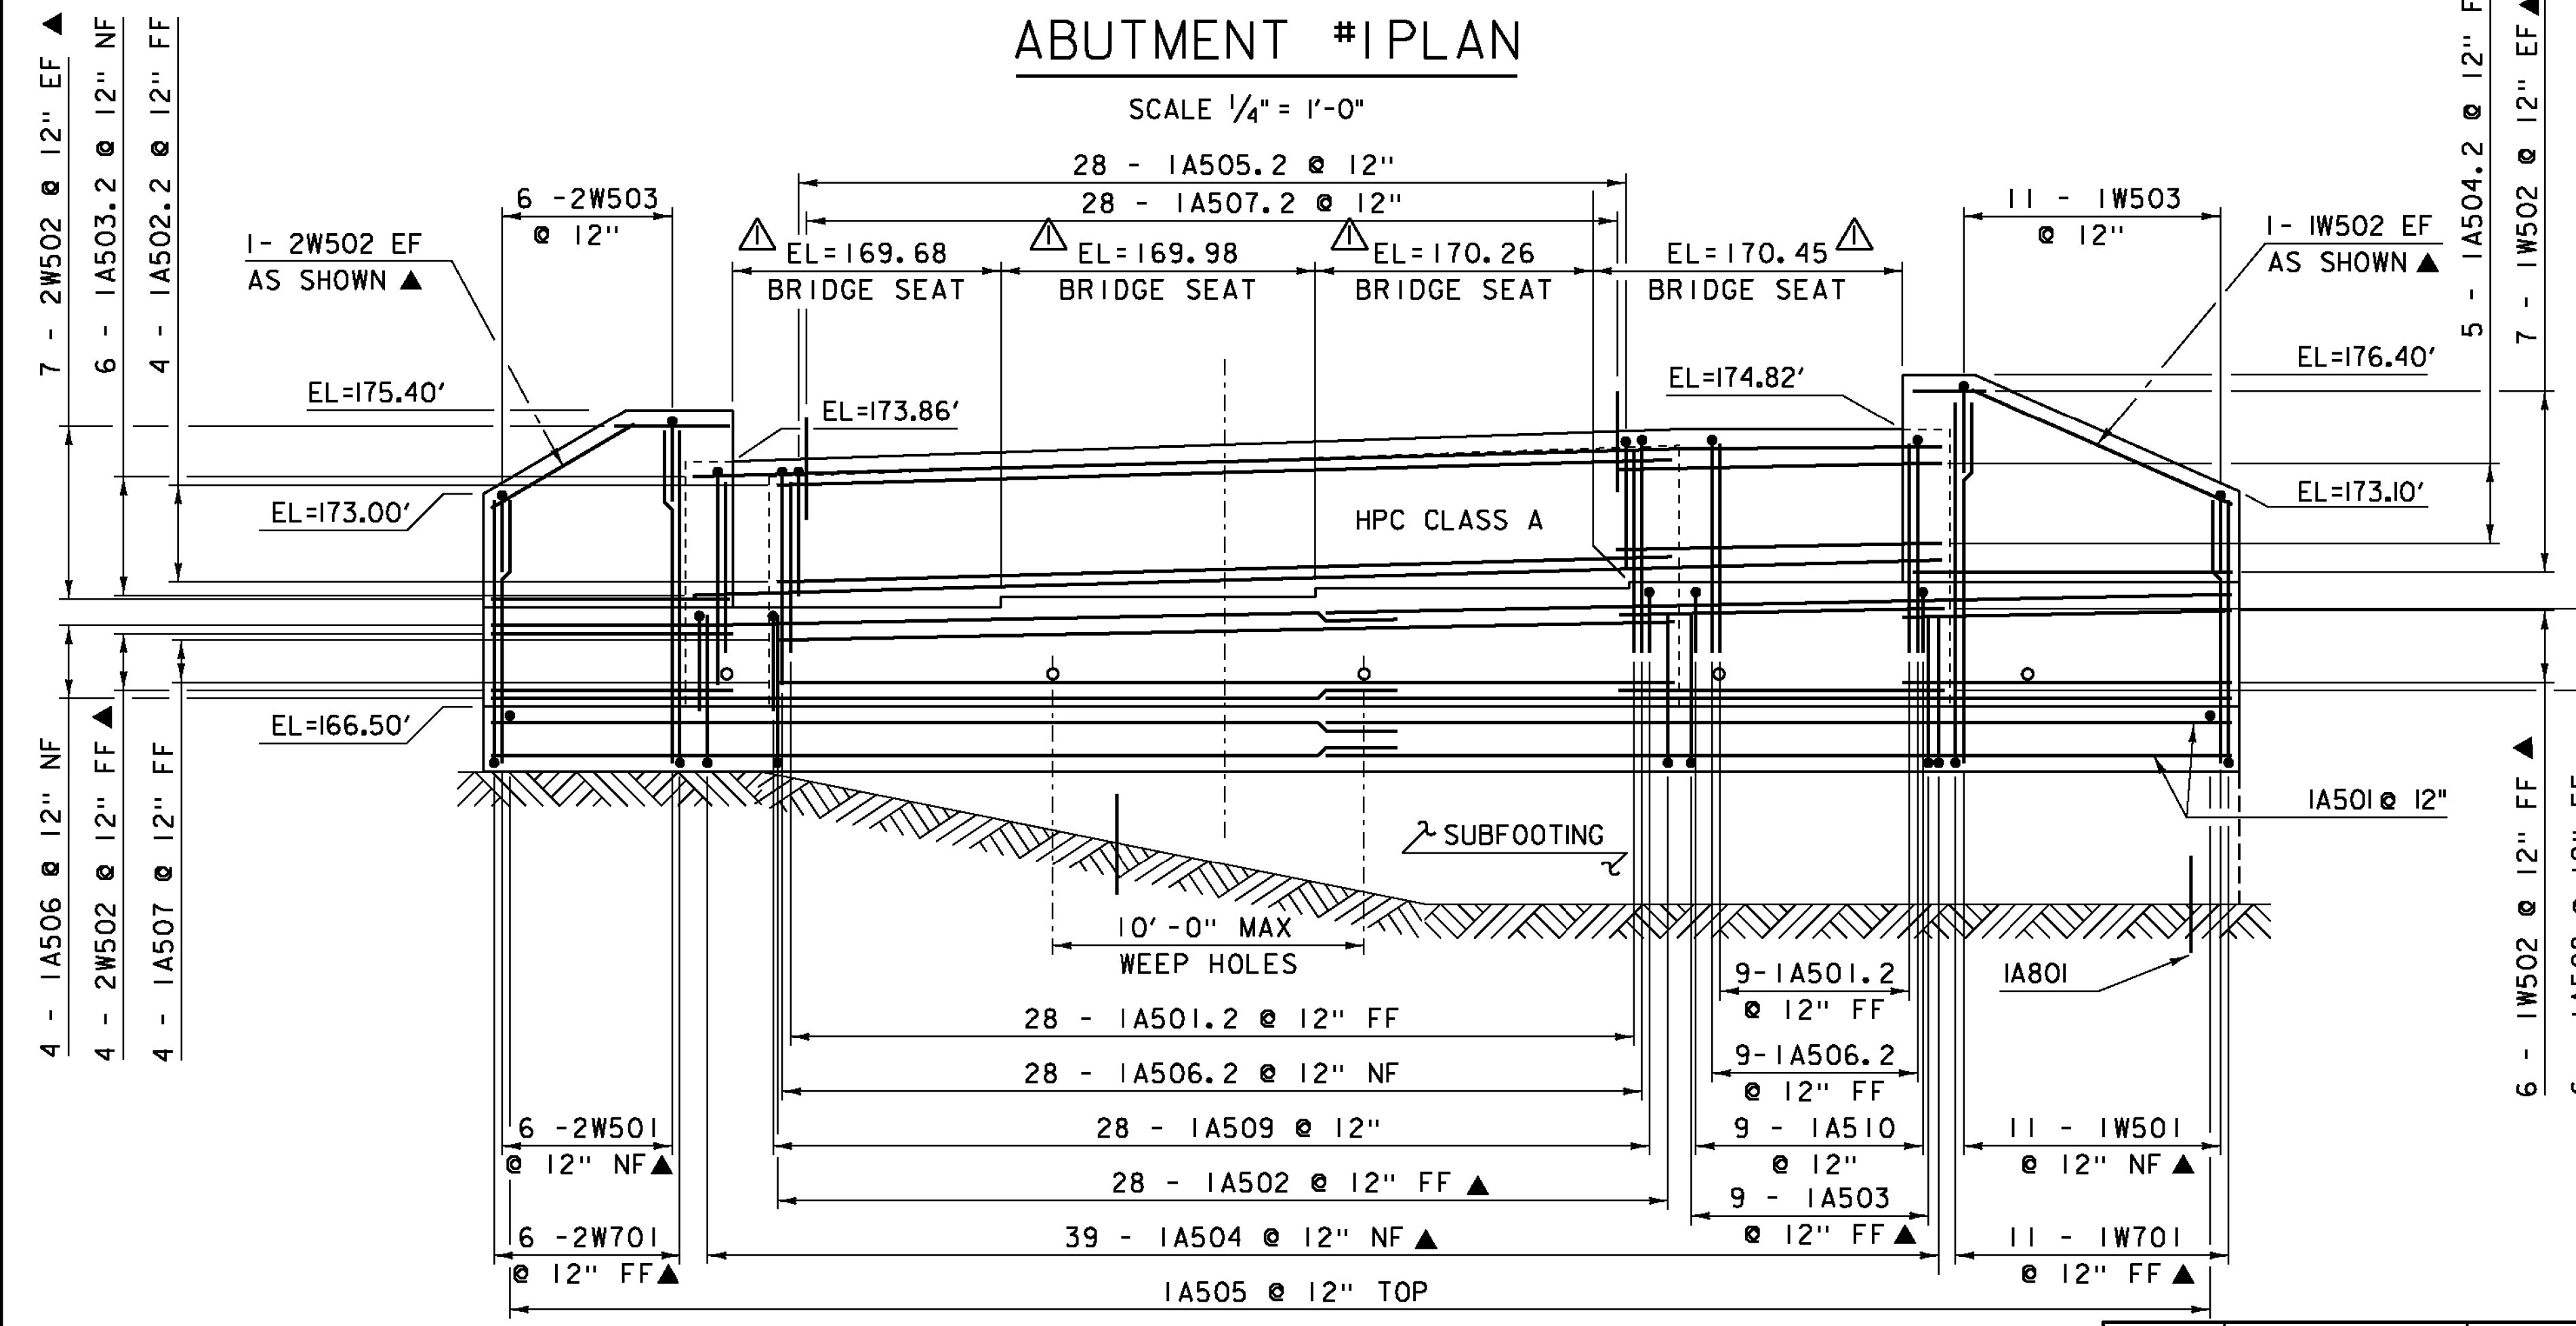

**ABUTMENT #1 ELEVATION**

SCALE 1/4" = 1'-0"

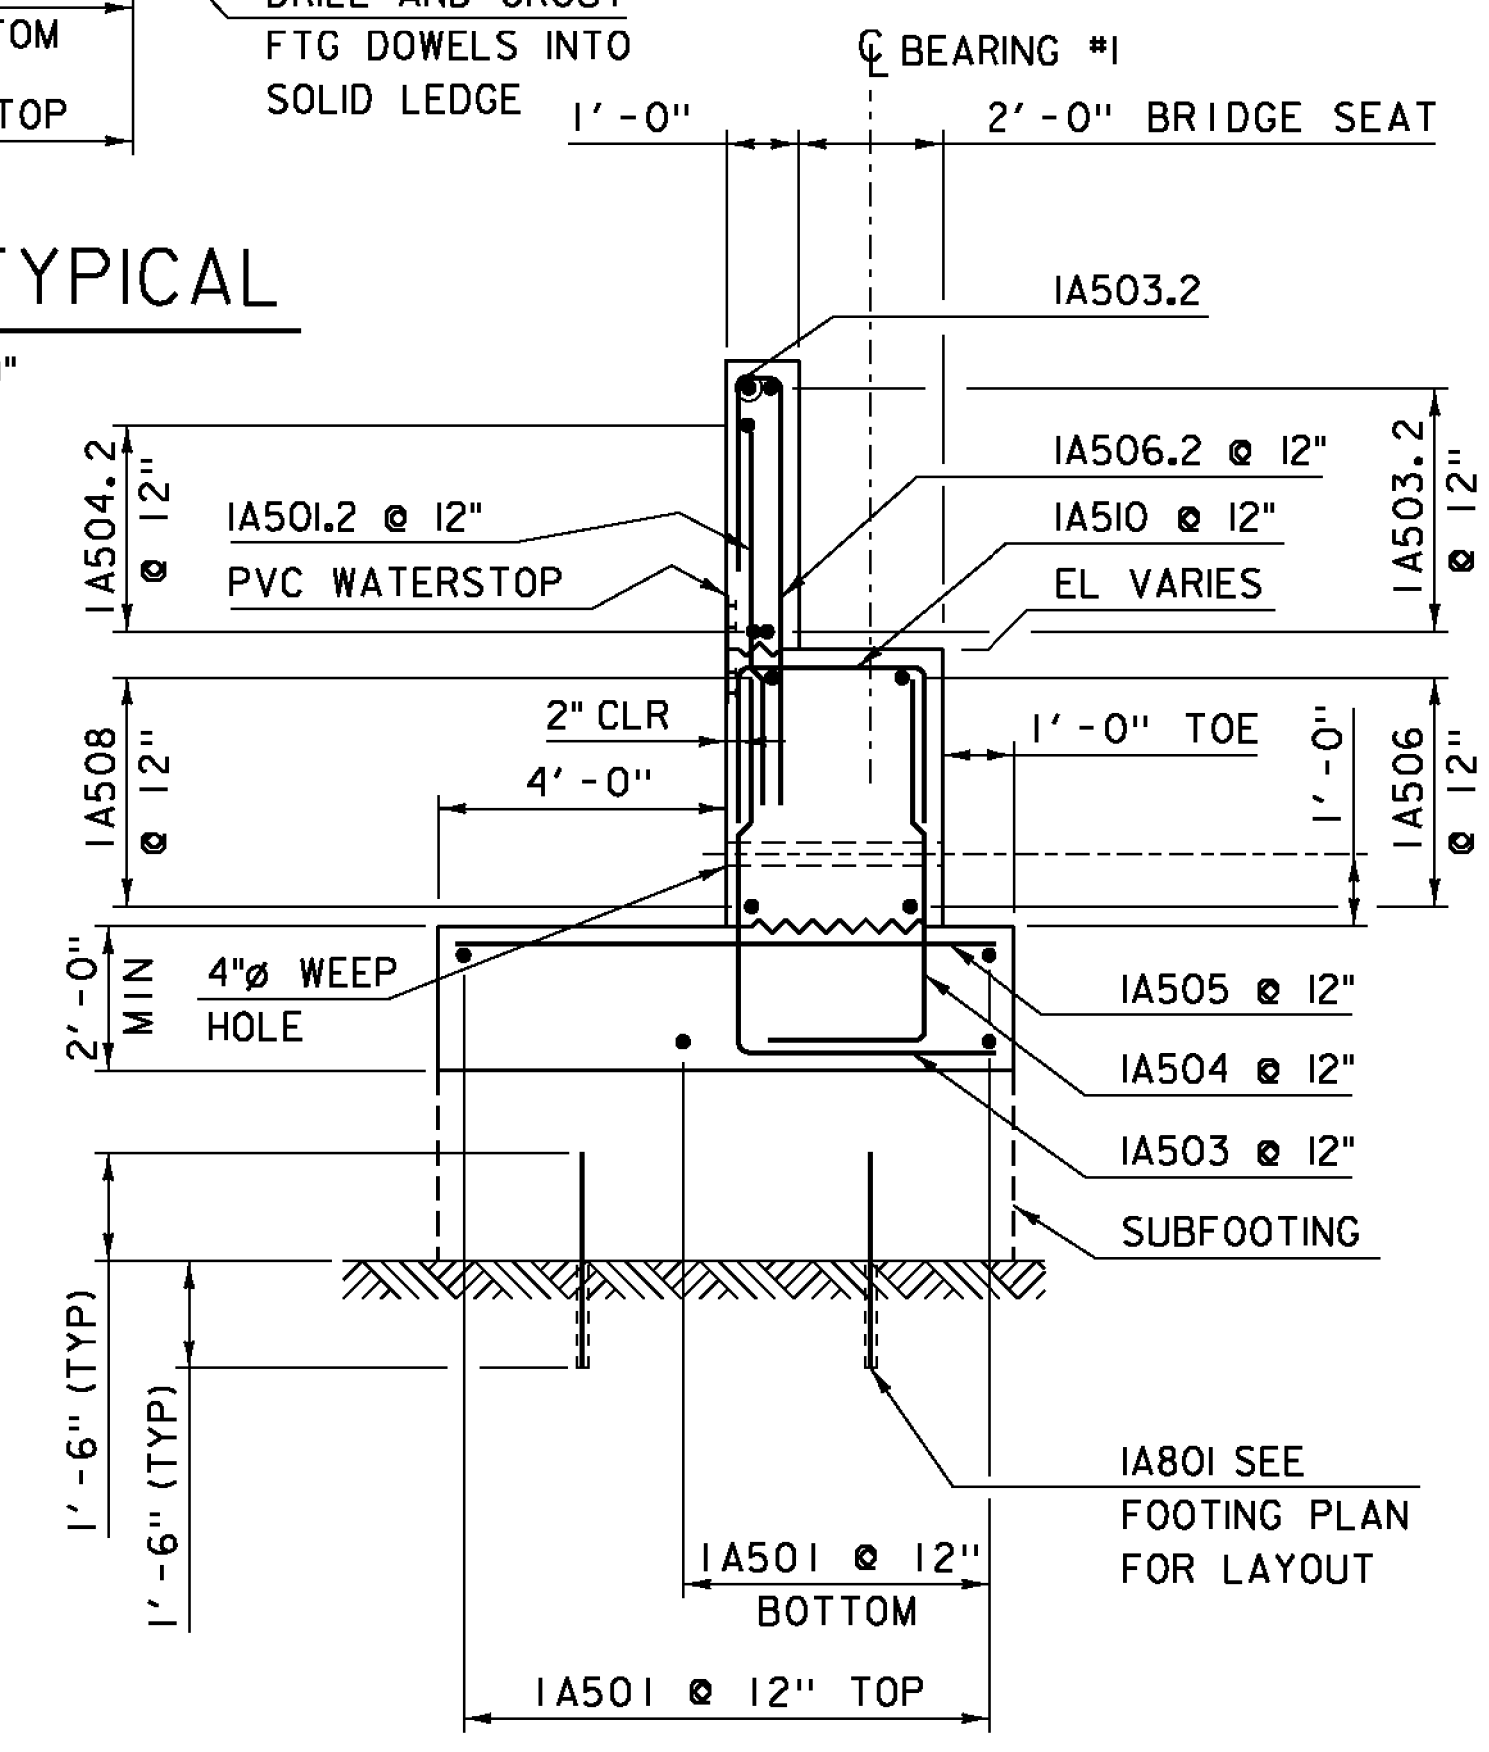

**SECTION A-A**

SCALE 3/8" = 1'-0"

**NOTE:**  
 NF = NEAR FACE  
 FF = FAR FACE  
 EF = EACH FACE  
 ▲ = CUT TO FIT IN FIELD  
 3" CLEAR, UNLESS OTHERWISE SPECIFIED ON THE PLANS.  
 2'-2" BAR LAP UNLESS OTHERWISE SPECIFIED ON THE PLANS.

KEY	DATE	BY	REVISION
△	04/20/2015	VAOT	MODIFIED BRIDGE SEAT ELEVATIONS.
△	06/11/2015	VAOT	MODIFIED ABUTMENT DIMENSIONS.

PROJECT NAME:	COLCHESTER	FILE NAME:	s95j298sub.dgn	PLOT DATE:	11-JUN-2015
PROJECT NUMBER:	STP 5600 (12)	PROJECT LEADER:	C. CARLSON	DRAWN BY:	M. UMBERGER
		DESIGNED BY:	J. GRIFFIN	CHECKED BY:	N. VANDENBERG
		ABUTMENT #1 PLAN & ELEVATION			SHEET 30 OF 53

SEE SHEET 30A FOR WINGWALL #2 DETAILS.