



ABUTMENT #2 PLAN

SCALE 1/4" = 1'-0"

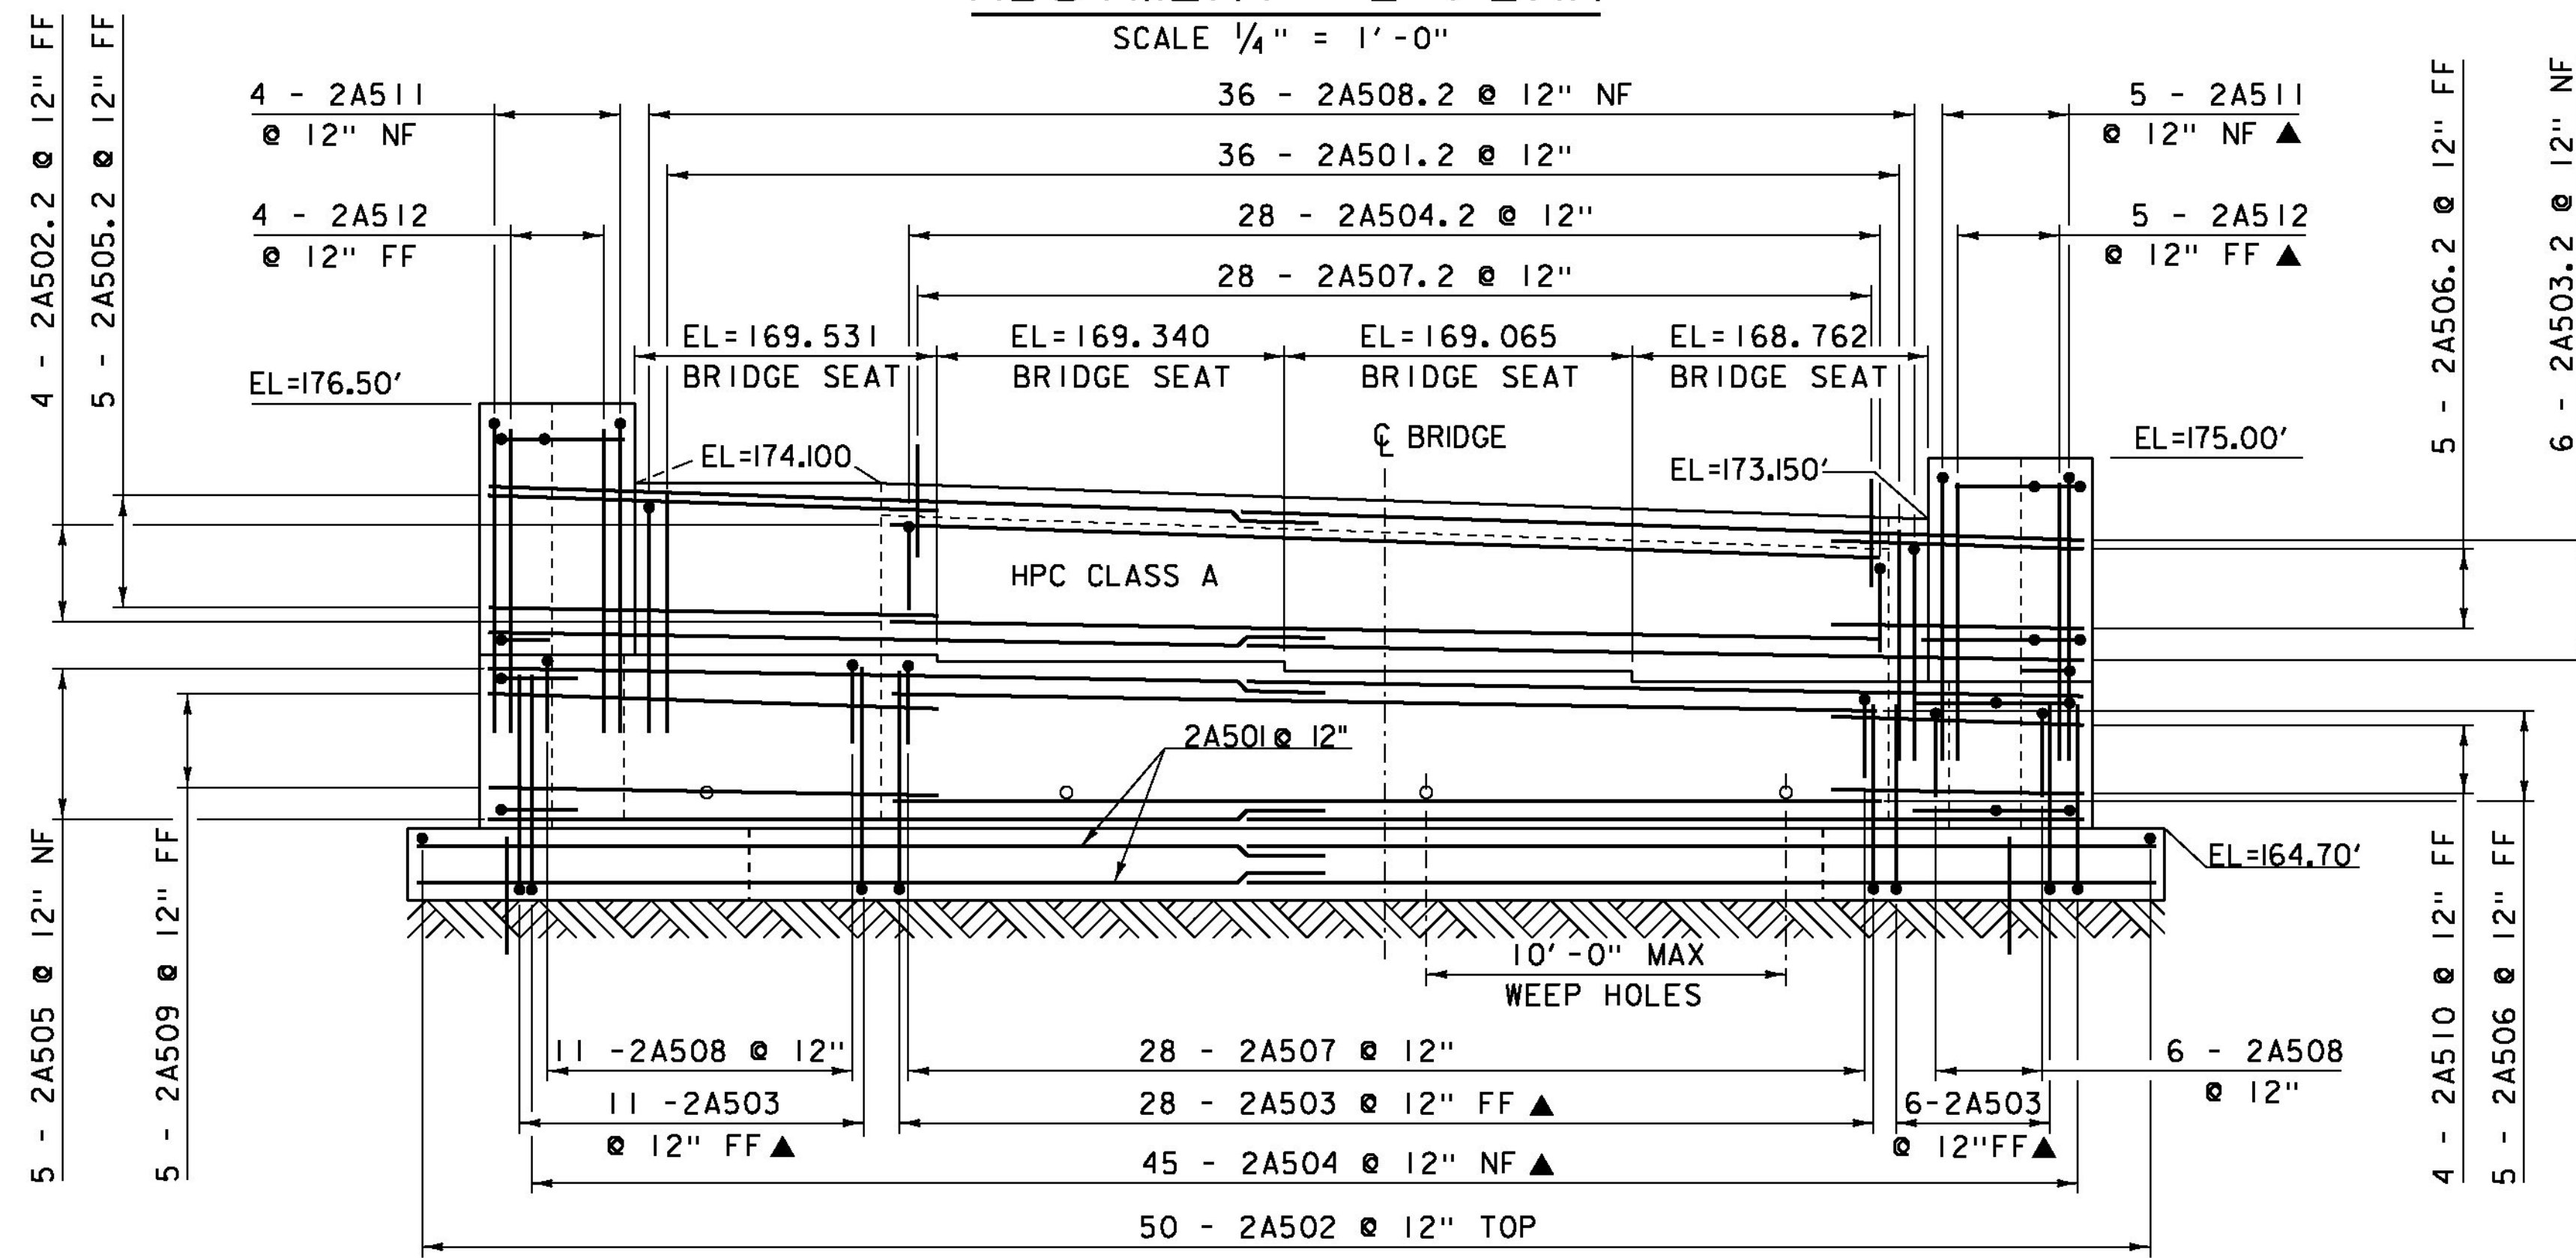


ABUTMENT #2 ELEVATION

SCALE 1/4" = 1'-0"

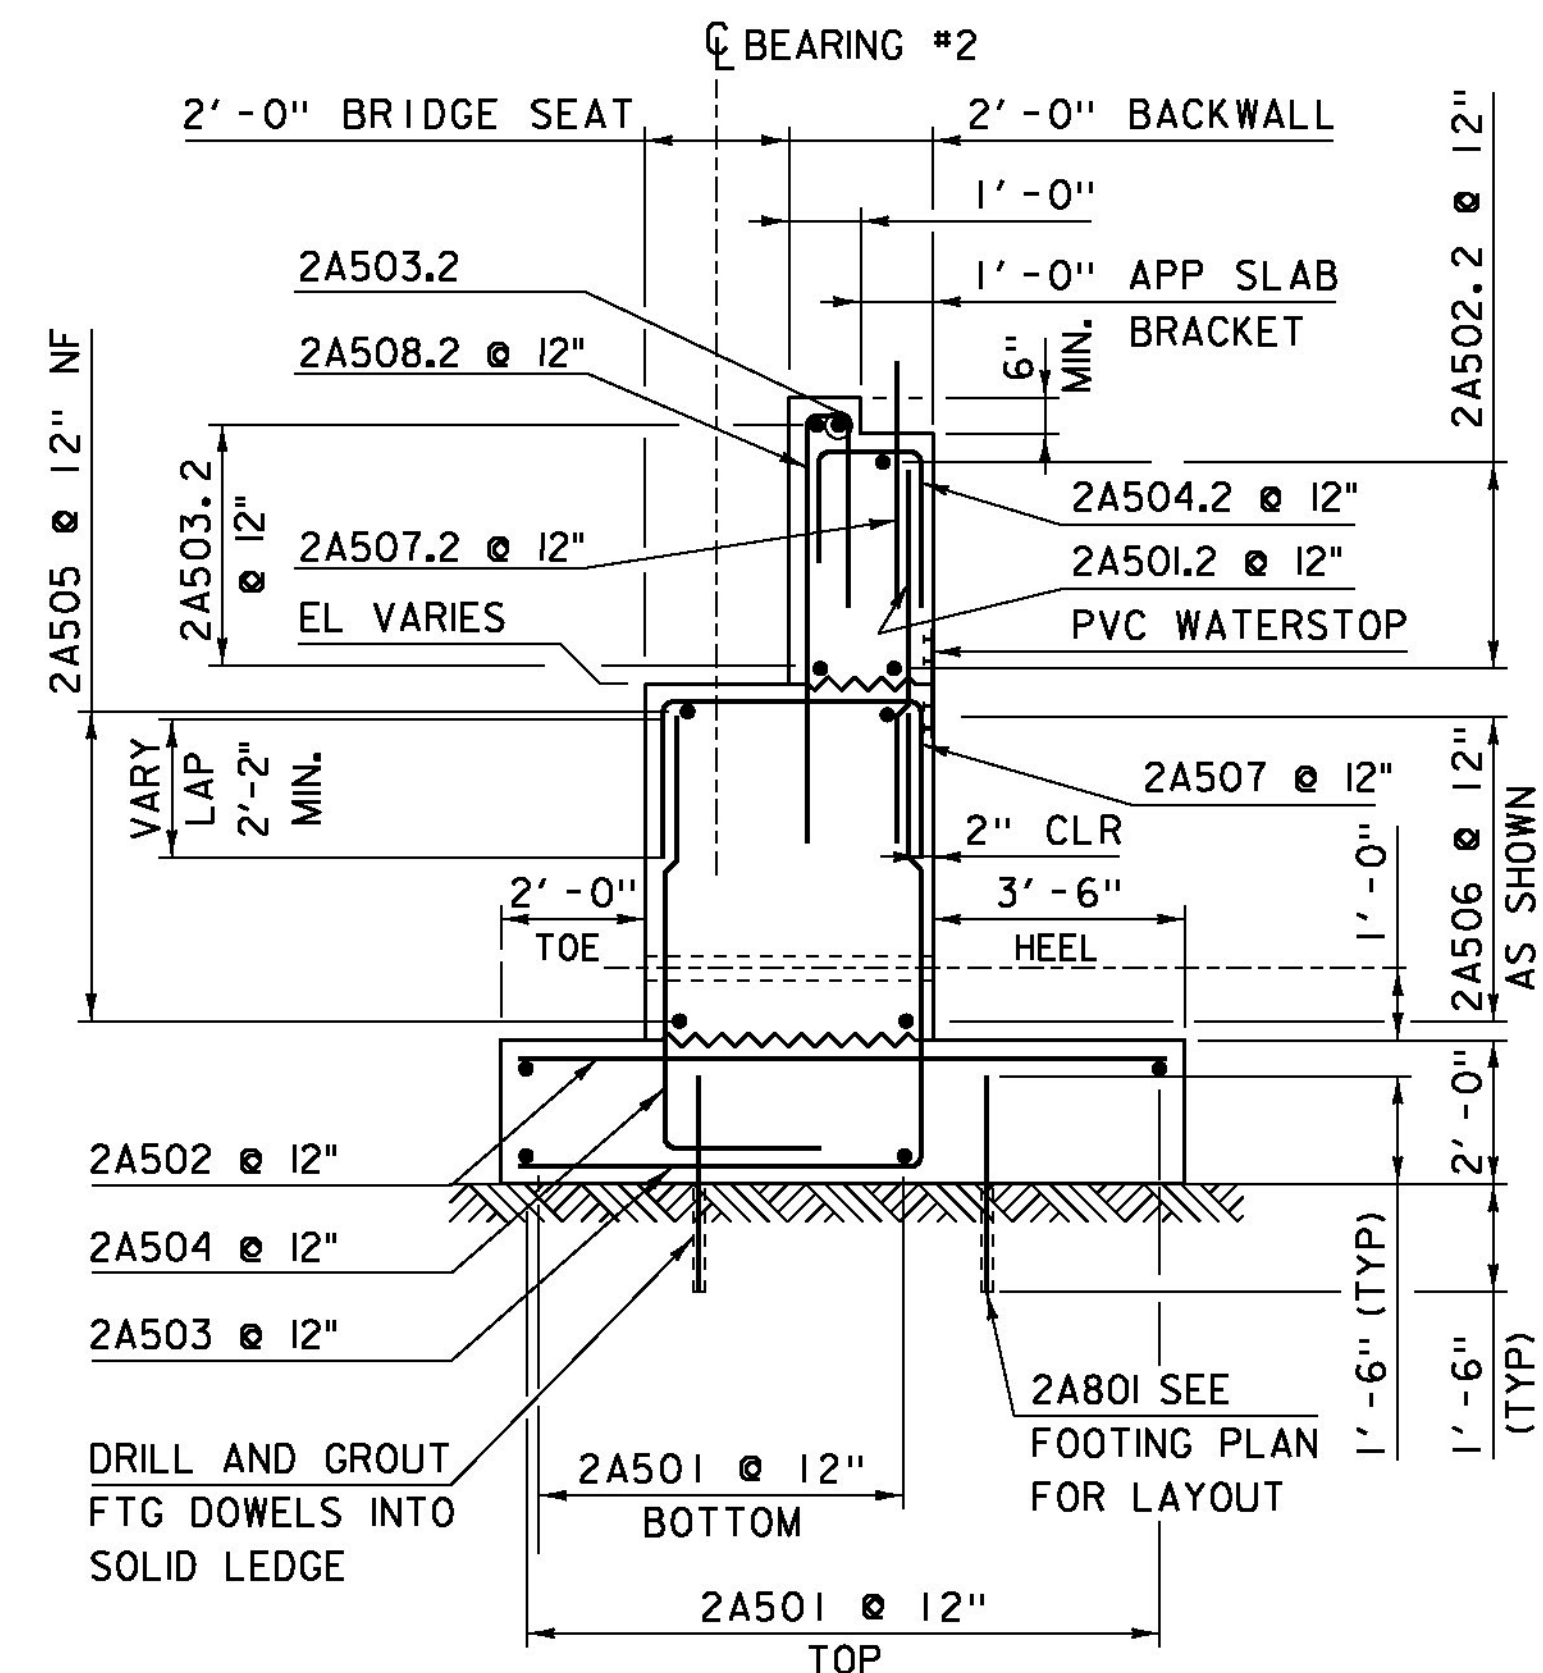

ABUTMENT #2 TYPICAL

SCALE 3/8" = 1'-0"

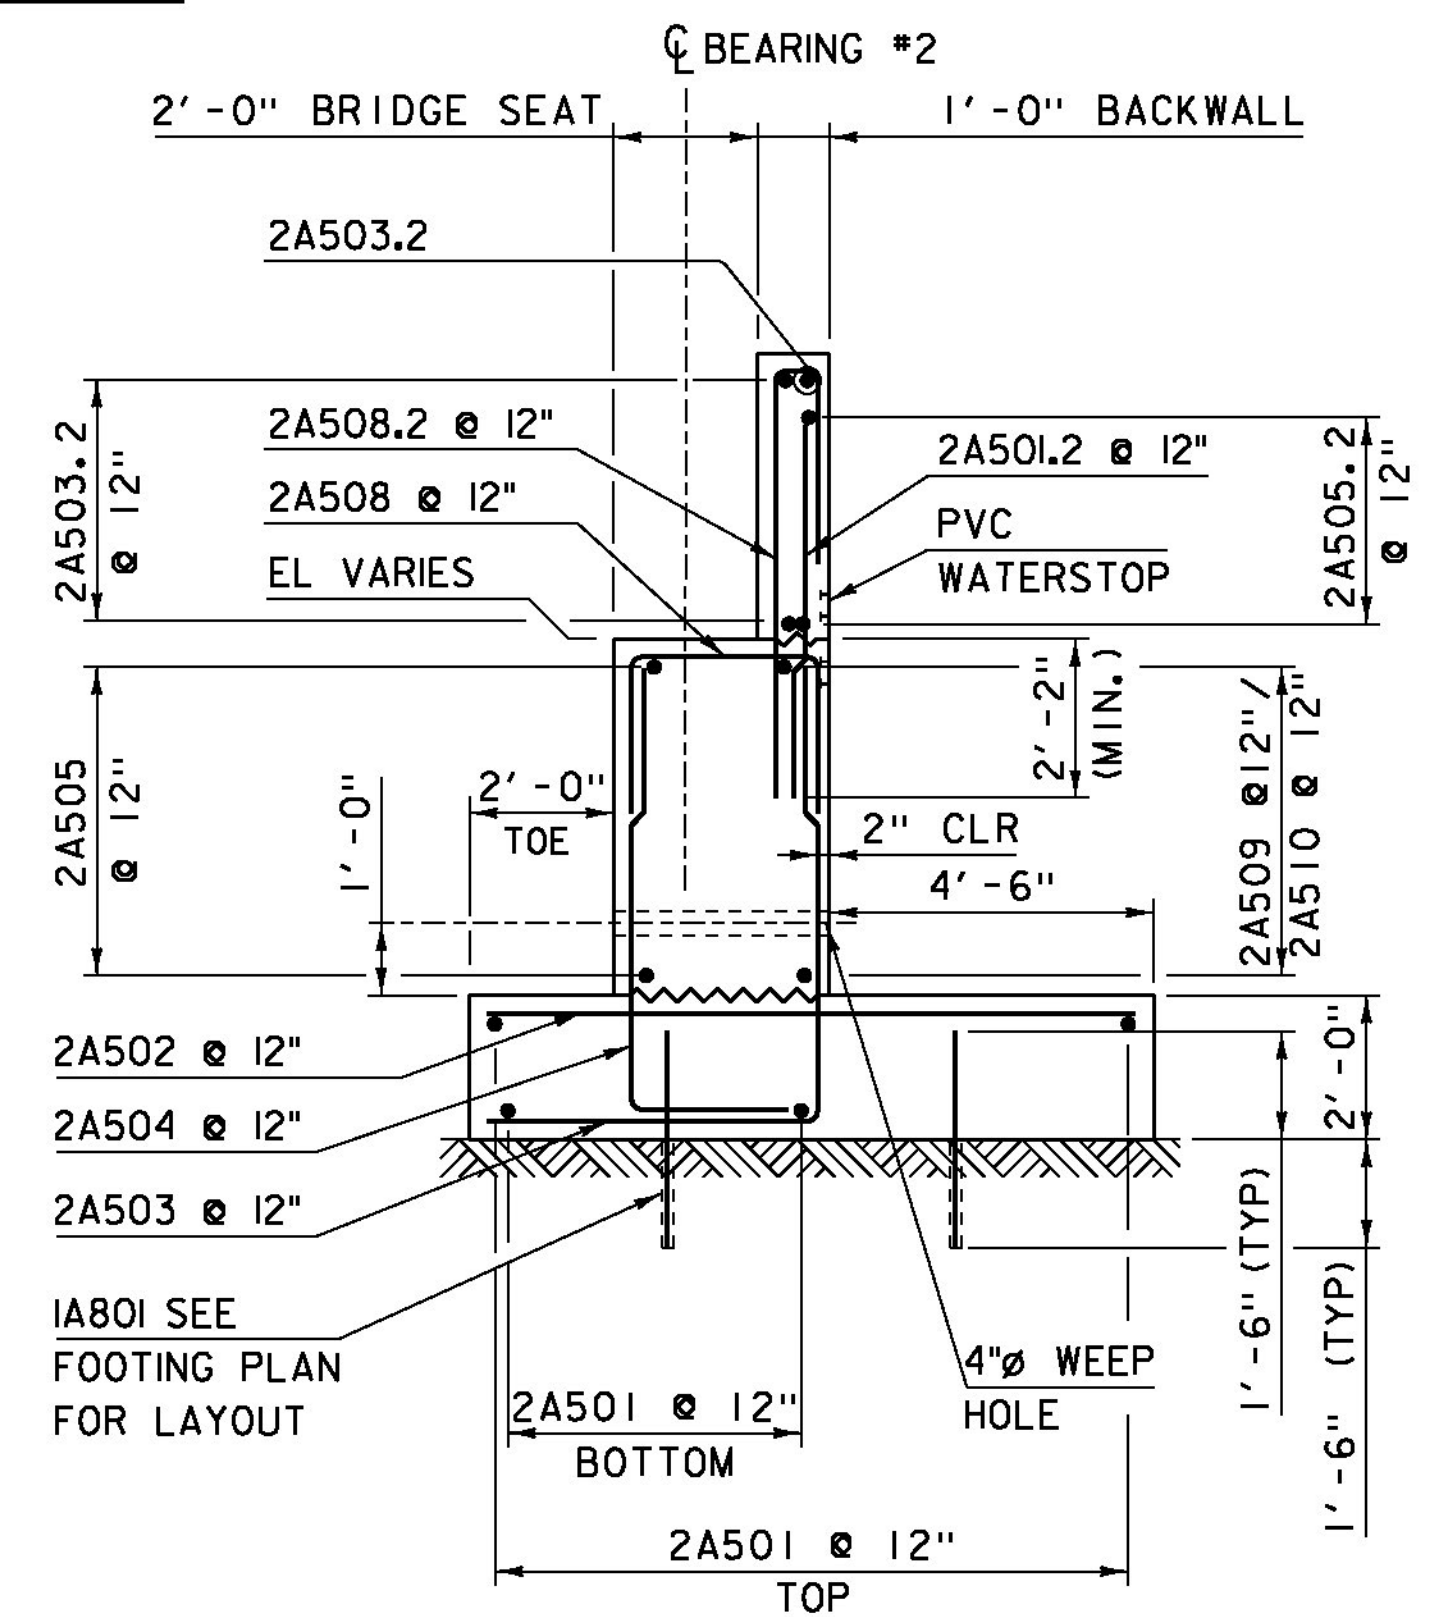

SECTION B-B

SCALE 3/8" = 1'-0"

NOTE:

- NF = NEAR FACE
- FF = FAR FACE
- EF = EACH FACE
- ▲ = CUT TO FIT IN FIELD
- 3" CLEAR, UNLESS OTHERWISE SPECIFIED ON THE PLANS.
- 2'-2" BAR LAP UNLESS OTHERWISE SPECIFIED ON THE PLANS.

PROJECT NAME: COLCHESTER
PROJECT NUMBER: STP 5600 (12)

FILE NAME: s95j298sub.dgn
PROJECT LEADER: C. CARLSON
DESIGNED BY: J. GRIFFIN
ABUTMENT #2 PLAN & ELEVATION

PLOT DATE: 12-JAN-2015
DRAWN BY: M. UMBERGER
CHECKED BY: N. VANDENBERG
SHEET 31 OF 53