




BEGIN APPROACH
11+75

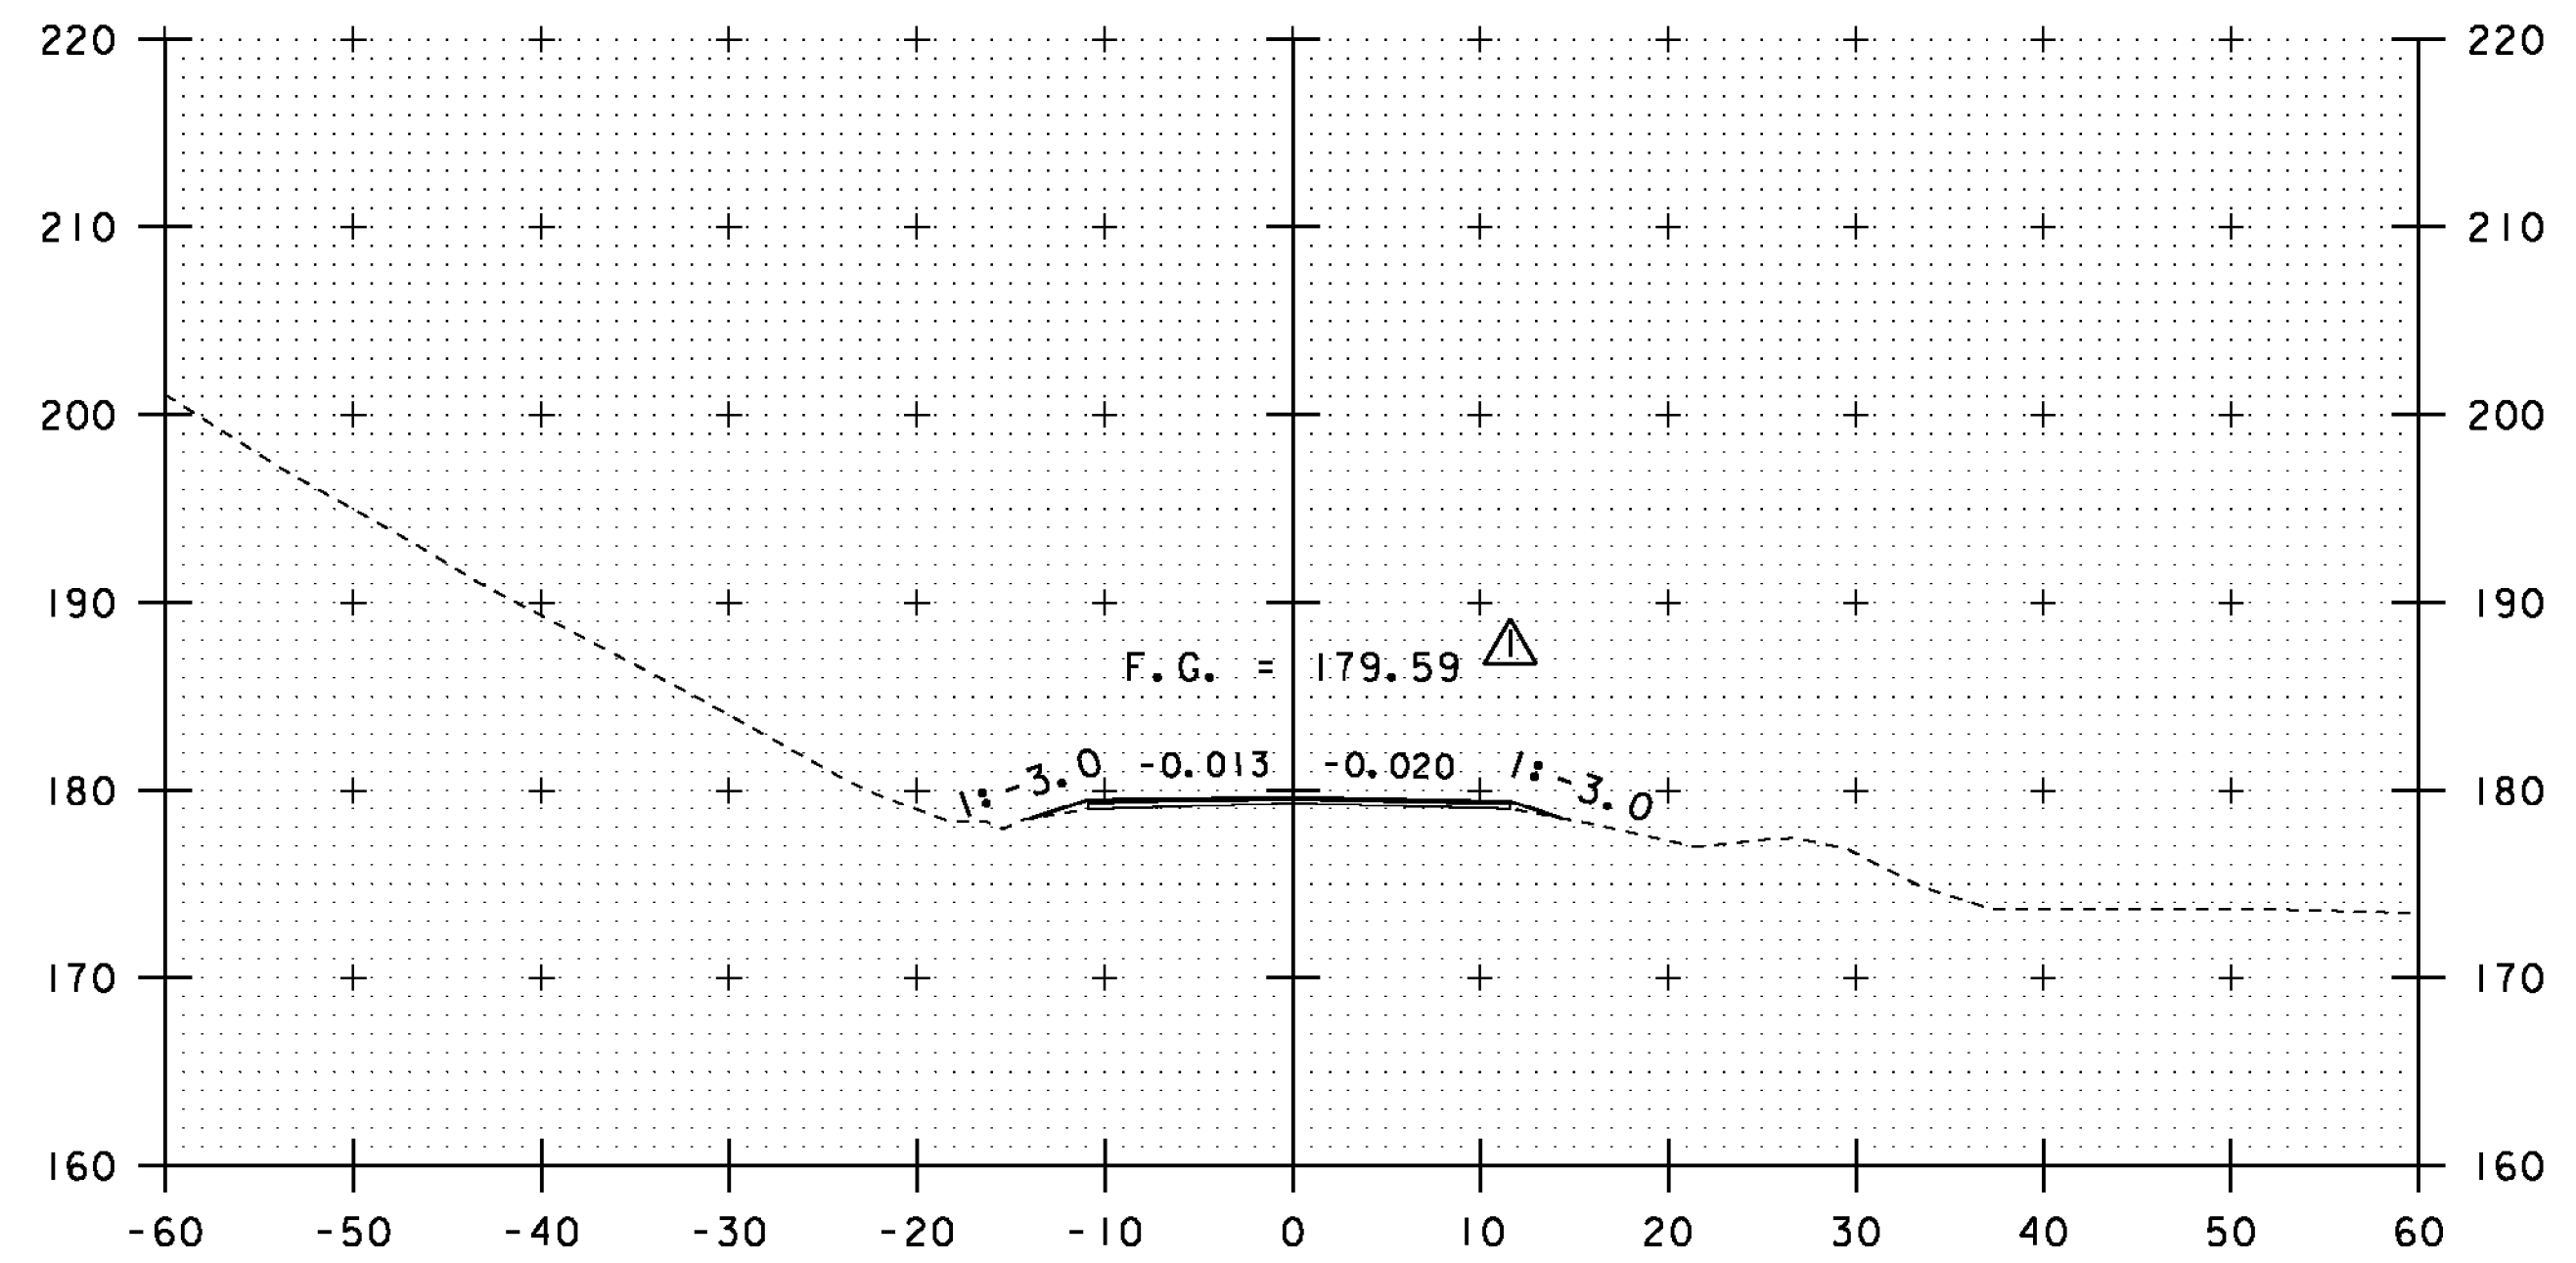

12+25

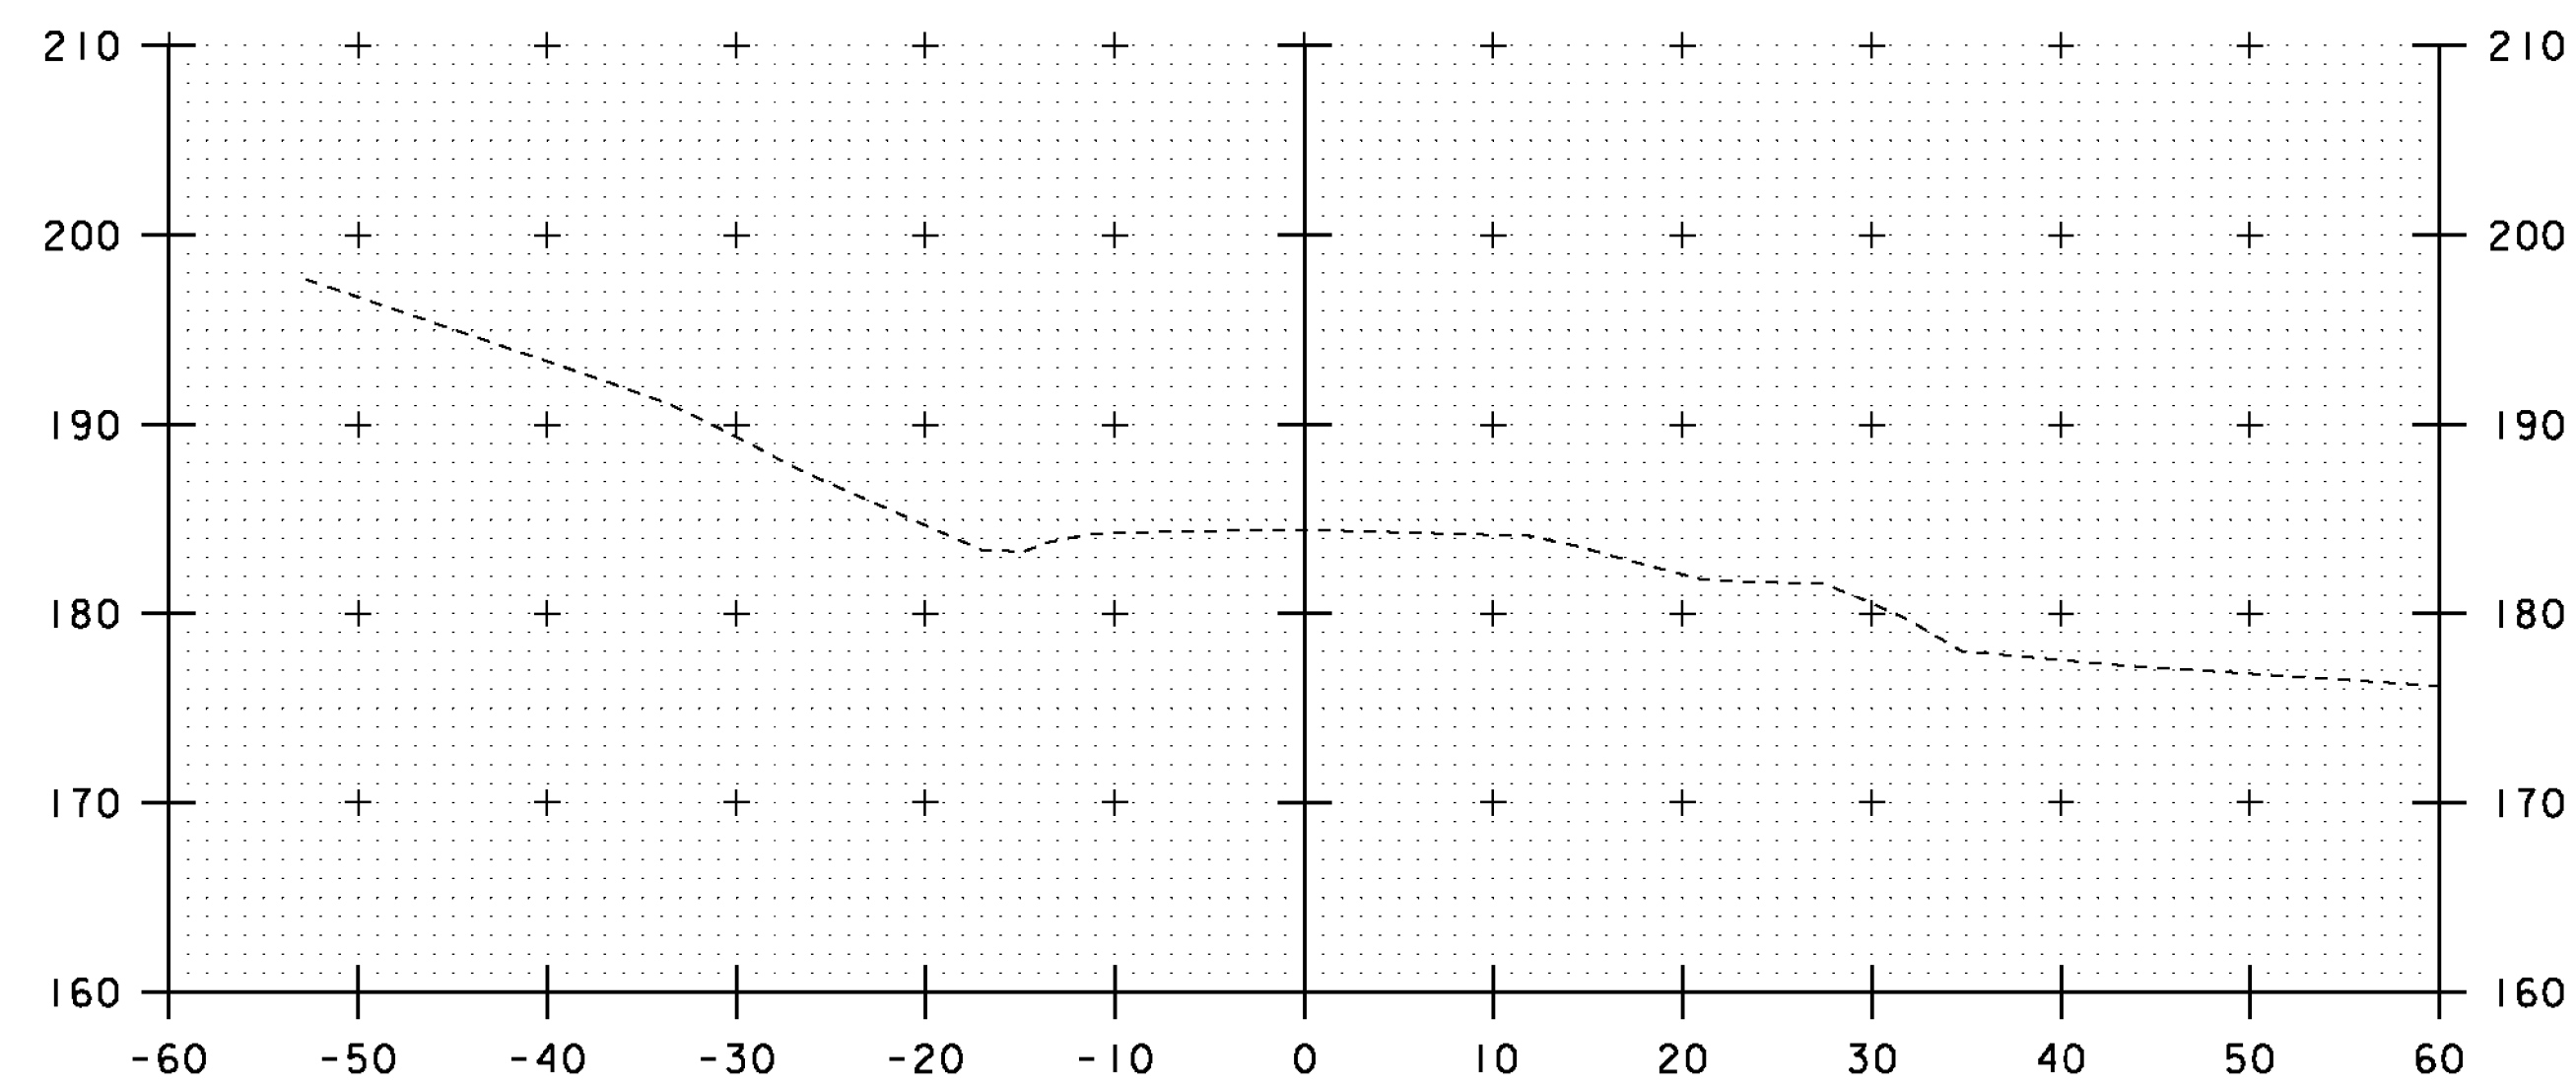

11+50

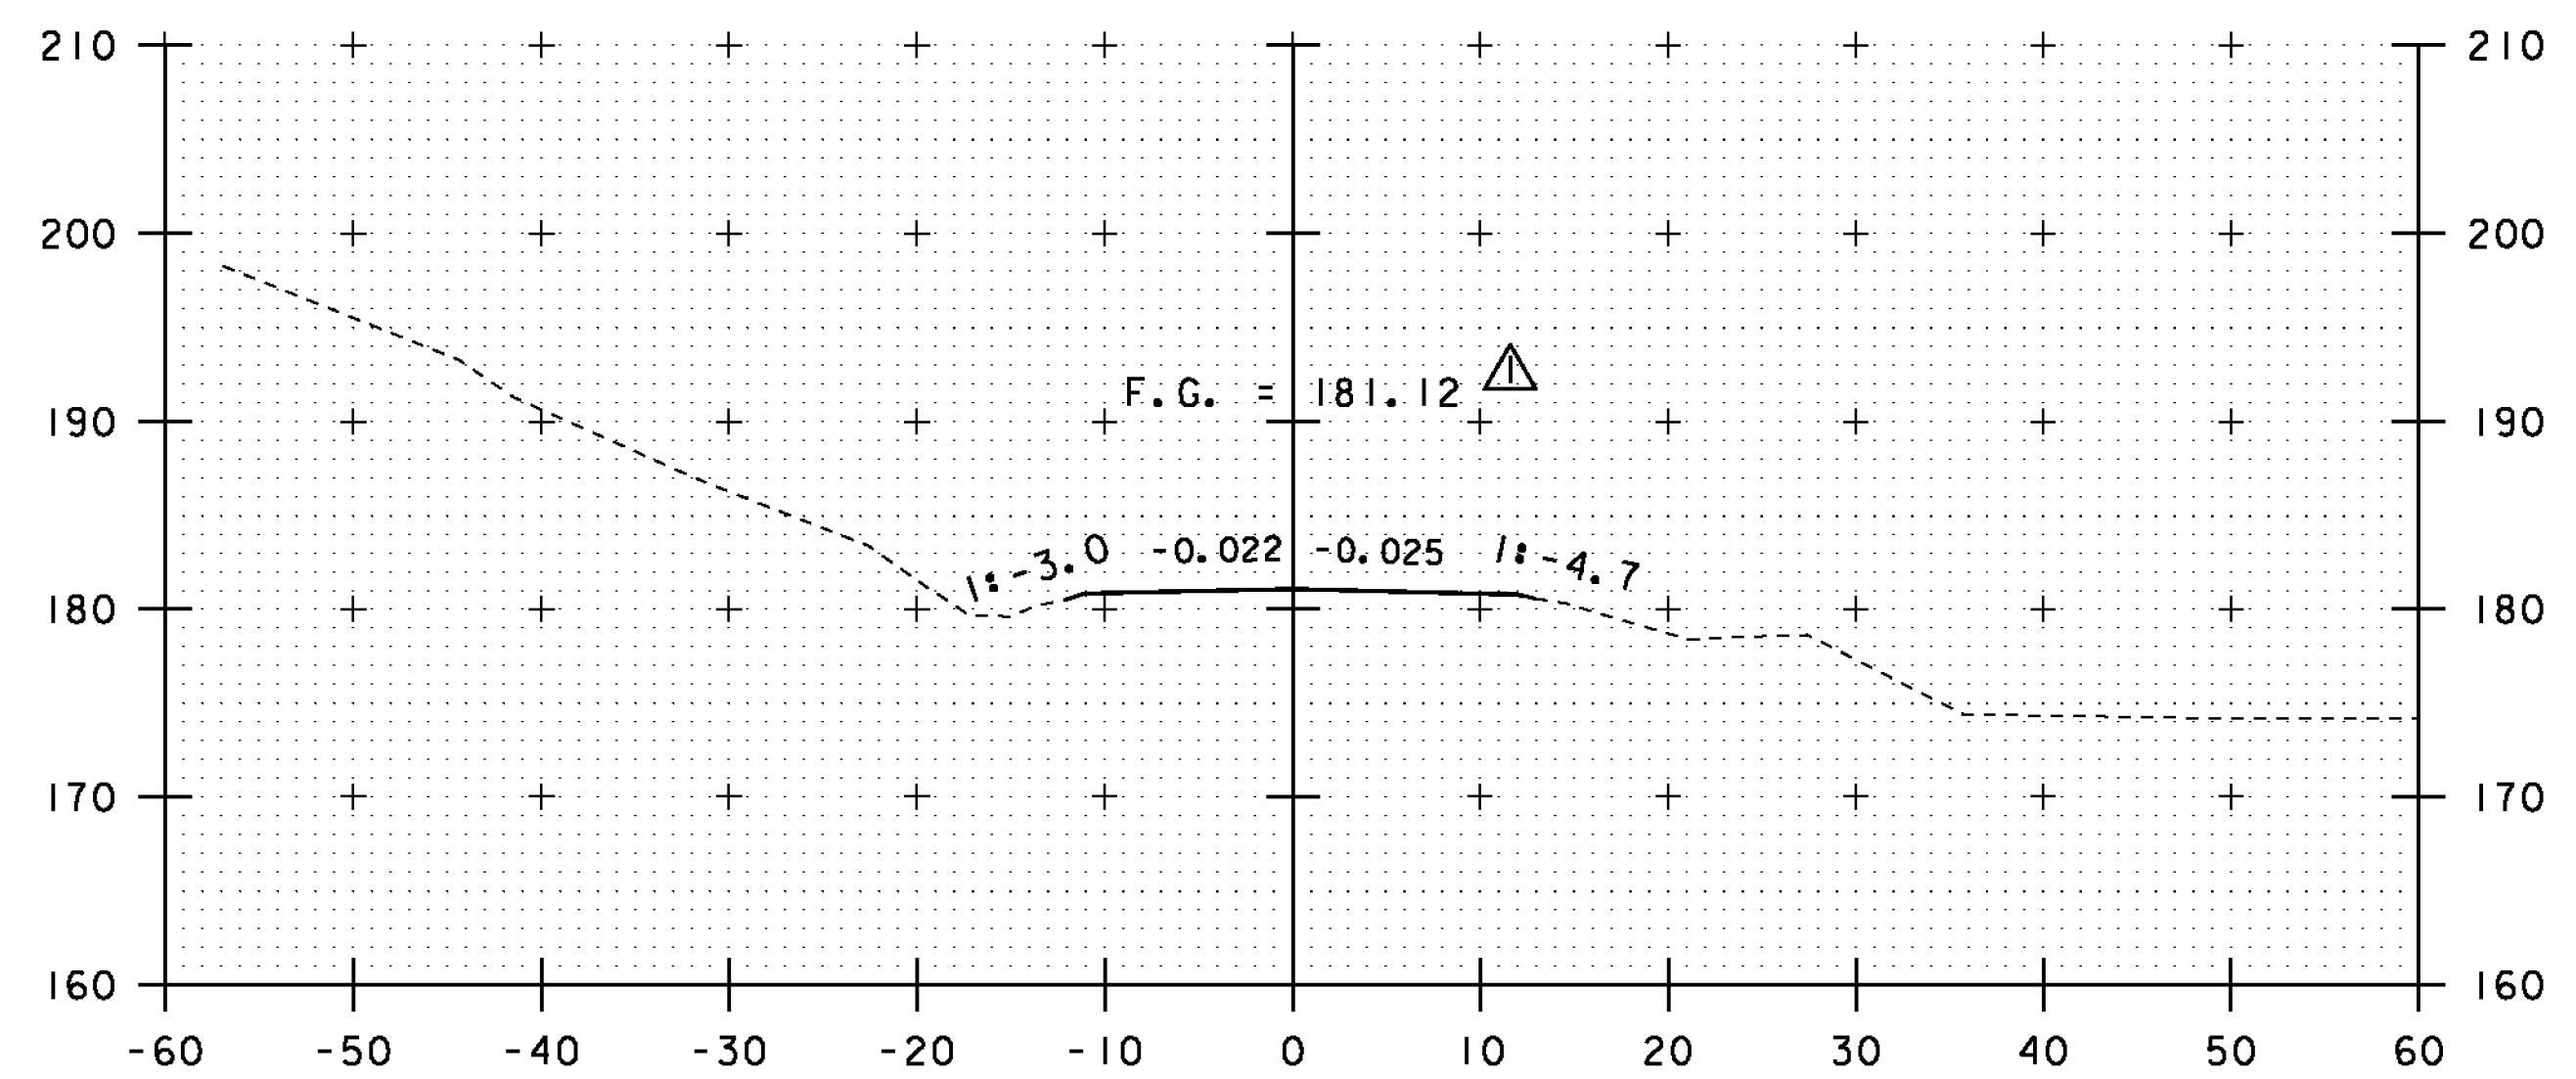

12+00

KEY	DATE	BY	REVISION
△	09/01/2015	VAOT	MODIFIED FINISH GRADE.

STA. 11+50 TO STA. 12+25

PROJECT NAME: COLCHESTER
PROJECT NUMBER: STP 5600 (12)

FILE NAME: s95j298xs.dgn
PROJECT LEADER: C. CARLSON
DESIGNED BY: N. VANDERBERG
ROADWAY CROSS SECTIONS I

PLOT DATE: 01-SEP-2015
DRAWN BY: G. ROKES
CHECKED BY: D. PETERSON
SHEET 36 OF 53