


BANKING DIAGRAM
NTS

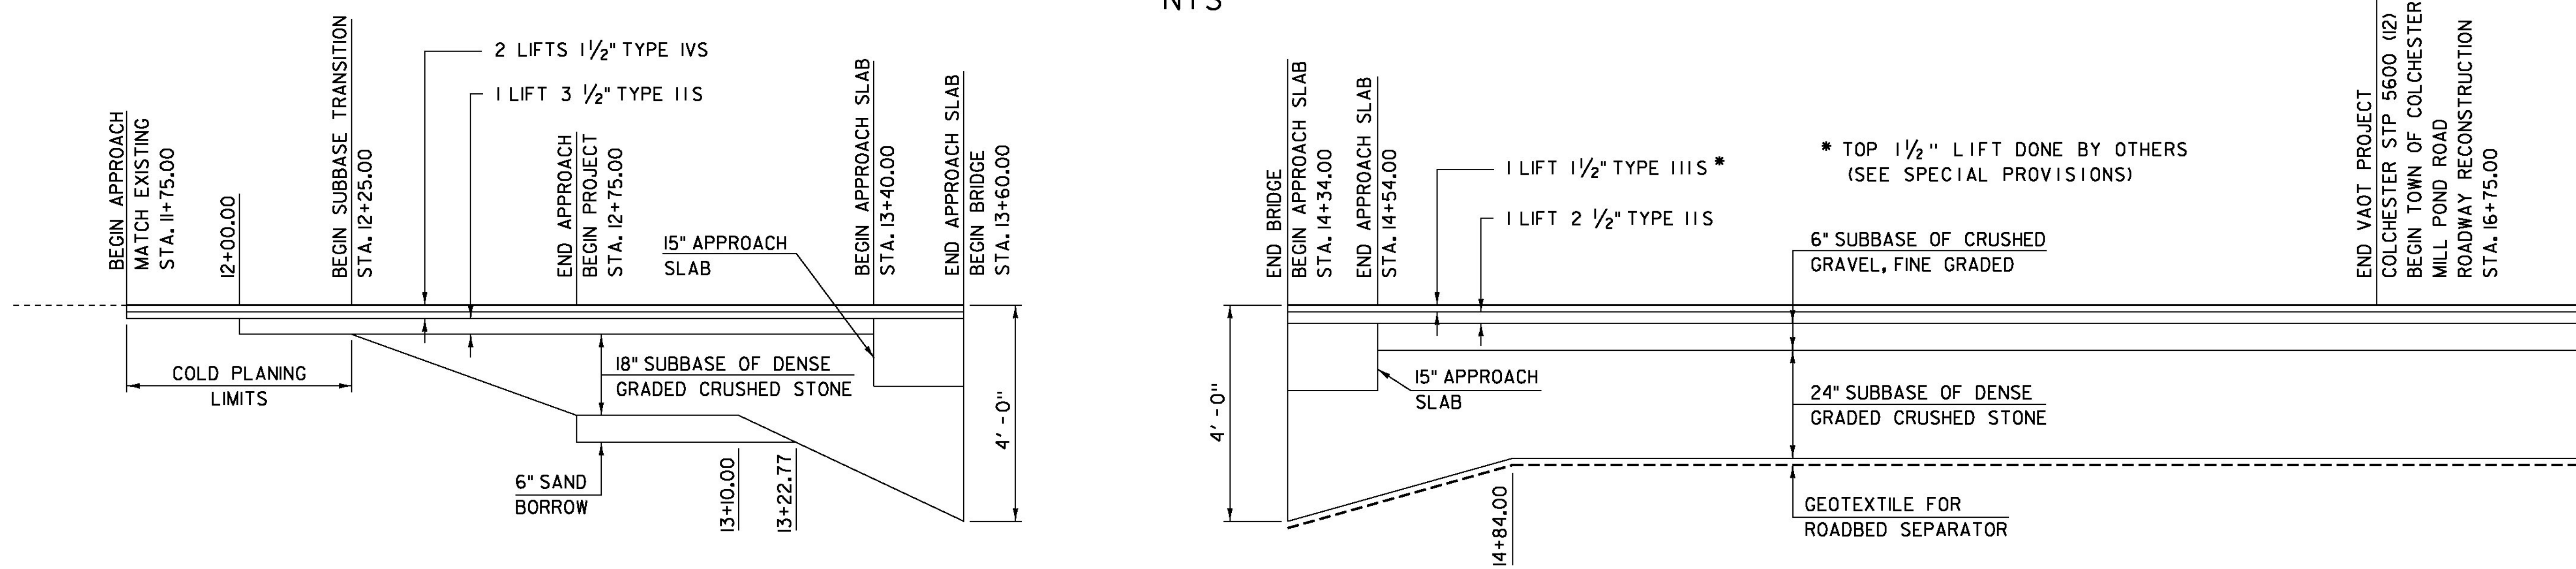

MATERIAL TRANSITION
NTS

PROJECT NAME: COLCHESTER
PROJECT NUMBER: STP 5600 (I2)

FILE NAME: s95j298xs.dgn
PROJECT LEADER: C. CARLSON
DESIGNED BY: N. VANDERBERG
MATERIAL TRANSITION AND BANKING DIAGRAM

PLOT DATE: 23-FEB-2015
DRAWN BY: G. ROKES
CHECKED BY: N. VANDERBERG
SHEET 41 OF 53

KEY	DATE	BY	REVISION
△	02/23/2015	VAOT	MODIFIED MATERIAL TRANSITION AFTER BRIDGE.