
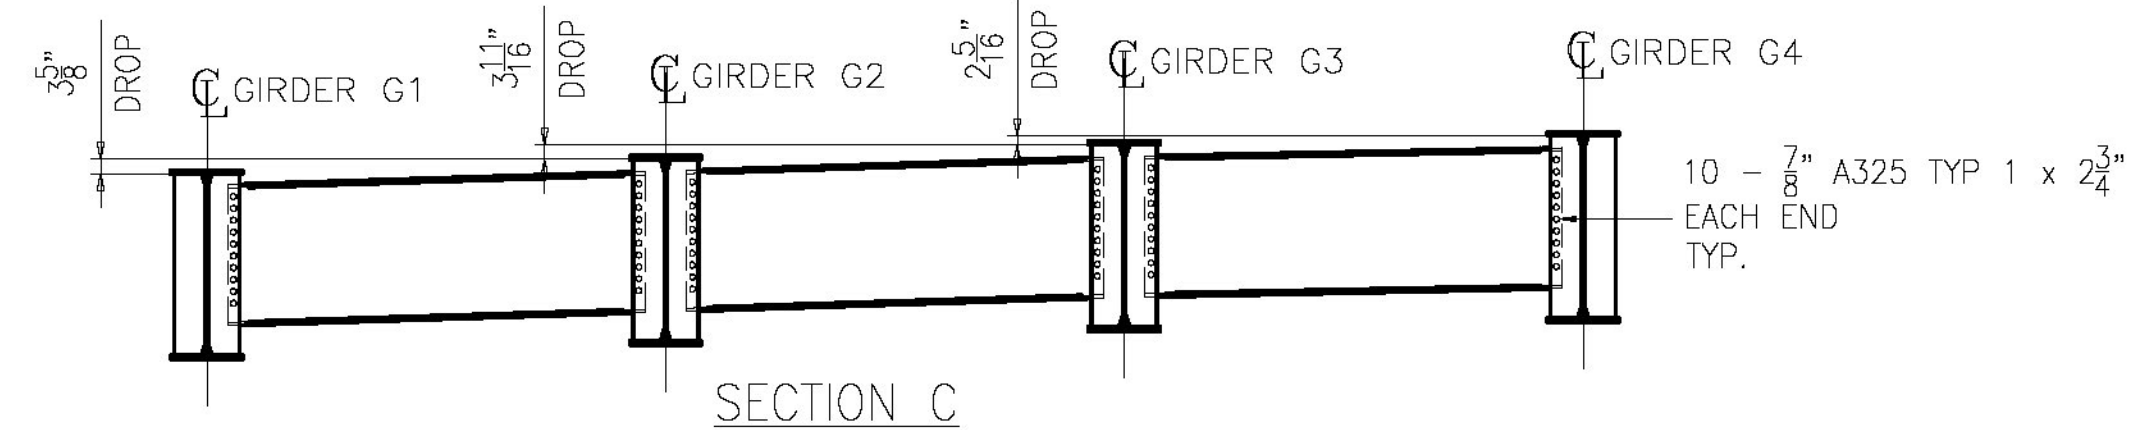
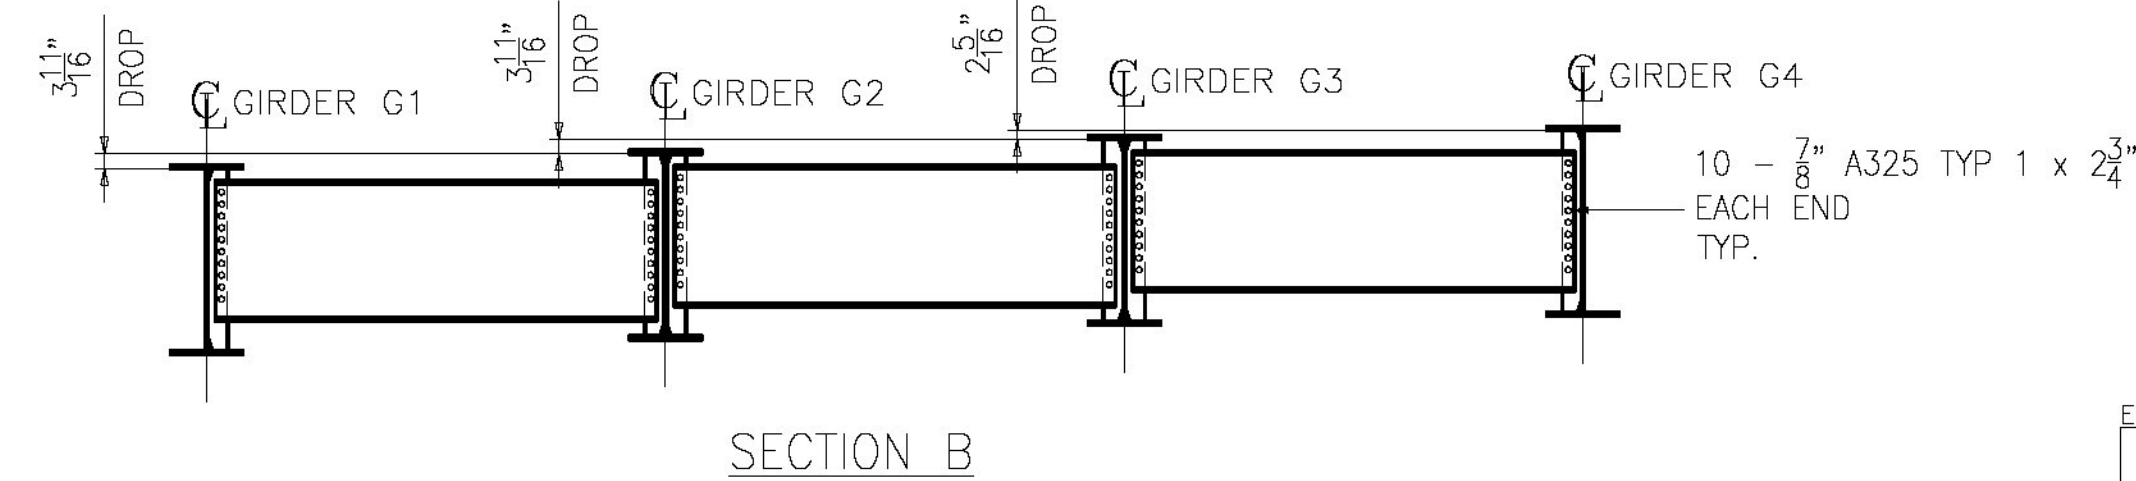


Vermont Agency of Transportation
RECEIVED

CK'D BY FDB OK'D BY HIS

June 10, 2015

RESUBMIT No Approved
 BY Carolyn Carlson DATE 06/11/15

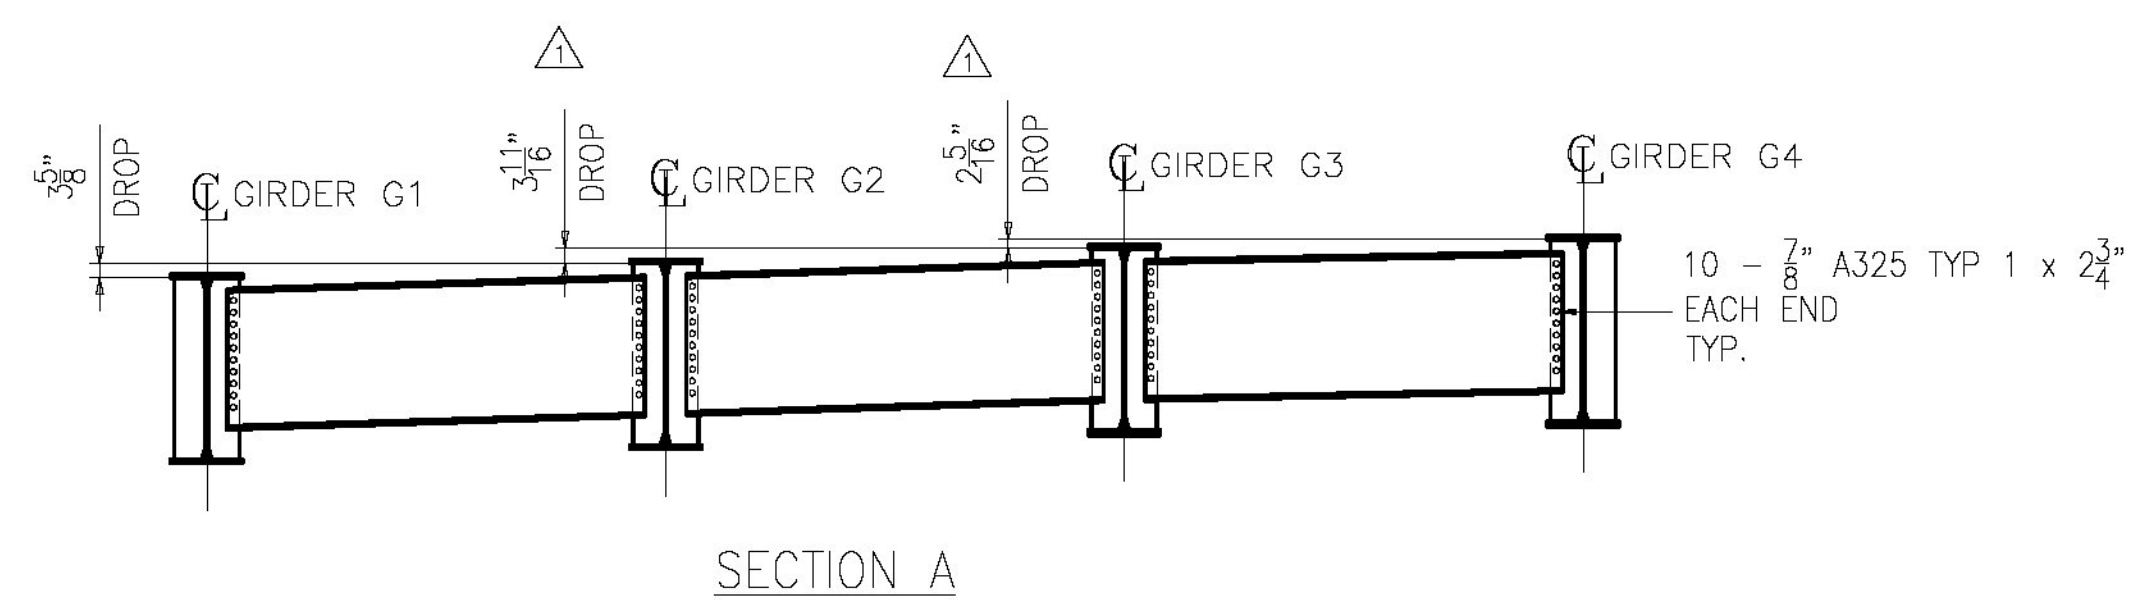

NOTES:

1. FOR GENERAL NOTES SEE SHEET GN1.

1	06/05/15	PER APPROVAL COMMENTS	EG	YT		
0						
REV.	DATE	REMARKS	DWN	CHK	APVL	SHOP

MATERIAL:	SURFACE PREP. & PAINT:	HOLES:	SHOP BOLTS:
		-	NONE

DESCRIPTION: FRAMING PLAN

CASCO BAY STEEL STRUCTURES, INC.
 1 WALLACE AVE. PHONE (207) 780-6722
 SOUTH PORTLAND, ME 04106 FAX. (207) 780-6726

STRUCTURE:	DRAWN:	DATE:
REPLACEMENT OF BRIDGE NO. 12 ON TH27 INCLUDING APPROACH ROADWAY AND CHANNEL WORK	BK	04/21
TOWN OF COLCHESTER, COUNTY OF CHITTENDEN	CHKD:	DATE:
STATE OF VERMONT AGENCY OF TRANSPORTATION	YT	04/28

LOCATION:	COLCHESTER / CHITTENDEN, VT	JOB NO.	DWG NO.
PROJ NO.	STP 5600(12)	629-1	E1
CUSTOMER:	A.L. ST. ONGE		REV.

ENGINEERING REVIEW STAMP