




**CAMBER DIAGRAM FOR 1G1A**

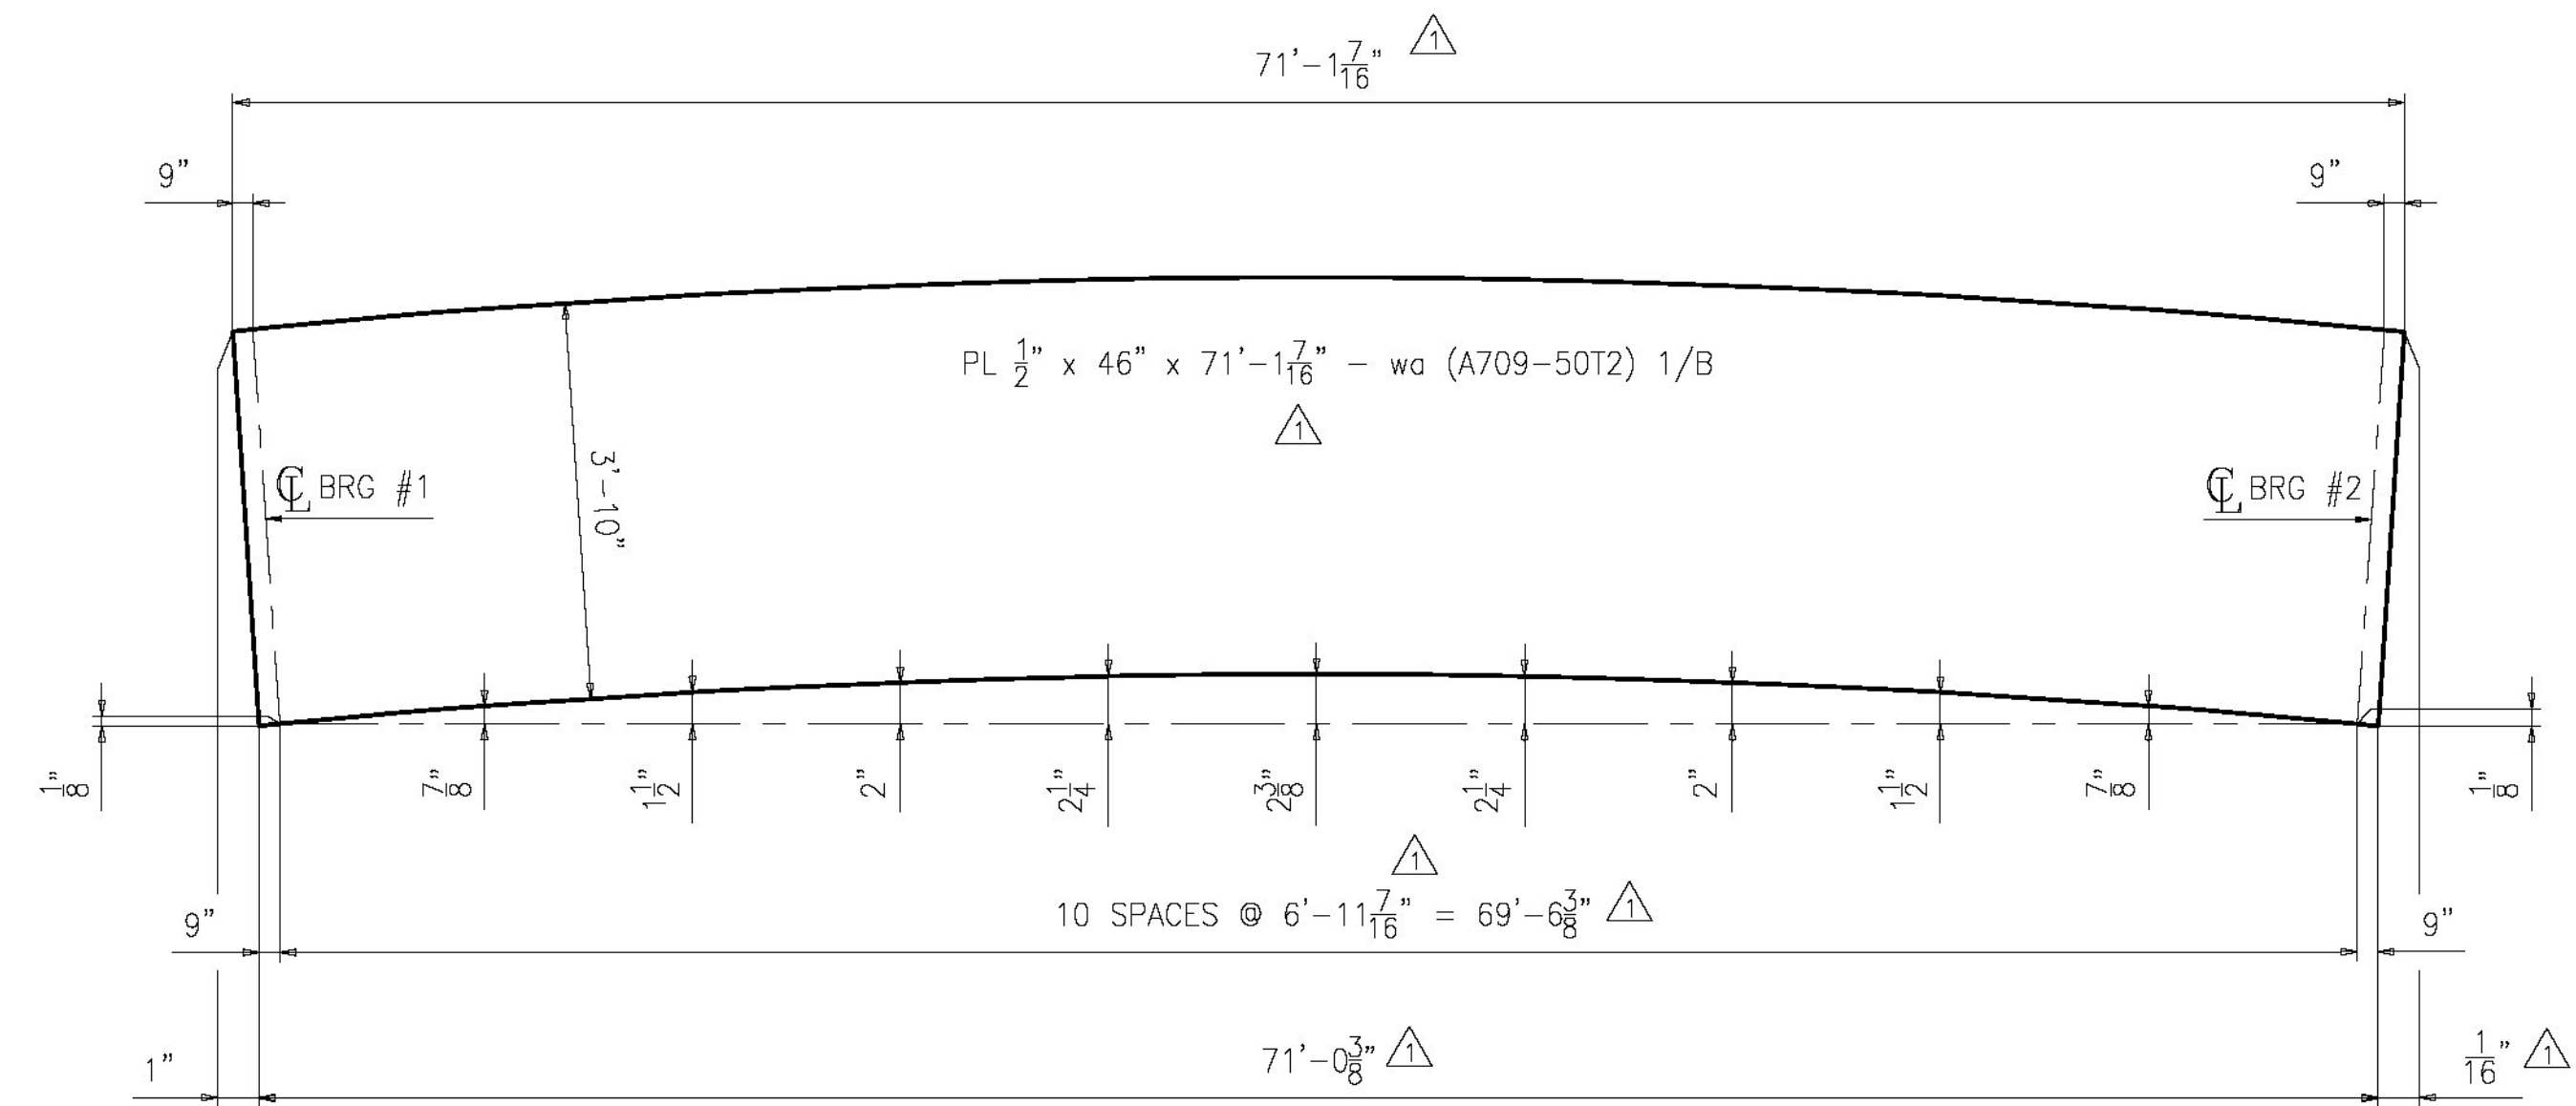

**CAMBER DIAGRAM FOR 2G2A**

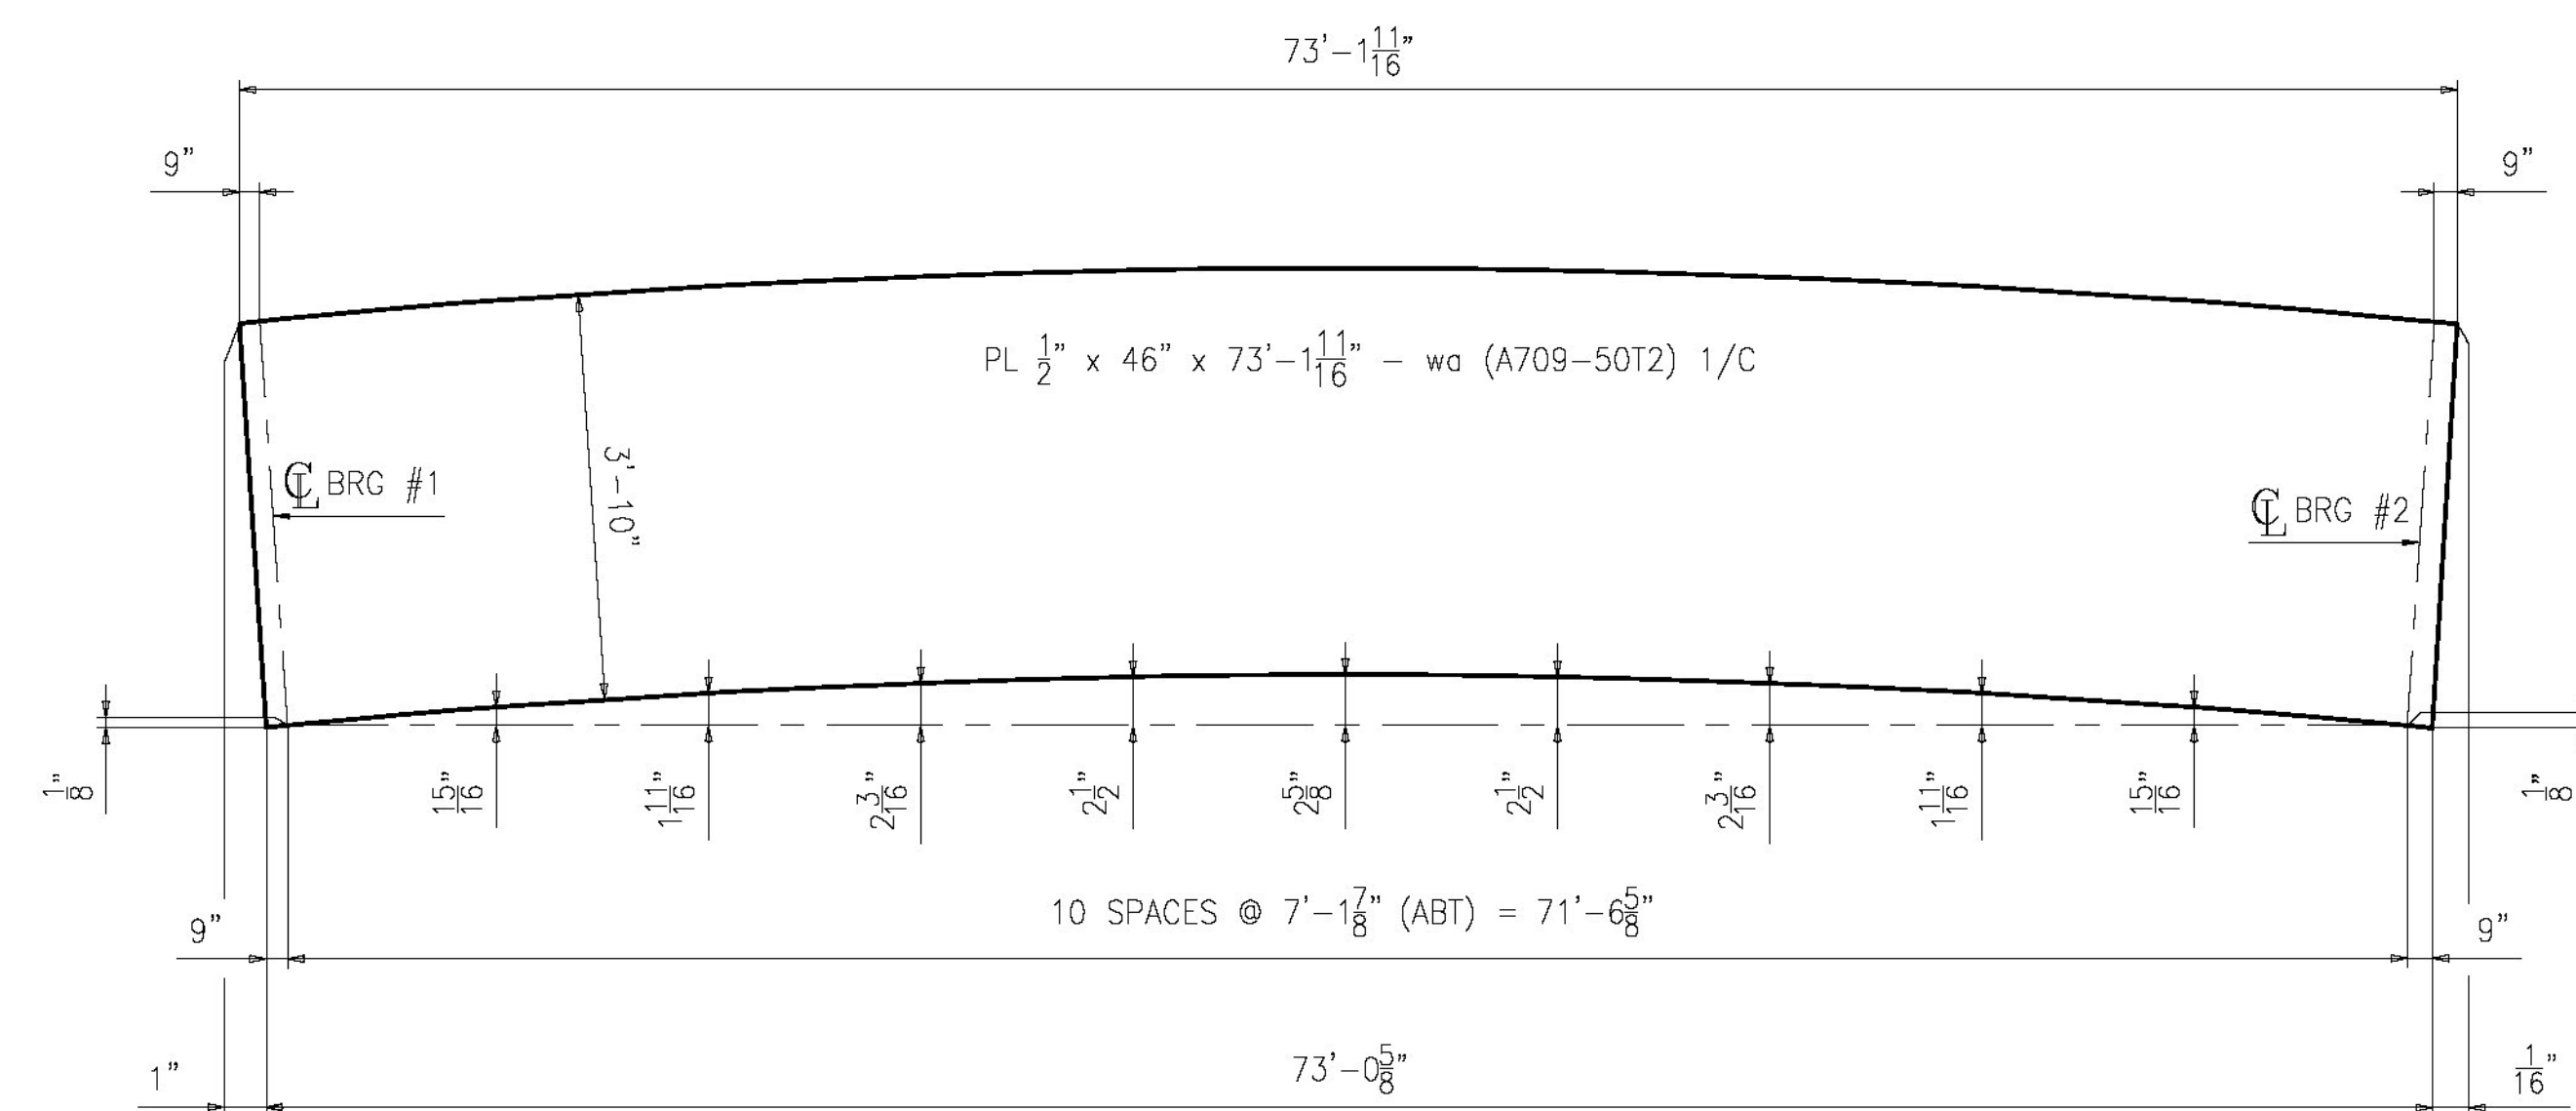

**CAMBER DIAGRAM FOR 3G3A**

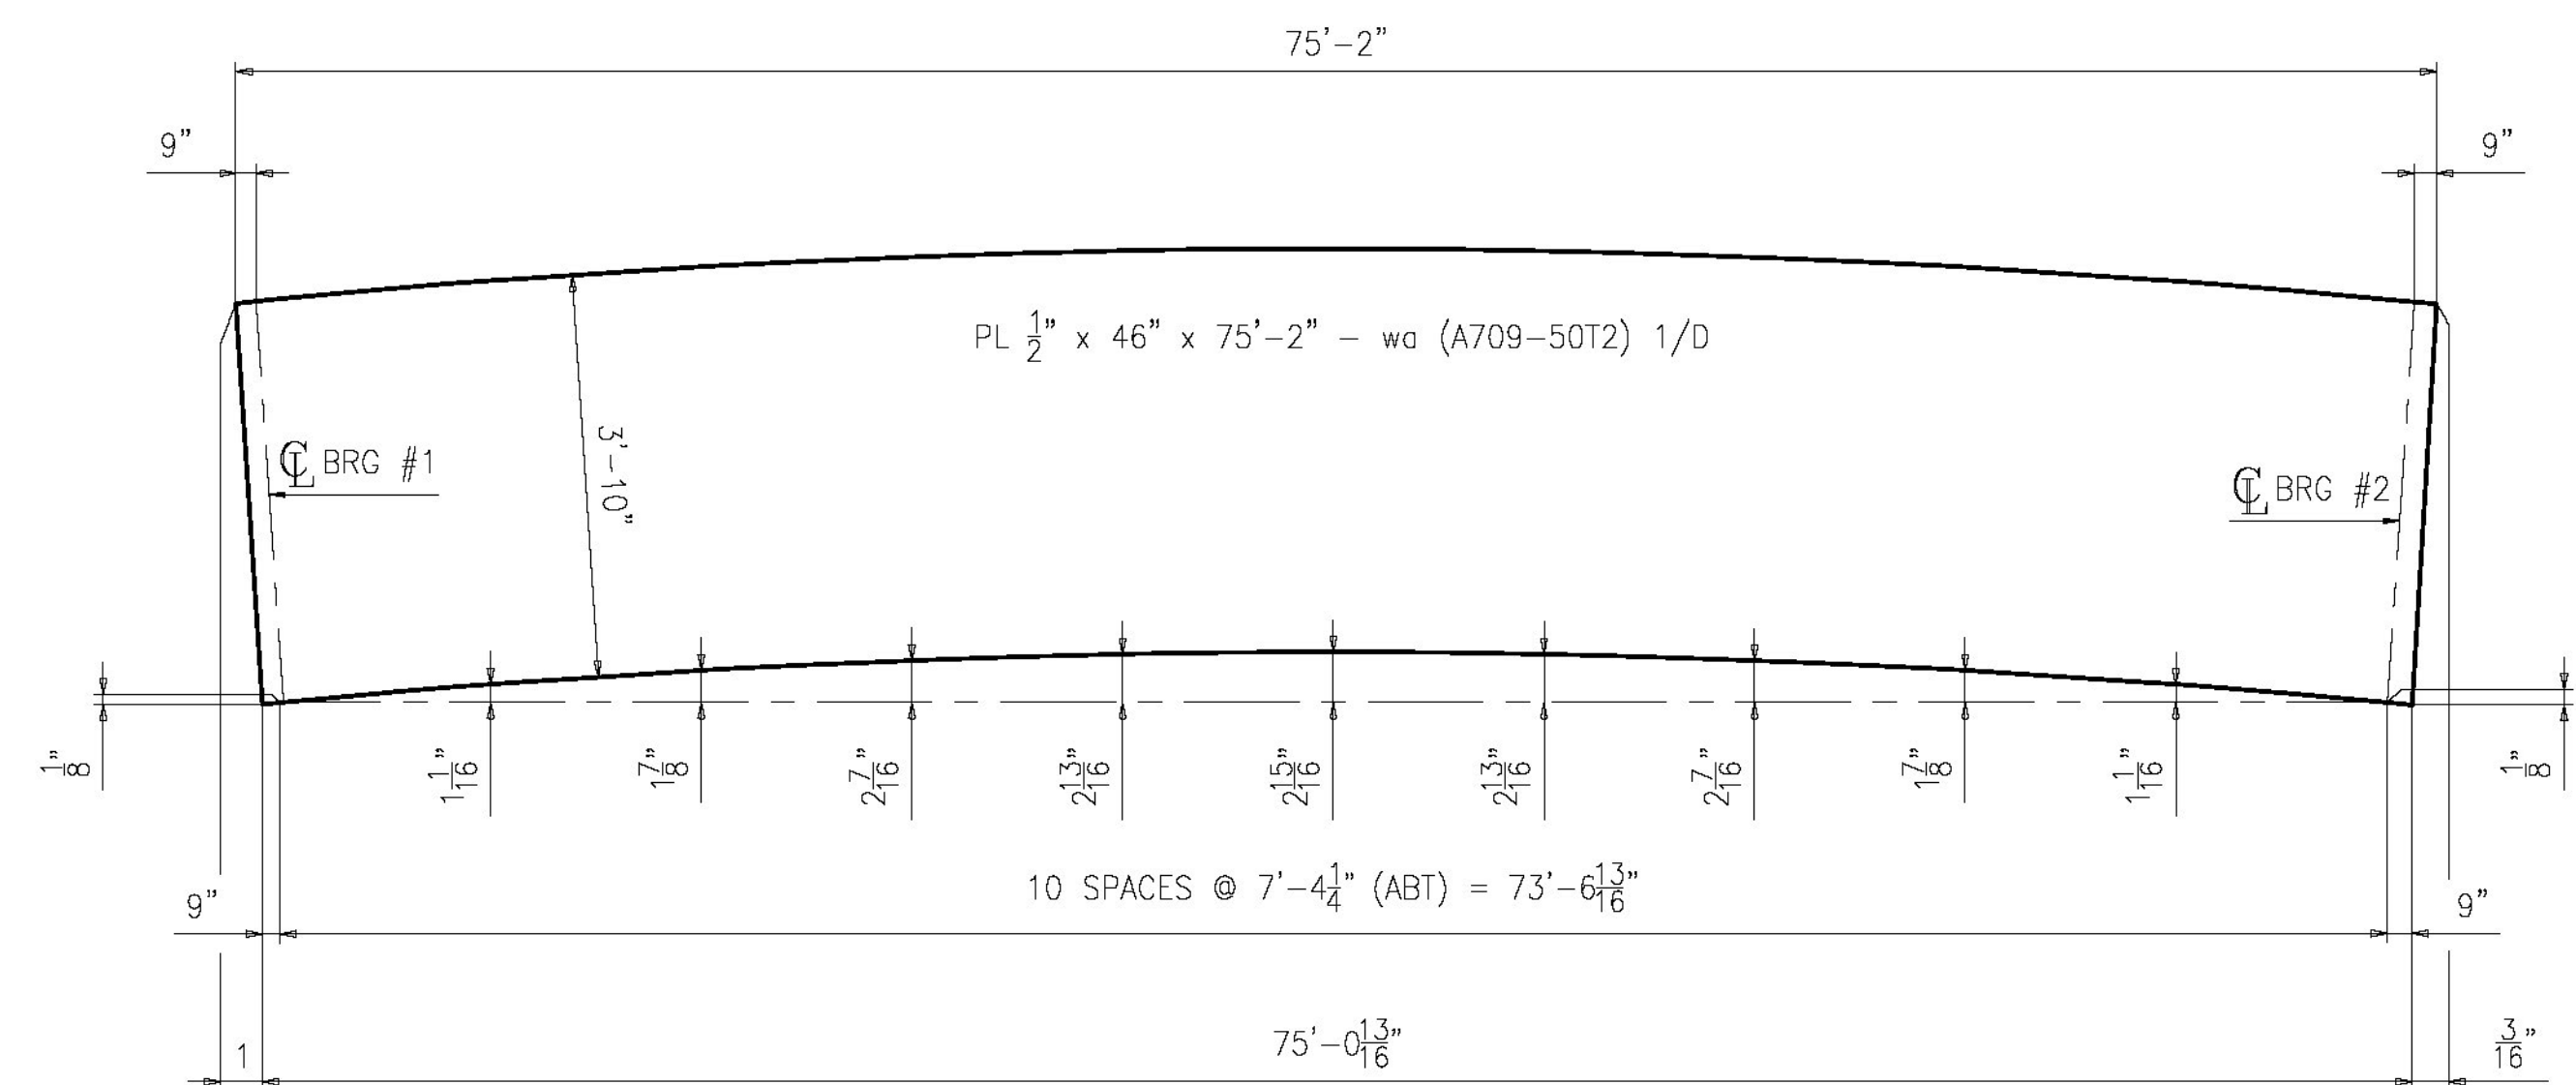

**CAMBER DIAGRAM FOR 4G4A**

**NOTES:**

- FOR GENERAL NOTES SEE SHEET GN1.
- T2 - DENOTES MATERIAL TO BE CHARPY V-NOTCH TESTED (ZONE 2)

| 1    | 06/05/15 | PER APPROVAL COMMENTS | EG  | YT  |      |      |
|------|----------|-----------------------|-----|-----|------|------|
| 0    |          |                       |     |     |      |      |
| REV. | DATE     | REMARKS               | DWN | CHK | APVL | SHOP |

|           |                        |        |             |
|-----------|------------------------|--------|-------------|
| MATERIAL: | SURFACE PREP. & PAINT: | HOLES: | SHOP BOLTS: |
|           | SEE DWG GN1            | 15/16" | NONE        |

DESCRIPTION: CAMBER DIAGRAMS

**CASCO BAY STEEL STRUCTURES, INC.**  
 1 WALLACE AVE. PHONE (207) 780-6722  
 SOUTH PORTLAND, ME 04106 FAX. (207) 780-6726  
 TENCA 1415

|   |         |         |
|---|---------|---------|
| STRUCTURE:  | DRAWN:  | DATE:   |
| REPLACEMENT OF BRIDGE NO. 12 ON TH27 INCLUDING APPROACH ROADWAY AND CHANNEL WORK TOWN OF COLCHESTER, COUNTY OF CHITTENDEN STATE OF VERMONT AGENCY OF TRANSPORTATION | BK      | 04/22   |
|   | CHKD:   | DATE:   |
|   | YT      | 04/28   |
| LOCATION: COLCHESTER / CHITTENDEN, VT   | JOB NO. | DWG NO. |
| PROJ NO. STP 5600(12)   | 629-1   | C1      |
| CUSTOMER: A.L. ST. ONGE   | REV.    | △       |

**Vermont Agency of Transportation**  
**RECEIVED**  
 CK'D BY FDB OK'D BY HIS  
**June 10, 2015**  
 RESUBMIT No Approved  
 BY Carolyn Carlson DATE 06/11/15

ENGINEERING REVIEW STAMP