
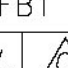


ABM INFO		BILL OF MATERIAL				JOB NO.	DRAWING NO.	REV.
PAGE	LINE	MARK	QTY	MARK	MATERIAL	LENGTH FT INCHES	REMARKS	WT
			360		A325 TYP 1 7/8"	2 3/4	1FL DTIS WASHER	
							+ 1 FL WASHER	

FIELD BOLT LIST					A325 TYPE 1 BOLTS					PIECES CONNECTED AND REMARKS	
LINE	NO REQ'D	BOLT DIAM.	BOLT LEN.	BOLTS /CONN.	NO OF /CONN.	GRIP*	THICK. OF PCS. CONNECTED			WASH CODE	
1	360	7/8"	2 3/4"	10	36	1 1/2"	5/8"	1/2"		3	DIAPHRAGM TO GIRDER CONNECTION PLATE

\* GRIP LENGTHS EXCLUDE WASHER THICKNESS

1: 1 HARD DTI'S/LOAD INDICATOR FLAT WASHER  
2: 2 HARD DTI'S/LOAD INDICATOR FLAT WASHERS  
3: 1 HARD DTI'S/LOAD INDICATOR FLAT WASHER AND 1 HARDENED WASHER.

REV.	DATE	REMARKS	DWN	CHK	APVL	SHOP
MATERIAL:		SURFACE PREP. & PAINT:		HOLES:		SHOP BOLTS:
				15/16"		NONE
DESCRIPTION: FIELD BOLT LIST						
 <b>CASCO BAY STEEL STRUCTURES, INC.</b> 1 WALLACE AVE. SOUTH PORTLAND, ME 04106 FAX. (207) 780-6726 PHONE (207) 780-6722						
STRUCTURE:			DRAWN:	DATE:		
REPLACEMENT OF BRIDGE NO. 12 ON TH27 INCLUDING APPROACH ROADWAY AND CHANNEL WORK TOWN OF COLCHESTER, COUNTY OF CHITTENDEN STATE OF VERMONT AGENCY OF TRANSPORTATION			BK	04/22		
			CHKD:	DATE:		
			YT	04/28		
LOCATION: COLCHESTER / CHITTENDEN, VT			JOB NO.	DWG NO.		
PROJ NO. STP 5600(12)			629-1	FB1		
CUSTOMER: A.L. ST. ONCE				REV. 		

**Vermont Agency of Transportation**  
**RECEIVED**  
©2015 CSO Colchester, VT. REV1 approved as noted p.8

CK'D BY FDB OK'D BY HIS  
**June 10, 2015**

RESUBMIT No Approved  
BY Carolyn Carlson DATE 06/11/15

**WORK THIS DRAWING WITH E1**

ENGINEERING REVIEW STAMP