



STATE OF VERMONT
AGENCY OF TRANSPORTATION

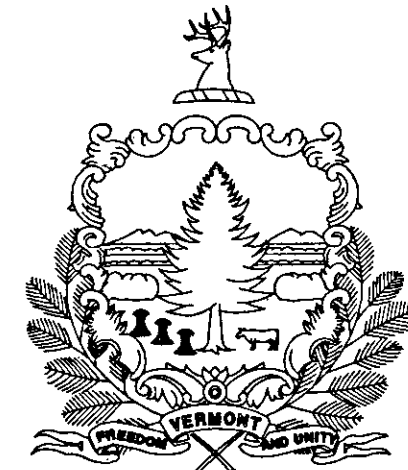

PROPOSED IMPROVEMENT
BRIDGE PROJECT
CITY OF BARRE
COUNTY OF WASHINGTON

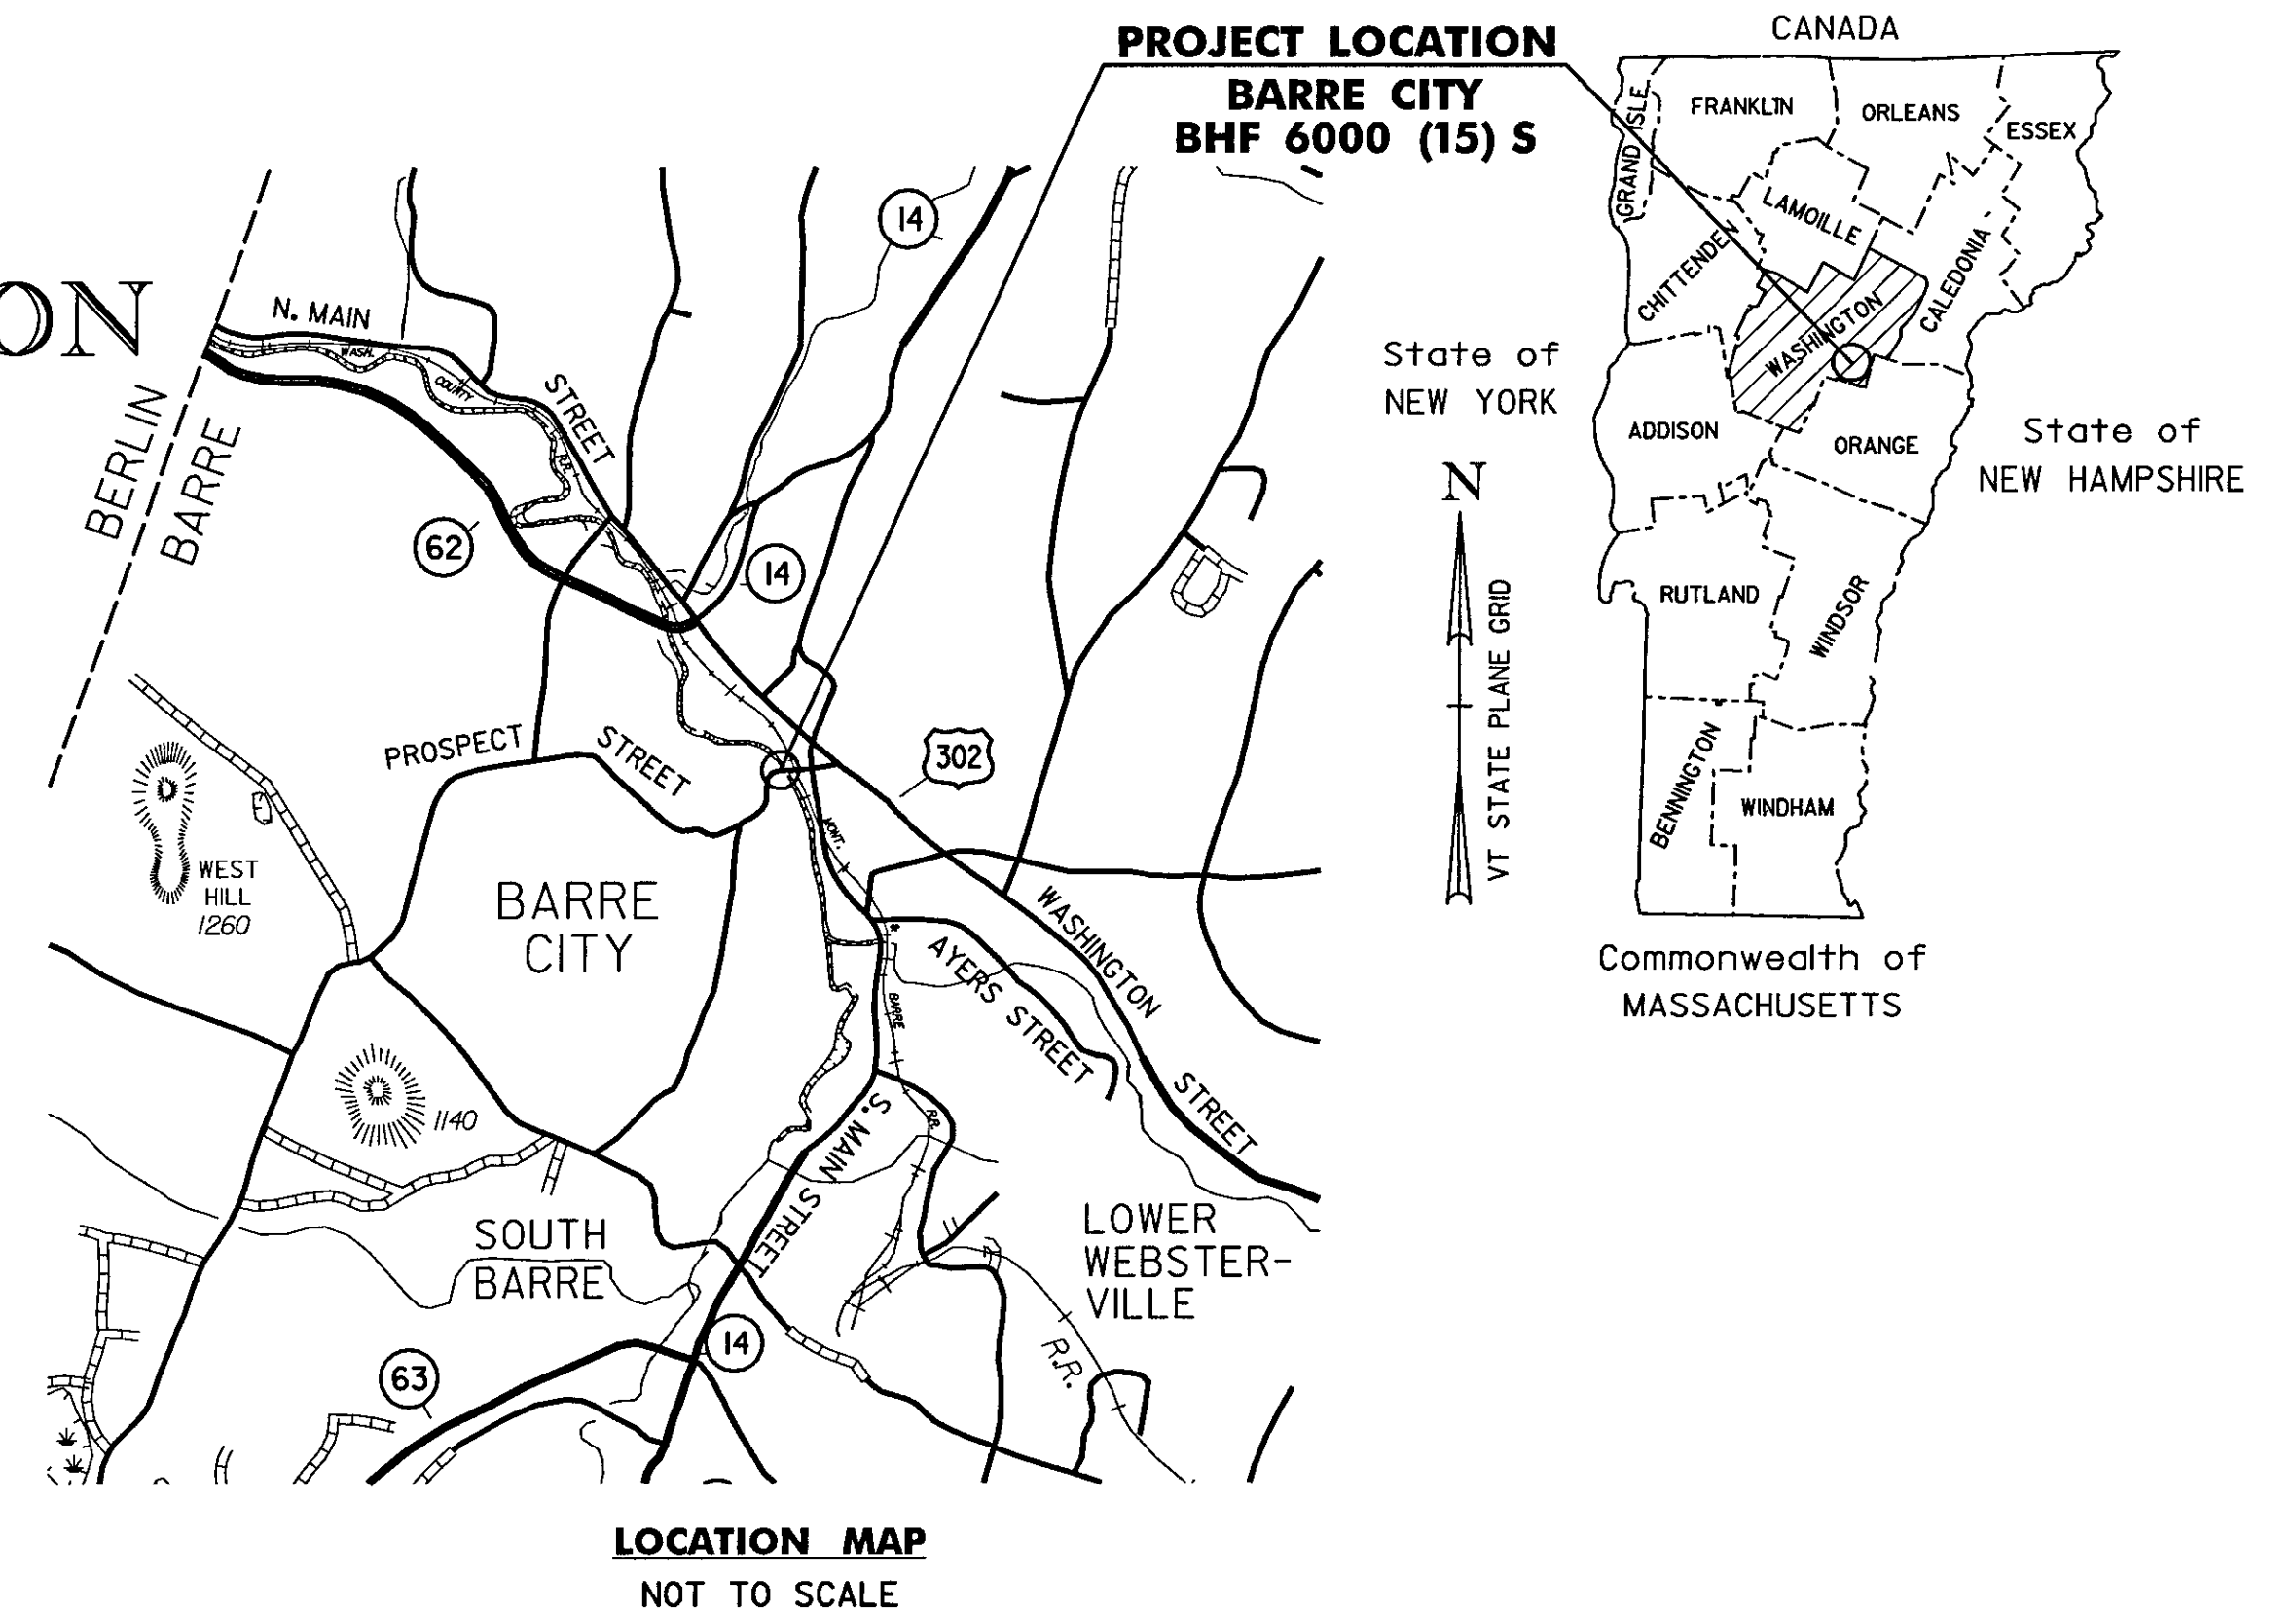

INDEX OF SHEETS
SEE SHEET 2

ROUTE NO : TH NO. 7 BRIDGE NO : 7
FUNCTIONAL CLASSIFICATION: URBAN COLLECTOR

PROJECT LOCATION : BEGINNING ON PROSPECT STREET TH NO. 7 AT A POINT APPROXIMATELY 603 FEET WEST OF THE INTERSECTION OF MAIN ST. (VT. 14) IN THE CITY OF BARRE AND EXTENDING EAST 325 FEET ALONG PROSPECT STREET.

PROJECT DESCRIPTION : REMOVAL OF EXISTING SUPERSTRUCTURE AND CONCRETE ABUTMENT CAPS, CONSTRUCTION OF A NEW CAST-IN-PLACE CONCRETE/STEEL BEAM COMPOSITE SUPERSTRUCTURE, CAST-IN-PLACE CONCRETE ABUTMENT CAPS AND CAST-IN-PLACE CONCRETE SIDEWALK WITH ASSOCIATED ROADWAY APPROACH AND UTILITY IMPROVEMENTS.

LENGTH OF STRUCTURE : 64.19 FEET.
LENGTH OF ROADWAY : 260.81 FEET.
LENGTH OF PROJECT : 325.00 FEET.

RECORD PLANS

CONTRACTOR: S. D. IRELAND CONCRETE CONST. CORP. - BURLINGTON, VT

RESIDENT ENGINEER: DAVID F. HALE

CONSTRUCTION BEGAN: MAY 15, 2009


CONSTRUCTION COMPLETE: MAY 6, 2010

RECORD PLANS BY: DAVID F. HALE & NICK GARBACIK

I HEREBY CERTIFY THAT ALL THE CONSTRUCTION REQUIRED BY THIS SET OF DRAWINGS HAS BEEN ACCOMPLISHED AS INDICATED HEREIN.

BY *David F. Hale* RESIDENT ENGINEER
DATE 5/25/11

NOTE: Any further information concerning final quantities, amounts or other details relative to this project may be found at Central Files in the electronic archives.



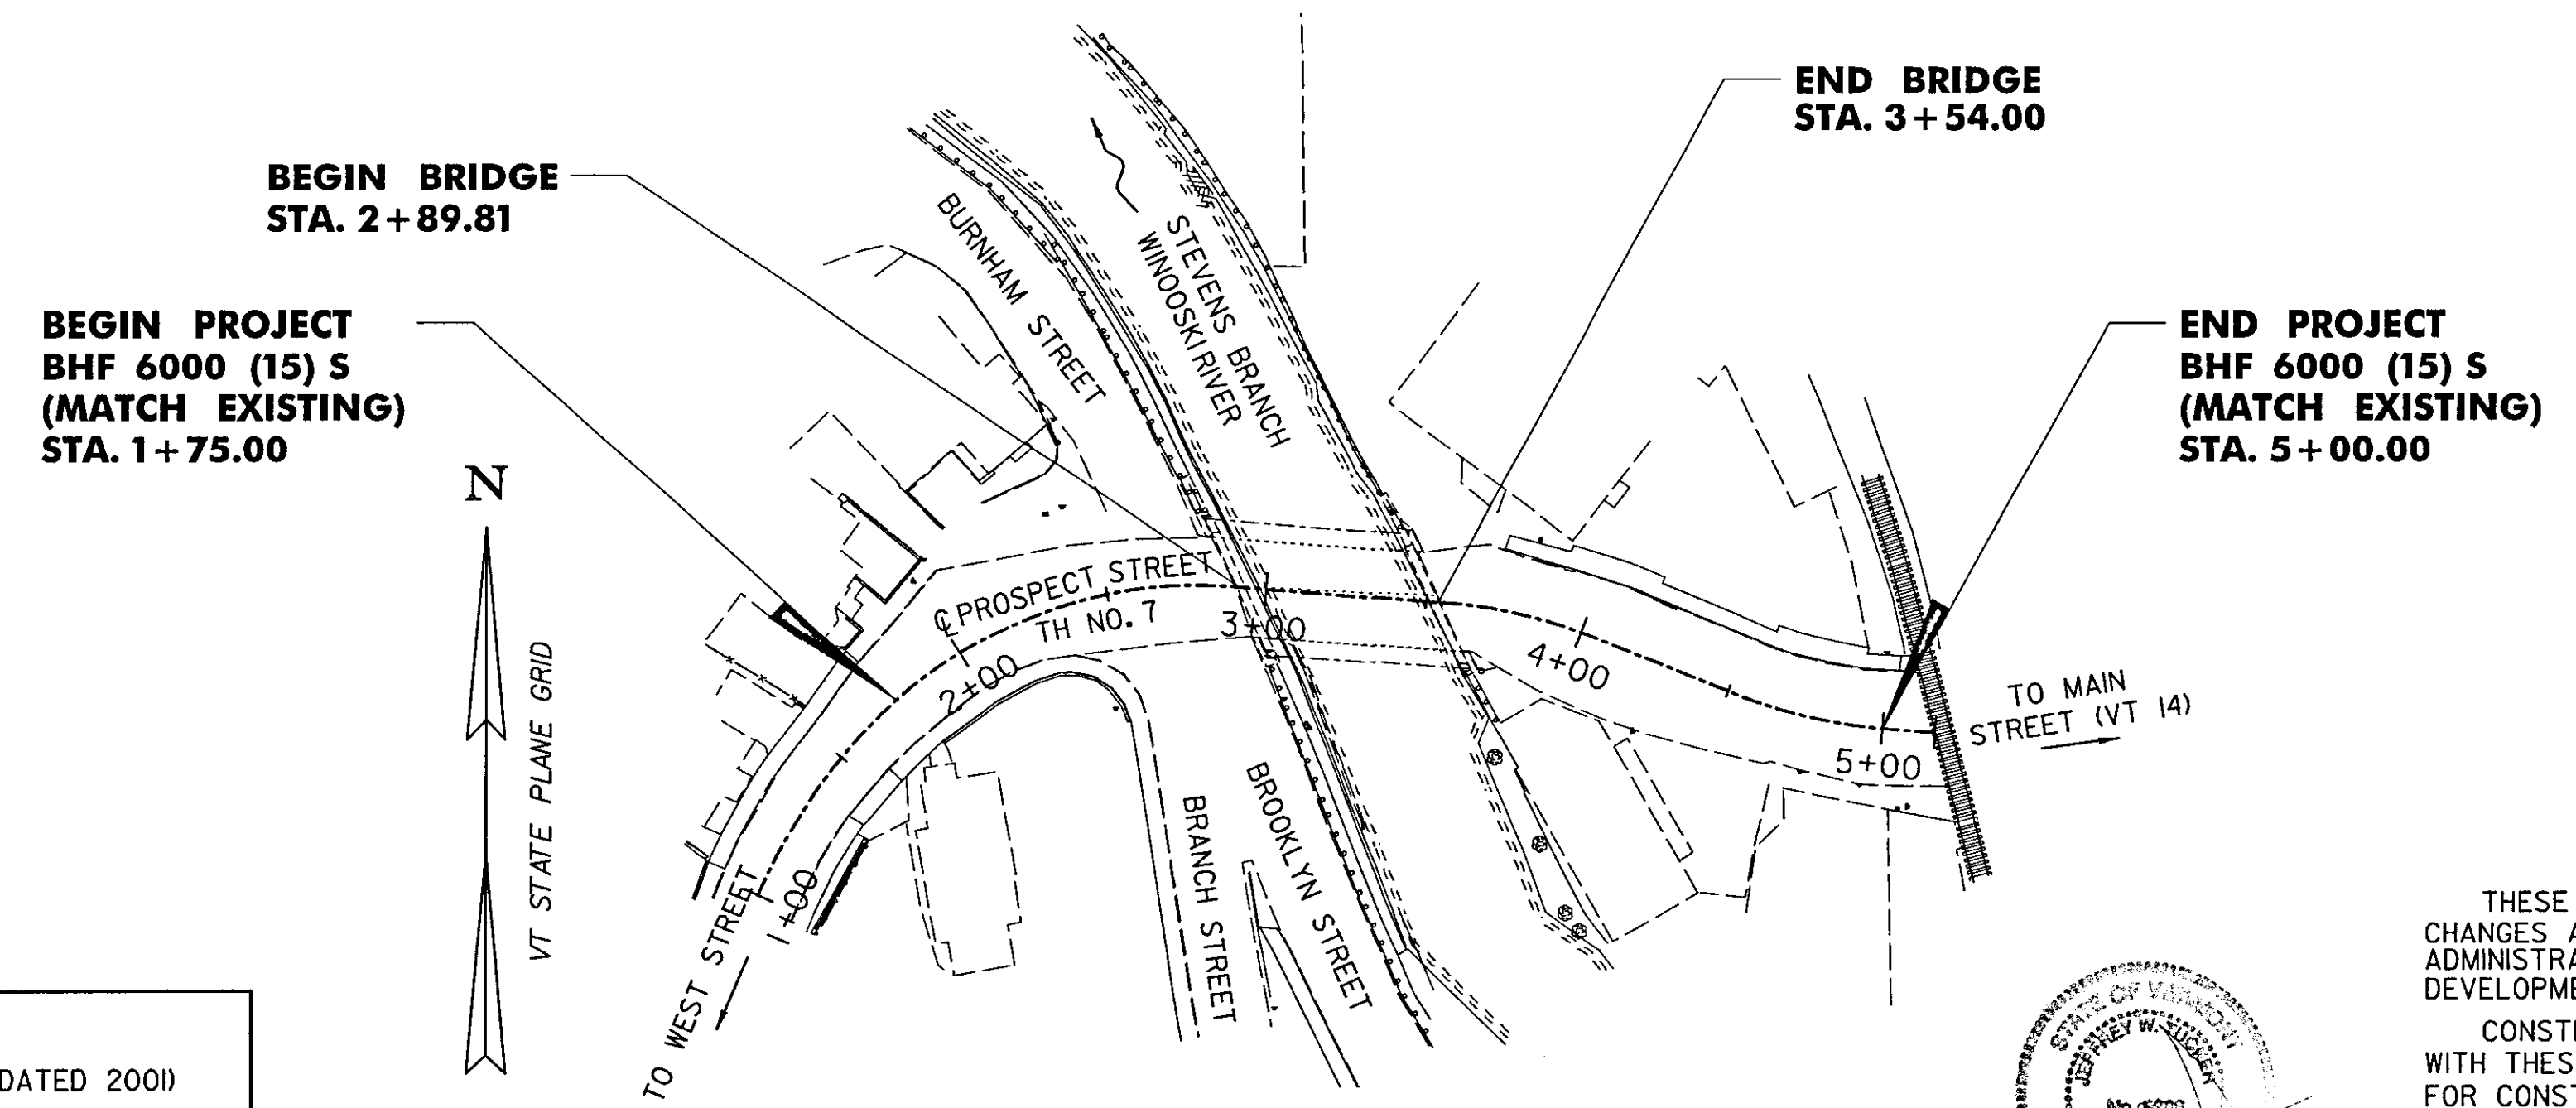


CONVENTIONAL SYMBOLS

COUNTY LINE	
TOWN LINE	
LIMITS OF ACCESS	
POINT OF ACCESS	
FENCE LINE	
STONE WALL	
TRAVELED WAY	
GUARD RAIL	
RAILROAD	
SURVEY LINE	
CULVERT	
POWER POLE	
TELEPHONE POLE	
TREES	
CONTROL OF ACCESS	
PROPERTY LINE	
R.O.W. TAKING LINE	
SLOPE RIGHTS	
TOP OF CUT	
TOE OF SLOPE	

SURVEYED BY : VTRANS
SURVEYED DATE : 1996 (UPDATED 2001)

DATUM
VERTICAL NAVD 88
HORIZONTAL NAD 83/92

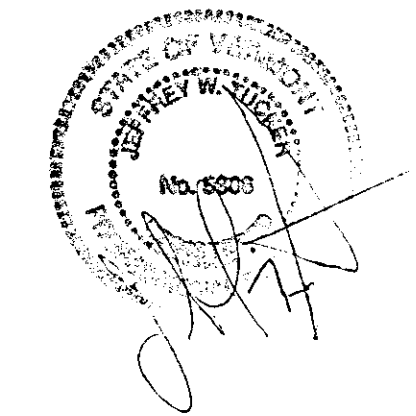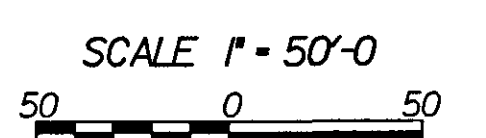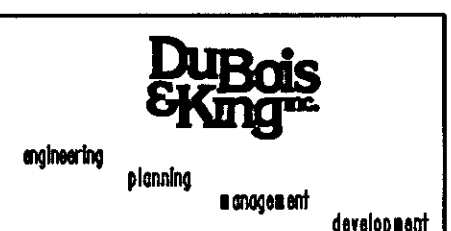

THESE PLANS ARE SUBJECT TO SUCH ENGINEERING CHANGES AS MAY BE REQUIRED BY THE FEDERAL HIGHWAY ADMINISTRATION OR THE DIRECTOR OF PROGRAM DEVELOPMENT.

CONSTRUCTION IS TO BE CARRIED ON IN ACCORDANCE WITH THESE PLANS AND THE STANDARD SPECIFICATIONS FOR CONSTRUCTION DATED 2006, AS APPROVED BY THE FEDERAL HIGHWAY ADMINISTRATION ON JUNE 15, 2006 FOR USE ON THIS PROJECT, INCLUDING ALL SUBSEQUENT REVISIONS AND SUCH REVISED SPECIFICATIONS AND SPECIAL PROVISIONS AS ARE INCORPORATED IN THESE PLANS.

PLOTTED 2/2/2009

DIRECTOR OF PROGRAM DEVELOPMENT	APPROVED <i>Richard Farnsworth</i> DATE 2-2-09
PROJECT MANAGER : SHERWARD FARNSWORTH, P. E.	
PROJECT NAME : BARRE CITY	
PROJECT NUMBER : BHF 6000 (15) S	
SHEET 1 OF 56 SHEETS	