


PLOTTED 2/2/2009

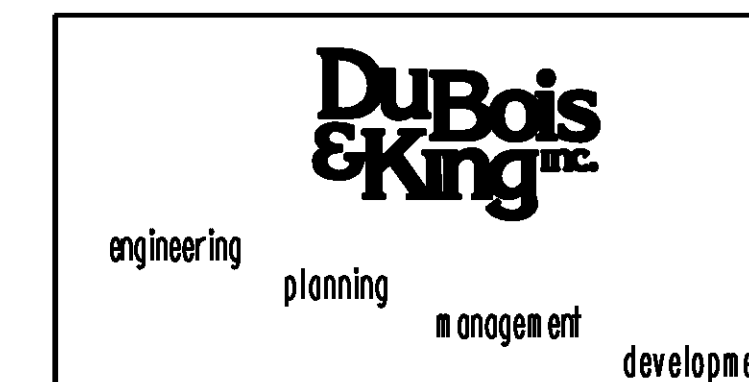

**STATE OF VERMONT  
AGENCY OF TRANSPORTATION**

Town Of	BARRE CITY	Bridge No.	7
Highway No.	PROSPECT ST.	Log Sta.	
		Surv. Sta.	

**PROSPECT ST. OVER STEVENS BRANCH**

**SIDE ROAD CROSS SECTIONS**

Designed By	A. P. GUYETTE	Drawn By	S. J. BIJOLLE
Checked By	Date	Bridge Design Supervisor	Date
E. P. DETRICK	1/09	J. W. TUCKER	1/09

PROJECT	BARRE CITY	PROJECT NO.	BHF 6000 (15) S
---------	------------	-------------	-----------------

I.G.C. info.	
Bridge Sheet No.	Sheet 54 of 56