


ERECTOR PLAN

**ERECTOR NOTE:**  
 THE TEMPORARY DIAPHRAGMS SHALL REMAIN IN PLACE UNTIL THE CONCRETE DECK IS FULLY CURED. FOLLOWING APPROVAL FROM THE ENGINEER THE DIAPHRAGMS ARE TO BE REMOVED AND SHALL BECOME THE PROPERTY OF THE CONTRACTOR.

Accepted	
Accepted as Noted	
Accepted Noted Resubmit	
Rejected, Revise Resubmit	
Rejected - Unacceptable	
Checking is only for conformance with the design concept of the Project and compliance with the information given in the Contract Documents. The Engineer assumes no liability for errors or omissions that may be contained herein. The Contractor, by approving and submitting these documents, verifies their accuracy as stipulated on the Contractor's Shop Drawing Stamp.	
Date: 6/9/09	DUBOIS AND KING By: [Signature]

FIELD BOLT CONNECTION LIST					
QTY.	DIAM.	LENGTH	GRIP	THICKNESS OF PIECES CONNECTED	CONNECTION
144	7/8	0'-2 1/2	7/8	1/2 3/8	INTERMEDIATE DIAPHRAGMS TO STRINGERS
6	7/8	0'-2 1/2	7/8	1/2 3/8	DIAPHRAGM BETWEEN 9S8 & 2S1
48	7/8	0'-2	1 1/8	1/2 5/8	WATER LINE SUPPORTS (TEE TO WF)
48	7/8	0'-2 1/2	1 1/8	1/2 5/8	WATER LINE SUPPORTS (D3 TO STRINGER)
5	7/8	0'-2 1/2	1 1/8	1/2 5/8	BENT PLATE @ STR. 9S8 TO STR. 2S1

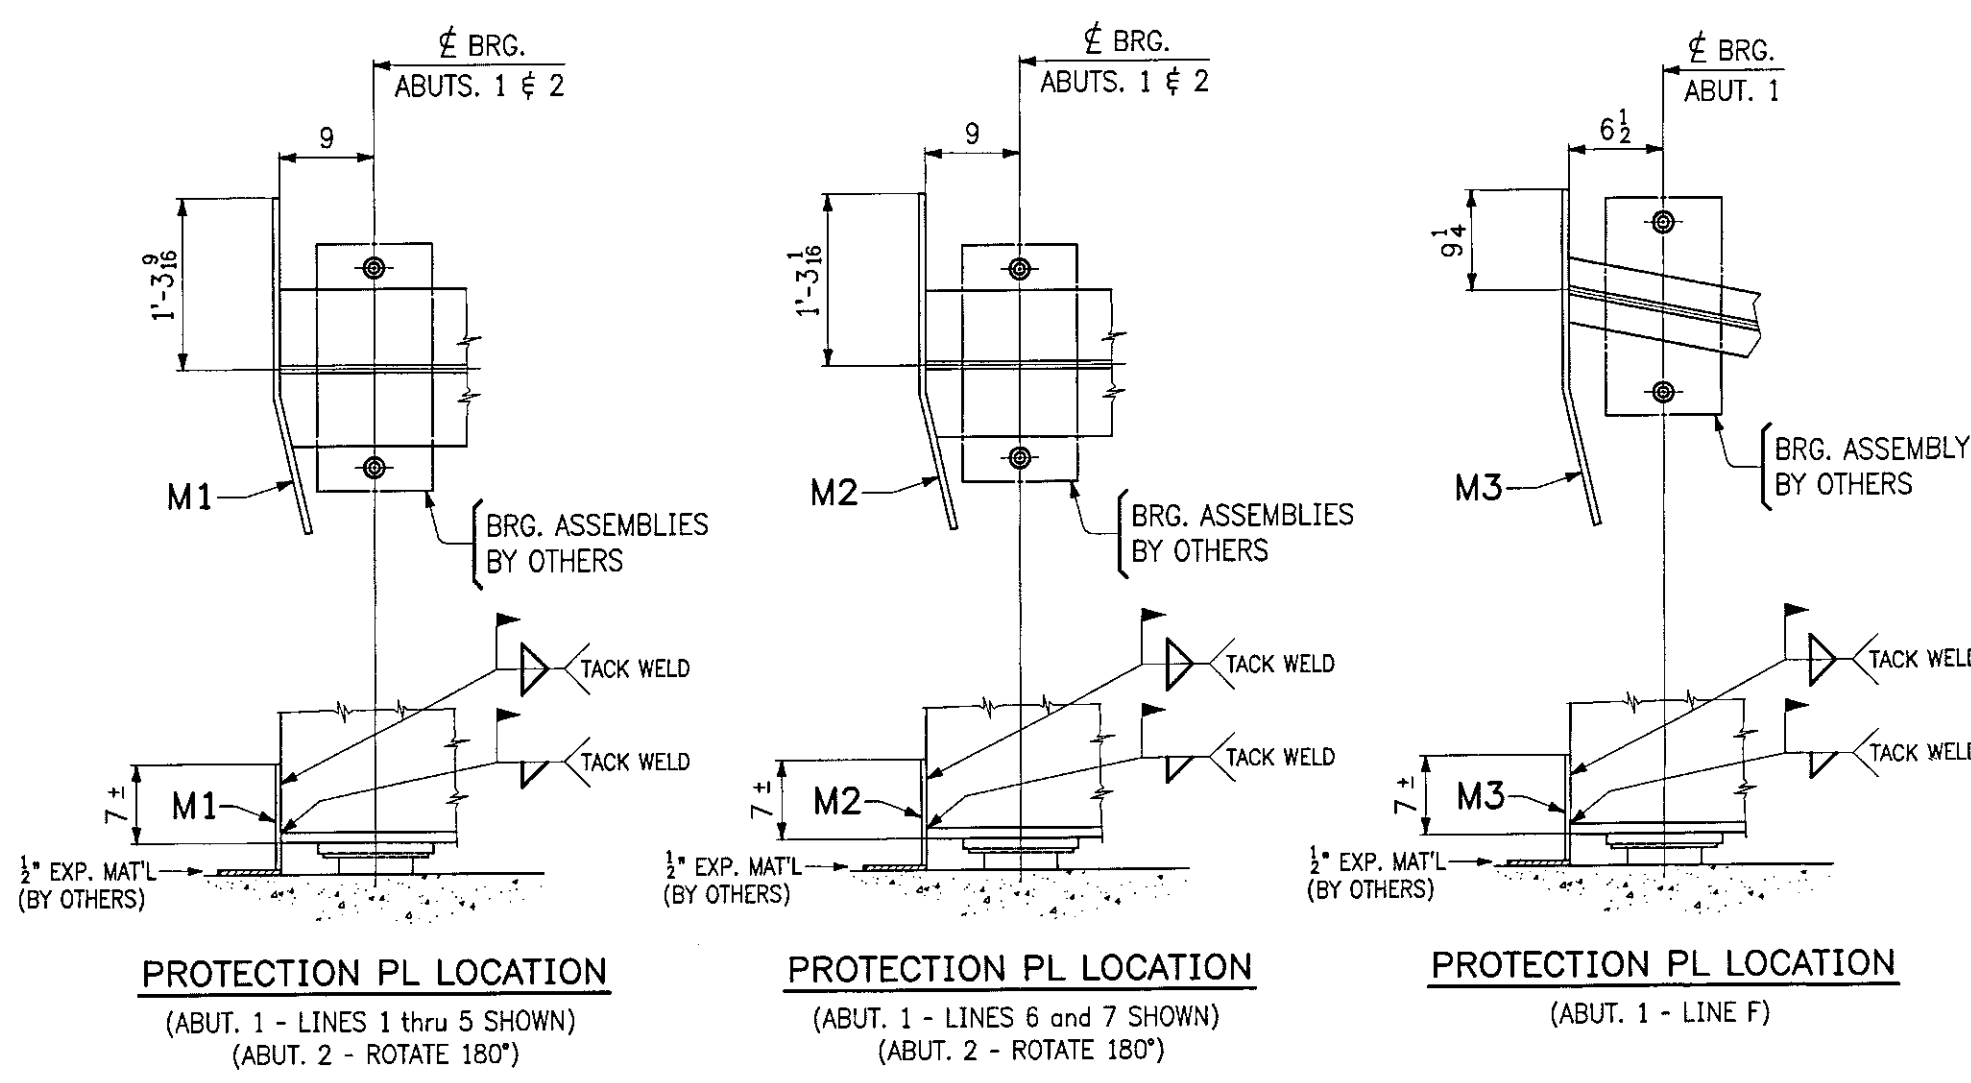

REVISIONS		PRINT RECORD	
NO.	DATE	DESCRIPTION	DATE
			5/7
			5/29
			6/15

PROJECT:	PROSPECT ST. OVER STEVENS BRANCH	DATE:	5-4-09
	PROJECT NO. BHF 6000 (15) S	DRAWN BY:	PSK
	BRIDGE NO. 7	CHECKED BY:	SDC/UX
	BARRE CITY, VERMONT	JOB NO.:	J-80
DESCRIPTION:	ERECTOR PLAN	SHT. NO.:	E1
ARCH:	N/A	ENGR:	VERMONT AGENCY OF TRANSPORTATION
CUSTOMER:	S.D. IRELAND CONCRETE CONSTRUCTION CORP.		