


H = HOLE SIDE
 SS = SHORT SLOTTED SIDE
 LS = LONG SLOTTED SIDE

NOTE: FOR GEN. NOTES AND TYP. DETAILS
 SEE DWG LB5
 FOR NORTH RAILING ELEVATIONS SEE LB8
 FOR APPROACH RAILINGS SEE LB15 & LB16

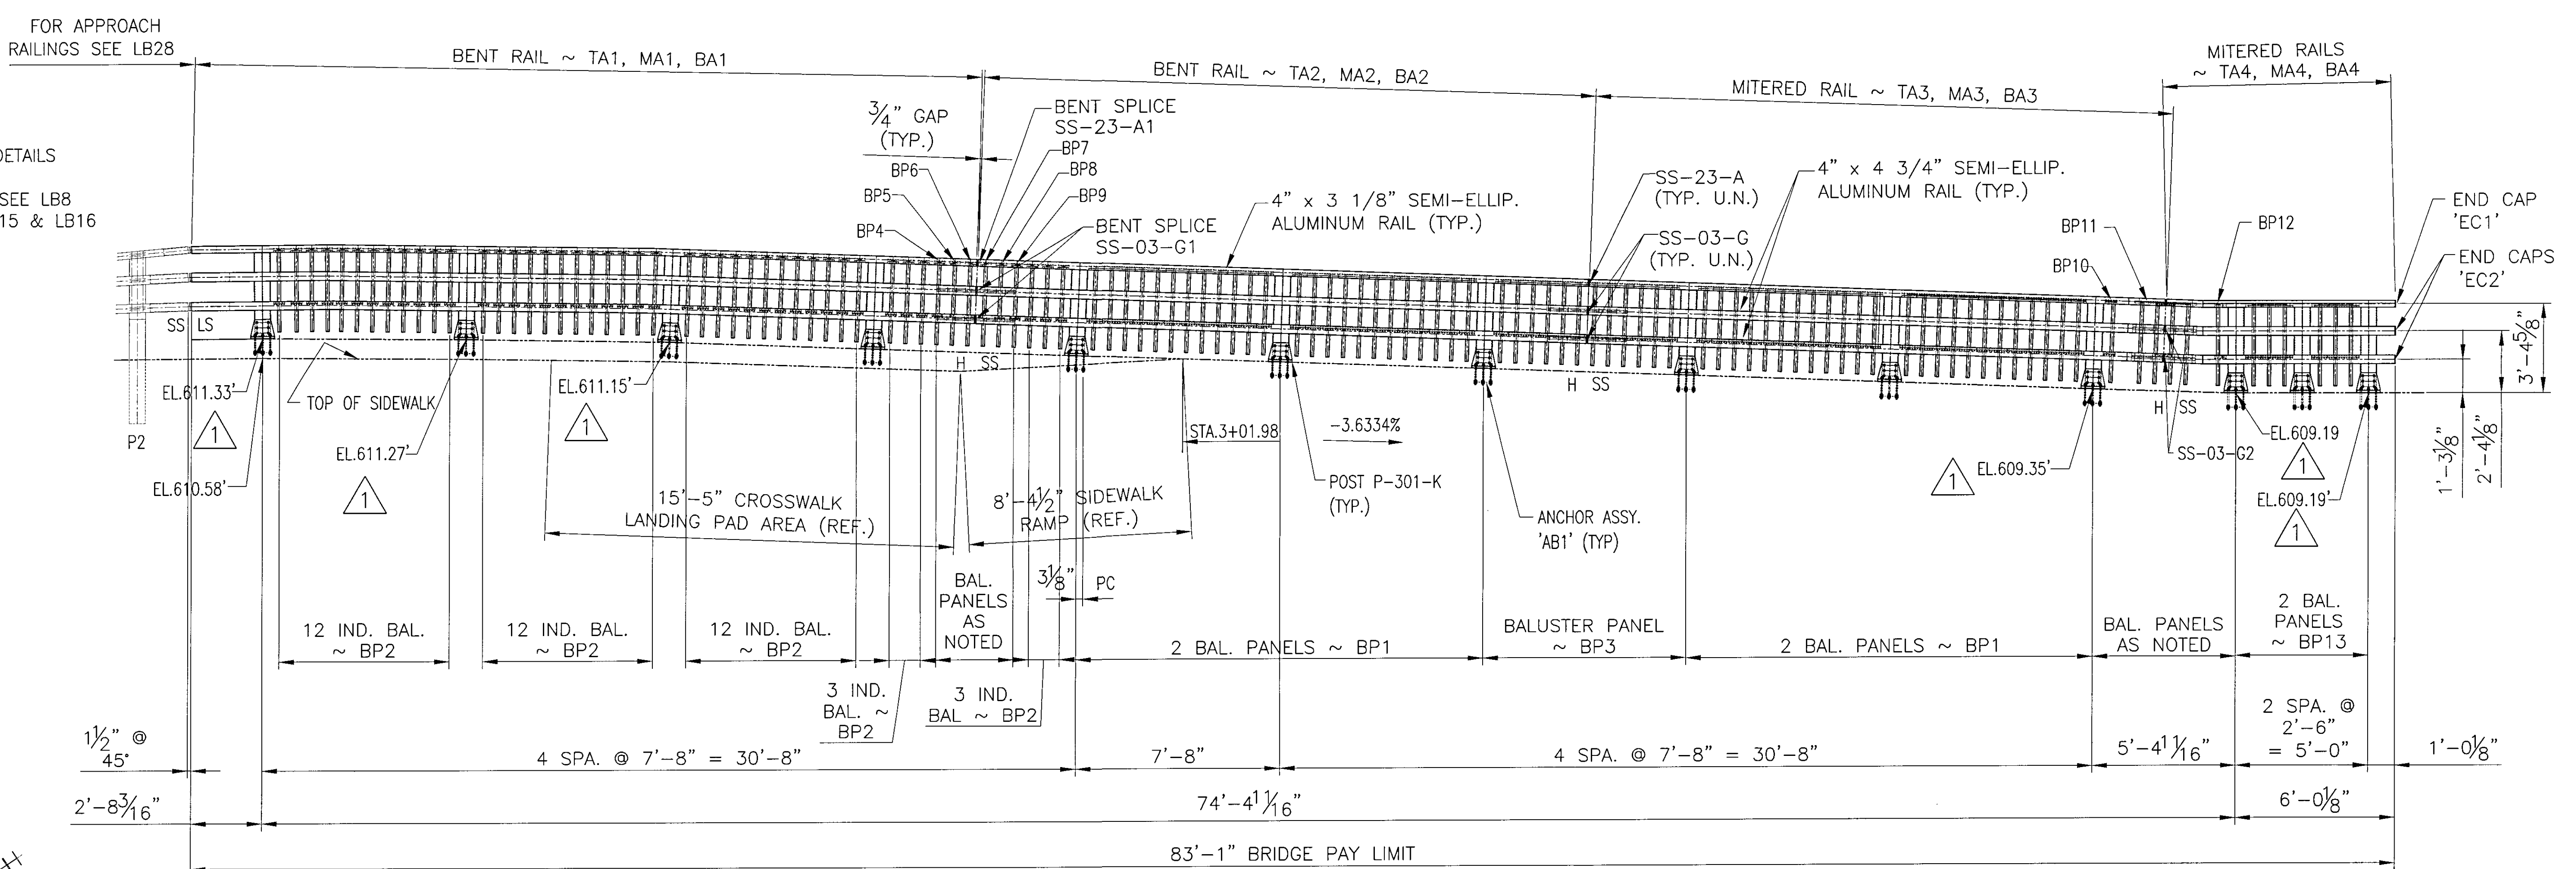


1 INSIDE ELEVATION ~ NORTH RAIL

- NOTE:
- THIS CONTRACT IS BASED UPON THE CONTRACTOR SETTING AND SPACING THE ANCHOR BOLTS TO THE MEASUREMENTS SHOWN ON THE APPROVED SHOP DRAWINGS. THE L.B. FOSTER CO. WILL NOT BE RESPONSIBLE FOR WORK NECESSITATED BY ANY OTHER SETTING AND SPACING.
 - THIS DRAWING IS NOT TO SCALE.
 - FOR GENERAL NOTES AND TYPICAL DETAILS SEE DRAWING LB5.
 - LENGTH OF RAILING ON THIS SHEET IS 83.08 LF PAY LENGTH.
 - POST SPACING IS MEASURED HORIZONTALLY ALONG BF OF PARAPET.
 - SPLICE GAP AT SLEEVE = 3/4\" TYP.
 - RAIL LENGTHS DO NOT INCLUDE GAPS.
 - * COMPENSATION FOR VERTICAL CURVE HAS BEEN INCLUDED IN RAIL LENGTHS
 - FOR BALUSTER DETAILS SEE DRAWING LB11 & LB12
 - ELEVATION MIMICS MAINLINE PROFILE PER CONTRACT SHT 15 OF 108

Accepted	✓
Accepted as Noted	
Accepted Noted Resubmit	
Rejected, Revise Resubmit	
Rejected - Unacceptable	

Checking is only for conformance with the design concept of the Project and compliance with the information given in the Contract Documents. The Engineer assumes no liability for errors or omissions that may be contained herein. The Contractor, by approving and submitting these documents, verifies the accuracy as stipulated on the Contractor's Shop Drawing Stamp.

DATE 9/14/09 DuBOIS AND KING
 BY ZPD

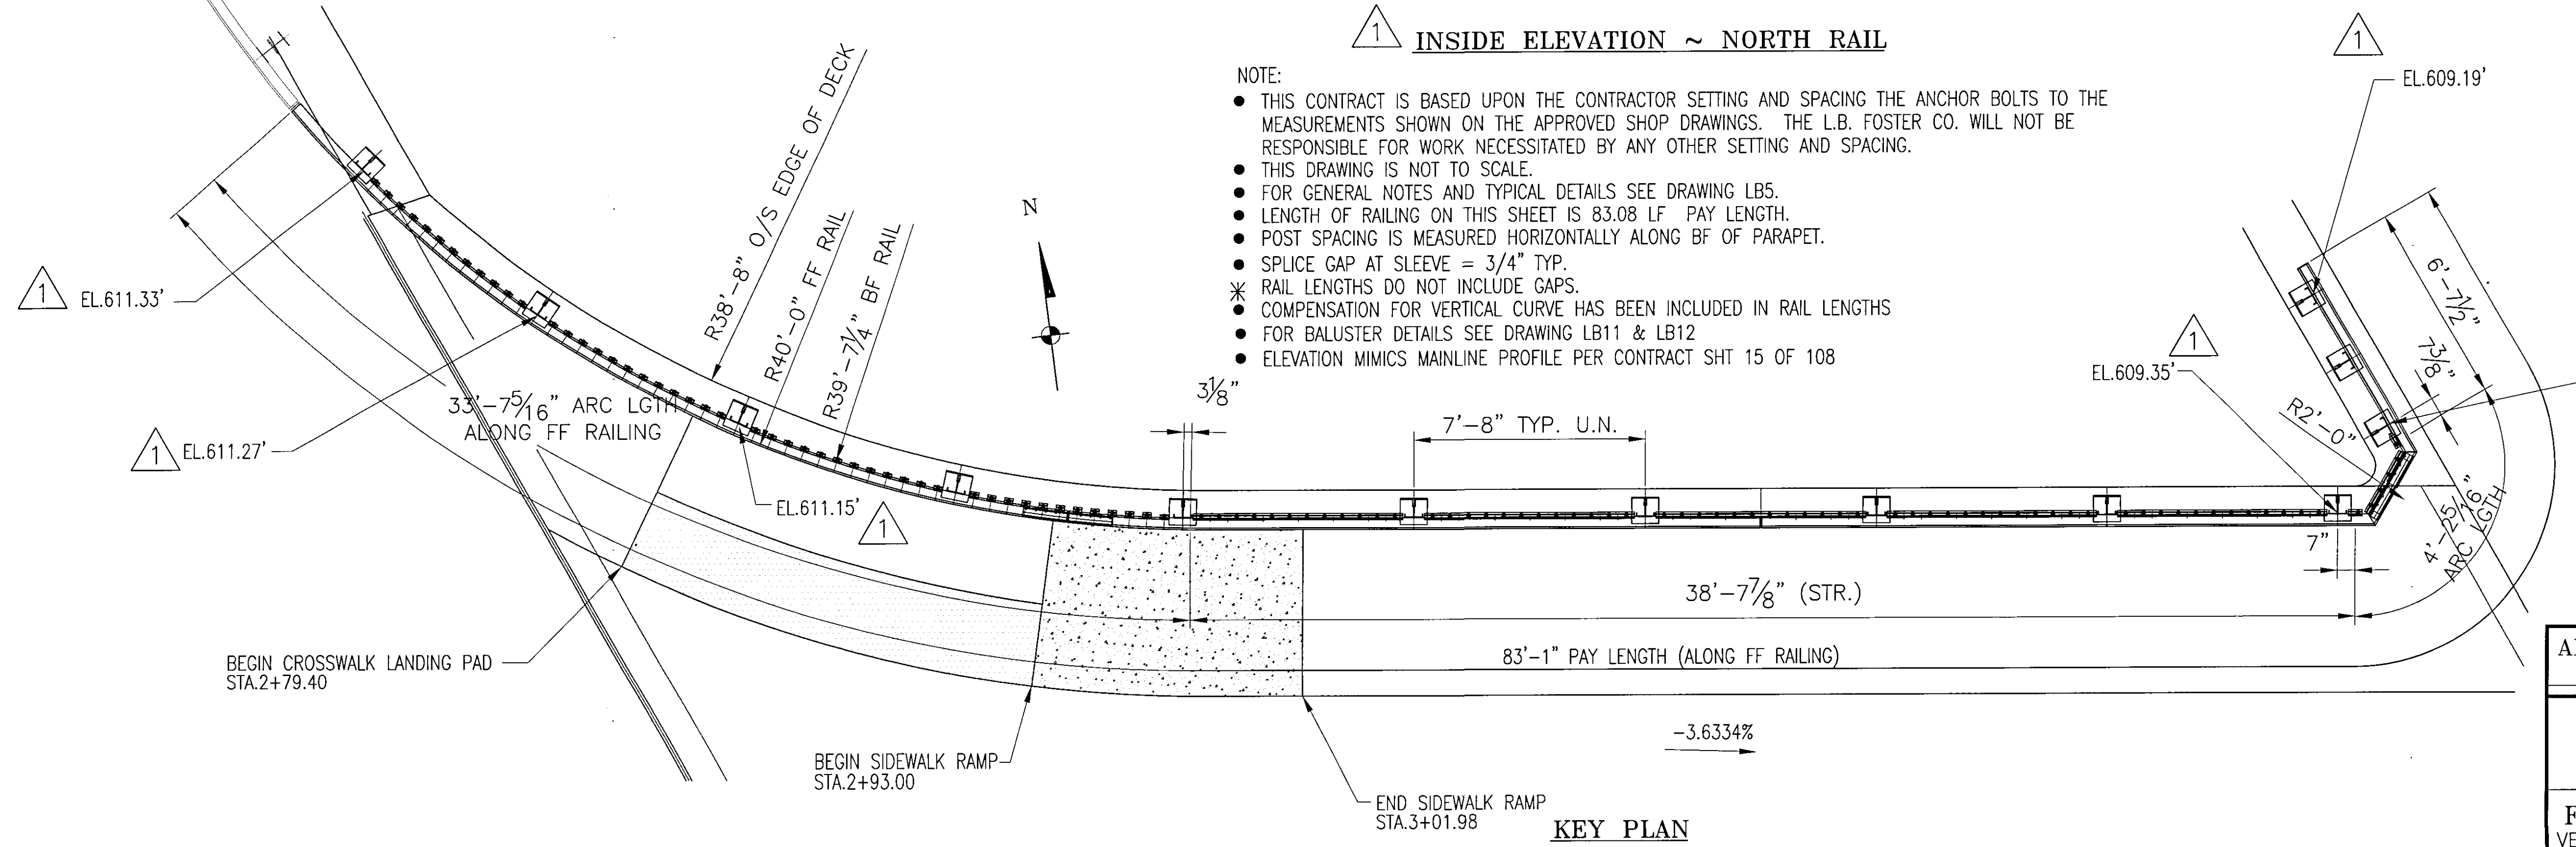

KEY PLAN

ANODIZED
 (SEE LB5 FOR NOTES)

BRIDGE No. 7
 ITEM No: 900,640
 PROJECT No. BHF 6000 (15) S

APPROVED: _____ REC'D APPROVAL _____
 DRAWING _____

L.B. FOSTER COMPANY
 1016 GREENTREE ROAD
 PITTSBURGH, PENNSYLVANIA 15220

FOR: F. R. LAFAYETTE, INCORPORATED
 VERMONT AGENCY OF TRANSPORTATION
 CITY OF BARRE, COUNTY OF WASHINGTON
 BRIDGE RAILING FOR PROSPECT ST. OVER STEVENS BRANCH
 3L ALUM BRIDGE RAILING ~ NORTH RAIL ELEV. & KEY PLAN

REV.	DESCRIPTION	BY	DATE
1	REVISED PER APPROVER COMMENTS	CMS	09/13/09

MADE CMS DATE 08/05/09 JOB No. ARO569 CUST. No. _____
 CHECK BLJ DATE 08/14/09 DRAWING LB7 REV. No. ONE