



INSIDE ELEVATION ~ SOUTH RAIL

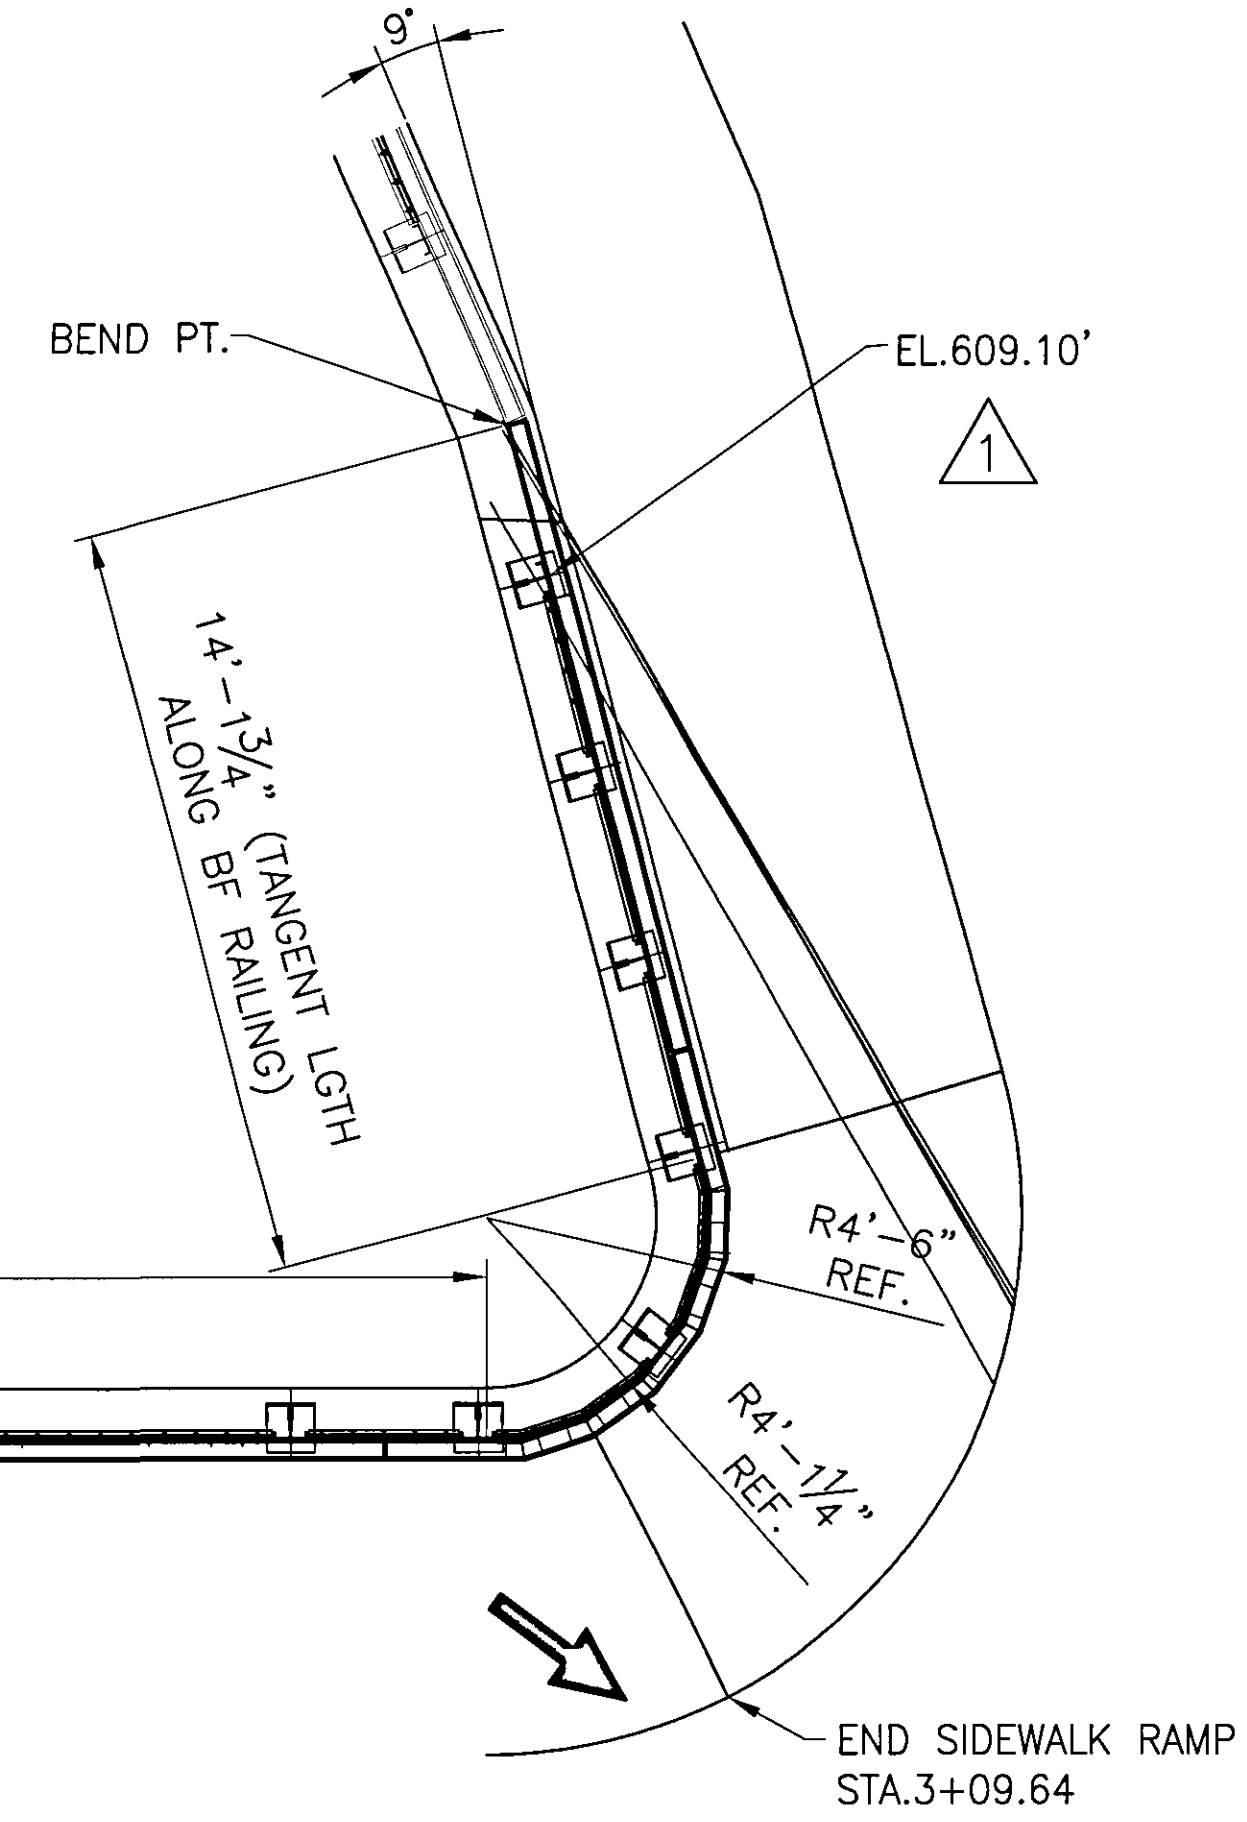

H = HOLE SIDE
 SS = SHORT SLOTTED SIDE
 LS = LONG SLOTTED SIDE

ANODIZED
 (SEE LB5 FOR NOTES)

NOTE: FOR GEN. NOTES AND TYP. DETAILS
 SEE DWG LB5
 FOR RAILING KEY PLAN SEE DWG LB10

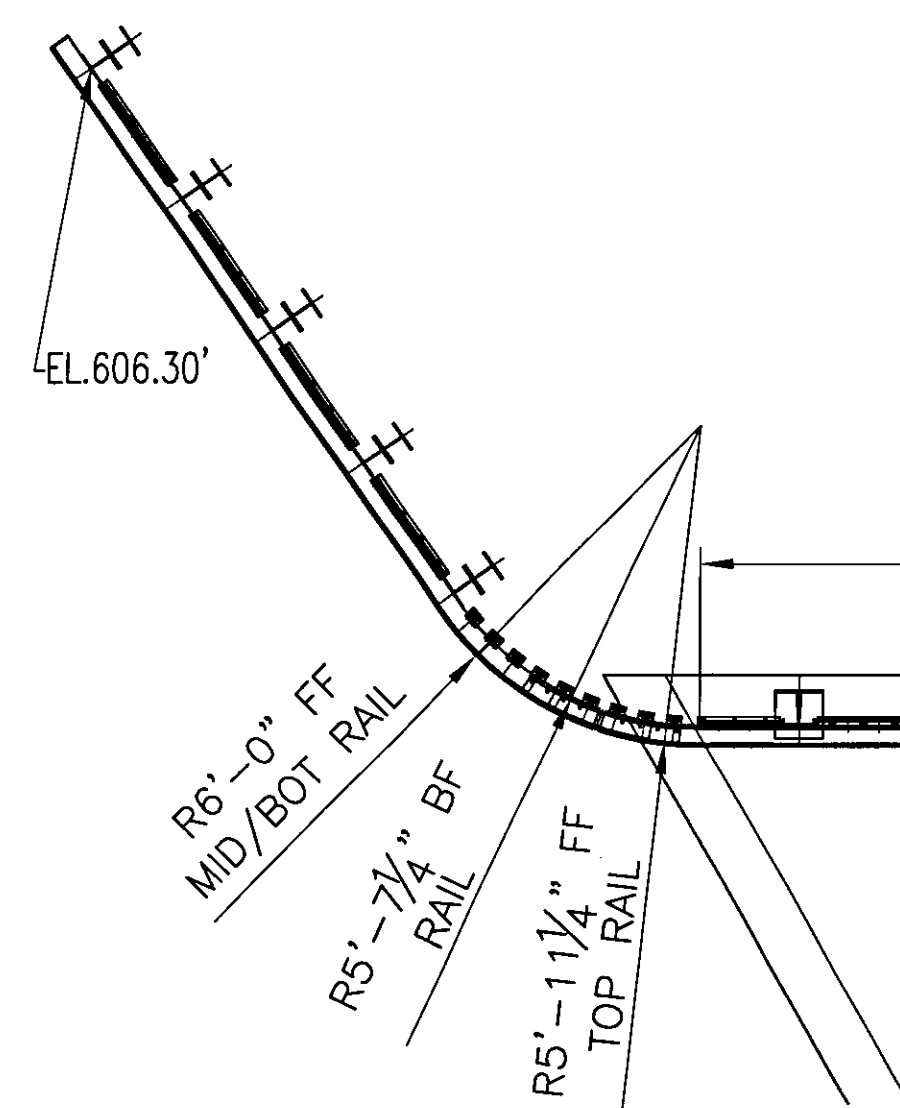

Accepted	✓
Accepted as Noted	
Accepted Noted Resubmit	
Rejected - Revise Resubmit	
Rejected - Unacceptable	

Checking is only for conformance with the design concept of the Project and compliance with the information given in the Contract Documents. The Engineer assumes no liability for errors or omissions that may be contained herein. The Contractor, by approving and submitting these documents, verifies their accuracy as stipulated on the Contractor's Shop Drawing Stamp.

9/25/09 DuBOIS AND KING
 By ZPD

BRIDGE No. 7
 ITEM No: 900.640
 PROJECT No. BHF 6000 (15) S

APPROVED: _____ REC'D APPROVAL _____
 DRAWING _____
L.B. FOSTER COMPANY
 1016 GREENTREE ROAD
 PITTSBURGH, PENNSYLVANIA 15220

FOR: F. R. LAFAYETTE, INCORPORATED
 VERMONT AGENCY OF TRANSPORTATION
 CITY OF BARRE, COUNTY OF WASHINGTON
 BRIDGE RAILING FOR PROSPECT ST. OVER STEVENS BRANCH
 3L ALUM BRIDGE RAILING ~ ELEVATION @ SOUTH RAIL

REV.	DESCRIPTION	BY	DATE
1	REVISED PER APPROVER COMMENTS	CMS	09/13/09

MADE CMS DATE 08/05/09 JOB No. ARO569 CUST. No. _____
 CHECK BLJ DATE 08/14/09 DRAWING LB8 REV. No. ONE