



H = HOLE SIDE
 SS = SHORT SLOTTED SIDE
 LS = LONG SLOTTED SIDE

| | |
|---|---------------------------|
| Accepted as Noted | |
| Accepted Noted Resubmit | |
| Rejected, Revise Resubmit | |
| Rejected - Unacceptable | |
| Checking is only for conformance with the design concept of the Project and compliance with the information given in the Contract Documents. The Engineer assumes no liability for errors or omissions that may be contained herein. The Contractor, by approving and submitting these documents, verifies the accuracy as stipulated on the Contractor's Shop Drawing Stamp. | |
| Date 9/23/09 | DUBOIS AND KING By EPD |

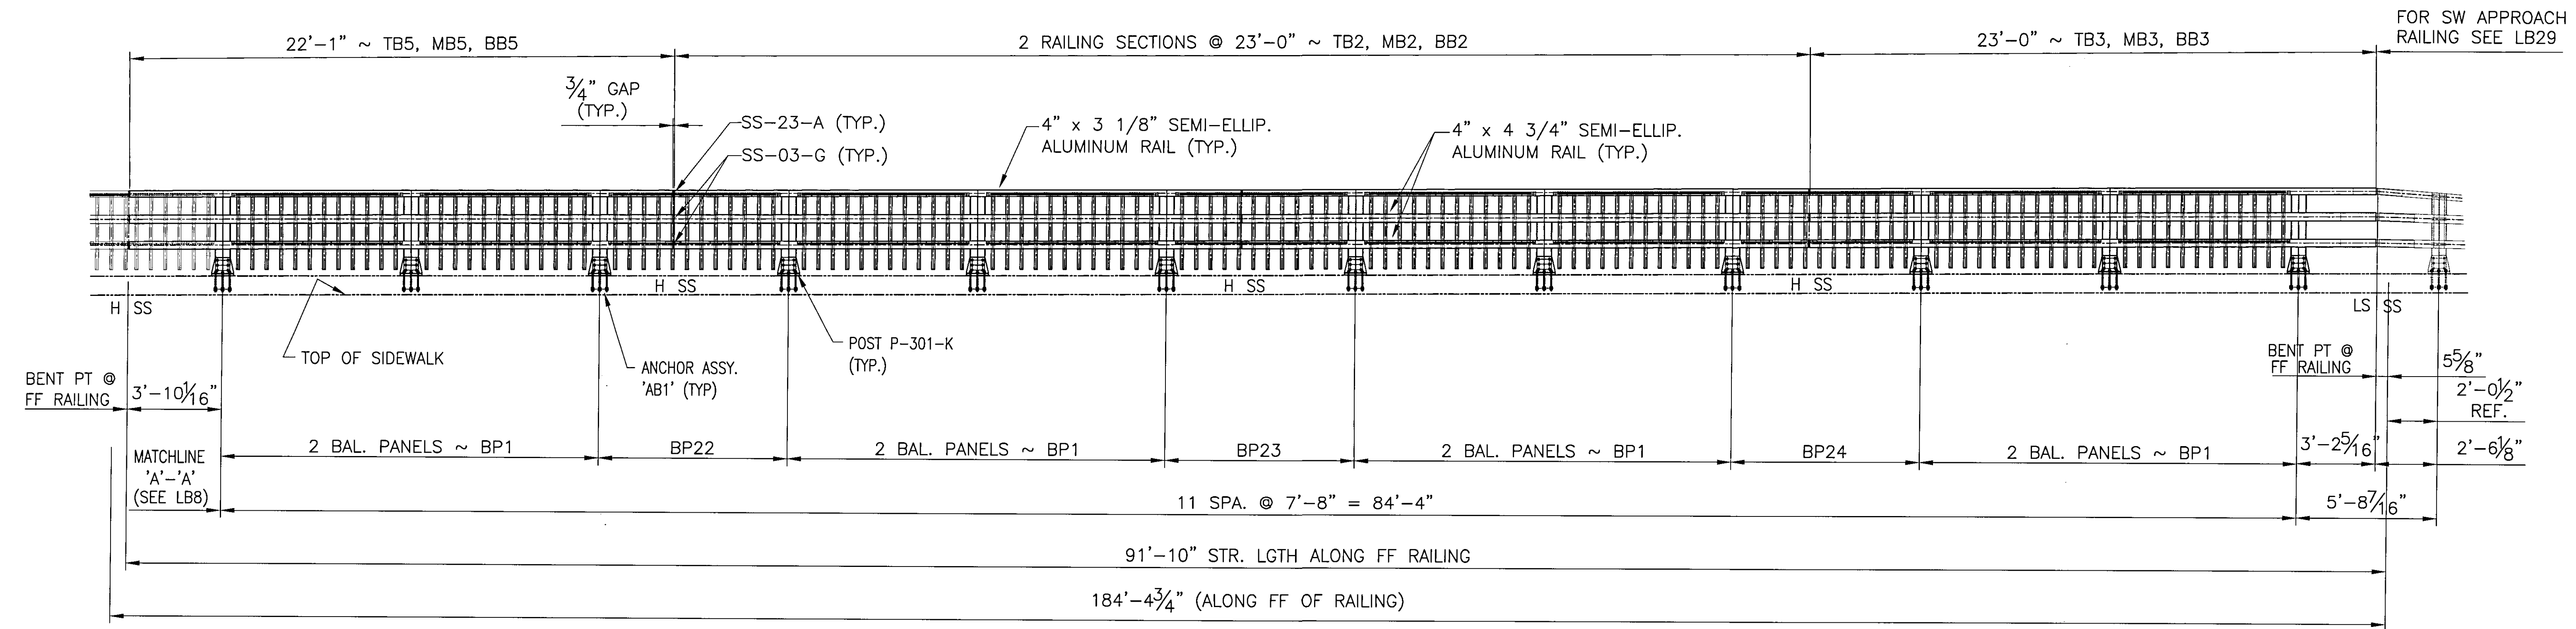

91'-3 5/8" (TANGENT ALONG BF RAILING)

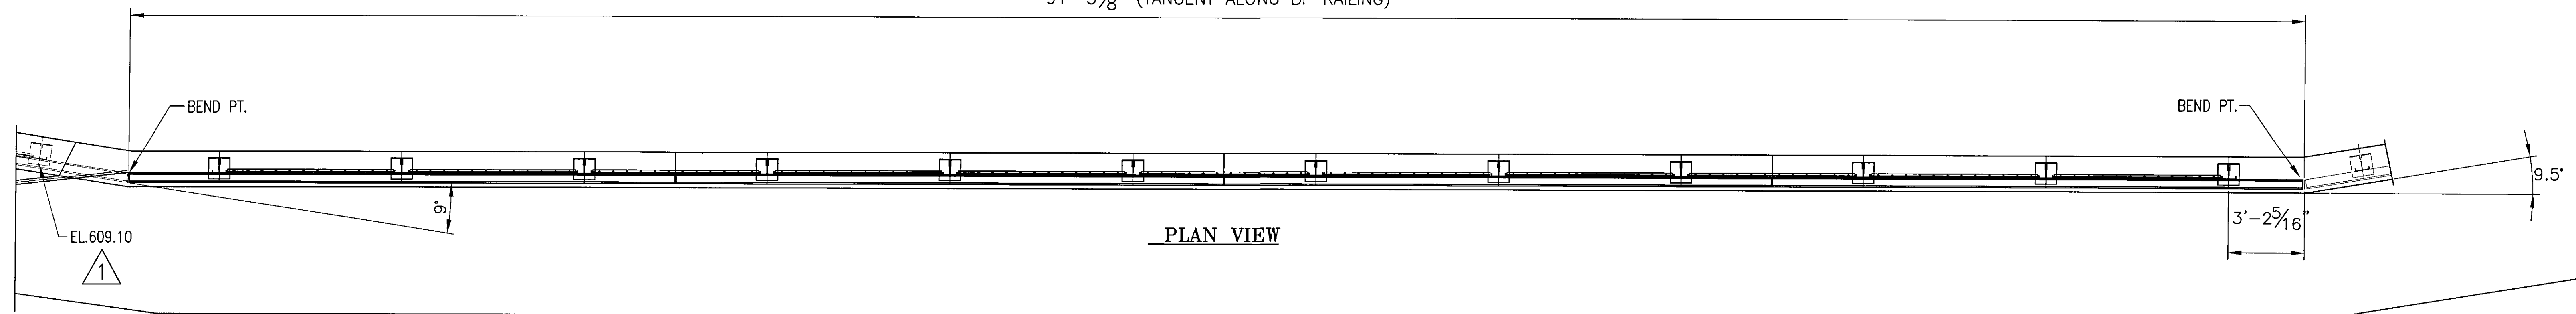

INSIDE ELEVATION ~ SOUTH RAIL (ALONG BROOKLYN STREET)

- NOTE:
- THIS CONTRACT IS BASED UPON THE CONTRACTOR SETTING AND SPACING THE ANCHOR BOLTS TO THE MEASUREMENTS SHOWN ON THE APPROVED SHOP DRAWINGS. THE L.B. FOSTER CO. WILL NOT BE RESPONSIBLE FOR WORK NECESSITATED BY ANY OTHER SETTING AND SPACING.
 - THIS DRAWING IS NOT TO SCALE.
 - FOR GENERAL NOTES AND TYPICAL DETAILS SEE DRAWING LB5.
 - LENGTH OF RAILING ON THIS SHEET & LB8 IS 184.396 LF PAY LENGTH.
 - POST SPACING IS MEASURED HORIZONTALLY ALONG BF OF PARAPET.
 - SPLICE GAP AT SLEEVE = 3/4" TYP. U.N.
 - * RAIL LENGTHS DO NOT INCLUDE GAPS.
 - COMPENSATION FOR VERTICAL CURVE HAS BEEN INCLUDED IN RAIL LENGTHS
 - FOR BALUSTER DETAILS SEE DRAWING LB11 & LB12.

ANODIZED
 (SEE LB5 FOR NOTES)

NOTE: FOR GEN. NOTES AND TYP. DETAILS SEE DWG LB5
 FOR RAILING KEY PLAN SEE DWG LB10

| | | | |
|------|-------------------------------|-----|----------|
| 1 | REVISED PER APPROVER MARK UPS | CMS | 09/12/09 |
| REV. | DESCRIPTION | BY | DATE |

BRIDGE No. 7
 ITEM No. 900.640
 PROJECT No. BHF 6000 (15) S

| | |
|---|--------------------------|
| APPROVED: | REC'D APPROVAL |
| DRAWING | |
| L.B. FOSTER COMPANY | |
| 1016 GREENTREE ROAD PITTSBURGH, PENNSYLVANIA 15220 | |
| FOR: F. R. LAFAYETTE, INCORPORATED | |
| VERMONT AGENCY OF TRANSPORTATION | |
| CITY OF BARRE, COUNTY OF WASHINGTON | |
| BRIDGE RAILING FOR PROSPECT ST. OVER STEVENS BRANCH | |
| 3L ALUM BRIDGE RAILING ~ ELEVATION @ SOUTH RAIL | |
| MADE CMS DATE 06/30/09 | JOB No. AR0569 CUST. No. |
| CHECK BLJ DATE 08/14/09 | DRAWING LB9 REV. No. ONE |