



SEE REVISED PROFILE PASSUMPSIC AVE
 SHEET 2 OF 11 DATED 10/4/11

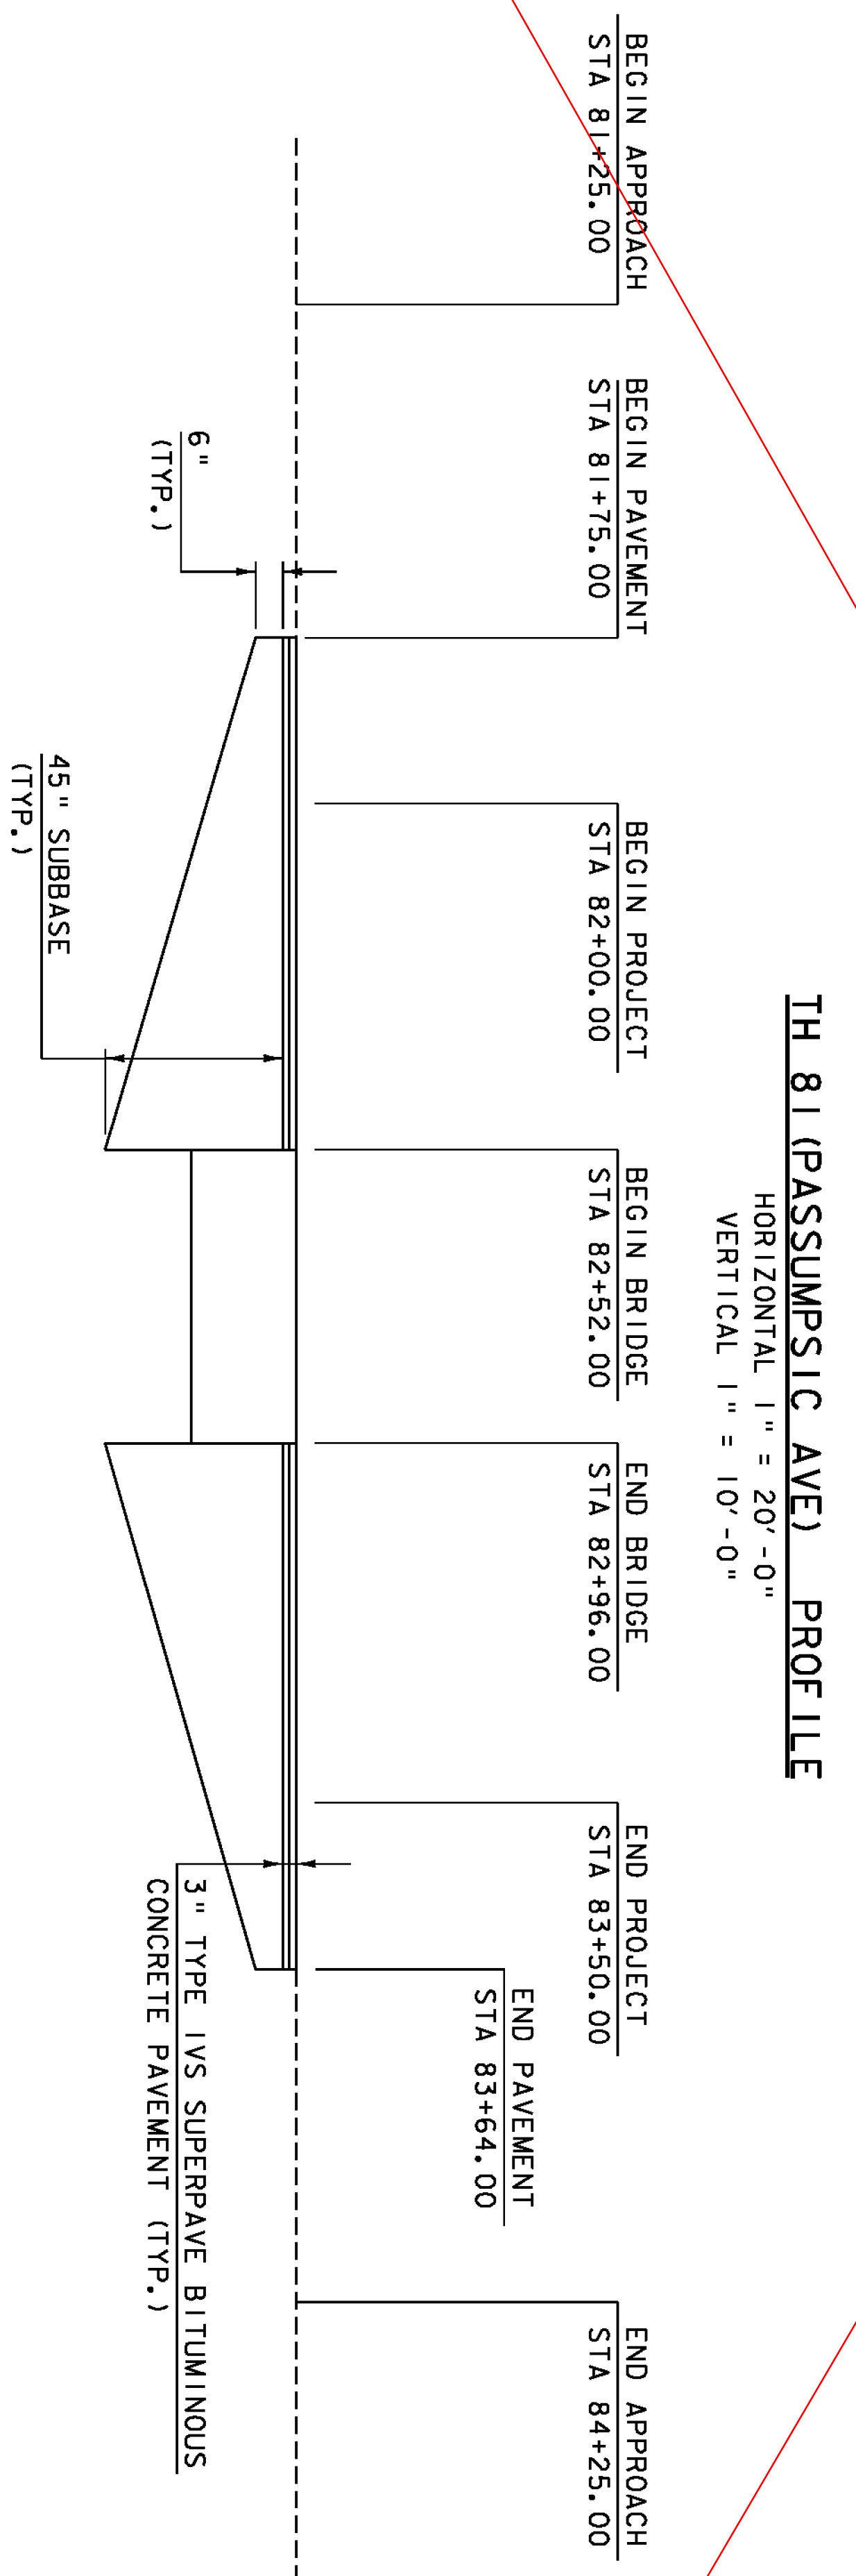

THE GRADES SHOWN TO THE NEAREST TENTH ARE THE ORIGINAL GRADES ALONG THE PROPOSED ALIGNMENT.
 THE GRADES SHOWN TO THE NEAREST HUNDREDTH ARE THE FINISH GRADES ALONG THE PROPOSED ALIGNMENT.

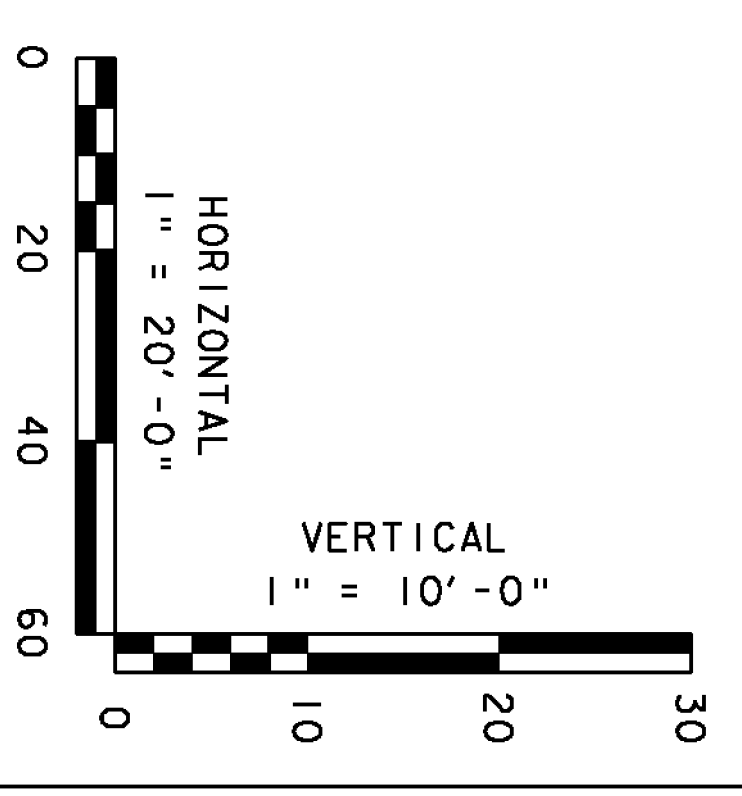

PROJECT NAME: HARTFORD (WILDER)
 PROJECT NUMBER: STP 1444(35)
 FILE NAME: b36\s96j070xslb36.dgn
 PROJECT LEADER: K. HIGGINS
 DESIGNED BY: T. FILLBACH
 MAINLINE PROFILE - BRIDGE 36
 PLOT DATE: 16-JUN-2010
 DRAWN BY: R. PELLETTI
 CHECKED BY: J. SALVATORI
 SHEET 12 OF 69

TH 81 (PASSUMPSIC AVE) MATERIAL TRANSITION

HORIZONTAL 1" = 20'-0"
 NO VERTICAL SCALE