

PAY LIMITS, GUARD RAIL APPROACH
SECTION, GALVANIZED NETC 4 RAIL

PLAN VIEW - APPROACH RAIL WW2



SCALE 1/2" = 1'-0"



46'-0" (FULL HEIGHT)

4 SPACES @ 3'-2" ON 16' RADIUS

8 SPACES @ 3'-2"

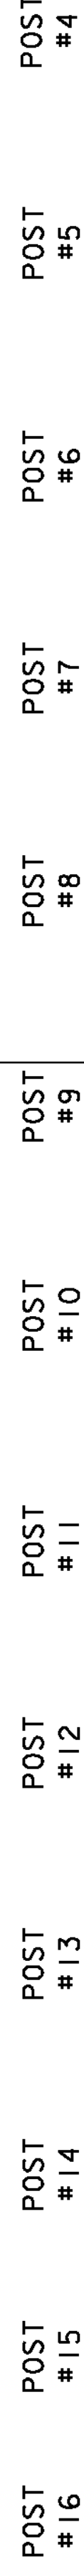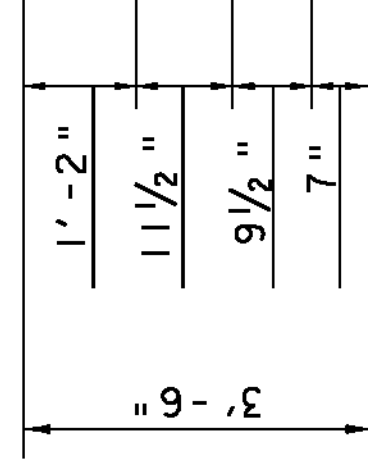

5" SIDEWALK
REVEAL

ELEVATION VIEW - APPROACH RAIL WW2

SCALE 1/2" = 1'-0"

