



NOTES

1. REFER TO NETC 2 RAIL STANDARD DETAILS, NOTES AND MATERIALS
2. PAYMENT FOR GUARD RAIL APPROACH CONNECTOR, THE CONNECTION
3. ALL APPROACH RAIL SPLICES
4. ALL BRIDGE APPROACH RAIL MATCH AS THOSE OF THE BRIDGE RAIL
5. APPROACH RAIL BOLTS SHALL (ASTM A563 GRADE A OR BETTER)
6. WELD SPLICE BARS TO FIT BE

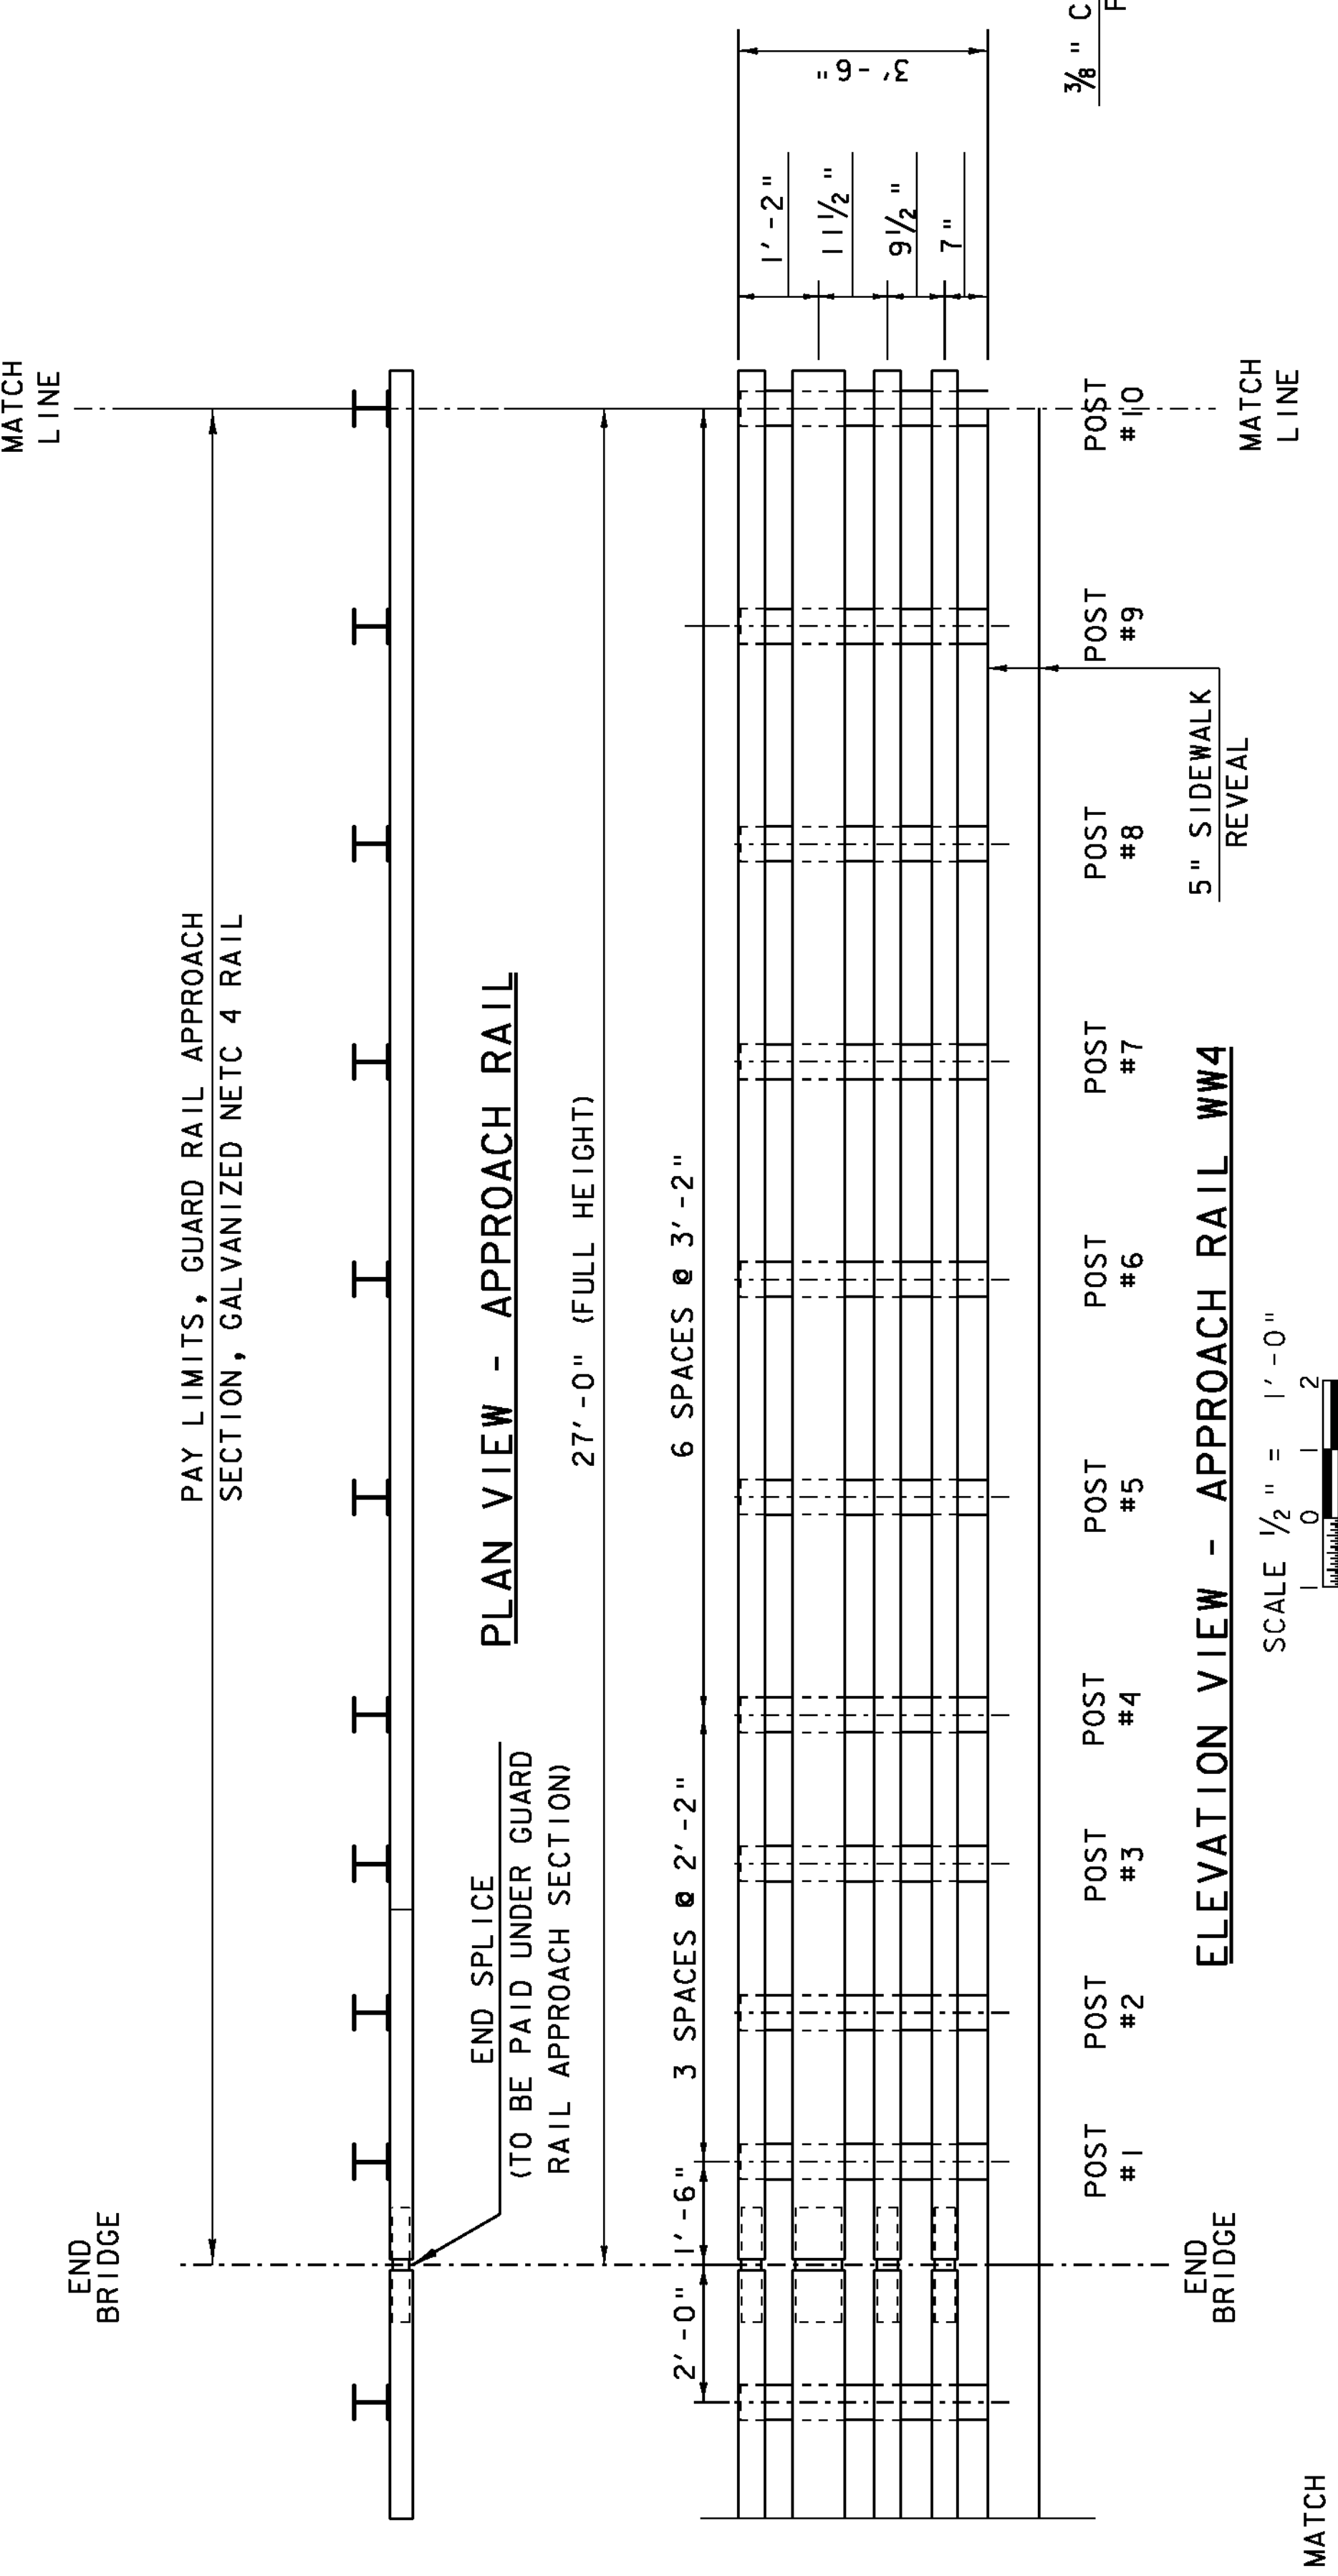


ELEVATION VIEW - APPROACH RAIL WW4

SCALE 1/2" = 1'-0"

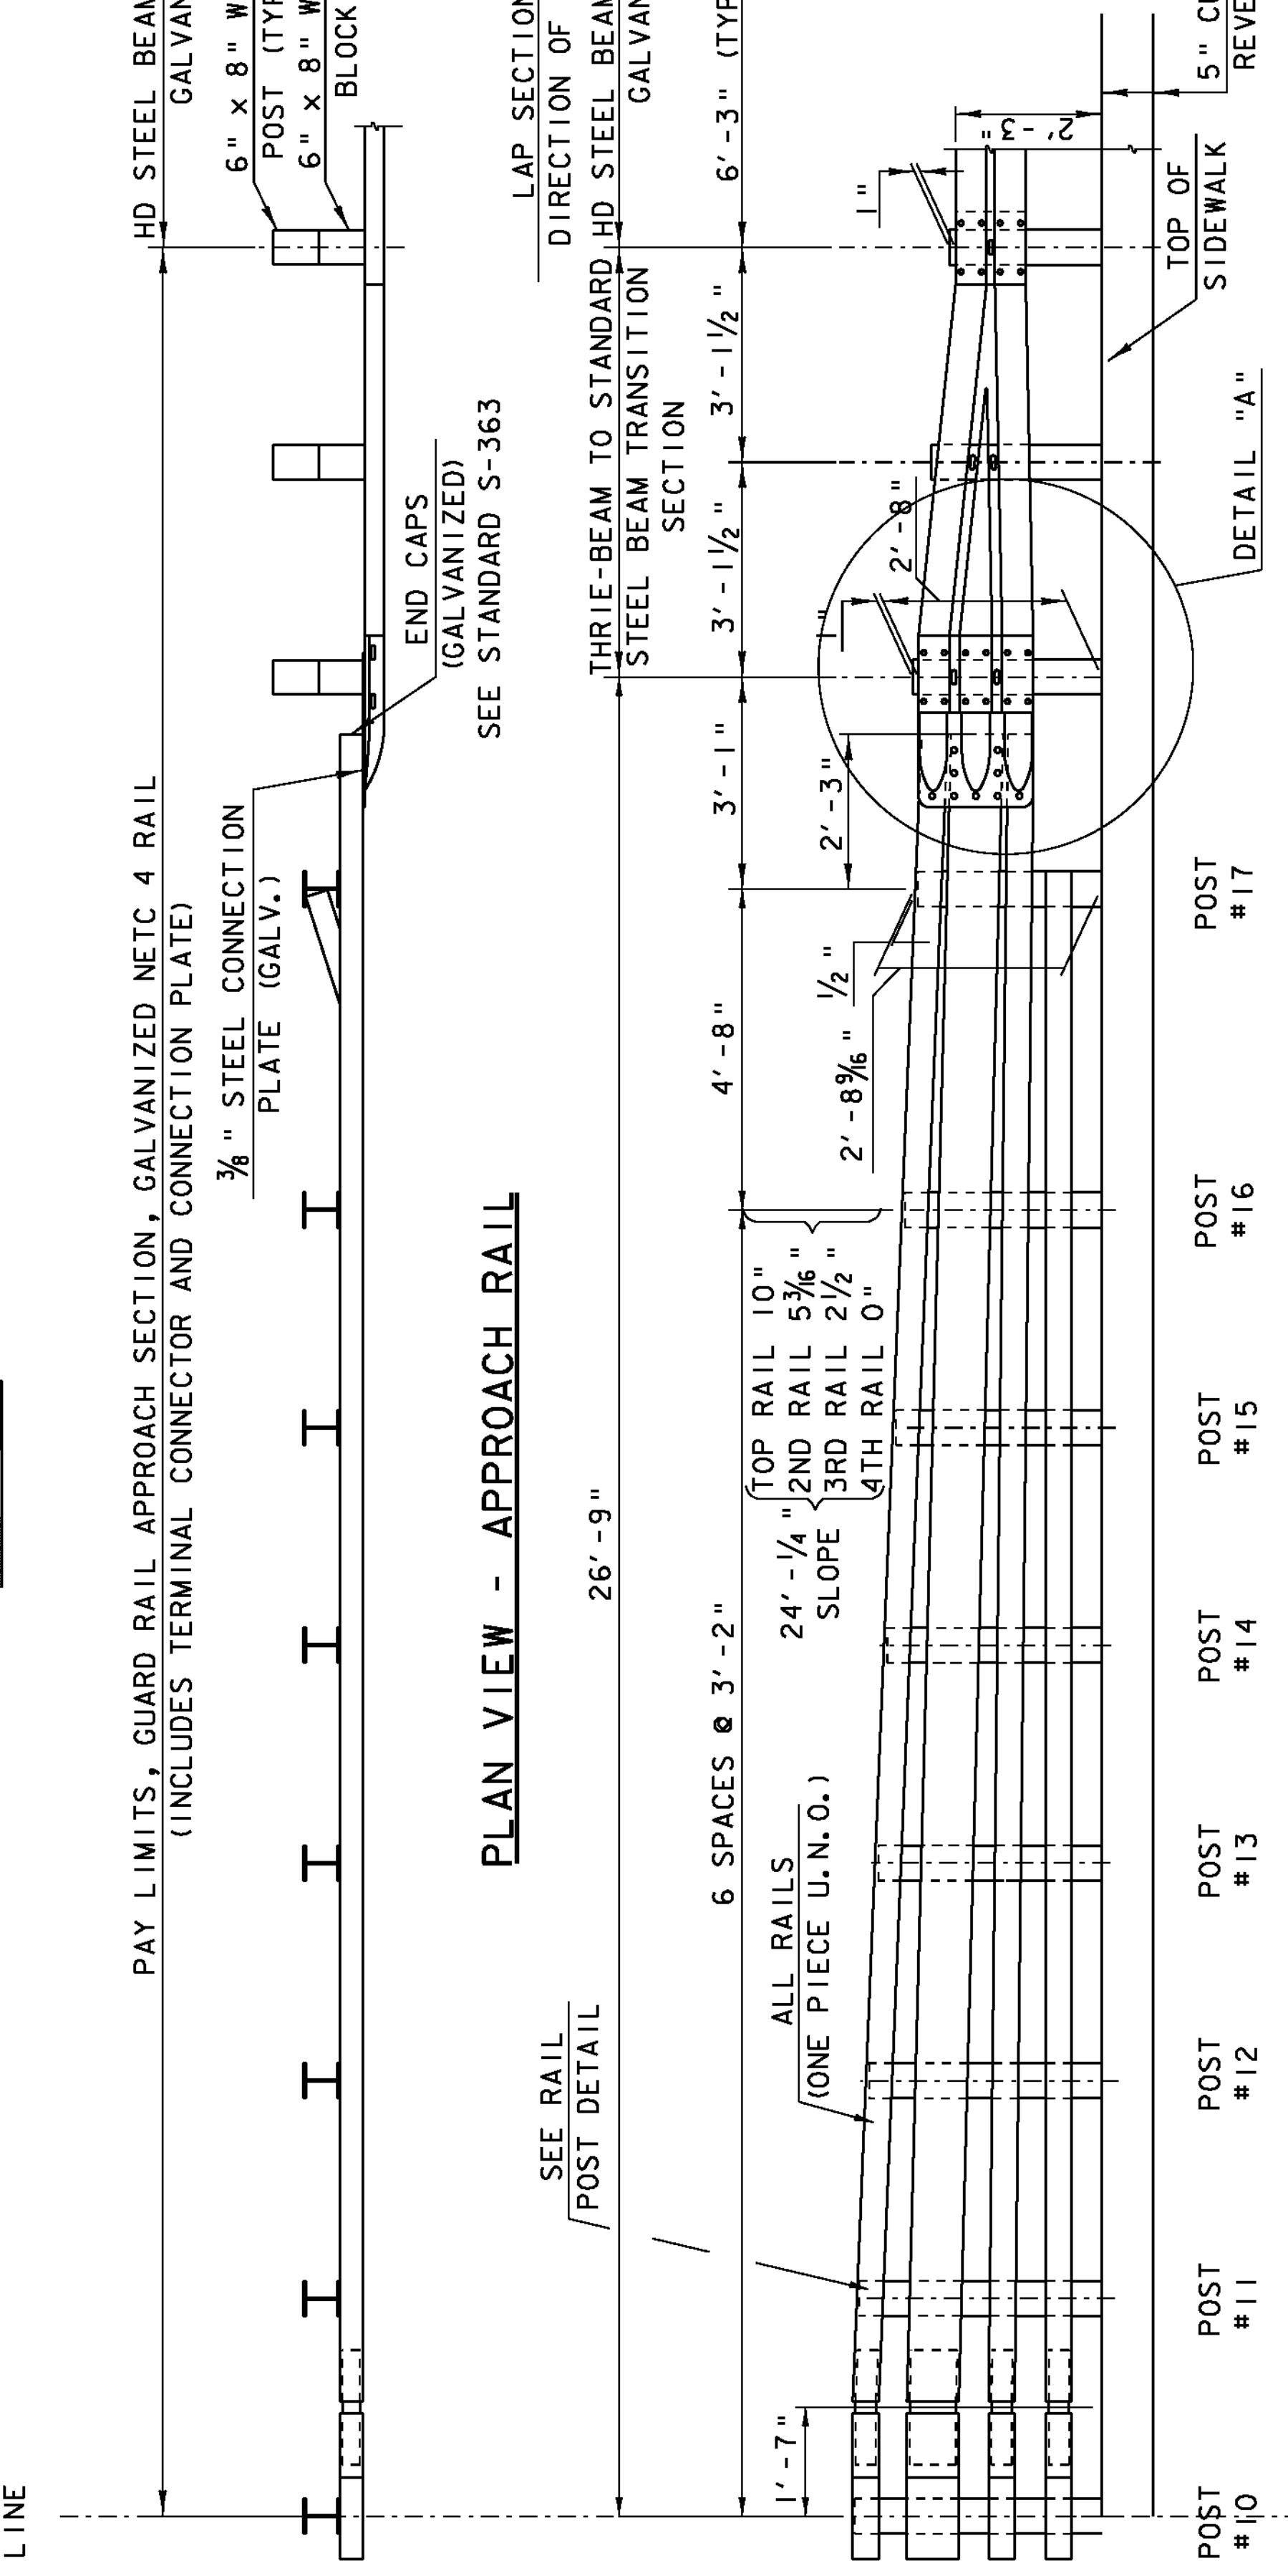


ELEVATION VIEW - APPROACH RAIL WW4

SCALE 1/2" = 1'-0"

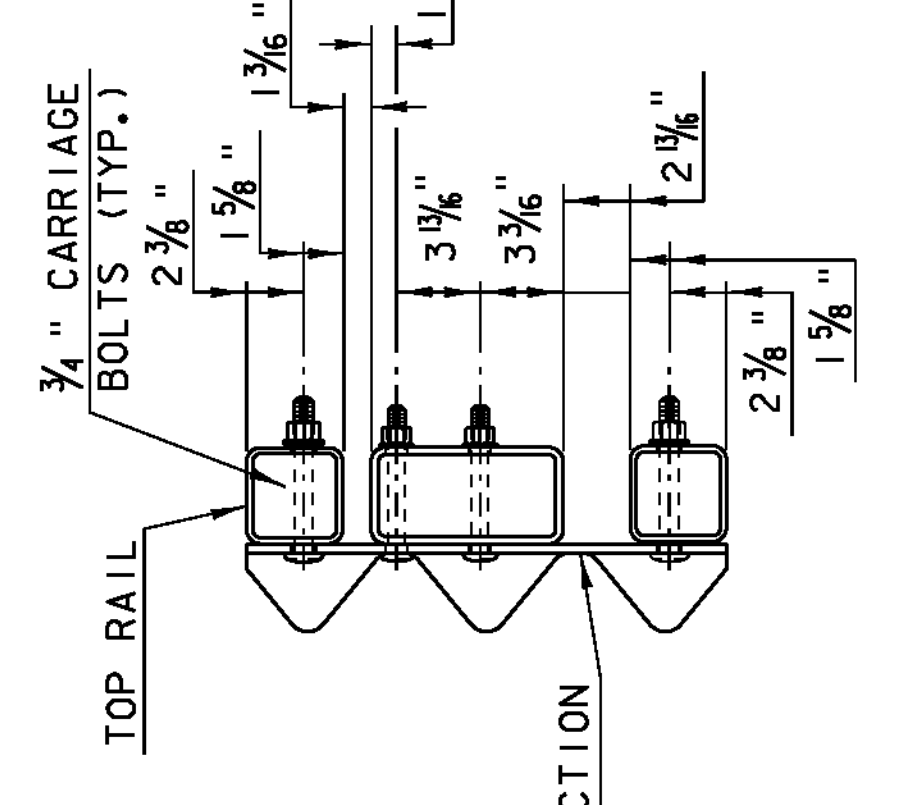

SECTION C-C CONNECTION PLATE
 (NOT TO SCALE)

PLAN VIEW - APPROACH RAIL

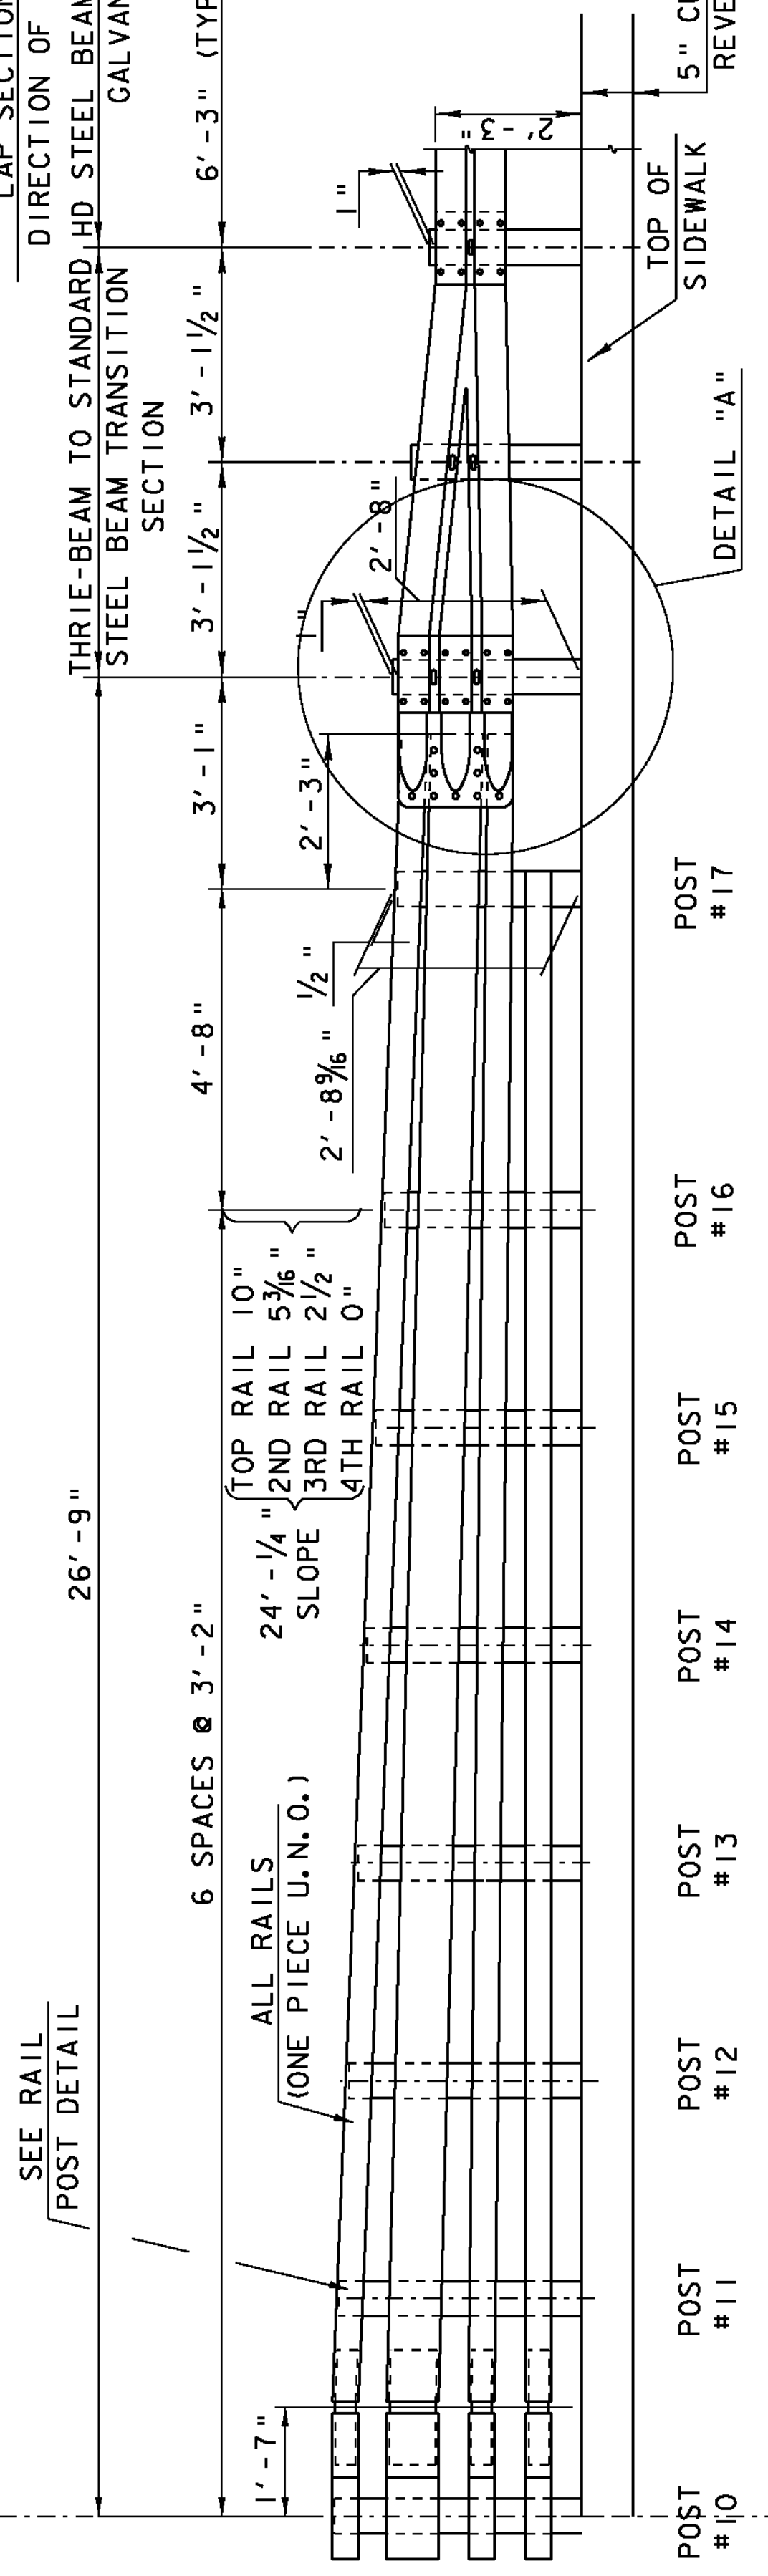

MATCH LINE