


81+75

82+2

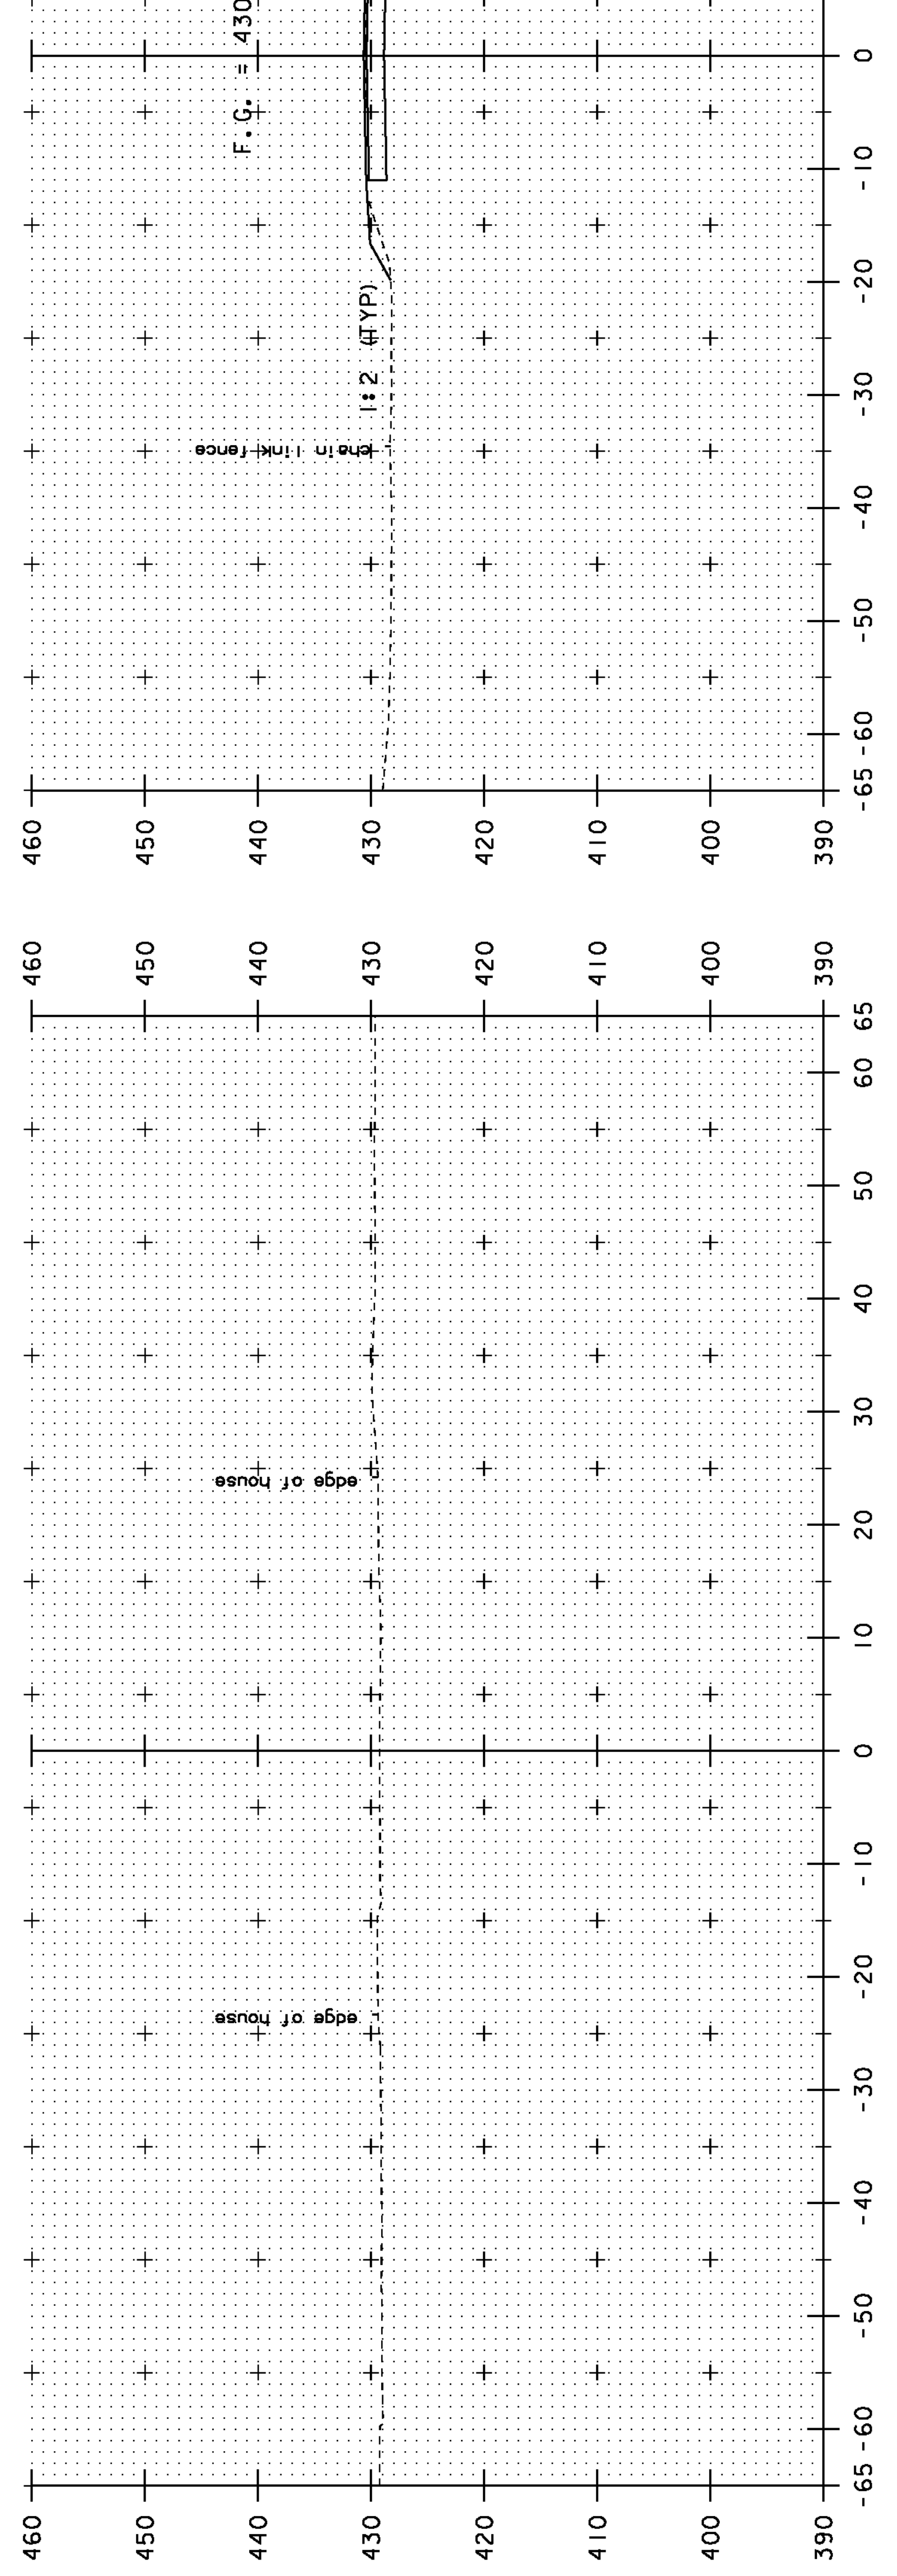

81+50

82+0

BEGIN APPROACH

BEGIN PRO

STA. 81+50 TO STA. 81+75

SCALE 1" = 10'