




82+75
BEGIN BRIDGE 82+52 - END BRIDGE 82+96

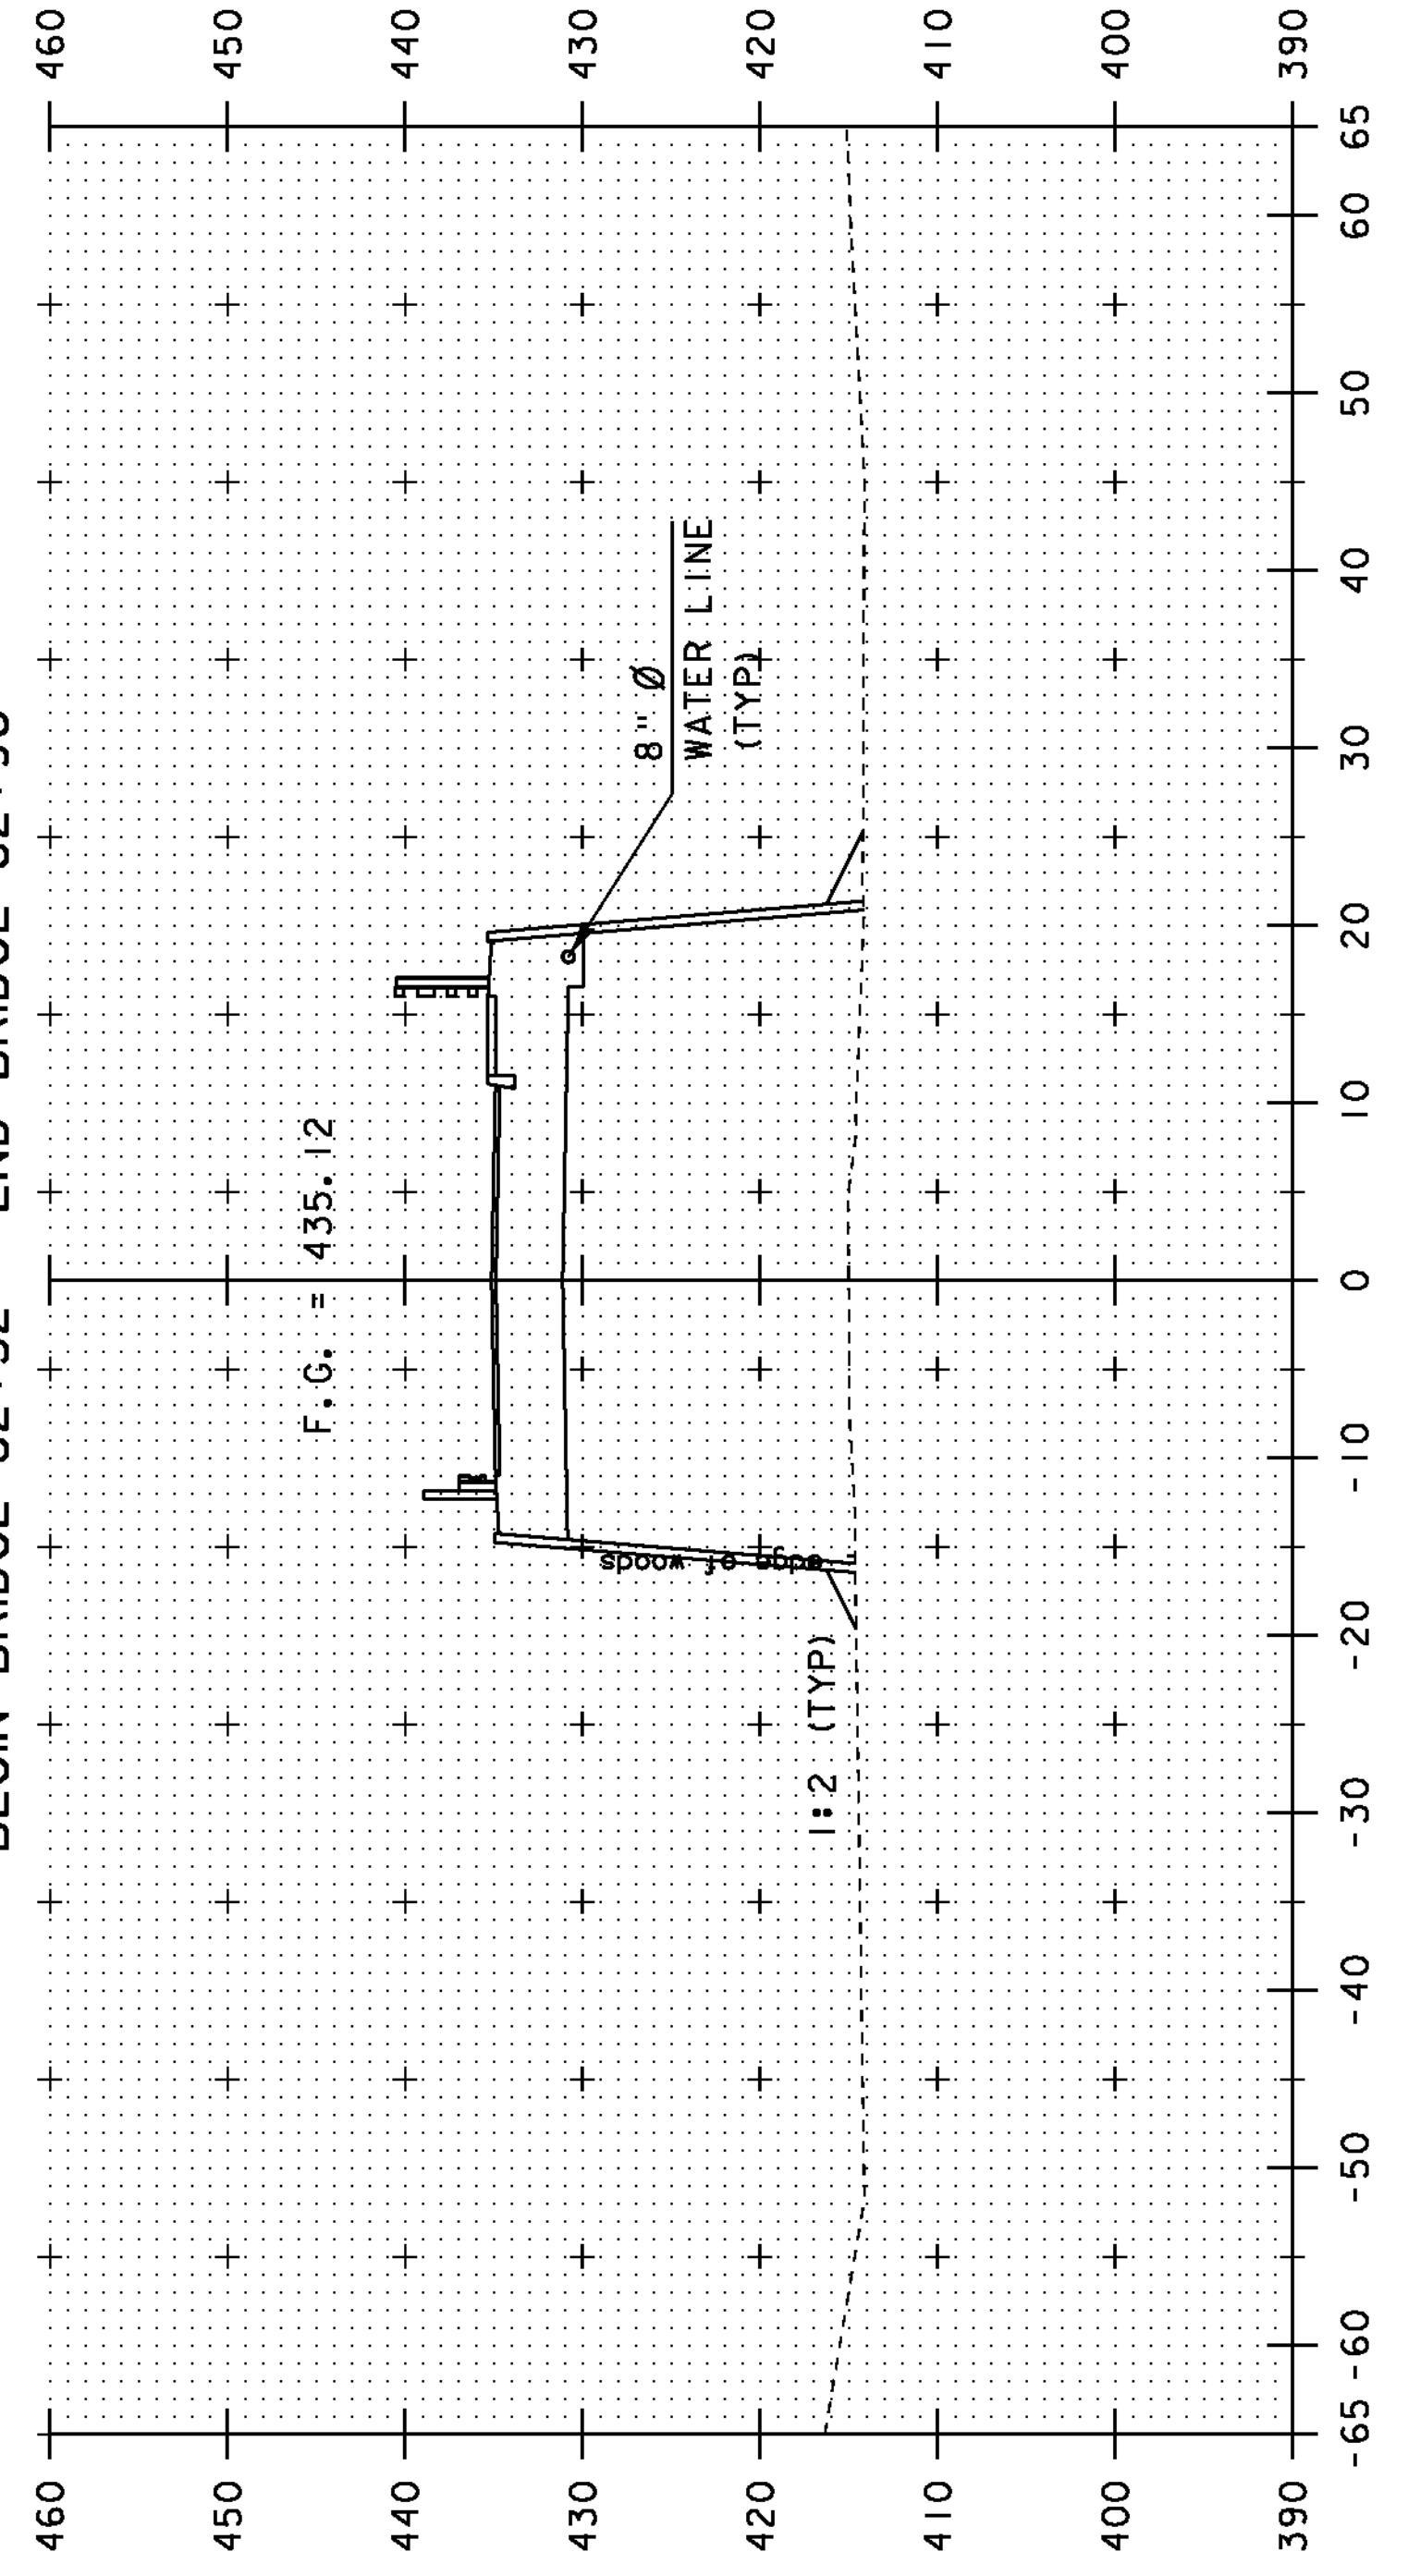

82+50

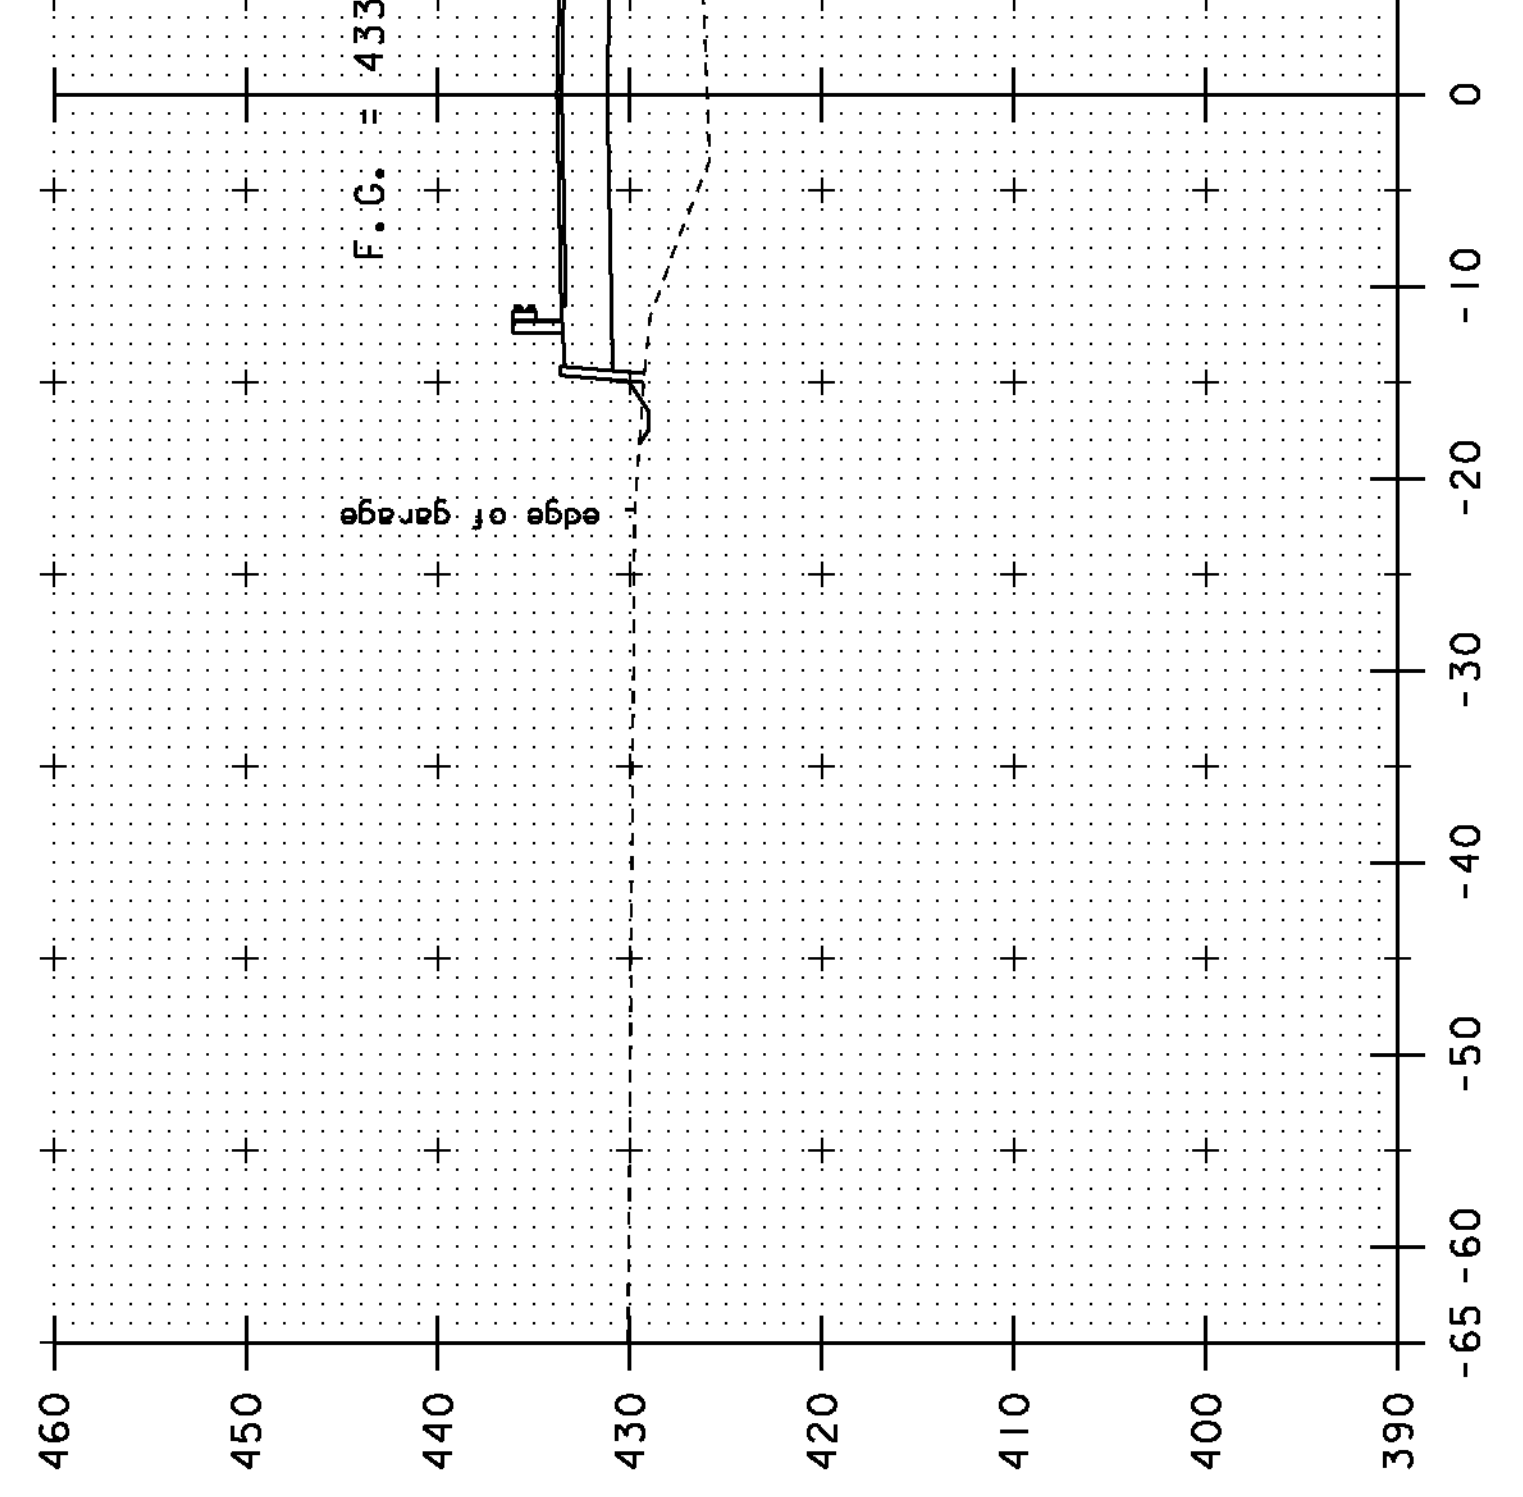

83+2

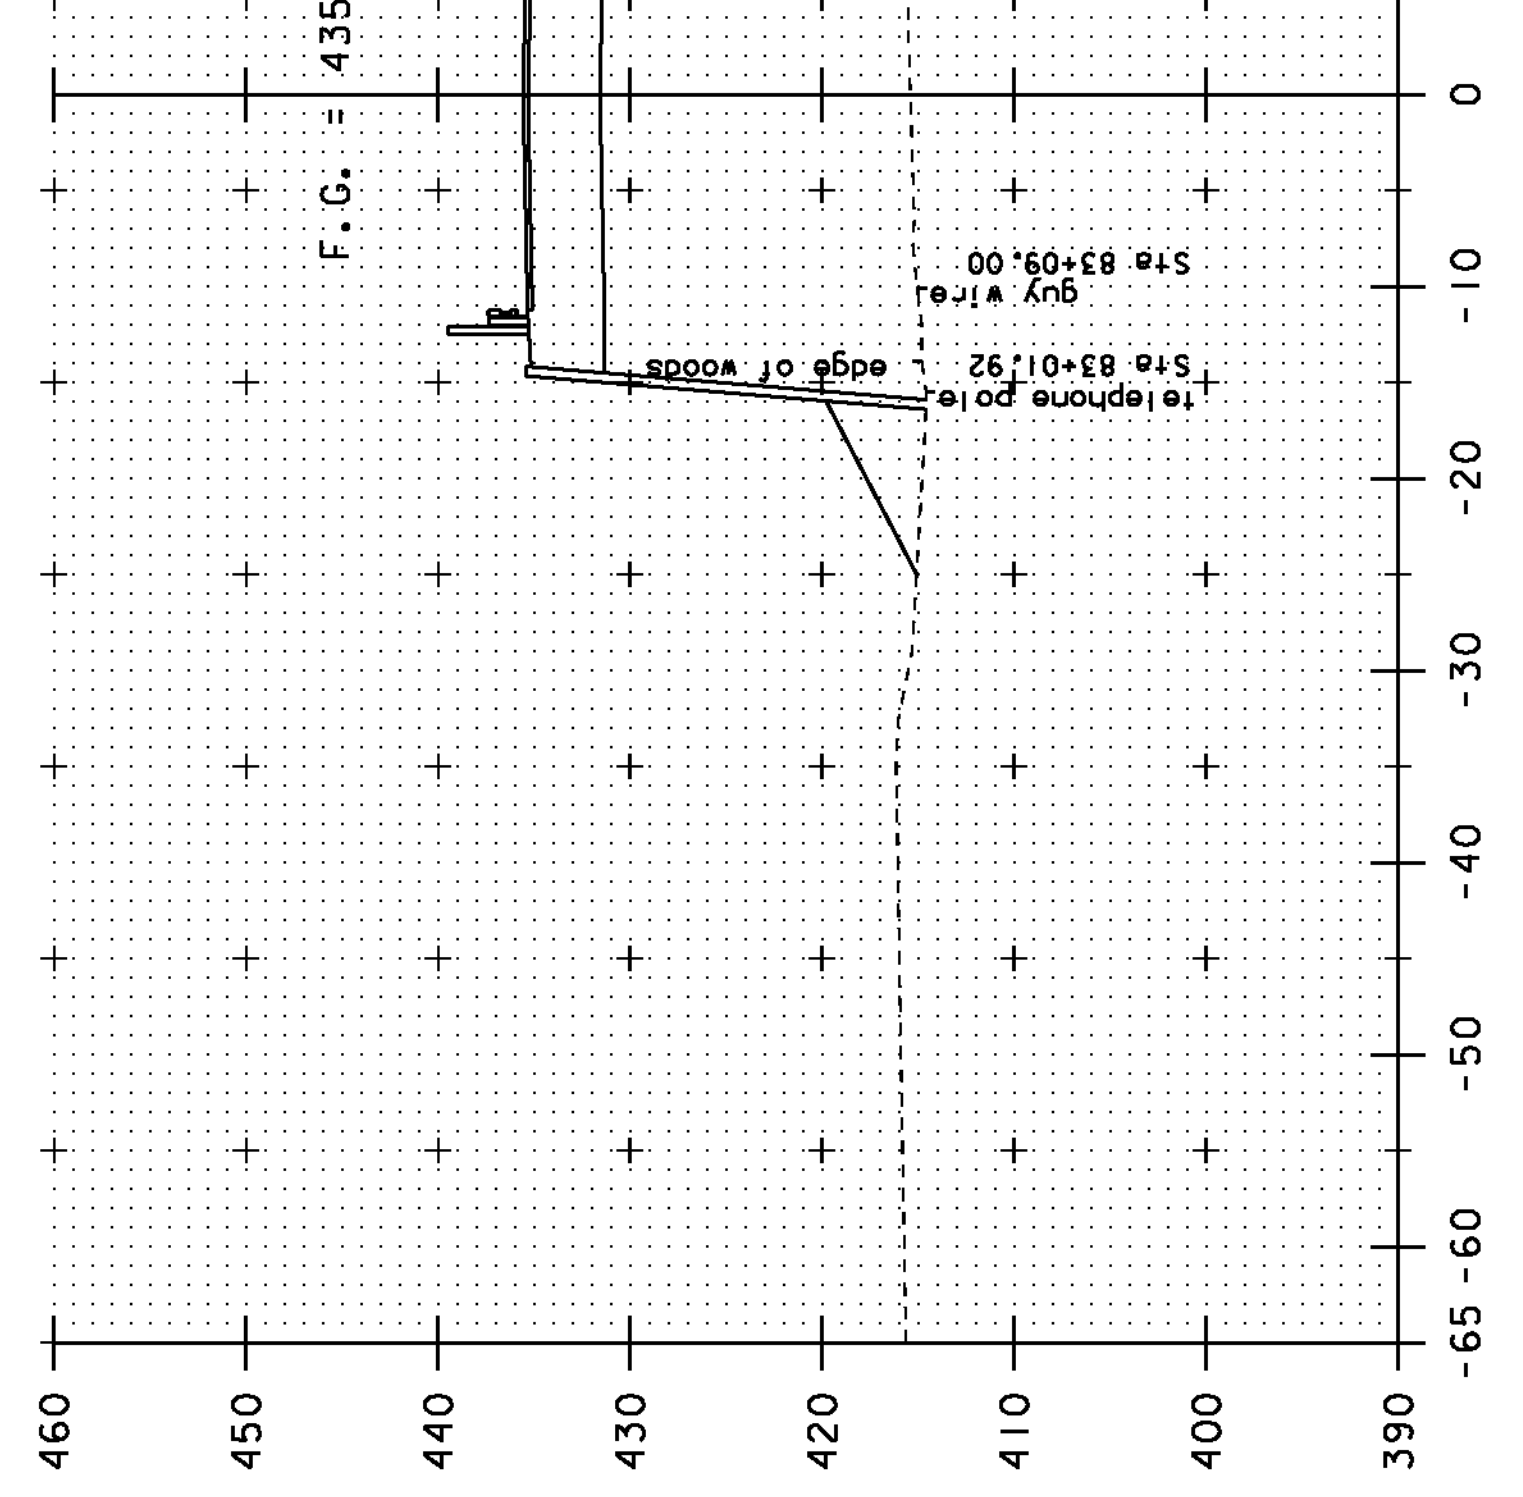

83+0

STA. 82+50 TO STA. 83+0

SCALE 1" = 10'