


83+75

84+25
END APPROX

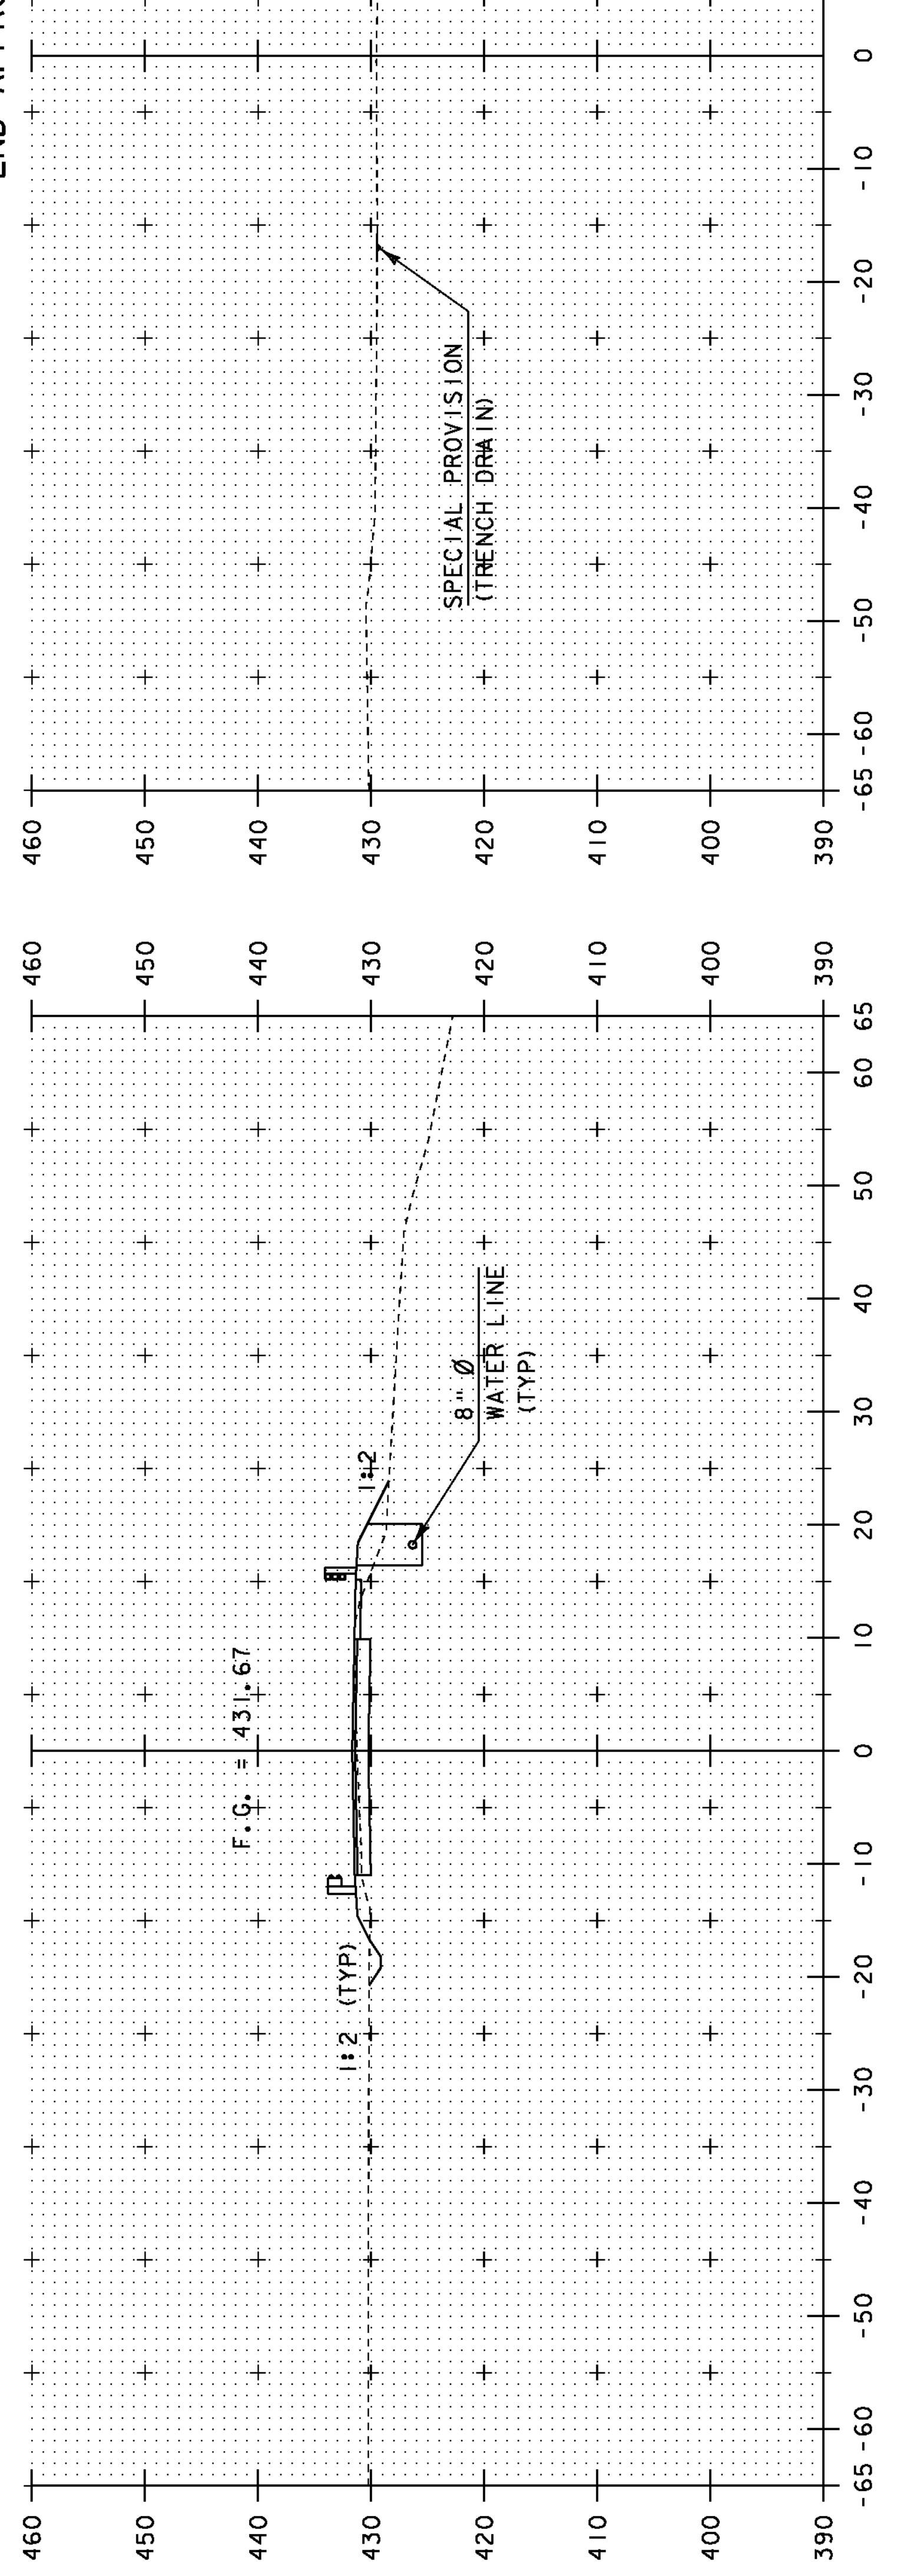

83+50
END PROJECT

84+00

STA. 83+50 TO STA. 84+00

SCALE 1" = 10'
0