



TH 29 (GILLETTE ST) ROADWAY TYPICAL  
SCALE 3/8" = 1'-0"

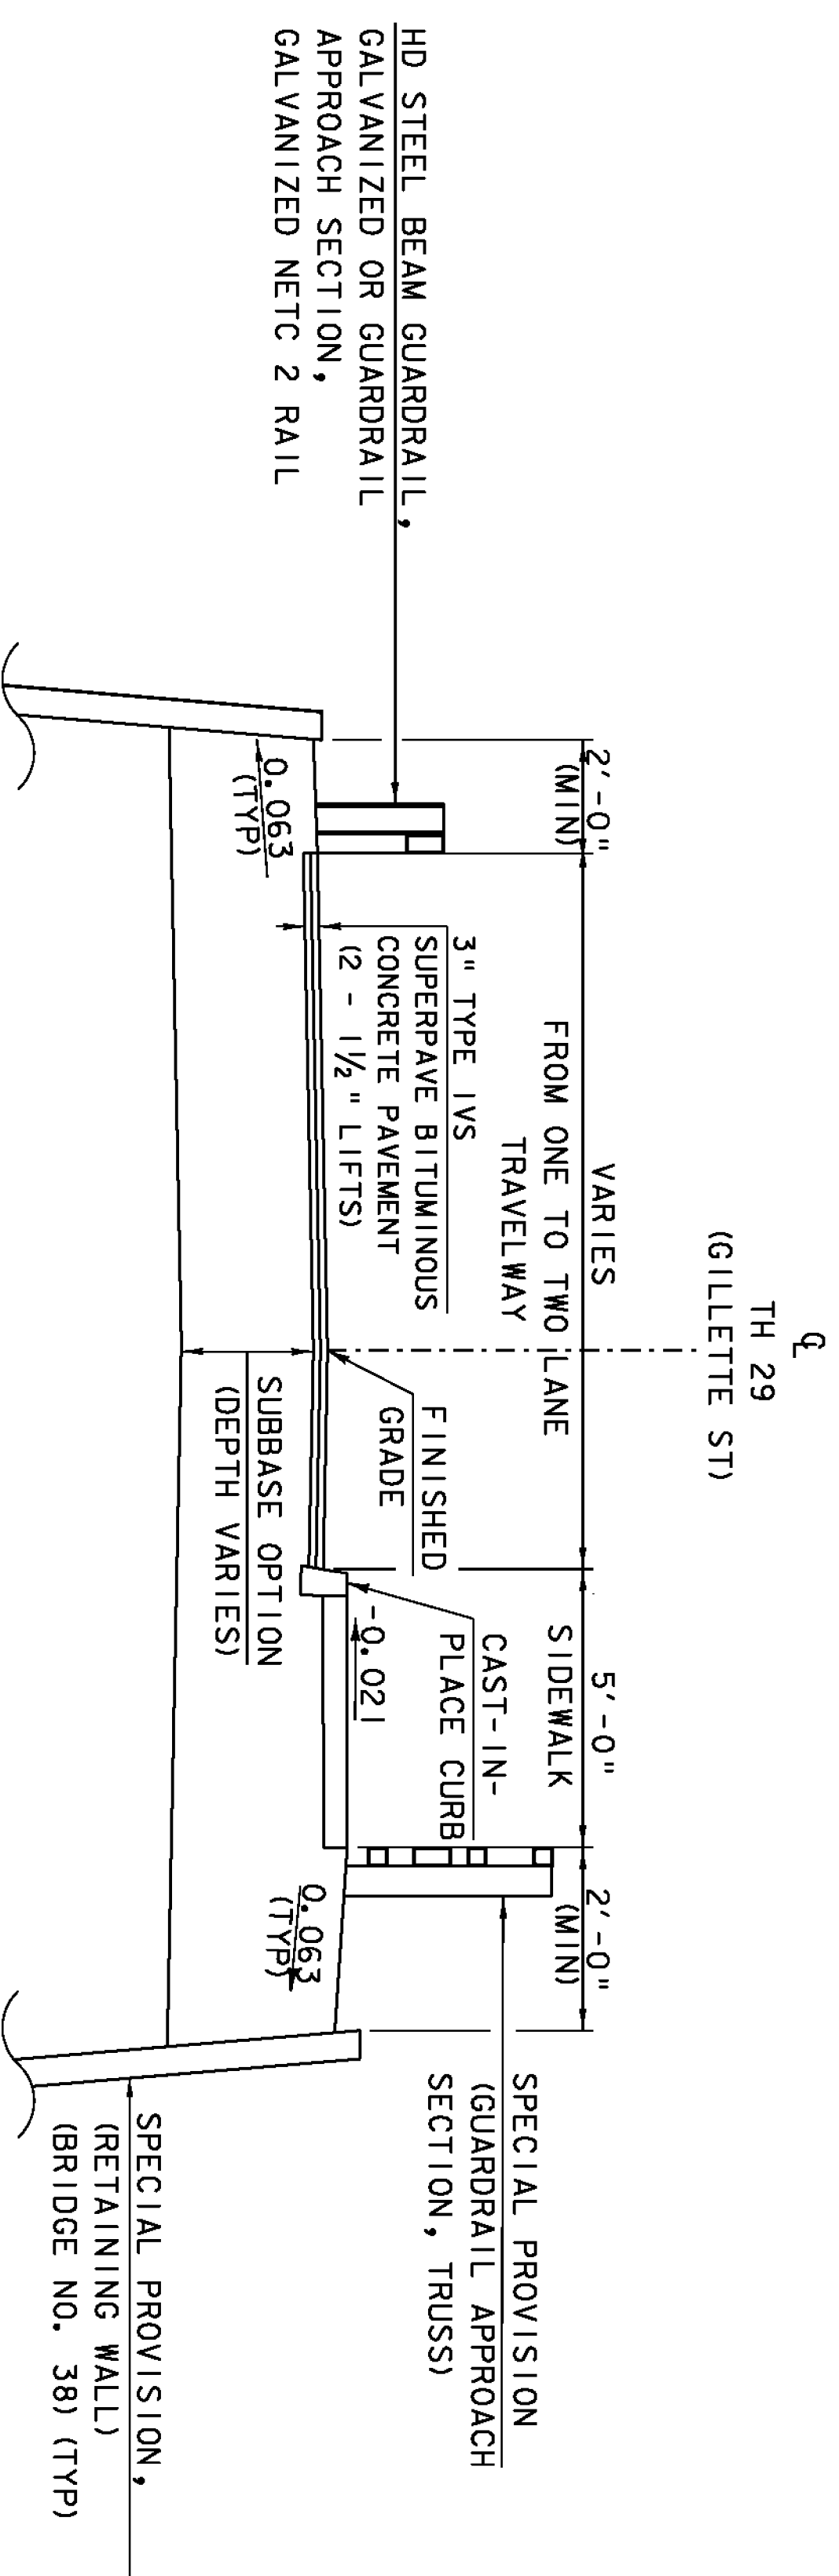

RETAINED FILL TYPICAL  
SCALE 3/8" = 1'-0"

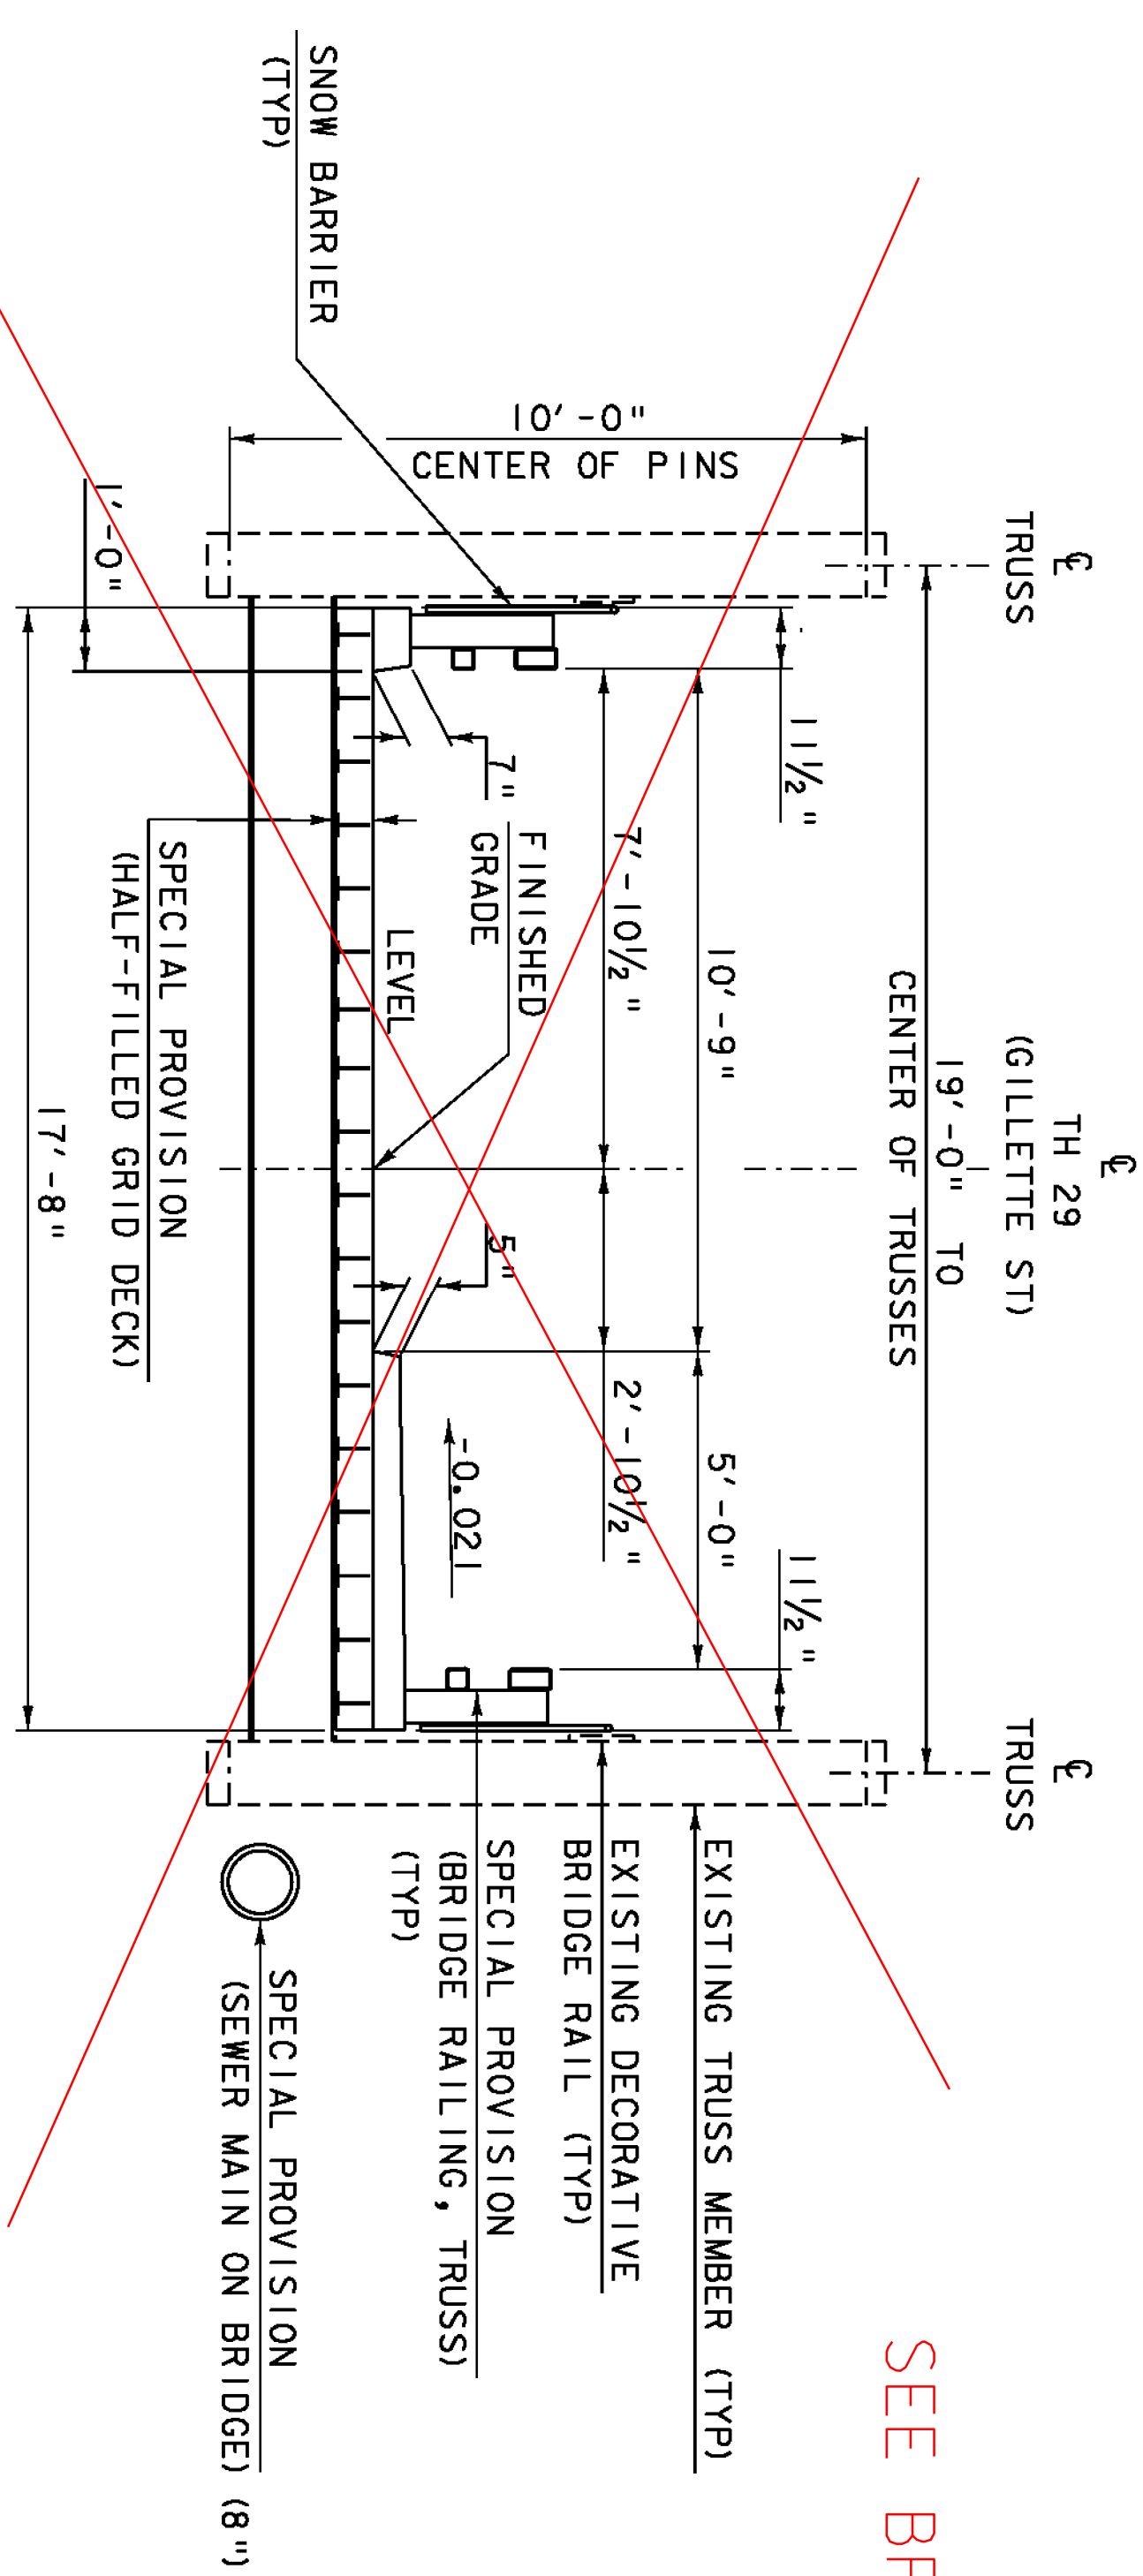


BRIDGE #38 TYPICAL  
SCALE 3/8" = 1'-0"

SEE BR. 39 TYPICAL REVISION

**SUMMARY OF WORK**

1. REMOVE SUPPORT BEAMS, TIMBER DECK AND FLOOR SYSTEM
2. SUPPORT SEWER LINE
3. REMOVE TRUSSES
4. BLAST CLEAN AND PAINT TRUSSES
5. REPLACE DAMAGED TRUSS COMPONENTS
6. REPAIR THE STONE ABUTMENTS
7. INSTALL EARTH RETAINING STRUCTURES
8. INSTALL CONCRETE ABUTMENTS FOR TRUSS BEARING
9. REPLACE TRUSS BEARINGS
10. RE-INSTALL TRUSSES
11. INSTALL FLOOR SYSTEM AND HALF-FILLED GRID DECK
12. INSTALL BRIDGE RAIL AND APPROACH GUIDE RAIL
13. RAISE AND REATTACH SEWER LINE
14. PAVE ROAD, INSTALL SIGNS AND PAVEMENT MARKINGS

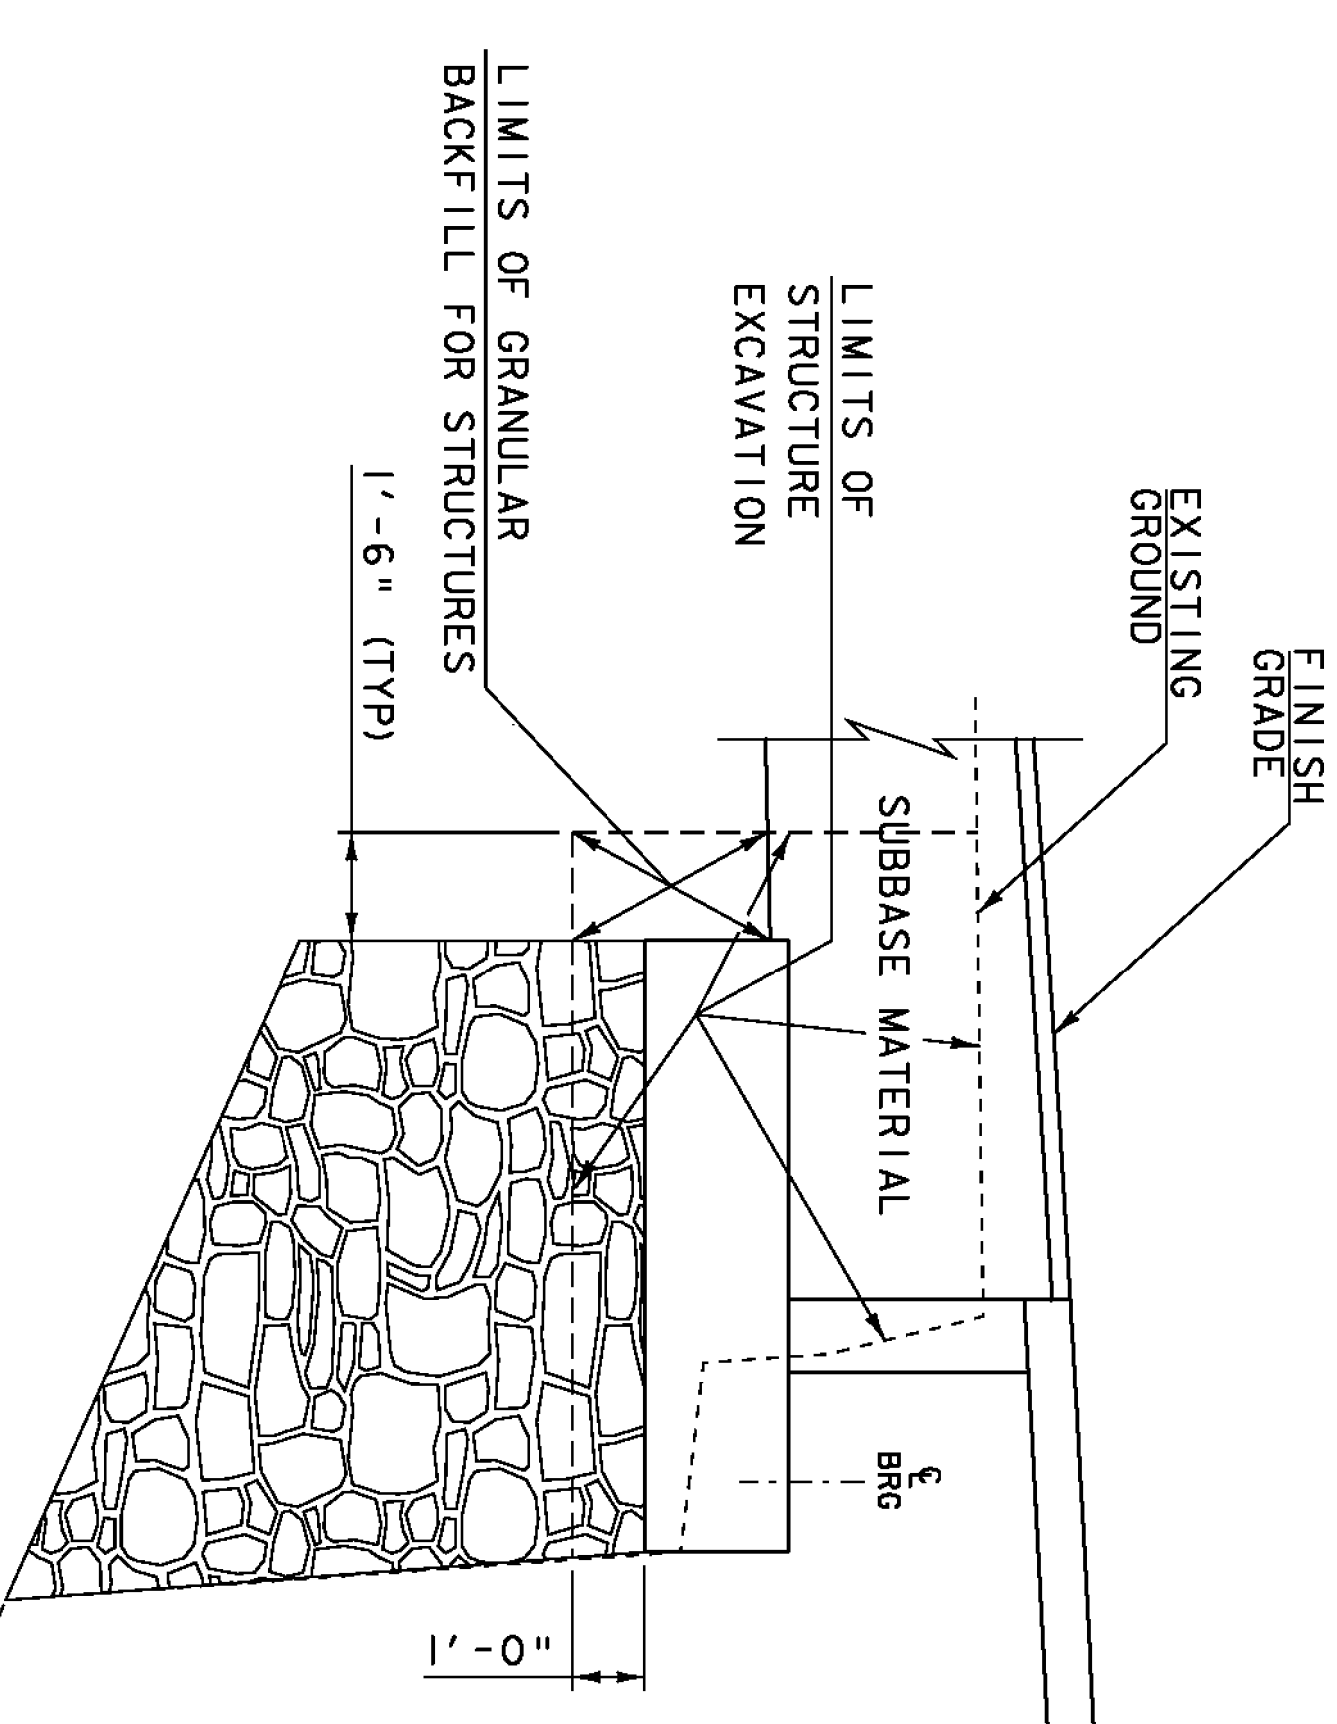

EARTHWORK SECTION  
SCALE 3/8" = 1'-0"

**MATERIAL TOLERANCES**  
(IF USED ON PROJECT)

SURFACE	TOLERANCE
- PAVEMENT (TOTAL THICKNESS)	+/- 1/4"
- AGGREGATE SURFACE COURSE	+/- 1/2"
SUBBASE	+/- 1"
SAND BORROW	+/- 1"

SCALE 3/8" = 1'-0"  
0 1 2 3 4

PROJECT NAME: HARTFORD (WILDER)  
PROJECT NUMBER: STP 1444(35)  
FILE NAME: B38\59610701\yp-lb38.dgn  
PROJECT LEADER: K. HIGGINS  
DESIGNED BY: T. FILLBACH  
TYPICAL SECTIONS - BRIDGE 38  
PLOT DATE: 09-JUL-2010  
DRAWN BY: R. PELLETI  
CHECKED BY: J. SALVATORI  
SHEET 31 OF 69