


TH 29 (GILLETTE ST) PROFILE

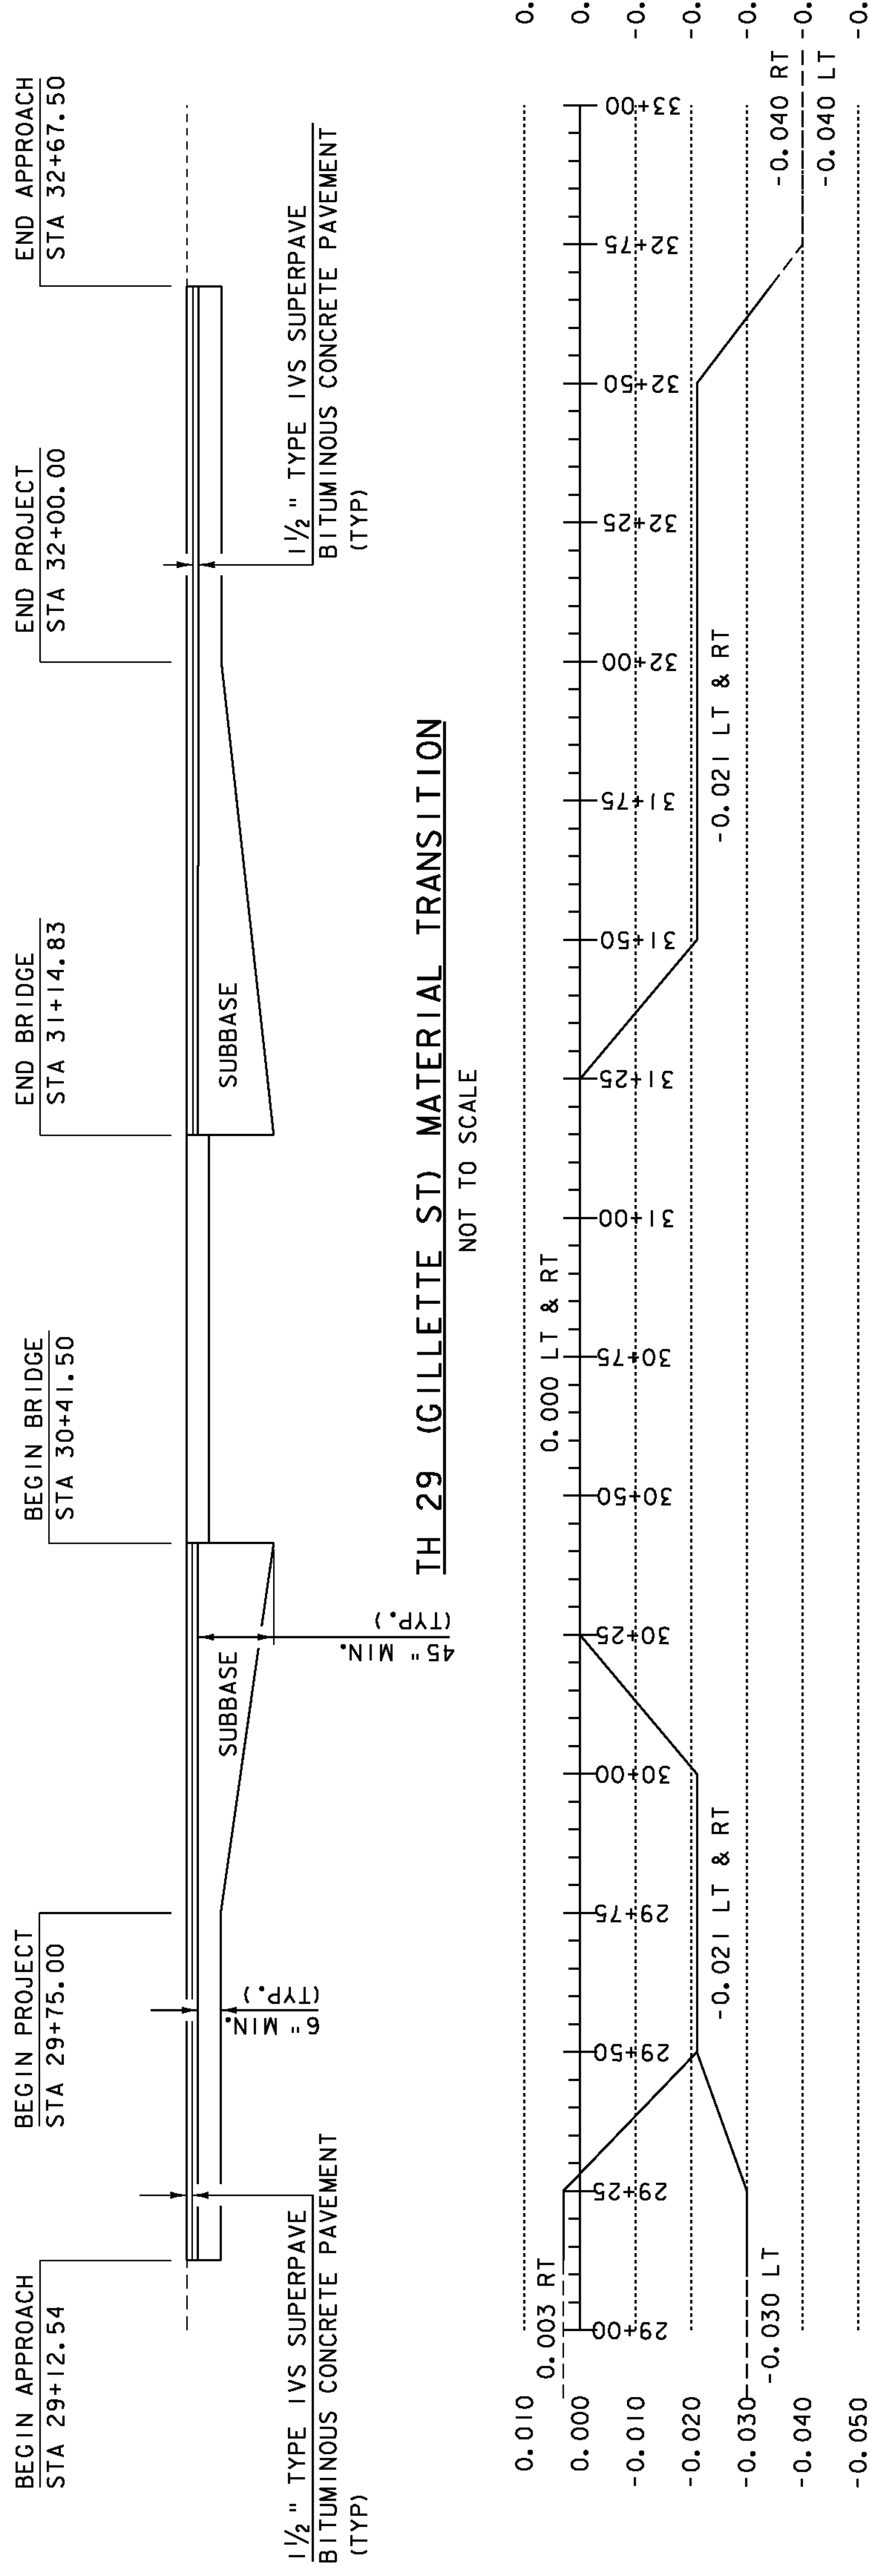

BANKING DIAGRAM

HOR. 1" = 20'-0"
 NO VER. SCALE