

**SOIL CLASSIFICATION**

- A1 Gravel and Sand
- A3 Fine Sand
- A2 Silty or Clayey Gravel and Sand
- A4 Silty Soil - Low Compressibility
- A5 Silty Soil - Highly Compressible
- A6 Clayey Soil - Low Compressibility
- A7 Clayey Soil - Highly Compressible

**ROCK QUALITY DESIGNATION**

R.O.D. (%)	ROCK DESCRIPTION
<25	Very Poor
25 to 50	Poor
51 to 75	Fair
76 to 90	Good
>90	Excellent

**SHEAR STRENGTH**

UNDRAINED SHEAR STRENGTH IN P.S.F.	CONSISTENCY
<250	Very Soft
250-500	Soft
500-1000	Med. Stiff
1000-2000	Stiff
2000-4000	Very Stiff
>4000	Hard

**CORRELATION GUIDE OF "N" TO DENSITY/CONSISTENCY**

DENSITY (GRANULAR SOILS)		CONSISTENCY (COHESIVE SOILS)	
DESCRIPTIVE TERM	N	DESCRIPTIVE TERM	N
<5	<2	Very Soft	<2
5-10	2-4	Soft	2-4
11-24	5-8	Med. Stiff	5-8
25-50	9-15	Stiff	9-15
>50	16-30	Very Stiff	16-30
	31-60	Hard	31-60
	>60	Very Hard	>60

**DEFINITIONS (AASHTO)**

- BEDROCK (LEDGE) - Rock in its native location of indefinite thickness.
- BOULDER - A rock fragment with an average dimension > 12 inches.
- COBBLE - Rock fragments with an average dimension between 3 and 12 inches.
- GRAVEL - Rounded particles of rock < 3" and > 0.075" (#10 sieve).
- SAND - Particles of rock < 0.075" (#10 sieve) and > 0.0025" (#200 sieve), non or slightly plastic and exhibits no strength when air-dried.
- SILT - Soil < 0.0025" (#200 sieve), non plasticity when moist, and considerable strength when air-dried.


**DEFINITIONS (AASHTO)**

- VARVED - Alternate layers of silt and clay.
- HARDFAN - Extremely dense soil, cemented layer, not softened when wet.
- MUCK - Soft organic soil (containing > 10% organic material).
- MOISTURE CONTENT - Weight of water divided by dry weight of soil.
- FLOWING SAND - Granular soil so saturated (loose) that it flows into drill casing during extraction of wash rod.
- STRIKE - Angle from magnetic north to line of intersection of bed with a horizontal plane.
- DIP - Inclination of bed with a horizontal plane.

**COMMONLY USED SYMBOLS**

- ▼ Water Elevation
- ⊕ Standard Penetration Boring
- ⊙ Auger Boring
- ⊖ Rod Sounding
- ⊗ Sample
- ⊘ Standard Penetration Test
- ⊙ Blow Count Per Foot For:
- 2" O.D. Sampler
- 1 7/8" I.D. Sampler
- Hammer Weight Of 140 Lbs.
- Hammer Fall Of 30"
- Field Vane Shear Test
- Undisturbed Soil Sample
- Blast
- Diamond Core
- Mud Drill
- Wash Ahead
- Hollow Stem Auger
- Core Size 1 1/8"
- Core Size 1 7/8"
- Core Size 2 7/8"
- Double Tube Core Barrel Used
- Liquid Limit
- Plasticity Limit
- Non Plastic
- Moisture Content (Dry Wgt. Basis)
- Dry
- Moist
- Moist To Wet
- Wet
- Saturated
- Boulder
- Gravel
- Sand
- Silt
- Clay
- Hardpan
- Ledge
- No Ledge To Depth
- To Ledge Or Boulder
- Can Not Penetrate Further
- No Recovery
- Rec.
- Percent Recovery
- Rock Quality Designation
- ROD
- California Bearing Ratio
- CBR
- Less Than
- Greater Than
- Refusal (N > 100)

SYMBOL	COLOR
blk	Black
bl	Blue
brn	Brown
dk	Dark
gry	Gray
gn	Green
lt	Light
or	Orange
pk	Pink
pu	Purple
rd	Red
tn	Tan
wh	White
yel	Yellow
mtc	Multicolored

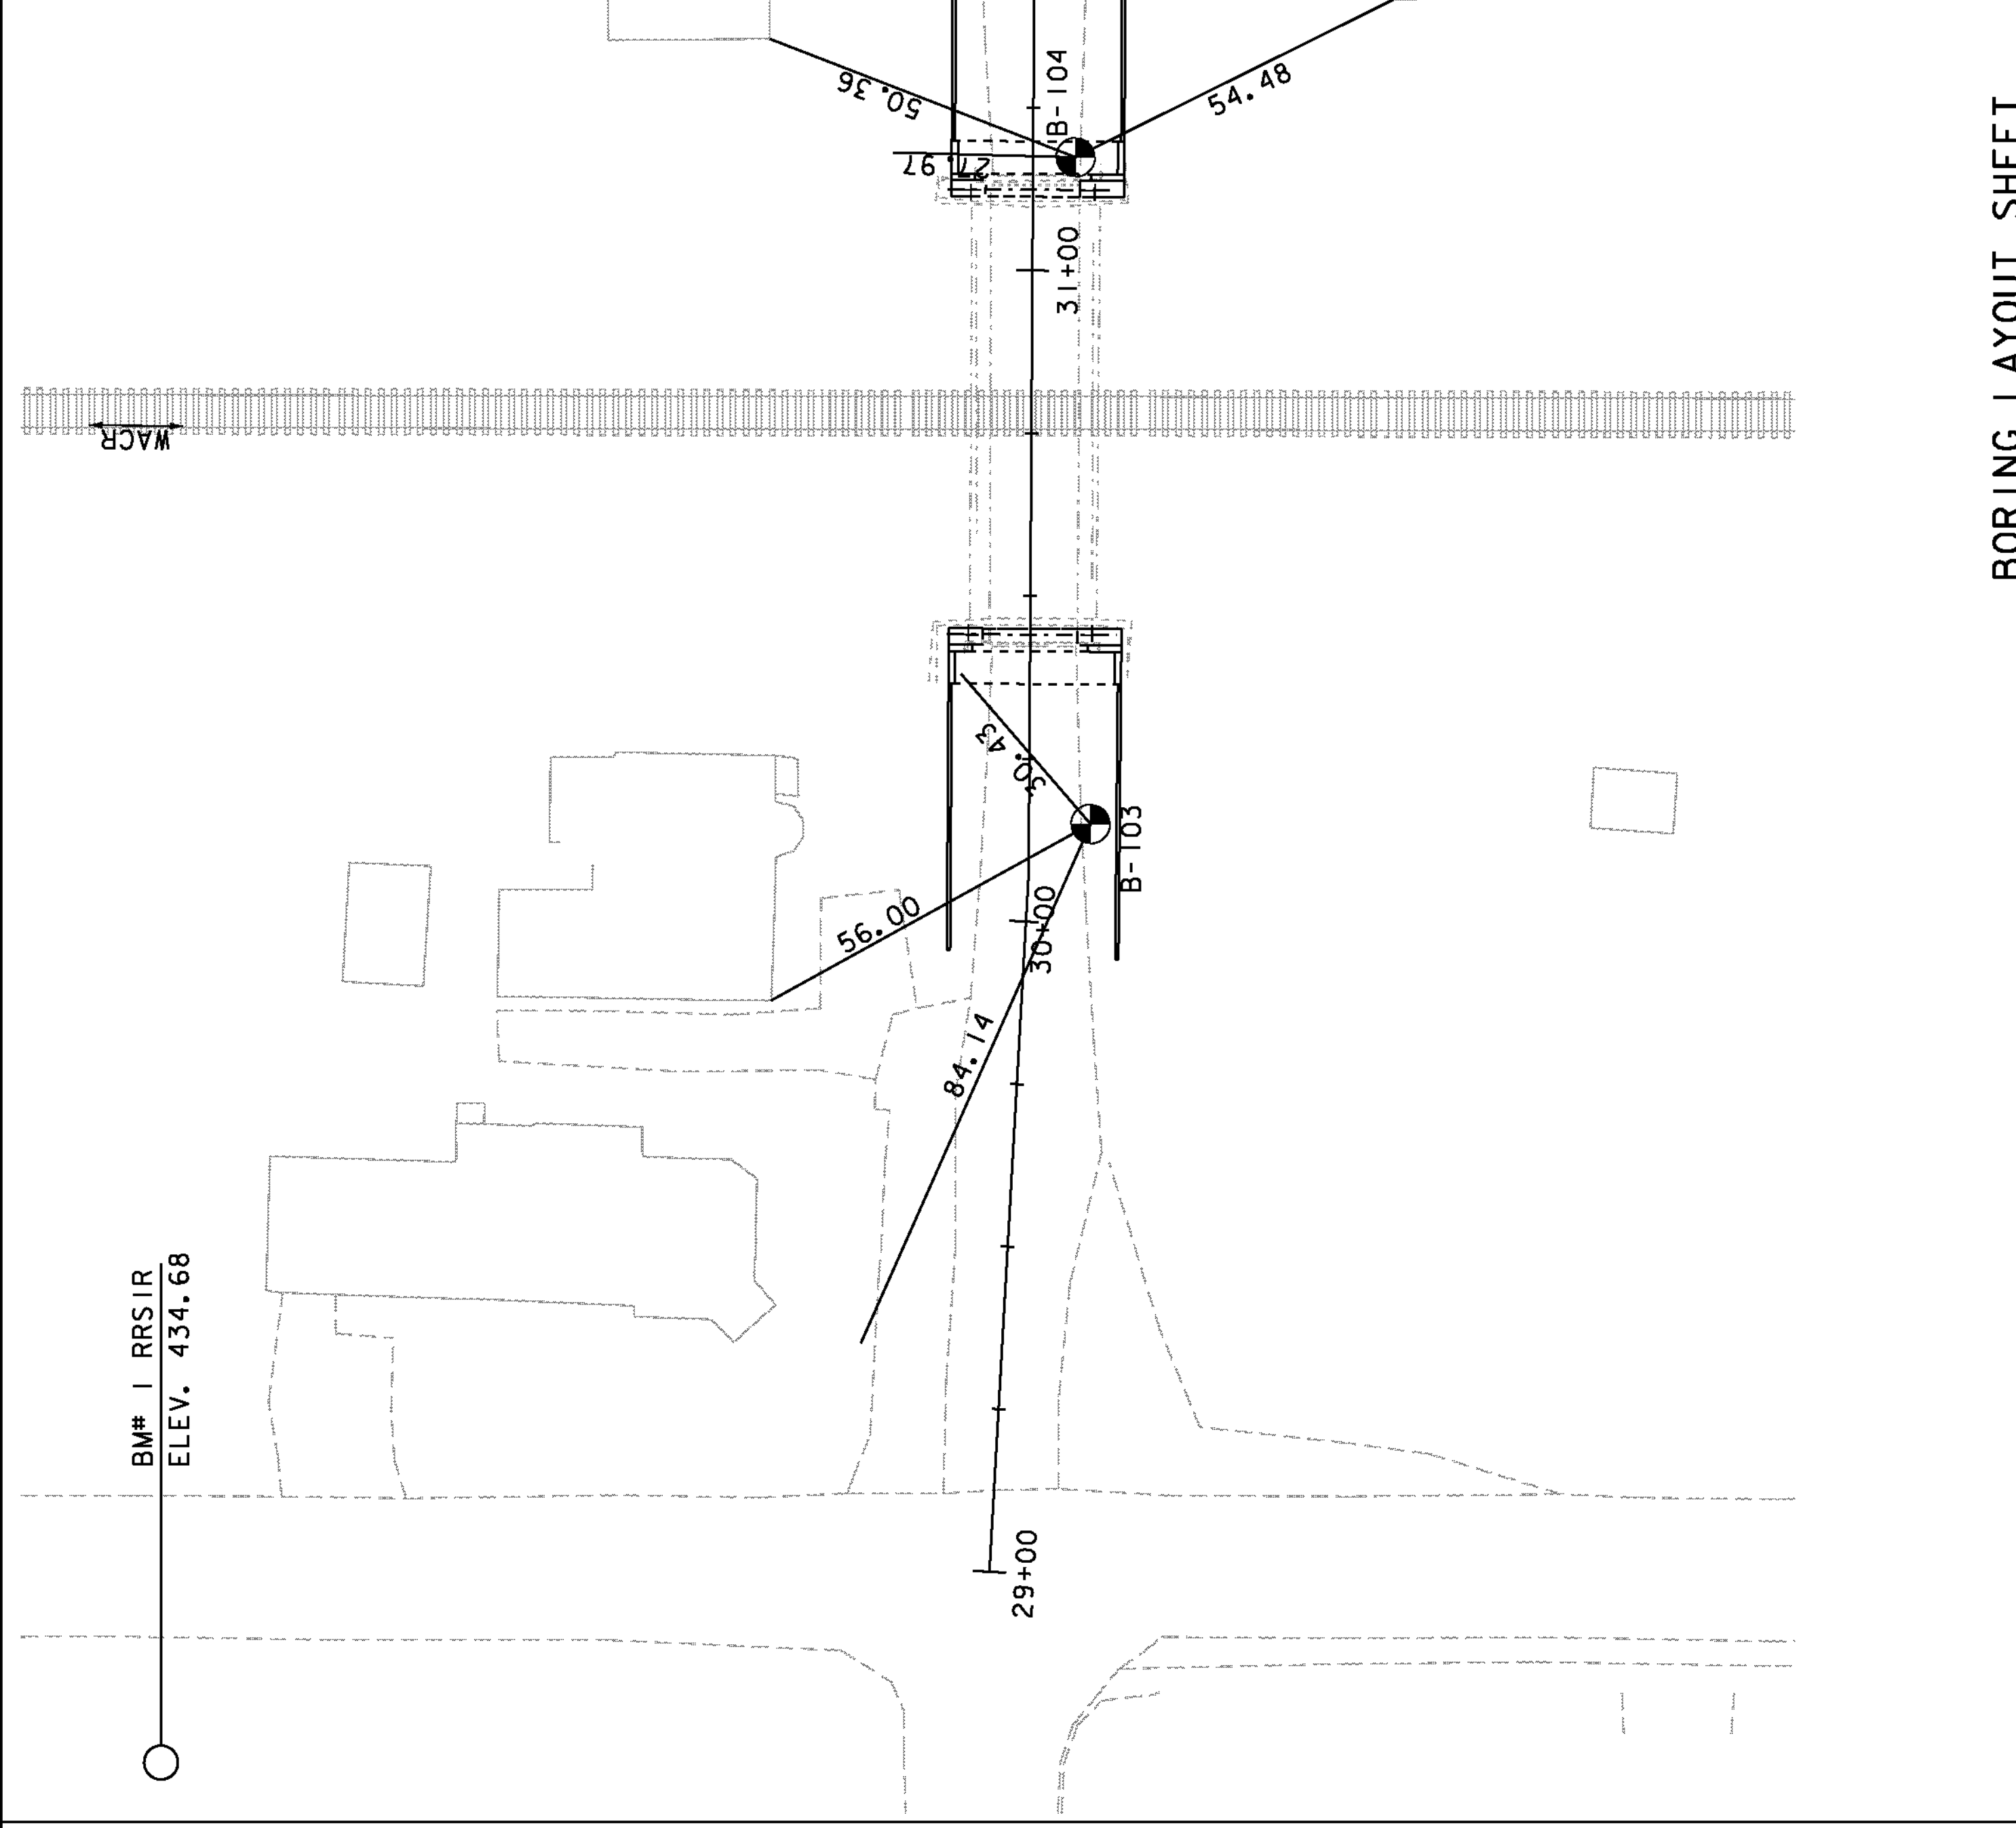

**BORING LAYOUT SHEET**

1. The subsurface explorations shown herein were made between 7/15/08 and 7/18/08 by the Agency.
2. Soil and rock classifications, properties and descriptions are based on engineering interpretation from available subsurface information from the Agency and may not necessarily reflect actual variations in subsurface conditions that may be encountered between individual boring or sample locations.
3. Observed water levels and/or conditions indicated are as recorded at the time of exploration and may vary according to the prevailing rainfall, methods of exploration and other factors.
4. Engineering judgment was exercised in preparing the subsurface information presented herein. Analysis and interpretation of subsurface data was performed and interpreted for Agency design and estimating purposes. Presentation of the information in the Contract is intended to provide the Contractor access to the same data available to the Agency. The subsurface information is presented in good faith and is not intended as a substitute for personal investigation, independent interpretation, independent analysis or judgment by the Contractor.
5. Pictorial structure details show the boring plan layout or soils profile are for illustrative purposes only and may not accurately portray final contract details.
6. Terminology used on boring logs describe the hardness, degree of weathering, and spacing of fractures, joints and other discontinuities in the bedrock defined in the AASHTO Manual on Subsurface Investigations, 1988.