


PLAN

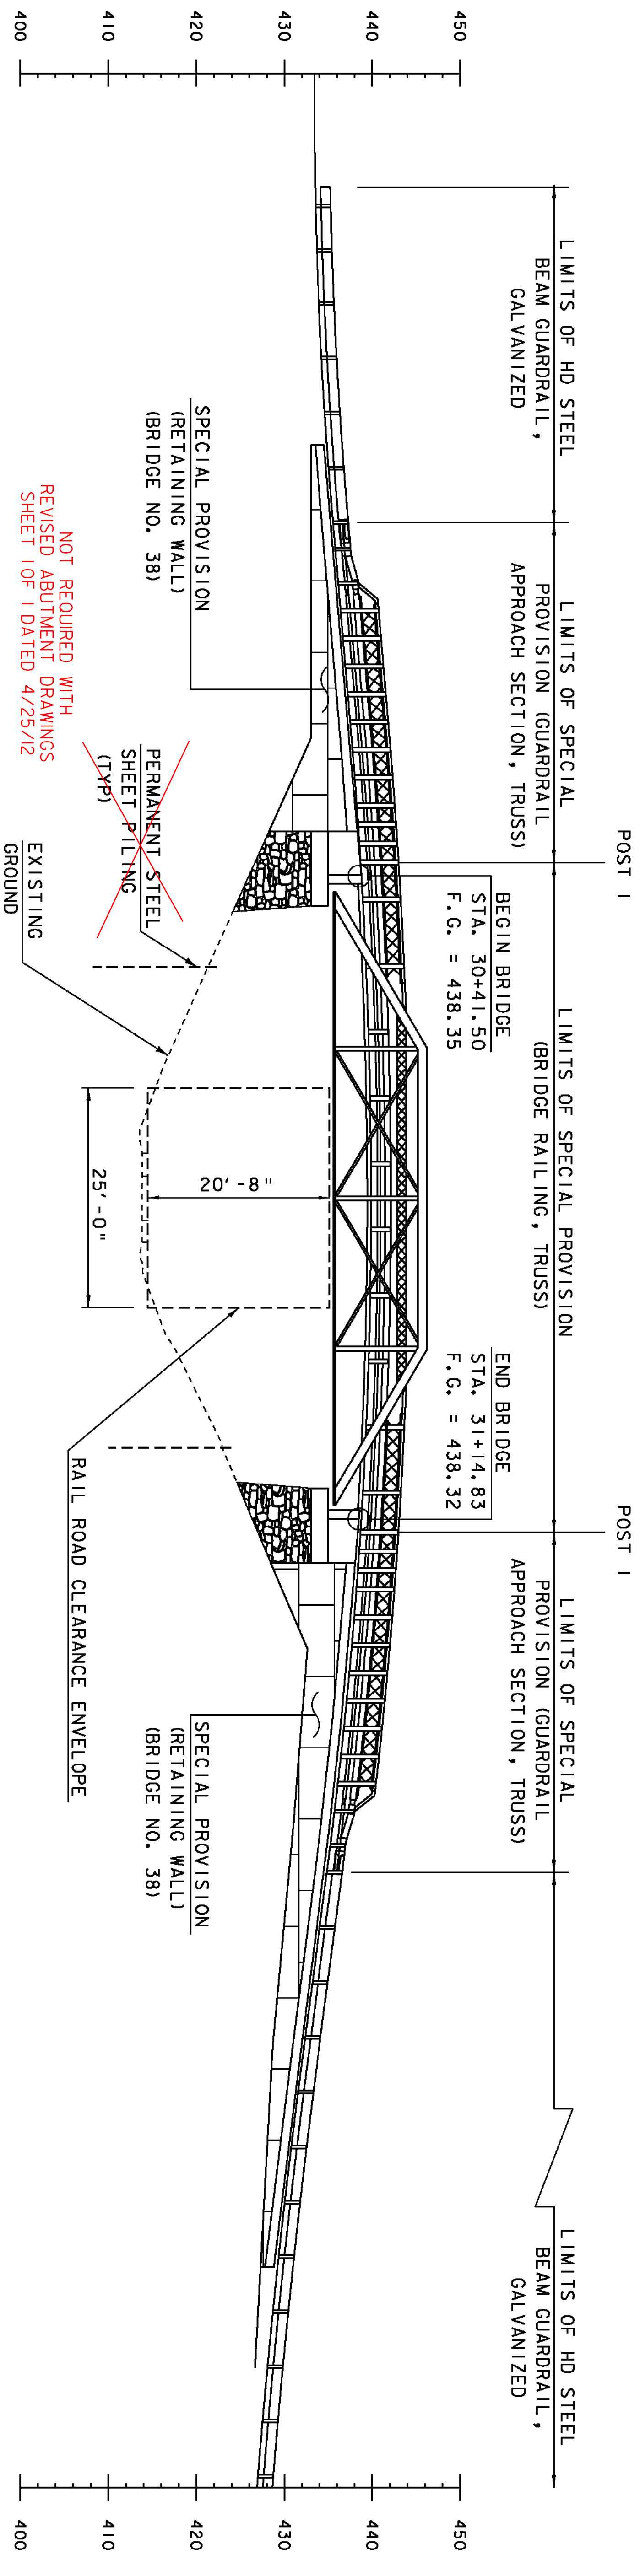

NOT REQUIRED WITH REVISED ABUTMENT DRAWINGS SHEET 1 OF 1 DATED 4/25/12

ELEVATION @ SOUTH FASCIA

SEE RAIL LAYOUT - BRIDGE 38 FOR RAIL DIMENSIONS

SCALE 1" = 10'-0"

PROJECT NAME: HARTFORD (WILDER)	PLOT DATE: 16-JUN-2010
PROJECT NUMBER: STP 1444(35)	DRAWN BY: R. PELLETT
FILE NAME: B38\5961070p_e_b38.dgn	CHECKED BY: J. SALVATORI
PROJECT LEADER: K. HIGGINS	SHEET 41 OF 69
DESIGNED BY: T. FILLBACH	
PLAN & ELEVATION - BRIDGE 38	