


29+12.54

29+12.54


BEGIN APPROACH

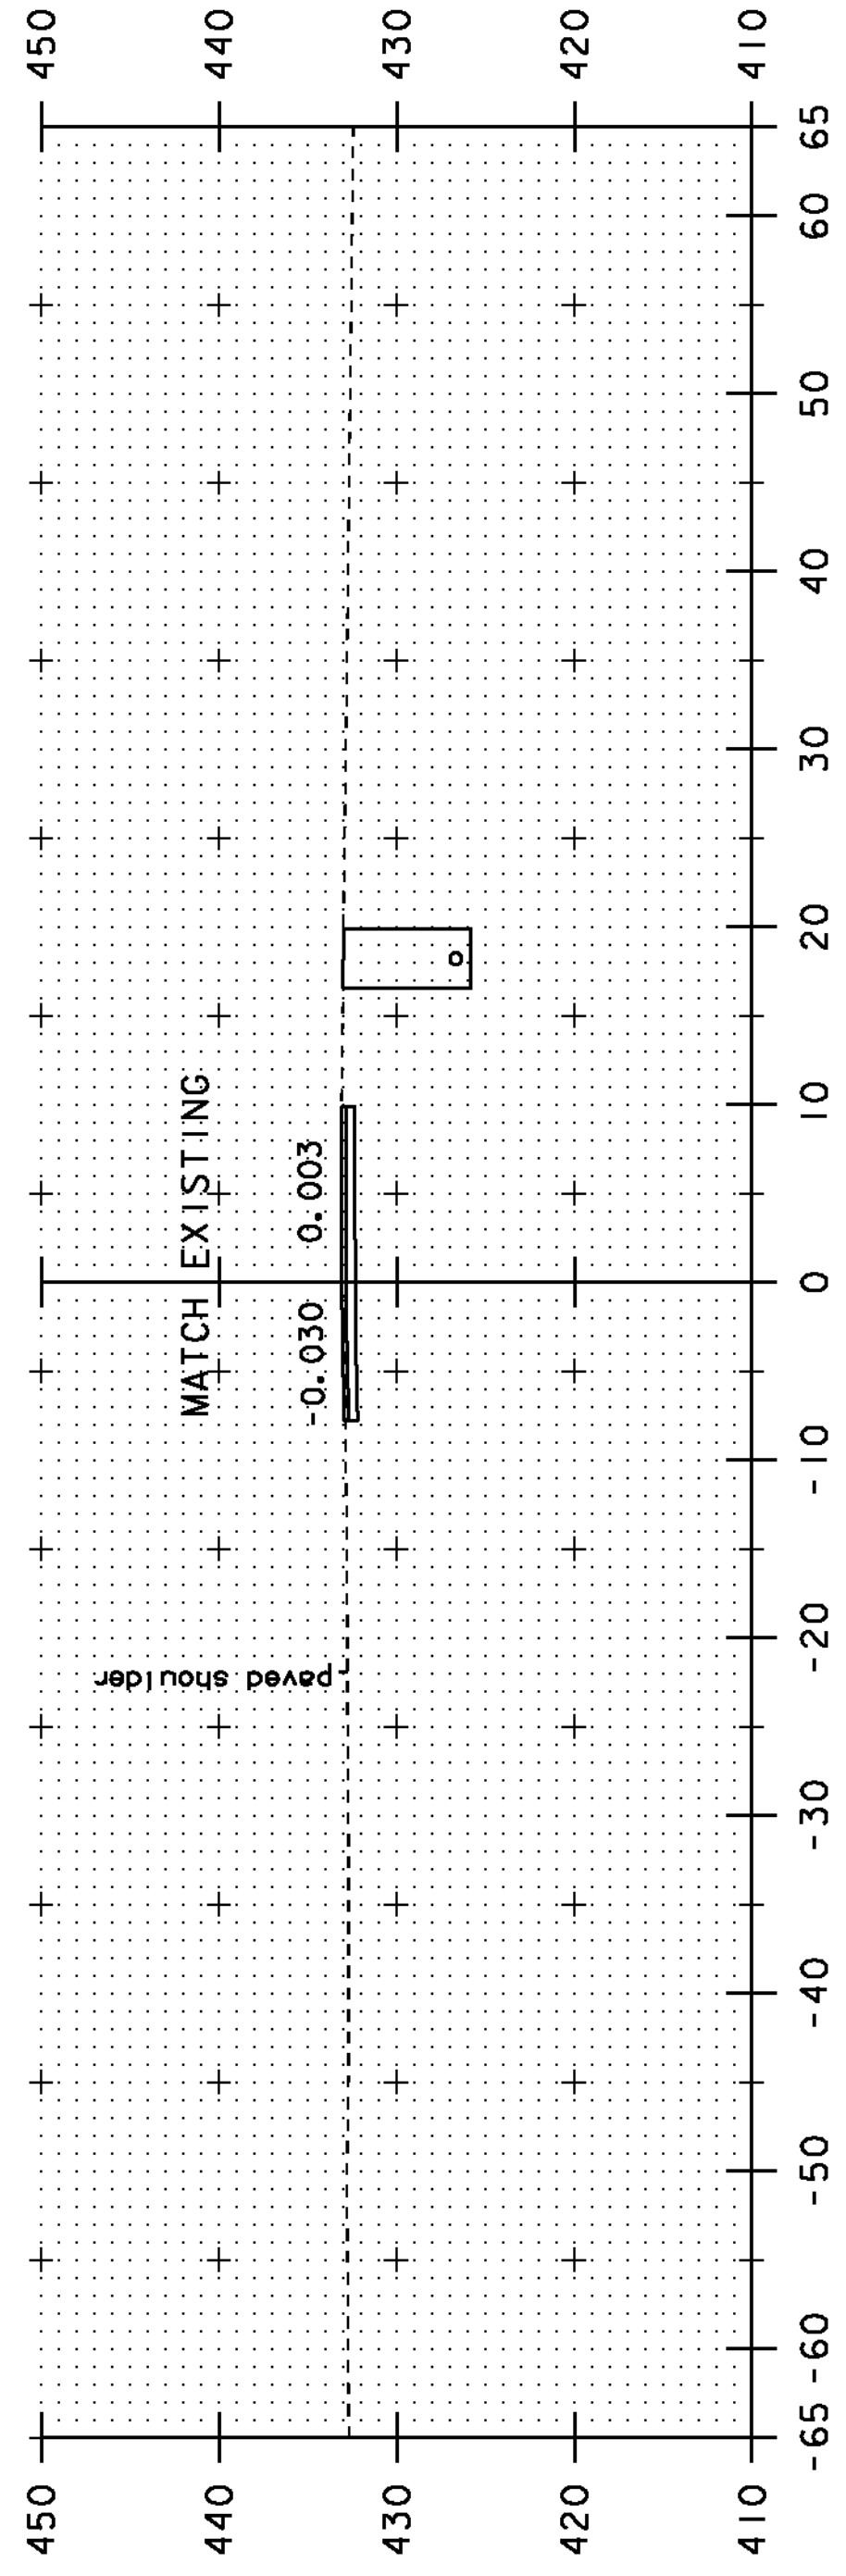


STA 29+70 LT
PAVED APRON & DRIVE

29+75.

BEGIN PRO

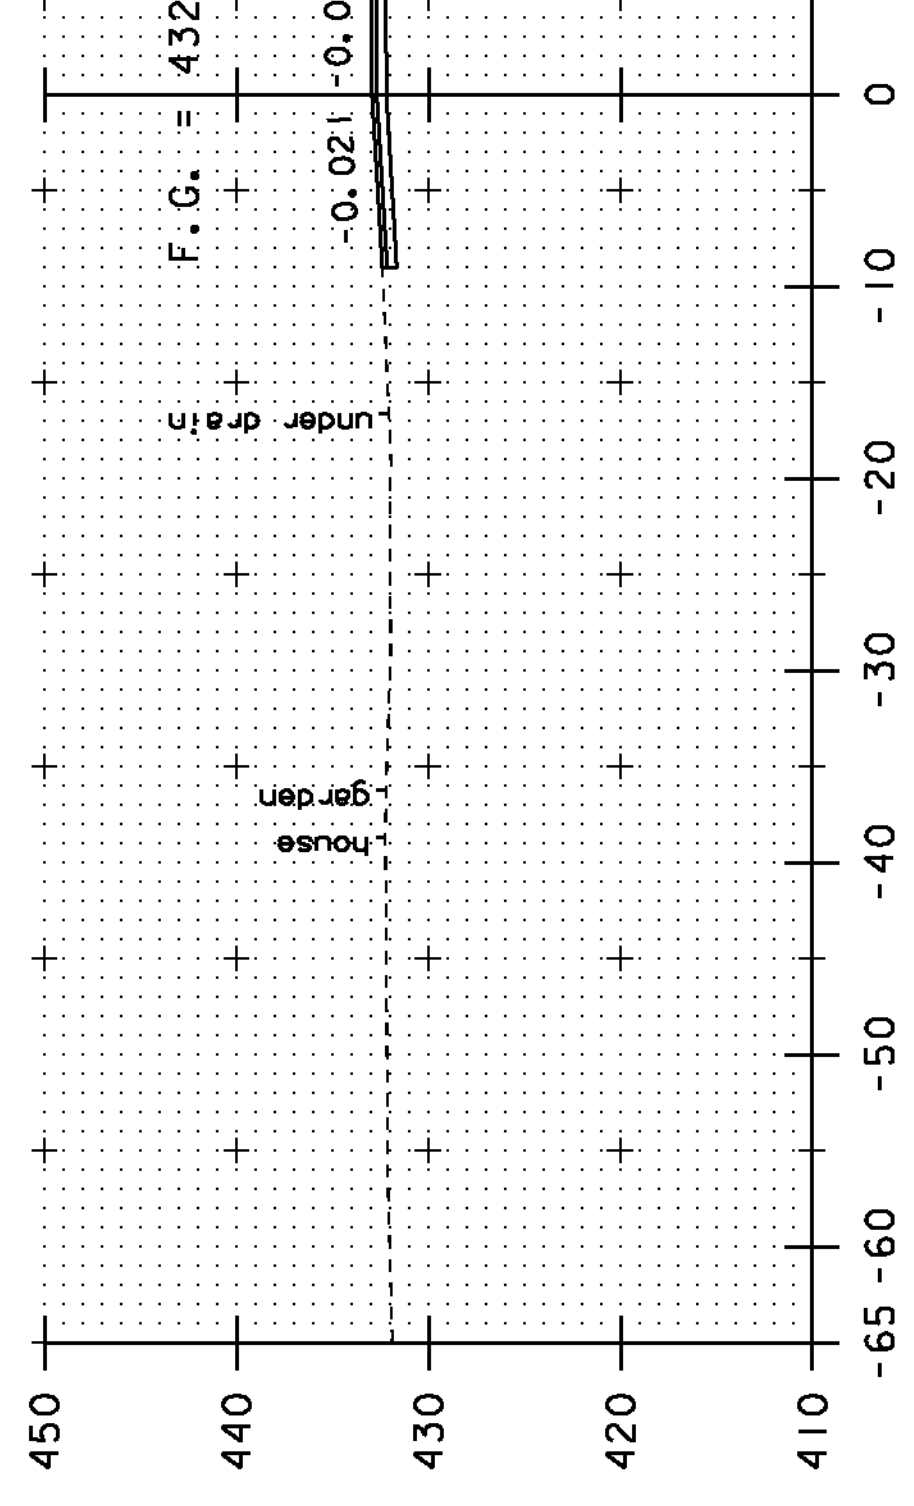

29+50.

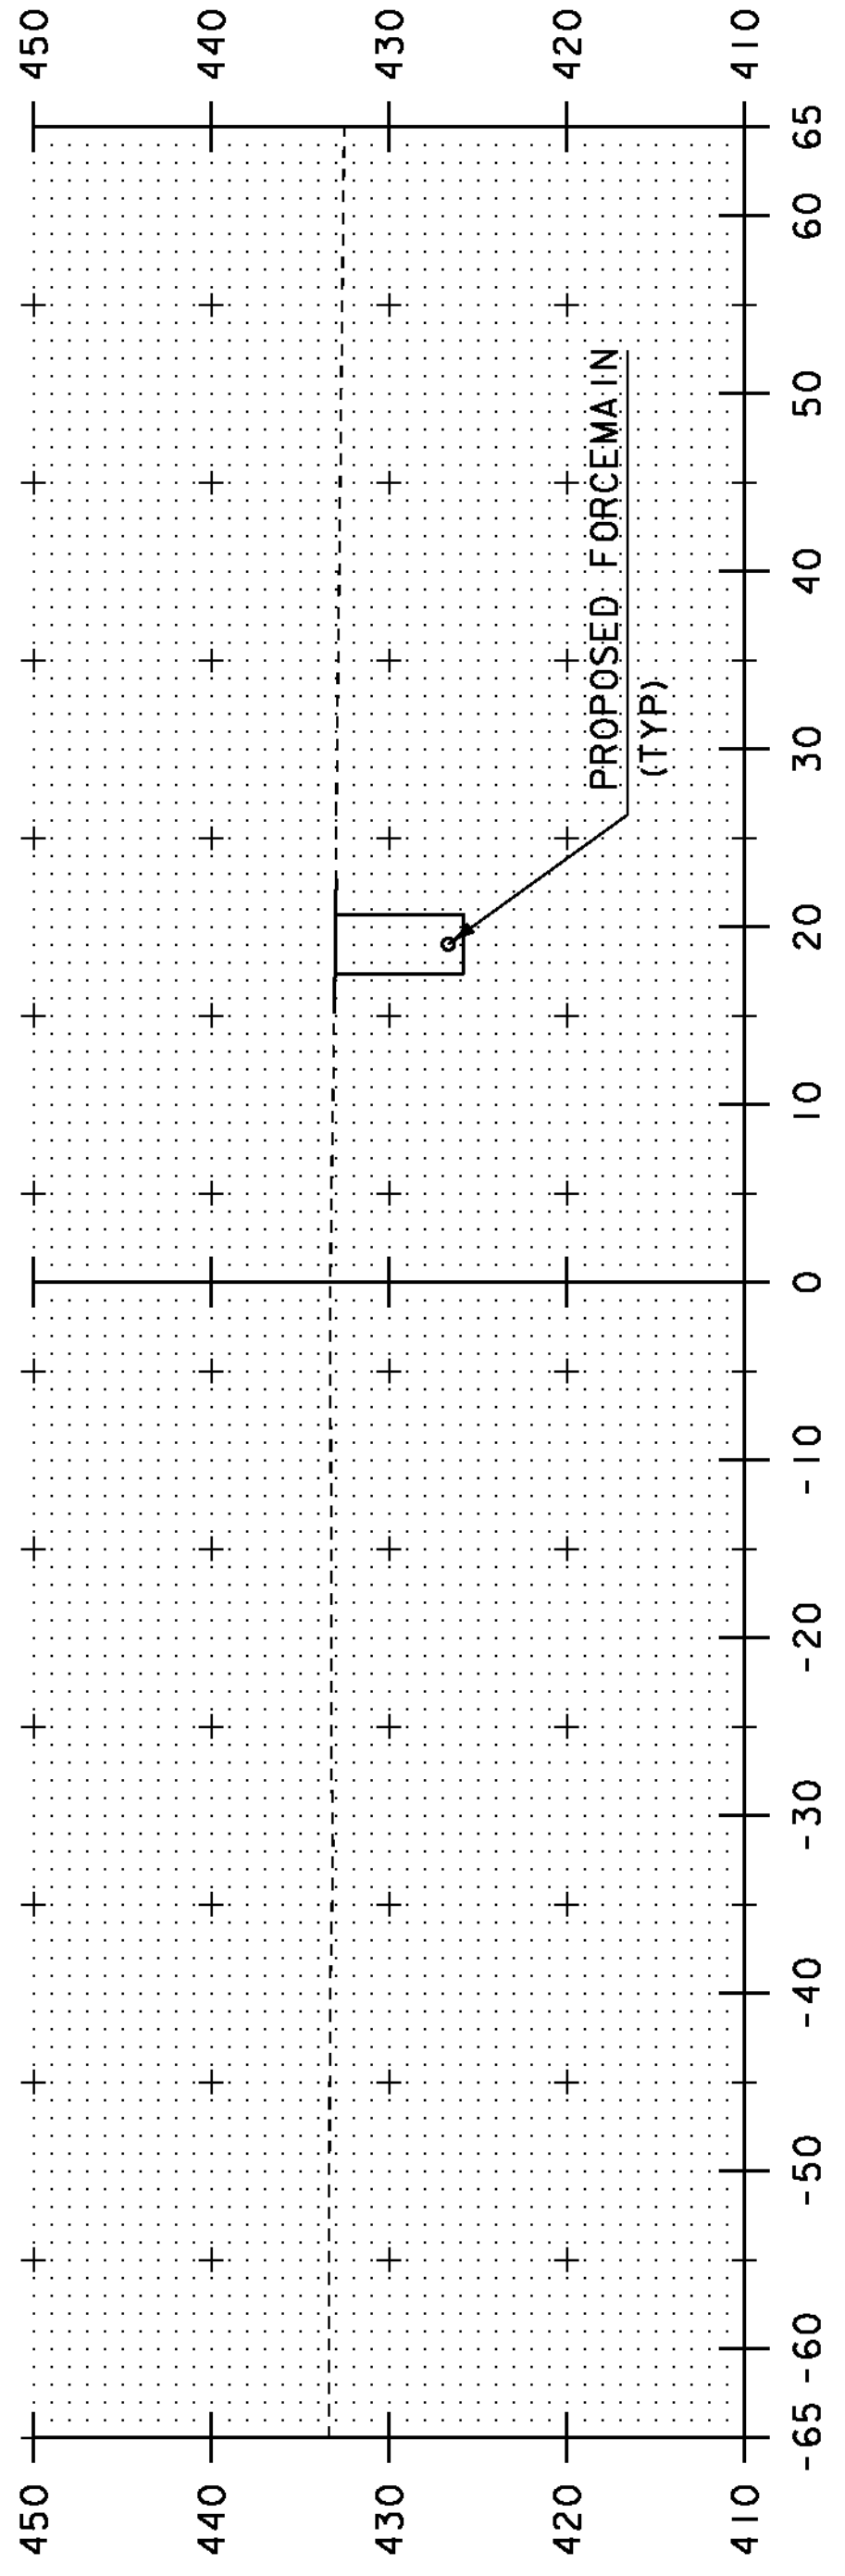

29+00.00

29+43.

SCALE 1" = 10'-0"



STA. 29+00.00 TO STA. 29+75.00