



32+25.00

32+75.

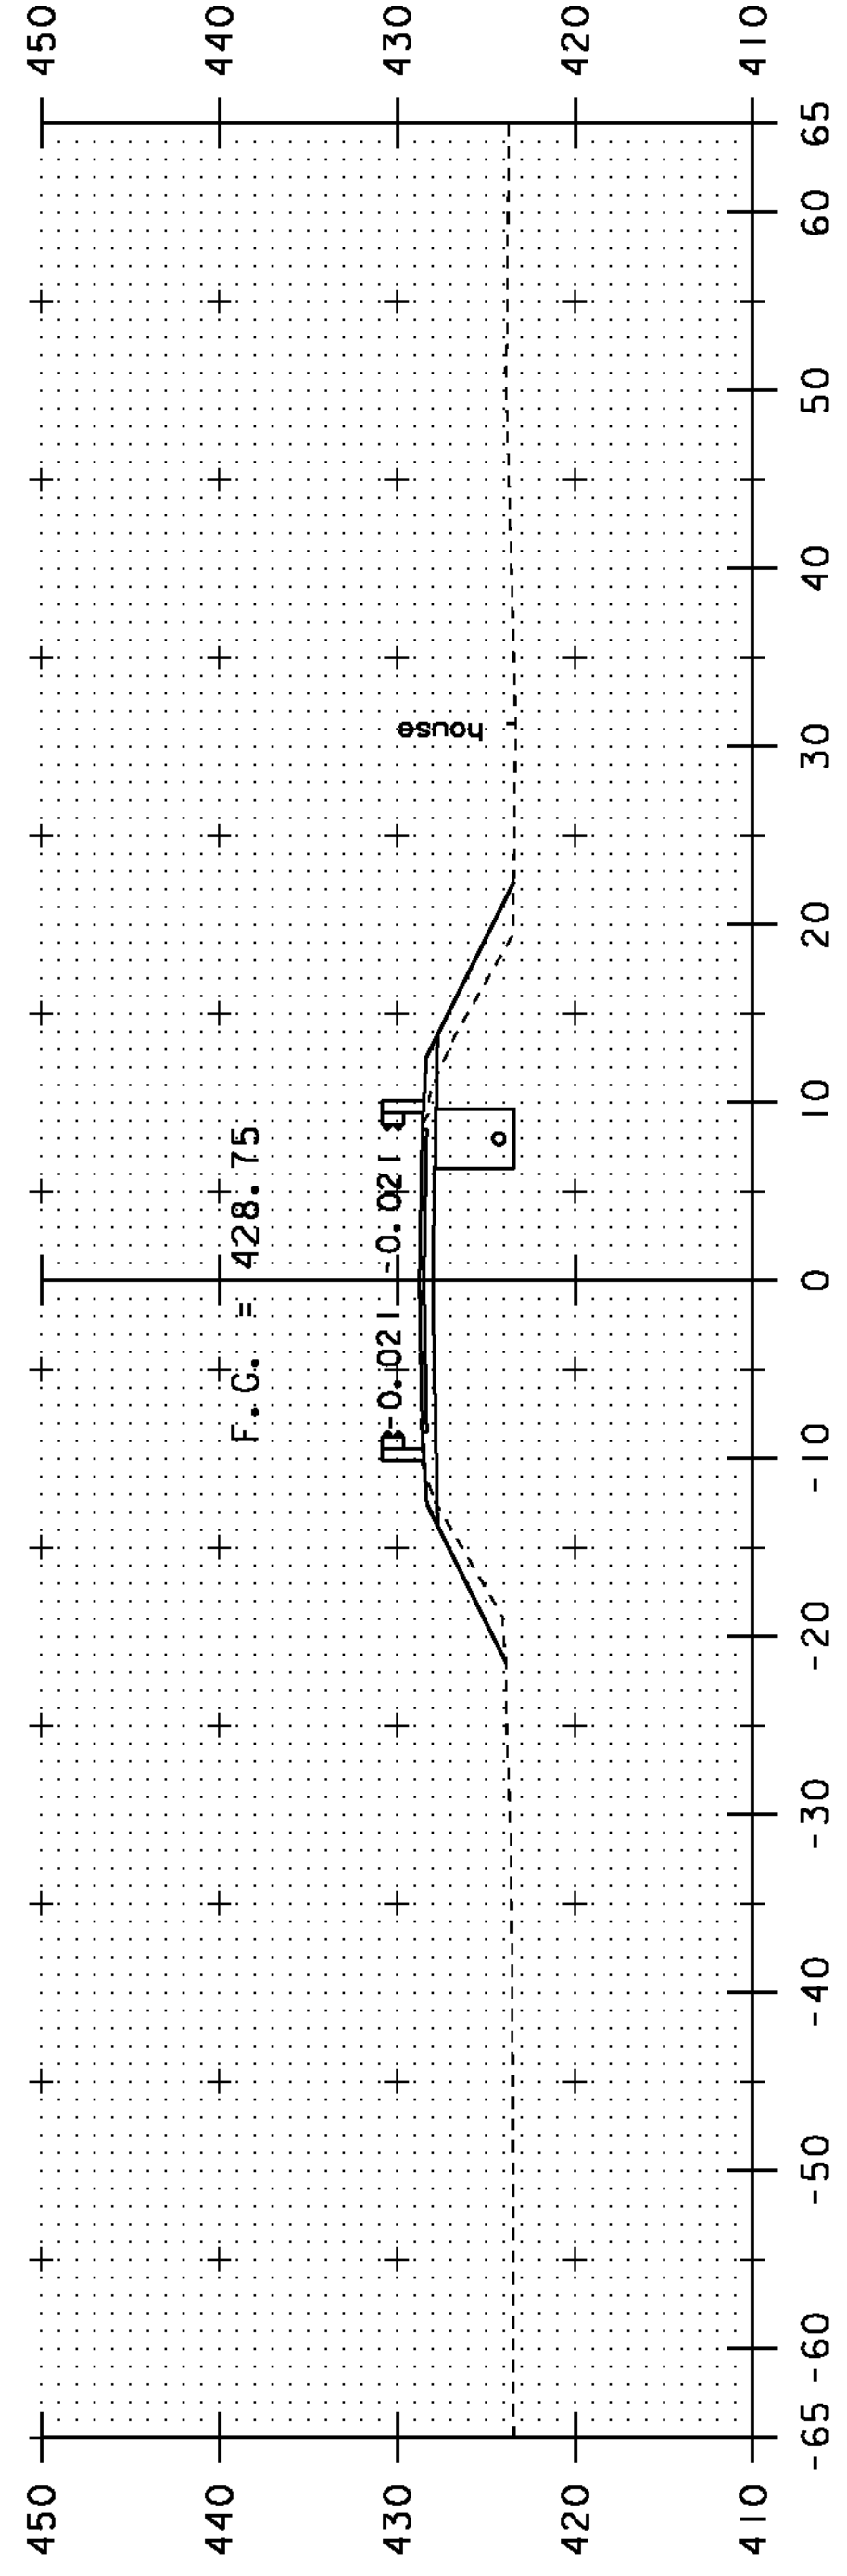


32+00.00  
END PROJECT

32+67.  
END APPROX

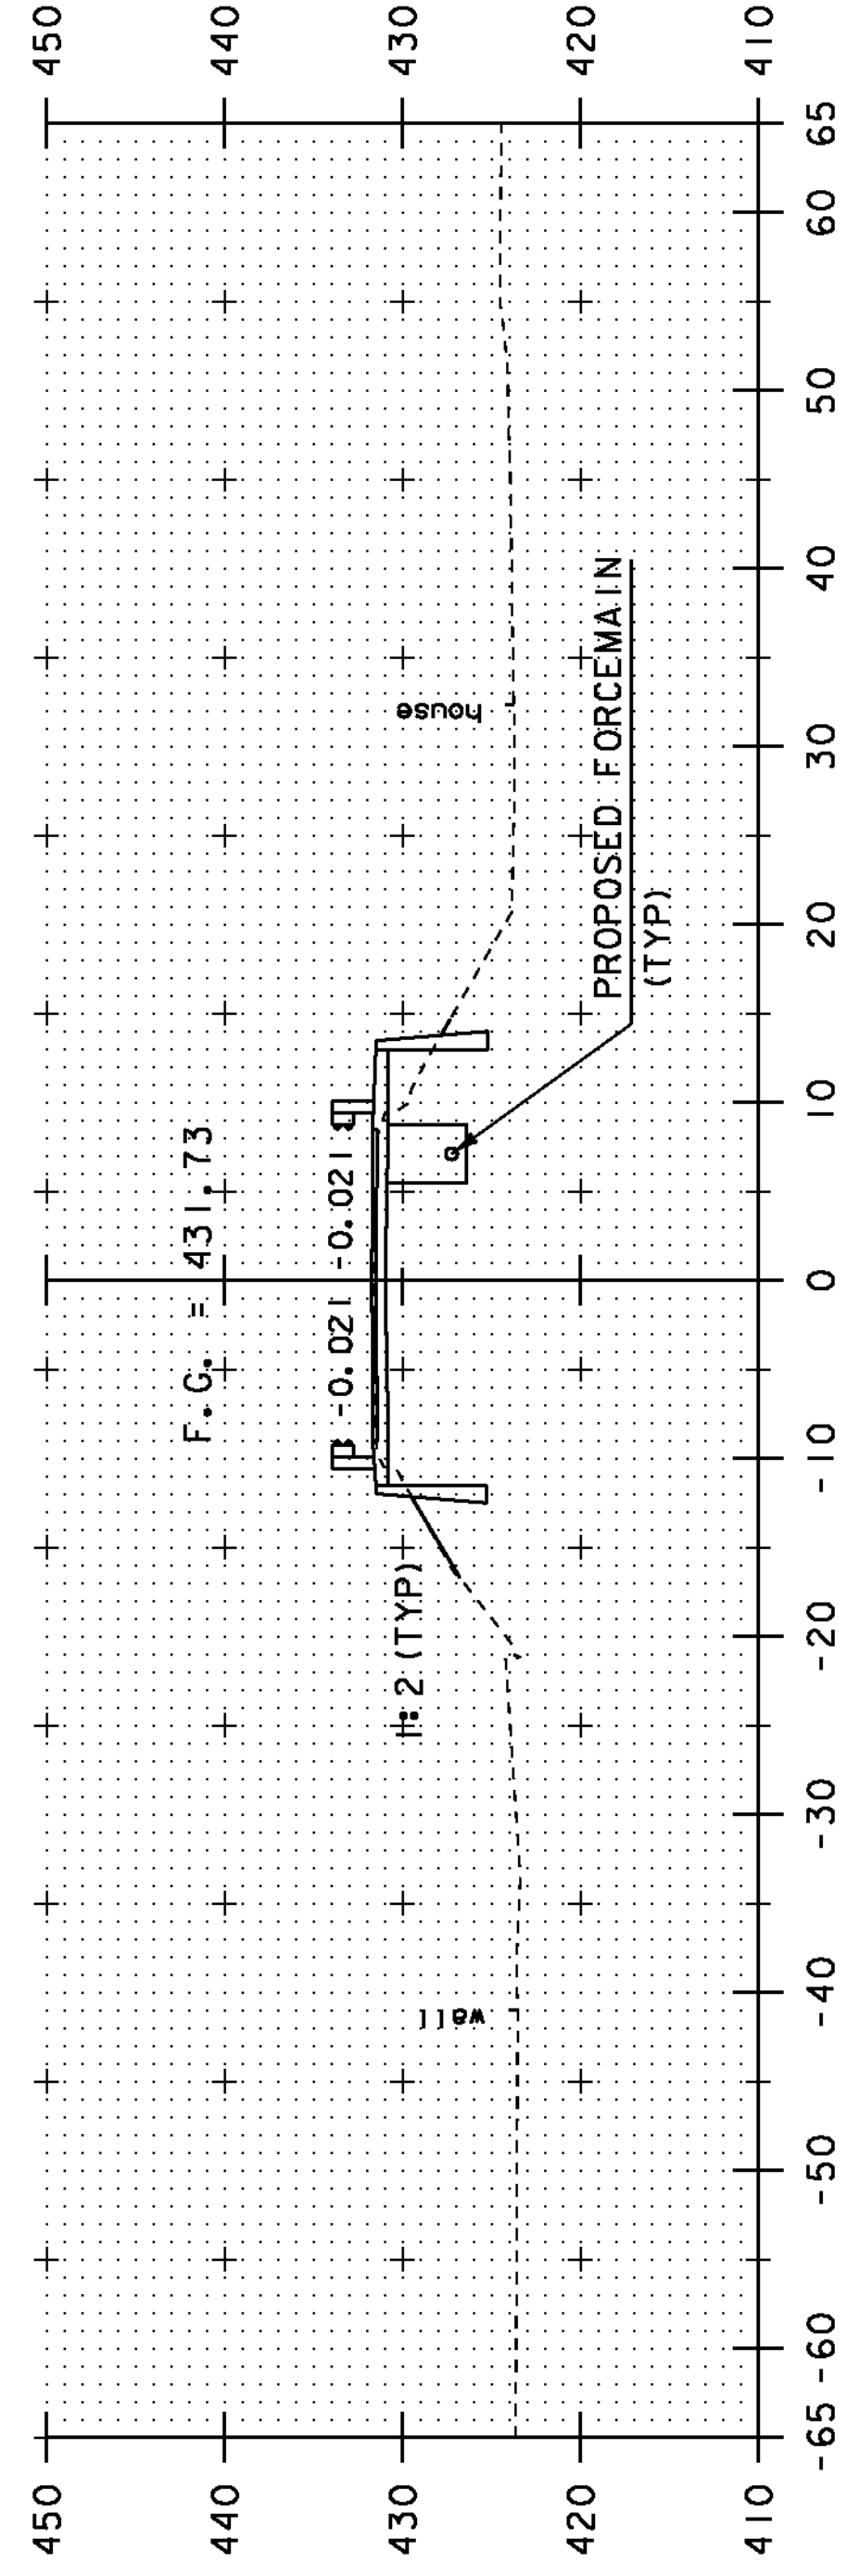

31+75.00

32+50.

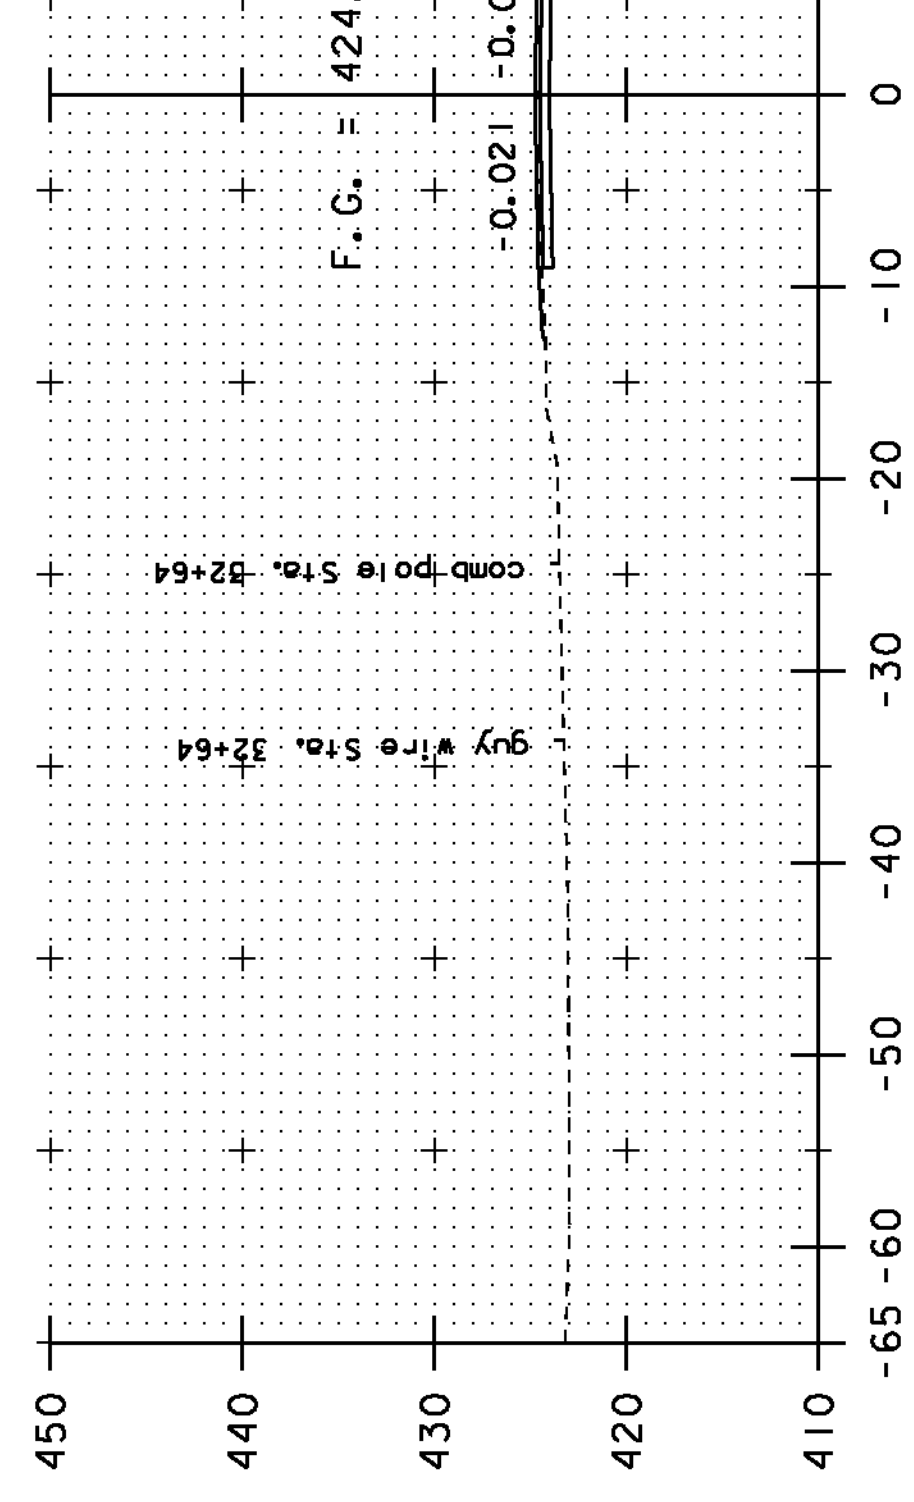

SCALE 1" = 10'-0"



STA. 31+75.00 TO STA. 32+75.00