




BRIDGE RAIL T2 (F) PAY LIMITS BRIDGE APPROACH RAIL T2 (F) ITEM 621.72 = 29'-1"

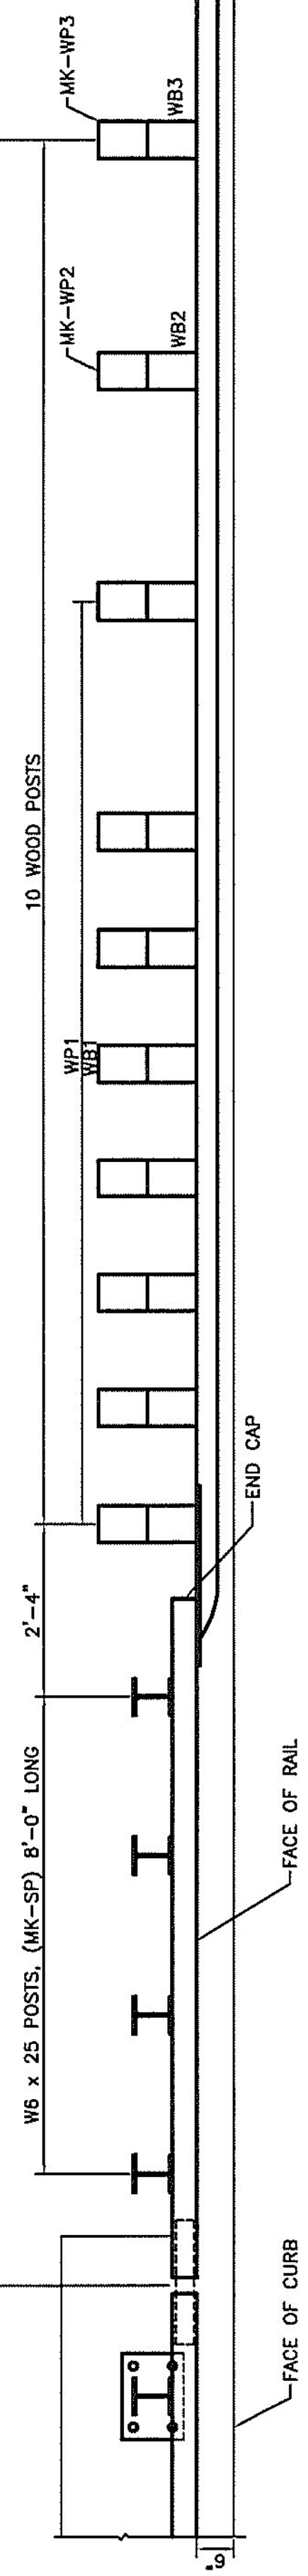


PLAN

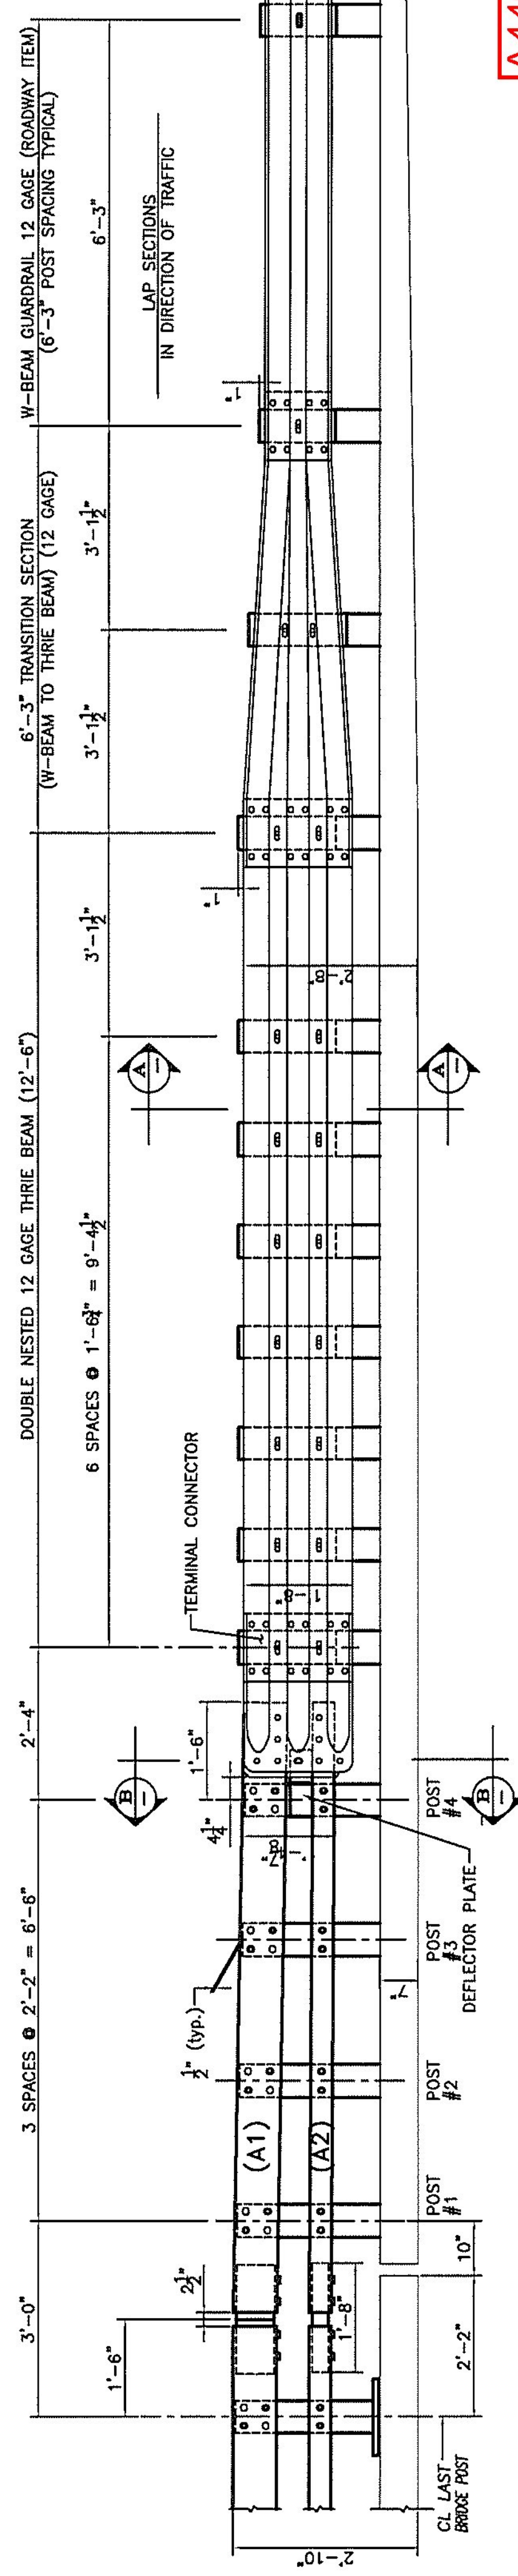


APPROACH RAIL ELEVATION  
(TOTAL LIMIT ITEM 621.72 = 58 LF)

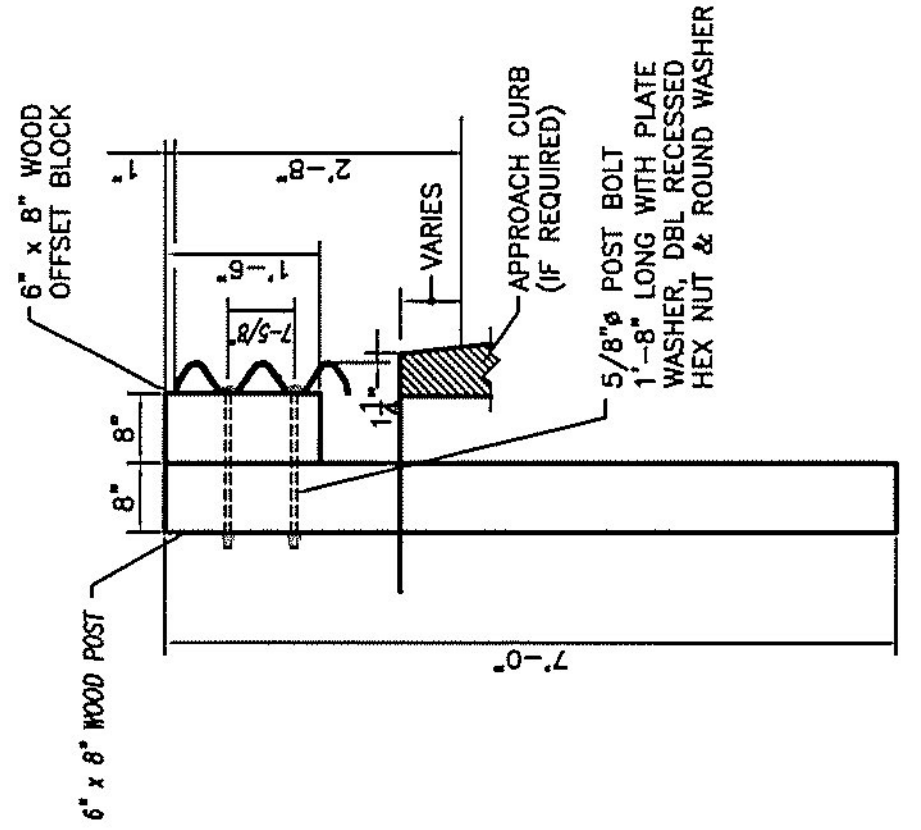


SECTION A-A

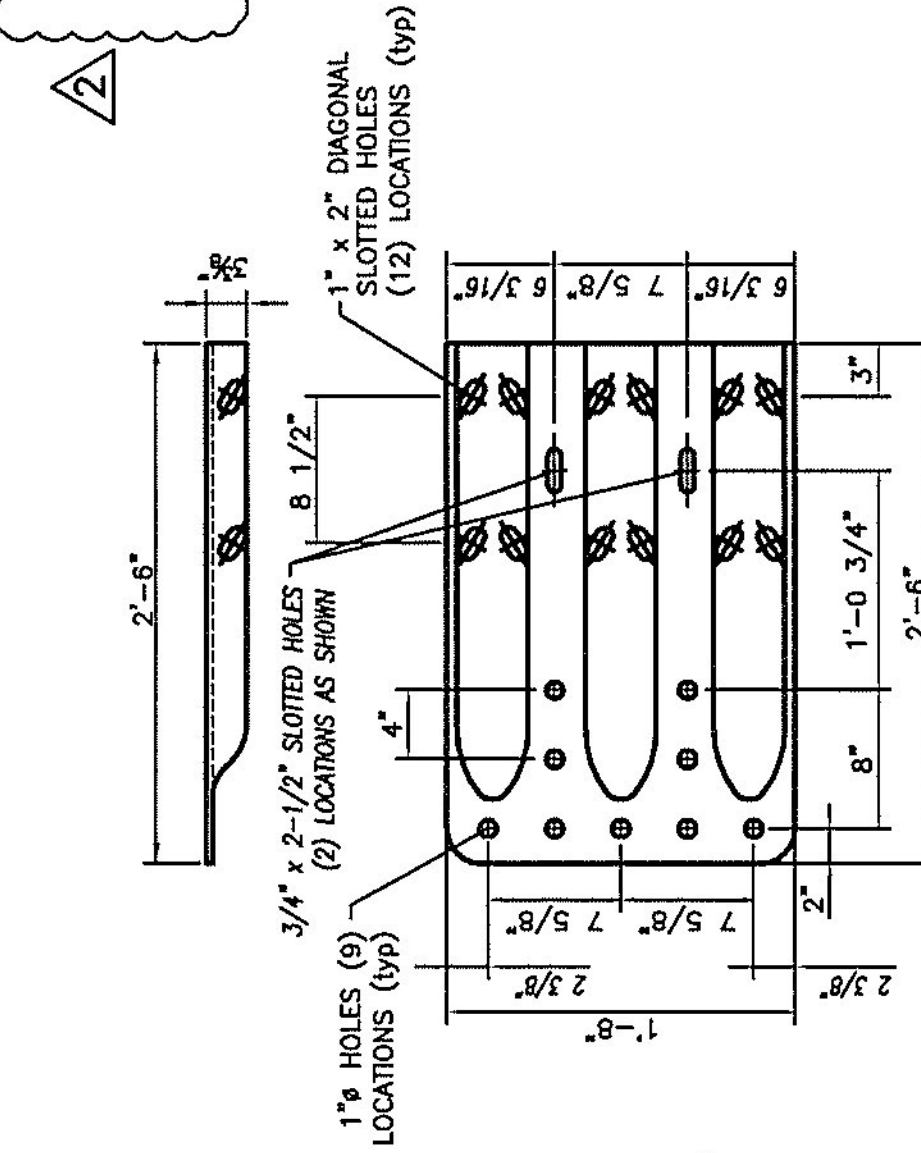


TERMINAL CONNECTOR  
10 GAUGE (ASHITO #180 B2)

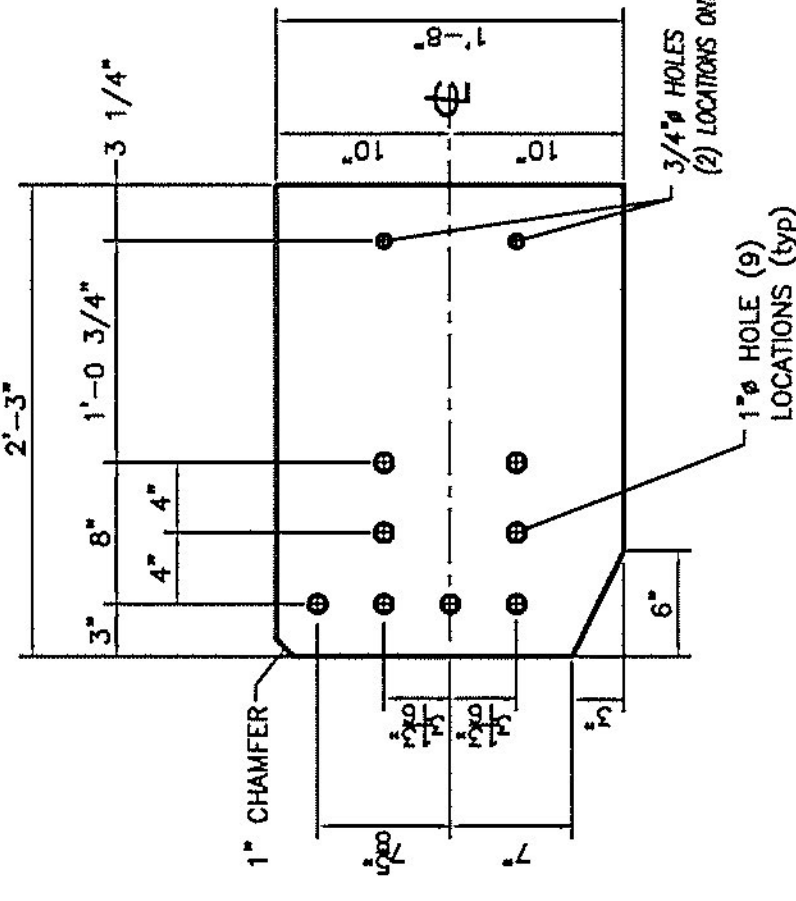


CONNECTION PLATE  
3/8" x 1'-8" x 2'-3" (A709 gr 36)

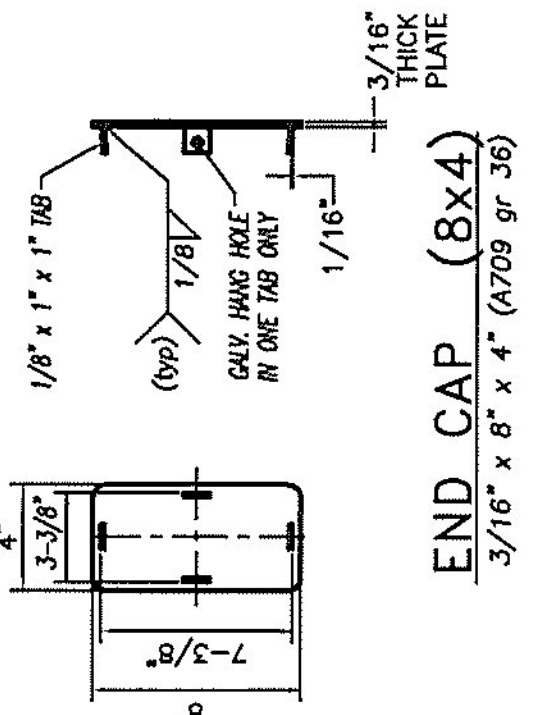


END CAP (8x4)  
3/16" x 8" x 4" (A709 gr 36)

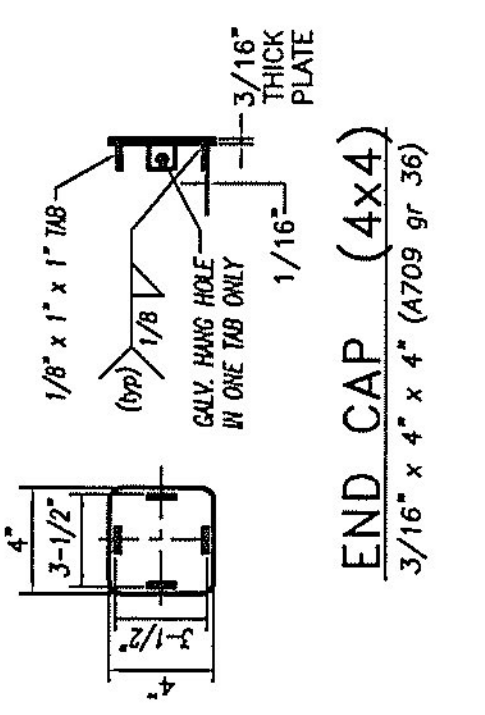


END CAP (4x4)  
3/16" x 4" x 4" (A709 gr 36)

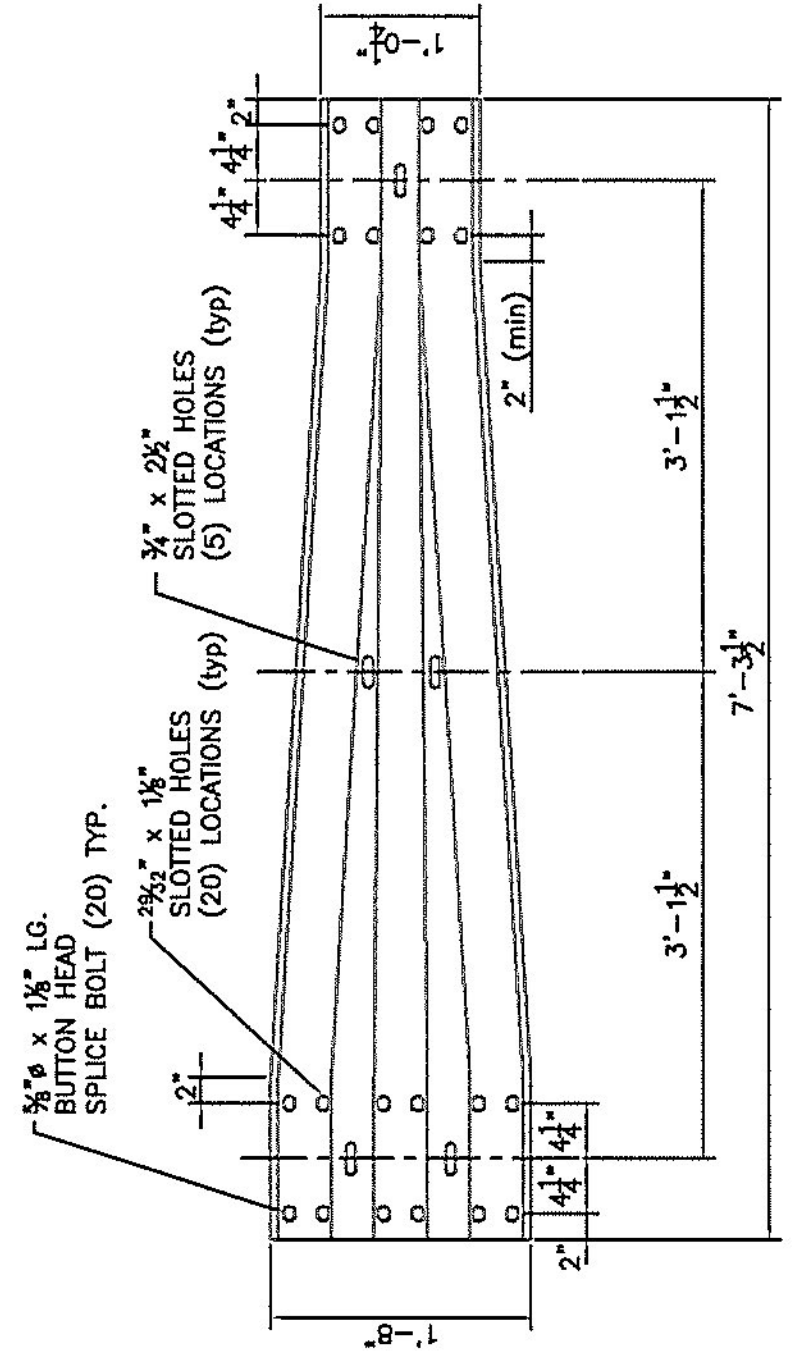

THRIE TRANSITION PANEL  
12 GAUGE (ASHITO #180 A2)

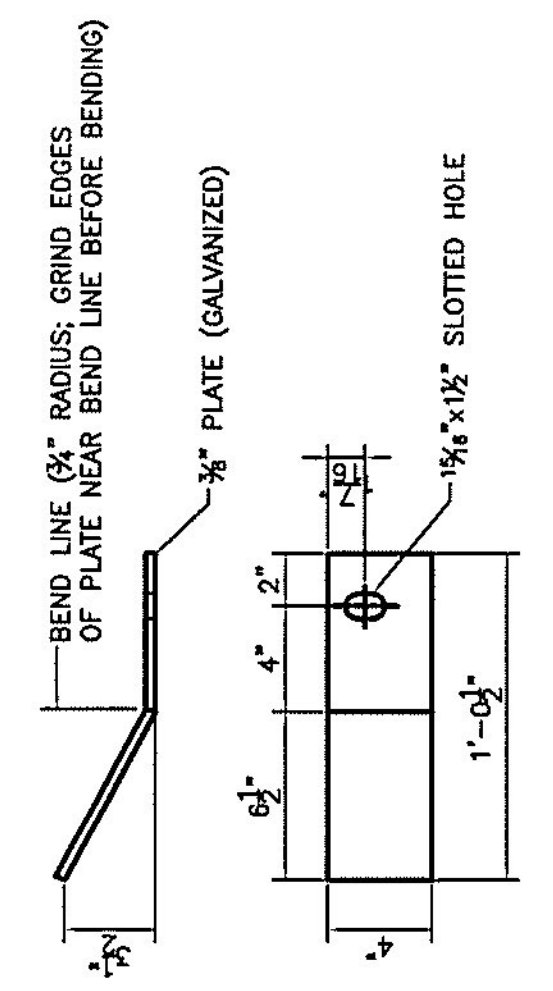

DEFLECTOR PLATE

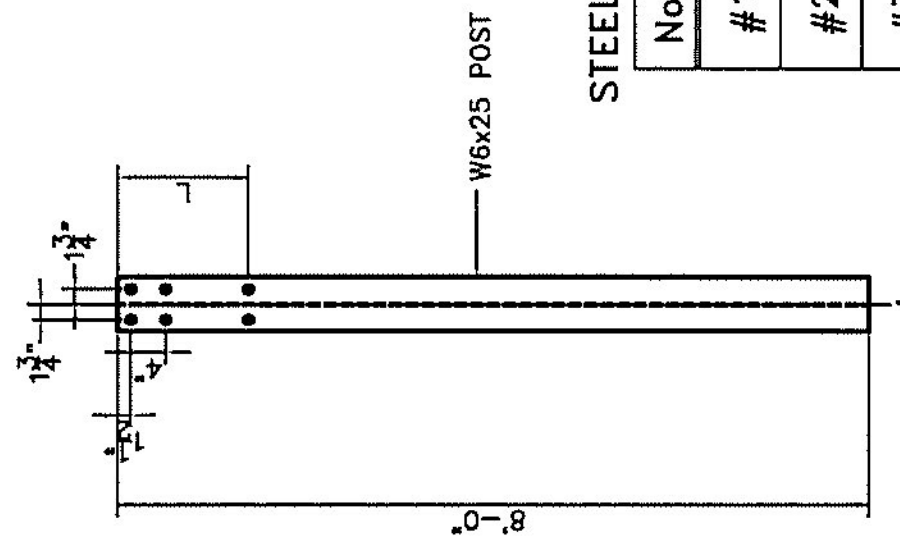

STEEL POST

STEEL POST CHART

No.	L
#1	1'-3.250"
#2	1'-3"
#3	1'-2.688"
#4	1'-2.375"

REVISIONS

No.	Initial	Submittal	Date
0		Ground profile	12-15-10
1		Ground profile	05-17-11
2		Per reviewer	06-10-11

SECTION B-B

A449 B  
in Deta

ANGLE  
SPLI

WOOD BLOCK DET.

Vermont Age  
REC'D BY GML  
9:00 a  
RESUBMIT  
BY TCF