


PLAN - C1 & C2
TOTAL WEIGHT = 25.8 TONS

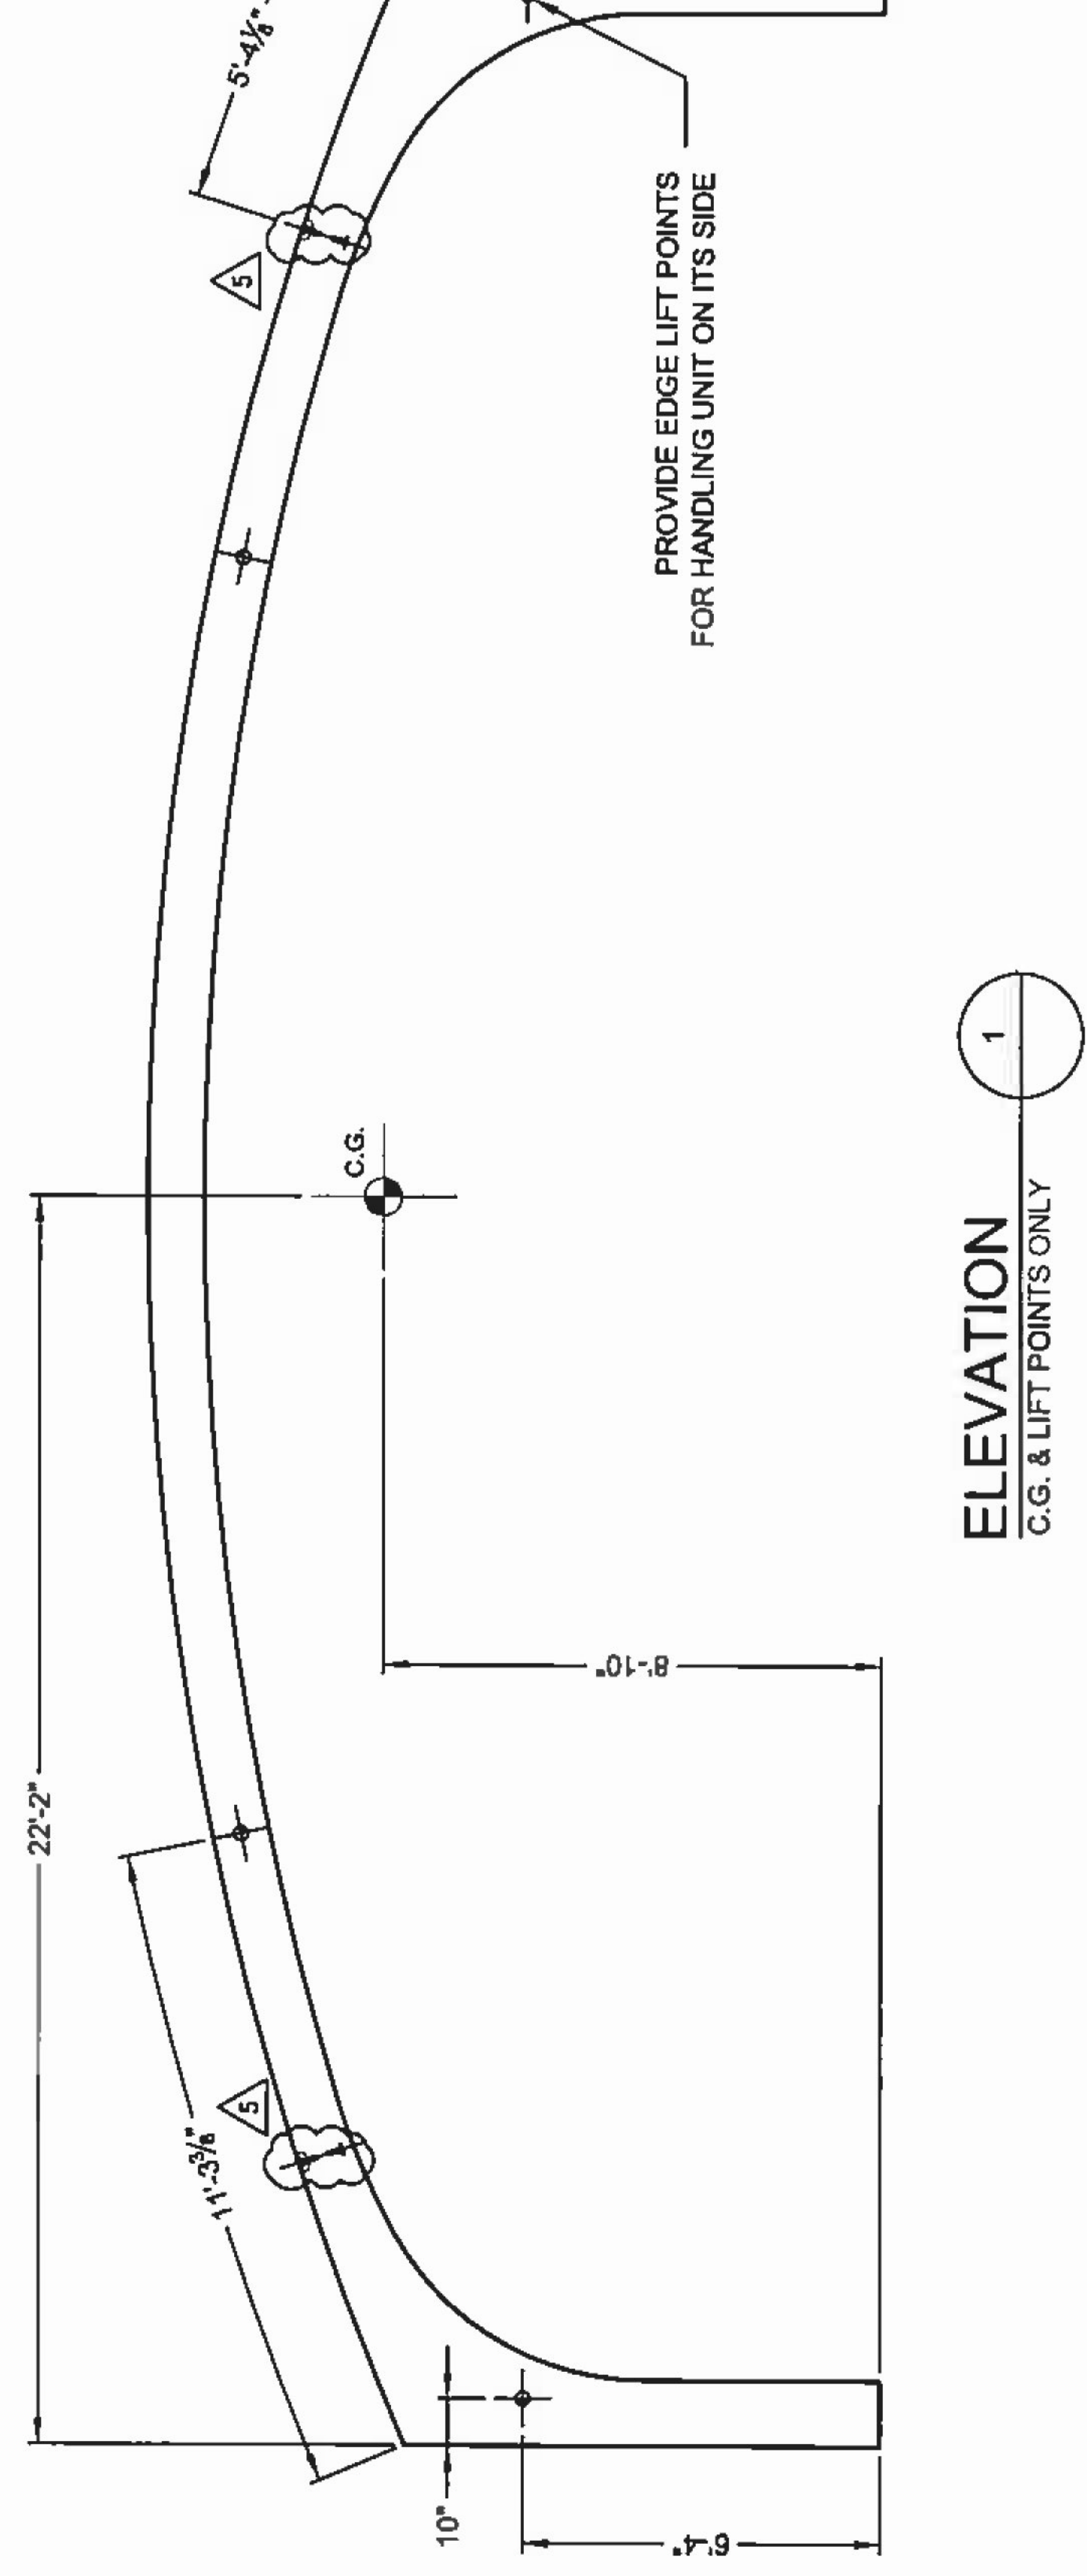

ELEVATION
C.G. & LIFT POINTS ONLY

The design and information shown on this drawing is provided as a service to the project owner, engineer and contractor by CONTECH. CONTECH, its employees, agents, representatives, contractors, subcontractors, suppliers, vendors, and other personnel, shall not be held liable for any errors, omissions, or inaccuracies in this drawing. CONTECH shall not be held liable for any damages, including consequential damages, arising from the use of this drawing. CONTECH shall not be held liable for any damages, including consequential damages, arising from the use of this drawing. CONTECH shall not be held liable for any damages, including consequential damages, arising from the use of this drawing.

MARK	DATE	REVISION DESCRIPTION	BY
5	4/27/2011	REVISIONS PER REVIEWERS COMMENTS	RKL
4	4/18/2011	NO CHANGES ON THIS SHEET	RKL
3	4/8/2011	NO CHANGES ON THIS SHEET	RKL
2	4/4/11	REVISIONS PER REVIEWERS COMMENTS	RKL
1	3/10/2011	REVISIONS PER REVIEWERS COMMENTS	RKL

CONTECH
CONSTRUCTION PRODUCTS INC.
www.contech-cpi.com
9025 Centre Pointe Dr., Suite 400, West Chester, OH 45069
800-338-1122 513-645-7000 513-645-7993 FAX

CONSPAN
BRIDGE SYSTEMS
CONTECH
FABRICATION
DRAWING

HARTFORD TH#
VERMONT AGENCY OF TRANSPORTATION
HARTFORD, VT