



☉ LIFT POINTS (TOP 2 LIFT POINTS MUST BE CAPABLE OF SUPPORTING ENTIRE WEIGHT OF WINGWALL)

WINGWALL - WW1A
TOTAL WEIGHT = 9.0 TONS

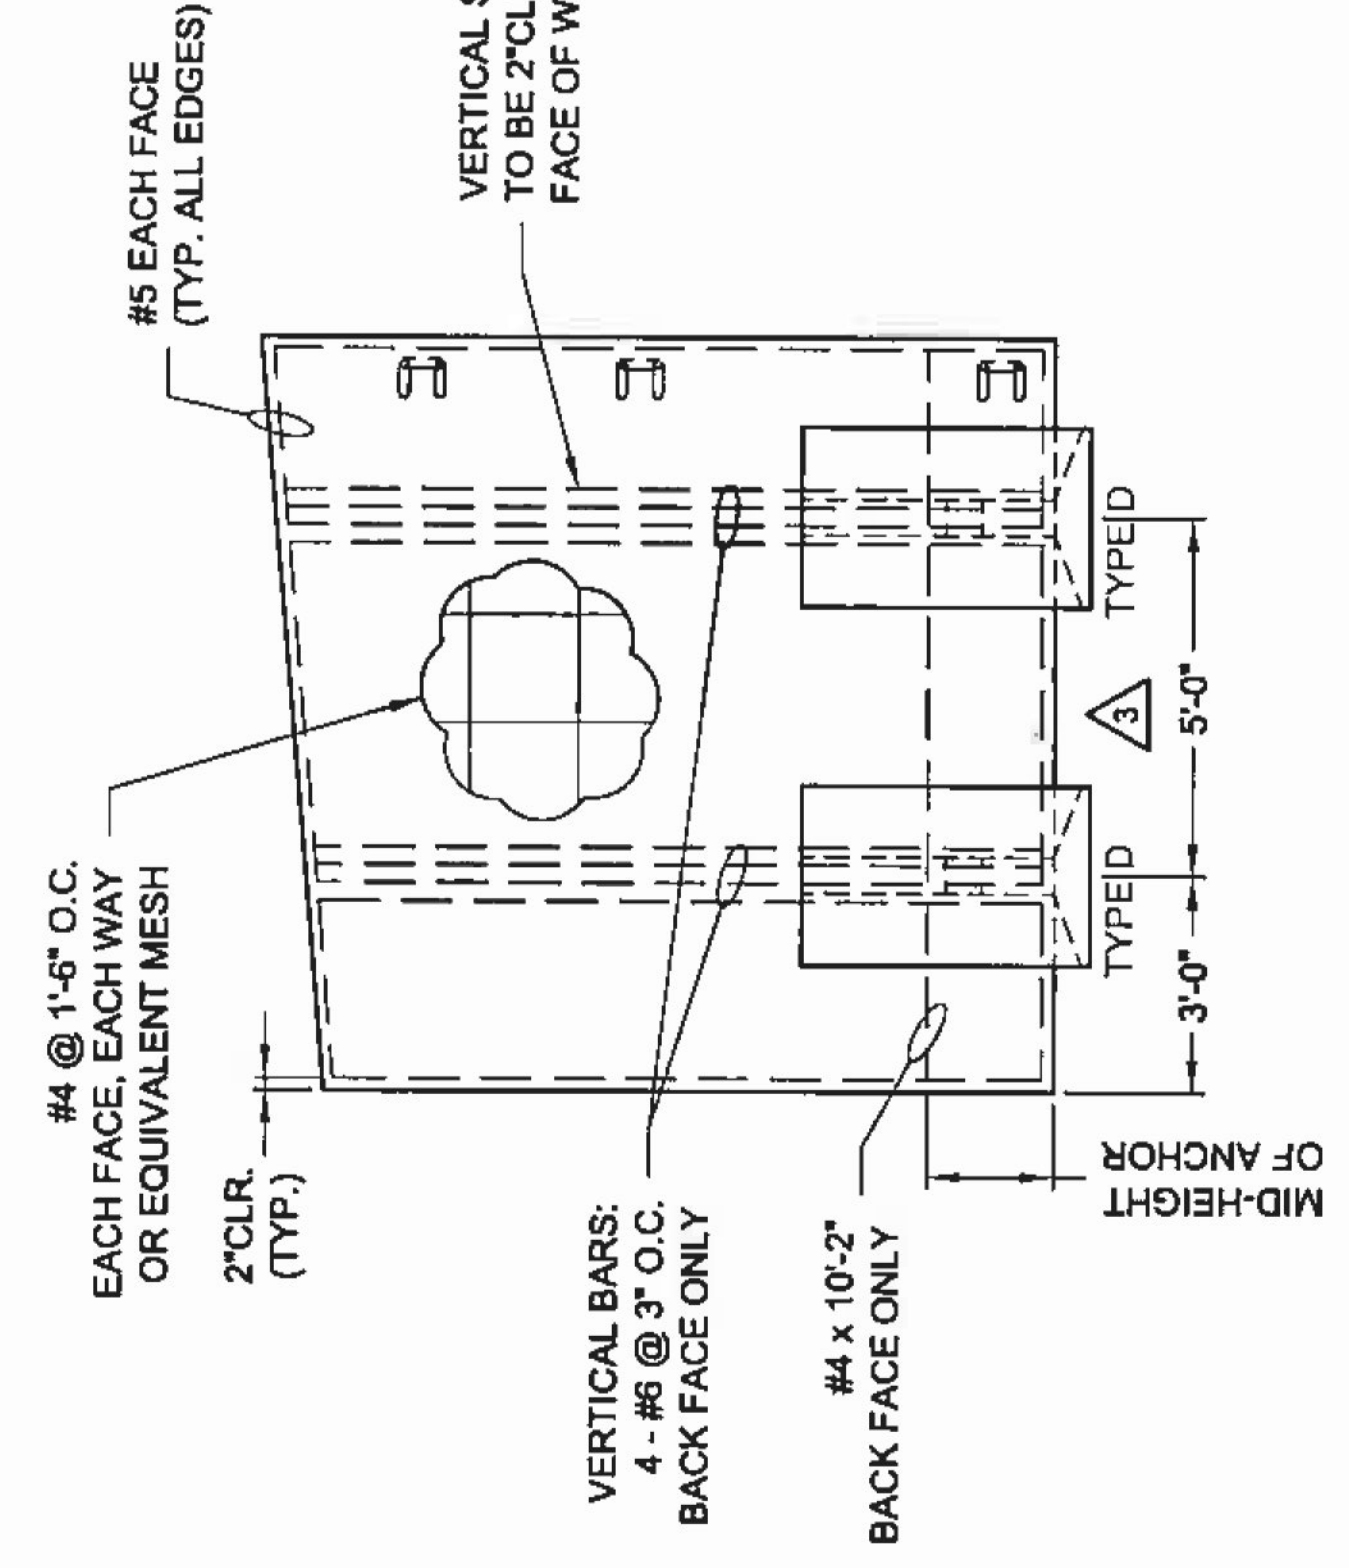

REINFORCING DETAIL - WW1A
(FOR ANCHOR REINFORCING SEE SHEET S25)

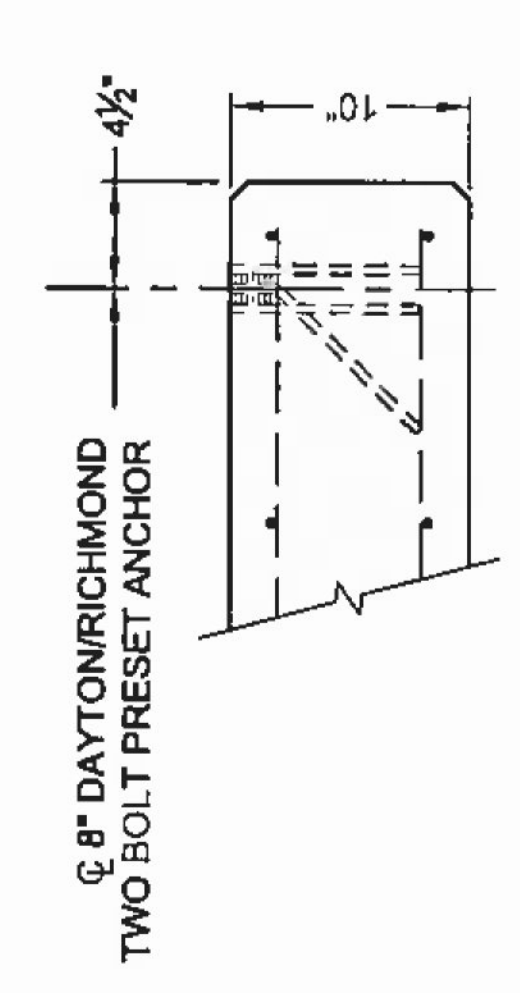

SECTION 13

The design and information shown on this drawing is provided as a service to the project owner, engineer and contractor by CONTECH CONSTRUCTION PRODUCTS INC. (CONTECH). The design and information shown on this drawing is not intended to be used, reproduced or modified in any manner without the prior written consent of CONTECH. CONTECH assumes no liability or responsibility for such use. If discrepancies between the supplied information and the drawing is found and actual field conditions are encountered in all work programs, these discrepancies must be reported immediately to the project engineer and the project manager. CONTECH assumes no liability for design based on drawings, interpretations or omissions information supplied by others.

MARK	DATE	REVISION DESCRIPTION	BY
5	4/27/2011	NO CHANGES ON THIS SHEET	RKL
4	4/18/2011	REVISIONS PER REVIEWERS COMMENTS	RKL
3	4/8/2011	REVISIONS PER REVIEWERS COMMENTS	RKL
2	4/4/11	NO CHANGES ON THIS SHEET	RKL
1	3/10/2011	REVISIONS PER REVIEWERS COMMENTS	RKL

CONTECH
CONSTRUCTION PRODUCTS INC.
www.contech-cpl.com
9025 Centre Pointe Dr., Suite 400, West Chester, OH 45069
800-338-1122 513-645-7000 513-645-7993 FAX

CONISPAN
BRIDGE SYSTEMS
CONTECH
FABRICATION
DRAWING

HARTFORD TH#
VERMONT AGENCY OF TRANSPORTATION
HARTFORD, VT