



Q LIFT POINTS (TOP 2 LIFT POINTS MUST BE CAPABLE OF SUPPORTING ENTIRE WEIGHT OF WINGWALL)

WINGWALL - WW1B

TOTAL WEIGHT = 9.5 TONS

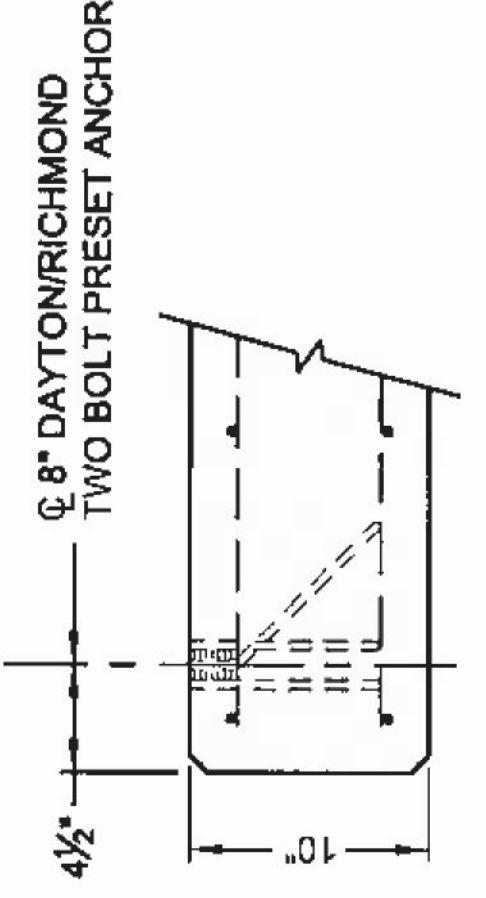


SECTION 14

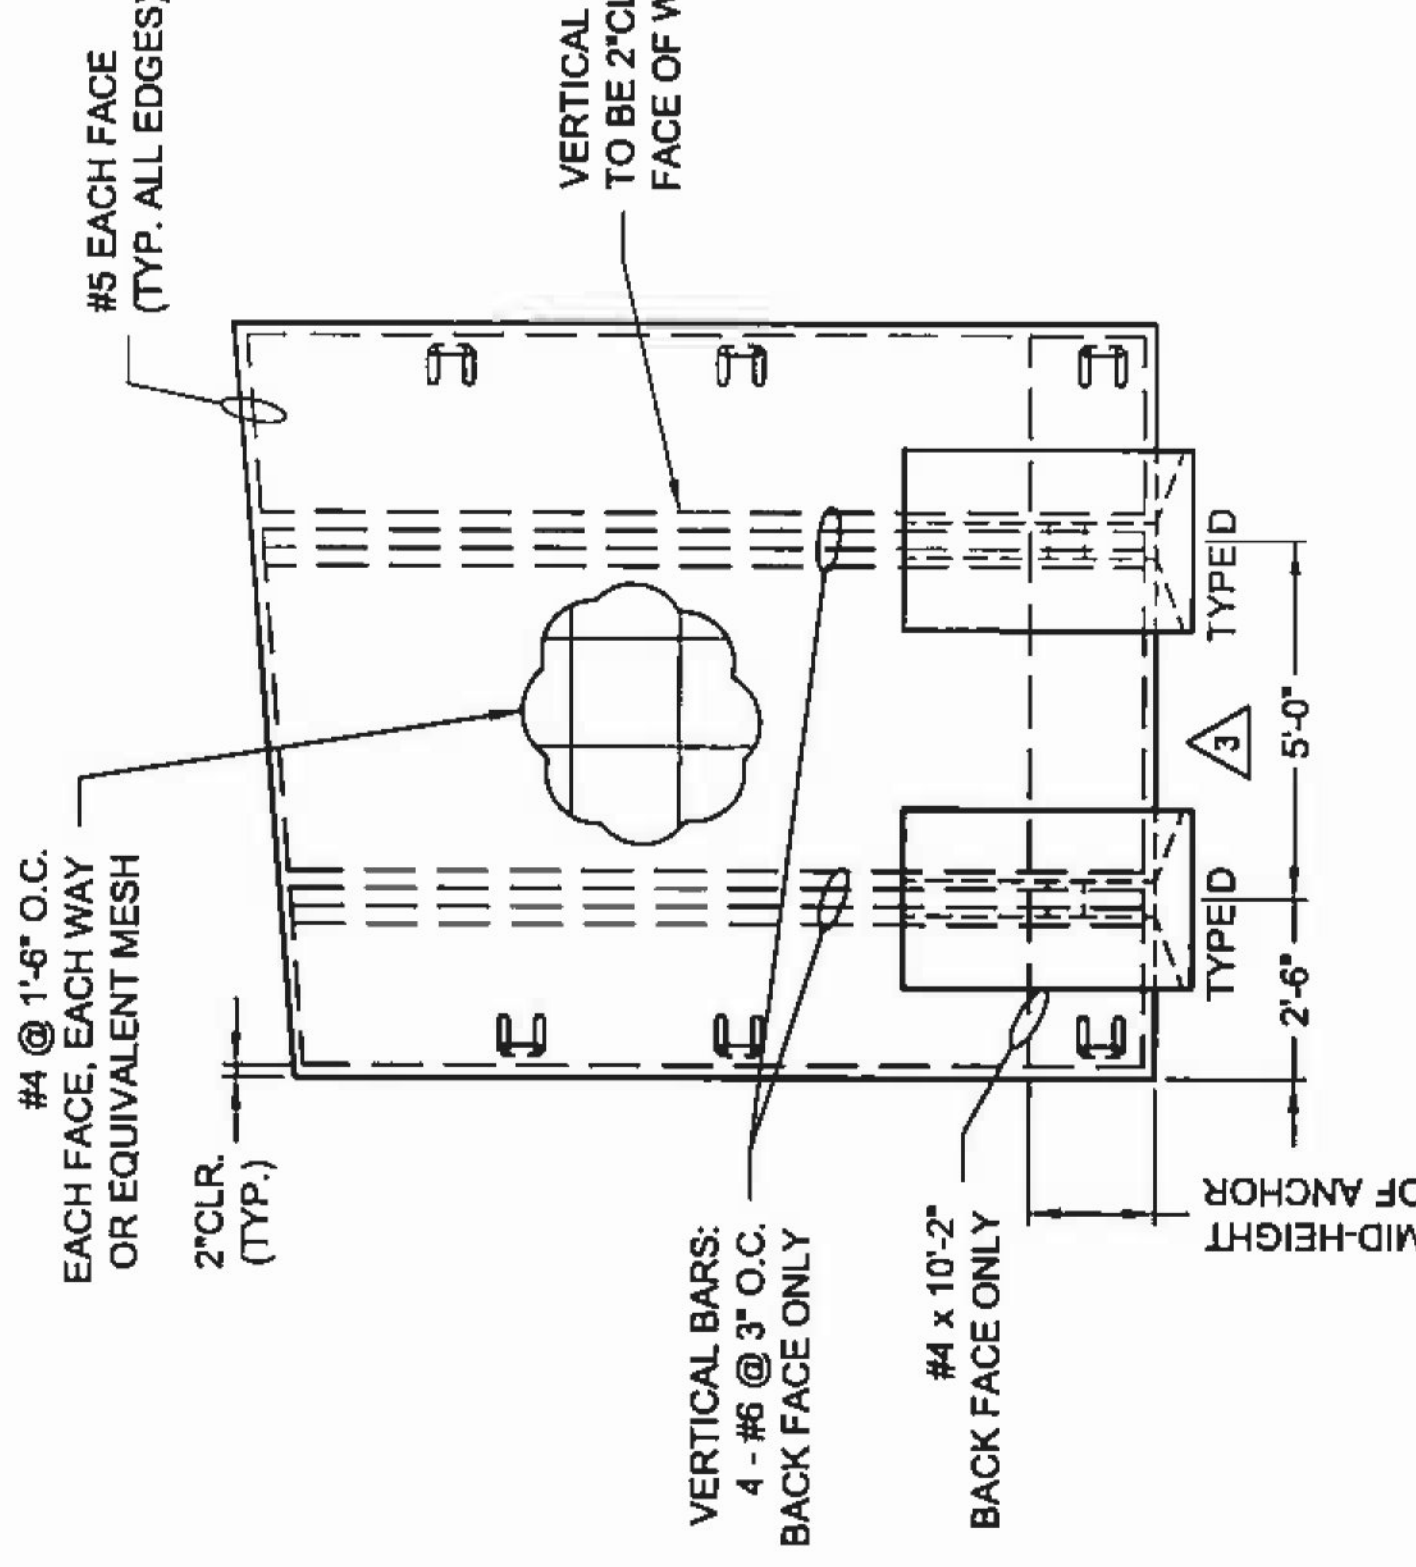

REINFORCING DETAIL - WW1B

(FOR ANCHOR REINFORCING SEE SHEET S25)

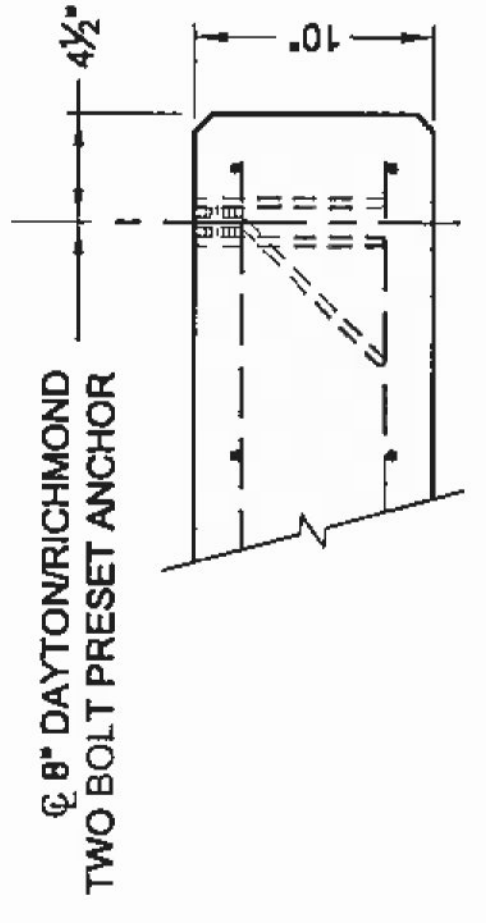

SECTION 15

The design and information shown on this drawing is provided as a service to the project owner, engineer and contractor by CONTECH CONSTRUCTION PRODUCTS INC. It is not intended to be used, reproduced or modified in any manner without the prior written consent of CONTECH CONSTRUCTION PRODUCTS INC. CONTECH CONSTRUCTION PRODUCTS INC. assumes no liability or responsibility for such use. If discrepancies between the specified information and the actual work program, these discrepancies must be reported immediately to the project engineer and the project manager. CONTECH CONSTRUCTION PRODUCTS INC. assumes no liability or responsibility for omissions or inaccuracies of information furnished by others.

MARK	DATE	REVISION DESCRIPTION	BY
5	4/27/2011	NO CHANGES ON THIS SHEET	RKL
4	4/18/2011	REVISIONS PER REVIEWERS COMMENTS	RKL
3	4/8/2011	REVISIONS PER REVIEWERS COMMENTS	RKL
2	4/4/11	NO CHANGES ON THIS SHEET	RKL
1	3/10/2011	REVISIONS PER REVIEWERS COMMENTS	RKL

CONTECH
CONSTRUCTION PRODUCTS INC.
www.contech-cpi.com
9025 Centre Pointe Dr., Suite 400, West Chester, OH 45069
800-338-1122 513-645-7000 513-645-7993 FAX

CONSPAN
BRIDGE SYSTEMS
CONTECH
FABRICATION
DRAWING

HARTFORD TH#
VERMONT AGENCY OF TRANSPORTATION
HARTFORD, VT