



### WINGWALL - WW3D


TOTAL WEIGHT = 11.4 TONS

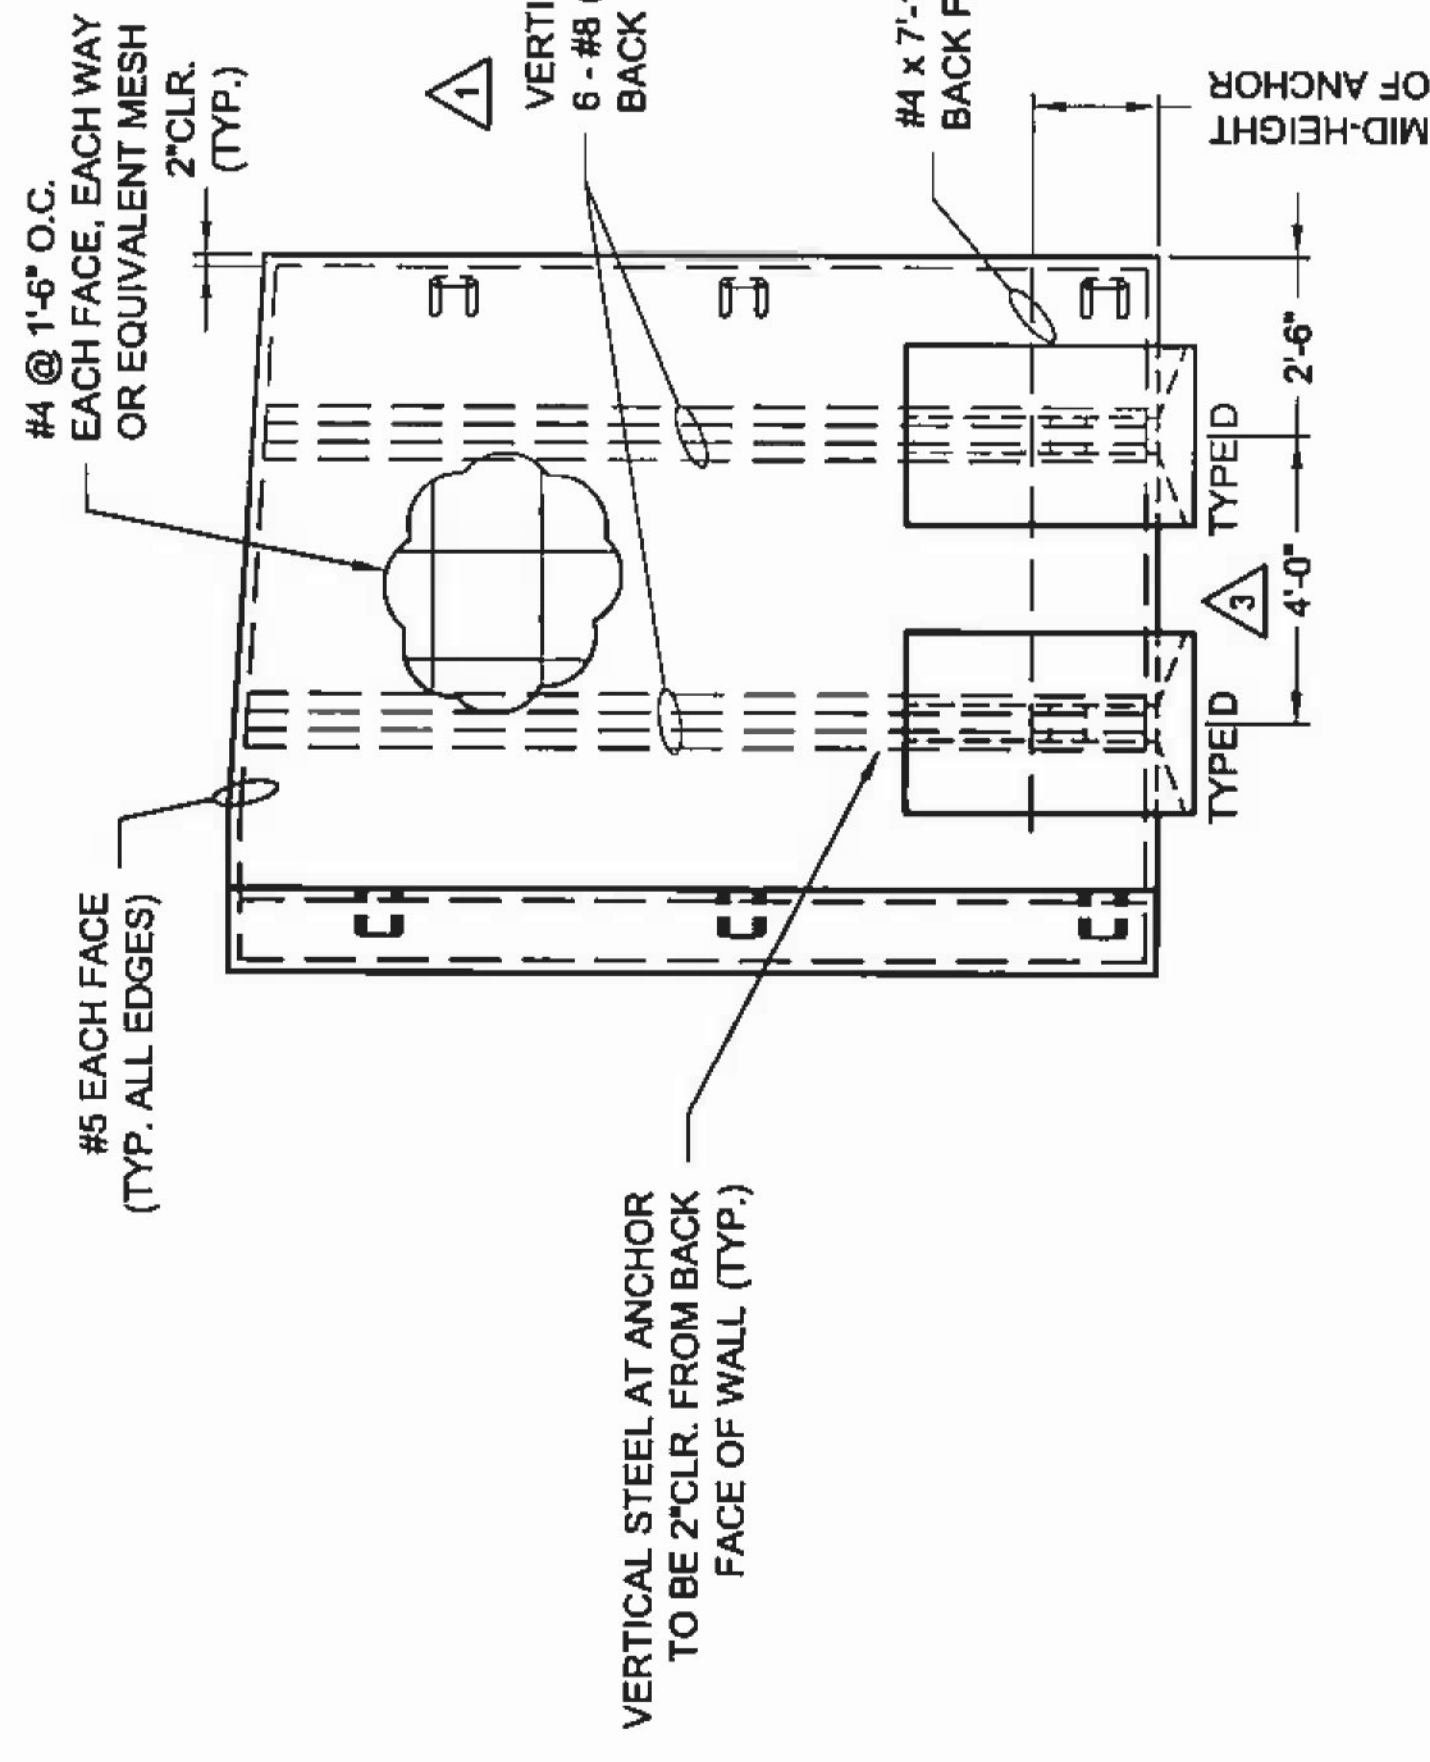

### REINFORCING DETAIL - WW3D (FOR ANCHOR REINFORCING SEE SHEET S25)

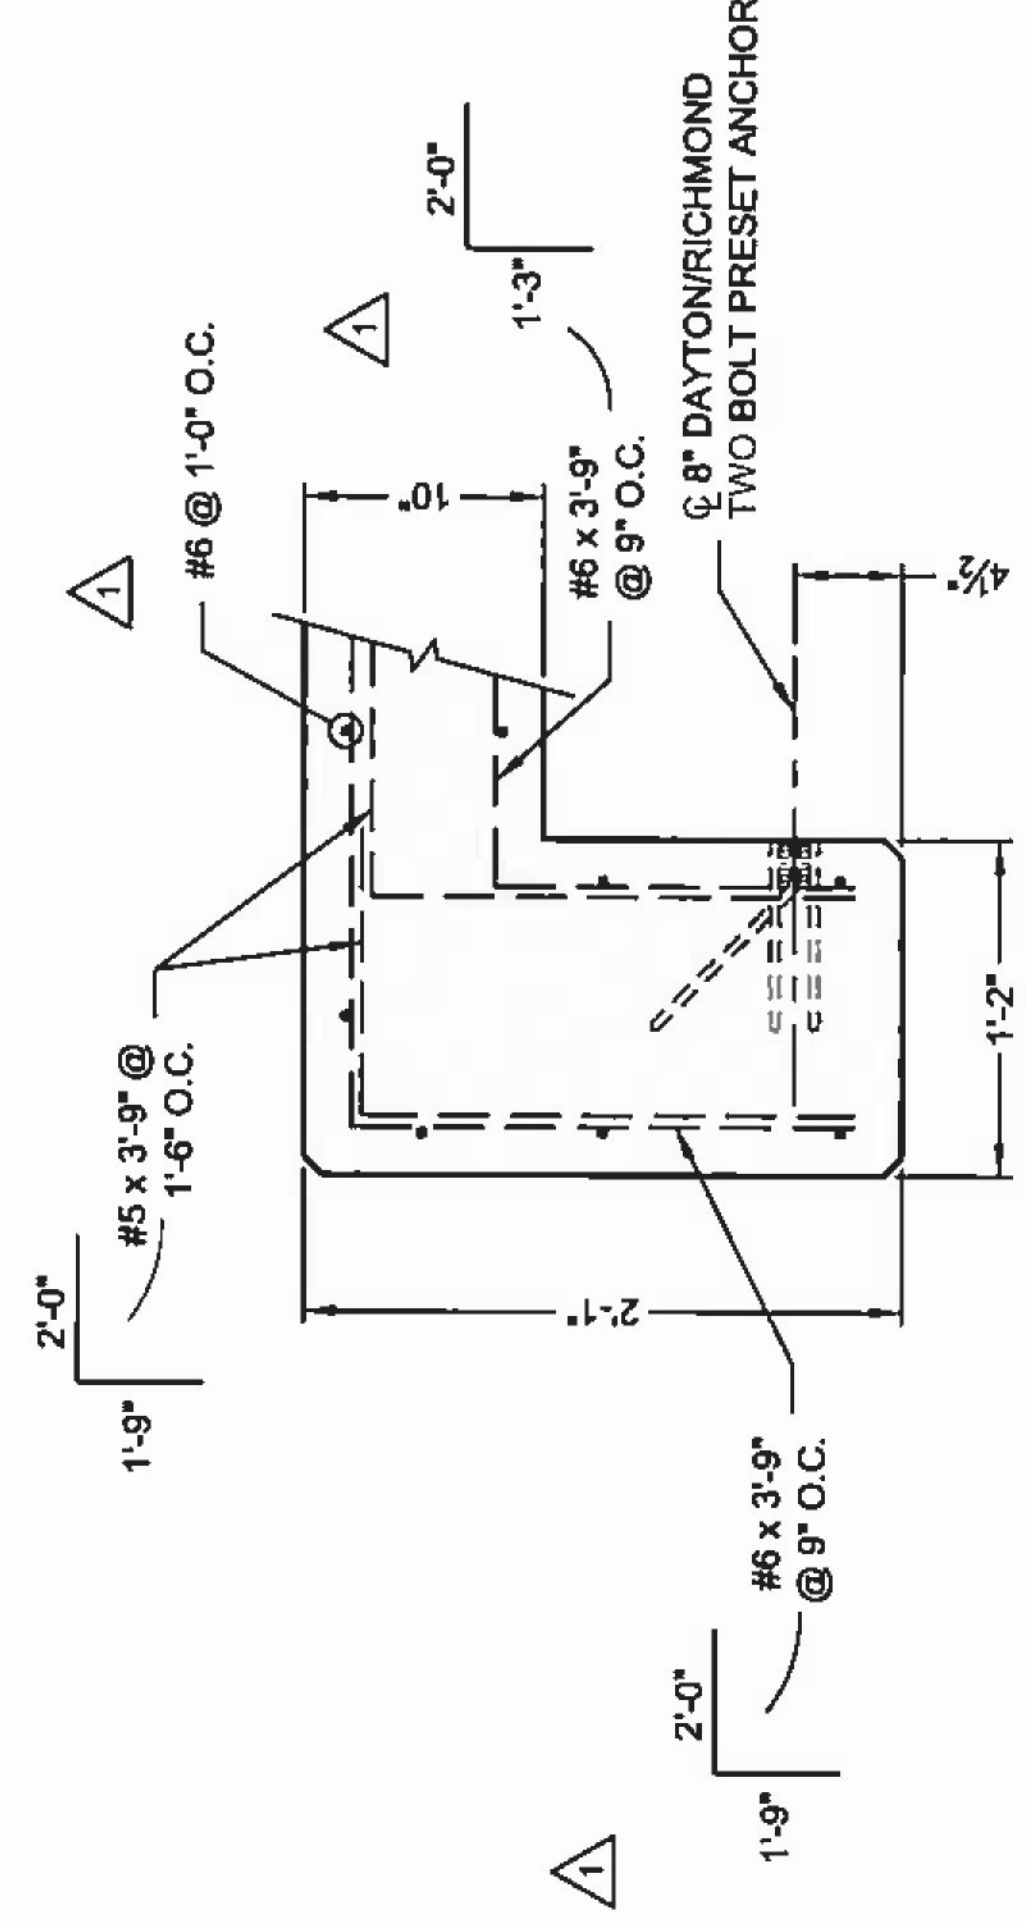

### SECTION

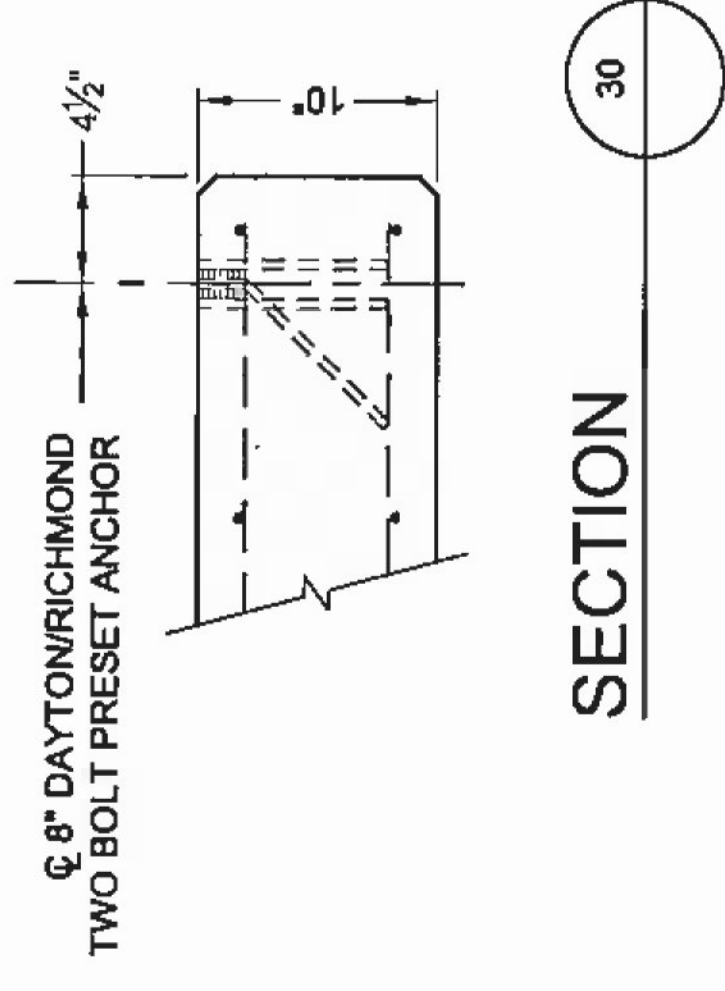

### SECTION

30

The design and information shown on this drawing is provided as a service to the project owner, engineer and contractor by CONTECH CONSTRUCTION PRODUCTS INC. or one of its affiliates. It is not to be used, reproduced or modified in any manner without the prior written consent of CONTECH. Failure to obtain such consent may constitute a violation of applicable laws and regulations and may result in liability for damages. CONTECH CONSTRUCTION PRODUCTS INC. shall not be held responsible for any errors, omissions or inaccuracies in this drawing or for any consequences arising therefrom. CONTECH CONSTRUCTION PRODUCTS INC. shall not be held responsible for any consequences arising from the use of this drawing for any purpose other than that intended by CONTECH CONSTRUCTION PRODUCTS INC. CONTECH CONSTRUCTION PRODUCTS INC. shall not be held responsible for any consequences arising from the use of this drawing for any purpose other than that intended by CONTECH CONSTRUCTION PRODUCTS INC.

MARK	DATE	REVISION DESCRIPTION	BY
5	4/27/2011	NO CHANGES ON THIS SHEET	RKL
4	4/18/2011	REVISIONS PER REVIEWERS COMMENTS	RKL
3	4/8/2011	REVISIONS PER REVIEWERS COMMENTS	RKL
2	4/4/11	NO CHANGES ON THIS SHEET	RKL
1	3/10/2011	REVISIONS PER REVIEWERS COMMENTS	RKL

**CONTECH**  
CONSTRUCTION PRODUCTS INC.  
www.contech-cpi.com

9025 Centre Pointe Dr., Suite 400, West Chester, OH 45069  
800-338-1122 513-645-7000 513-645-7993 FAX

**CONSPAN**  
BRIDGE SYSTEMS

CONTECH  
FABRICATION  
DRAWING

HARTFORD TH#  
VERMONT AGENCY OF TRAN  
HARTFORD,