



WINGWALL - WW4A

TOTAL WEIGHT = 9.0 TONS

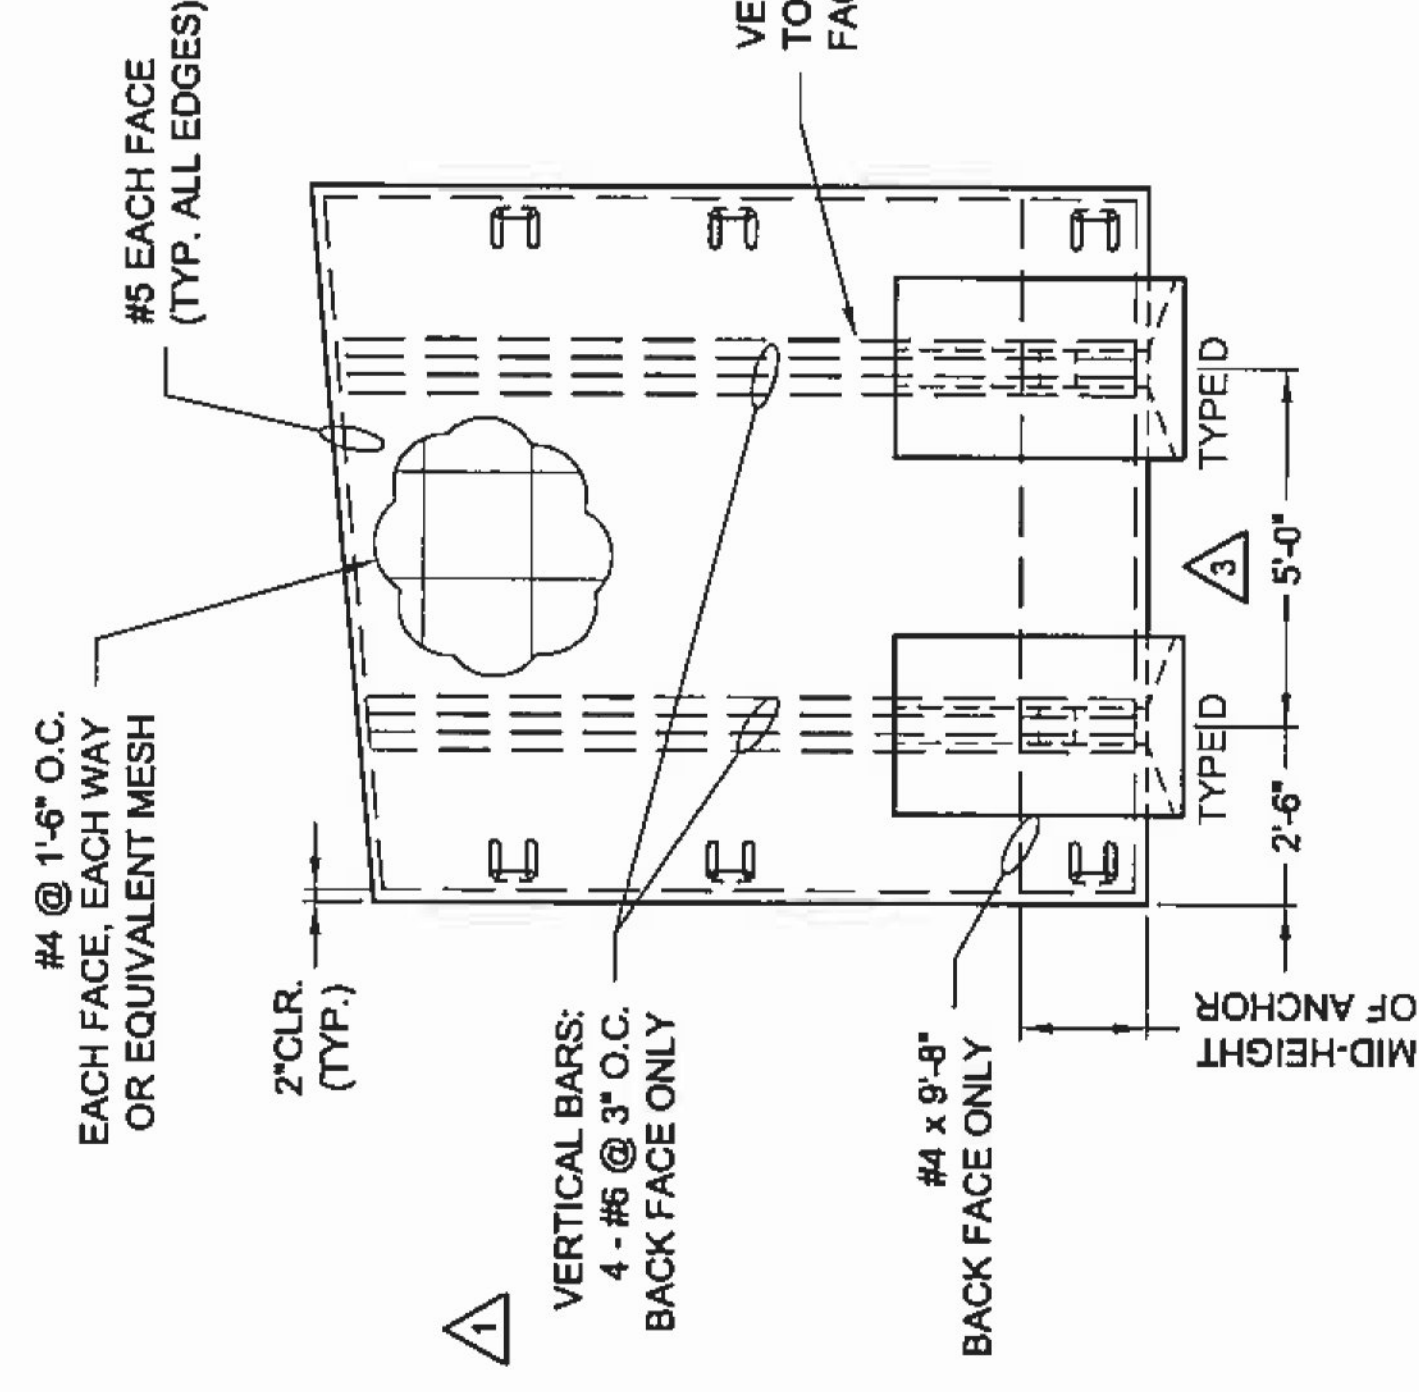

REINFORCING DETAIL - WW4A

(FOR ANCHOR REINFORCING SEE SHEET S22)

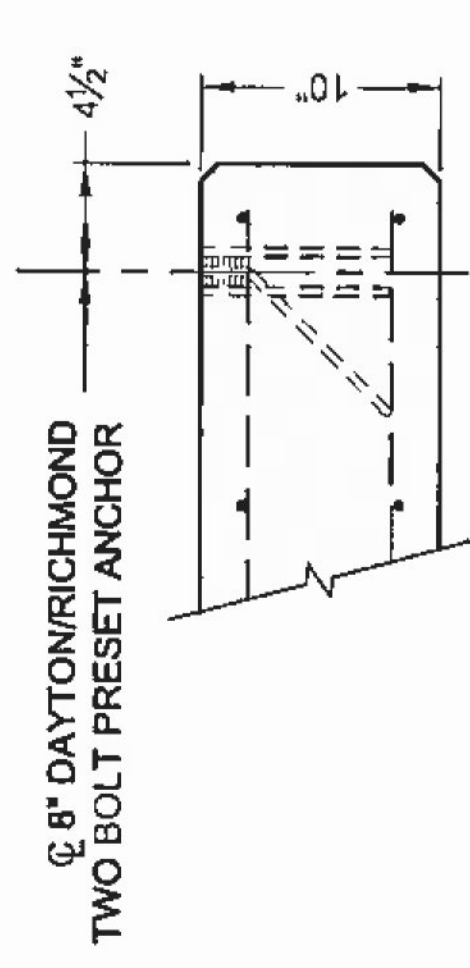

SECTION

31

The design and information shown on this drawing is provided as a service to the project owner, engineer and contractor by CONTECH CONSTRUCTION PRODUCTS INC. (CONTECH). CONTECH warrants that the design and information shown on this drawing were prepared by CONTECH and that the design and information were prepared without the aid of any other source. CONTECH shall not be held responsible for any errors or omissions in this drawing or for any consequences that may result from the use of this drawing. CONTECH shall not be held responsible for any consequences that may result from the use of this drawing. CONTECH shall not be held responsible for any consequences that may result from the use of this drawing.

MARK	DATE	REVISION DESCRIPTION	BY
5	4/27/2011	NO CHANGES ON THIS SHEET	RKL
4	4/18/2011	REVISIONS PER REVIEWERS COMMENTS	RKL
3	4/8/2011	REVISIONS PER REVIEWERS COMMENTS	RKL
2	4/4/11	NO CHANGES ON THIS SHEET	RKL
1	3/10/2011	REVISIONS PER REVIEWERS COMMENTS	RKL

CONTECH
CONSTRUCTION PRODUCTS INC.
www.contech-cpl.com
9025 Centre Pointe Dr., Suite 400, West Chester, OH 45069
800-338-1122 513-645-7000 513-645-7993 FAX

CONISPAN
BRIDGE SYSTEMS
CONTECH
FABRICATION
DRAWING

HARTFORD TH#
VERMONT AGENCY OF TRANSPORTATION
HARTFORD, VT