




WINGWALL - WW4B
TOTAL WEIGHT = 9.5 TONS

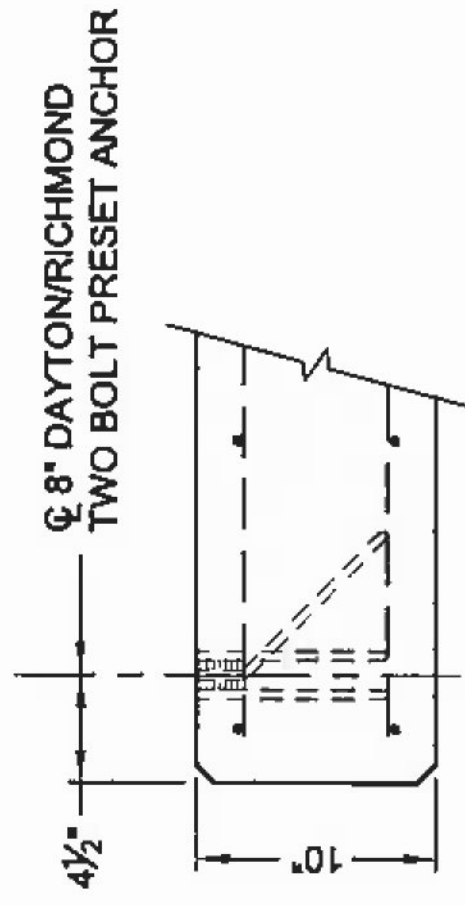

SECTION 32

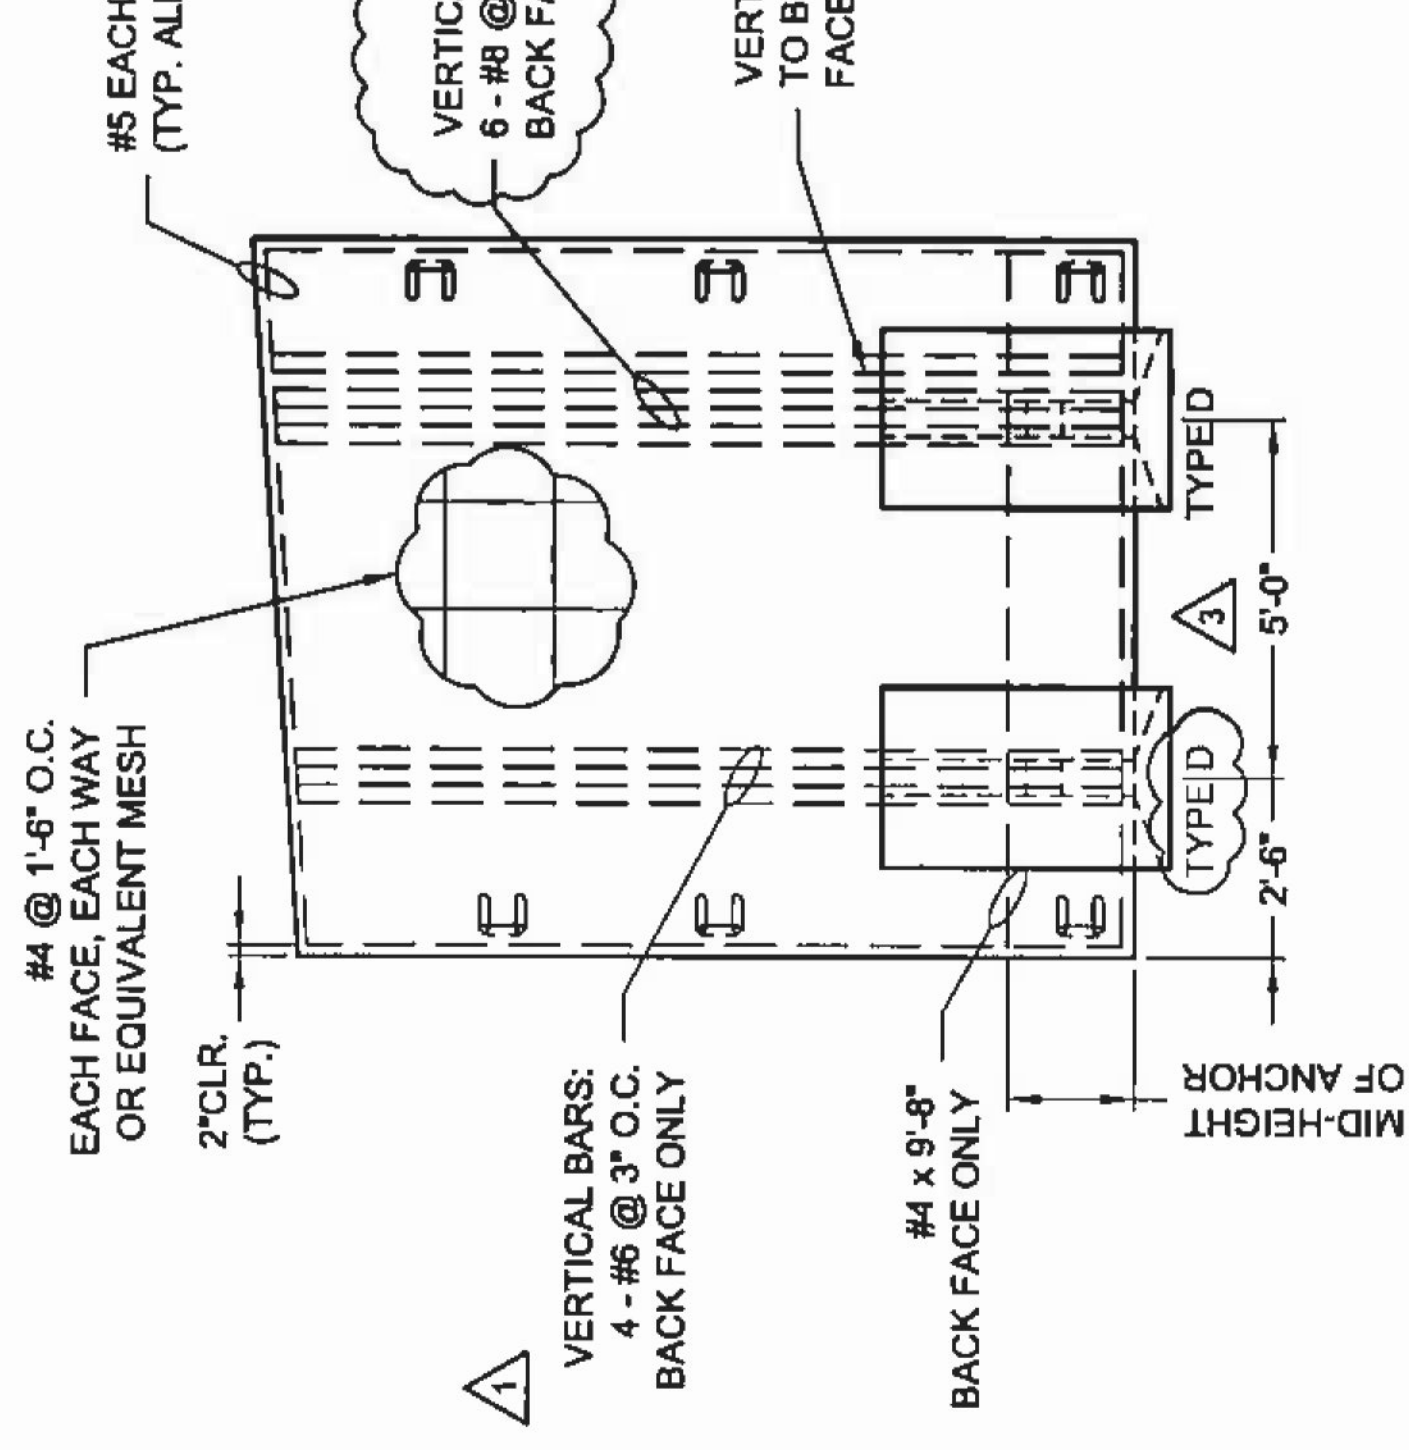

REINFORCING DETAIL - WW4B
(FOR ANCHOR REINFORCING SEE SHEET 33)

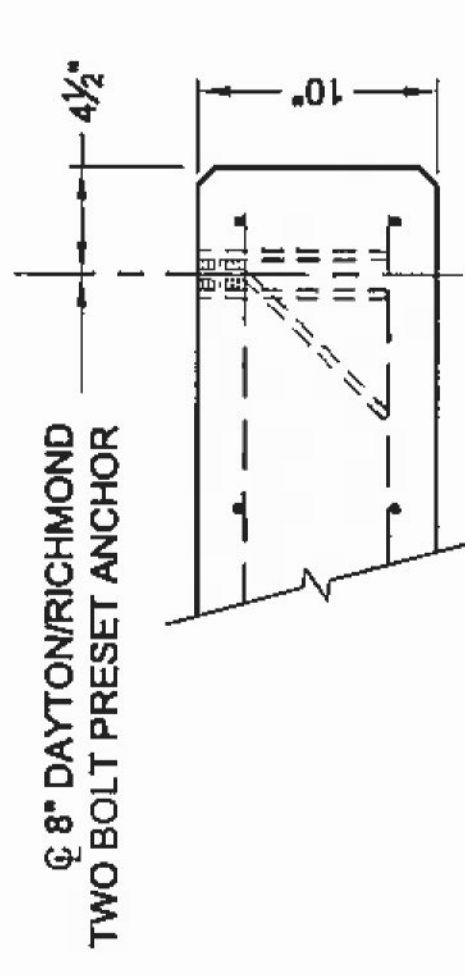

SECTION 33

The design and information shown on this drawing is provided as a service to the project owner, engineer and contractor by CONTECH CONSTRUCTION PRODUCTS INC. It is not intended to be used for any other project without the prior written consent of CONTECH CONSTRUCTION PRODUCTS INC. CONTECH CONSTRUCTION PRODUCTS INC. shall not be held responsible for any liability or responsibility for such use.

MARK	DATE	REVISION DESCRIPTION	BY
5	4/27/2011	NO CHANGES ON THIS SHEET	RKL
4	4/18/2011	REVISIONS PER REVIEWERS COMMENTS	RKL
3	4/18/2011	REVISIONS PER REVIEWERS COMMENTS	RKL
2	4/14/11	NO CHANGES ON THIS SHEET	RKL
1	3/10/2011	REVISIONS PER REVIEWERS COMMENTS	RKL

CONTECH
CONSTRUCTION PRODUCTS INC.
www.contech-cpi.com
9025 Centre Pointe Dr., Suite 400, West Chester, OH 45069
800-338-1122 513-645-7000 513-645-7993 FAX

CONISPAN
BRIDGE SYSTEMS
CONTECH
FABRICATION
DRAWING

HARTFORD TH#
VERMONT AGENCY OF TRANSPORTATION
HARTFORD, VT