

WINGWALL - WW4D


TOTAL WEIGHT = 13.1 TONS

Vermont Agency of Transportation
RECEIVED


CK'D BY **GML** OK'D BY **TCF**

7:13 am, May 03, 2011


RESUBMIT **APPROVED** X
 BY **KMH** DATE **5-3-11**

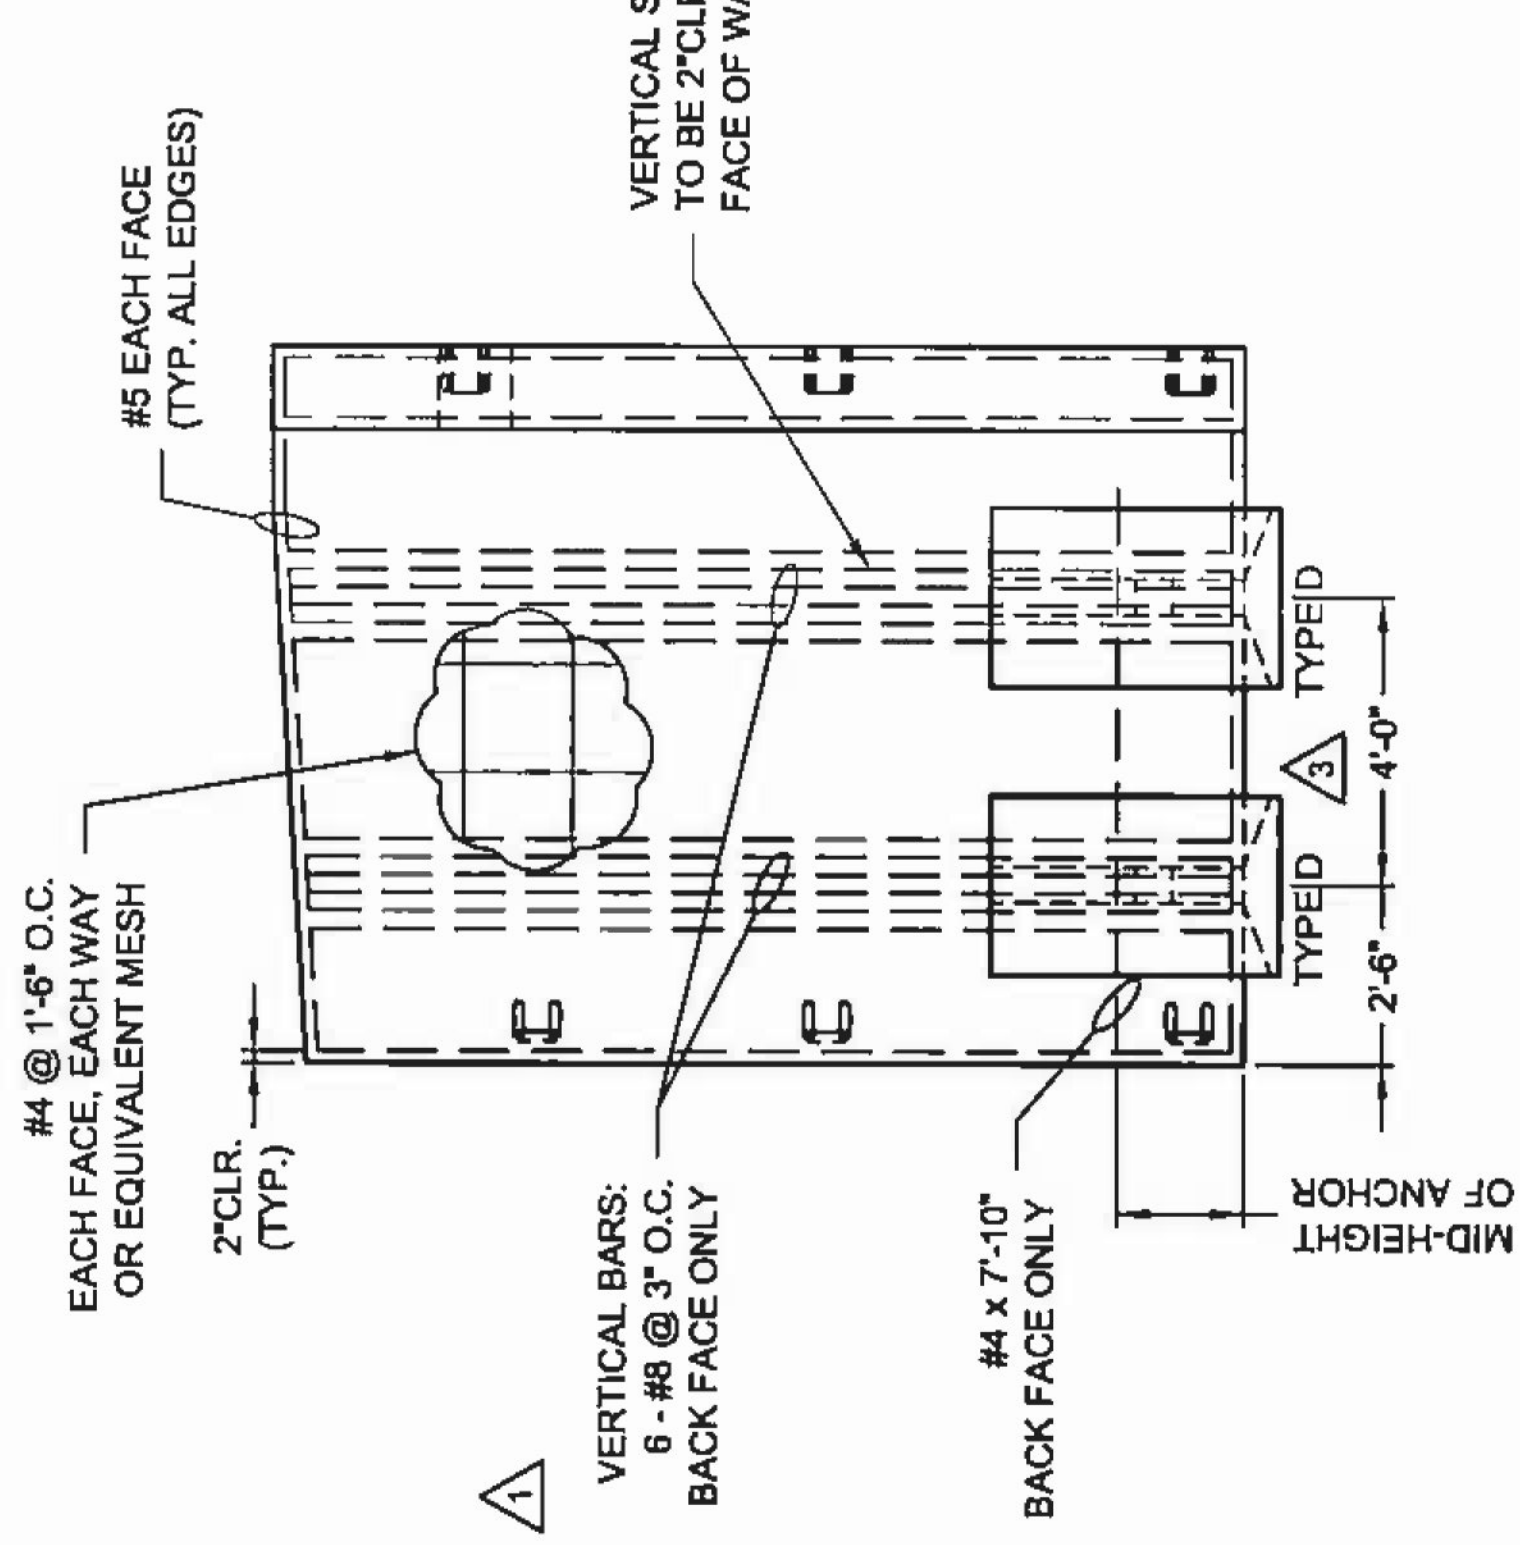

REINFORCING DETAIL - WW4D
 (FOR ANCHOR REINFORCING SEE SHEET S25)

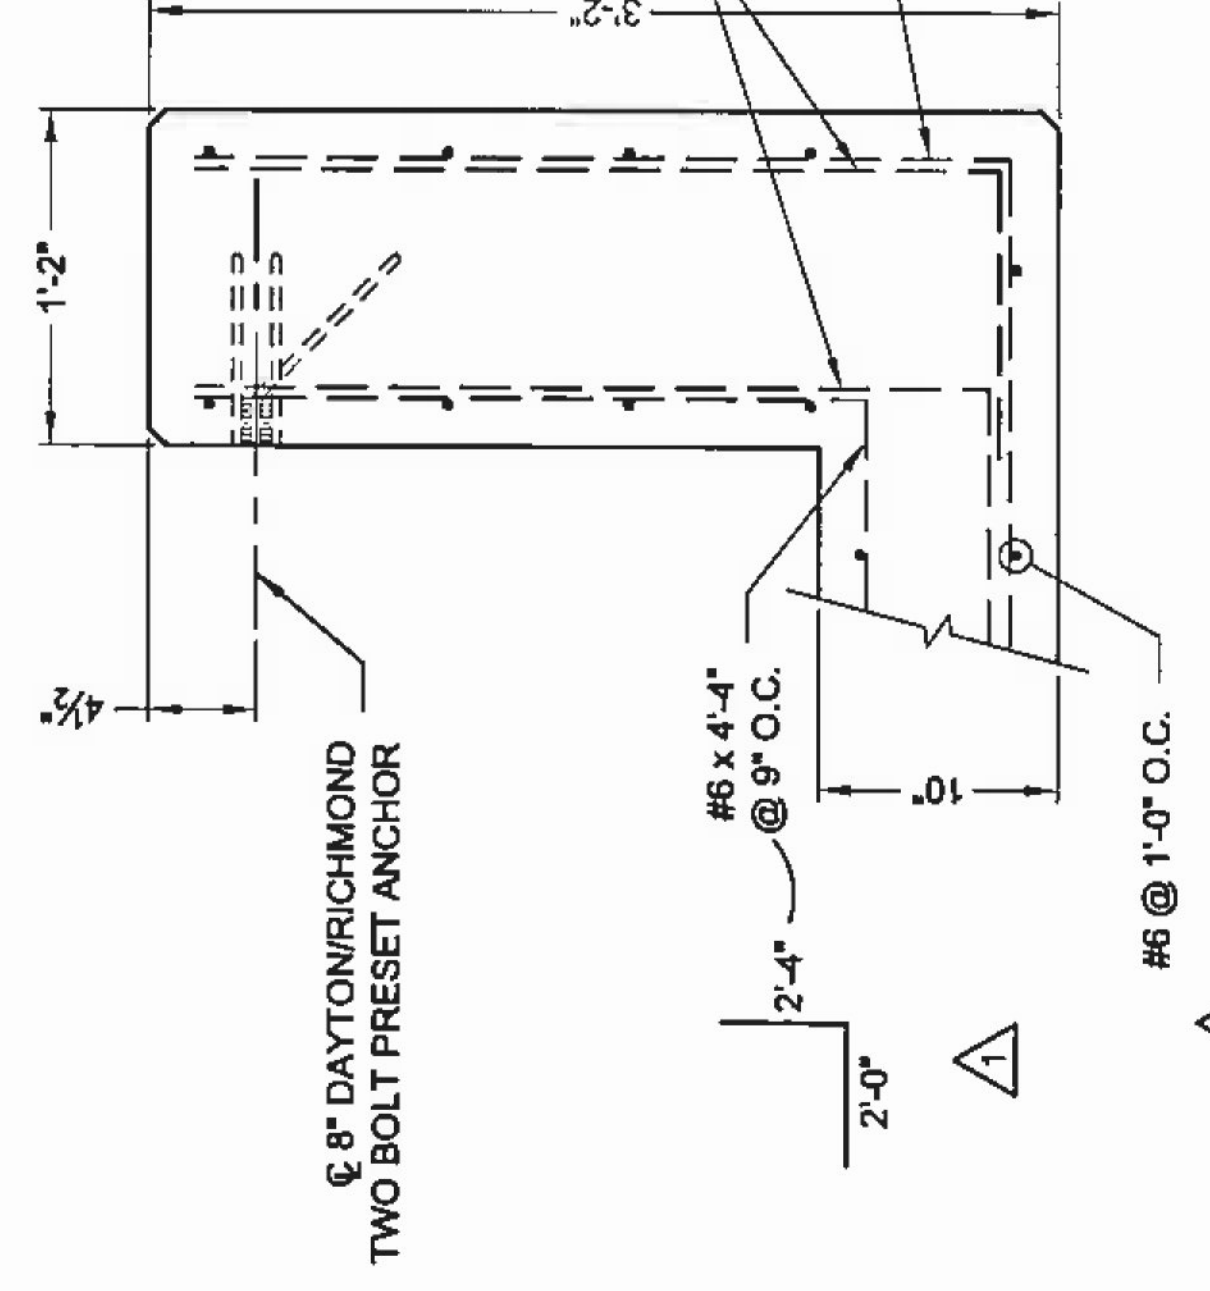

SECTION 36

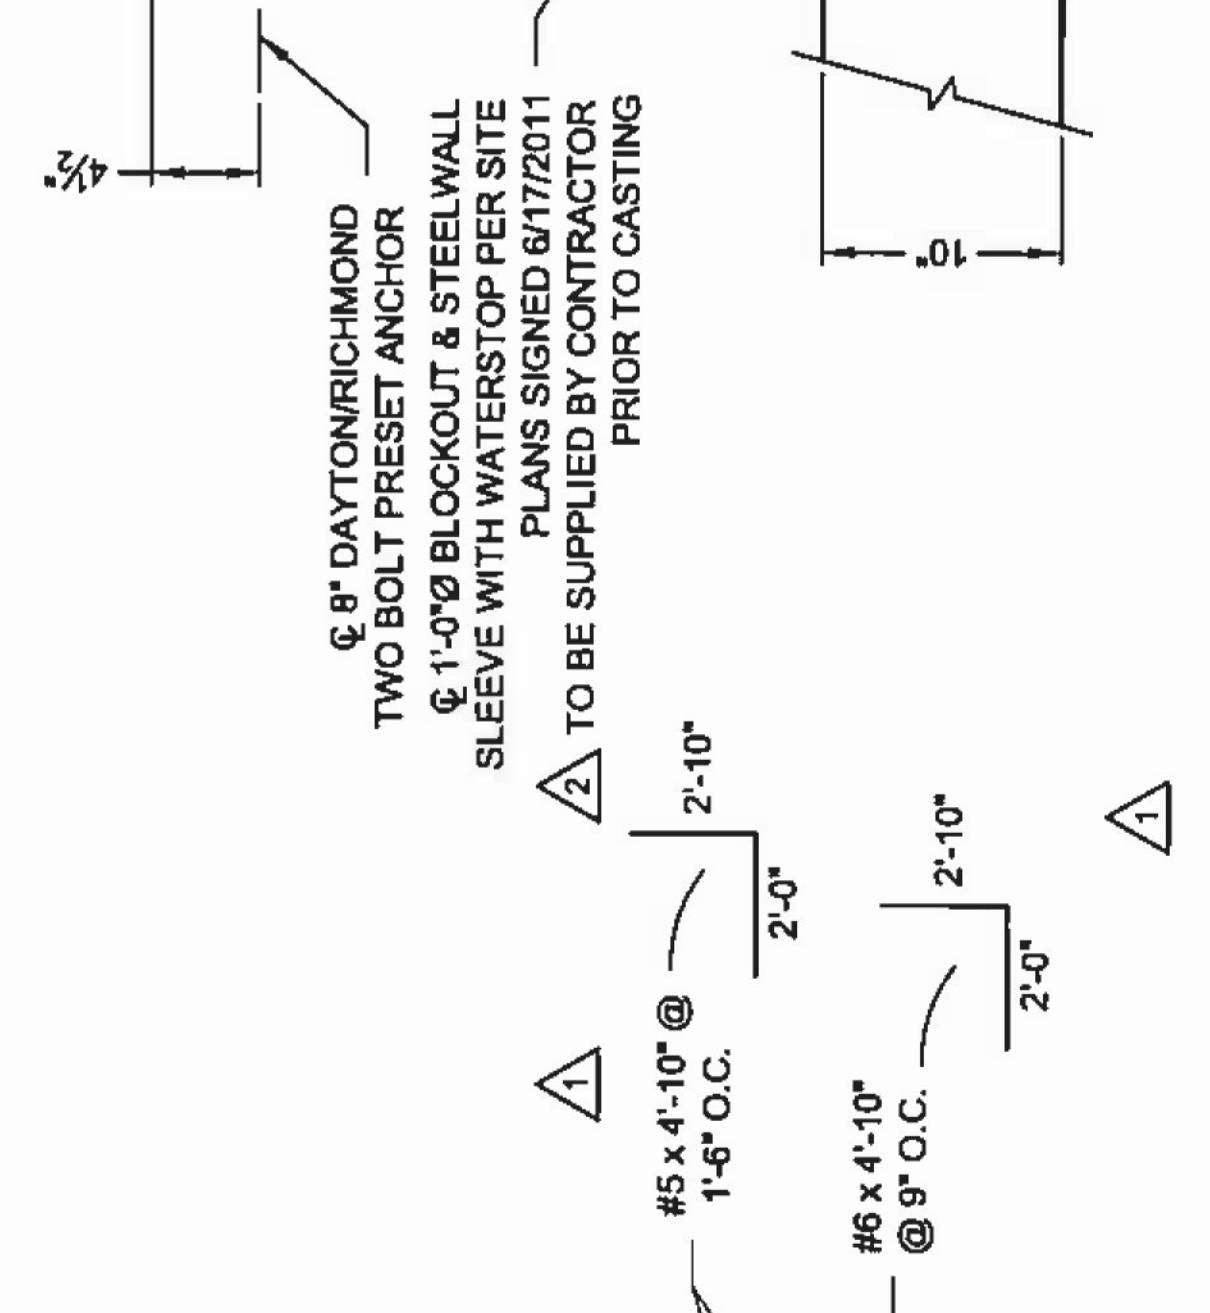

SECTION 37

This design and information shown on this drawing is provided as a service to the project owner, engineer and contractor by CONTECH Construction Products Inc. It is not to be used for any other project without the express written consent of CONTECH Construction Products Inc. CONTECH Construction Products Inc. shall not be held responsible for any errors or omissions in this drawing or for any consequences that may result from its use. CONTECH Construction Products Inc. shall not be held responsible for any consequences that may result from its use. CONTECH Construction Products Inc. shall not be held responsible for any consequences that may result from its use.

MARK	DATE	REVISION DESCRIPTION	BY
5	4/27/2011	NO CHANGES ON THIS SHEET	RKL
4	4/18/2011	REVISIONS PER REVIEWERS COMMENTS	RKL
3	4/8/2011	REVISIONS PER REVIEWERS COMMENTS	RKL
2	4/4/11	REVISIONS PER REVIEWERS COMMENTS	RKL
1	3/10/2011	REVISIONS PER REVIEWERS COMMENTS	RKL

CONTECH
 CONSTRUCTION PRODUCTS INC.
 www.contech-cpi.com
 8025 Centre Pointe Dr., Suite 400, West Chester, OH 45069
 800-338-1122 513-645-7000 513-645-7993 FAX

CONISPAN
 BRIDGE SYSTEMS
 CONTECH
 FABRICATION
 DRAWING

HARTFORD TH#
 VERMONT AGENCY OF TRANSPORTATION
 HARTFORD, VT