



△ EC3 MAT'L C8X11.5
LENGTH: 34'-5 1/8" QTY. 2

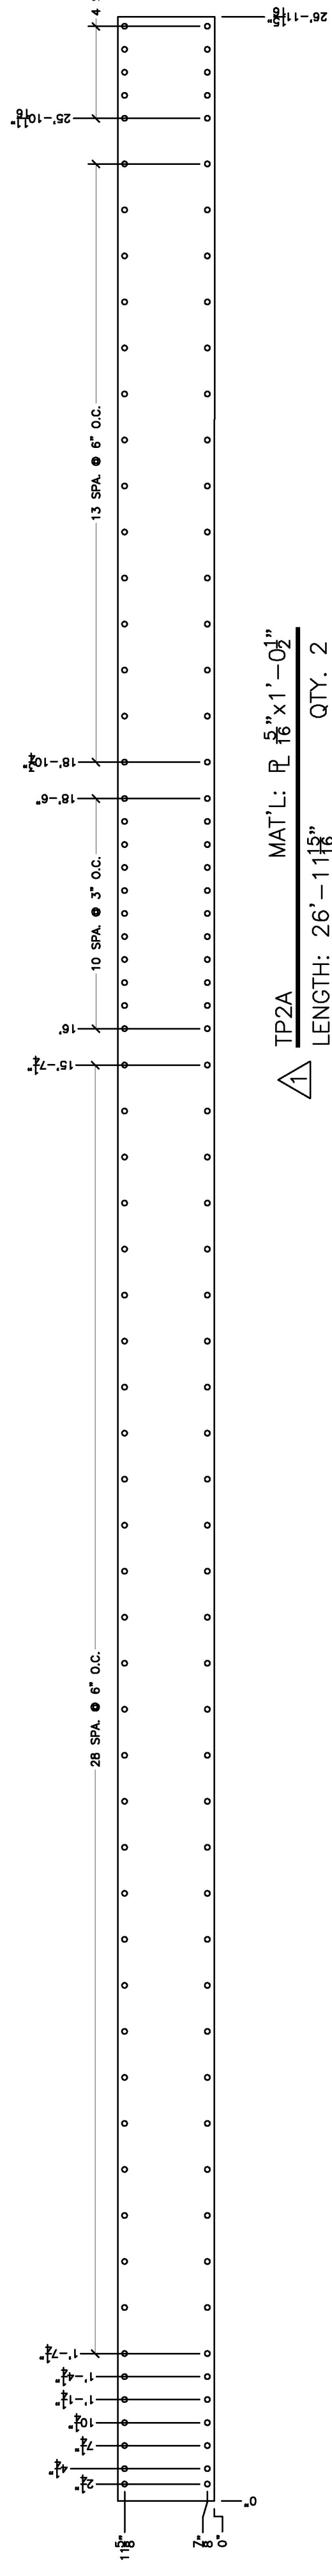

△ TP2A MAT'L: PL 5/8"x1'-0 1/2"
LENGTH: 26'-11 1/8" QTY. 2

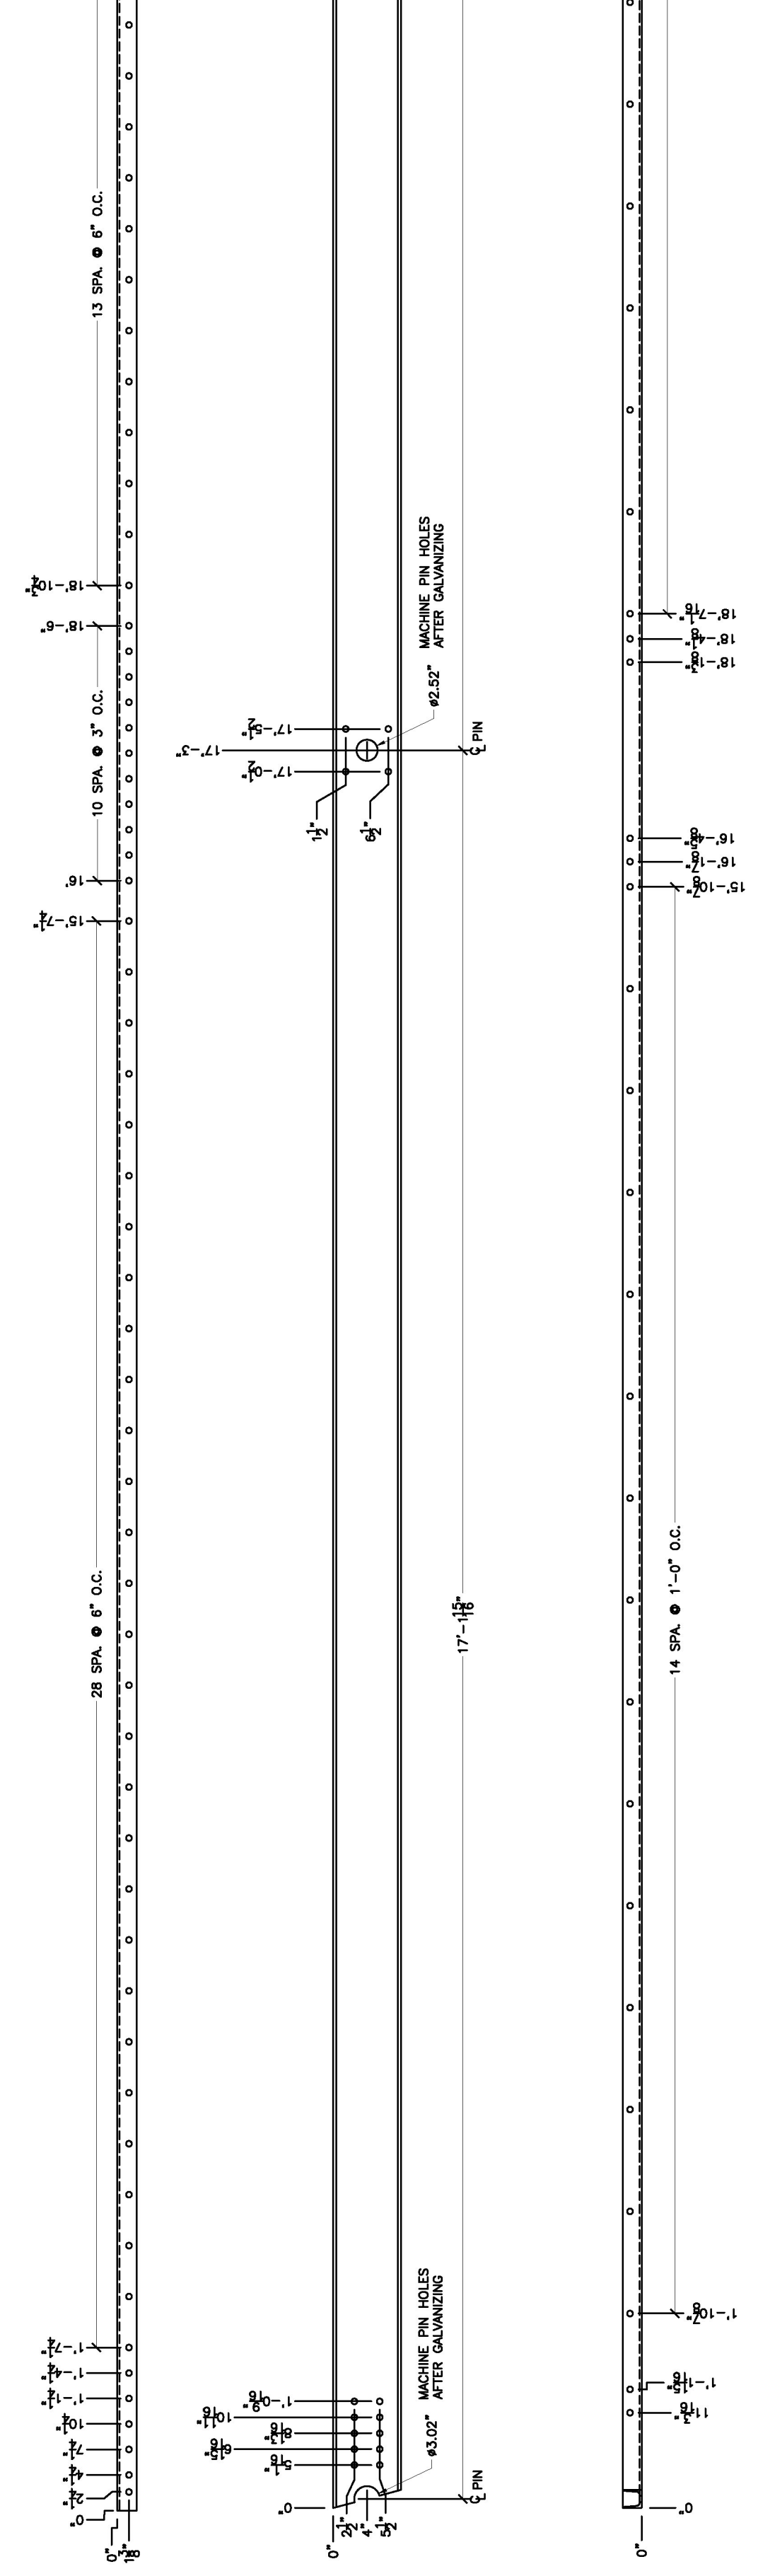

△ EC4 MAT'L C8X11.5
LENGTH: 34'-5 1/8" QTY. 2

Vermont Agency of Transportation
RECEIVED

CK'D BY TCF : OK'D BY KMH
October 5, 2012

RESUBMIT BY KMH APPROVED X
DATE 10/5/2012

REV. NO.	DATE:
△	10/3/2012

B. K