


EC1 MAT'L CBX11.5
 LENGTH: 20'-4 3/8" QTY. 4

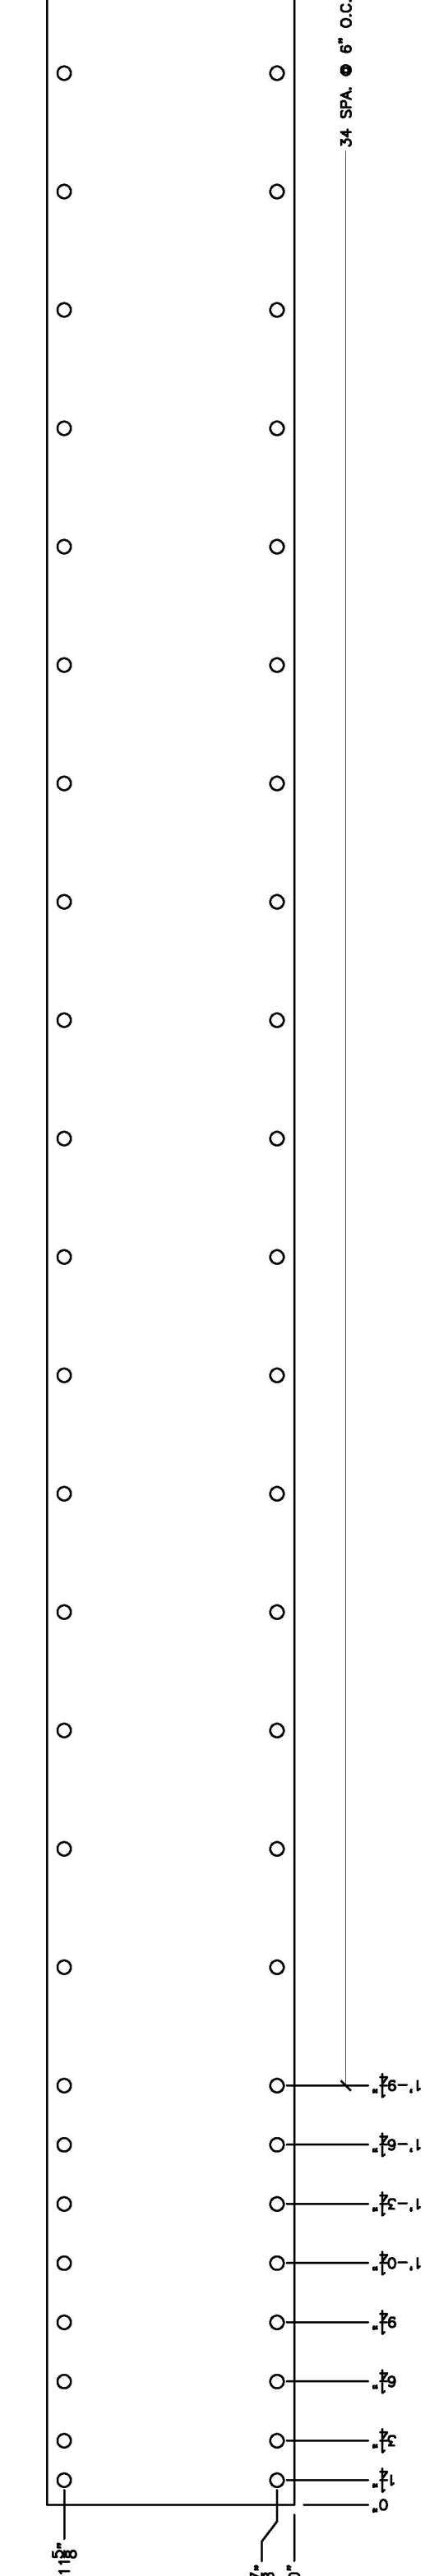

TP1 MAT'L: R 18"X1'-0 1/2"
 LENGTH: 20'-4 3/8" QTY. 4

Vermont Agency of Transportation

RECEIVED

CK'D BY TCF, OK'D BY KMH
 October 5, 2012

RESUBMIT BY KMH, APPROVED X DATE 10/5/2012

REV. NO.	DATE:
Δ	10/3/2012

B. K